


DCR PHOENIX HOMES

NUVO - BACK TO BACK
STACKED TERRACE HOMES

UPPER UNIT

REVISED: JANUARY 17, 2023

PATHWAYS BUILDING 2 UNIT 210

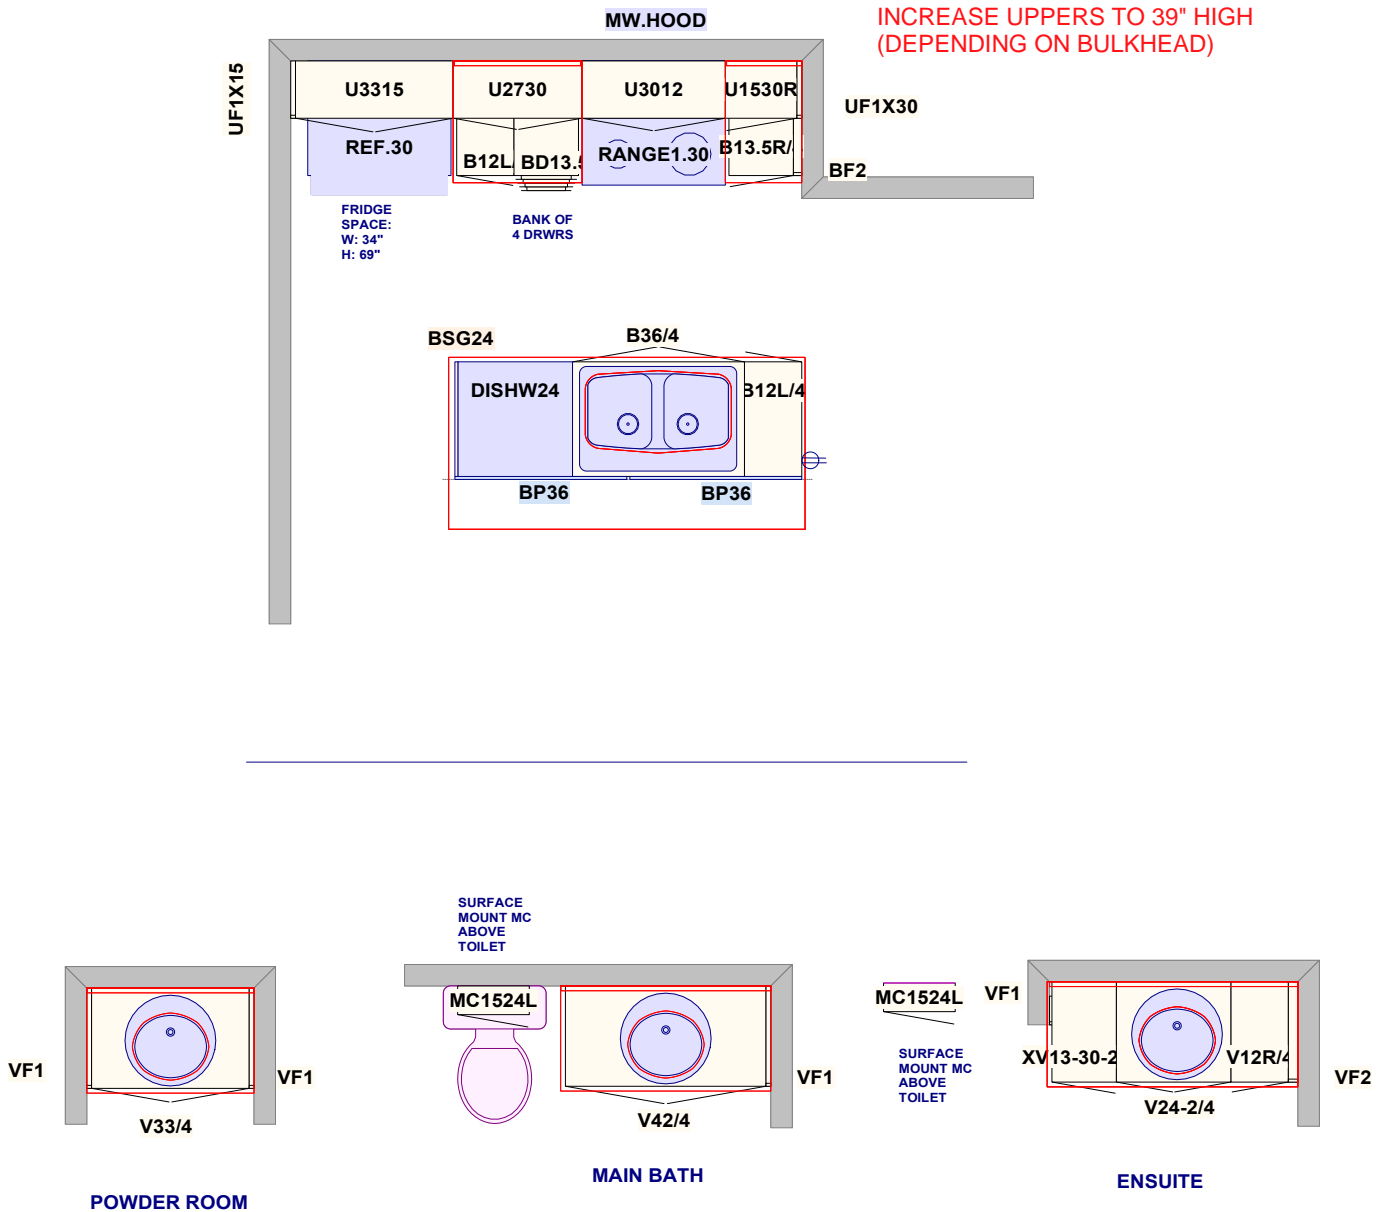

All dimensions .size designations given are subject to verification on job site and adjustment to fit job conditions.




This is an original design and must not be released or copied unless applicable fee has been paid or job order placed.

Designed: 9/30/2024
Printed: 9/30/2024

DS Initial
Dka

PATHWAYS BUILDING 2 UNIT 210

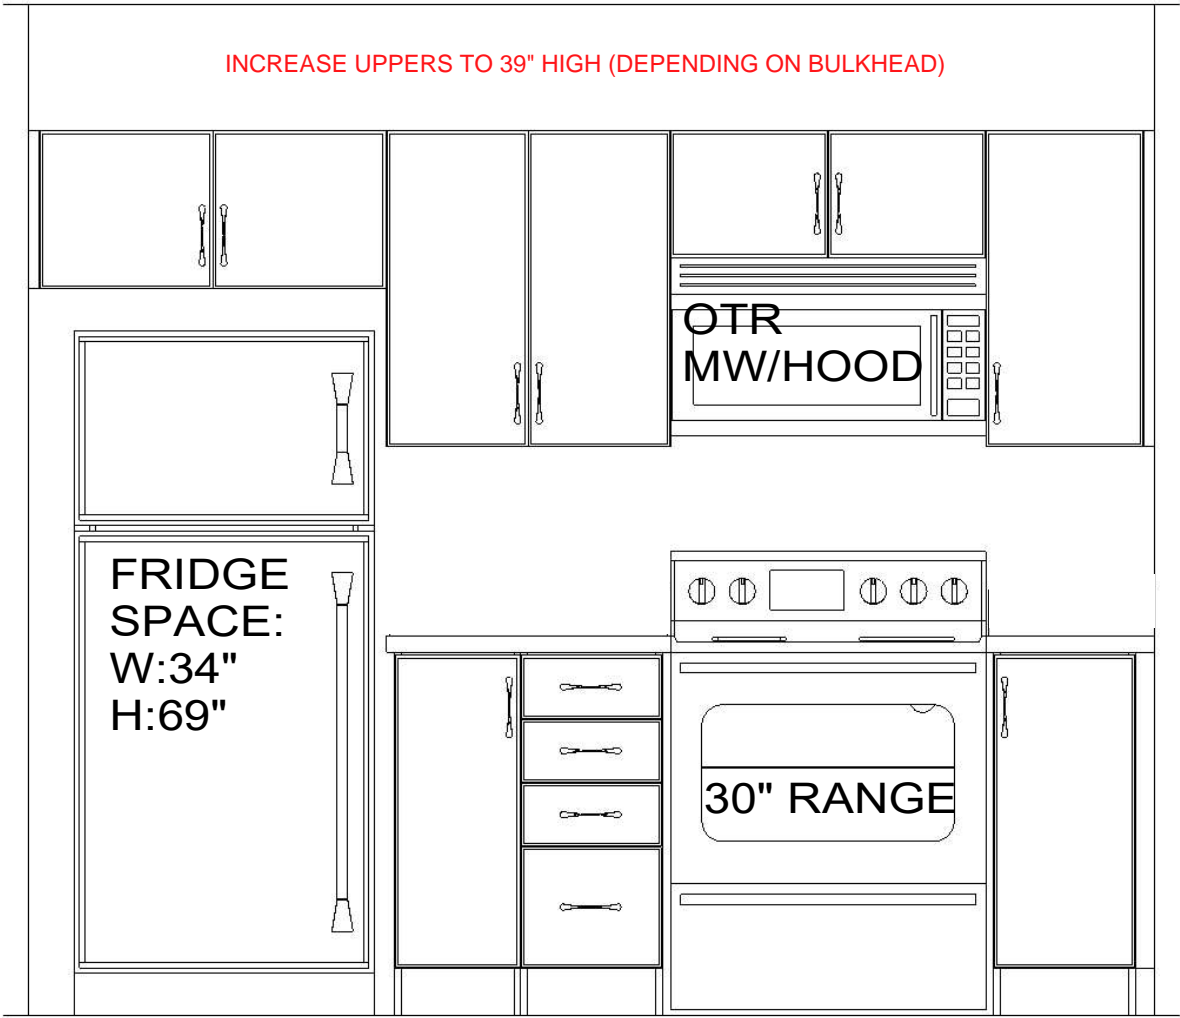

UPPER UNIT

FRIDGE/ RANGE WALL ELEVATION

All dimensions ,size designations given are subject to verification on job site and adjustment to fit job conditions.




This is an original design and must not be released or copied unless applicable fee has been paid or job order placed.

Designed: 9/30/2024
Printed: 9/30/2024


DS Initial
Dka *[Signature]*

PATHWAYS BUILDING 2 UNIT 210

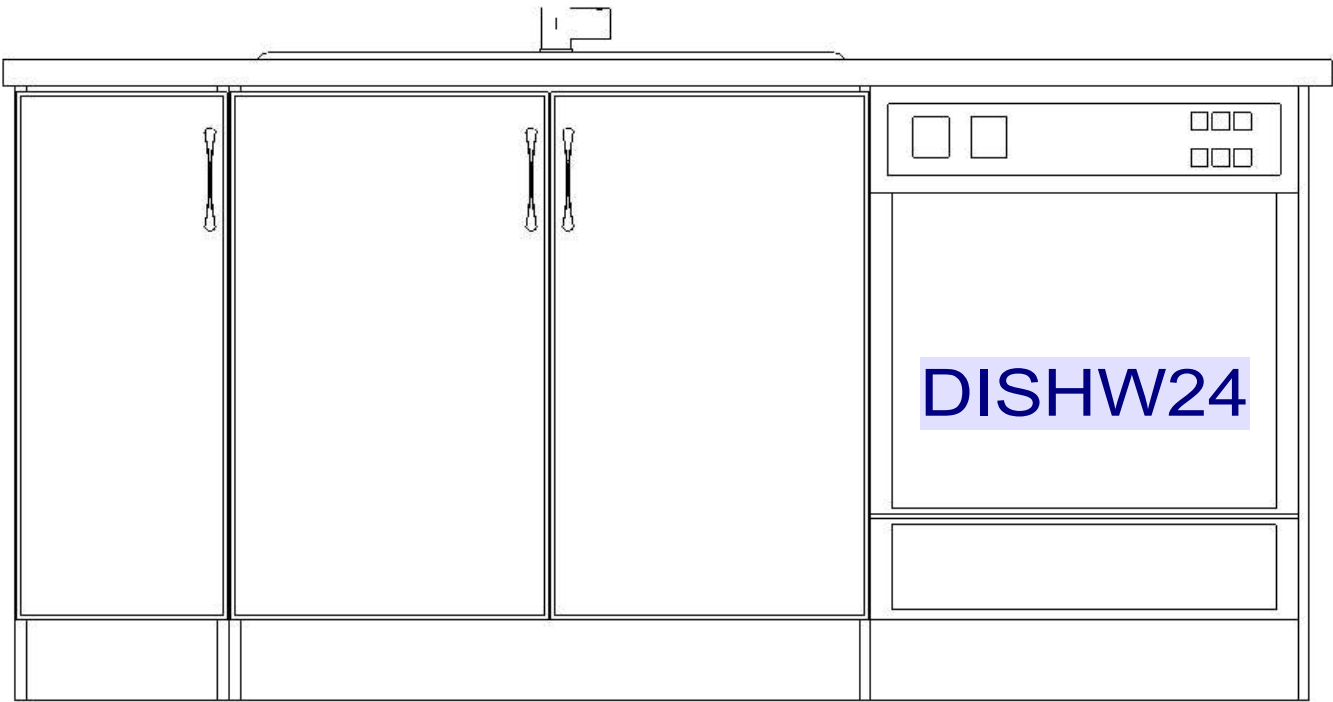


ISLAND ELEVATION


PATHWAYS BUILDING 2 UNIT 210

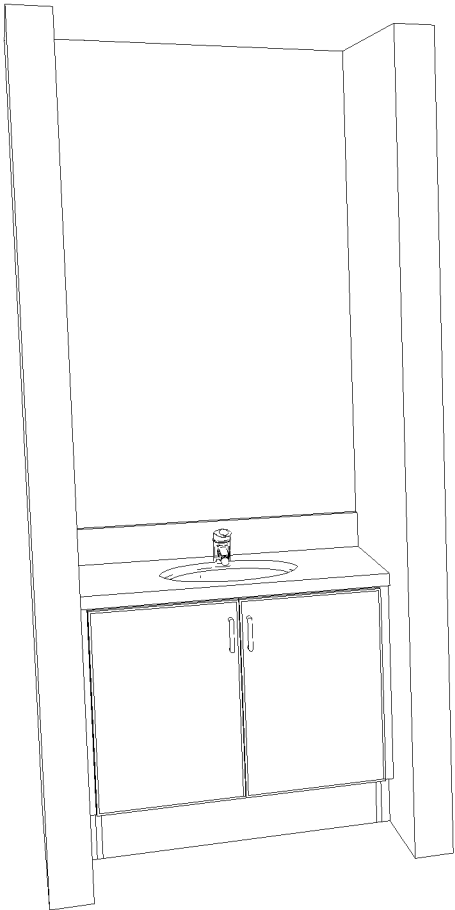

POWDER ROOM

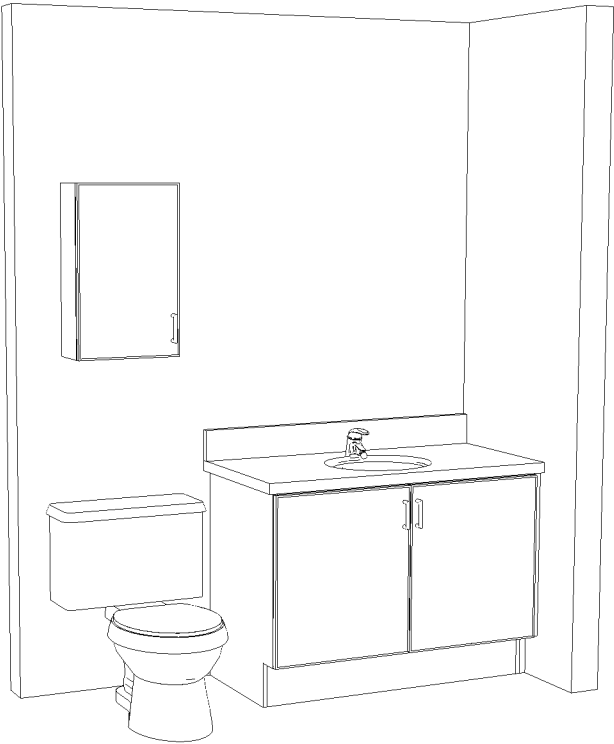

MAIN BATH

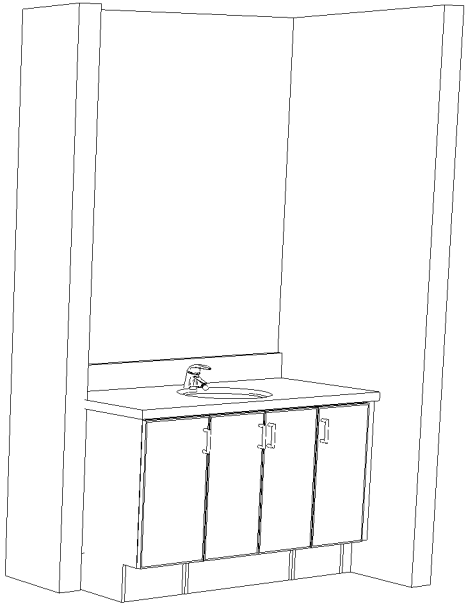

ENSUITE

UPPER UNIT - VANITIES - 3D VIEW

CUSTOMER APPROVAL

I have reviewed these drawings and understand the details of the design and the Cartier Kitchens specifications

Signature _____

Date _____

Note: This drawing is an artistic interpretation of the general appearance of the design. It is not meant to be an exact rendition.

SPECTRUM KITCHEN and BATH DESIGN

DCR - Terrace Homes - Upper unit



Designed: 2020-06-29
Printed: 2020-08-09

DS
Dka

Initial
[Signature]

Drawing #: 1