



DCR PHOENIX HOMES

NUVO - BACK TO BACK  
STACKED TERRACE HOMES

UPPER UNIT

REVISED: JANUARY 17, 2023

PATHWAYS BUILDING 2 UNIT 212

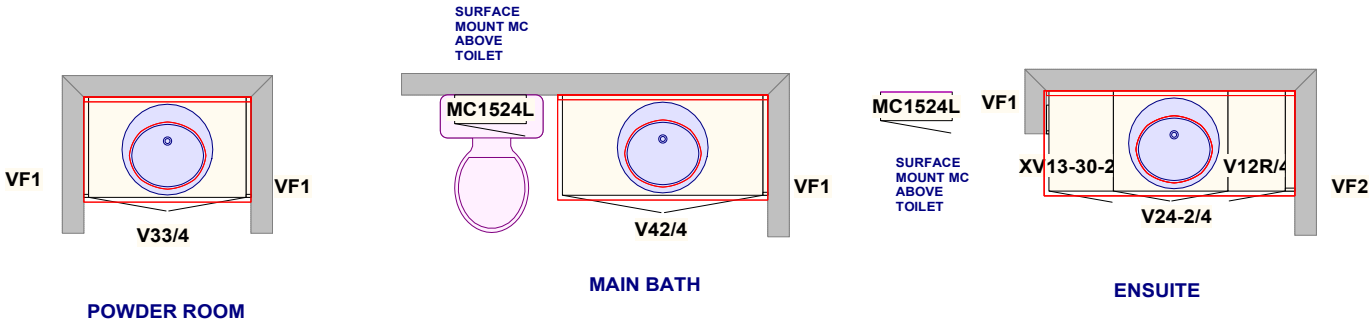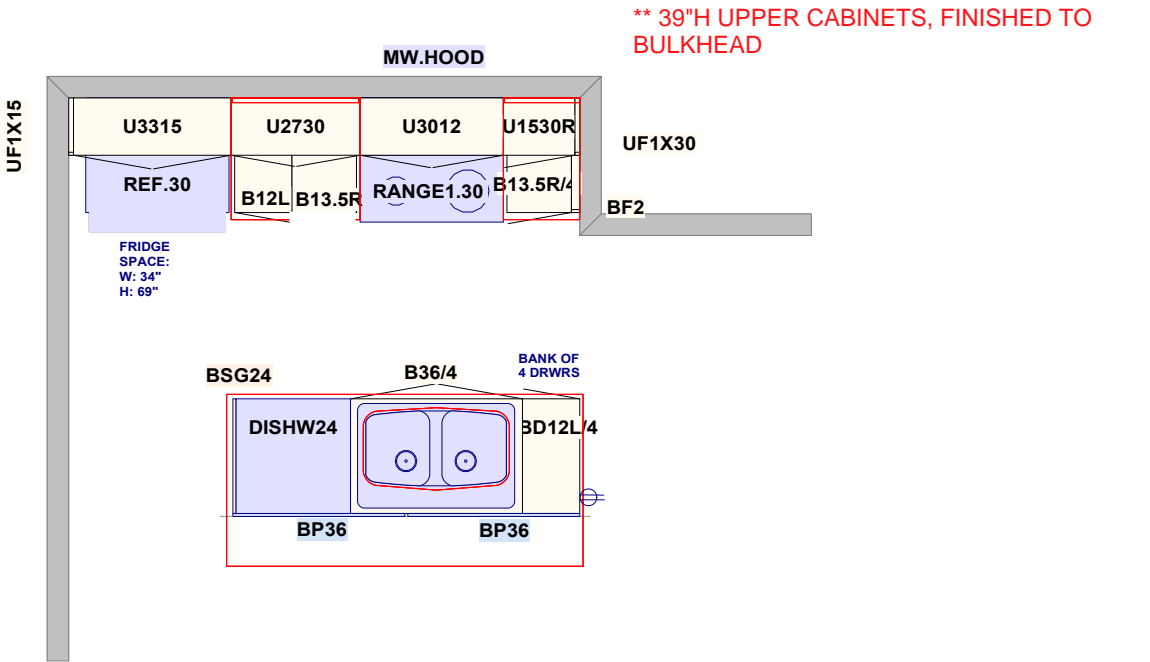


All dimensions .size designations given are subject to verification on job site and adjustment to fit job conditions.



This is an original design and must not be released or copied unless applicable fee has been paid or job order placed.

Designed: 9/30/2024  
Printed: 9/30/2024

Initial DS  
AK M+

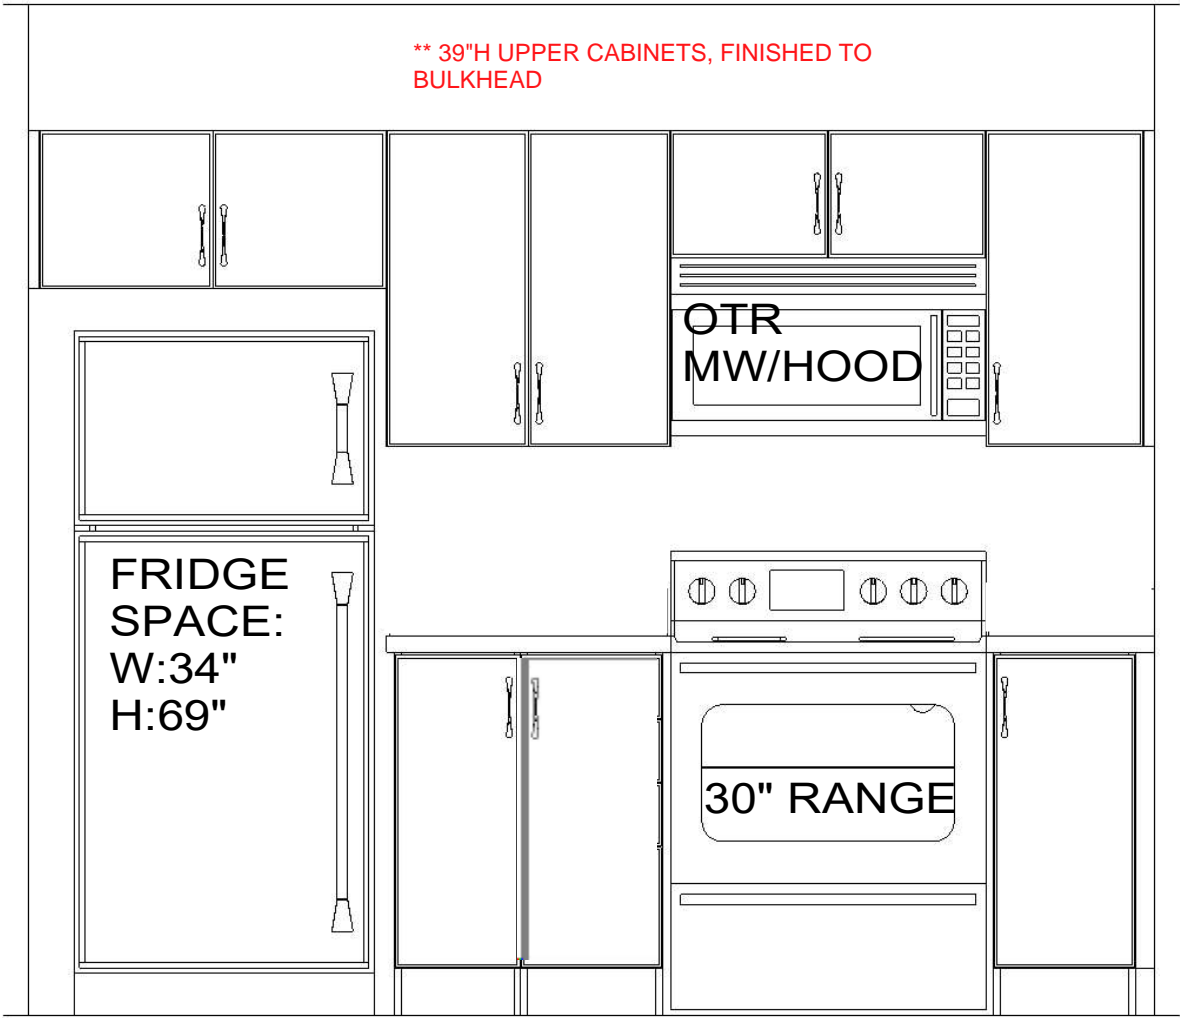

UPPER UNIT

FRIDGE/ RANGE WALL ELEVATION


All dimensions ,size designations given are subject to verification on job site and adjustment to fit job conditions.



This is an original design and must not be released or copied unless applicable fee has been paid or job order placed.

Designed: 9/30/2024  
Printed: 9/30/2024

Initial DS  
AK M+

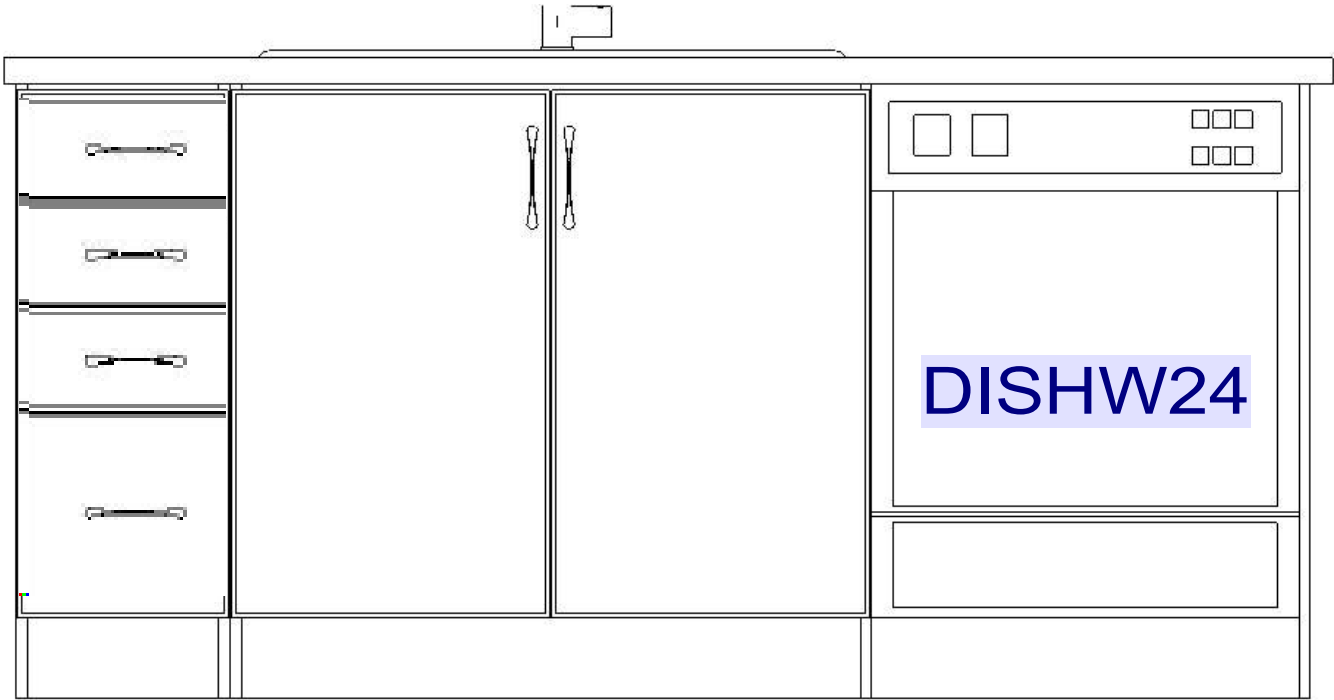


ISLAND ELEVATION

All dimensions ,size designations given are subject to verification on job site and adjustment to fit job conditions.




This is an original design and must not be released or copied unless applicable fee has been paid or job order placed.


Designed: 9/30/2024  
Printed: 9/30/2024  
Initial AK DS MT

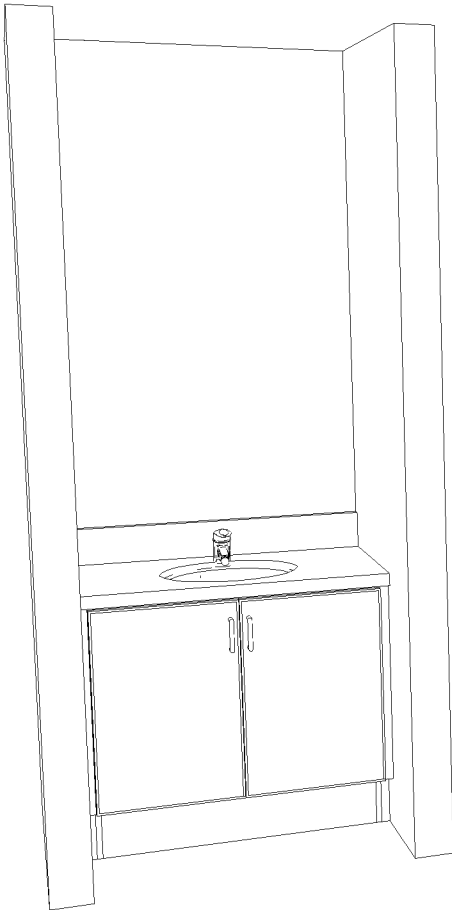

POWDER ROOM

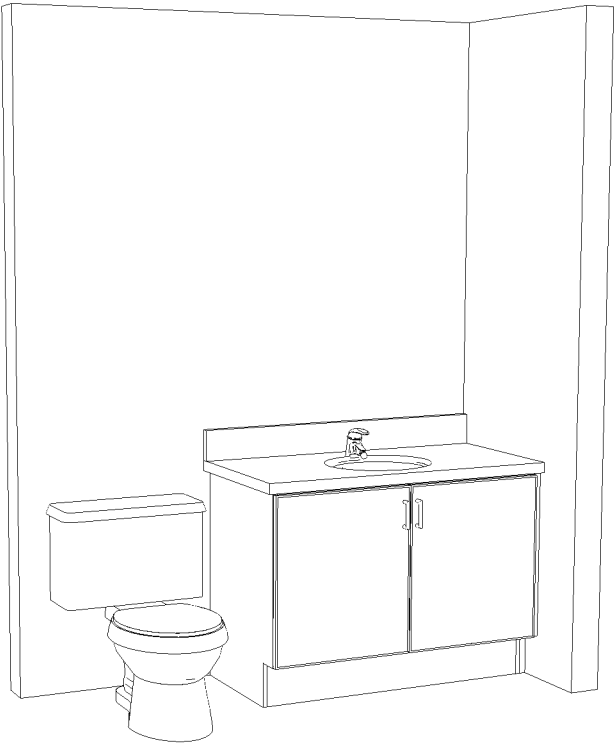

MAIN BATH

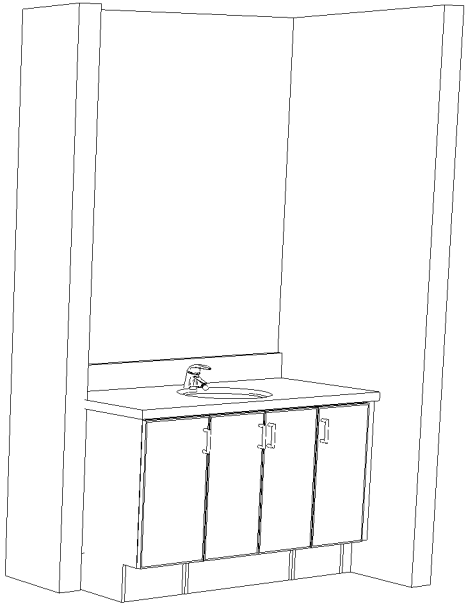

ENSUITE

UPPER UNIT - VANITIES - 3D VIEW

<b>CUSTOMER APPROVAL</b>	
I have reviewed these drawings and understand the details of the design and the Cartier Kitchens specifications	
Signature	_____
Date	_____

Note: This drawing is an artistic interpretation of the general appearance of the design. It is not meant to be an exact rendition.

SPECTRUM KITCHEN and BATH DESIGN

DCR - Terrace Homes - Upper unit



Designed: 2020-06-29 Printed: 2020-08-09	
Initial <b>AK</b>	DS <b>Mt</b>
Drawing #: 1	