

DCR PHOENIX HOMES



NUVO - BACK TO BACK  
STACKED TERRACE HOMES

LOWER UNIT


REVISION: JANUARY 17, 2023

- CABINETS - CARTIER LINE 1
- HARDWARE - STD & 1ST UPGRADE
- STD HINGES
- STD METAL DRWRS
- 5 PCS - 5/8" KICK
- 6 PCS - FLAT SHOE MOULDING


PATHWAYS BUILDING 2 UNIT 109

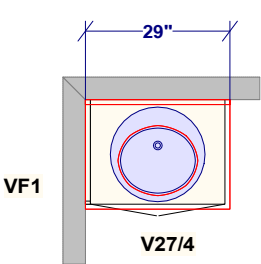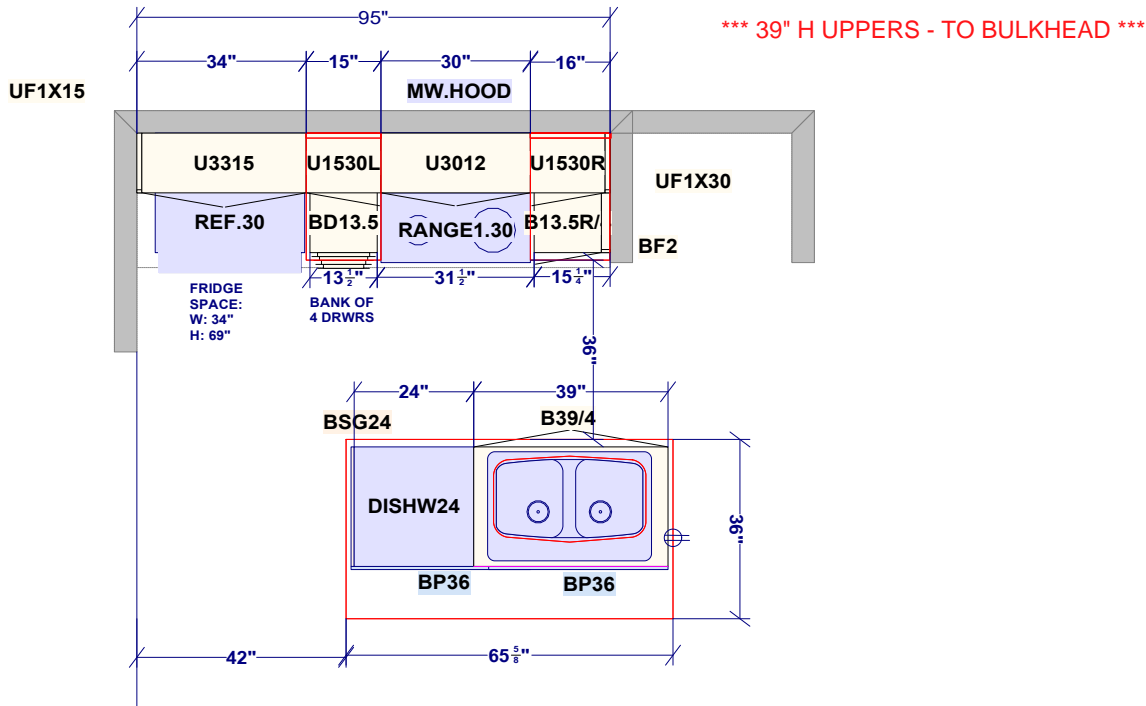

POWDER ROOM

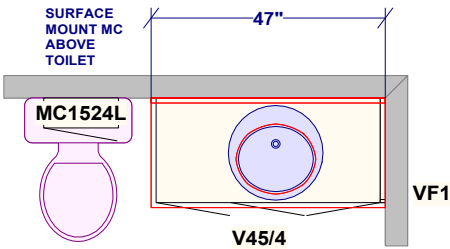

MAIN BATH

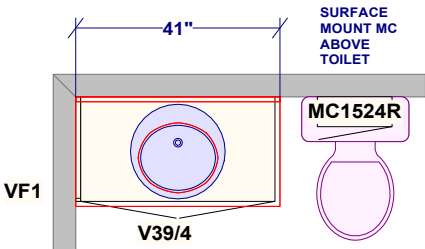

ENSUITE

**CUSTOMER APPROVAL**

I have reviewed these drawings and understand the details of the design and the Cartier Kitchens specifications

Signature \_\_\_\_\_


Date \_\_\_\_\_

All dimensions size designations given are subject to verification on job site and adjustment to fit job conditions.



This is an original design and must not be released or copied unless applicable fee has been paid or job order placed.

Designed: 1/17/2023  
Printed: 1/17/2023

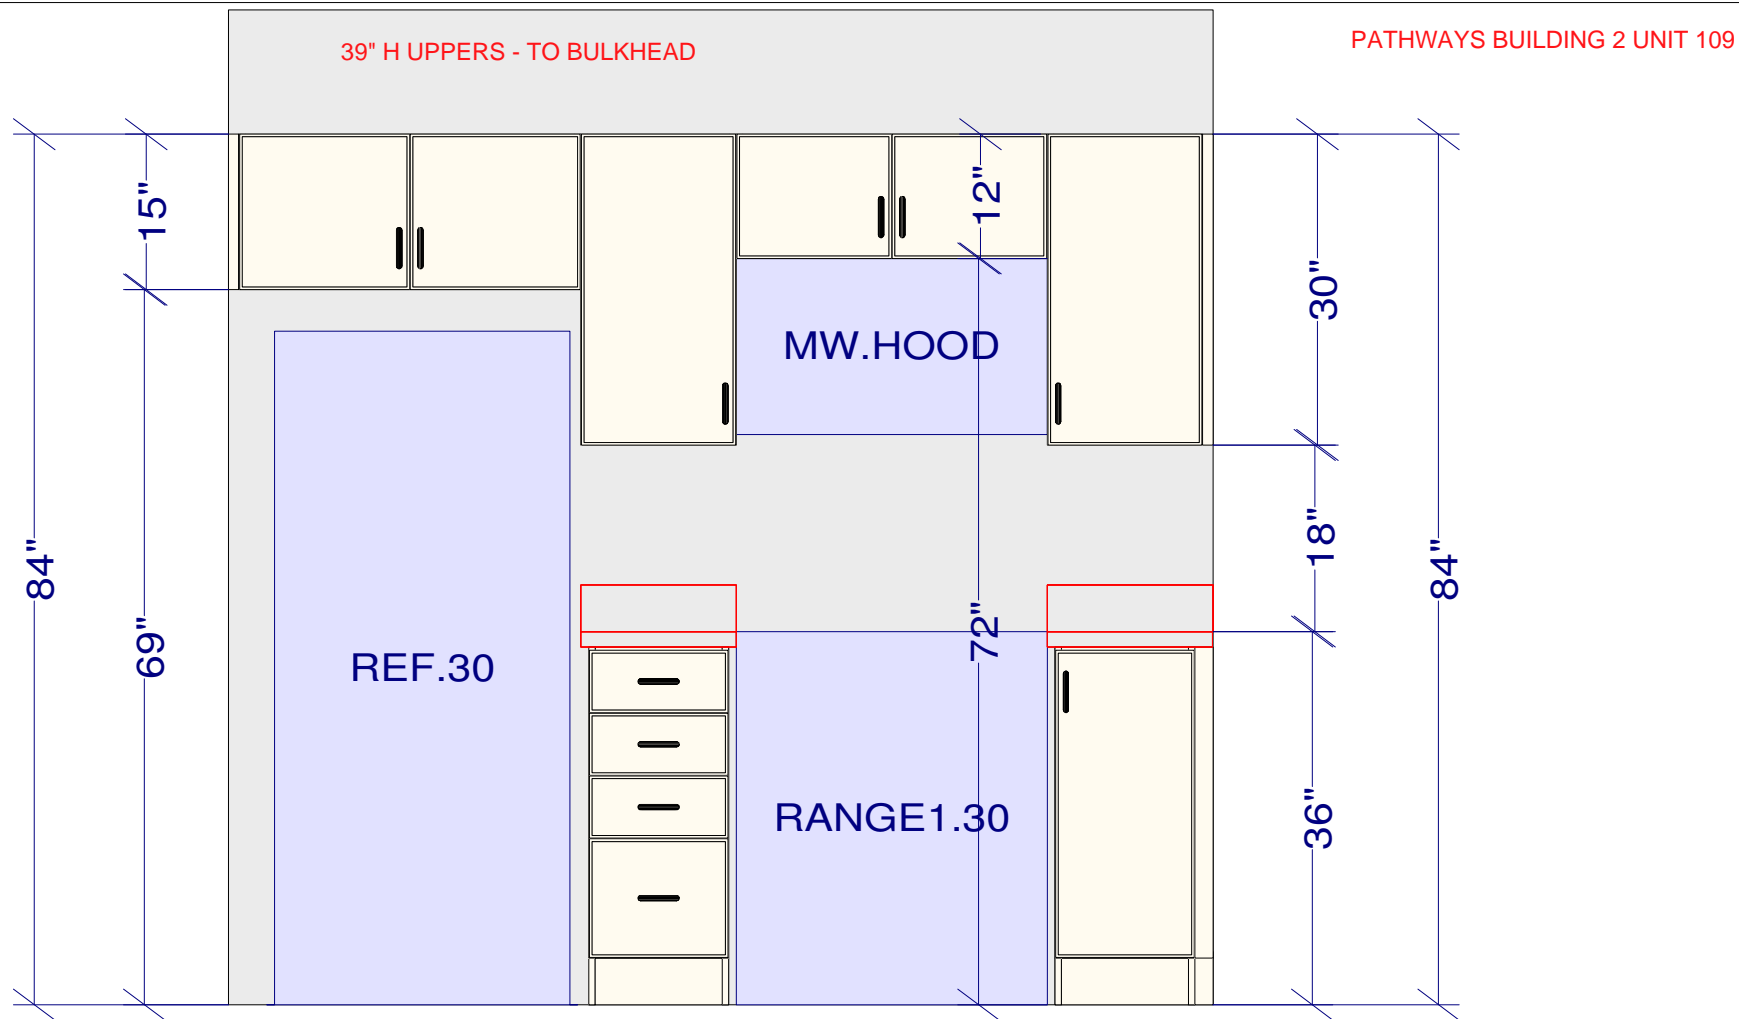

# LOWER UNIT FRIDGE / RANGE WALL ELEVATION

## CUSTOMER APPROVAL

I have reviewed these drawings and understand the details of the design and the Cartier Kitchens specifications

Signature \_\_\_\_\_


Date \_\_\_\_\_

All dimensions \_size designations given are subject to verification on job site and adjustment to fit job conditions.



This is an original design and must not be released or copied unless applicable fee has been paid or job order placed.

Designed: 2020-06-24  
Printed: 2023-01-04

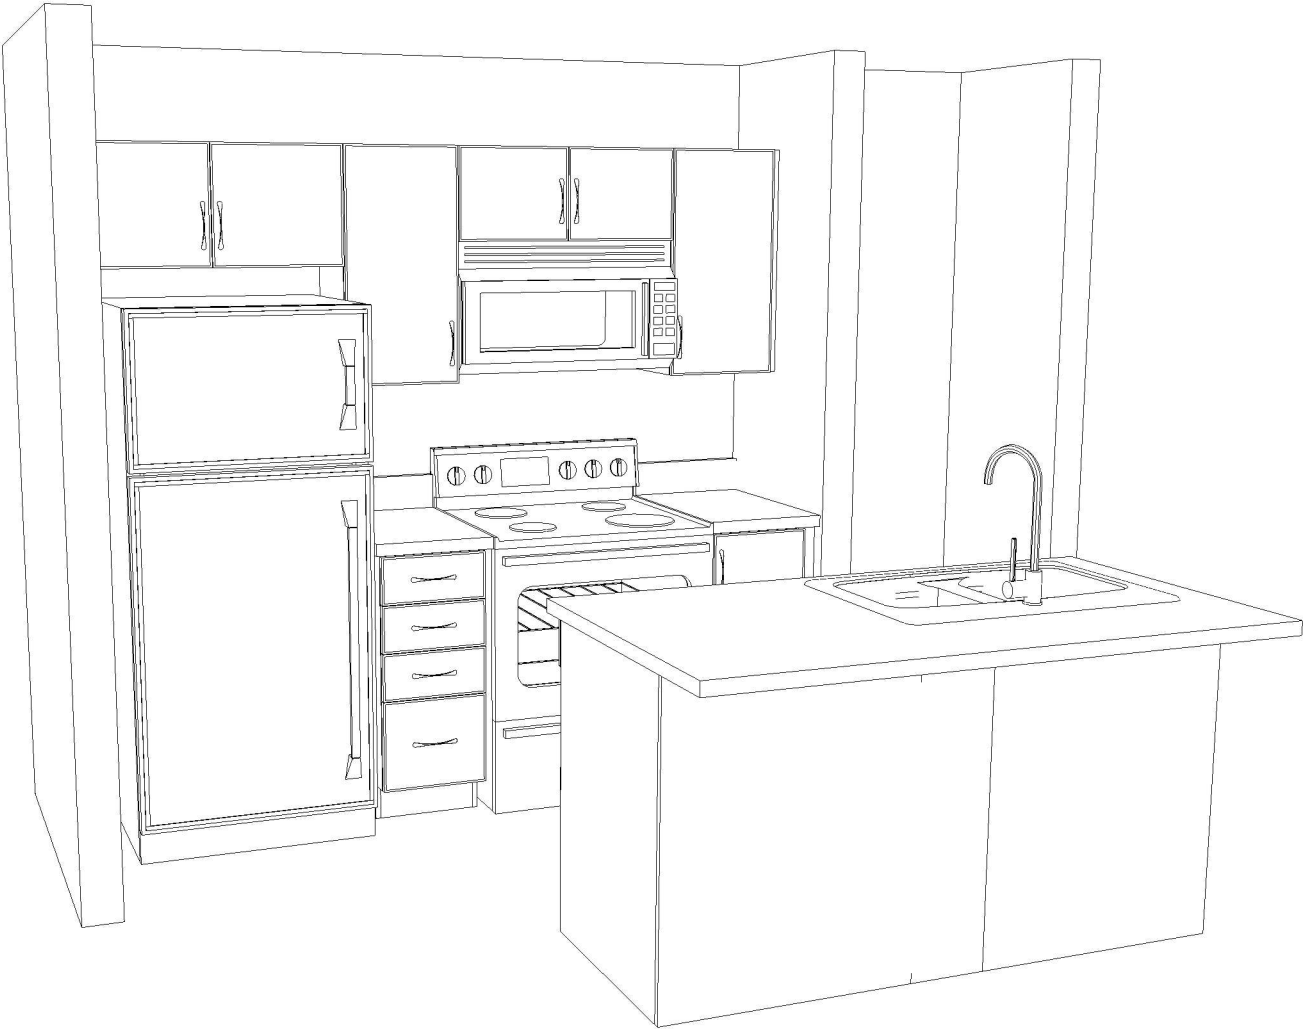


LOWER UNIT - KITCHEN 3D VIEW #1

<p><b>CUSTOMER APPROVAL</b></p> <p>I have reviewed these drawings and understand the details of the design and the Cartier Kitchens specifications</p> <p>Signature _____</p> <p>Date _____</p>	
---	--

Note: This drawing is an artistic interpretation of the general appearance of the design. It is not meant to be an exact rendition.



Designed: 1/17/2023	
Printed: 1/17/2023	

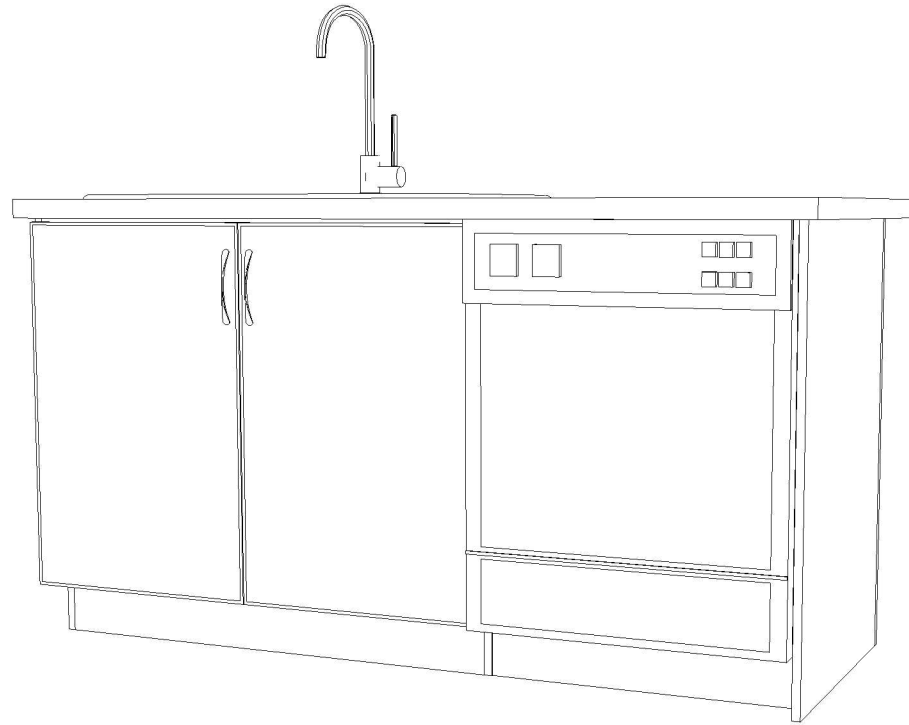

LOWER UNIT - KITCHEN - 3D VIEW #2

**CUSTOMER APPROVAL**

I have reviewed these drawings and understand the details of the design and the Cartier Kitchens specifications

Signature \_\_\_\_\_

Date \_\_\_\_\_

Note: This drawing is an artistic interpretation of the general appearance of the design. It is not meant to be an exact rendition.




Designed: 1/17/2023  
Printed: 1/17/2023



POWDER ROOM

MAIN BATH

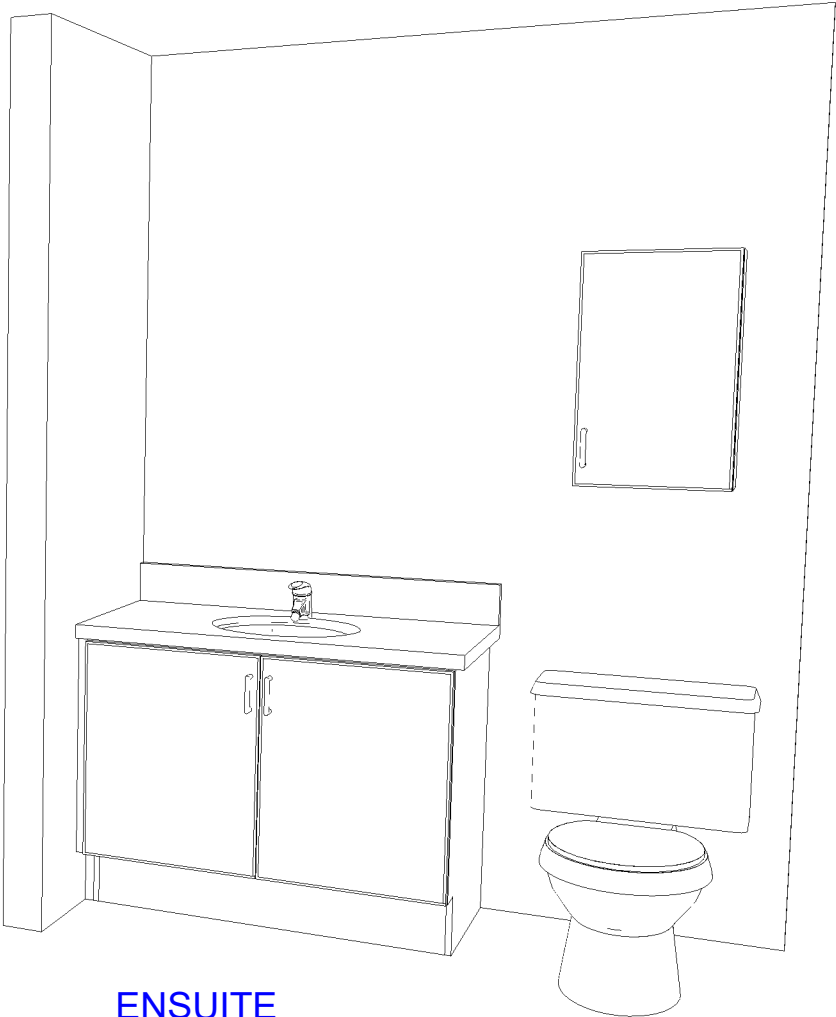

ENSUITE

LOWER UNIT VANITIES - 3D VIEW

<p><b>CUSTOMER APPROVAL</b></p> <p>I have reviewed these drawings and understand the details of the design and the Cartier Kitchens specifications</p> <p>Signature _____</p> <p>Date _____</p>	
---	--

Note: This drawing is an artistic interpretation of the general appearance of the design. It is not meant to be an exact rendition.

SPECTRUM KITCHEN and BATH DESIGN

DCR - Terrace Homes -Lower unit.kit



Designed: 2020-06-24
Printed: 2020-08-09

All	Drawing #: 1
-----	--------------