


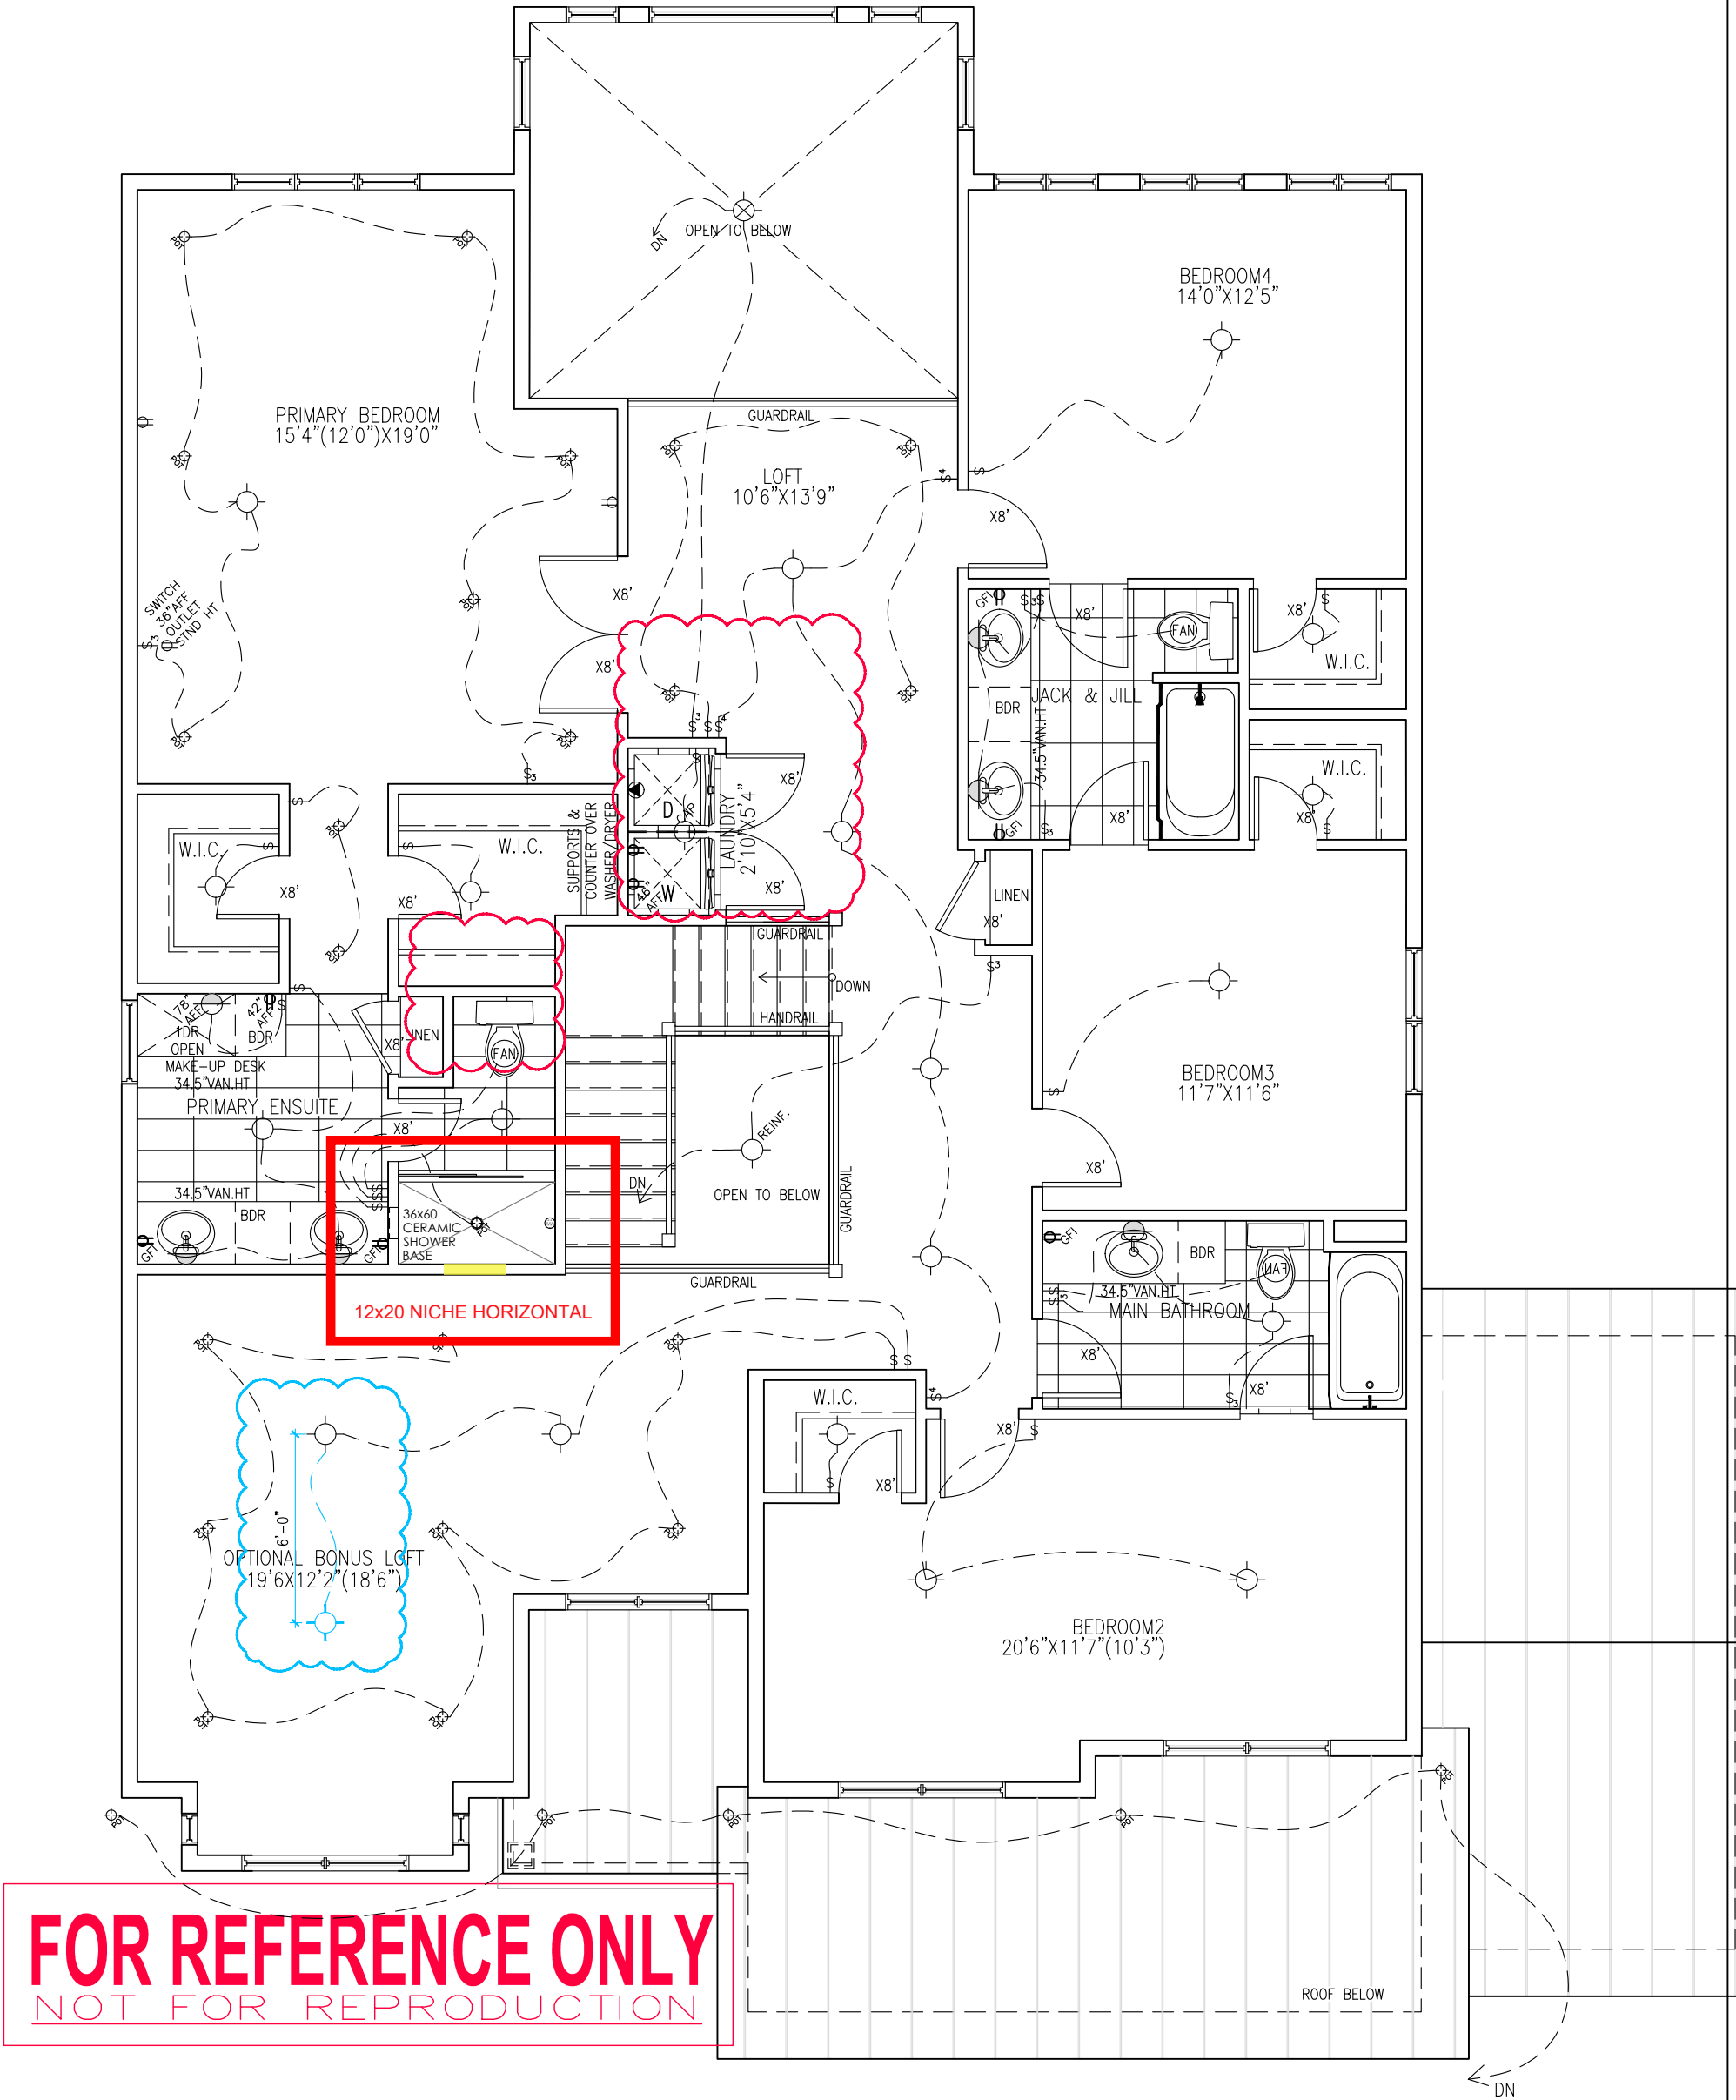

SECOND FLOOR PLAN ELEV. R

9' SECOND FLOOR

PHOENIX HOMES

KINGSWOOD-R-2022

SITE: WHITE TAIL RIDGE

LOT NUMBER: 126

CIVIC ADDRESS:
136 FRANK FISHER CRES

16	FINAL FOR SITE REVISED	MAY-07-25	SP
15	NEW FINAL BLACKLINES	MAY-06-25	RK
14	FINAL FOR SITE REVISED	APR-03-25	SP
13	FINAL FOR SITE REVISED	JAN-20-25	SP
12	FINAL BLACKLINES REVISED	JAN-9-25	SP
11	FINAL FOR SITE	OCT-31-24	SP
No.	Description	Date	By
REVISIONS			

file number: 50-22-4R

drawn by: S.P.

date: FEB. 2022

scale: 3/16"=1'

DCL-202
sheet no:

4R
9