


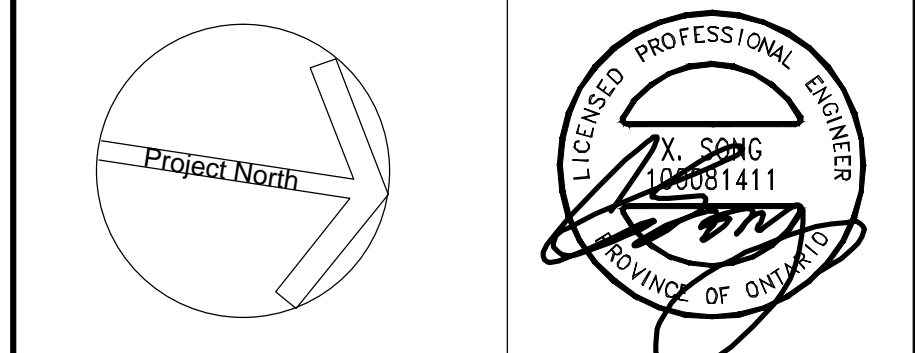
10	CM	ISSUED FOR AS PER SI E-10	2017-09-12
89	CM	ISSUED FOR AS PER SI E-4	2017-08-17
88	CM	ISSUED FOR AS PER SI E-3	2017-08-11
87	CM	ISSUED FOR CONSTRUCTION	2017-08-09
86	CM	PROGRESS FOR CONSTRUCTION	2017-07-18
85	CM	ISSUED FOR PERMIT	2016-12-28
84	CM	REVISED AS PER ADD E-1	2016-12-12
83	CM	REVISED AS PER SI E-2	2016-10-04
82	CM	REVISED AS PER ESA COMMENTS AND FOR CLARIFICATION	2016-05-19
81	CM	ISSUED FOR TENDER	2016-03-15
NO. BY		DESCRIPTION	DATE

This drawing, is an instrument of service, is provided by and is the property of United Engineering Inc. The contractor must verify and accept responsibility for all dimensions and conditions on site and must notify United Engineering Inc. of any discrepancy before proceeding.

United Engineering Inc. is not responsible for the accuracy of Architectural, structural, interior design, etc. on this drawing.

Refer to the appropriate trade drawings before proceeding with any work. Installation must conform to all applicable codes and requirements of the authorities having jurisdiction.

This drawing is not to be scaled, all symbols are graphic representations only.



United Engineering Inc.
 Mechanical Electrical Consulting Engineers
 3645 Keele Street, Suite 105,
 Toronto, Ontario, M3J 1M6
 Tel: (416) 398 1999, Fax: (416) 398 1933

TITLE	7TH FLOOR PLAN - B ELECTRICAL
-------	----------------------------------

PROJECT

**PROPOSED RESIDENTIAL DEVELOPMENT
25 BAKER HILL BLVD.**

ROYAL PINE HOMES
STOUFFVILLE, ONTARIO

DRAWN CM	CHECKED MG	SCALE 1:75
DATE SEPT. 2015	PROJECT 14-016	DRAWING E-7B
		OF 12