



## Site Instruction

Royal Pine Homes  
3550 Langstaff Road, Suite 200  
Woodbridge, Ontario  
L4L 9G3

SI 05

PROJECT	: Hampton Manor
PROJECT No	: 1136.13
DATE	: August 31, 2017

Attn: Vince Staffieri

Site instructions/memos and Addendums are issued only for the purpose of recording any clarification or interpretation of the contract documents or giving direction on problems resulting from field conditions. These memos are subject to the provisions of the contract documents and unless reviewed with and authorized by the Client, will not affect the contract. Should the Contractor require a change in the contract price or project schedule, he shall submit to the Client, prior to commencement of work outlined in this memo, an itemized proposal for approval.

Title: Typical shaft curb height change and F/A door and louver shift.

### A230 : P1 Parking Plan

- Dimensioning and Indicating Doors 23, 25. Shifting door 25 and louver opening by fresh air shaft.

### CS201: P1 CS Plan

- Changing shaft curb heights from 200mm high to 400mm high (typical) and shifting louver and door for fresh air shaft.

Reason: **As per Contractor Request.**

References: A231 & CS201.

GRAZIANI + CORAZZA  
ARCHITECTS INC

**G. Colangelo** Diploma Arch. Technology  
Associate. Director of Contract Documents


### Distribution:

Royal Pine Homes  
ReXcon Construxion  
ReXcon Construxion  
Graziani + Corazza Architects

Cinzia Caruso  
Lenny Simonelli  
Lauren Sorichetti  
Carmen Taranu

cinzia@royalpinehomes.com  
rexcon.construxion@gmail.com  
lsorichetti402@gmail.com  
ctaranu@gc-architects.com

\_\_\_\_\_

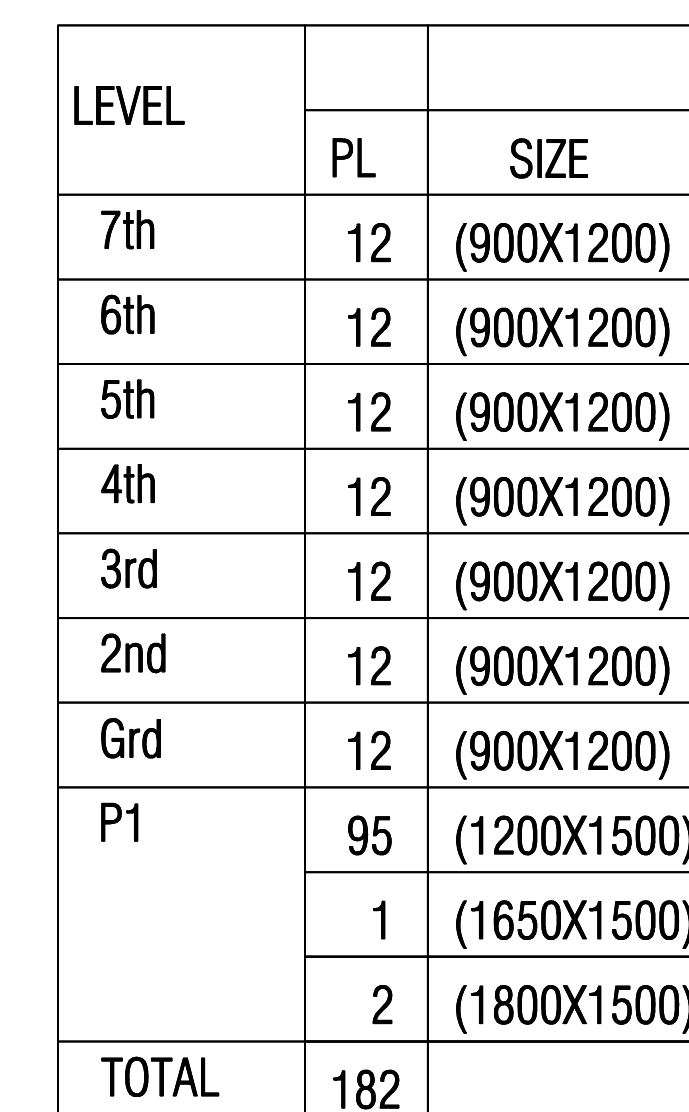


BAKER HILL -CAR COUNT

T=tandem car

BY-LAW REQUIRED 236 CARS  
TOTAL PROVIDED 319 CARS

issued for revisions

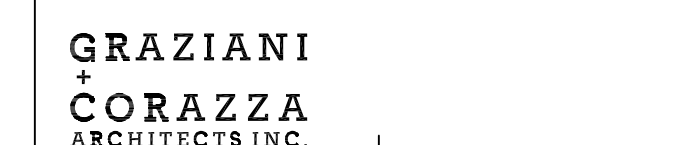

Phone: 905.795.2601 Fax: 905.795.2644 [www.gc-architects.com](http://www.gc-architects.com)

STOUFFVILLE ROYAL PINES HOMES ONTARIO

## PARKING PLAN





This drawing is not to be scaled. All architectural symbols indicated on this drawing  
graphic representations only.

S05 F/A SHAFT LOUVER &amp; DOOR SHIFT BO

G


GRAZIANI  
+  
CORAZZA

PROPOSED RESIDENTIAL DEVELOPMENT

STOUFFVILLE ROTAL FINES HOMES ONTARIO

Checked By: D.BIASE

## PARKING PLAN

 1:125 CS-A20