


NO.	BY	DESCRIPTION	DATE
5	LB	REVISED AS PER SITE INSTRUCTION 11-6	AUG/25/2017
4	LB	REVISED AS PER SITE INSTRUCTION 11-5	AUG/09/2017
3	LB	PROGRESS FOR CONSTRUCTION	JUL/18/2017
2	LY	ISSUED FOR PERMIT	DEC/28/2016
1	LY	ISSUED FOR TENDER	MAR/21/2016

This drawing, is an instrument of service, is provided by and is the property of United Engineering Inc. The contractor must verify and accept responsibility for all dimensions and conditions on site and must notify United Engineering Inc. of any discrepancy before proceeding. United Engineering Inc. is not responsible for the accuracy of Architectural, structural, interior design, etc. on this drawing. Refer to the appropriate trade drawings before proceeding with any work. Installation must conform to all applicable codes and requirements of the authorities having jurisdiction. This drawing is not to be scaled, all symbols are graphic representations only.

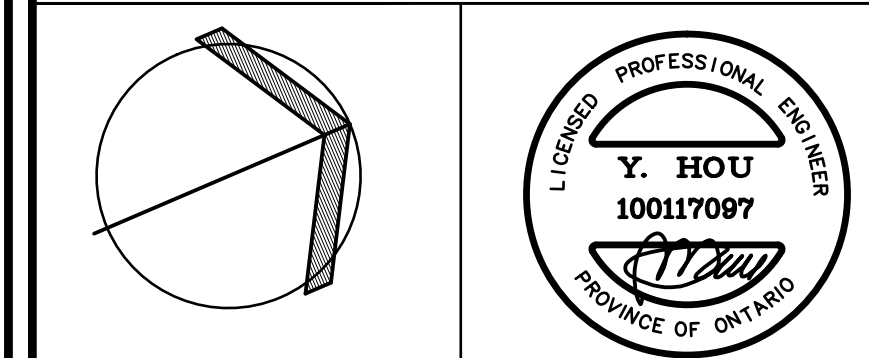

United Engineering Inc.
Mechanical Electrical Consulting Engineers
3045 Keele Street, Suite 105,
Toronto, Ontario, M3J 1M6
Tel: (416) 398 1999, Fax: (416) 398 1933

TITLE PART 3RD AND 4TH FLOORS MECHANICAL			
PROJECT 25 BAKER HILL BLVD. ROYAL PINE HOMES			
STOUFFVILLE, ONTARIO PROPOSED RESIDENTIAL DEVELOPMENT			
DRAWN GC	CHECKED BT	SCALE 1:50	DRAWING M-16 OF 42
DATE JUNE 2015	PROJECT 14-016		