


NOTES:
-ALL FLOOR DRAINS SHALL BE TRAPPED, PRIMED AND VENTED IN ACCORDANCE WITH PART #7 OF O.B.C.
-CLEANOUTS SHALL BE INSTALLED AT INTERVALS NOT EXCEEDING 15M ON 100MM DRAINAGE PIPE AND THE BASE OF ALL SOIL/WASTE STACKS.
-ALL PLUMBING FIXTURES SHALL BE VENTED IN ACCORDANCE WITH PART #7 OF O.B.C.
-ELECTRICALLY TRACE & INSULATE ALL EXPOSED TRAPS IN GARAGE

NO.	BY	DESCRIPTION	DATE
1	LB	ISSUED FOR TENDER	MAR/21/2016
2	LB	ISSUED FOR PERMIT	DEC/28/2016
3	LB	PROGRESS FOR CONSTRUCTION	JUL/18/2017
4	LB	ISSUED FOR CONSTRUCTION	AUG/09/2017
5	LB	REVISED AS PER SITE INSTRUCTION P-5	SEP/11/2017
6	LB	REVISED AS PER SITE INSTRUCTION P-9	OCT/19/2017

This drawing is an instrument of service, is provided by and is the property of United Engineering Inc. The contractor must verify and accept responsibility for all dimensions and conditions on site and must notify United Engineering Inc. of any discrepancy before proceeding. United Engineering Inc. is not responsible for the accuracy of Architectural, structural, interior design, etc. on this drawing. Refer to the appropriate trade drawings before proceeding with any work. Installation must conform to all applicable codes and requirements of the authorities having jurisdiction. This drawing is not to be scaled, all symbols are graphic representations only.

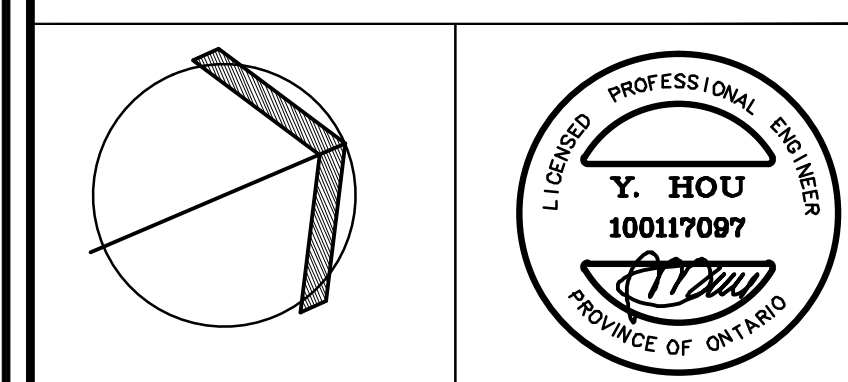

United Engineering Inc.
Mechanical Electrical Consulting Engineers
3045 Keele Street Suite 105
Toronto, Ontario, M3J 1M6
Tel: (416) 398 1999, Fax: (416) 398 1933

TITLE	
PARKING LEVEL PLAN MECHANICAL	
PROJECT	
25 BAKER HILL BLVD. ROYAL PINE HOMES	
STOUFFVILLE, ONTARIO	
PROPOSED RESIDENTIAL DEVELOPMENT	
DRAWN	CHECKED
GC	BT
DATE	PROJECT
JUNE 2015	14-016
SCALE	
1:100	
DRAWING	
M-4	
OF 42	