


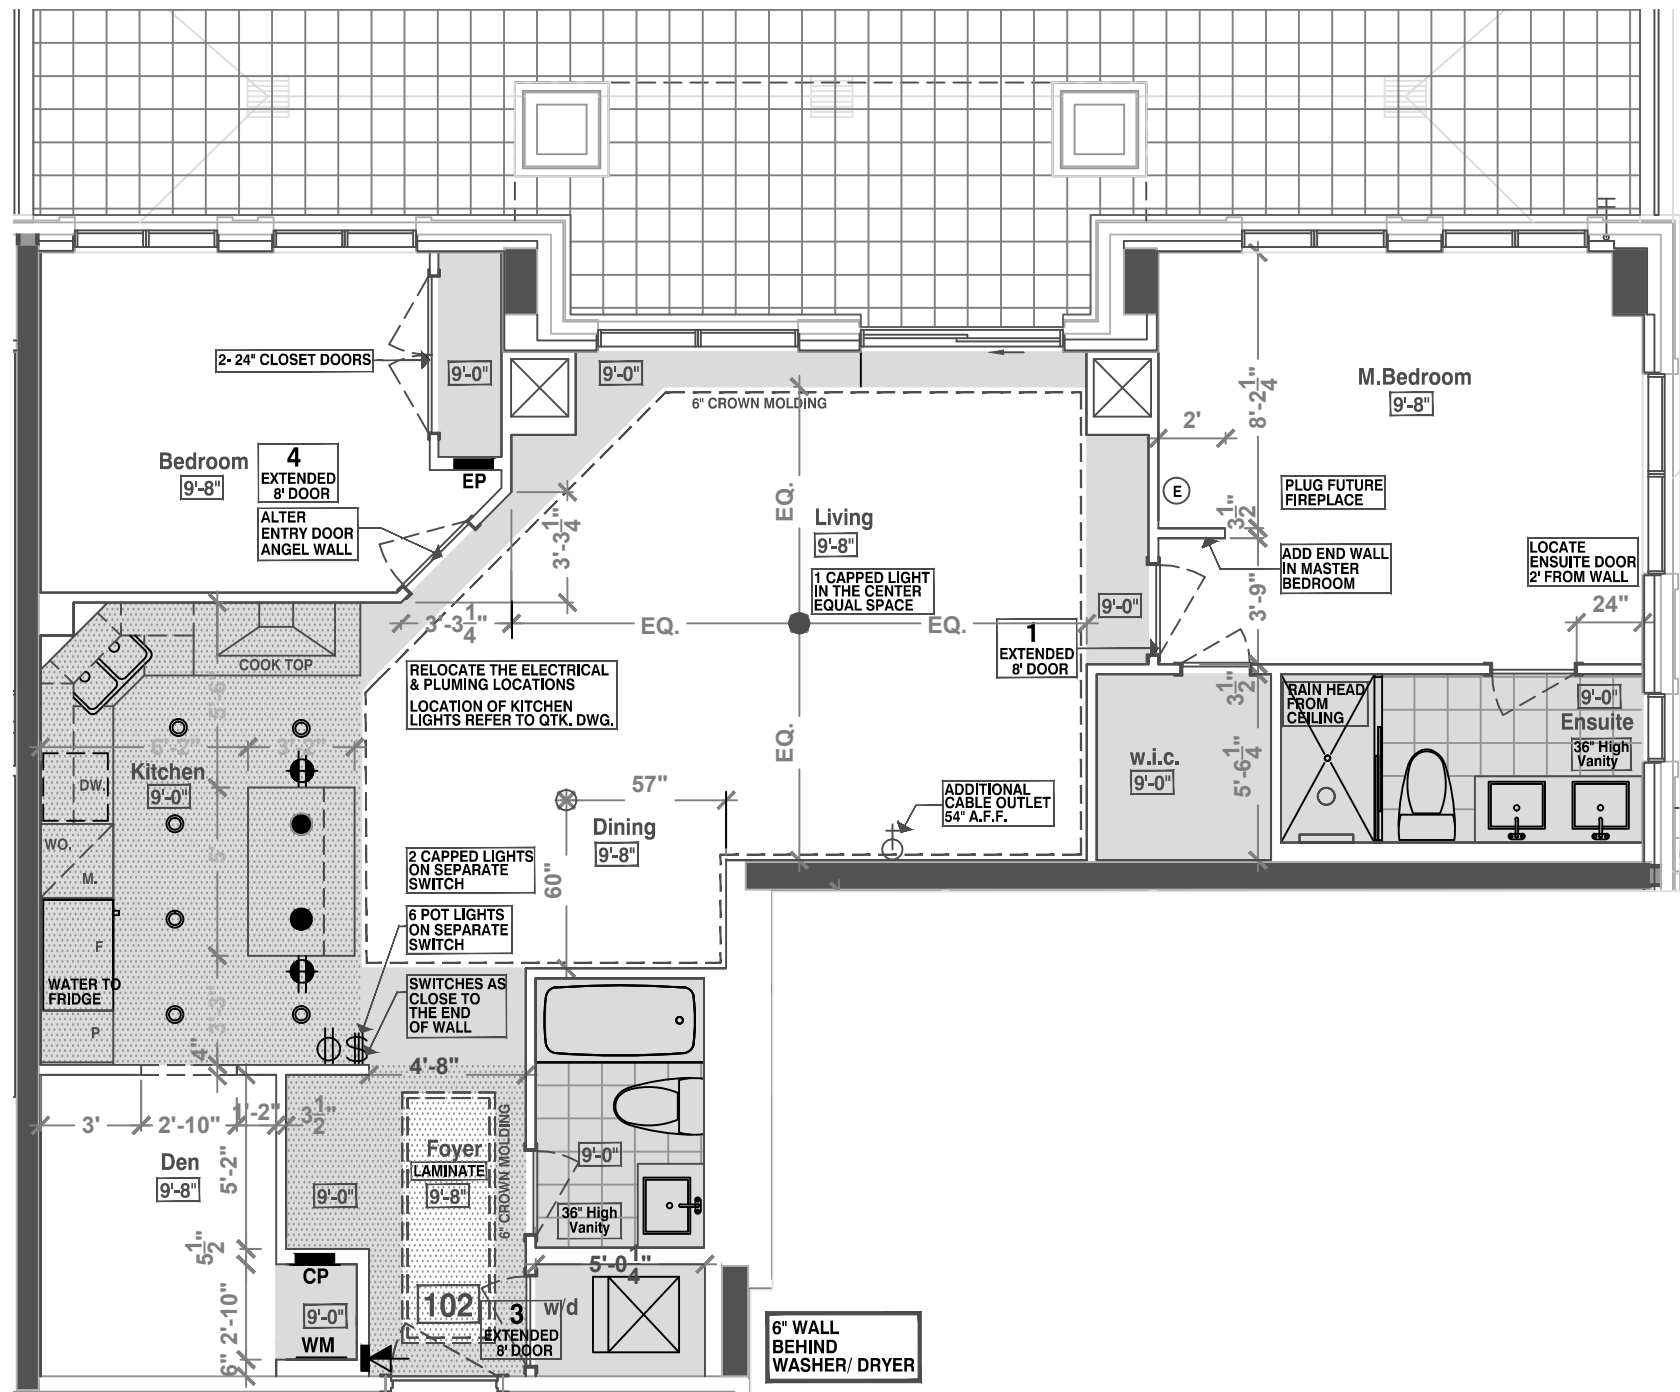

SUITE 102 - LAUREL (MOD.)

■ HAMPTON PLACE ■ 25 Baker Hill Blvd - Stouffville, ON ■ Jan 18, 2018

DRAWING AS PER AGREEMENT OF PURCHASE AND SALE (before decor appointment)