


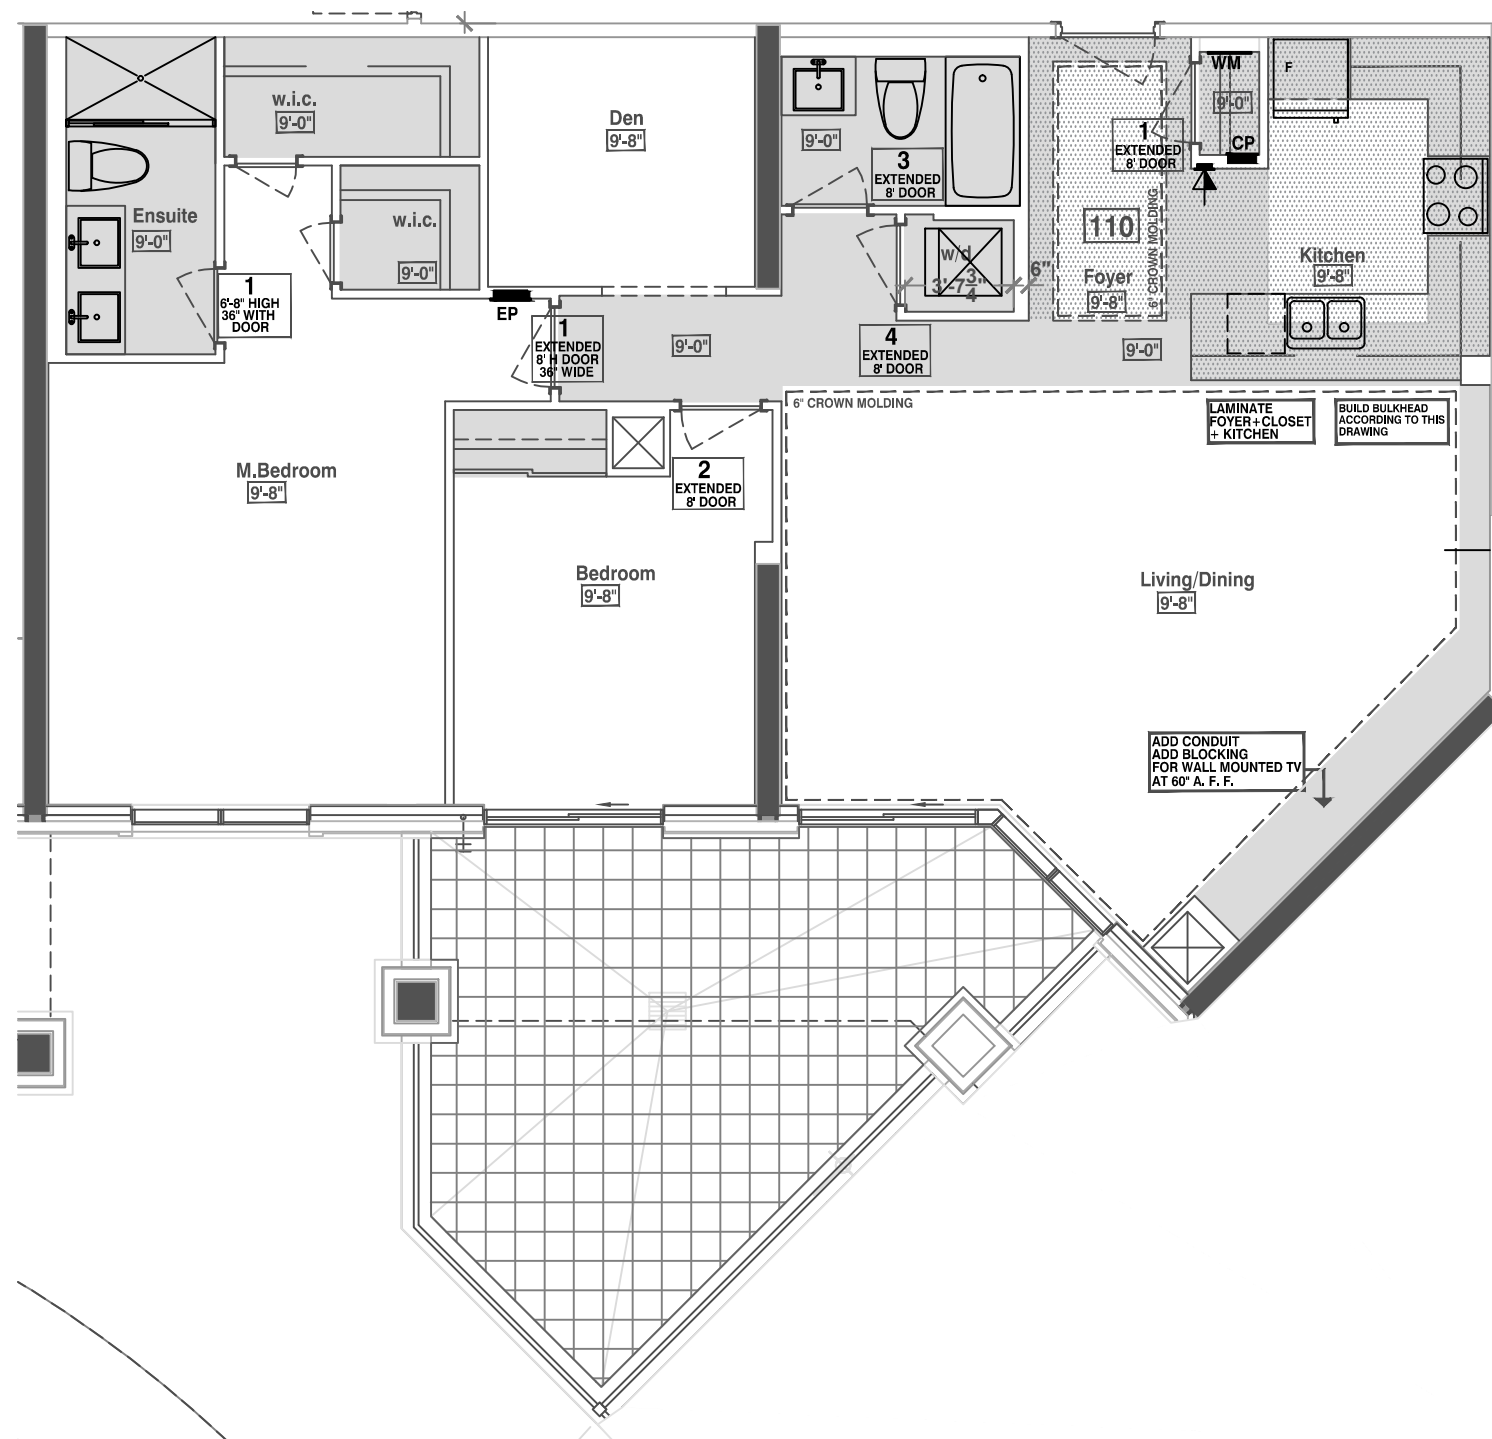

6" WALL
BEHIND W/D

ELIMINATE JOG
AT FRIDGE WALL

LEGEND:

-  SECURITY PANEL
-  ELECTRICAL PANEL
-  COMMUNICATION PANEL
-  WATER METER
-  FRIDGE
-  DROPPED AREA
-  6" CROWN MOLDING

1st Floor Plan - SUITE 110 - BROOKHAVEN - 2L + D - P

■ HAMPTON PLACE ■ 25 Baker Hill Blvd - Stouffville, ON ■ Jan 18, 2018

DRAWING AS PER AGREEMENT OF PURCHASE AND SALE (before decor appointment)