


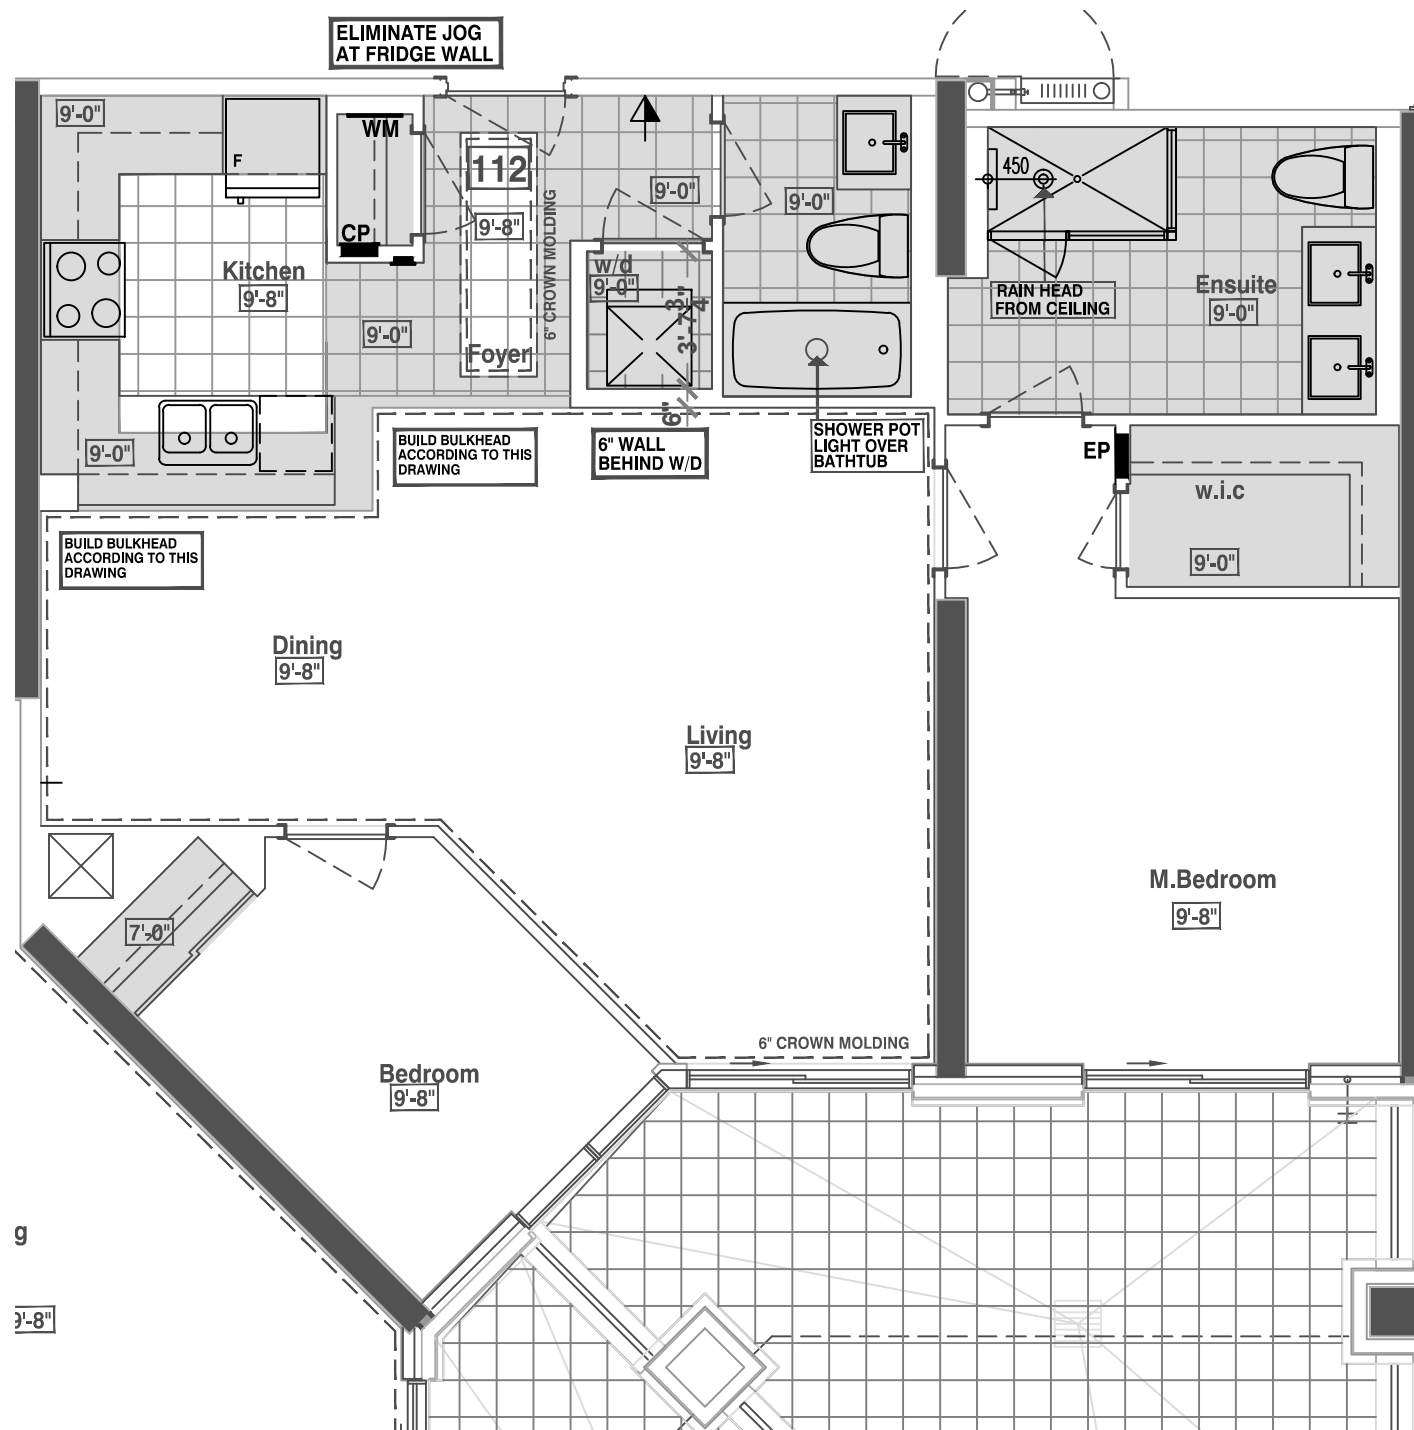

SUITE 112 – REMSENBURG – 2D – P

■ HAMPTON PLACE ■ 25 Baker Hill Blvd – Stouffville, ON ■ Jan 18, 2018

DRAWING AS PER AGREEMENT OF PURCHASE AND SALE (before decor appointment)