


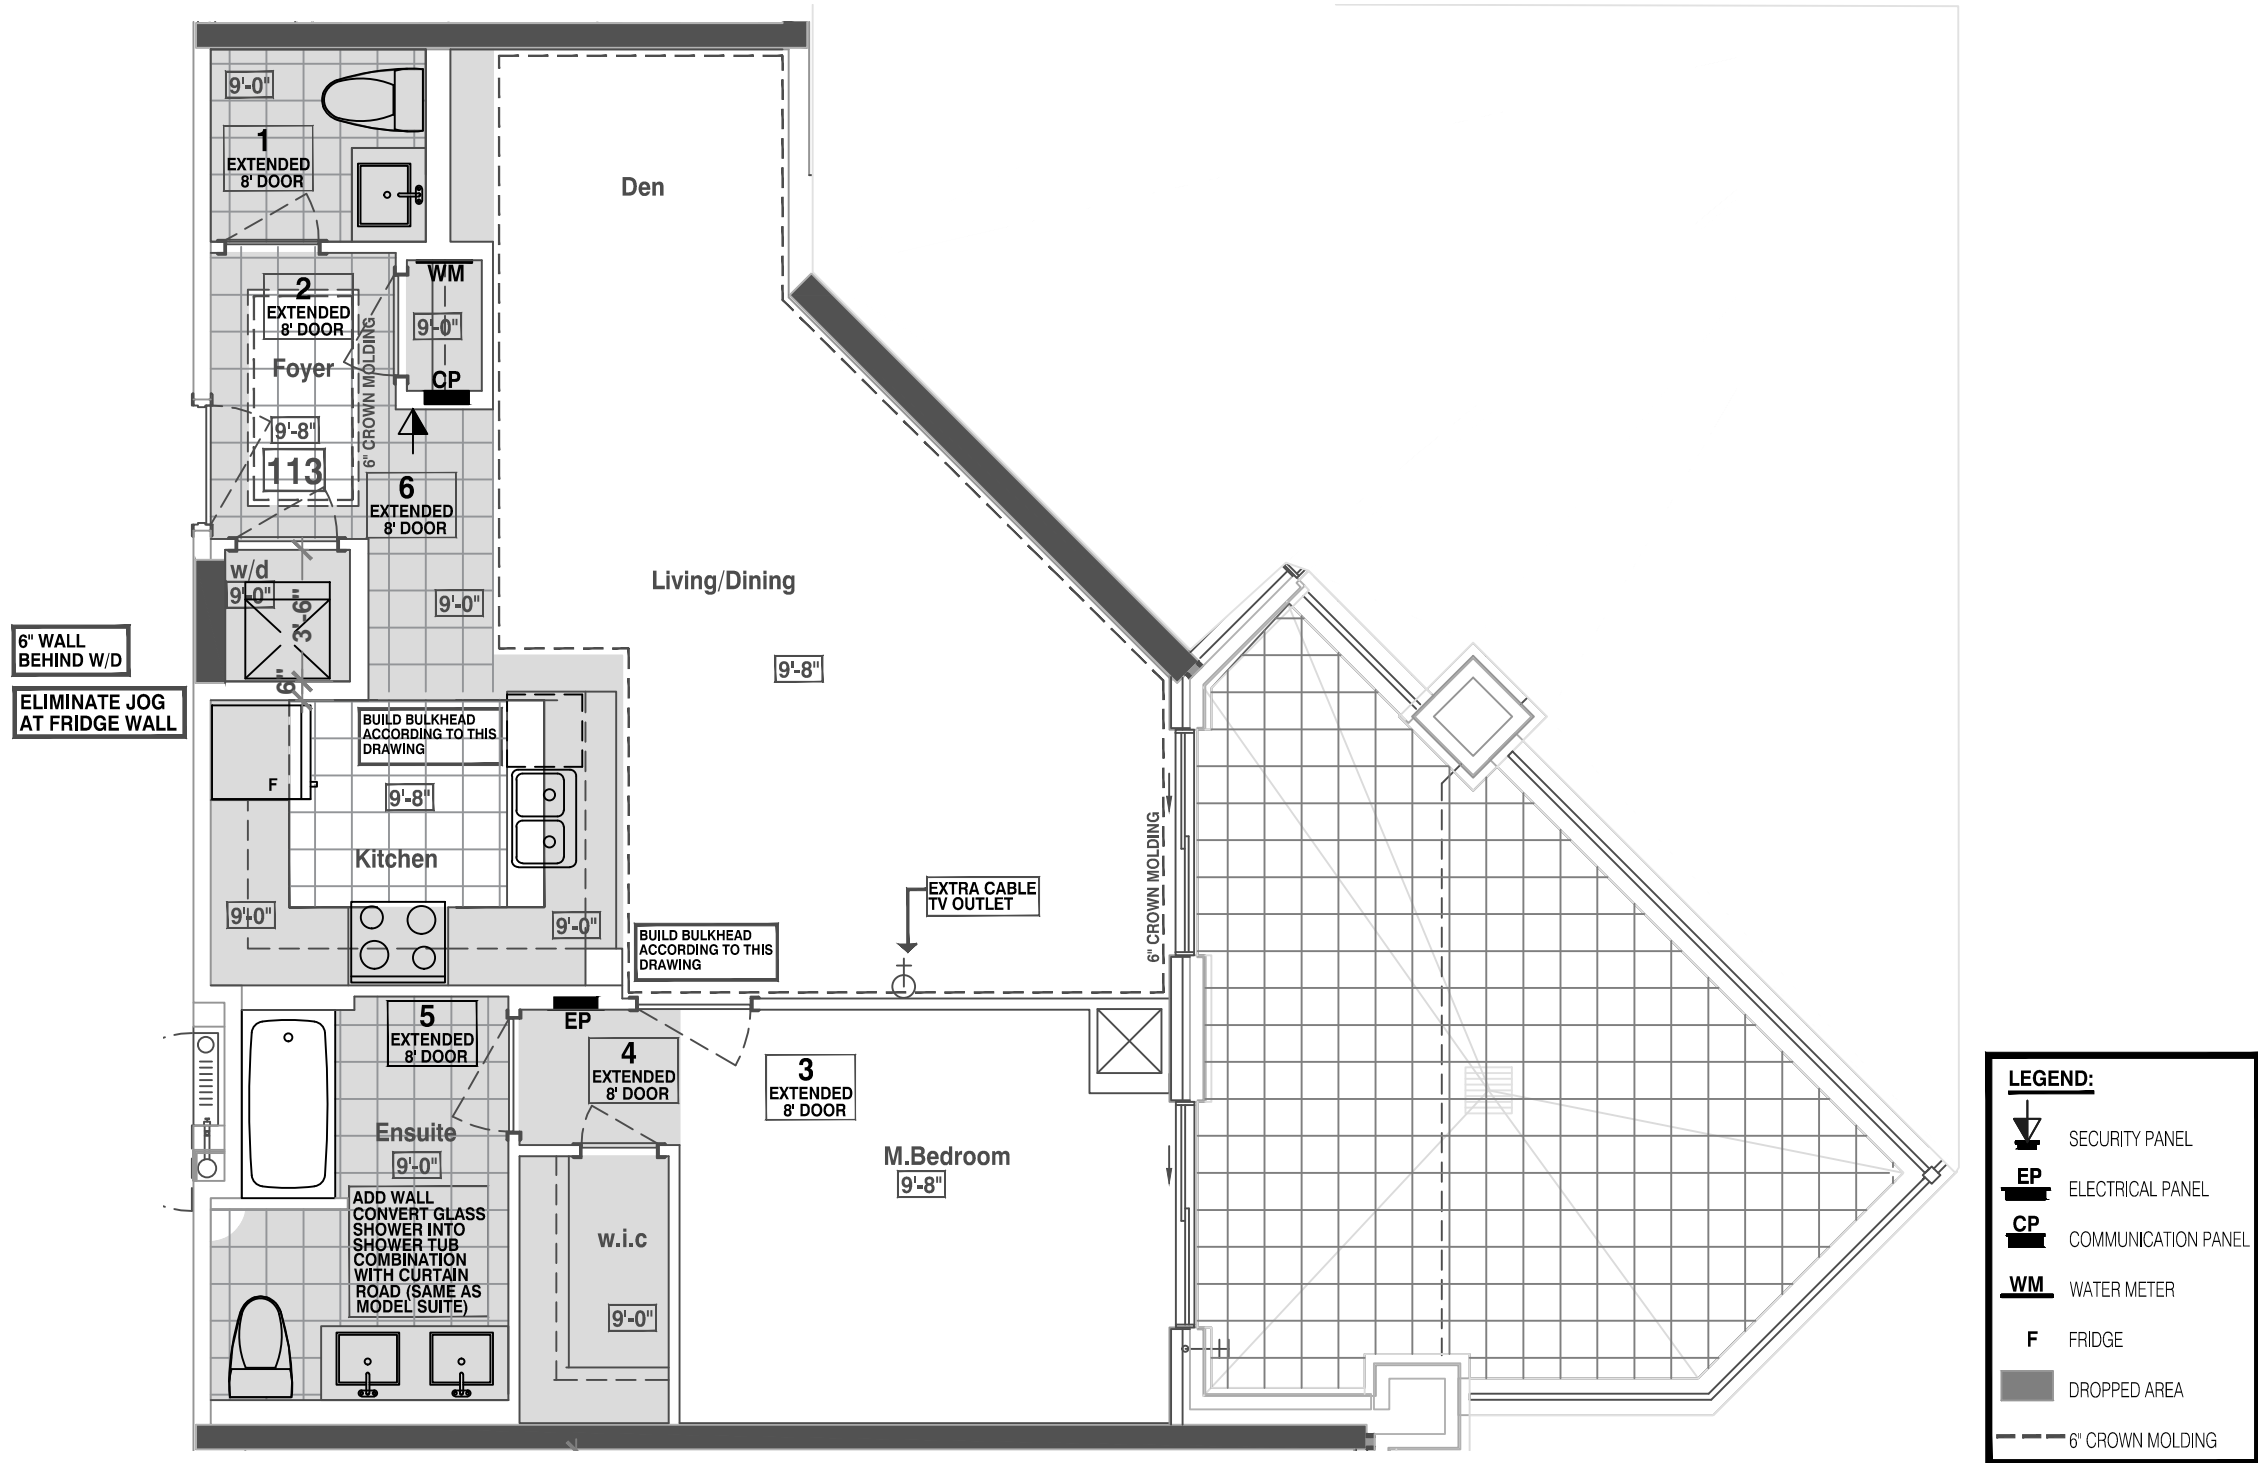

1st Floor Plan - SUITE 113 - SAG HARBOUR - 1C+D-P-R

■ HAMPTON PLACE ■ 25 Baker Hill Blvd - Stouffville, ON ■ Jan 18, 2018

DRAWING AS PER AGREEMENT OF PURCHASE AND SALE (before decor appointment)