



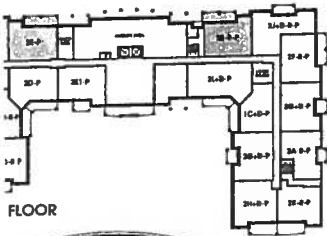


Flanders

SUITE ORIGINAL
#101


1,059 SQ FT *plus 180 sq. ft. of balcony area*

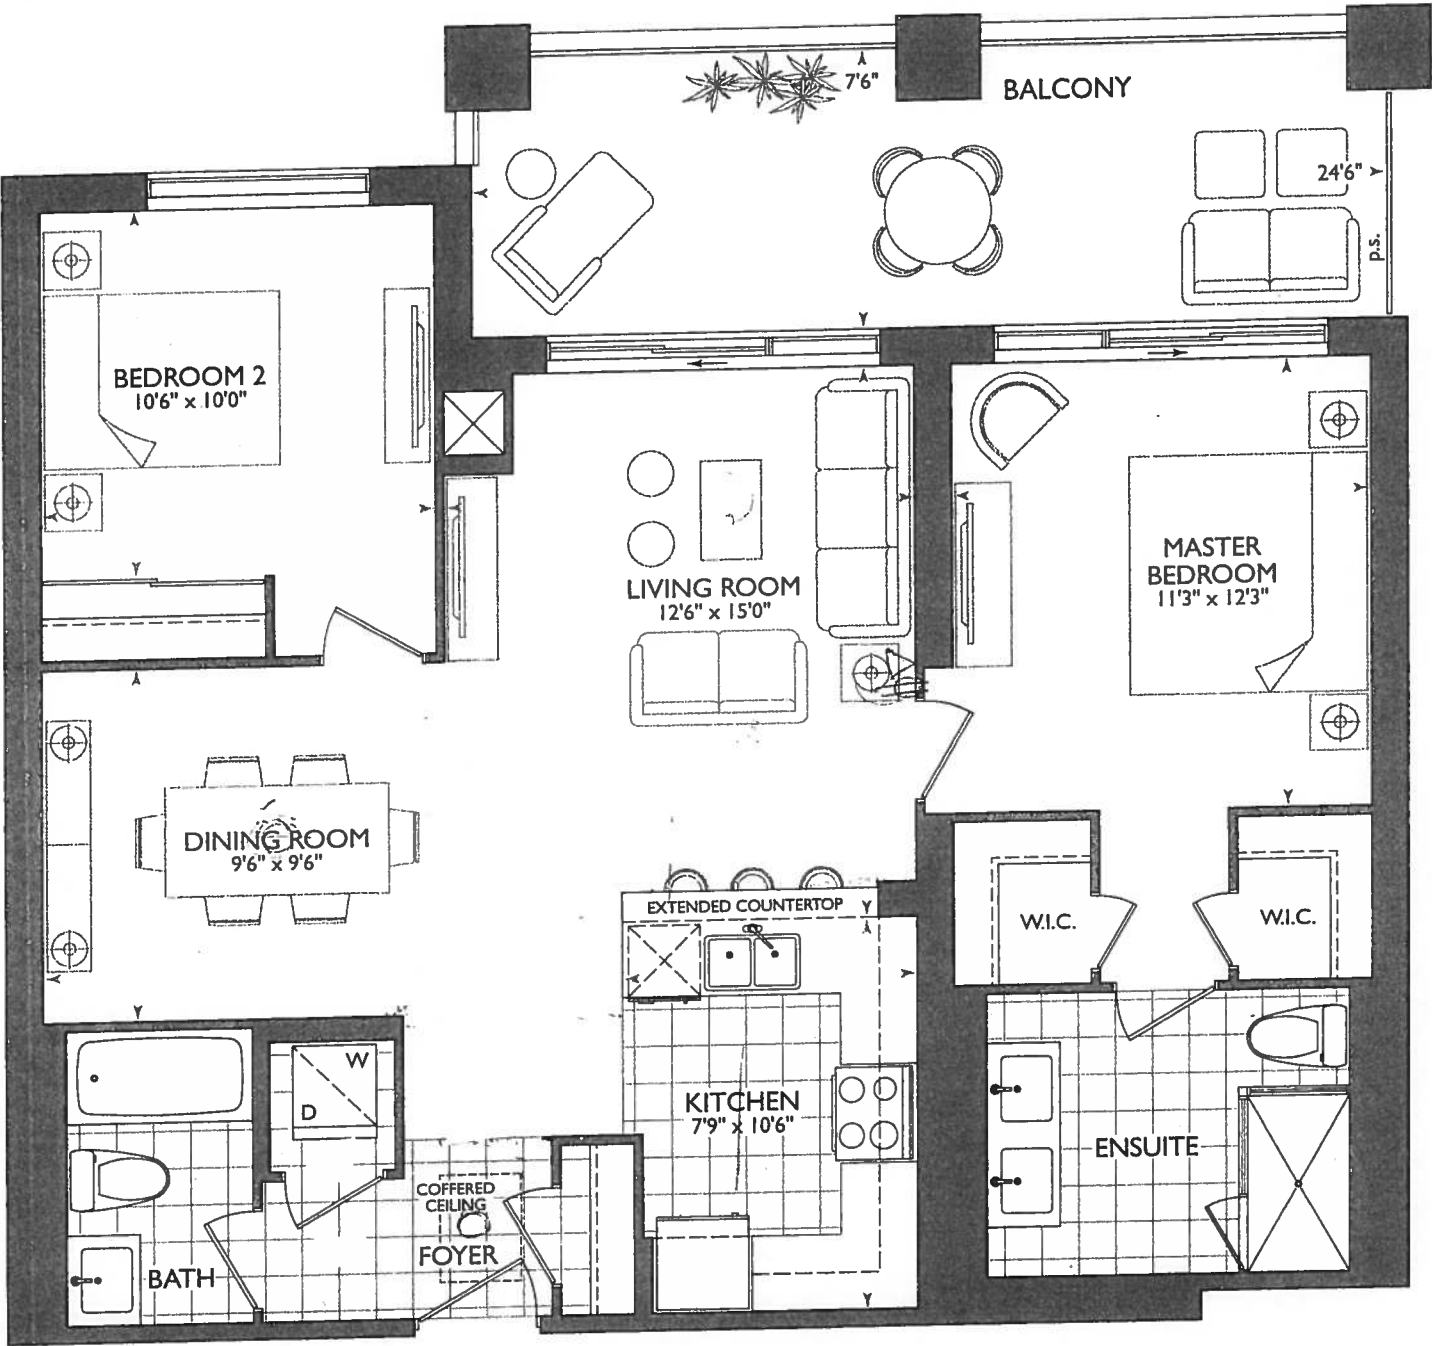


FLOOR

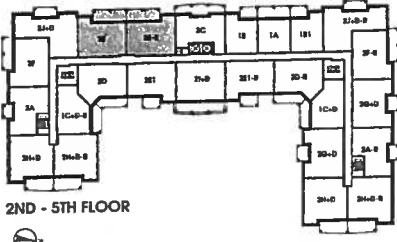

2ND - 5TH FLOOR

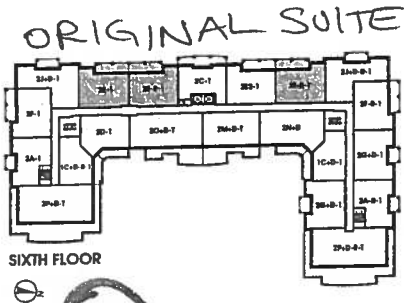

SIXTH FLOOR

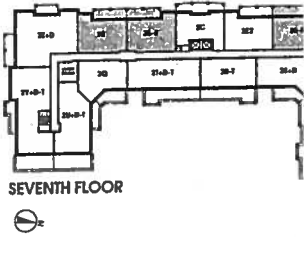

SEVENTH FLOOR




LEGEND:

	SECURITY PANEL
	ELECTRICAL PANEL
	COMMUNICATION PANEL
	WATER METER
	FRIDGE
	DROPPED AREA
	6" CROWN MOLDING

* Revised ENS +
N. Bedroom + W.I.C
Due to
4" Dummy wall
for ensuite
shower
faucet

* Revised
coffered
ceiling.
AS PER
THIS PLAN

4" x 40"
4" Dummy wall
for shower
faucet

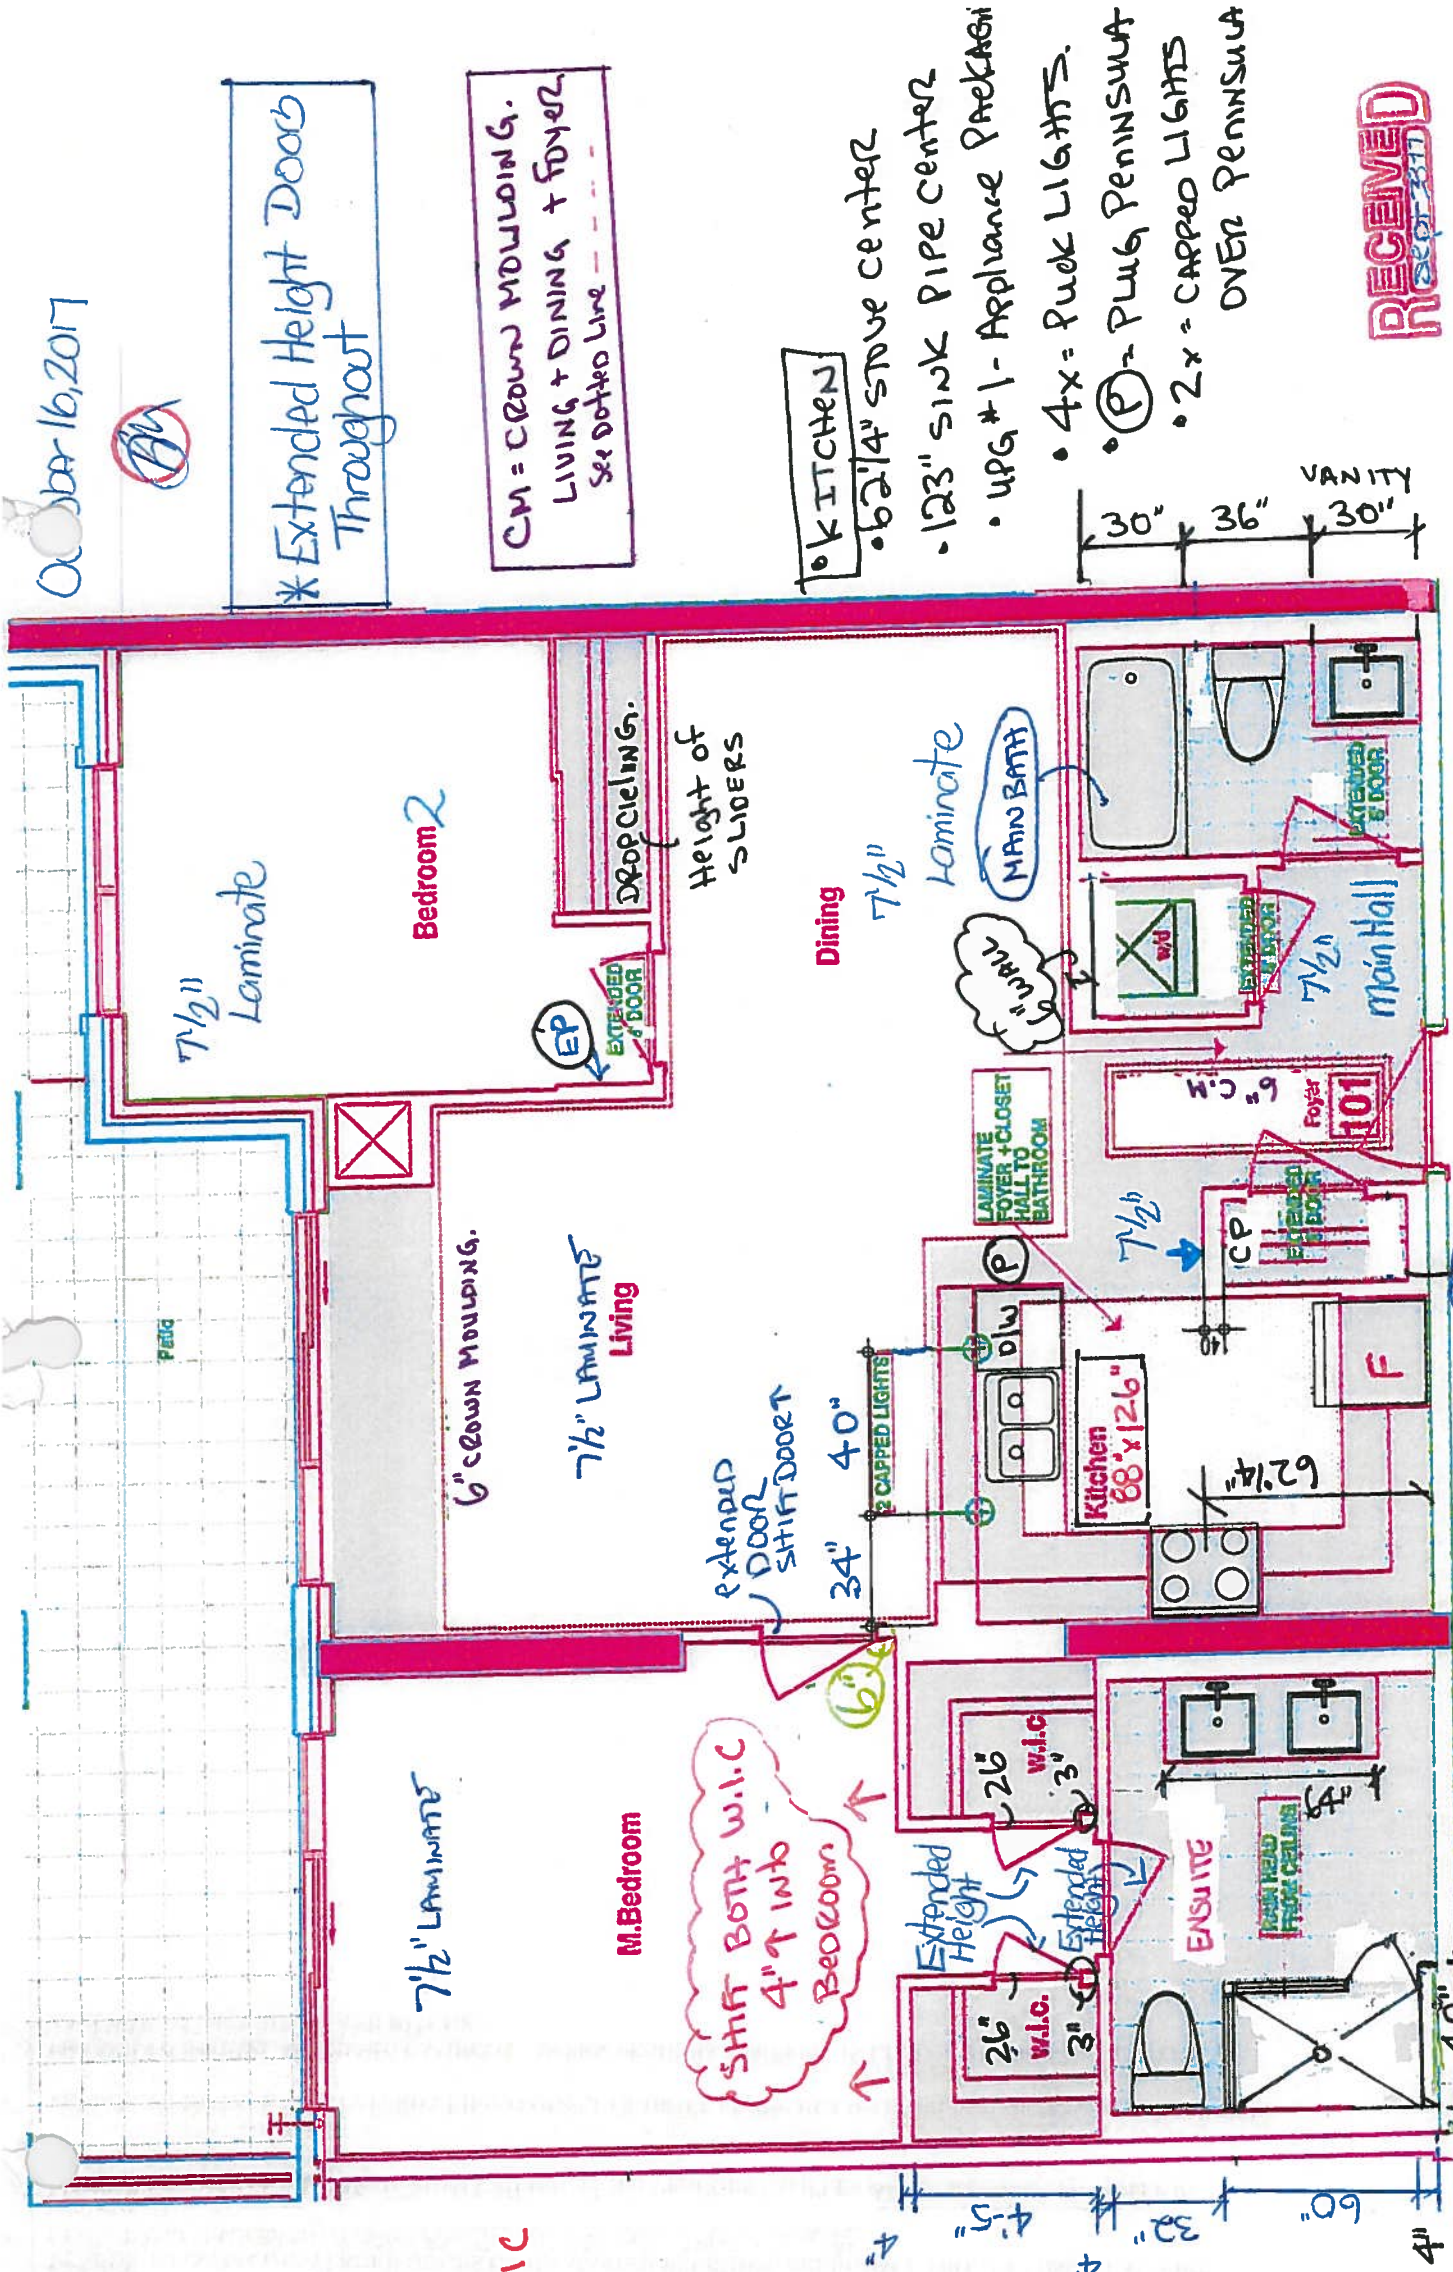

SUITE 101 - FLANDERS - 2E-P-R

25 Baker Hill Blvd - Stouffville, ON - Sep 28, 2017

RECEIVED
SEP 28 2017



SITE COPY

CONSTRUCTION SUMMARY

Hampton Place

PURCHASER: WILLIAM A. MCGROGAN TEL: RES.: 416-409-7388

LOT NUMBER	PHASE	HOUSE TYPE	CLOSING DATE
101	1	FLANDERS(2E)*	11-Sep-18

Offer	ADDITIONAL - SINGLE PARKING UNIT
Workshee	Note:

Workshee	PURCHASER TO RECEIVE \$10,000(INCLUDES APPLICABLE TAXES) WORTH OF UPGRADES AT THE DECOR CENTER AT TIME OF COLOUR CHART.
	Note:

DESCRIPTION
✓ VENDOR TO INSTALL EXTENDED DOORS ON ON MASTER BEDROOM, BEDROOM 2, FRONT CLOSET, LAUNDRY CLOSET AND MAIN BATH, <i>Master Ensuite W.I.C's and Master Ensuite</i>
✓ VENDOR TO INSTALL RAINHEAD FROM CEILING, FROM VENDORS SAMPLES (MOEN 116651/AT2199/S176EP IN MASTER ENSUITE - DELTA -
✓ VENDOR TO INSTALL TWO CAPPED CEILING OUTLETS ABOVE PENINSULA ON EACH END OF SINK AS PER SKETCH.
✓ VENDOR TO INSTALL STANDARD LAMINATE, AS PER VENDORS SAMPLES, IN LIEU OF TILES IN MAIN FOYER, HALLWAY TO BATHROOM, AND KITCHEN

* note: Revised Foyer Coffered ceiling. ~~to~~
AS PER THIS PLAN.

TILES TO REMAIN AS PER ORIGINAL
SUITE LAYOUT

- ENSUITE ENLARGE 4"
ADDED 4"x40" WET WALL FOR SHOWER FAUCET
(NOTE- NEW DIMENTIONS ARE ON NEW BROCHURE
FOR W.I.C. & MASTER BEDROOM)



SITE COPY

CONSTRUCTION SUMMARY
Hampton Place

PURCHASER: WILLIAM A. MCGROGAN

TEL: RES.: 416-409-7388

LOT NUMBER	PHASE	HOUSE TYPE	CLOSING DATE	
101	1	FLANDERS(2E)*	11-Sep-18	

Date Added: 10-Nov-17 Invoice Number: 7011

1 - KITCHEN - Install water line rough in
As per Fonzie

1 - PURCHASER AWARE AND ACCEPTS THAT ANY CHANGES MADE TO UPGRADES AFTER SIGNING THIS PURCHASERS EXTRA FORM ARE SUBJECT TO A MINIMUM ADMINISTRATION FEE OF \$1000 PLUS A 10% HOLDBACK FEE.
Note:

Date Added: 25-Oct-17 Invoice Number: 6988

1 - DISCLAIMER - DELCINED WATER LINE;
KITCHEN - Purchaser has DECLINED Upgrade of Water Line at the decor centre. Purchaser will accommodate OWN Water Line to fridge AFTER CLOSING.
Note: Purchaser accepts & acknowledges that no accommodation will be provided.
Vendor is Exempt.

1 - CLARIFICATION;
MASTER ENSUITE - Purchaser accepts & acknowledges the standard frameless glass shower at master ensuite shower stall will NOT touch the ceiling and will receive a Standard Chrome Header. (See Sketch)
Note:

1 - PURCHASER AWARE AND ACCEPTS THAT ANY CHANGES MADE TO UPGRADES AFTER SIGNING THIS PURCHASERS EXTRA FORM ARE SUBJECT TO A MINIMUM ADMINISTRATION FEE OF \$1,000 PLUS A 10% HOLDBACK FEE.
Note:

Date Added: 16-Oct-17 Invoice Number: 6971

3 - INTERIOR DOORS - Install EXTENDED HEIGHT Interior Doors at Master Bedroom Walk-In Closets and Master Ensuite (x3 Doors) (See Sketch)
Note: In Addition to Upgraded Extended Height Interior Doors Included in APAS

1 - KITCHEN & BATHROOMS - Purchaser has DECLINED All Upgrades offered during decor centre appointment at the decor centre for kitchen & bathroom cabinetry. Standard Kitchen Layout & Standard Bathroom Vanities to be installed as per standard plan. (See Sketch)
Note:

1 - KITCHEN - Install Builders Standard GRANITE Countertop - BIANCO ANTICO - Throughout kitchen where applicable. (does not include granite backsplash) (See Sketch)
Note:

1 - KITCHEN - Install UPGRADE " M " EDGING - Throughout kitchen countertop, where applicable. (See Sketch)
Note:

1 - DISCLAIMER - GRANITE COUTNERTOP;
KITCHEN - Due to the many variables that can affect the pattern, colour and/or design and "pitting" of natural products, granite installed will not be identical to the samples displayed.
Note: Every effort is made to provide granite countertops as close as possible but the vendor is not responsible for results which differ from the sample displayed. All countertop surfaces may have seams, and product pattern and shade can change in areas containing seams.

1 - KITCHEN - Kitchen Backsplash - Install 1ST UPGRADE - 12x12 Misat Random Strip Glass Mosaics - Throughout kitchen, where applicable. (does not include behind the fridge or stove) (See Sketch)
Note:

1 - KITCHEN - Kitchen Hardware - Upgrade MIX & MATCH STANDARD Hardware - Throughout kitchen cabinetry, where applicable. (See Sketch)
Handle - 16338-105 - Installed at Drawers
Knob - B603-SC - Installed at Cabinetry Doors
Note:

1 - APPLIANCE PACKAGE - Install Upgrade Appliance Package - UPGRADE PACKAGE # 1 - To be installed throughout suite, where applicable. (See Sketch)
Note:

SITE COPY

CONSTRUCTION SUMMARY

Hampton Place

PURCHASER: WILLIAM A. MCGROGAN

TEL: RES.: 416-409-7388

LOT NUMBER 101	PHASE 1	HOUSE TYPE FLANDERS(2E)*	CLOSING DATE 11-Sep-18	
--------------------------	-------------------	------------------------------------	----------------------------------	--

Date Added: 16-Oct-17

Invoice Number: 6971

1 - KITCHEN - Kitchen Sink - Install Builders Standard Undermount Sink - BLANCO Horizon Plus U2 Undermount Sink (8") - Model # 401234 (See

1 - KITCHEN - Kitchen Facuet - Install Upgrade Faucet - DELTA - Cassidy Pull-Down Kitchen Faucet (Single Hole) - Model # 9997-DST - Chrome
(See Sketch)1050

Note:

1 - MAIN BATH & MASTER ENSUITE - Install Builders Standard GRANITE Countertop - BIANCO ANTICO - Throughout Main Bath & Master Ensuite Vanities, where applicable. (Includes 3" Splash) (See Sketch)

Note:

1 - CLARIFICATION:
MAIN BATH & MASTER ENSUITE - Install Standard 3" Splash above all bathroom countertop vanities, where applicable. To include; Main Bath & Master Ensuite (See Sketch)

Note:

1 - DISCLAIMER - GRANITE COUNTERTOP;

1- DISCLAIMER - GRANITE COUNTERTOP, MAIN BATH & MASTER ENSUITE - Due to the many variables that can affect the pattern, colour and/or design and "pitting" of natural products, granite installed will not be identical to the samples displayed.

Note: Every effort is made to provide granite countertops as close as possible but the vendor is not responsible for results which differ from the sample displayed. All countertop surfaces may have seams, and product pattern and shade can change in areas containing seams.

1 - CLARIFICATION;

MAIN BATH & MASTER ENSUITE - Install Builders Standard Bathroom Plumbing Fixtures throughout all bathrooms where applicable. To Include; Bath and Master Ensuite (See Sketch)

1 - CLARIFICATION - MASTER ENSUITE REFER TO APAS;

**1- CLARIFICATION - MASTER ENSUITE REFER TO A/F AS,
MASTER ENSUITE - Install Rain Shower Head from Ceiling at Master Ensuite Shower Stall - Install DELTA Shower Trim & Hansgrohe SlideBar
with Handheld & Ceiling Mount ShowerHead -**

Note: Model # R11000 / T13020-CDN/27454002 / 27744000 / RP52382 / RP46870 / RP6025 / R11000 / T11800 - Chrome
(See Attached Sketch)

1 - BONUS PACKAGE - PURCHASER HAS APPLIED \$10,000.00 (Includes Taxes) WORTH OF UPGRADE PROMOTIONAL PACKAGE TOWARDS THE PURCHASE OF UPGRADES COMPLETED AT THE DECOR CENTRE.

Note:

1 - PURCHASER HAS ATTENDED A COLOR APPOINTMENT AT THE DECOR CENTRE AND HAS DECLINED ANY ADDITIONAL UPGRADES. Purchaser accepts and acknowledges that there will be no further changes/additions/deletions to be made upon signing on October 16, 2017

Note:

1 - PURCHASER AWARE AND ACCEPTS THAT ANY CHANGES MADE TO UPGRADES AFTER SIGNING THIS PURCHASERS EXTRA FORM ARE SUBJECT TO A MINIMUM ADMINISTRATION FEE OF \$1,000 PLUS A 10% HOLDBACK FEE.

Note:

This Document is Extremely Time Sensitive - Printed 22 Jan 18 at 14:29



Purchasers

Closing Date	Unit
11/09/2018	101

Hampton Place

Printed Oct 16, 2017 11:38 am



* INTERIOR COLOR SCHEME *

Purchasers	Decor Consultant	Model Type	Telephone Res. / Bus	Project	Closing Date	Unit
WILLIAM A. MCGROGAN	Melissa Di Marino	FLANDERS(2E)	(416) 409-7388 /	Hampton Place	11/09/2018	101

Page 2 of 3

CABINETS, VANITIES AND COUNTERTOPS

	Style	Countertop	Counter Edge	Handle / Knob	APPLIANCE PACKAGE
MAIN BATHROOM	☒ CATEGORY 1 - LP LAMINATE- CHILL QT 1022 (STD)	☒ BIANCO ANTICO GRANITE (STD)	☒ "A" EDGE (STD)	B603-SC	Upgrade Package #1
MASTER ENSUITE	☒ CATEGORY 1 - LP LAMINATE- CHILL QT 1022 (STD)	☒ BIANCO ANTICO GRANITE (STD)	☒ "A" EDGE (STD)	B603-SC	
POWDER ROOM	☒ CATEGORY 1 - LP LAMINATE- CHILL QT 1022 (STD)	N/A	N/A	N/A	
KITCHEN / DINETTE	☒ CATEGORY 1 - MDF - WHITE QT 1203 (STD)	☒ BIANCO ANTICO GRANITE (STD)	☒ "M" EDGE (UPG)	See Notes	
LAUNDRY ROOM	☒ CATEGORY 1 - MDF - WHITE QT 1203 (STD)	N/A	N/A	N/A	Std 31in Opening

PLUMBING FIXTURES

KITCHEN	
Sink Model	☒ STANDARD
Sink Faucet	☒ UPG - Delta Cassidy # 9997-DST

TOILETS

Master Ensuite	STANDARD
Main Bathroom	STANDARD
Powder Room	N/A

VANITY FAUCETS

Master Ensuite	STANDARD
Main Bathroom	STANDARD
Powder Room	N/A

VANITY SINKS

Master Ensuite	STANDARD
Main Bathroom	STANDARD
Powder Room	N/A

SHOWER STALL / TUBS

Master Ensuite Shower Stall	STANDARD
Master Ensuite Tub	N/A
Main Bathroom Tub	STANDARD

Trim	
Baseboard & Casing	STANDARD
Interior Doors	STANDARD - CARRARA, SMOOTH
Levers	STANDARD
Door Height	Extended Height (UPG)

Cornice Moulding / Medallion

Foyer	☒ STANDARD - # CTR-611
Living Room	☒ STANDARD - # CTR-611
Dining Room	☒ STANDARD - # CTR-611
Den	N/A
Master Bedroom	NONE
Bedroom 2	NONE
Bedroom 3	N/A

Fireplace

Fireplace	N/A
Location Flooring	N/A
Style	N/A
Finish	N/A
Marble	N/A
Hearth	N/A

MISC. INSTALLATIONS

Ceramic Accessories (installed by Vendor)	☒ Yes ☐ No
Bathroom Mirrors (installed by Vendor)	☒ Yes ☐ No
Wire Shelving - Closet (installed by Vendor)	☒ Yes ☐ No

Paint Throughout

Walls	STANDARD - OYSTER WHITE
Trim	STANDARD - WHITE

Page 2 of 3

Decor Consultant:  Purchaser: 

Melissa Di Marino

WILLIAM A. MCGROGAN

Vendor: 

Hampton Place

Lot: 101 Project: Hampton Place Model: FLANDERS(2E)


Printed Oct 16, 2017 11:38 am

Suite 101 Hampton



(P) - Plug Peninsula
(2x) - Pendant lights
over Peninsula
(4x) - Puck lights.

O = Pendant (x2)
LIGHTS

Oct. 16, 2017

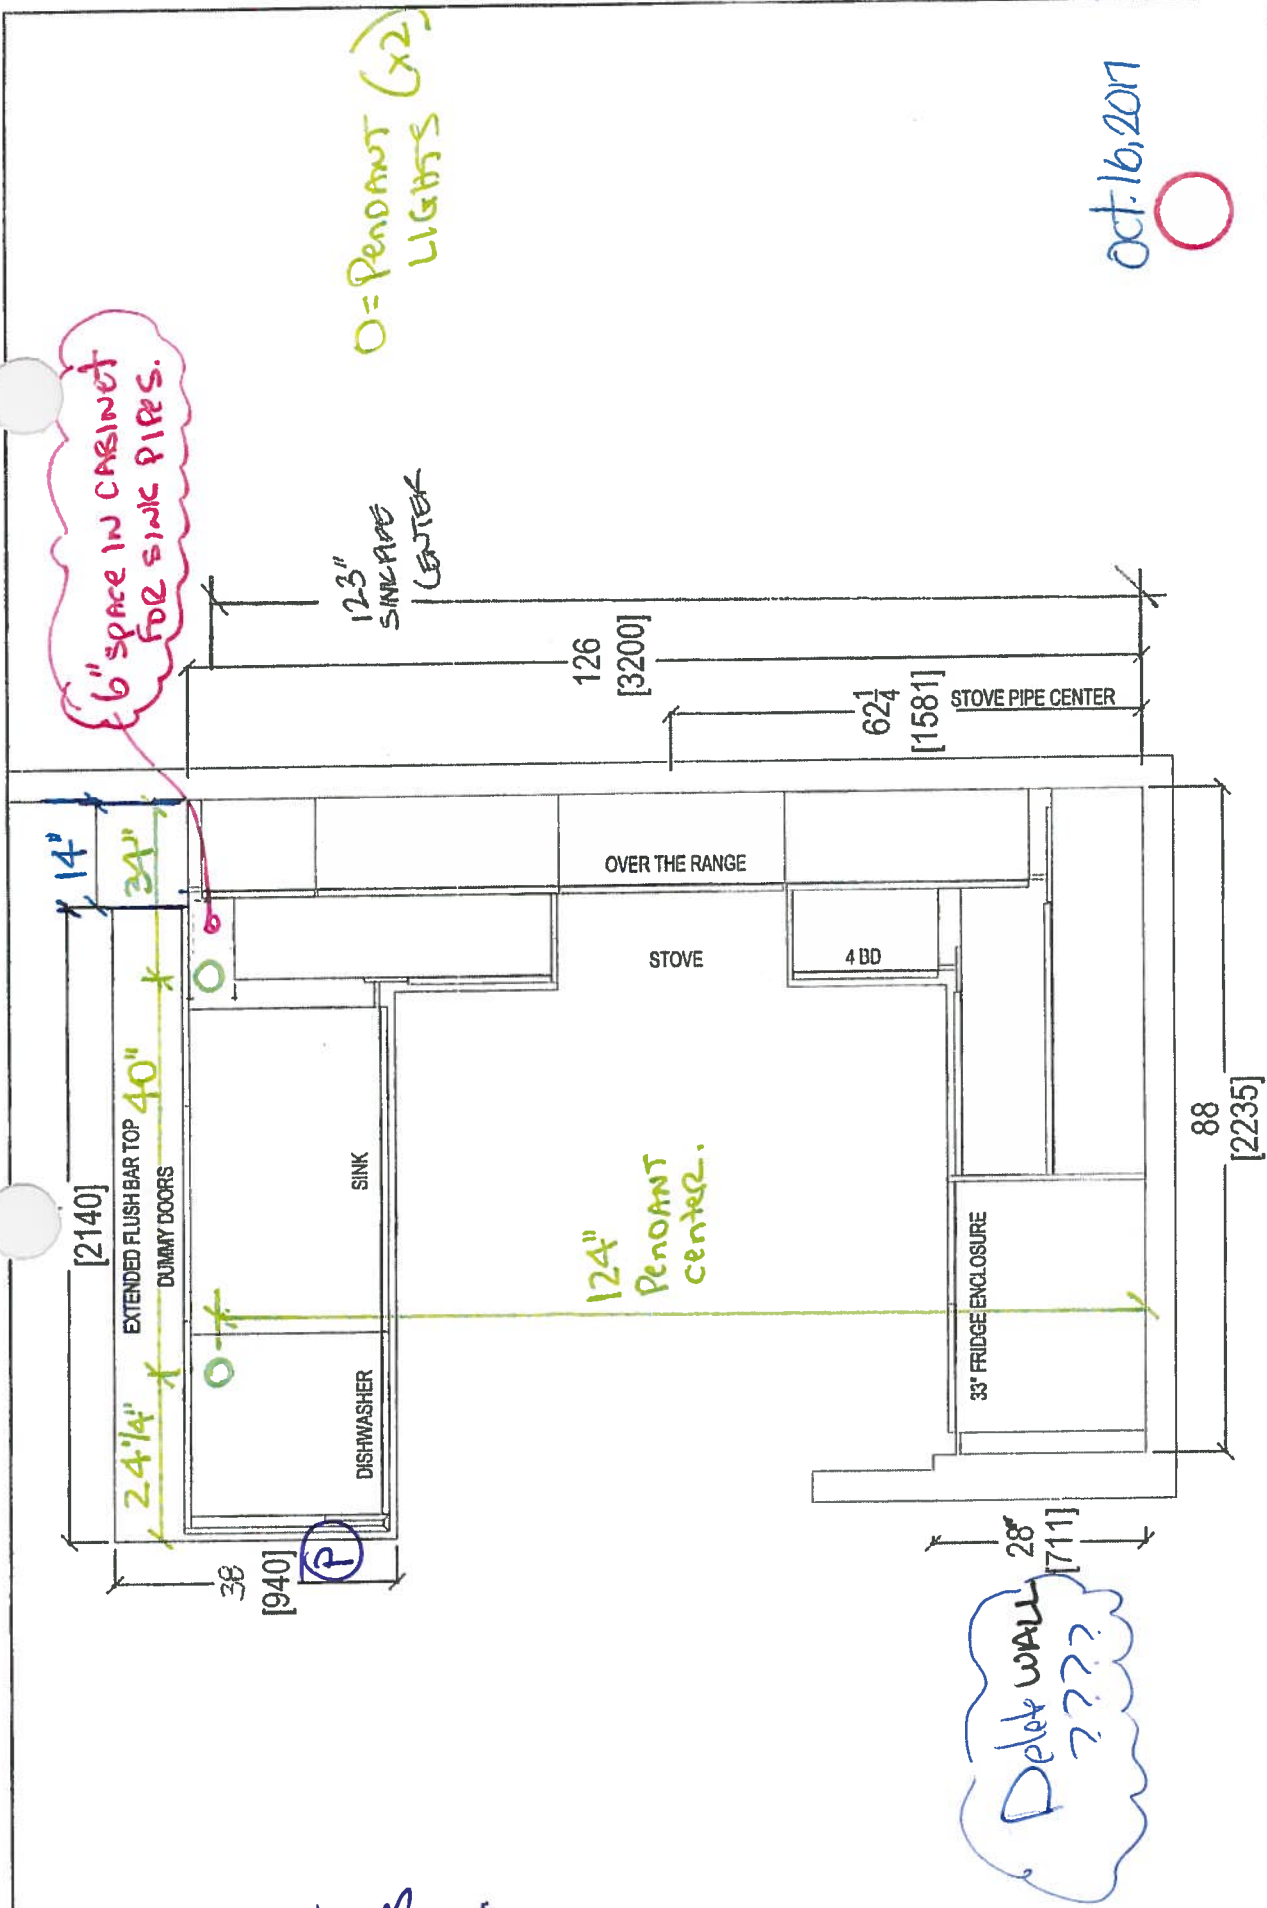


 OTK your kitchen, your way 80 SANTE DRIVE, VAUGHAN, ON L4K 3C4 T: 416.748.1811 F: 905.761.5901	CLIENT: ROYAL PINE HOMES	JOB NAME: UNIT 101 HMP	ROOM: KITCHEN FLOOR PLAN	DRAWN BY: SK	COMMENTS:	
	SITE: HAMPTON PLACE	DOOR STYLE: —	DOOR HANDLE: —	SCALE: 1/2" = 1' - 0"	PLEASE NOTE ALL DIMENSIONS ARE NOT FINAL AND ARE SUBJECT TO CHANGE UPON FINAL SITE MEASURE	
	PHONE: —	FINISH: —	DRW HANDLE: —	DATE: OCT 16, 2017		
	EMAIL: —	SPECIES: —	TOP: —	PAGE: —		

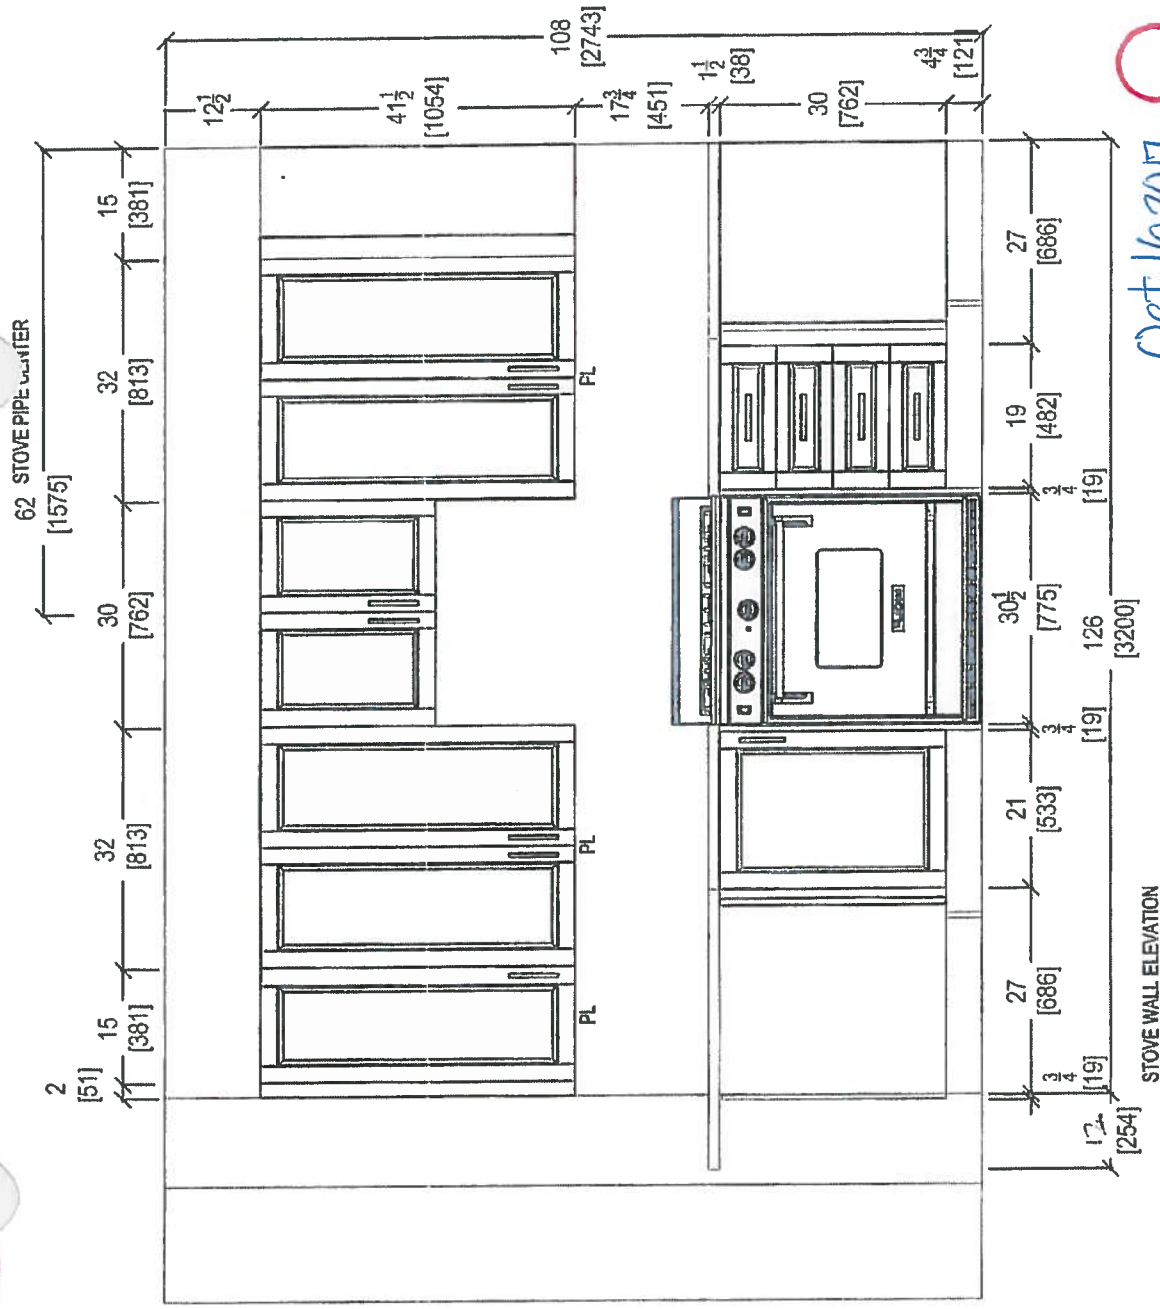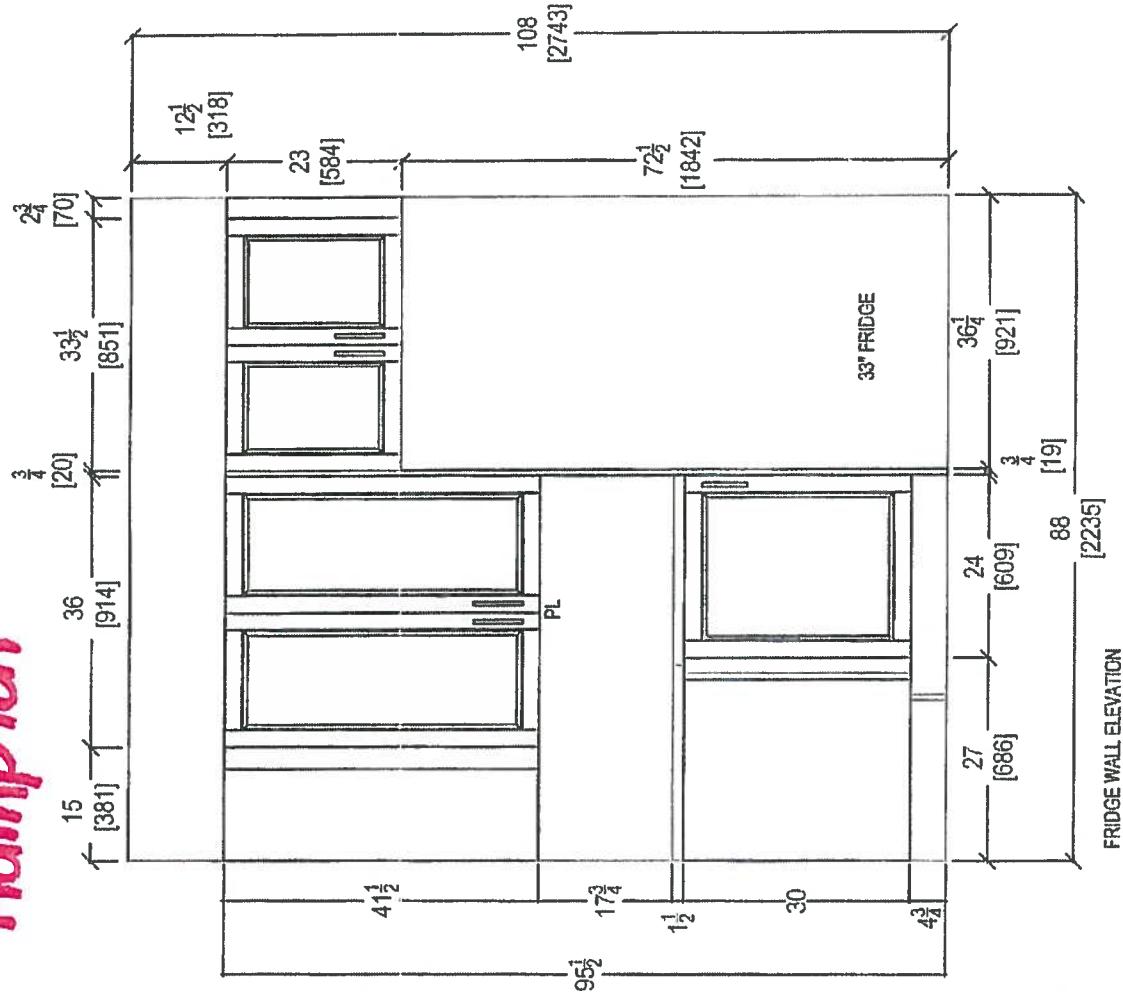

Oct 16, 2017

 Your kitchen. FOR US 80 SANTE DRIVE, VAUGHAN, ON L4K 3C4, T: 416.746.1811 F: 905.761.5901	CLIENT: ROYAL PINE HOMES	JOB NAME: UNIT 101 HMP	ROOM: KITCHEN FLOOR PLAN	DRAWN BY: SK	COMMENTS: PLEASE NOTE ALL DIMENSIONS ARE NOT FINAL AND ARE SUBJECT TO CHANGE UPON FINAL SITE MEASURE	
	SITE: HAMPTON PLACE	DOOR STYLE: —	DOOR HANDLE: —	SCALE: 1/2" = 1' - 0"		
	PHONE: —	FINISH: —	DRW HANDLE: —	DATE: OCT 16, 2017		
	EMAIL: —	SPECIES: —	TOP: —	PAGE: —		

Suite 101
Hampton

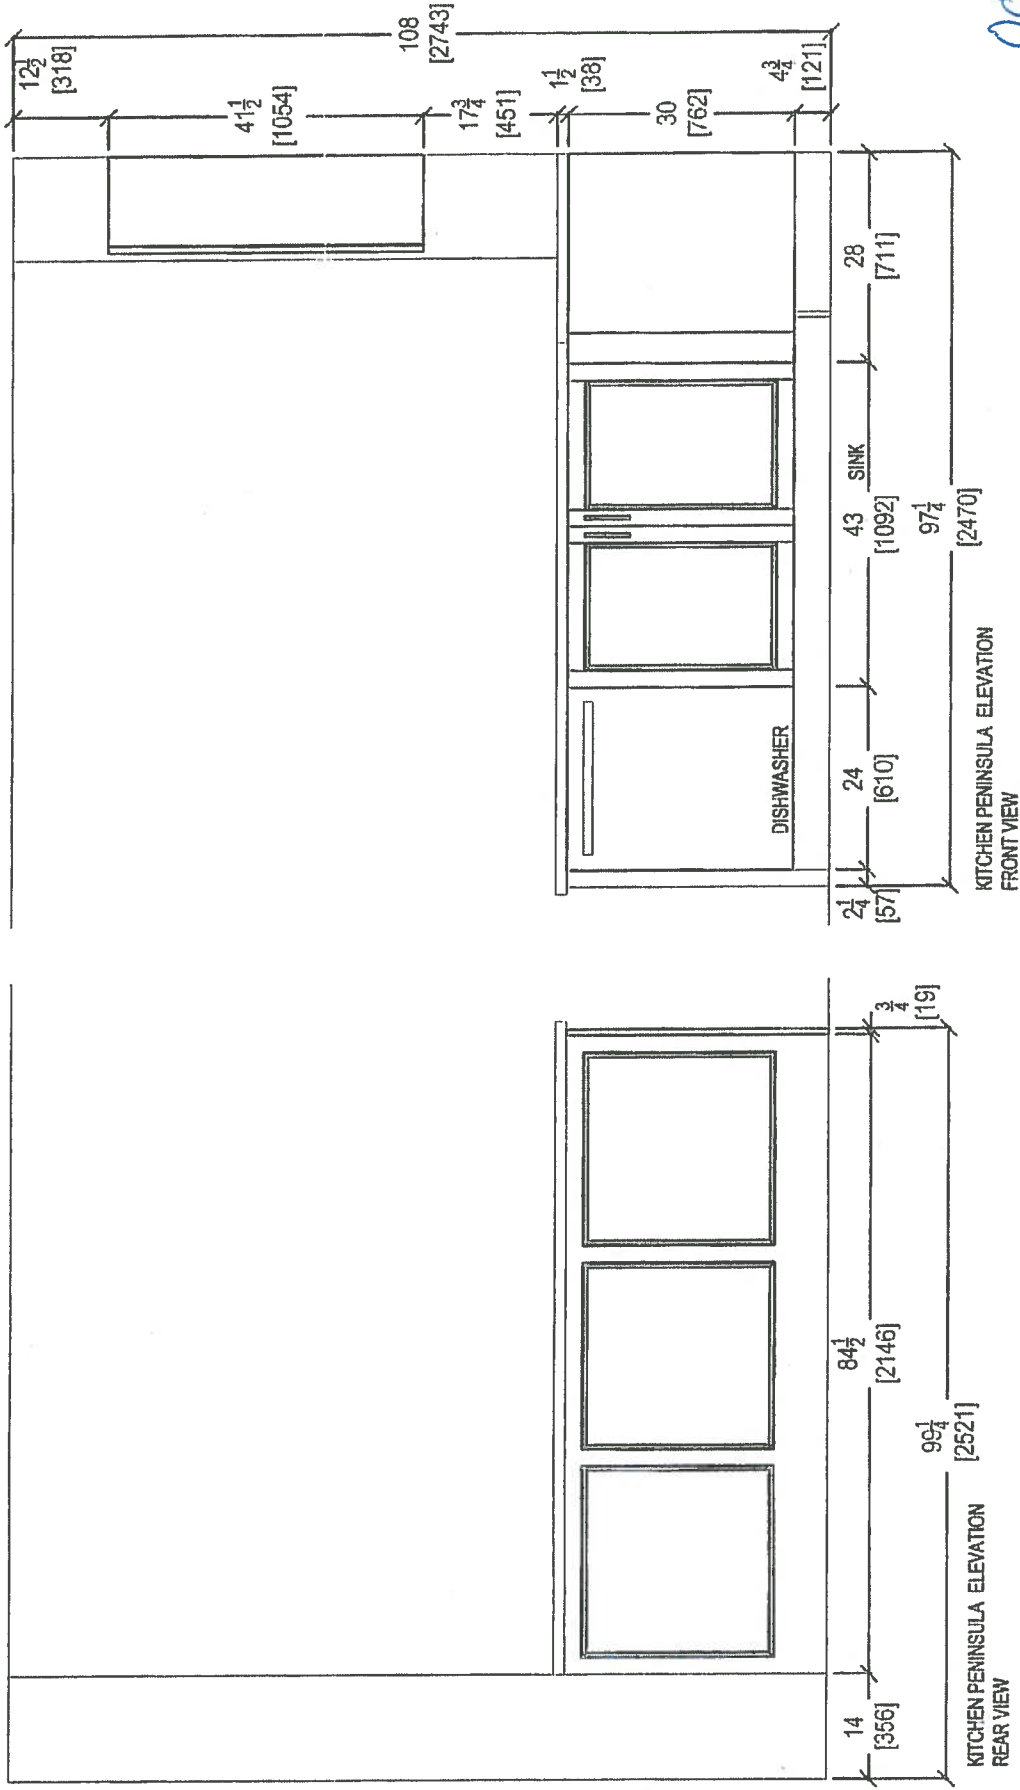

Oct 16, 2017




 <i>your kitchen. OTK better.</i> 80 SANTE DRIVE, VAUGHAN, ON L4K 3C4. T: 416 746 1811 F: 905 761 5501				CLIENT: ROYAL PINE HOMES		JOB NAME: UNIT 101 HMP		ROOM: KITCHEN FLOOR PLAN		DRAWN BY: SK		COMMENTS: PLEASE NOTE ALL DIMENSIONS ARE NOT FINAL AND ARE SUBJECT TO CHANGE UPON FINAL SITE MEASURE	
SITE: HAMPTON PLACE		DOOR STYLE: —		DOOR HANDLE: —		SCALE: 1/2" = 1' - 0"							
PHONE: —		FINISH: —		DRW HANDLE: —		DATE: OCT 16, 2017							
EMAIL: —		SPECIES: —		TOP: —		PAGE: —							




80 SANTE DRIVE, VAUGHAN, ON L4K 3C4,
T: 416 746 1811 F: 905 761 5501



Suite 101 Hampton

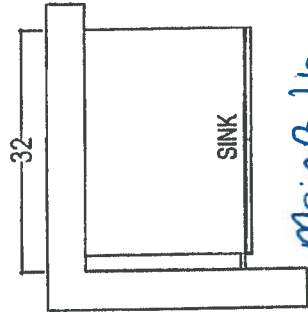

Main Bath

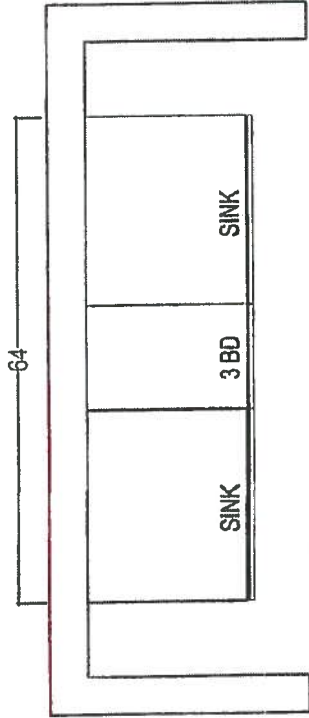

MASTER ENSUITE

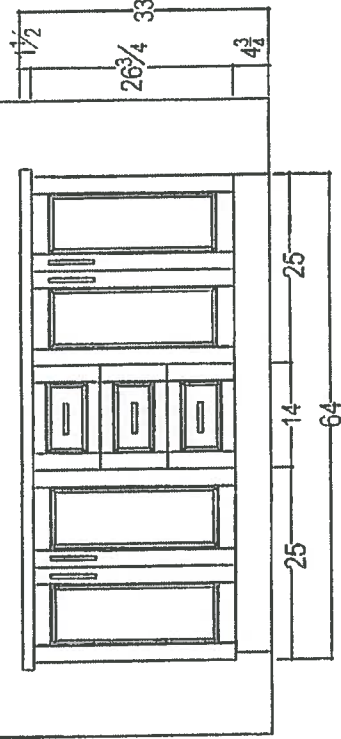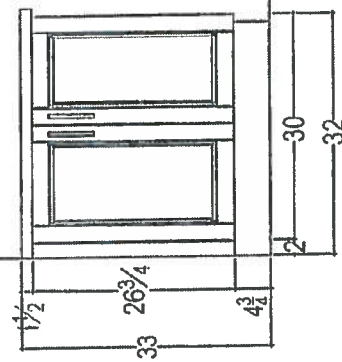

Oct 16, 2017



80 SANTE DRIVE, VAUGHAN, ON L4K 3C4.
T: 416.746.1811 F 905.761.5501

CLIENT: ROYAL PINE HOMES	JOB NAME: 2E	ROOM:	VANITIES	DRAWN BY SK	COMMENTS
SITE: HAMPTON PLACE	DOOR STYLE: —	DOOR HANDLE: —	SCALE: 1/2" = 1' - 0"		PLEASE NOTE ALL DIMENSIONS ARE NOT FINAL AND ARE SUBJECT TO CHANGE UPON FINAL SITE MEASURE
PHONE: —	FINISH: —	DRW HANDLE: —	DATE: AUG 4, 2017		
EMAIL: —	SPECIES: —	TOP: —	PAGE: —		

Suite 101
Hampton

October 16, 2017

Bm

CONNOLLY Marble & Granite Ltd.

EDGE
DETAILS


004

A.




STRAIGHT EDGE
(STANDARD - 3/4")

Standard:
Main Bath
Master Ensuite

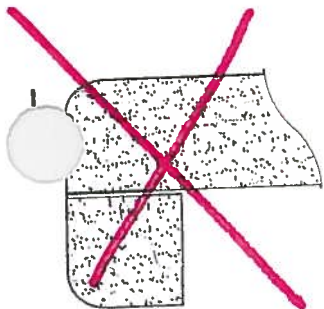

DOUBLE TOP "D" EDGE
(STANDARD - 1 1/2")


M.

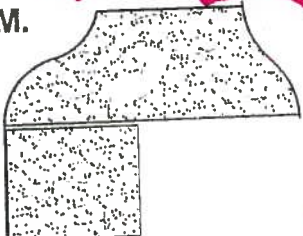

OGEE - SQUARE EDGE
(MED./HIGH - 1 1/2")

Upgrade:
Kitchen


EDGING UP-GRADE OPTIONS

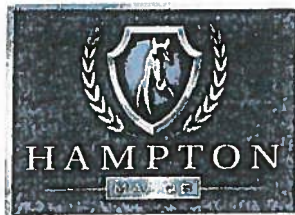

Suite 101
Hampton



Delta Wynne Chrome Single Lever
Lavatory Faucet With Pop Up
#534LF

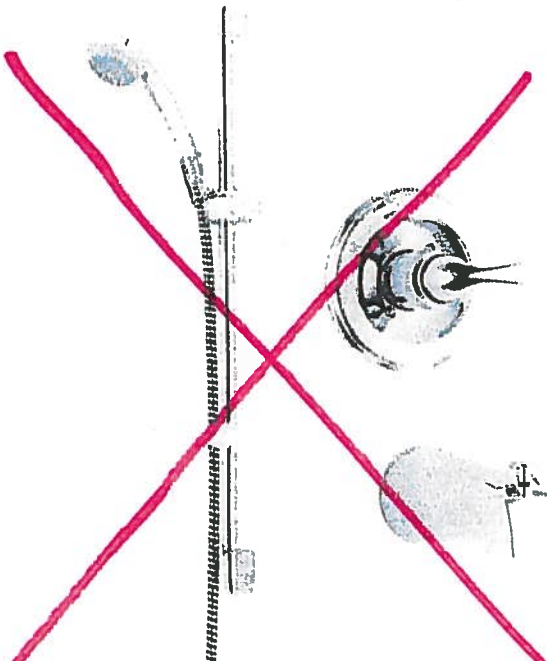

Delta Shower Trim with Tub Spout and
Hansgrohe Slide Bar with Handheld
#R10000/T13020-CDN/2001-TP/27454002/
27744000




Delta Shower Trim with ~~Tub Spout~~ and
Hansgrohe Slide Bar with Handheld and
~~Wall~~ ^{Ceiling} Mount Showerhead
#R10000/T13020-CDN/27454002/
27744000/RP52382/RP46870/RP6025/
R11000/T11800

Master
Ensuite


Suite 101 Hampton




KITCHEN UPGRADE OPTIONS

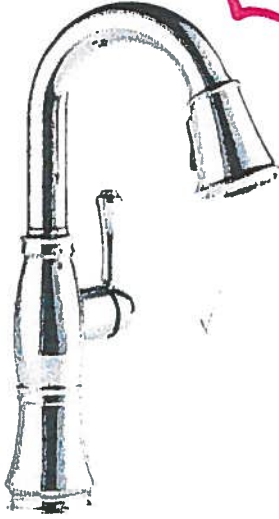

**Delta Cassidy Pull Down Kitchen
#9997-DST**

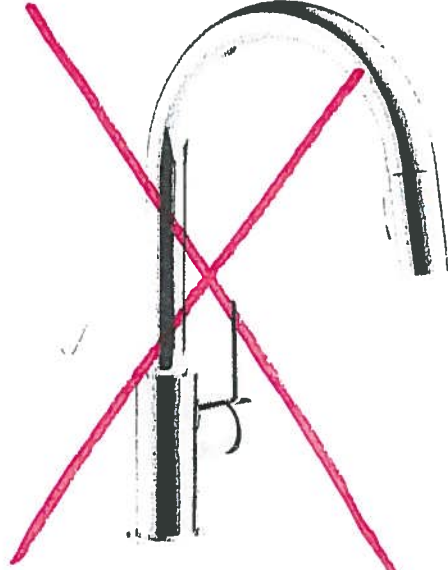

**Delta Trinsic Pull Down Kitchen
#9159-DST**

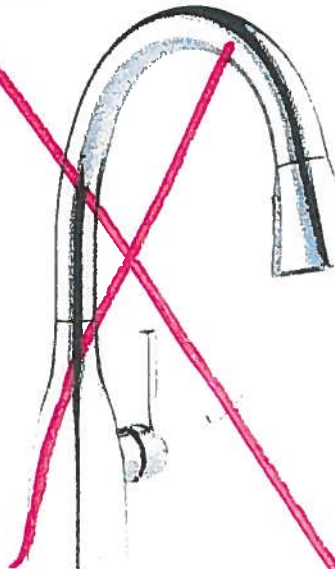


**Delta Mateo Pull Down Kitchen
#9183-DST**

Kitchen


RECEIVED
10/15/11

Suite 101
Hampton

Kitchen

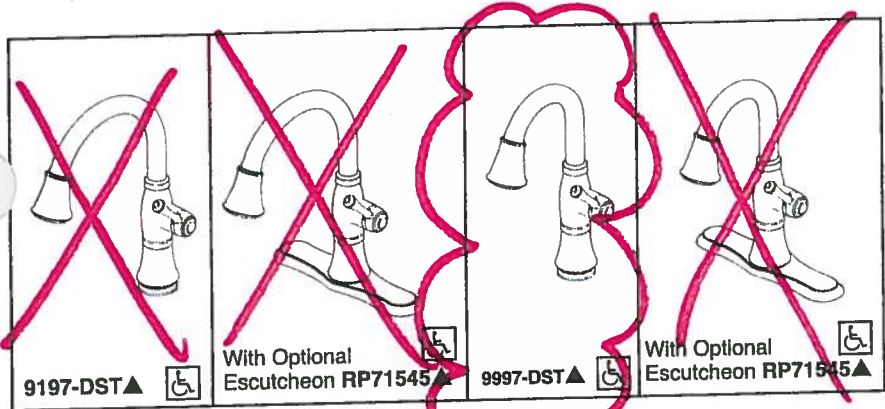

Submitted Model No.:
Specific Features:

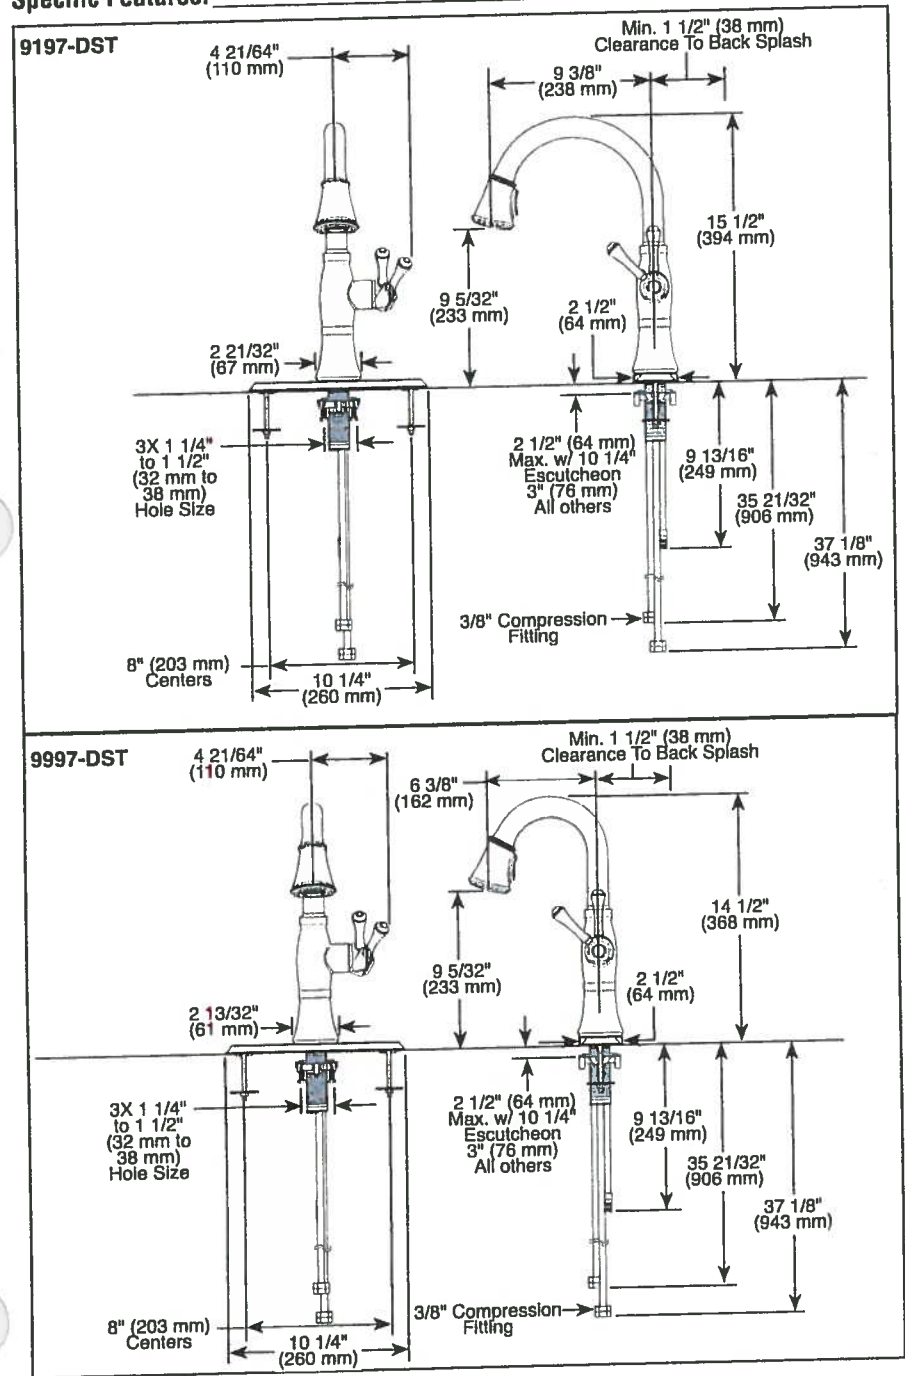

▲ Designate proper finish suffix
Delta reserves the right (1) to make changes in specifications and materials, and (2) to change or discontinue models, both without notice or obligation. Dimensions are for reference only. See current full-line price book or www.deltafaucet.com for finish options and product availability.
DSP-K-9197-DST Rev. C



KITCHEN
FAUCETS

- Cassidy™ Collection
- Single Handle Deck Mount
- 2-Function Pull-Down Sprayer
- Single or 3 Hole Sink Applications
- Integrated Innoflex® Supply Lines
- MagnaTite® Magnetic Docking
- DIAMOND Seal® Technology

STANDARD SPECIFICATIONS:

- 360° rotating spout.
- Diamond embedded ceramic disc cartridge.
- Touch-Clean® 2-function wand operates in stream or spray mode.
- 62" braided hose ensures smooth operation.
- Free-Moving hose weight provides maximum reach.
- 2 1/2" maximum deck thickness.
- 32" (minimum) Innoflex® supply lines with 3/8" compression fittings.
- Hot/cold markings on handle to indicate temperature.
- ADA complaint lever handle.
- Euro-Motion handle only rotates forward to eliminate backsplash interference.
- Maximum 1.80 gpm @ 60 psi, 6.8 L/min @ 414 kPa
- Order RP61607 for 1.5 gpm hose adapter.
- Order RP71545 for optional escutcheon.
- Order RP71543 for optional coordinating soap dispenser.

WARRANTY

- Lifetime limited warranty on parts (other than electronic parts and batteries) and finishes; or, for commercial users, for 5 years from date of purchase.
- 5 year limited warranty on electronic parts (other than batteries); or, for commercial users, for 1 year from the date of purchase. No warranty is provided on batteries.

COMPLIES WITH:

- ASME A112.18.1 / CSA B125.1
- ASME A112.18.6
- Indicates compliance to ICC/ANSI A117.1
- Verified compliant with .25% weighted average Pb content regulations.



55 E 111th Street, Indianapolis, Indiana 46280
350 South Edgeware Road, St. Thomas, ON N5P 4L1
© 2015 Masco Corporation of Indiana

WRB322DMBM

Upgrade
Package I


SUITE 101
HAMPTON
OCT. 16 '17



Whirlpool®

<http://www.whirlpool.com>

36 inches wide Bottom-Freezer Refrigerator with
SpillGuard™ Glass Shelves - 22 cu. ft

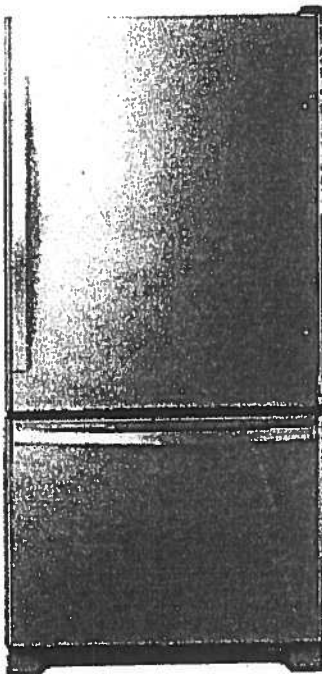

Key Features:

- SpillGuard™ Glass Shelves
- Adaptive Defrost
- FreshFlow™ Produce Preserver
- LED Interior Lighting
- ENERGY STAR® Qualified

Product Dimensions:

Height: 70

Width: 32 5/8

Depth: 33 3/8

Electrical Requirements:

15

Additional Information:

[Use And Care Guide](#)

[Dimension Guide](#)

[Energy Guide](#)

[Warranty Certificate](#)

INVESTED
IN
AMERICA



©Registered trademark/TM Trademark of Whirlpool, U.S.A. © 2016 Whirlpool Corporation. All Rights Reserved.
All other trademarks are owned by their respective companies.
Because Whirlpool Corporation policy includes a continuous commitment to improve our products, we reserve the right to change materials and specifications without notice. We also reserve the right to discontinue or transition products without notice.
Manufacturer's Suggested Retail Price (MSRP) and Minimum Advertised Price (MAP) provided for reference purposes only. Dealer alone determines advertised and retail prices.
Created On: Tuesday, March 14, 2017 11:30:08

SUITE 101
HAMPTON
Upgrade Oct. 16, '17
Package 1

WEE745H0FS



Whirlpool®

<http://www.whirlpool.com>

6.4 Cu. Ft. Slide-In Electric Range with True Convection

Key Features:

- Frozen Bake™ Technology
- True Convection Cooking
- FlexHeat™ Triple Radiant Element
- Convection Conversion
- AquaLift® Self-Cleaning Technology
- Temperature Sensor
- Rapid Preheat
- 6.4 Cu. Ft. Capacity
- Easy-Wipe Ceramic Glass Cooktop
- Large Oven Window
- Max Capacity Rack
- Hidden Bake Element

Product Dimensions:

Height: 36

Width: 29 7/8


Additional Information:

[Use And Care Guide](#)

[Dimension Guide](#)

[Installation Guide](#)

[Warranty Certificate](#)

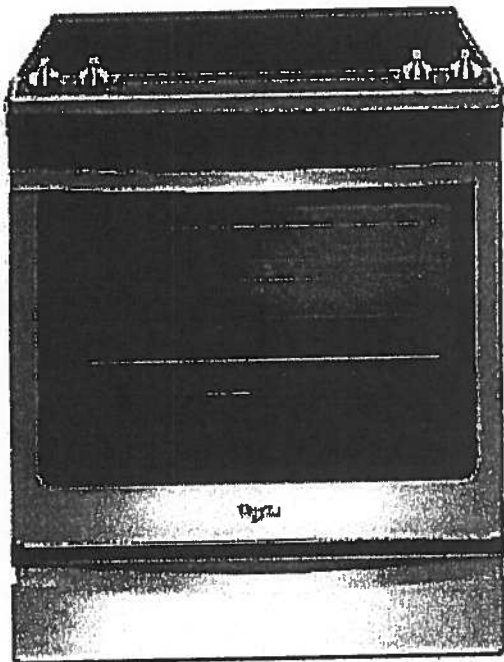

INVESTED
IN
AMERICA



©Registered trademark/TM Trademark of Whirlpool, U.S.A. © 2016 Whirlpool Corporation. All Rights Reserved.
All other trademarks are owned by their respective companies.
Because Whirlpool Corporation policy includes a continuous commitment to improve our products, we reserve the right to change materials and specifications without notice. We also reserve the right to discontinue or transition products without notice.
Manufacturer's Suggested Retail Price (MSRP) and Minimum Advertised Price (MAP) provided for reference purposes only. Dealer alone determines advertised and retail prices.
Created On: Friday, January 27, 2017 10:48:47

Upgrade Package 1


SUITE 101
HAMPTON
OCT. 16 '17



<http://www.whirlpool.com>

YWMH76719CS

1.9 cu. ft. Microwave Hood Combination with
TimeSaver™ Plus True Convection

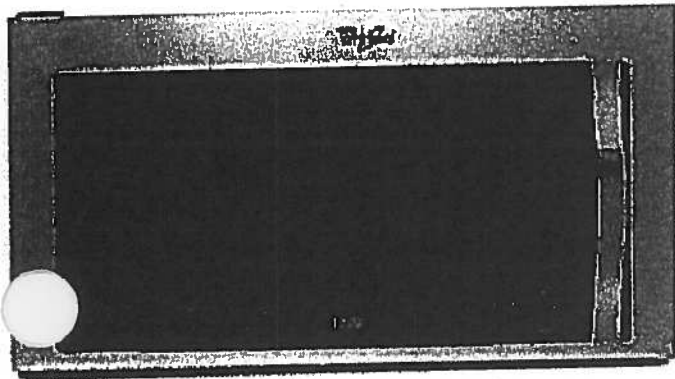

Key Features:

- TimeSaver™ Plus True Convection Cooking System
- Steam Cooking
- Sensor Cooking
- AccuPop™ Cycle
- CleanRelease® Non-Stick Interior
- SteamClean Option
- Integrated Hidden Vent and Console
- Auto Adapt Fan
- Recessed, Stoppable Glass Turntable
- Universal Microwave Steamer
- 1.9 cu. ft. Capacity
- 1,100 Watts Cooking Power

Product Dimensions:

Height: 17 1/8

Width: 29 15/16

Depth: 18 1/2

Electrical Requirements:

15 or 20. 120 V.

Additional Information:

[Use And Care Guide](#)

[Installation Guide](#)

[Warranty Certificate](#)

Available in:

● Stainless Steel



©Registered trademark/TM Trademark of Whirlpool, U.S.A. © 2013 Whirlpool Corporation. All Rights Reserved.
All other trademarks are owned by their respective companies.
Because Whirlpool Corporation policy includes a continuous commitment to improve our products, we reserve
the right to change materials and specifications without notice. We also reserve the right to discontinue or
transition products without notice.
Manufacturer's Suggested Retail Price (MSRP) and Minimum Advertised Price (MAP) provided for reference
purposes only. Dealer alone determines advertised and retail prices.
Created On: Monday, March 14, 2016 13:16:48

SUITE 101
HAMPTON
OCT. 16, '17

Upgrade Package 1

BM

WDTA50SAHZ

Whirlpool®

<http://www.whirlpool.com>

Contemporary Design. Stainless Steel Tub
Dishwasher with TotalCoverage Spray Arm

Key Features:

- Sensor Cycle
- TotalCoverage Spray Arm
- 1-Hour Wash Cycle
- Tap Touch Controls

Product Dimensions:

Height: 34 1/2
Width: 23 7/8
Depth: 24 1/2

Additional Information:


[Use And Care](#)

[Dimension Guide](#)

[Installation Guide](#)

[Energy Guide](#)

[Warranty](#)

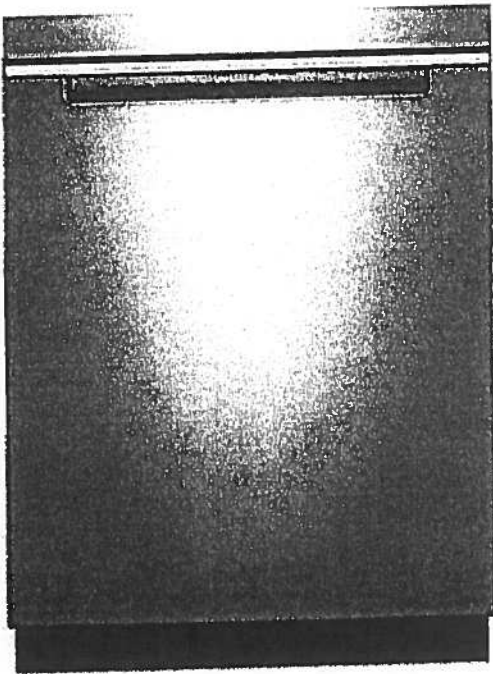

Available in:

● Black

Fingerprint Resistant Sunset Bronze

Fingerprint Resistant Black Stainless

○ White

Fingerprint Resistant Stainless Steel

INVESTED
IN
AMERICA



®Registered trademark/TM Trademark of Whirlpool, U.S.A. © 2016 Whirlpool Corporation. All Rights Reserved. All other trademarks are owned by their respective companies.

Because Whirlpool Corporation policy includes a continuous commitment to improve our products, we reserve the right to change materials and specifications without notice. We also reserve the right to discontinue or transition products without notice.

Manufacturer's Suggested Retail Price (MSRP) and Minimum Advertised Price (MAP) provided for reference purposes only. Dealer alone determines advertised and retail prices.

Upgrade Package 1

SUITE 101
HAMPTON
OCT. 16, '17


WFW75HEFW



Whirlpool
HOME APPLIANCES

<http://www.whirlpool.com>

4.5 cu. ft. Front Load Washer with Precision
Dispense

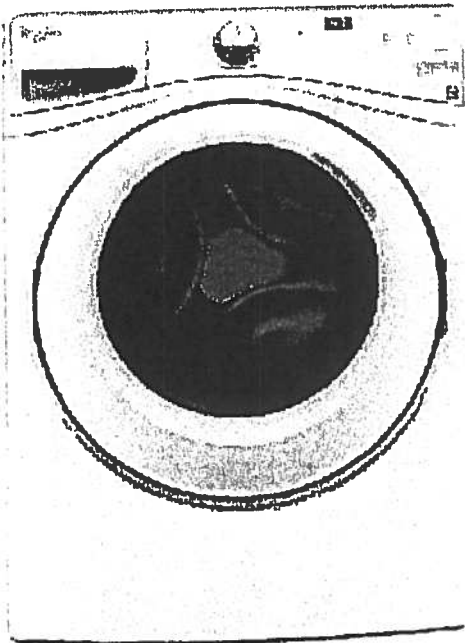

Key Features:

- Precision Dispense
- Adaptive Wash Technology
- Smooth Wave Stainless Steel Wash Basket
- 4.5 cu. ft. Capacity
- ENERGY STAR® Qualified

Product Dimensions:

Height: 39 3/4

Width: 27

Depth: 33 5/16

Electrical Requirements:

15 or 20. 120 V.

Additional Information:

[Use And Care Guide](#)

[Dimension Guide](#)

[Installation Guide](#)

[Energy Guide](#)

[Warranty Certificate](#)

INVESTED
IN
AMERICA



©Registered trademark/TM Trademark of Whirlpool, U.S.A. ©2013 Whirlpool Corporation. All Rights Reserved.
All other trademarks are owned by their respective companies.
Because Whirlpool Corporation policy includes a continuous commitment to improve our products, we reserve
the right to change materials and specifications without notice. We also reserve the right to discontinue or
transition products without notice.
Manufacturer's Suggested Retail Price (MSRP) and Minimum Advertised Price (MAP) provided for reference
purposes only. Dealer alone determines advertised and retail prices.
Created On: Wednesday, March 23, 2016 11:51:03

Upgrade
Package 1

SUITE 101
HAMPTON
OCT. 16, '17

YWED75HEFW



Whirlpool®

<http://www.whirlpool.com>

7.4 cu. ft. Duet® High Efficiency Front Load Electric
Dryer with ENERGY STAR®

MSRP: \$0.00

Key Features:

- Advanced Moisture Sensing System
- Quad Baffles
- Tap Touch Controls with Memory
- EcoBoost™ Option
- Wrinkle Shield™ Plus Option
- Undercounter Installation
- 7.4 Cu. Ft. Capacity
- ENERGY STAR® Qualified

Product Dimensions:

Height: 39

Width: 27


Depth: 31

Additional Information:

Use And Care

Installation Guide

Warranty

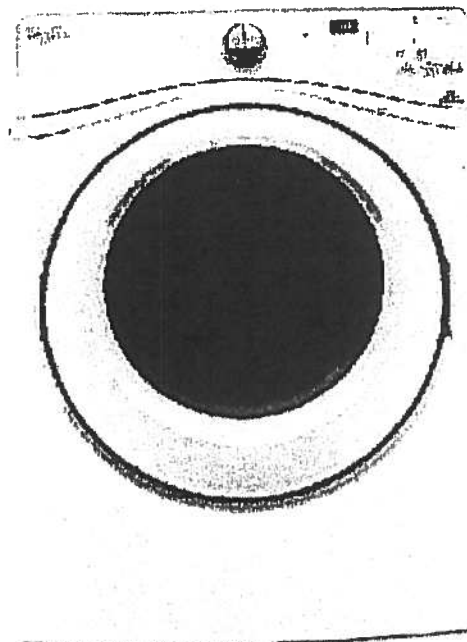

Available in:

☐ White

INVESTED
IN
AMERICA

ADA
Compliant

®Registered trademark/TM Trademark of Whirlpool, U.S.A. © 2016 Whirlpool Corporation. All Rights Reserved. All other trademarks are owned by their respective companies.

Because Whirlpool Corporation policy includes a continuous commitment to improve our products, we reserve the right to change materials and specifications without notice. We also reserve the right to discontinue or transition products without notice.

Manufacturer's Suggested Retail Price (MSRP) and Minimum Advertised Price (MAP) provided for reference purposes only. Dealer alone determines advertised and retail prices.