






Noyac Bay

Suite 104.
ORIGINAL

1,121 SQ FT *plus 81 sq. ft. of balcony area*

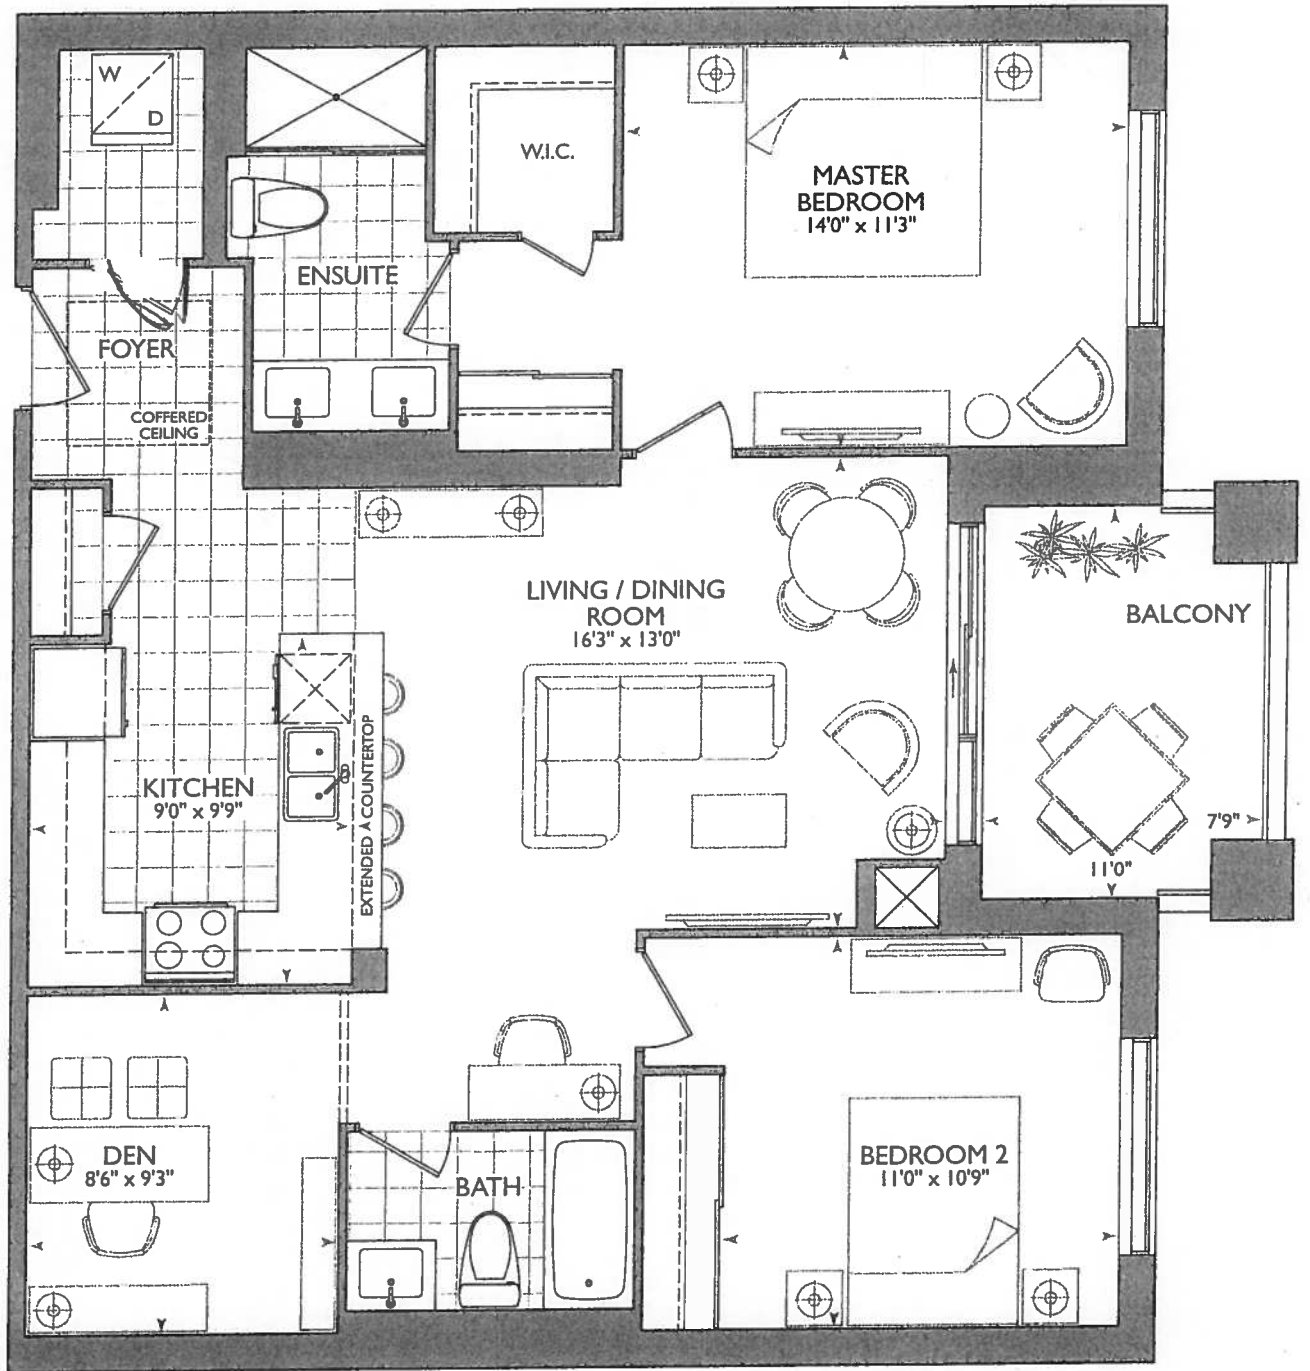

ORIGINAL SUITE

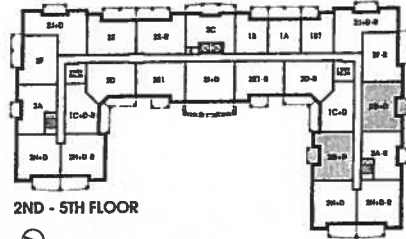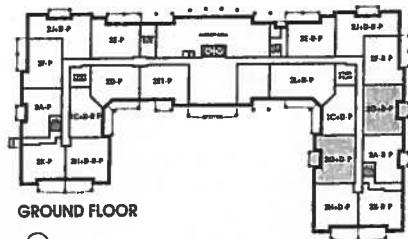

SMOOTH WALLING

* (x5) Extended Height Doors
* Kitchen Pots & Pendants
SEE KITCHEN LAYOUT

* (16x) Puck Lights
(8x) Lower
(8x) Upper.

* (x2) = PLUGS ISLAND

* UPG #1 = APPLIANCE PACKAGE
① SPECIMEN CABINET

* MAIN ENSUITE 36" RAISED

VANITY w/ 3" SPLASH

* 6x = POT LIGHTS - Kitchen

* 1x PENDANT LIGHT OVER ISLAND


NO shelving
NO ceramic
accessories
NO mirrors
THROUGH OUT

RELOCATE THE ELECTRICAL
& PLUMBING LOCATIONS
LOCATION OF KITCHEN
LIGHTS REFER TO QTK. DWG.

LEGEND:

	SECURITY PANEL
	ELECTRICAL PANEL
	COMMUNICATION PANEL
	WATER METER
	FRIDGE
	DROPPED AREA
	6" CROWN MOLDING

RECEIVED
DEC 13 17

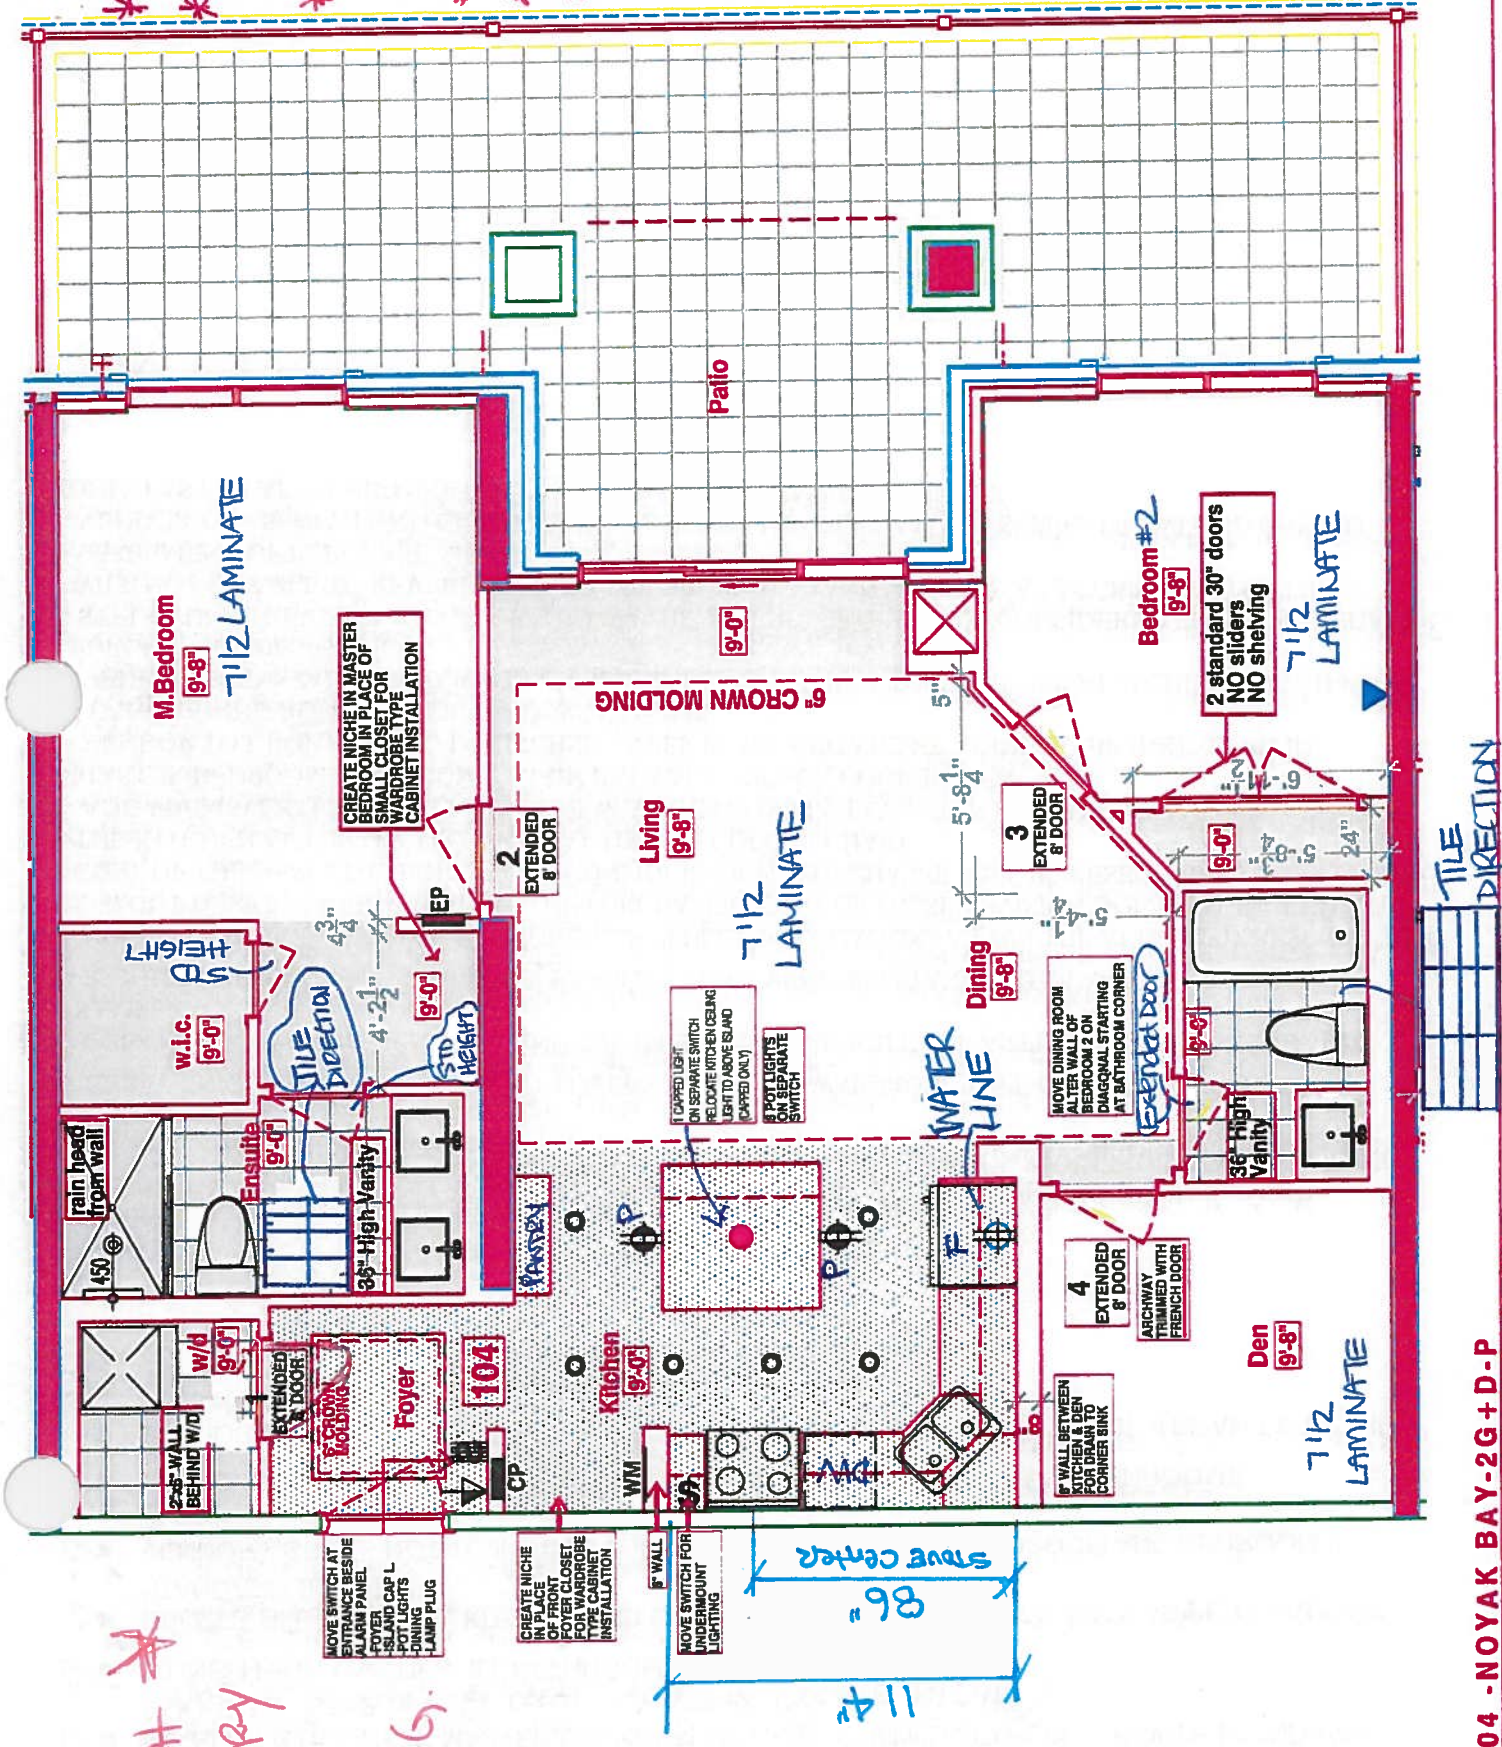

* WATCH
LAUNDRY
DOOR
SWING.



SITE COPY

CONSTRUCTION SUMMARY

Hampton Place

PURCHASERS: CATHERINE VANOS and JOHN VANOS

TEL: RES.: 905-554-4950

LOT NUMBER	PHASE	HOUSE TYPE	CLOSING DATE
104	1	NOYAC BAY*	05-Sep-18

Offer	NO BATHROOM PLATE MIRRORS INSTALLED.
Workshee	Note:

Offer	NO SLIDER DOORS IN MASTER BEDROOM AND BEDROOM #2 AND REPLACE WITH STANDARD DOORS, AS PER VENDORS SAMPLES.
Workshee	Note:

Offer	36 INCH HIGH VANITIES ALL BATHROOMS.
Workshee	Note:

Offer	DELETE TILE IN FOYER, KITCHEN AND HALL CLOSET AND INSTALL LAMINATE AS PER VENDORS STANDARD SAMPLES.
Workshee	Note:

Offer	VENDOR AGREES NOT TO INSTALL WIRE SHELVING IN MASTER BEDROOM AND BEDROOM 2 CLOSETS
Workshee	Note:

Offer	VENDOR AGREES NOT TO INSTALL ANY CERAMIC ACCESSORIES IN ALL BATHROOMS.
Workshee	Note:

Offer	VENDOR AGREES THAT A CENTRALIZED WATER SOFTENER SYSTEM WILL BE INSTALLED IN THE BUILDING.
Workshee	Note:

Offer	VENDOR AGREES TO INSTALL SMOOTH CEILINGS THROUGOUT.
Workshee	Note:

Offer	CREATE NICHE IN PLACE OF FRONT FOYER CLOSET FOR WARDROBE TYPE CABINET INSTALLATION
Upgrade	Note:

Offer	CREATE NICHE IN MASTER BEDROOM IN PLACE OF SMALL CLOSET FOR WARDBROBE TYPE CABINET INSTALLATION
Upgrade	Note:

Offer	VENDOR TO RELOCATE THE ELECTRICAL & PLUMBING LOCATIONS AS PER THE ATTACHED NEW KITCHEN LAYOUT DESIGN AS PROVIDED BY THE PURCHASER. COST OF THESE REVISION DOES NOT INCLUDE THE COST OF THE NEW KITCHEN LAYOUT CONFIGURATION. PURCHASER WILL BE RESPONSIBLE TO upgrade
Upgrade	Note: the kitchen at the door office at time of colour chart .

Offer	ALTER WALL OF BEDROOM 2 ON DIAGONAL STARTING AT BATH CORNER (NO CHANGE TO BATH)
Upgrade	Note:

Offer	CREATE ARCHWAY IN DEN AREA AND TRIMMED, WITH FRENCH DOOR AS PER VENDORS STANDARD SAMPLE
Upgrade	Note:

Offer	STRUCTURAL REVISIONS AS ACCEPTED ON THIS AMENDMENT WILL BE CONSIDERED FINAL. PURCHASER WILL NOT BE ABLE TO REVERT BACK TO THE ORIGINAL STANDARD PLAN AS ACCEPTED WITH THE AGREEMENT OF PURCHASE & SALE.
Upgrade	Note:

Offer	VENDOR TO DROP CEILING IN KITCHEN AS PER PLAN. CROWN MOULDING TO BE INSTALLED IN LIVING/DINING ROOM AS PER VENDORS SAMPLES
Upgrade	Note:

Offer	ADD FIVE (5) EXTENDED HEIGHT DOORWAYS (APPROXIMATELY 8 FT IN HEIGHT) IN LAUNDRY AREA, MASTER BEDROOM, BEDROOM 2, MAIN BATH AND FRENCH DOOR TO DEN
Upgrade	Note:



SITE COPY

CONSTRUCTION SUMMARY
Hampton Place

PURCHASERS: CATHERINE VANOS and JOHN VANOS
TEL: RES.: 905-554-4950

LOT NUMBER	PHASE	HOUSE TYPE	CLOSING DATE
104	1	NOYAC BAY*	05-Sep-18
Offer / Upgrade	RAINHEAD FROM WALL IN MASTER ENSUITE , FROM VENDORS STANDARD SAMPLES Note:		
Offer / Upgrade	VENDOR TO RELOCATE KITCHEN CEILING LIGHT TO ABOVE ISLAND ON SEPERATE SWITCH (CAPPED ONLY) AS PER ATTACHED SKETCH PROVIDED BY PURCHASERS DESIGNER Note:		
Offer / Upgrade	VENDOR TO INSTALL 6 POTLIGHTS ON SEPARATE SWITCH IN KITCHEN AS PER ATTACHED SKETCH FROM PURCHASERS DESIGNER. Note:		



SITE COPY

CONSTRUCTION SUMMARY
Hampton Place

PURCHASERS: CATHERINE VANOS and JOHN VANOS

TEL: RES.: 905-554-4950

LOT NUMBER	PHASE	HOUSE TYPE	CLOSING DATE
104	1	NOYAC BAY*	05-Sep-18

Date Added: 15-Dec-17 Invoice Number: 7009

1 - CLARIFICATION-As per the P&SA Install only (X5) FIVE extended height doors, to include the Laundry Rm door, Den ,Bedroom #2, Master n, and Main Bath.
1 - **Purchaser has declined increasing the height of the remaining doors in suite.
Install standard height for Bedroom #2 closet doors, Master Bedroom WIC door, & the Master Ensuite door

1 - CLARIFICATION- DEN- French door included in the P&SA to be Wood Mullions with clear bevelled glass.
Note:

1 - KITCHEN & BATHROOM- SEE QUALITY TOPS & KITCHENS FOR ALL KITCHEN & BATHROOMS UPGRADES/LAYOUTS (See attached Upgrade Package)
Note:

1 - KITCHEN- Shift the stove away from the wall, to accommodate for a spice rack- See Sketch / See QTK Layout
Note: No Charge as per Vince

1 - CLARIFICATION:
MASTER ENSUITE & MAIN BATH-Install RAISED VANITY HEIGHT at Main Bath and Master Ensuite Vanities, where applicable (See attached QTK Upgrade paperwork and Layouts)
Note:

1 - APPLIANCE PACKAGE- Install Upgrade Appliance Package #1 To be installed throughout the suite, where applicable (See Sketch)
Note: **PLEASE NOTE** - the above Includes the Fisher & Paykel Fridge, as per the attached spec

CHEN- Install a WATER LINE to the fridge
Note: Approved as per Vince

1 - **PLEASE NOTE** In lieu of the credit owed to the purchaser for the kitchen dropped ceiling, The Vendor has allowed the purchaser to replace the whirlpool fridge from Package #1 with the Fisher and Paykel fridge.
**See attached specs
Note:

1 - KITCHEN -Install the builders standard counter top "Aspen Terra White" through out the kitchen, where applicable
Note:

4 - KITCHEN- Install FOUR (X4) ADDITIONAL PUCK LIGHTS (Same Switch as standard Puck Lights) at kitchen. To be installed below kitchen cabinetry, where applicable (See attached QTK layout for locations)
Note: Purchaser is paying the difference for additional Puck Lights- standard Kitchen to Receive Four (4) Puck Lights- Upgrade Kitchen requires a total of EIGHT (X8) Puck Light

1 - KITCHEN- KITCHEN- Install EIGHT (X8) Pucklights (on seperate switch). Puck lights to be installed on upper top cabinets for the split Mesh.
Note:

1 - DISCLAIMER -KITCHEN / BATHROOMS:

Stone slabs vary in size & all seams are visible & the fabricator reserves the right to position the seams as necessary.

1 - KITCHEN- Install the builders standard undermount sink in the kitchen- Install the BLANCO HORIZON Plus U2 (8") Undermount Sink- Model # 401234
Note:

1 - KITCHEN- Install the builders standard Faucet in the kitchen- Install the DELTA Chrome Pull-Out Kitchen Faucet (Single Hole) - Model # 469LF- Chrome
Note:



SITE COPY

CONSTRUCTION SUMMARY

Hampton Place

PURCHASERS: CATHERINE VANOS and JOHN VANOS

TEL: RES.: 905-554-4950

LOT NUMBER	PHASE	HOUSE TYPE	CLOSING DATE
104	1	NOYAC BAY*	05-Sep-18

Date Added: 15-Dec-17

Invoice Number: 7009

1

CLARIFICATION-

1

BATH & MASTER ENSUITE- Install the standard Plumbing Fixtures throughout all bathrooms, where applicable. To Include the Main Bath & Master Ensuite

Note:

1

CLARIFICATION-

1

MASTER ENSUITE / MAIN BATH- Install the Standard 3" Splash throughout all bathroom vanity counter tops, where applicable. To include the Main Bath and the Master Ensuite

Note:

1

LAUNDRY ROOM-

1

Install a 1st upgrade floor tile, 13x13 Rustic Grey in the Laundry Room, in lieu of teh buildesr standard 8x8

Note:

1

MAIN BATH / MASTER ENSUITE-

1

Install the builders standard counter top through out the Master Ensuite & Main Bath where applicable

Note:

1

MAIN BATH-

1

Install a 1st upgrade 12x24 floor tile on the floor of the Main Bath, in lieu of the builders standard 13x13 Installed Straight/stacked

Note: **PLEASE NOTE** Install builders standard 8x10 wall tile for the tub alcove

1

MAIN BATH-

1

Install the builders standard 8x10 wall tile horizontal on tub alcove of Main Bath

Note:

1

MASTER ENSUITE -

1

Install a 1st upgrade 12x24 floor tile on the floor of the Master Ensuite, in lieu of the builders standard 13x13. Installed Straight/stacked

Note:

1

MASTER ENSUITE -

1

Install a 1st upgrade 12x24 floor tile on the shower stall walls of the Master Ensuite. Installed Straight/stacked AND Vertical

Note:

1

CLARIFICATION-

1

MASTER ENSUTE- Install the builders standard glass shower to 8'-0" high in the Master Ensuite

Note:

1

PURCHASER AWARE AND ACCEPTS THAT ANY CHANGES MADE TO UPGRADES AFTER SIGNING THIS PURCHASERS EXTRA FORM ARE SUBJECT TO A MINIMUM ADMINISTRATION FEE OF \$1000. PLUS A 10% HOLDBACK FEE.

Note:

1

PURCHASER HAS ATTENDED A COLOR APPOINTMENT AT THE DECOR CENTRE AND HAS DECLINED ANY ADDITIONAL UPGRADES.

Note:



Purchasers

CATHERINE VANOS & JOHN VANOS

Decor Consultant

Laura Di Pede

Model Type

NOYAC BAY*

Telephone Res. / Bus

(905) 554-4950 /

Project

Hampton Place

Closing Date

05/09/2018

Unit

104

CABINETRY, VANITIES AND COUNTERTOPS

	Style	Countertop	Counter Edge	Handle / Knob
MAIN BATHROOM	SEE QTK	☒ ASPEN TERRA WHITE- STD	"A" -(STD)	3487128 STD
MASTER ENSUITE	SEE QTK	☒ ASPEN TERRA WHITE- STD	"A" -(STD)	3487128 STD
POWDER ROOM	N/A	N/A	N/A	N/A
KITCHEN / DINETTE	SEE QTK	☒ ASPEN TERRA WHITE- STD	"A" -(STD)	3487128 STD
LAUNDRY ROOM	N/A			

APPLIANCE PACKAGE

PACKAGE #1
WITH SPECIAL
FRIDGE
SEE ATTACHED

Std 31in Opening

PLUMBING FIXTURES

KITCHEN	
Sink Model	☒ STANDARD
Sink Faucet	☒ STANDARD
TOILETS	
Master Ensuite	☒ STANDARD
Main Bathroom	☒ STANDARD
Powder Room	N/A
VANITY FAUCETS	
Master Ensuite	☒ STANDARD
Main Bathroom	☒ STANDARD
Powder Room	N/A

Trim	
Baseboard & Casing	STANDARD
Interior Doors	STANDARD
Levers	STANDARD
Door Height	X5 Extended Height Doors ONLY

Cornice Moulding / Medalion

Foyer	☒ STANDARD- CTR #611
Living Room	☒ STANDARD- CTR #611
Dining Room	☒ STANDARD- CTR #611
Den	N/A
Master Bedroom	N/A
Bedroom 2	N/A
Bedroom 3	N/A

Fireplace

Fireplace	N/A
Location Flooring	N/A
Style	N/A
Finish	N/A
Marble	N/A
Hearth	N/A

VANITY SINKS

Master Ensuite	☒ STANDARD
Main Bathroom	☒ STANDARD
Powder Room	N/A

Paint Throughout

Walls	BIRCH WHITE- STANDARD
Trim	WHITE STANDARD

SHOWER STALL / TUBS

Master Ensuite Shower Stall	STANDARD
Master Ensuite Tub	N/A
Main Bathroom Tub	☒ STANDARD

MISC. INSTALLATIONS

☒ Ceramic Accessories
(installed by Vendor)
☐ Yes ☒ No

☒ Bathroom Mirrors
(installed by Vendor)
☐ Yes ☒ No

☒ Wire Shelving - Closet
(installed by Vendor)
☐ Yes ☒ No

Decor Consultant:

Laura Di Pede

Laura Di Pede

Purchaser:

Catherine Vanos

CATHERINE VANOS

Purchaser:

John Vanos

JOHN VANOS

Vendor:

Hampton Place

Hampton Place

NOTES

DEC 7 1971



1x Pendant Light - Island


$$6x = 80 + 116475$$

$PL = (16x) \text{ Puck Lights}$

$$(B_x) = \text{Lower}$$
$$(g_x) = \text{upper}$$
 $\bullet (x_2) = \text{PLUGS ISLAND}$

* UPGT-1 = Appliance Specs
w/ special
FR10GB

* Powder Room +
ENSUITE 36"
Raised vanity
w/ 3" splash.

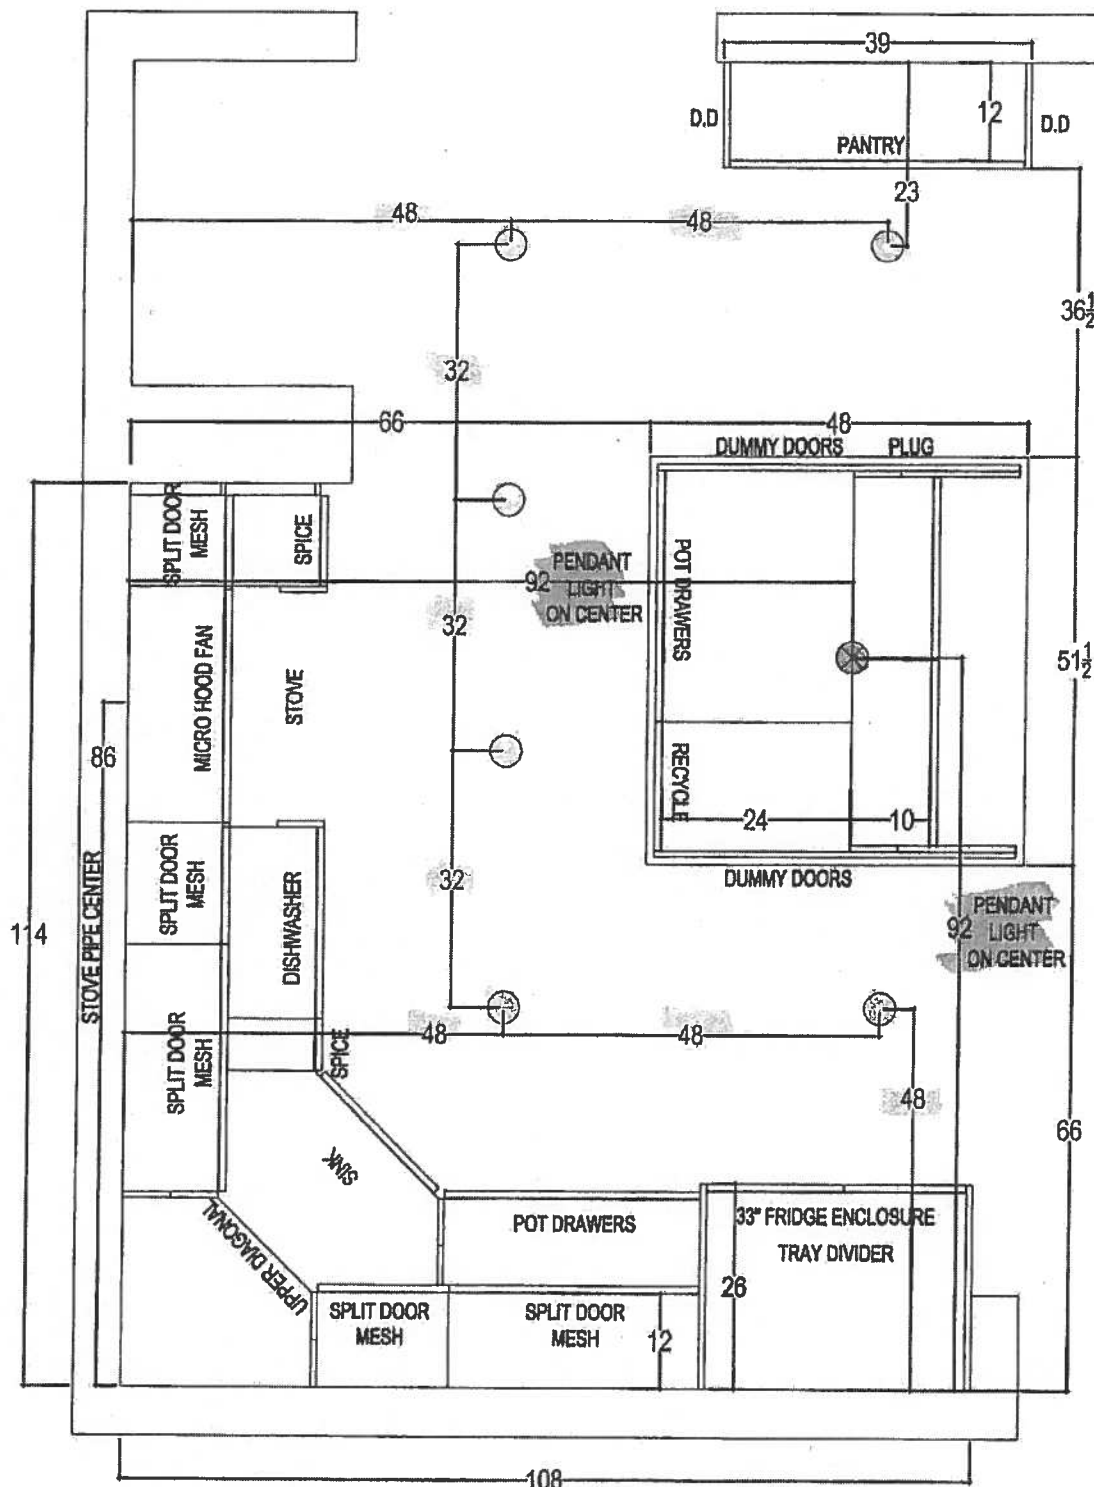

80 SANTE DRIVE, VAUGHAN, ON L4K 3C4,
T. 416.748.1811 F.905.701.5001


CLIENT: ROYAL PINE HOMES	JOB NAME: UNIT 104 HMP	ROOM: KITCHEN	DRAWN BY: SK
SITE: HAMPTON PLACE	DOOR STYLE: __	DOOR HANDLE: __	SCALE: 1/2"=1'-0"
PHONE: __	FINISH: __	DRW HANDLE: __	DATE: DEC 5, 2017
EMAR: __	SPECIES: __	TOP: __	PAGE: __

HAMPTON SUITE 104

DEC 7/17

am
am






PL = PUCK
LIGHTS
Total (X16)
Puck Lights
(X8) UPPER
(X8) LOWER

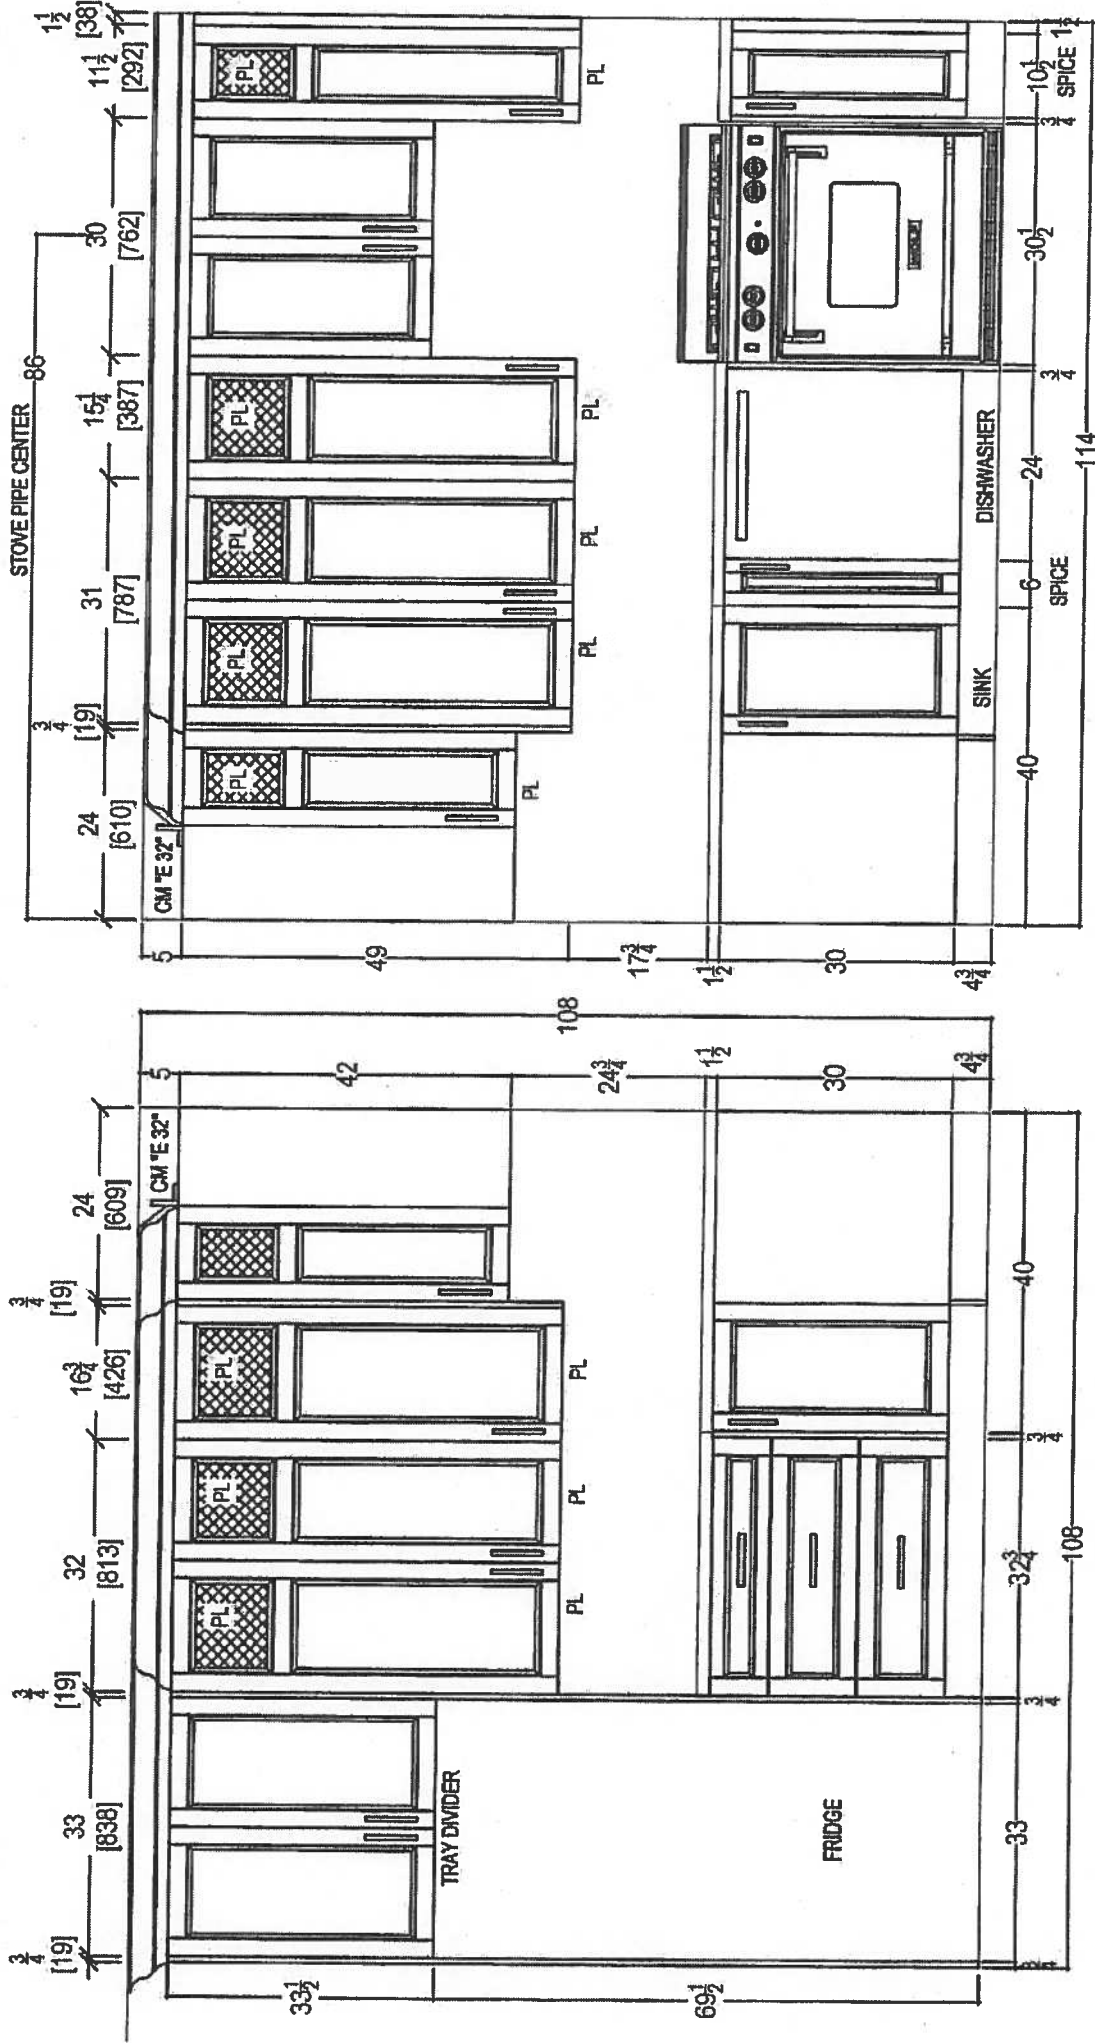

 your kitchen, your taste 80 SANTE DRIVE, VAUGHAN, ON L4K 3C4, T: 416.746.1811 F: 905.761.5901	CLIENT: ROYAL PINE HOMES		UNIT 104 HMP	ROOM: KITCHEN	DRAWN BY: SK	COMMENTS: PLEASE NOTE ALL DIMENSIONS ARE NOT FINAL AND ARE SUBJECT TO CHANGE UPON FINAL SITE MEASURE
	SITE: HAMPTON PLACE	DOOR STYLE: —	DOOR HANDLE: —	SCALE: 1/2" = 1'-0"		
	PHONE: —	FINISH: —	DRW HANDLE: —	DATE: DEC 5, 2017		
	EMAIL: —	SPECIES: —	TOP: —	PAGE: —		

HAMPTON SUITE 104

DEC 7 117

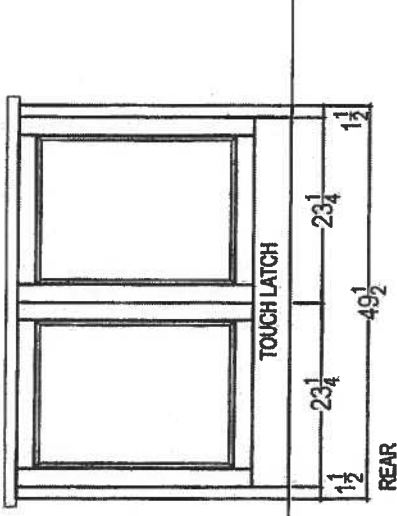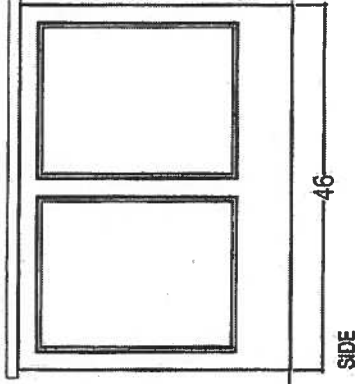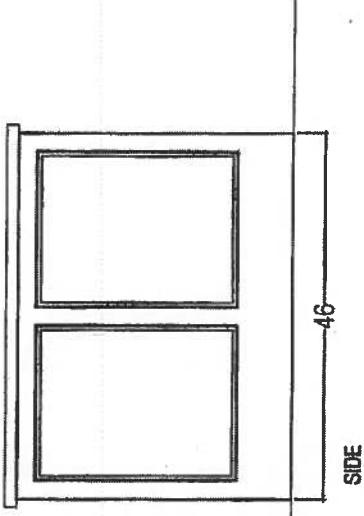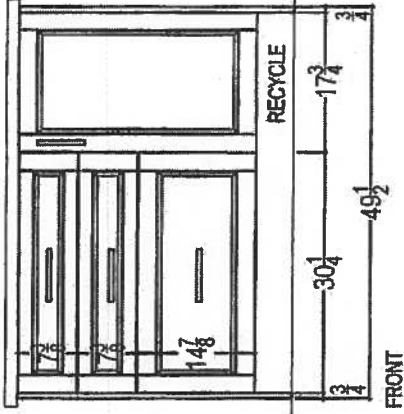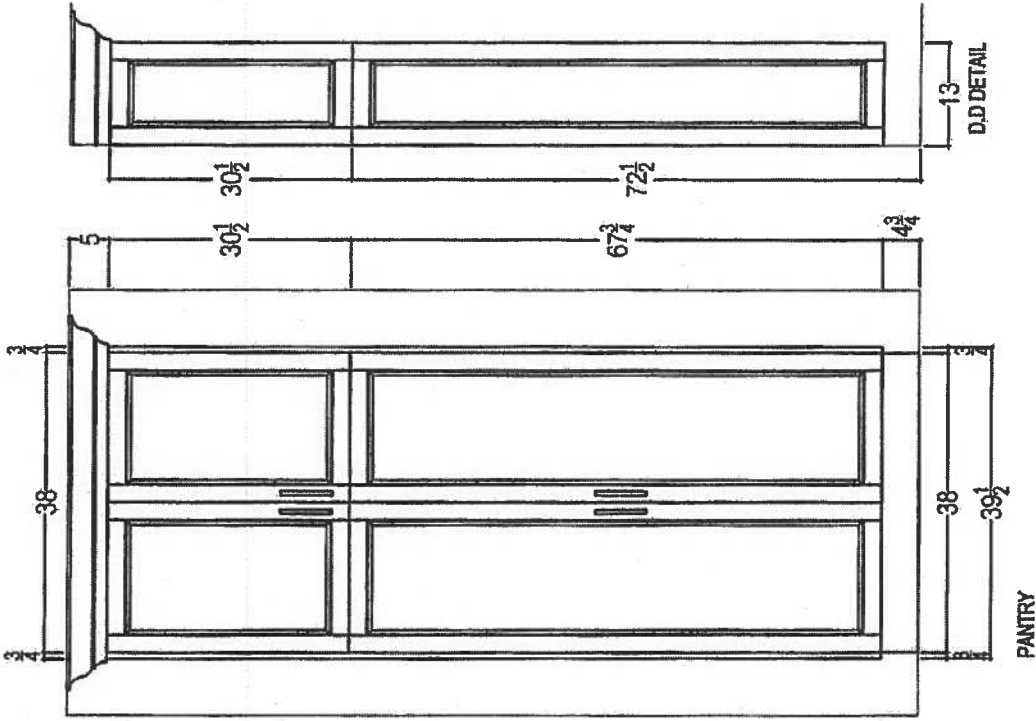

your kitchen. your taste.
80 SANTE DRIVE VAUGHAN, ON L4K 3C4,
T: 416.746.1811 F: 905.761.5901

CLIENT: ROYAL PINE HOMES

SITE: HAMPTON PLACE

PHONE: —

EMAIL: —

UNIT 104 HMP

DOOR STYLE: —

FINISH: —

SPECIES: —

ROOM: KITCHEN

DOOR HANDLE: —

DRW HANDLE: —

TOP: —

DRAWN BY: SK


SCALE: 1/2" = 1'-0"

DATE: DEC 5, 2017

PAGE: —



COMMENTS:

PLEASE NOTE ALL DIMENSIONS
ARE NOT FINAL AND ARE
SUBJECT TO CHANGE UPON
FINAL SITE MEASURE

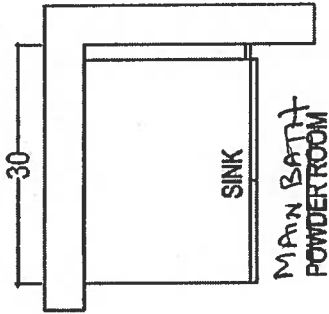


MAIN BATH POWDERROOM

RAISED HEIGHT
INSTALL 3" SPLASH

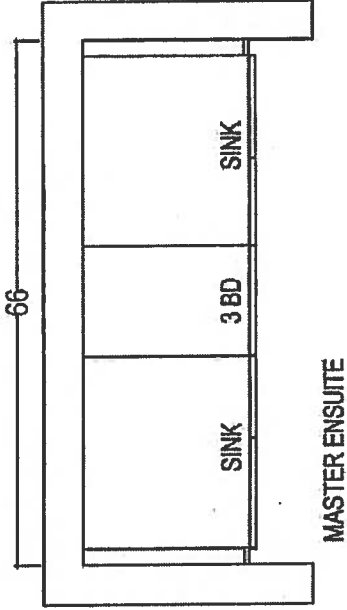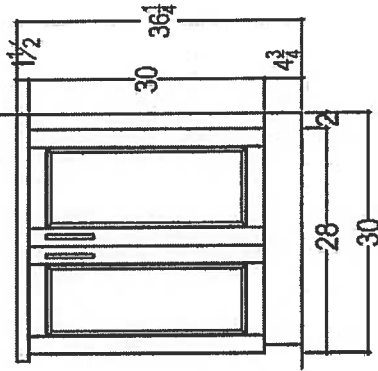

RAISED HEIGHT
INSTALL 3" SPLASH

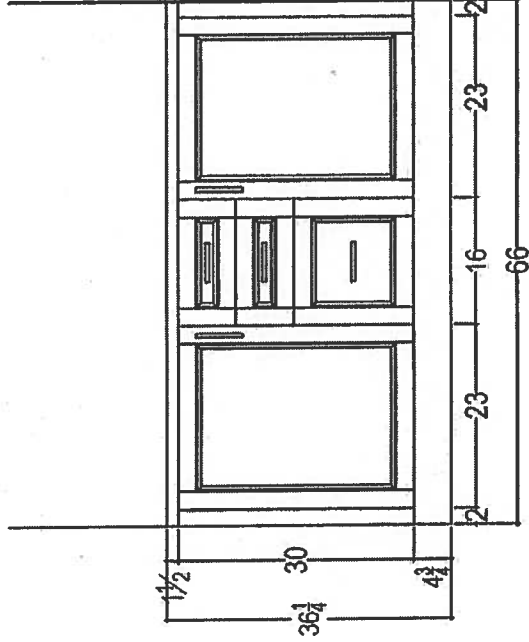

your kitchen, your taste.
80 SANTE DRIVE, VAUGHAN, ON L4K 3C4.
T: 416.746.1811 F: 805.781.5901

CLIENT: ROYAL PINE HOMES		JOB NAME: UNIT 104 HMP	ROOM:	VANITIES*	DRAWN BY: SK	COMMENTS:
SITE: HAMPTON PLACE	DOOR STYLE: ---	DOOR HANDLE: ---	DOOR HANDLE: ---	SCALE: 1/2" = 1'-0"		
PHONE: ---	FINISH: ---	DRW HANDLE: ---	DRW HANDLE: ---	DATE: NOV 6, 2017		
EMAIL: ---	SPECIES: ---	TOP: ---	TOP: ---	PAGE: ---		

SUITE 104
HAMPTON

CONNOLLY Marble & Granite Ltd.

EDGE
DETAILS

004

A.



STRAIGHT EDGE
(STANDARD - 3/4")

* KITCHEN *


* MASTER ENSUITE *

* MAIN BATH *

km


km

~~I.~~

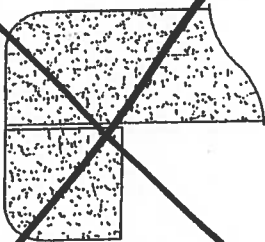

~~DOUBLE TOP "D" EDGE
(STANDARD - 1 1/2")~~

~~III.~~

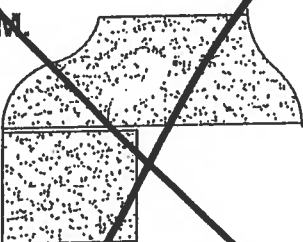


~~OGEE - SQUARE EDGE
(MED./HIGH - 1 1/2")~~

EDGING UP-GRADE OPTIONS




Suite 104

Hampton

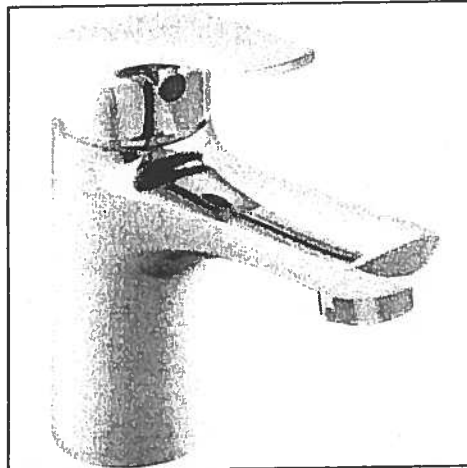


Delta Wynne Chrome Single Lever
Lavatory Faucet With Pop Up
#534LF


MASTER (x2)
MAIN BATH (x1)
STANDARD

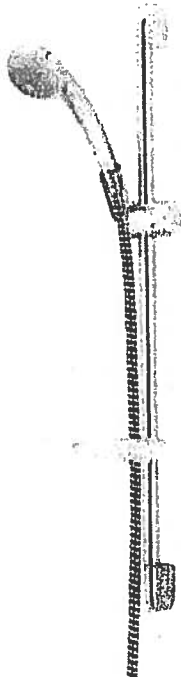


MAIN BATH
STANDARD

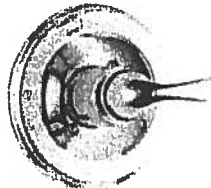

Delta Shower Trim with Tub Spout and
Hansgrohe Slide Bar with Handheld
#R10000/T13020-CDN/2001-TP/27454002/
27744000

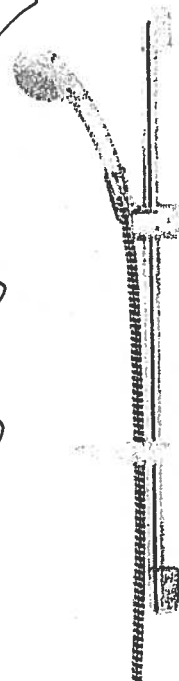

MASTER ENSUITE
↑
FROM
WALL.

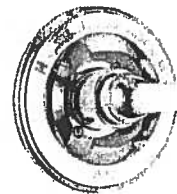

Delta Shower Trim ~~with Tub Spout~~ and
Hansgrohe Slide Bar with Handheld and
Wall Mount Showerhead
#R10000/T13020-CDN/27454002/
27744000/RP52382/RP46870/RP6025/
R11000/T11800

UPGRADE PACKAGE #1 w/ UPGRADE FRIDGE (SPECIAL)


RF170WDRUX5-ActiveSmart™ Refrigerator - 17 cu ft Counter Depth Bottom Freezer w... Page 1 of 3

☒ Fisher & Paykel Appliances

HAMPTON

SUITE 104

~~AM~~ ~~AM~~

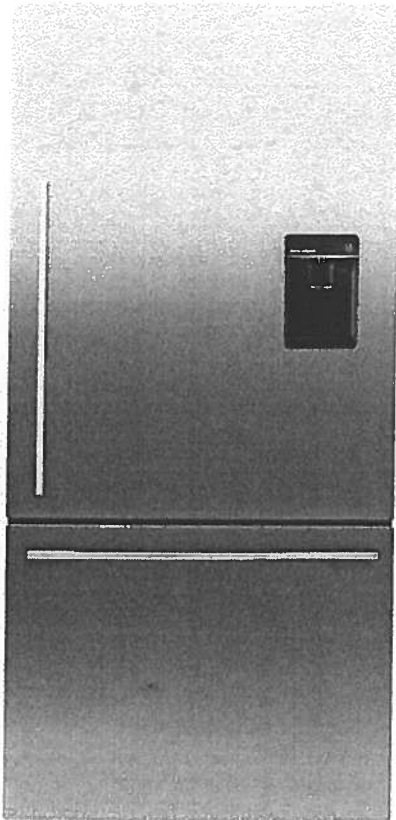

RF170WDRUX5

ActiveSmart™ Refrigerator - 17 cu ft Counter Depth Bottom Freezer with Ice & Water

This refrigerator has been designed for what you use most often. The upper refrigerator enables easy access to everyday items. The 17 cu ft Bottom Mount includes ergonomic storage bins and glass shelves that can be configured to suit every lifestyle. The lower drawer-based freezer ensures that longer-term storage items are just as easy to access.

67 17/32 31 3/32 27 3/8in
H W D

HAMPTON

SUITE 104



ActiveSmart™ FoodCare

Easy Living

These fridges adapt to suit your lifestyle by streamlining food preparation and organisation with SmartTouch controls, flexible shelving and storage options and slide out bins and trays.

Sized to Suit

Available in multiple widths, these fridges are sized to suit families and kitchens, large and small. Designed to fit easily in your kitchen, they can sit flush with your bench top with a range of ultra flat or curved doors. Concealed hinges on many models add to a clean, refined appearance.

Easy Cleaning

Removable, spill safe glass shelves are easy to clean and contain drips and spills. Storage bins and EZKleen stainless steel doors just need a wipe to keep spotless.

Specs

Configuration	Consumption Data	Design	Dimensions
Adjustable glass shelves	Energy usage (kWh/yr) 535	Bottom mount freezer	Height - incl. feet and hinge cap 67 1/2in
Adjustable roller feet	Premium Energy Efficiency - Energy Star	Concealed hinge	Width 31 1/8in
Clear freezer bins 3		Door opening	Depth - including handle 28 3/4in
Counter depth		Available left and right	Depth - door closed not including handle 27 3/8in
Covered door shelves 2		EZKleen stainless steel	Minimum air clearance - each side 3/4in
Four shelves (incl above vegetable area)		Flat door design	Minimum air clearance - at rear (incl. compressor tray) 1 1/8in
Front levelling feet		Silver prepaint cabinet	Minimum air clearance - on top 2in
Full extension freezer drawer		Stainless steel doors	Refrigerator volume 12.3 cu.ft
Full extension runners		Straight designer handle	Freezer volume 4.8 cu.ft
Full width adjustable door shelves 2			Total gross volume 17.1 cu.ft
Half width adjustable door shelves 2			
Humidity controlled half-width crisper bins 2			
Ice bin and scoop			
Rear rollers			
Roll out freezer tray			
Single bottle holders 2			

WEE745H0FS

Upgrade
Package I

HAMPTON


SUITE 104

[Signature]

Whirlpool®

<http://www.whirlpool.com>

4 Cu. Ft. Slide-In Electric Range with True
Convection

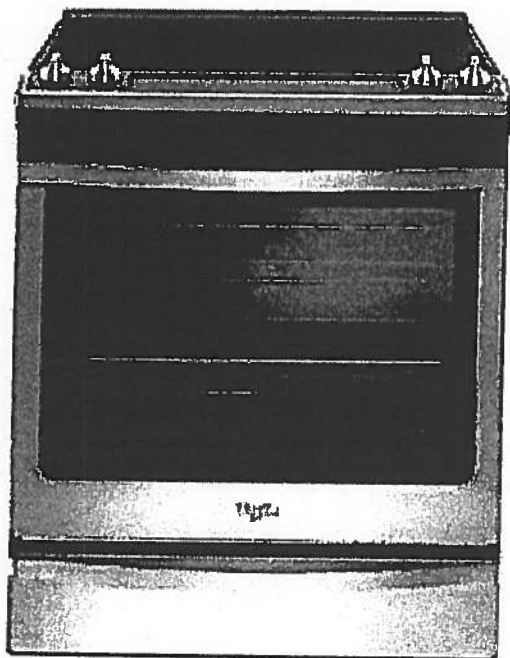

Key Features:

- Frozen Bake™ Technology
- True Convection Cooking
- FlexHeat™ Triple Radiant Element
- Convection Conversion
- AquaLift® Self-Cleaning Technology
- Temperature Sensor
- Rapid Preheat
- 6.4 Cu. Ft. Capacity
- Easy-Wipe Ceramic Glass Cooktop
- Large Oven Window
- Max Capacity Rack
- Hidden Bake Element

Product Dimensions:

Height: 36

Width: 29 7/8

Additional Information:

[Use And Care Guide](#)

[Dimension Guide](#)

[Installation Guide](#)

[Warranty Certificate](#)

INVESTED
IN
AMERICA

ADA
Compliant

©Registered trademark/TM Trademark of Whirlpool, U.S.A. © 2016 Whirlpool Corporation. All Rights Reserved.
All other trademarks are owned by their respective companies.
Because Whirlpool Corporation policy includes a continuous commitment to improve our products, we reserve
the right to change materials and specifications without notice. We also reserve the right to discontinue or
transition products without notice.
Manufacturer's Suggested Retail Price (MSRP) and Minimum Advertised Price (MAP) provided for reference
purposes only. Dealer alone determines advertised and retail prices.
Created On: Friday, January 27, 2017 10:46:47

Upgrade Package 1

HAMPTON
SUITE 104

mu sm

YWMH76719CS

1.9 cu. ft. Microwave Hood Combination with
TimeSaver™ Plus True Convection



<http://www.whirlpool.com>

Key Features:

- TimeSaver™ Plus True Convection Cooking System
- Steam Cooking
- Sensor Cooking
- AccuPop™ Cycle
- CleanRelease® Non-Stick Interior
- SteamClean Option
- Integrated Hidden Vent and Console
- Auto Adapt Fan
- Recessed, Stoppable Glass Turntable
- Universal Microwave Steamer
- 1.9 cu. ft. Capacity
- 1,100 Watts Cooking Power

Product Dimensions:

Height: 17 1/8

Width: 29 15/16

Depth: 18 1/2

Electrical Requirements:

15 or 20. 120 V.

Additional Information:

Use And Care Guide

Installation Guide

Warranty Certificate

Available in:

☒ Stainless Steel



©Registered trademark/TM Trademark of Whirlpool, U S A. © 2013 Whirlpool Corporation. All Rights Reserved
All other trademarks are owned by their respective companies.
Because Whirlpool Corporation policy includes a continuous commitment to improve our products, we reserve the right to change materials and specifications without notice. We also reserve the right to discontinue or transition products without notice.
Manufacturer's Suggested Retail Price (MSRP) and Minimum Advertised Price (MAP) provided for reference purposes only. Dealer alone determines advertised and retail prices.
Created On: Monday, March 14, 2016 13:16:48

Upgrade Package 1

HAMPTON

SUITE 104  

WDTA50SAHZ

Contemporary Design. Stainless Steel Tub
Dishwasher with TotalCoverage Spray Arm

Whirlpool®

<http://www.whirlpool.com>

Key Features:

- Sensor Cycle
- TotalCoverage Spray Arm
- 1-Hour Wash Cycle
- Tap Touch Controls

Product Dimensions:

Height: 34 1/2

Width: 23 7/8

Depth: 24 1/2

Additional Information:


[Use And Care](#)

[Dimension Guide](#)

[Installation Guide](#)

[Energy Guide](#)

[Warranty](#)

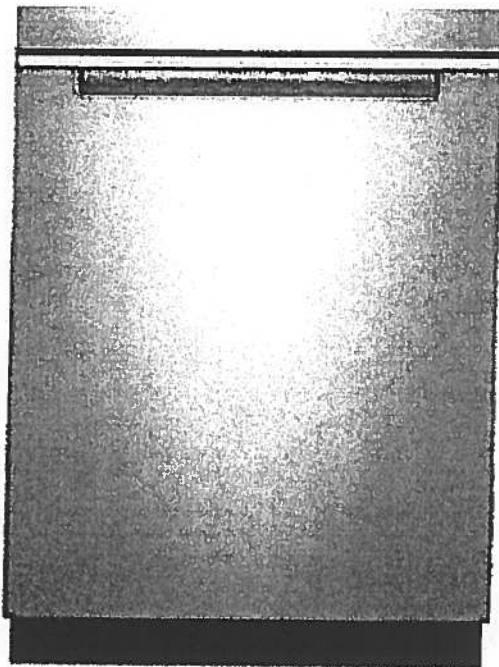

Available in:

☒ Black

Fingerprint Resistant Sunset Bronze

Fingerprint Resistant Black Stainless

☐ White

☐ Fingerprint Resistant Stainless Steel

INVESTED
IN
AMERICA



©Registered trademark/TM Trademark of Whirlpool, U.S.A. © 2016 Whirlpool Corporation. All Rights Reserved. All other trademarks are owned by their respective companies.

Because Whirlpool Corporation policy includes a continuous commitment to improve our products, we reserve the right to change materials and specifications without notice. We also reserve the right to discontinue or transition products without notice.

Manufacturer's Suggested Retail Price (MSRP) and Minimum Advertised Price (MAP) provided for reference purposes only. Dealer alone determines advertised and retail prices.

Upgrade Package I

HAMPTON


SUITE 104 *[Signature]*

WFW75HEFW

5 cu. ft. Front Load Washer with Precision
Dispense



<http://www.whirlpool.com>

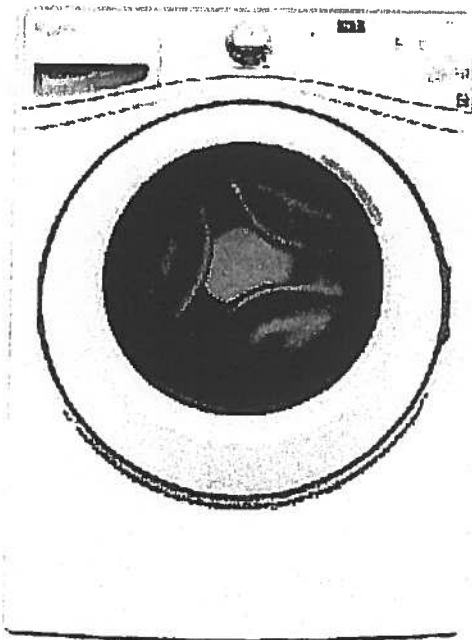

Key Features:

- Precision Dispense
- Adaptive Wash Technology
- Smooth Wave Stainless Steel Wash Basket
- 4.5 cu. ft. Capacity
- ENERGY STAR® Qualified

Product Dimensions:

Height: 39 3/4

Width: 27

Depth: 33 5/16

Electrical Requirements:

15 or 20. 120 V.

Additional Information:

[Use And Care Guide](#)

[Dimension Guide](#)

[Installation Guide](#)

[Energy Guide](#)

[Warranty Certificate](#)

INVESTED
IN
AMERICA



©Registered trademark/TM Trademark of Whirlpool, U.S.A. ©2013 Whirlpool Corporation All Rights Reserved.
All other trademarks are owned by their respective companies.
Because Whirlpool Corporation policy includes a continuous commitment to improve our products, we reserve
the right to change materials and specifications without notice. We also reserve the right to discontinue or
transition products without notice.
Manufacturer's Suggested Retail Price (MSRP) and Minimum Advertised Price (MAP) provided for reference
purposes only. Dealer alone determines advertised and retail prices.
Created On: Wednesday, March 23, 2016 11:51:03

Upgrade
Package 1

Hampton

Suite 104

Am

emo


YWED75HEFW

7.4 cu. ft. Duet® High Efficiency Front Load Electric
Dryer with ENERGY STAR®

MSRP: \$0.00

Whirlpool®

<http://www.whirlpool.com>

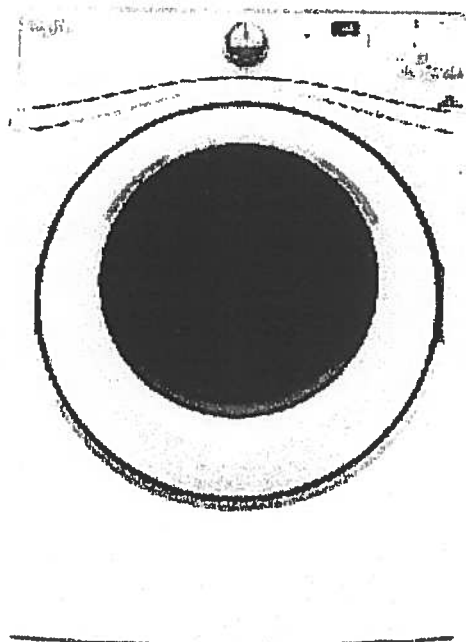

Key Features:

- Advanced Moisture Sensing System
- Quad Baffles
- Tap Touch Controls with Memory
- EcoBoost™ Option
- Wrinkle Shield™ Plus Option
- Undercounter Installation
- 7.4 Cu. Ft. Capacity
- ENERGY STAR® Qualified

Product Dimensions:

Height: 39

Width: 27

Depth: 31

Additional Information:

Use And Care

Installation Guide

Warranty

Available in:

☐ White

INVESTED
IN
AMERICA

ADA
Compliant

®Registered trademark/TM Trademark of Whirlpool, U.S.A. © 2016 Whirlpool Corporation. All Rights Reserved. All other trademarks are owned by their respective companies.

Because Whirlpool Corporation policy includes a continuous commitment to improve our products, we reserve the right to change materials and specifications without notice. We also reserve the right to discontinue or transition products without notice.

Manufacturer's Suggested Retail Price (MSRP) and Minimum Advertised Price (MAP) provided for reference purposes only. Dealer alone determines advertised and retail prices.