





Montauk

#105


988 SQ FT *plus* 61 sq. ft. of balcony area

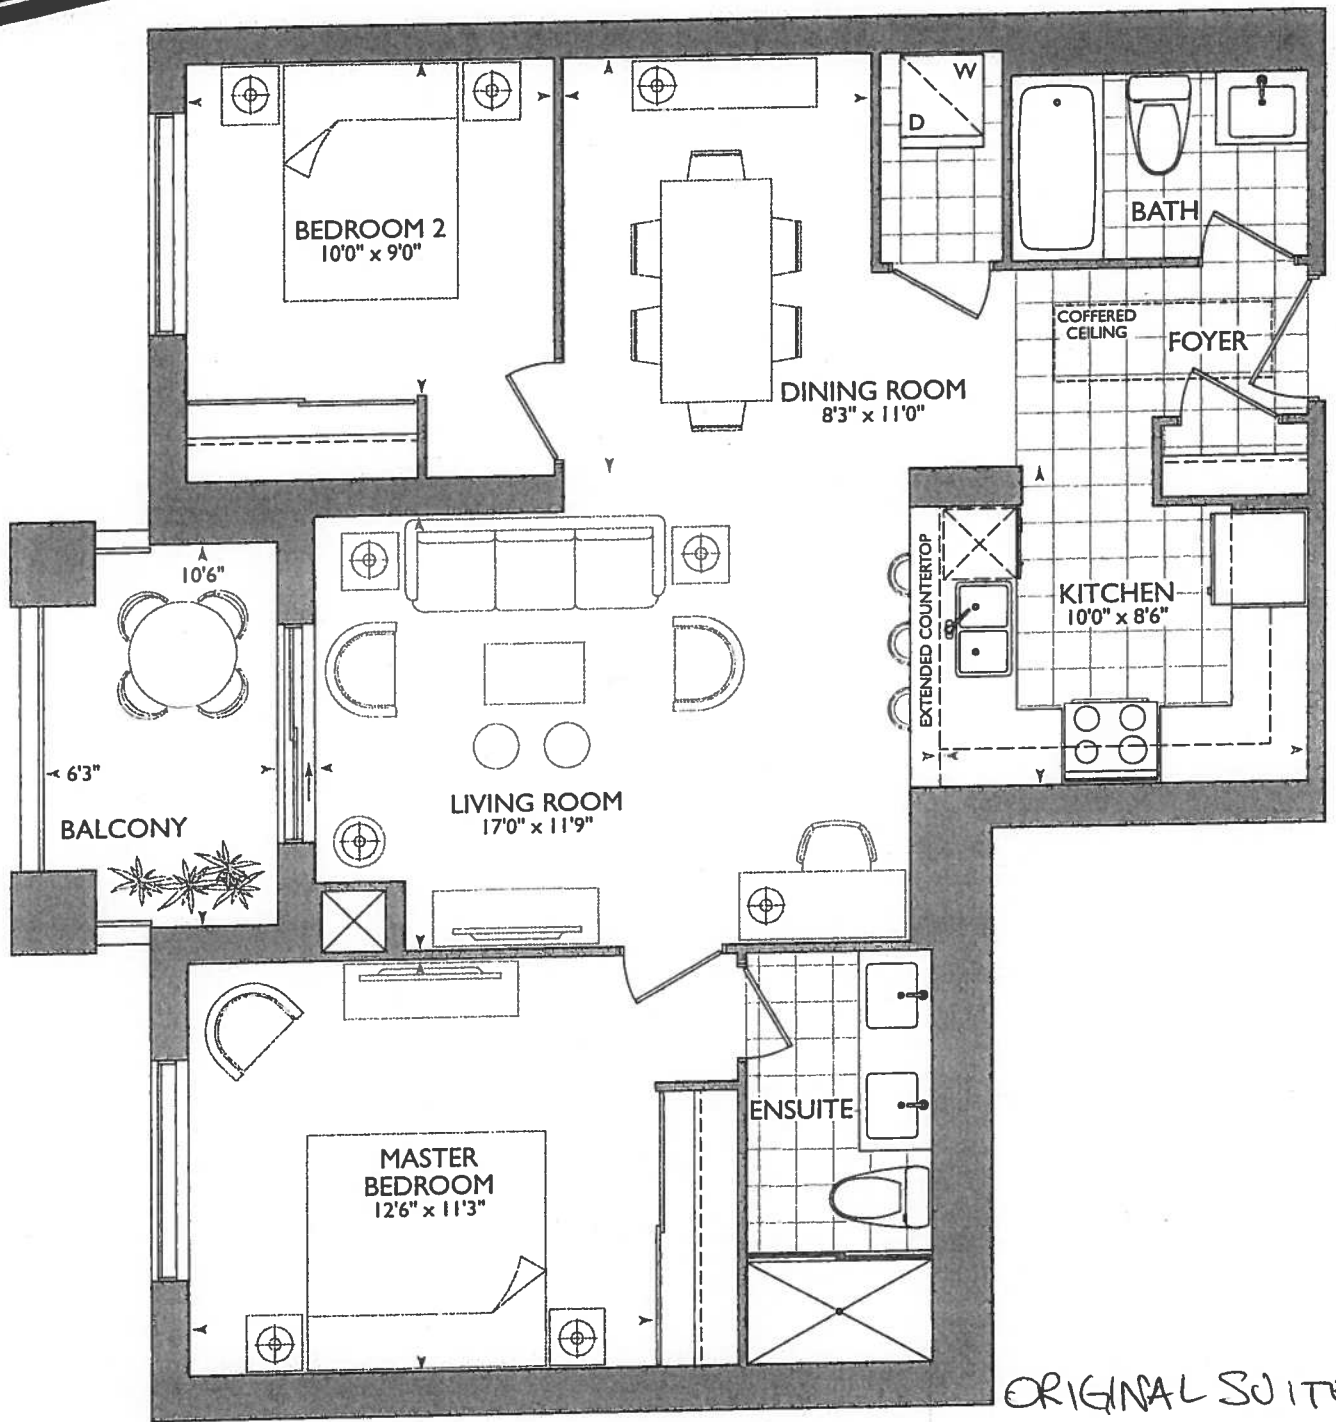


ORIGINAL SUITE

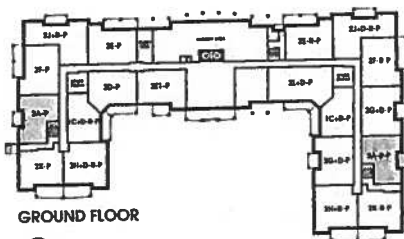

GROUND FLOOR

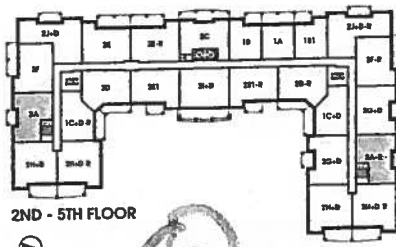

2ND - 5TH FLOOR

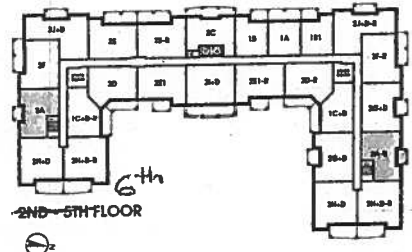


6th
2ND - 5TH FLOOR



October 18, 2017

(11/11/17)
Bath

CHILD & ADULTITY W/ BETH AND WASHER

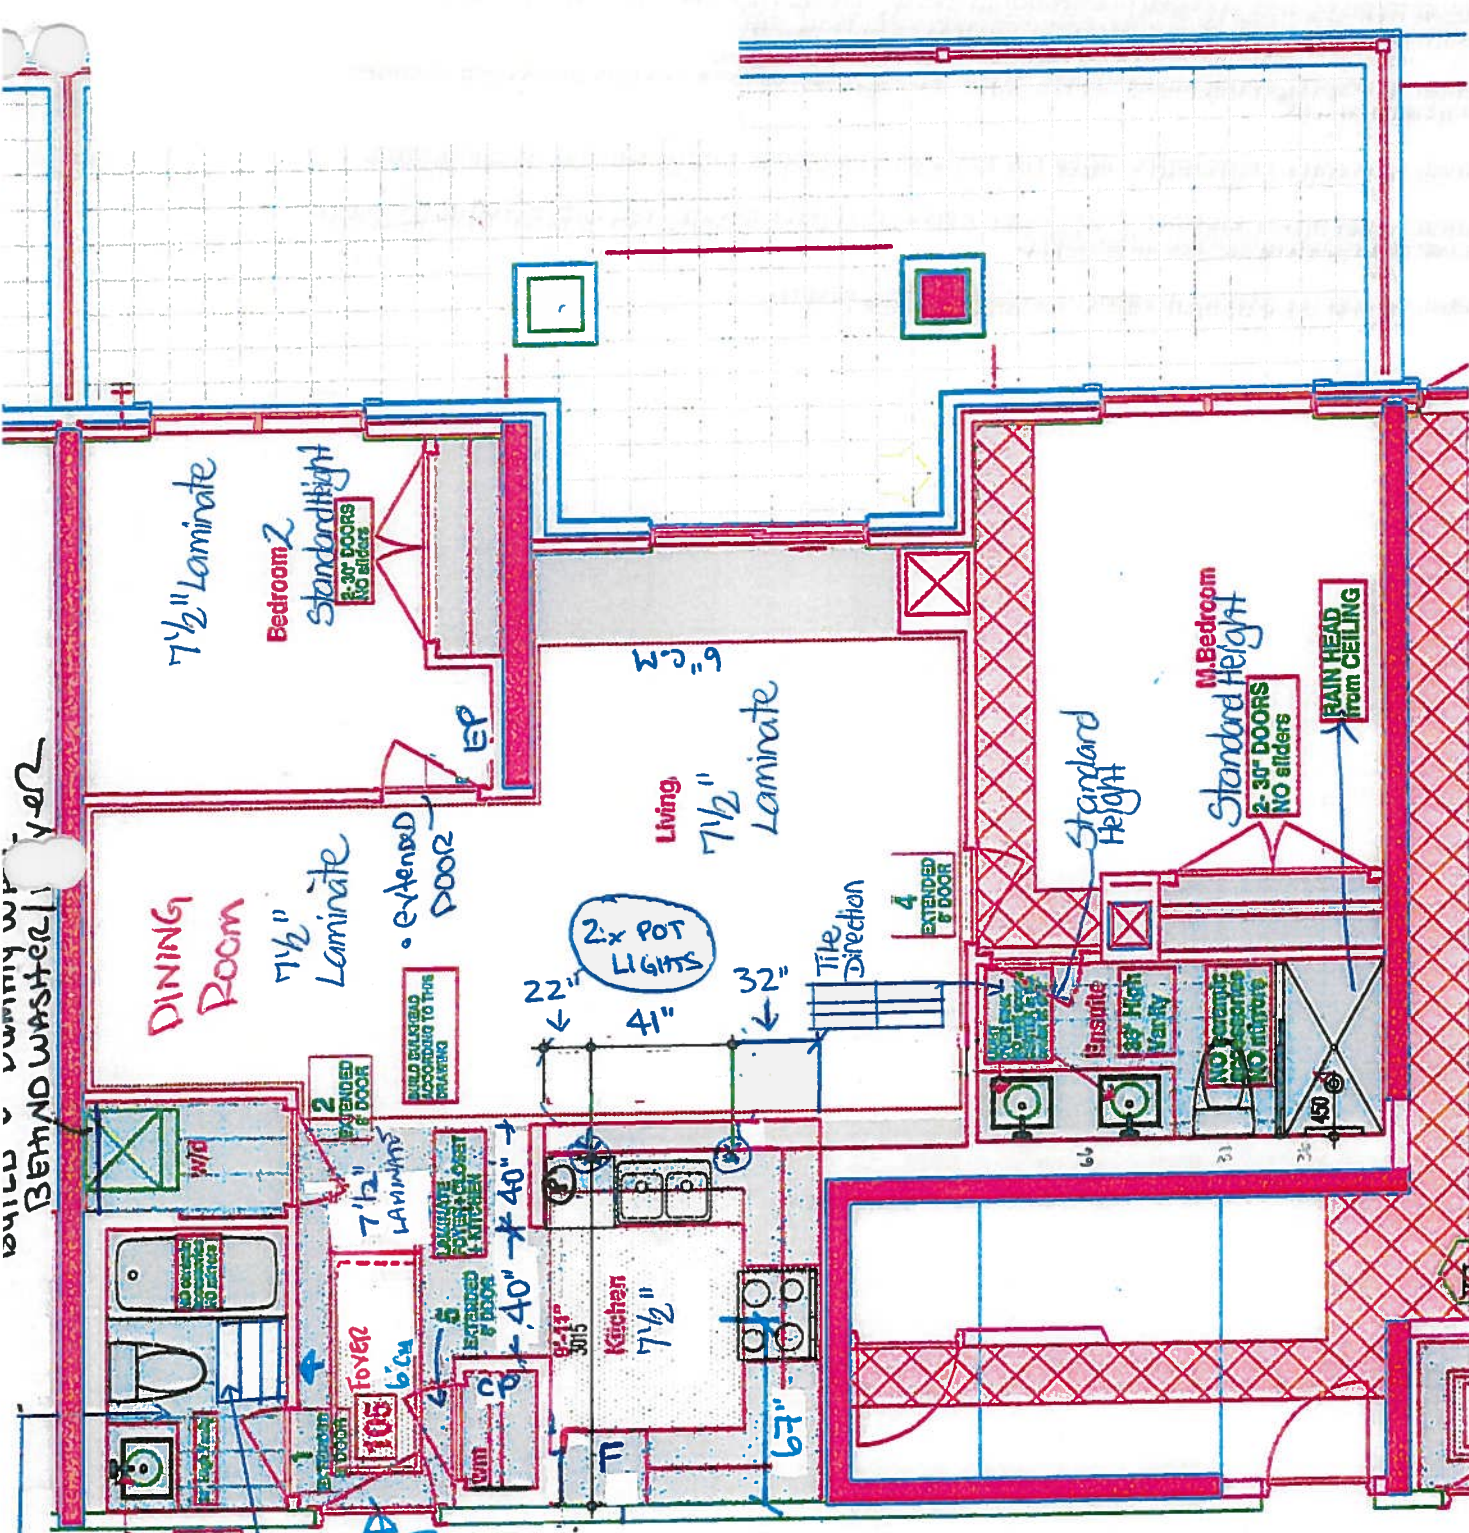

* Reduce
FOYER ENTRANCE
BY 5" (DUE TO
KITCHEN MEASUREMENT)
EXTENDED HEIGHT DOORS (x5)
EXCLUDING CLOSETS IN
MASTER BEDRM @ BEDRM 2
@ ENSUITE DOOR

- Kitchen**
- 67" STOVE PIPE CENTER
 - 115" SINK PIPE CENTER
 - (4x) - PUCK LIGHTS
 - (P) = PLUG ON WALL OVER DISHWASHER
 - (2x) = POTS OVER PENINSULA
 - RAISED MAIN @ ENSUITE VANITIES 36 1/4 (Delete 3" splash)

RECEIVED
10/25/17



Hampton Place

PURCHASER: DIMITRIOS SISTANIS

TEL: RES.: 905-591-2000

Offer	VENDOR TO INSTALL RAINHEAD FROM CEILING IN MASTER ENSUITE.
Upgrade	Note:



SITE COPY

CONSTRUCTION SUMMARY

Hampton Place

PURCHASER: DIMITRIOS SISTANIS

TEL: RES.: 905-591-2000

LOT NUMBER	PHASE	HOUSE TYPE	CLOSING DATE
105	1	MONTAUK*	05-Sep-18

Date Added: 23-Nov-17

Invoice Number: 6977

1 - CLARIFICATION;
ER BEDROOM CLOSET, MASTER ENSUITE & BEDROOM #2 CLOSET - Purchaser has DECLINED Upgrade to Extend Height of the
Doors at the Master Bedroom Closet, Master Ensuite & Bedroom #2 Closet.
Note: Purchaser accepts & acknowledges Standard Height Interior Doors will be installed at; Master Bedroom Closet, Master Ensuite
and Bedroom #2 Closet.
Vendor is Exempt

1 - CLARIFICATION;
DINING ROOM - Standard Crown Moulding to continue throughout perimeter of Dining Room,where applicable. (See Sketch)
Note: As per Vince at Head-Office

1 - KITCHEN & BATHROOMS - Purchaser has DECLINED All Upgrades offered during decor centre appointment at the decor centre for kitchen &
bathroom cabinetry. Standard Kitchen Layout & Standard Bathroom Vanities to be installed as per standard layout.
Note: (See Sketch)

1 - KITCHEN - CABINETRY - Install UPGRADE PACKAGE 3 - Category 4G - Fiberboard Cloud White with Sky Linen Glaze QT 4801 - To be
installed throughout kitchen, where applicable. (See Sketch)
Note:

1 - MAIN BATH- CABINETRY - Install UPGRADE PACKAGE 3 - Category 4G - Fiberboard Asphalt with Black Linen Glaze QT 4801 - To be
installed throughout main bath vanity, where applicable. (See Sketch)
Note:

1 - MASTER ENSUITE - CABINETRY - Install UPGRADE PACKAGE 3 - Category 4G - Fiberboard Asphalt with Black Linen Glaze QT 4801 - To
be installed throughout master ensuite vanity, where applicable. (See Sketch)
Note:

1 - KITCHEN - Install UPGRADE " I " EDGING - Throughout kitchen countertop where applicable. (See Sketch)
Note:

1 - MAIN BATH - Install UPGRADE " I " EDGING - Throughout main bath vanity countertop where applicable. (See Sketch)
Note:

1 - MASTER ENSUITE - Install UPGRADE " I " EDGING - Throughout master ensuite vanity countertop where applicable. (See Sketch)
Note:

35 - KITCHEN - Kitchen Backsplash - Upgrade 3 - 12x12 ORIENTAL WHITE STRIPS MOSAICS - To be installed throughout kitchen where
applicable. (Does not include behind fridge or stove) (See Sketch)
Note:

1 - KITCHEN - Kitchen Sink - Install Upgrade Undermount Sink - BLANCO Quatrus U Super Single Undermount Sink - Model # 401248 (See
Sketch)
Note:

1 - KITCHEN - Kitchen Faucet - Install Upgrade Faucet - DELTA - MATEO Pull-Down Kitchen Faucet (Single Hole) - Model # 9183-DST-AR
(Arctic Stainless) (See Sketch)

1 - APPLIANCE PACKAGE - Install Upgrade Appliance Package - UPGRADE APPLIANCE PACKAGE # 1 - To be installed throughout suite, where
applicable. (See Sketch)
Note:

30 - MAIN BATH - 1ST UPGRADE - PORCELAIN TILE - 12x24 H-STONE LIGHT GREY - To be installed throughout main bath floor. (To be
Installed Straight) (See Sketch)
Note: Includes Larger Size

85 - MAIN BATH - 1ST UPGRADE - PORCELAIN TILE - 12x24 H-STONE LIGHT GREY - To be installed throughout main bath tub/showrer
enclosure. (To be Horizontally / Stacked) (See Sketch)
Note: Includes Larger Size



SITE COPY

CONSTRUCTION SUMMARY

Hampton Place

PURCHASER: DIMITRIOS SISTANIS

TEL: RES.: 905-591-2000

LOT NUMBER	PHASE	HOUSE TYPE	CLOSING DATE	
105	1	MONTAUK*	05-Sep-18	

Date Added: 23-Nov-17

Invoice Number: 6977

45 - MASTER ENSUITE - 1ST UPGRADE - PORCELAIN TILE - 12x24 H-STONE LIGHT GREY - To be installed throughout master ensuite floor.
Installed Straight) (See Sketch)
Includes Larger Size

105 - MASTER ENSUITE - 1ST UPGRADE - PORCELAIN TILE - 12x24 H-STONE LIGHT GREY - To be installed throughout master ensuite shower stall. (To be Horizontally / Stacked) (See Sketch)
Note: Includes Larger Size

1 - CLARIFICATION;
MAIN BATH & MASTER ENSUITE - Install RAISED VANITY HEIGHT - Throughout all bathrooms where applicable. To Include; Main Bath and Master Ensuite (Upgrade Included in APAS) (See Sketch)
Note:

1 - CLARIFICATION;
MAIN BATH & MASTER ENSUITE - Install Builders Standard Plumbing Fixtures throughout all bathrooms where applicable. To Include; Main Bath and Master Ensuite (See Sketch)
Note:

1 - CLARIFICATION;
MAIN BATH & MASTER ENSUITE - DELETE Standard 3" Splash throughout all bathrooms vanity countertops, where applicable. To Include; Main Bath and Master Ensuite (See Sketch)
Note:

1 - PURCHASER HAS ATTENDED A COLOR APPOINTMENT AT THE DECOR CENTRE AND HAS DECLINED ANY ADDITIONAL UPGRADES. Purchaser accepts and acknowledges that there will be no further changes/additions/deletions to be made upon signing on October 1st.
Note:

1 - PURCHASER AWARE AND ACCEPTS THAT ANY CHANGES MADE TO UPGRADES AFTER SIGNING THIS PURCHASERS EXTRA FORM ARE SUBJECT TO A MINIMUM ADMINISTRATION FEE OF \$1,000 PLUS A 10% HOLDBACK FEE.
Note:

Date Added: 26-Oct-17

Invoice Number: 6984

1 - KITCHEN - Install WATER LINE ROUGH-IN ONLY for Fridge at Kitchen. (See Sketch)
Note:

1 - CLARIFICATION;
MASTER ENSUITE - Purchaser accepts & acknowledges the standard glass at master ensuite shower stall will NOT touch the ceiling and will receive a Standard Chrome Header. (See Sketch)
Note:

1 - PURCHASER AWARE AND ACCEPTS THAT ANY CHANGES MADE TO UPGRADES AFTER SIGNING THIS PURCHASERS EXTRA FORM ARE SUBJECT TO A MINIMUM ADMINISTRATION FEE OF \$1,000 PLUS A 10% HOLDBACK FEE.
Note:

This Document is Extremely Time Sensitive - Printed 22 Jan 18 at 15:51



* INTERIOR COLOR SCHEME *

Purchaser DIMITRIOS SISTANIS		Decor Consultant Melissa Di Marino	Model Type MONTAUK*	Telephone Res. / Bus (905) 591-2000 /	Project Hampton Place	Closing Date 05/09/2018	Unit 105
---------------------------------	--	---------------------------------------	------------------------	--	--------------------------	----------------------------	-------------

Page 1 of 3

	Flooring		Wall Tile		
	Description		Main	Accent/Insert	Pattern
MASTER ENSUITE	12x24 H-STONE LIGHT GREY (Upg)(Straight)	✓	12x24 H-Stone LightGrey (Upg)(Horizontal)	NONE	NONE
MAIN BATHROOM	12x24 H-STONE LIGHT GREY (Upg)(Straight)	✓	12x24 H-Stone LightGrey (Upg)(Horizontal)	NONE	NONE
POWDER ROOM	N/A		N/A	N/A	N/A
KITCHEN / DINETTE	7 1/2" TorleysForest -NorthernCordillera 9687-P(STD)	✓	12x12 Oriental White Strips Mosaics (UPG)	NONE	NONE
FOYER	7 1/2" TorleysForest -NorthernCordillera 9687-P(STD)	✓	N/A	N/A	N/A
LAUNDRY	8x8 BEHRAM PINK (STD)	✓	N/A	N/A	N/A
LIVING ROOM	7 1/2" TorleysForest -NorthernCordillera 9687-P(STD)	✓			
DINING ROOM	7 1/2" TorleysForest -NorthernCordillera 9687-P(STD)	✓			

Notes

INTERIOR DOORS - Install Extended Height Doors at: Front Closet, Main Bath, Laundry Closet, Master Bedroom and Bedroom #2
INTERIOR DOORS - Install Standard Height Doors at: Master Bedroom Closet, Master Ensuite and Bedroom #2 Closet

Page 1 of 3

Consultant: 
Melissa Di Marino

Purchaser: 
DIMITRIOS SISTANIS

Vendor: 
Hampton Place
Printed Oct 18, 2017 11:56 am



* INTERIOR CURTAIN SCHEME *

Purchaser DIMITRIOS SISTANIS		Decor Consultant Melissa Di Marino	Model Type MONTAUK*	Telephone Res. / Bus (905) 591-2000 /	Project Hampton Place	Closing Date 05/09/2018	Unit 105
---------------------------------	--	---------------------------------------	------------------------	--	--------------------------	----------------------------	-------------

Page 2 of 3

CABINETS, VANITIES AND COUNTERTOPS

Style	Countertop	Counter Edge	Handle / Knob
✓ CATEGORY 4G - FIBERBOARD - ASPHALT with BLACK LINEN GLAZE QT 4801 (UPG)	✓ ASPEN TERRA WHITE (STD)	1" EDGE (UPG)	39660-195
✓ CATEGORY 4G - FIBERBOARD - ASPHALT with BLACK LINEN GLAZE QT 4801 (UPG)	✓ ASPEN TERRA WHITE (STD)	1" EDGE (UPG)	39660-195
N/A	N/A	N/A	N/A
✓ CATEGORY 4G - FIBERBOARD - Cloud White with Sky Linen Glaze QT 4801 (UPG)	✓ ASPEN TERRA WHITE (STD)	1" EDGE (UPG)	39660-195
N/A	N/A	N/A	N/A

✓ APPLIANCE PACKAGE

Upgrade
Package #1

Std 31in Opening

PLUMBING FIXTURES

KITCHEN
Sink Model
Ubg - Blanco Super Single #401248
Sink Faucet
Ubg - Delta Mateo #9183-DST-AR

TOILETS

Master Ensuite
STANDARD
Main Bathroom
STANDARD
Powder Room
N/A

VANITY FAUCETS

Master Ensuite
STANDARD
Main Bathroom
STANDARD
Powder Room
N/A

VANITY SINKS

Master Ensuite
STANDARD
Main Bathroom
STANDARD
Powder Room
N/A

SHOWER STALL / TUBS

Master Ensuite Shower Stall
STANDARD
Master Ensuite Tub
N/A
Main Bathroom Tub
STANDARD

Trim	Baseboard & Casing	STANDARD	Levers	STANDARD
	Interior Doors	STANDARD - CARRARA, SMOOTH	Door Height	SEE NOTES

Cornice Moulding / Medallion

Foyer	STANDARD - #CTR-611
Living Room	STANDARD - #CTR-611
Dining Room	STANDARD - #CTR-611
Master Bedroom	NONE
Bedroom 2	NONE
Bedroom 3	N/A

Fireplace

Fireplace	N/A
Location Flooring	N/A
Style	N/A
Finish	N/A
Marble	N/A
Hearth	N/A

Paint Throughout

Walls	STANDARD - BIRCH WHITE	Trim	STANDARD - WHITE
-------	------------------------	------	------------------

MISC. INSTALLATIONS

Ceramic Accessories
(installed by Vendor)
☒ Yes ☐ No

Bathroom Mirrors
(installed by Vendor)
☐ Yes ☒ No

Wire Shelving - Closet
(installed by Vendor)
☒ Yes ☐ No

Page 2 of 3

Decor Consultant: Purchaser:

Project: Hampton Place Model: MONTAUK*

Vendor:

Hampton Place
Printed Oct 18, 2017 11:56 am


Suite 105

Hampton

- * (P) = PLUG ON WALL ABOVE DISHWASHER FOR PENINSULA PLUG.
- * (4x) = PUCK LIGHTS.
- * UPG #1 - Appliance PACKAGE
- * MAIN + ENSUITE RAISED VANITY 36 1/4" (NO 3" splash)

* 2 pots ABOVE PENINSULA ON EITHER SIDE OF SINK


* FRIDGE LINE

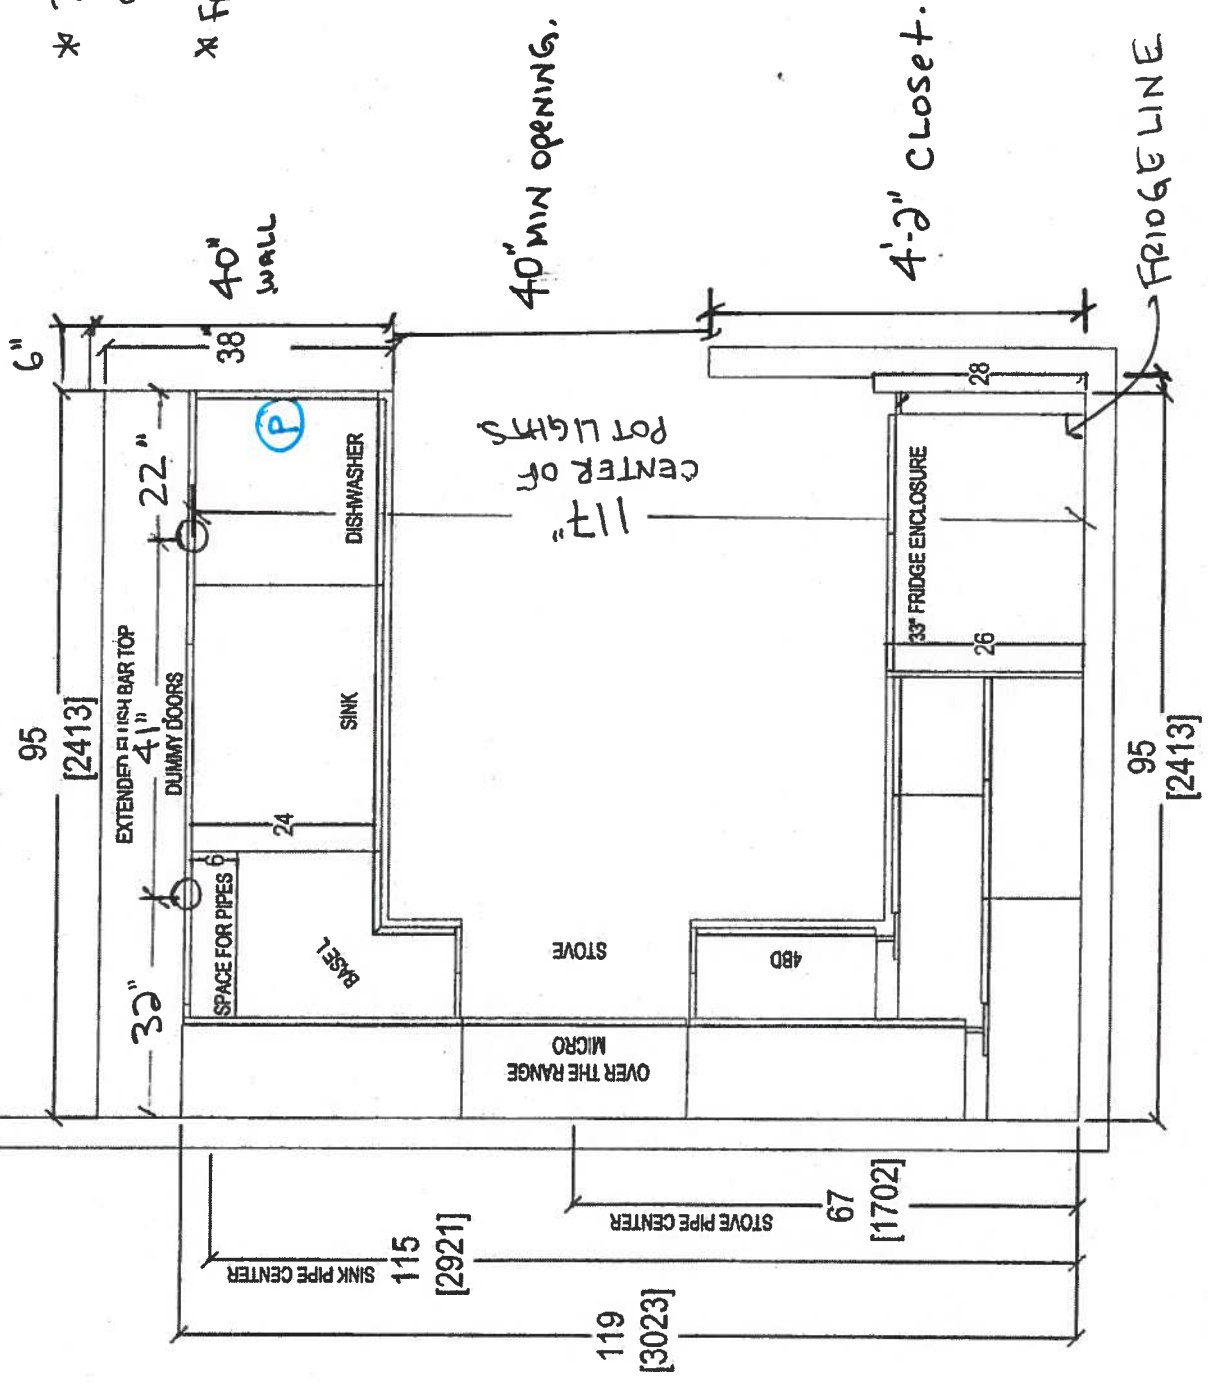

Oct. 23, 2017

 your kitchen, your taste. 80 SANTE DRIVE, VAUGHAN, ON L4K 3C4, T: 416.746.1811 F: 905.761.5901	CLIENT: ROYAL PINE HOMES		UNIT 105 HMP	ROOM:	KITCHEN FLOOR PLAN	DRAWN BY: SK		COMMENTS: 	
	SITE: HAMPTON PLACE	DOOR STYLE: —	DOOR HANDLE: —	DOOR HANDLE: —	SCALE: 1/2" = 1'-0"				
	PHONE: —	FINISH: —	DRW HANDLE: —	DRW HANDLE: —	DATE: OCT 23, 2017				
	EMAIL: —	SPECIES: —	TOP: —	TOP: —	PAGE: —				

Pr - Rock Light


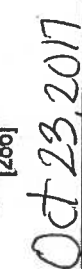


your kitchen your taste.

80 SANTE DRIVE, VAUGHAN, ON L4K 3C4,
T: 416.746.1811 F: 905.781.5901

CLIENT: ROYAL PINE HOMES	UNIT 105 HMP	ROOM: KITCHEN	DRAWN BY: SK	COMMENTS:
SITE: HAMPTON PLACE	DOOR STYLE: —	DOOR HANDLE: —	SCALE: 1/2" = 1' - 0"	
PHONE: —	FINISH: —	DRW HANDLE: —	DATE: OCT 23, 2017	
EMAIL: —	SPECIES: —	TOP: —	PAGE: —	





Suite 105 Hampton

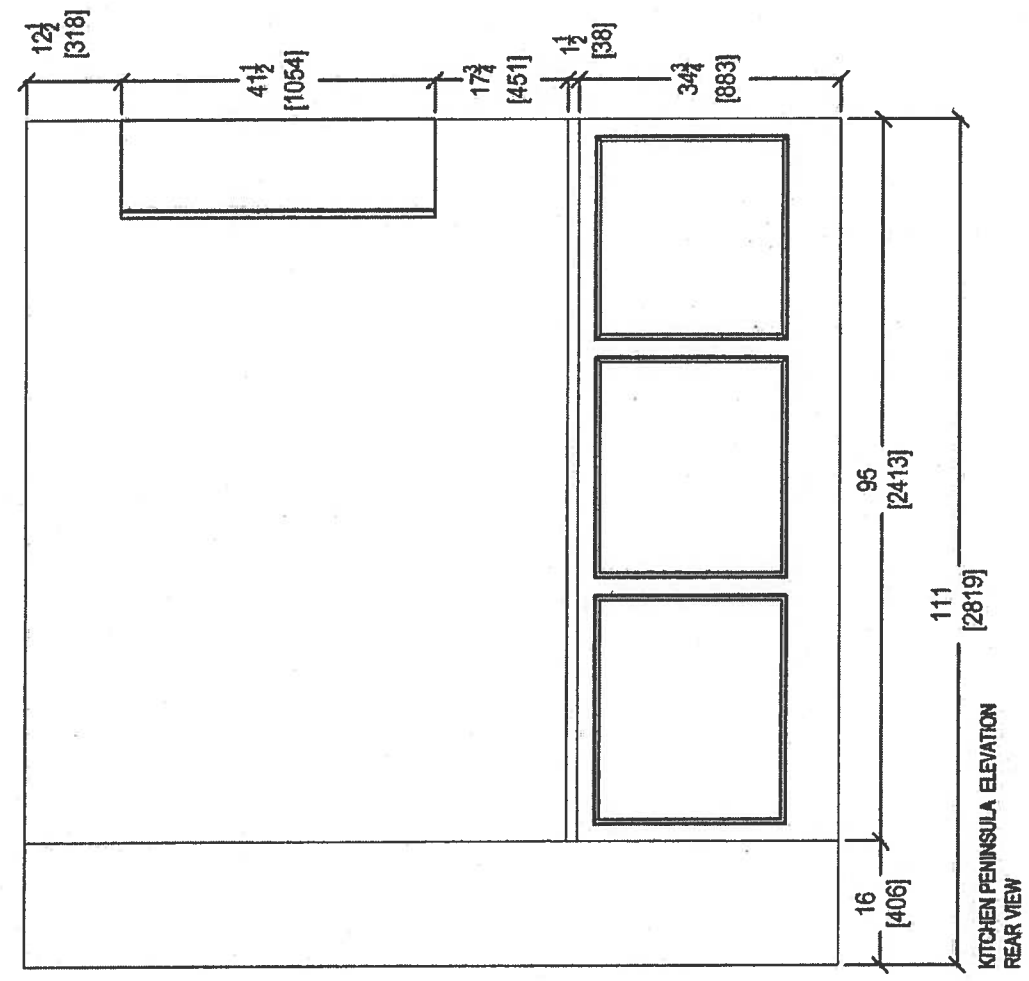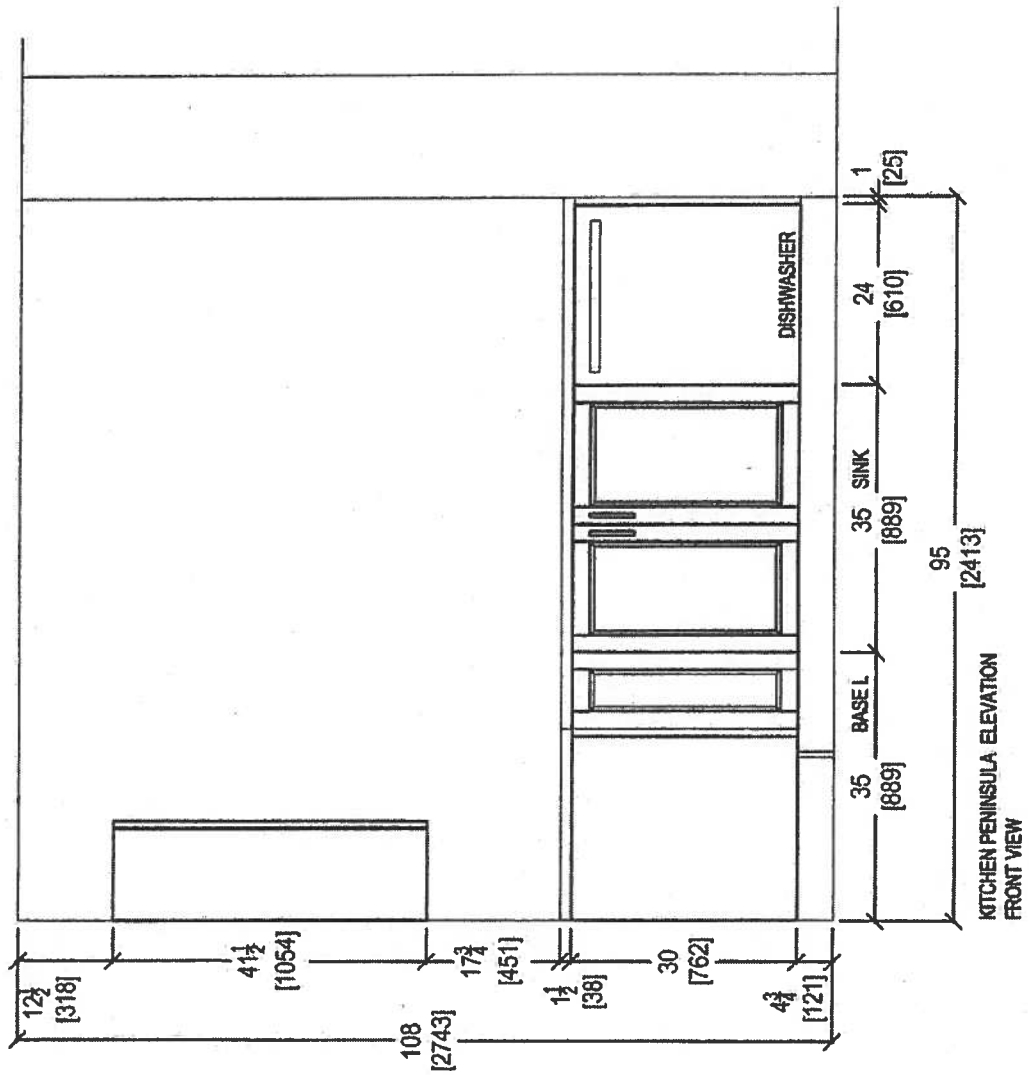

Oct-23, 2017

 your kitchen, your <i>basic</i> 80 SANTE DRIVE, VAUGHAN, ON L4K 3C4 T: 416.746.1811 F: 905.761.5901				CLIENT: ROYAL PINE HOMES SITE: HAMPTON PLACE PHONE: — EMAIL: —	UNIT 105 HMP DOOR STYLE: — FINISH: — SPECIES: —		ROOM: KITCHEN DOOR HANDLE: — DRW HANDLE: — TOP: —	DRAWN BY: SK SCALE: 1/2" = 1' - 0" DATE: OCT 23, 2017 PAGE: —	COMMENTS: ○	
---	--	--	--	---	--	--	---	---	--	--

Suite 105 Hampton

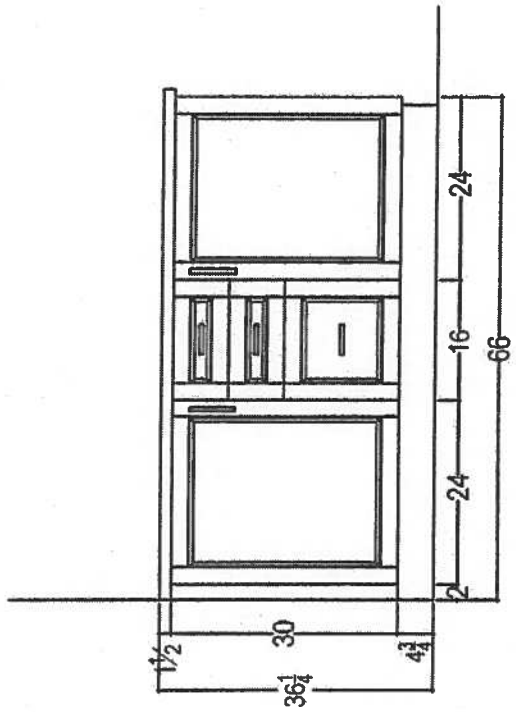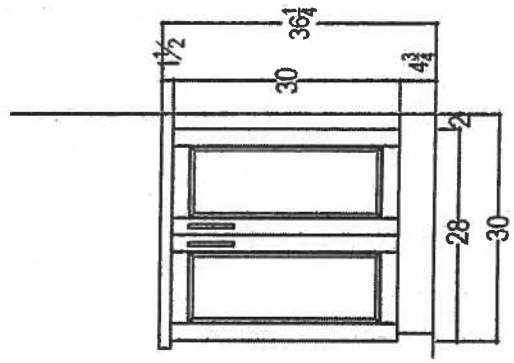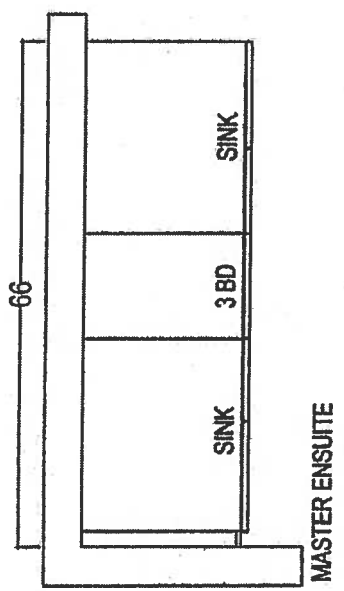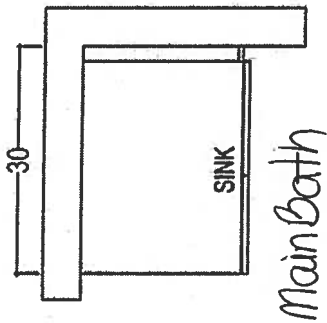

Oct. 23, 2017

 your kitchen your taste 80 SANTE DRIVE, VAUGHAN, ON L4K 3C4, T: 416.740.1811 F: 905.761.5801	CLIENT: ROYAL PINE HOMES	2A MONTAUK UPGRADE PACKAGE	ROOM:	DRAWN BY: SK	COMMENTS:
	SITE: HAMPTON PLACE	DOOR STYLE: —	DOOR HANDLE: —	SCALE: 1/2" = 1' - 0"	
	PHONE: —	FINISH: —	DRW HANDLE: —	DATE: AUG 4, 2017	
	EMAIL: —	SPECIES: —	TOP: —	PAGE: —	


Suite 105
Hampton

Oct. 18, 2017


CONNOLLY Marble & Granite Ltd.

EDGE
DETAILS


004

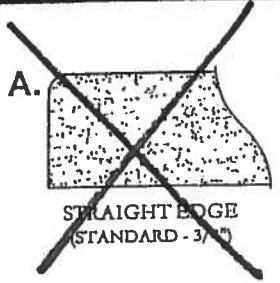

Upgrade
Kitchen
Main Bath
Master Ensuite

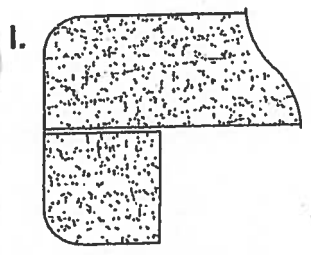

DOUBLE TOP "D" EDGE
(STANDARD - 1 1/2")

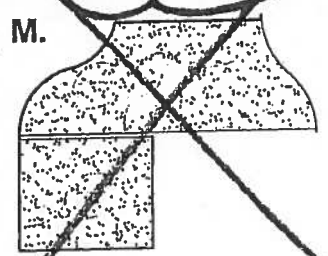

OGEE - SQUARE EDGE
(MED./HIGH - 1 1/2")

EDGING UP-GRADE OPTIONS

Suite 105
Hampton

Kitchen


Product Specification Sheet

BLANCO QUATRUS U 1 SUPER SINGLE

Satin brushed finish



PRODUCT DIMENSIONS

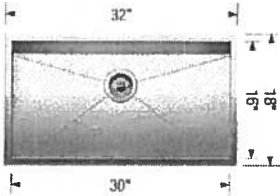

BLANCO QUATRUS U 1 SUPER SINGLE	Colour Finish	Model No.	FEATURES / SPECIFICATIONS
---------------------------------------	---------------	-----------	---------------------------



Satin brushed
finish

401248

- German designed and engineered
- Premium 304 series, 18 gauge stainless steel
- 18/10 chrome-nickel content for exceptional lustre, durability and strength
- Compact sized model
- Rear-positioned drain hole for maximum usable bowl and cabinet storage space
- Zero-radius corners, X-pattern drain grooves
- 3 1/2" (90 mm) stainless steel strainer included
- Undermount clips, template included
- Limited Lifetime Warranty

DESIGN AND PLANNING TIPS

Cabinet Size: 36" (915 mm)
Bowl depth: 9" (230 mm)
Depending on cabinet construction, a different cabinet size may be required.
Consult the cabinet manufacturer.

WARRANTY

Limited Lifetime warranty

Code/Standards Compliance

BLANCO sinks and faucets are third-party tested and certified to CSA, cUPC, ANSI/ASME and NSF standards and listed by applicable certification bodies. For more information on individual product listings, contact our office or listing organization.

BLANCO CANADA
100 Corporation Drive
Brampton, ON L6S 6B5

Tel: 905 494 2400
Fax: 905 494 2425
www.blancocanada.com


Toll Free: 1 877 425 2626
Toll Free: 1 877 825 2626

© 2016 BLANCO CANADA


Standard




Suite 105
Hampton

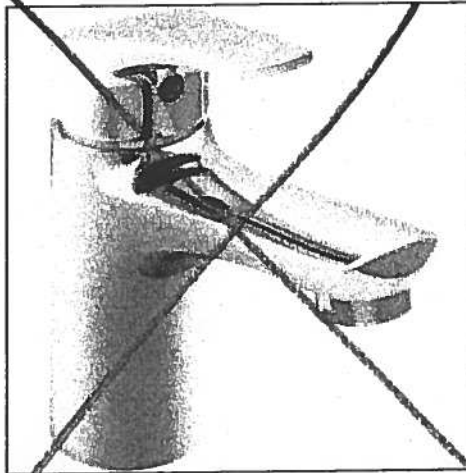

Delta Wynne Chrome Single Lever
Lavatory Faucet With Pop Up
#534LF

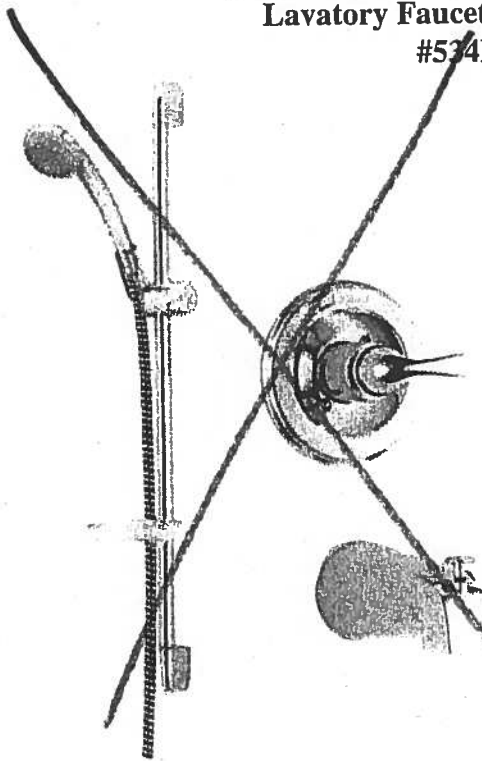

Delta Shower Trim with Tub Spout and
Hansgrohe Slide Bar with Handheld
#R10000/T13020-CDN/2001-TP/27454002/
27744000

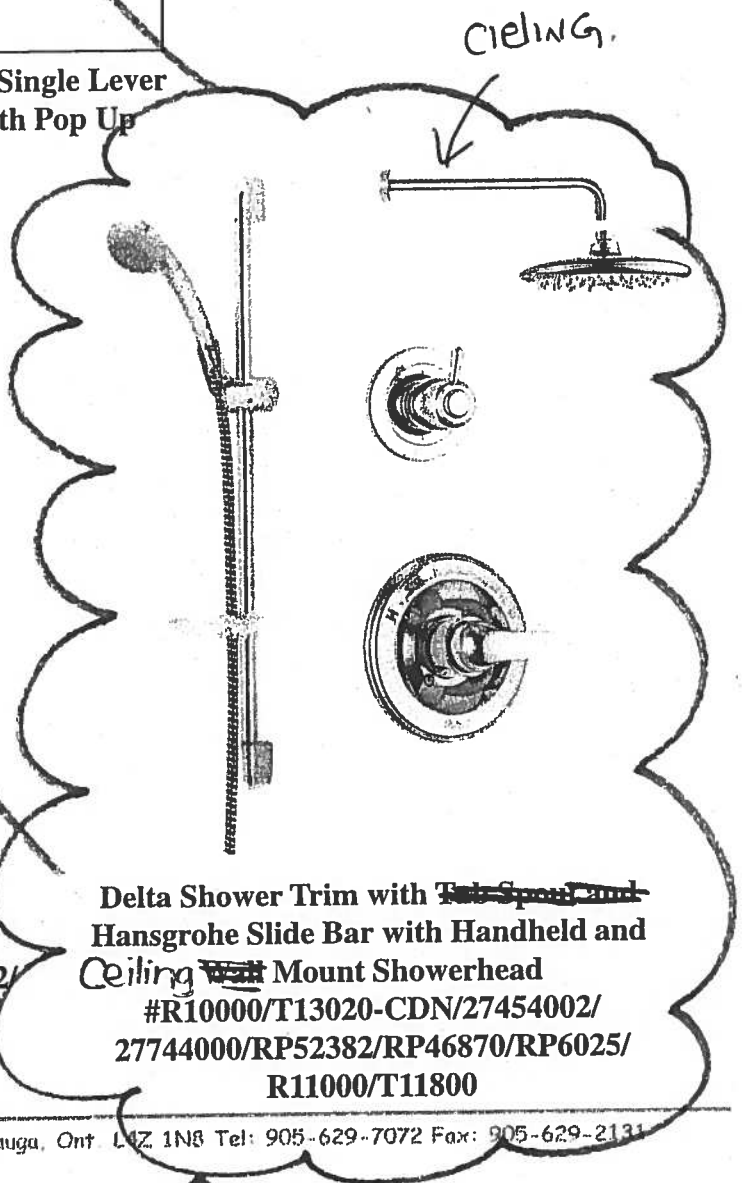

Delta Shower Trim with ~~Tub Spout and~~
Hansgrohe Slide Bar with Handheld and
Ceiling ~~Wall~~ Mount Showerhead
#R10000/T13020-CDN/27454002/
27744000/RP52382/RP46870/RP6025/
R11000/T11800


Centon Sales Corp. 400 Matheson Blvd. Unit # 30, Mississauga, Ont. L4Z 1N8 Tel: 905-629-7072 Fax: 905-629-2131

Master Ensuite
Shower Stall


Suite 105 Hampton




KITCHEN UPGRADE OPTIONS

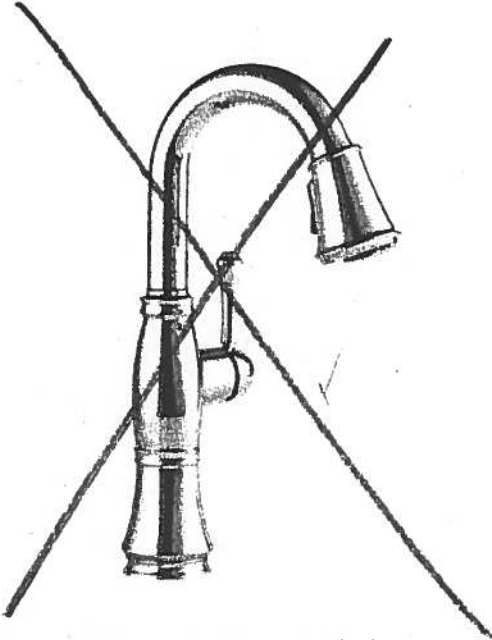

Delta Cassidy Pull Down Kitchen
#9997-DST

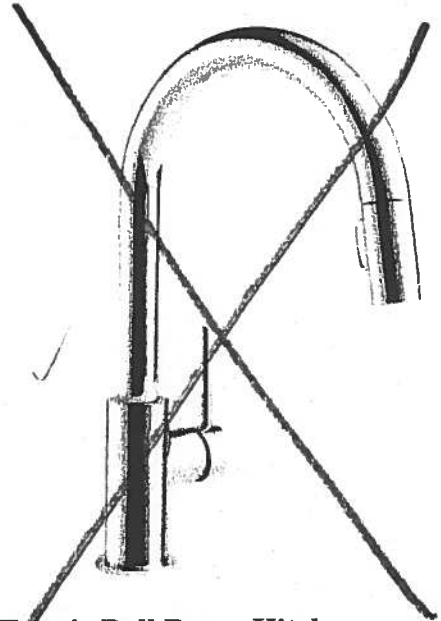

Delta Transic Pull Down Kitchen
#9159-DST

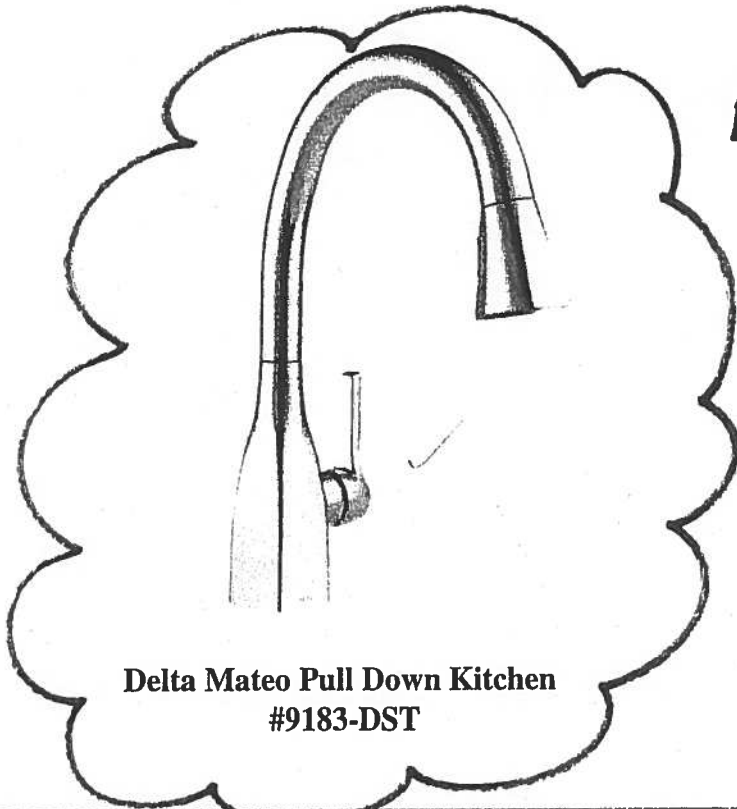

Delta Mateo Pull Down Kitchen
#9183-DST


Kitchen

*Arctic Stainless
Finish*

RECEIVED



Suite 105 Hampton Kitchen

Arctic
Stainless

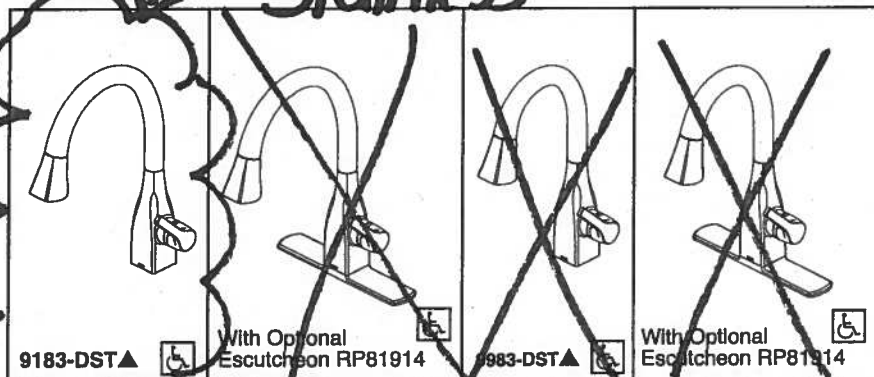

Submitted Model No.:

Specific Features:

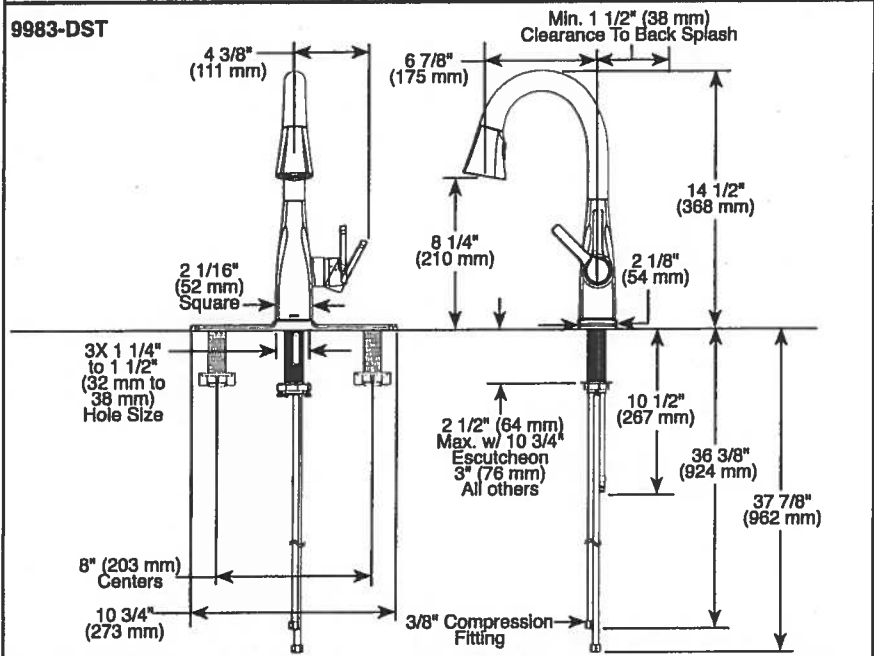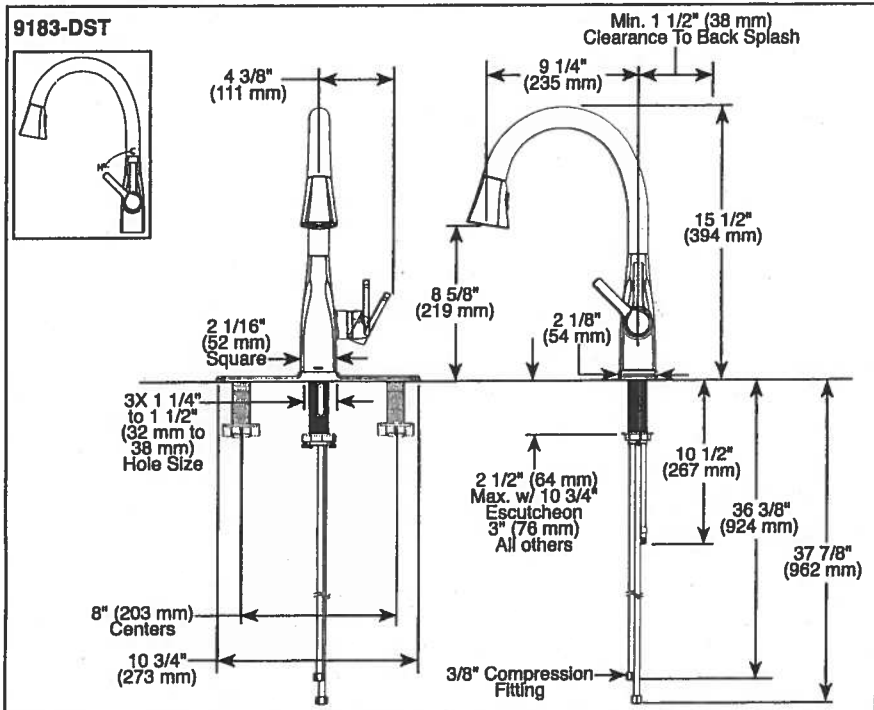

▲ Designate proper finish suffix

Delta reserves the right (1) to make changes in specifications and materials, and (2) to change or discontinue models, both without notice or obligation. Dimensions are for reference only. See current full-line price book or www.deltafaucet.com for finish options and product availability.

DSP-K-9183-DST Rev. B



KITCHEN FAUCETS

- Mateo® Collection
- Single Handle Pull-Down

FEATURES:

- DIAMOND Seal® Technology
- MagnaTite® Magnetic Docking
- Touch-Clean® Sprayhead

STANDARD SPECIFICATIONS:

- 1.8 gpm @ 60 psi, 6.8 L/min @ 414 kPa
- One or three hole mount (Escutcheon optional, not included)
- Diamond coated ceramic cartridge
- 3/8" O.D. straight, staggered PEX supply lines
- Rotating spout
- Red/Blue indicator markings
- Two-function wand; Aerated stream or spray
- Dual integral check valves in sprayer

WARRANTY

- Lifetime limited warranty on parts (other than electronic parts and batteries) and finishes; or, for commercial users, for 5 years from date of purchase.
- 5 year limited warranty on electronic parts (other than batteries); or, for commercial users, for 1 year from the date of purchase. No warranty is provided on batteries.

COMPLIES WITH:

- ASME A112.18.1 / CSA B125.1
- ASME A112.18.6
- Indicates compliance to ICC/ANSI A117.1
- Verified compliant with .25% weighted average Pb content regulations.



55 E 111th Street, Indianapolis, Indiana 46280
350 South Edgeware Road, St. Thomas, ON N5P 4L1
© 2016 Masco Corporation of Indiana

Suite 105
Hampton

Oct. 18, 2017



Upgrade Package I

WRB322DMBM


Whirlpool®

<http://www.whirlpool.com>

3-inches wide Bottom-Freezer Refrigerator with
SpillGuard™ Glass Shelves - 22 cu. ft

Key Features:

- SpillGuard™ Glass Shelves
- Adaptive Defrost
- FreshFlow™ Produce Preserver
- LED Interior Lighting
- ENERGY STAR® Qualified

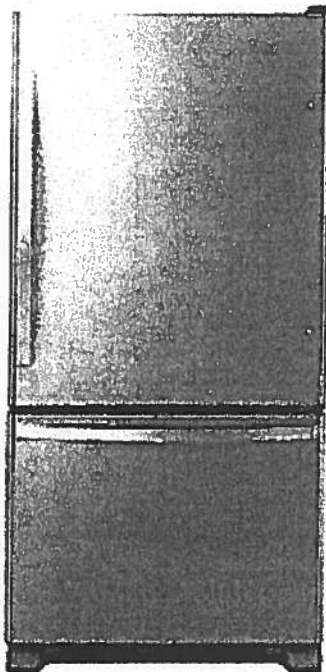

Product Dimensions:

Height: 70

Width: 32 5/8

Depth: 33 3/8

Electrical Requirements:

15

Additional Information:

[Use And Care Guide](#)

[Dimension Guide](#)

[Energy Guide](#)

[Warranty Certificate](#)

INVESTED
IN
AMERICA



©Registered trademark/TM Trademark of Whirlpool, U.S.A. © 2016 Whirlpool Corporation. All Rights Reserved.
All other trademarks are owned by their respective companies.

Because Whirlpool Corporation policy includes a continuous commitment to improve our products, we reserve the right to change materials and specifications without notice. We also reserve the right to discontinue or transition products without notice.

Manufacturer's Suggested Retail Price (MSRP) and Minimum Advertised Price (MAP) provided for reference purposes only. Dealer alone determines advertised and retail prices.

Created On: Tuesday, March 14, 2017 11:30:08

Suite 105
Hampton

Upgrade
Package I

Oct 13, 2017


③

WEE745H0FS

Whirlpool®

<http://www.whirlpool.com>

6.4 Cu. Ft. Slide-In Electric Range with True
Convection

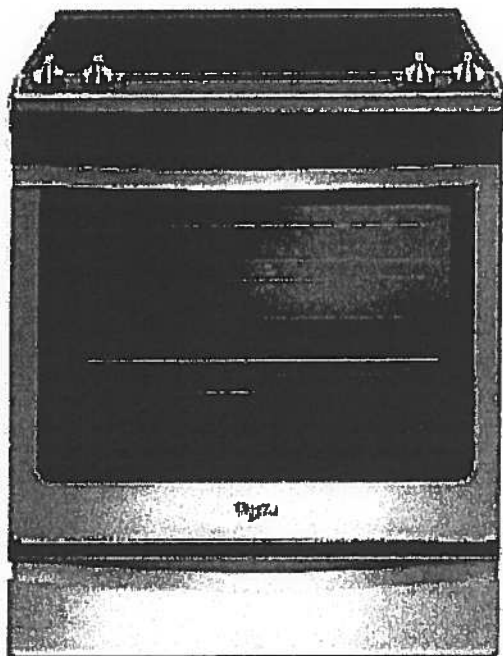

Key Features:

- Frozen Bake™ Technology
- True Convection Cooking
- FlexHeat™ Triple Radiant Element
- Convection Conversion
- AquaLift® Self-Cleaning Technology
- Temperature Sensor
- Rapid Preheat
- 6.4 Cu. Ft. Capacity
- Easy-Wipe Ceramic Glass Cooktop
- Large Oven Window
- Max Capacity Rack
- Hidden Bake Element

Product Dimensions:

Height: 36

Width: 29 7/8

Additional Information:

[Use And Care Guide](#)

[Dimension Guide](#)

[Installation Guide](#)

[Warranty Certificate](#)

INVESTED
IN
AMERICA



©Registered trademark/TM Trademark of Whirlpool, U.S.A. © 2016 Whirlpool Corporation. All Rights Reserved.
All other trademarks are owned by their respective companies.
Because Whirlpool Corporation policy includes a continuous commitment to improve our products, we reserve the right to change materials and specifications without notice. We also reserve the right to discontinue or transition products without notice.
Manufacturer's Suggested Retail Price (MSRP) and Minimum Advertised Price (MAP) provided for reference purposes only. Dealer alone determines advertised and retail prices.
Created On: Friday, January 27, 2017 10:46:47

Suite 105
Hampton

Upgrade Package 1

Oct. 18, 2017

A

YWMH76719CS



<http://www.whirlpool.com>

9 cu. ft. Microwave Hood Combination with
TimeSavor™ Plus True Convection

Key Features:

- TimeSavor™ Plus True Convection Cooking System
- Steam Cooking
- Sensor Cooking
- AccuPop™ Cycle
- CleanRelease® Non-Stick Interior
- SteamClean Option
- Integrated Hidden Vent and Console
- Auto Adapt Fan
- Recessed, Stoppable Glass Turntable
- Universal Microwave Steamer
- 1.9 cu. ft. Capacity
- 1,100 Watts Cooking Power

Product Dimensions:

Height: 17 1/8

Width: 29 15/16

Depth: 18 1/2

Electrical Requirements:

15 or 20. 120 V.

Additional Information:


[Use And Care Guide](#)

[Installation Guide](#)

[Warranty Certificate](#)

Available in:

● Stainless Steel

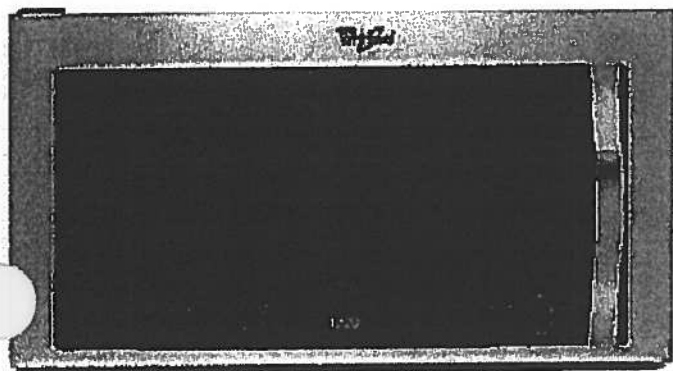

©Registered trademark/TM Trademark of Whirlpool, U S A. © 2013 Whirlpool Corporation. All Rights Reserved
All other trademarks are owned by their respective companies.
Because Whirlpool Corporation policy includes a continuous commitment to improve our products, we reserve the right to change materials and specifications without notice. We also reserve the right to discontinue or transition products without notice.
Manufacturer's Suggested Retail Price (MSRP) and Minimum Advertised Price (MAP) provided for reference purposes only. Dealer alone determines advertised and retail prices.
Created On: Monday, March 14, 2016 13:16:48

Suite 105
Hampton

Upgrade
Package 1

Oct. 18, 2017

②

WDTA50SAHZ

Whirlpool®

<http://www.whirlpool.com>

Contemporary Design. Stainless Steel Tub
Dishwasher with TotalCoverage Spray Arm

Key Features:

- Sensor Cycle
- TotalCoverage Spray Arm
- 1-Hour Wash Cycle
- Tap Touch Controls

Product Dimensions:

Height: 34 1/2
Width: 23 7/8
Depth: 24 1/2

Additional Information:


[Use And Care](#)

[Dimension Guide](#)

[Installation Guide](#)

[Energy Guide](#)

[Warranty](#)

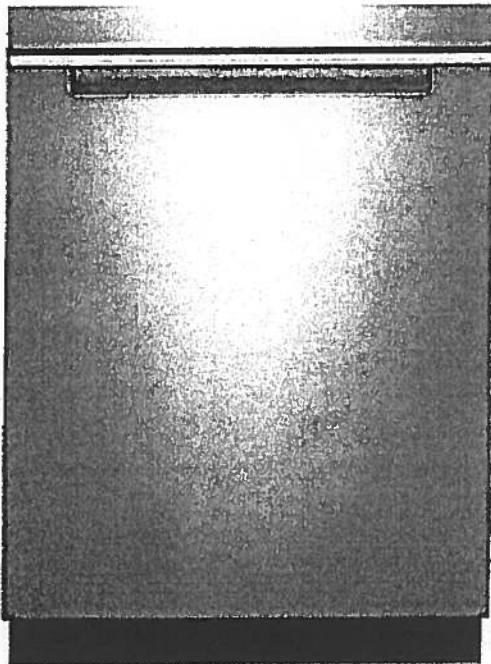

Available in:

● Black

Fingerprint Resistant Sunset Bronze

Fingerprint Resistant Black Stainless

○ White

Fingerprint Resistant Stainless Steel

INVESTED
IN
AMERICA



©Registered trademark/TM Trademark of Whirlpool, U.S.A. © 2016 Whirlpool Corporation. All Rights Reserved. All other trademarks are owned by their respective companies.

Because Whirlpool Corporation policy includes a continuous commitment to improve our products, we reserve the right to change materials and specifications without notice. We also reserve the right to discontinue or transition products without notice.

Manufacturer's Suggested Retail Price (MSRP) and Minimum Advertised Price (MAP) provided for reference purposes only. Dealer alone determines advertised and retail prices.

Suite 105 Hampton Upgrade Package I

Oct. 18, 2017




WFW75HEFW



<http://www.whirlpool.com>

5 cu. ft. Front Load Washer with Precision
Dispense

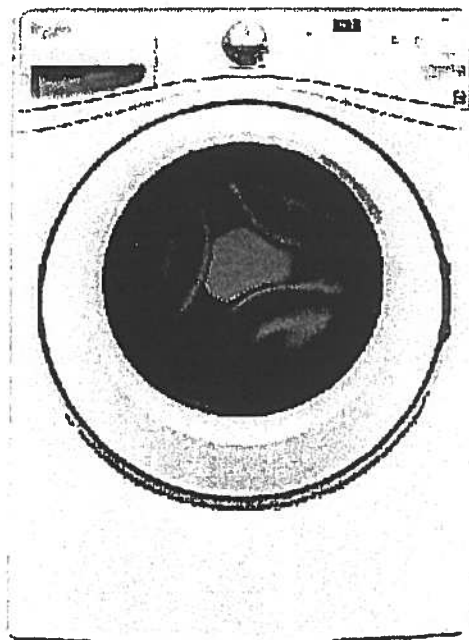

Key Features:

- Precision Dispense
- Adaptive Wash Technology
- Smooth Wave Stainless Steel Wash Basket
- 4.5 cu. ft. Capacity
- ENERGY STAR® Qualified

Product Dimensions:

Height: 39 3/4

Width: 27

Depth: 33 5/16

Electrical Requirements:

15 or 20. 120 V.

Additional Information:

[Use And Care Guide](#)

[Dimension Guide](#)

[Installation Guide](#)

[Energy Guide](#)

[Warranty Certificate](#)

INVESTED
IN
AMERICA



©Registered trademark/TM Trademark of Whirlpool, U.S.A. ©2013 Whirlpool Corporation All Rights Reserved.
All other trademarks are owned by their respective companies.
Because Whirlpool Corporation policy includes a continuous commitment to improve our products, we reserve
the right to change materials and specifications without notice. We also reserve the right to discontinue or
transition products without notice.
Manufacturer's Suggested Retail Price (MSRP) and Minimum Advertised Price (MAP) provided for reference
purposes only. Dealer alone determines advertised and retail prices.
Created On: Wednesday, March 23, 2016 11:51:03

Suite 105
Hampton

Upgrade
Package 1

Oct. 18, 2017




YWED75HEFW

Whirlpool®

<http://www.whirlpool.com>

7.4 cu. ft. Duet® High Efficiency Front Load Electric
Dryer with ENERGY STAR®

MSRP: \$0.00

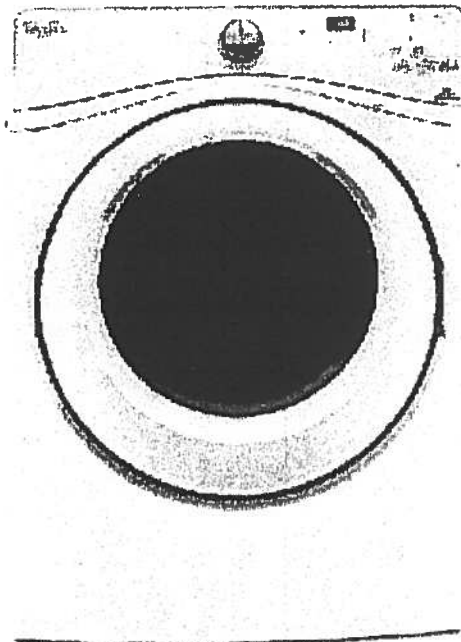

Key Features:

- Advanced Moisture Sensing System
- Quad Baffles
- Tap Touch Controls with Memory
- EcoBoost™ Option
- Wrinkle Shield™ Plus Option
- Undercounter Installation
- 7.4 Cu. Ft. Capacity
- ENERGY STAR® Qualified

Product Dimensions:

Height: 39

Width: 27

Depth: 31

Additional Information:

[Use And Care](#)

[Installation Guide](#)

[Warranty](#)

Available in:

☐ White

INVESTED
IN
AMERICA



®Registered trademark/TM Trademark of Whirlpool, U.S.A. © 2016 Whirlpool Corporation. All Rights Reserved. All other trademarks are owned by their respective companies.

Because Whirlpool Corporation policy includes a continuous commitment to improve our products, we reserve the right to change materials and specifications without notice. We also reserve the right to discontinue or transition products without notice.

Manufacturer's Suggested Retail Price (MSRP) and Minimum Advertised Price (MAP) provided for reference purposes only. Dealer alone determines advertised and retail prices.