



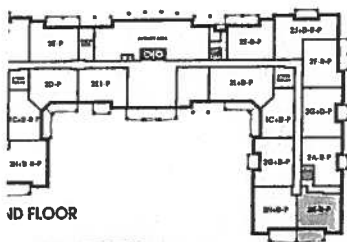

Riverhead

#106

1,050 SQ FT *plus* 168 sq. ft. of patio area

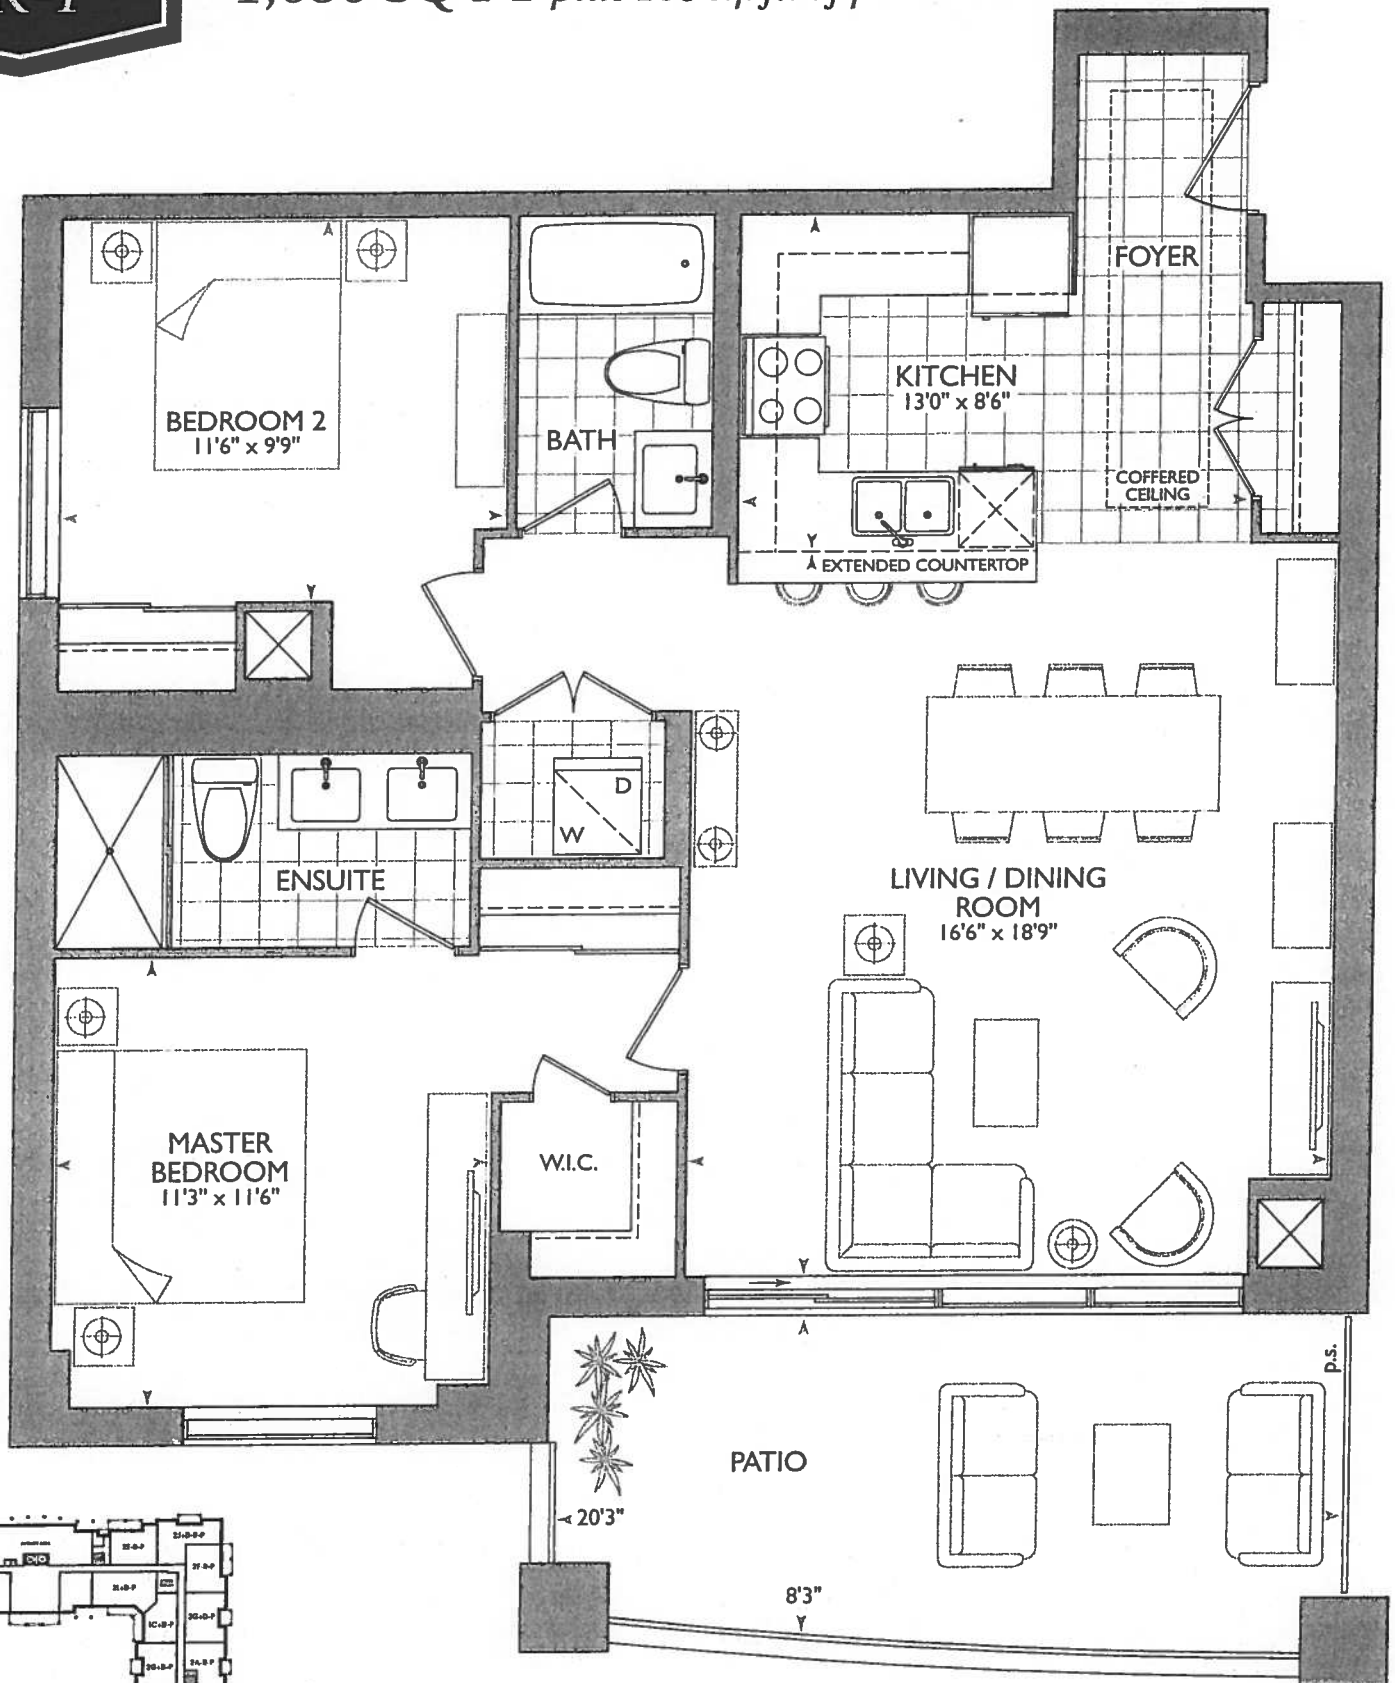


ORIGINAL SUITE

Smooth Ceilings

Oct. 12, 2017

KW 6/16

WM

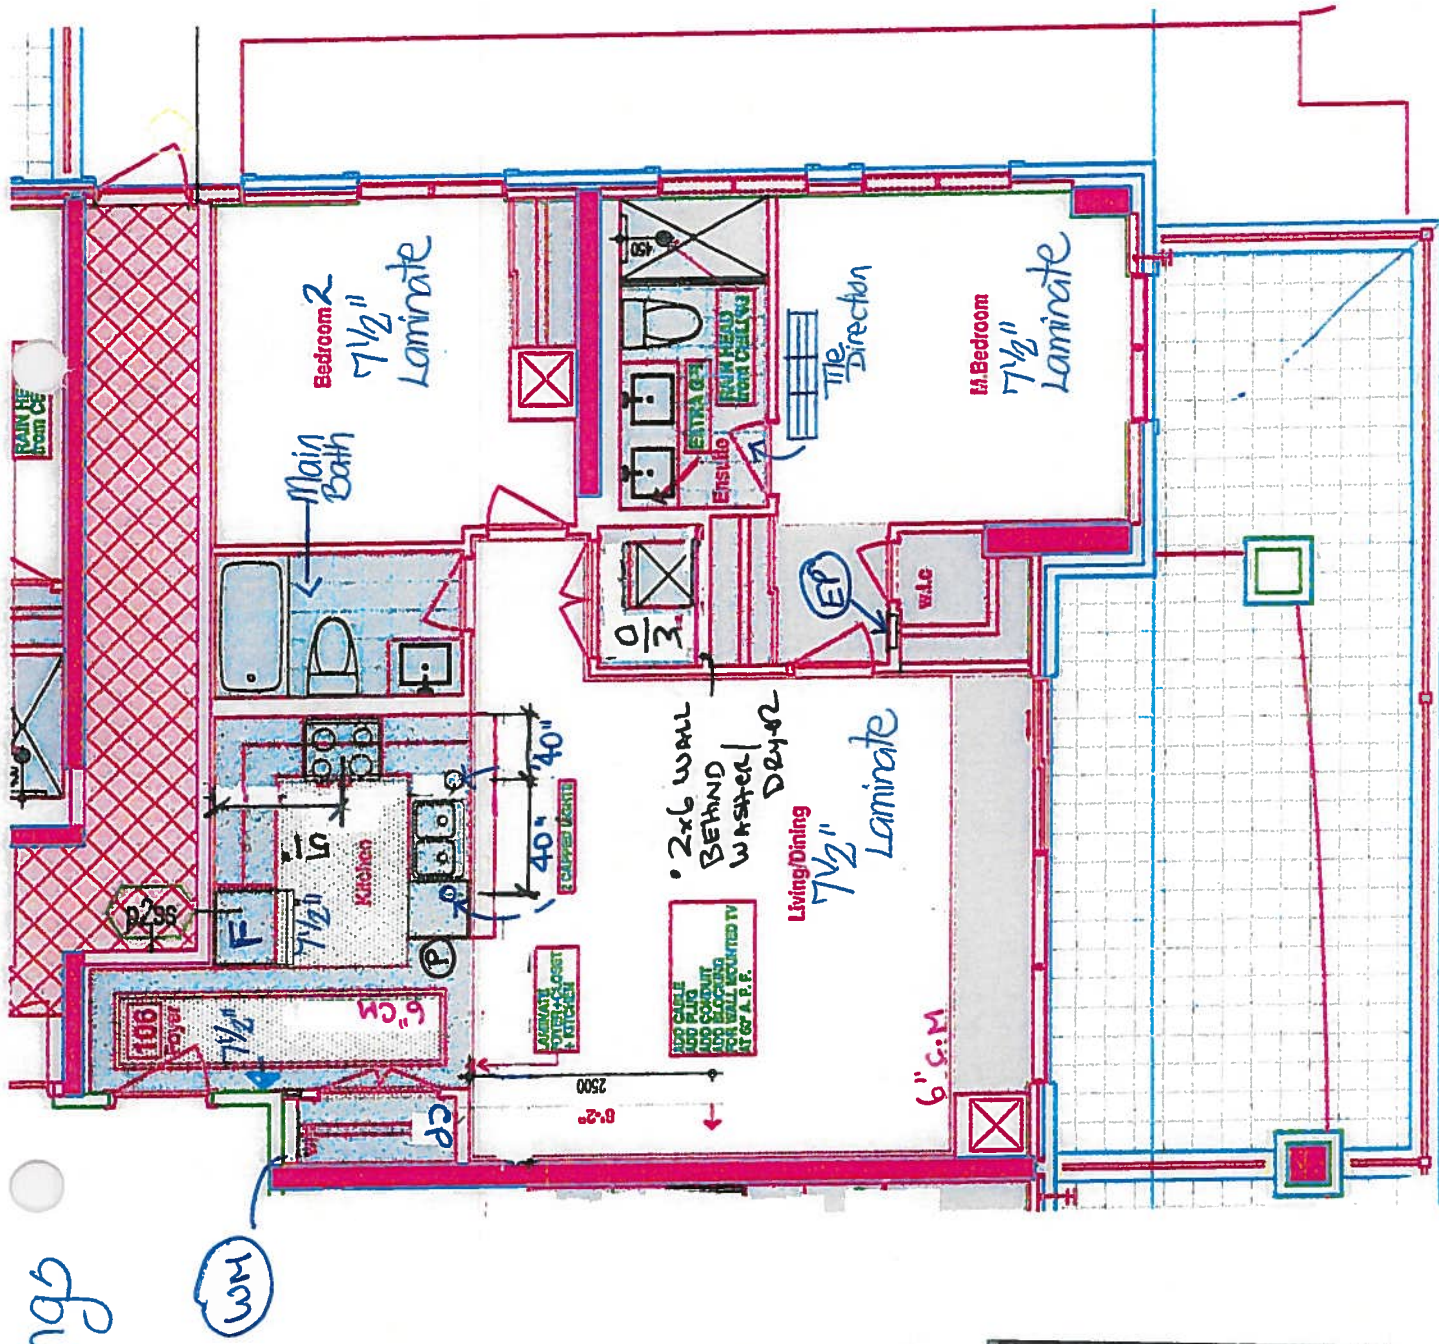

Kitchen

- STOVE PIPE CENTER 51"
- SINK PIPE CENTER 96"
- 2x PENDANT LIGHTS OVER PENINSULA CAPPED
- P PLUG PENINSULA.
- STANDARD APPLIANCE PACKAGE

LEGEND:	
	SECURITY PANEL
	ELECTRICAL PANEL
	COMMUNICATION PANEL
	WATER METER
	FRIDGE
	DROPPED AREA
	6\"/>

SUITE 106 - RIVERHEAD - 2K-P-R

HAUPTON PLACE 25 BAKER HILL BLVD - STAMFORD, ON SEP 28, 2017

RECEIVED



SITE COPY

CONSTRUCTION SUMMARY

Hampton Place

PURCHASERS: BENJAMIN S. MULLEN and KENDALL MICHELLE WIELD

TEL: RES.: 416-518-0466

LOT NUMBER	PHASE	HOUSE TYPE	CLOSING DATE
106	1	RIVERHEAD	05-Sep-18

Offer	TANDEM PARKING SPACE IN LIEU OF SINGLE PARKING SPACE
Workshee	Note:
Offer	PURCHASER TO RECEIVE \$10,000(INCLUDES APPLICABLE TAXES) WORTH OF UPGRADES AT THE DECOR CENTER AT TIME OF COLOUR CHART.
Workshee	Note:
Offer	VENDOR AGREES TO SUPPLY AND INSTALL SMOOTH CEILINGS THROUGHOUT
Workshee	Note:

DESCRIPTION
✓ RAINHEAD FROM CEILING IN SHOWER OF MASTER ENSUITE
✓ EXTRA GFI RECEPTACLE ABOVE SINK ON SIDE WALL IN MASTER ENSUITE AS PER SKETCH
✓ 2 - TWO EXTRA CEILING CAPPED OUTLETS ABOVE PENINSULA IN KITCHEN AS PER SKETCH
✓ ADDITIONAL CABLE OUTLET IN LIVING/DINING AND ADDITIONAL DUPLEX RECEPTACLE IN LIVING/DINING AS PER SKETCH
✓ CONDUIT AND BLOCKING FOR WALL MOUNTED TV (60 INCHES ABOVE FINISHED FLOOR) IN LIVING/DINING
✓ STANDARD LAMINATE IN LIEU OF TILES IN MAIN FOYER, MAIN CLOSET AND KITCHEN , AS PER VENDORS STANDARD SAMPLES



SITE COPY

CONSTRUCTION SUMMARY
Hampton Place

PURCHASERS: BENJAMIN S. MULLEN and KENDALL MICHELLE WIELD TEL: RES.: 416-518-0466

LOT NUMBER 106	PHASE 1	HOUSE TYPE RIVERHEAD	CLOSING DATE 05-Sep-18
-------------------	------------	-------------------------	---------------------------

Date Added: 23-Nov-17 Invoice Number: 7029

1 - CLARIFICATION;
MASTER ENSUITE - Purchaser accepts & acknowledges the standard glass at master ensuite shower stall will NOT touch the ceiling and will receive a
Hard Chrome Header. (See Sketch)
Note:

1 - PURCHASER AWARE AND ACCEPTS THAT ANY CHANGES MADE TO UPGRADES AFTER SIGNING THIS PURCHASERS EXTRA
FORM ARE SUBJECT TO A MINIMUM ADMINISTRATION FEE OF \$1,000 PLUS A 10% HOLDBACK FEE.
Note:

Date Added: 12-Oct-17 Invoice Number: 6968

1 - KITCHEN & BATHROOMS - SEE QUALITY TOPS & KITCHENS FOR ALL KITCHEN & BATHROOM UPGRADES / LAYOUT. (See
Attached Paperwork)
Note:

1 - KITCHEN - Install 3RD UPGRADE COUNTERTOP - 5131 CALACATTA NUVO - Throughout kitchen where applicable (Does not include
granite backsplash) (See Sketch)
Note: Purchaser Paying Difference - Standard Granite Included in APAS

1 - KITCHEN - Kitchen Backsplash - Install 3RD UPGRADE - 12x12 Oriental White Herringbone Mosaics - Throughout kitchen backsplash, where
applicable. (Does not include behind the fridge or stove) (See Sketch)
Note:

1 - KITCHEN - Kitchen Sink - Install Upgrade Undermount Sink - BLANCO Quatrus U Super Single Undermount Sink - Model # 401248 (See
Sketch)
Note:

1 - KITCHEN - Kitchen Faucet - Install Standard Faucet - DELTA - Chrome Pull-Out Kitchen Faucet (Single Hole) - Model # 469LF - Chrome (See
Sketch)
Note:

1 - APPLIANCE PACKAGE - Install STANDARD Appliance Package - To be installed throughout suite, where applicable. (See Sketch)
Note:

45 - MASTER ENSUITE - 2ND UPGRADE - PORCELAIN TILES - 12x24 CALACATTA POLISHED - To be installed throughout master ensuite
floor. (To be Installed Straight) (See Sketch)
Note: Includes Rectified

105 - MASTER ENSUITE - 2ND UPGRADE - PORCELAIN TILES - 12x24 CALACATTA POLISHED - To be installed throughout master ensuite
shower stall. (To be Installed Horizontally / Stacked) (See Sketch)
Note: Includes Rectified

1 - CLARIFICATION;
MAIN BATH & MASTER ENSUITE - DELETE Standard 3" Splash throughout all bathroom vanity countertops, where applicable. To Include; Main
Bath and Master Ensuite (See Sketch)
Note:

1 - CLARIFICATION;
MAIN BATH & MASTER ENSUITE - DELETE Do Not Install / Supply / Credit purchaser for builders standard ceramic bathroom accessories (toilet
paper, towel bar & soap dish) To Include; Main Bath and Master Ensuite (See Sketch)
Note:

1 - BONUS PACKAGE - PURCHASER HAS APPLIED \$10,000.00 (Includes Taxes) WORTH OF UPGRADE PROMOTIONAL PACKAGE
TOWARDS THE PURCHASE OF UPGRADES COMPLETED AT THE DECOR CENTRE.
Note:



SITE COPY

CONSTRUCTION SUMMARY

Hampton Place

PURCHASERS: BENJAMIN S. MULLEN and KENDALL MICHELLE WIELD

TEL: RES.: 416-518-0466

LOT NUMBER	PHASE	HOUSE TYPE	CLOSING DATE
106	1	RIVERHEAD	05-Sep-18

Date Added: 12-Oct-17 Invoice Number: 6968

1 - PURCHASER HAS ATTENDED A COLOR APPOINTMENT AT THE DECOR CENTRE AND HAS DECLINED ANY ADDITIONAL UPGRADES. Purchaser accepts and acknowledges that there will be no further changes/additions/deletions to be made upon signing on October 17, 2017.
Note:

1 - PURCHASER AWARE AND ACCEPTS THAT ANY CHANGES MADE TO UPGRADES AFTER SIGNING THIS PURCHASERS EXTRA FORM ARE SUBJECT TO A MINIMUM ADMINISTRATION FEE OF \$1,000 PLUS A 10% HOLDBACK FEE.
Note:

This Document is Extremely Time Sensitive - Printed 22 Jan 18 at 15:53



* INTERIOR COLOR SCHEME *

Purchasers		Decor Consultant	Model Type	Telephone Res. / Bus	Project	Closing Date	Unit
BENJAMIN S. MULLEN & KENDALL MICHELLE WIELD		Melissa Di Marino	RIVERHEAD	(416) 518-0466 /	Hampton Place	05/09/2018	106

Page 1 of 3

MASTER ENSUITE

MAIN BATHROOM

POWDER ROOM

KITCHEN / DINETTE

FOYER

LAUNDRY

LIVING ROOM

DINING ROOM

DEN

MASTER BEDROOM

BEDROOM 2


BEDROOM 3

Flooring	Wall Tile		
	Main	Accent/Insert	Pattern
12x24 CALACATTA POLISHED (UPG) (Straight)	12x24 Calacatta Polished (Horizontal) (Upg)	NONE	NONE
13x13 RUSTIC GREY (STD)		NONE	NONE
N/A	N/A	N/A	N/A
7 1/2" Torleys Forest Sagueway Valley 9744-P (Std)	12x12 Oriental White Herringbone Mosaics (Upg)	NONE	NONE
7 1/2" Torleys Forest Sagueway Valley 9744-P (Std)	N/A	N/A	N/A
8x8 BEHRAM PINK (STD)	N/A	N/A	N/A
7 1/2" Torleys Forest Sagueway Valley 9744-P (Std)			
7 1/2" Torleys Forest Sagueway Valley 9744-P (Std)			
N/A			
7 1/2" Torleys Forest Sagueway Valley 9744-P (Std)			
7 1/2" Torleys Forest Sagueway Valley 9744-P (Std)			
N/A			


Notes

Page 1 of 3

Consultant: 
Melissa Di Marino

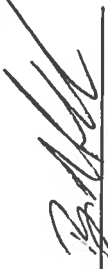Purchaser: 
BENJAMIN S. MULLEN

Purchaser: 
KENDALL MICHELLE WIELD

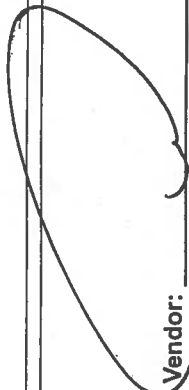Vendor: 
Hampton Place



* INTERIOR COLOR SCHEME *

Purchasers		Decor Consultant	Model Type	Telephone Res. / Bus	Project	Closing Date	Unit
BENJAMIN S. MULLEN & KENDALL MICHELLE WIELD		Melissa Di Marino	RIVERHEAD	(416) 518-0466 /	Hampton Place	05/09/2018	106

Page 2 of 3

CABINETRY, VANITIES AND COUNTERTOPS

	Style	Countertop	Counter Edge	Handle / Knob	APPLIANCE PACKAGE
MAIN BATHROOM	CATEGORY 2 - MAPLE - PISTACHIO QT 2503 (STD)	ASPEN TERRA WHITE (STD)	* A " EDGE (STD)	3487-128	Standard
MASTER ENSUITE	CATEGORY 2 - MAPLE - SMOKEHOUSE QT 2503	ASPEN TERRA WHITE (STD)	* A " EDGE (STD)	3487-128	
POWDER ROOM	N/A	N/A	N/A	N/A	
KITCHEN / DINETTE	CATEGORY 1 - MDF - WHITE QT 1203 (STD)	5131 CALACATTA NUOVO (UPG)	* A " EDGE (STD)	3487-128	
LAUNDRY ROOM	N/A	N/A	N/A	N/A	Sid 31in Opening

PLUMBING FIXTURES

KITCHEN	Sink Model	UPG - Blanco Super Single #401248
	Sink Faucet	STANDARD
TOILETS	Master Ensuite	STANDARD
	Main Bathroom	STANDARD
	Powder Room	N/A
VANITY FAUCETS	Master Ensuite	STANDARD
	Main Bathroom	STANDARD
	Powder Room	N/A
VANITY SINKS	Master Ensuite	STANDARD
	Main Bathroom	STANDARD
	Powder Room	N/A
SHOWER STALL / TUBS	Master Ensuite Shower Stall	STANDARD
	Master Ensuite Tub	N/A
	Main Bathroom Tub	STANDARD

Trim	Baseboard & Casing	Levers
Interior Doors	STANDARD	Door Height
	STANDARD - CARRARA, SMOOTH	

Cornice Moulding / Medallion

Foyer	STANDARD - # CTR-611
Living Room	STANDARD - # CTR-611
Dining Room	STANDARD - # CTR-611
Den	N/A
Master Bedroom	NONE
Bedroom 2	NONE
Bedroom 3	N/A

Fireplace

Fireplace	N/A
Location Flooring	N/A
Style	N/A
Finish	N/A
Marble	N/A
Hearth	N/A

Paint Throughout

Walls	Trim
BIRCH WHITE	STANDARD - WHITE

Page 2 of 3

Decor Consultant: 
Melissa Di Marino


Purchaser: 
BENJAMIN S. MULLEN

Purchaser: 
KENDALL MICHELLE WIELD

Vendor: 

Suite 106 Hampton

- O = 2-CARDED LIGHTS OVER PENINSULA.
- (P) = PLUG PENINSULA
- (5x) = PUCK LIGHTS
- STD Appliance PACKAGE.
- MAIN + ENSUITE BASIN VANITIES 36 1/4" (NO 3" splash)

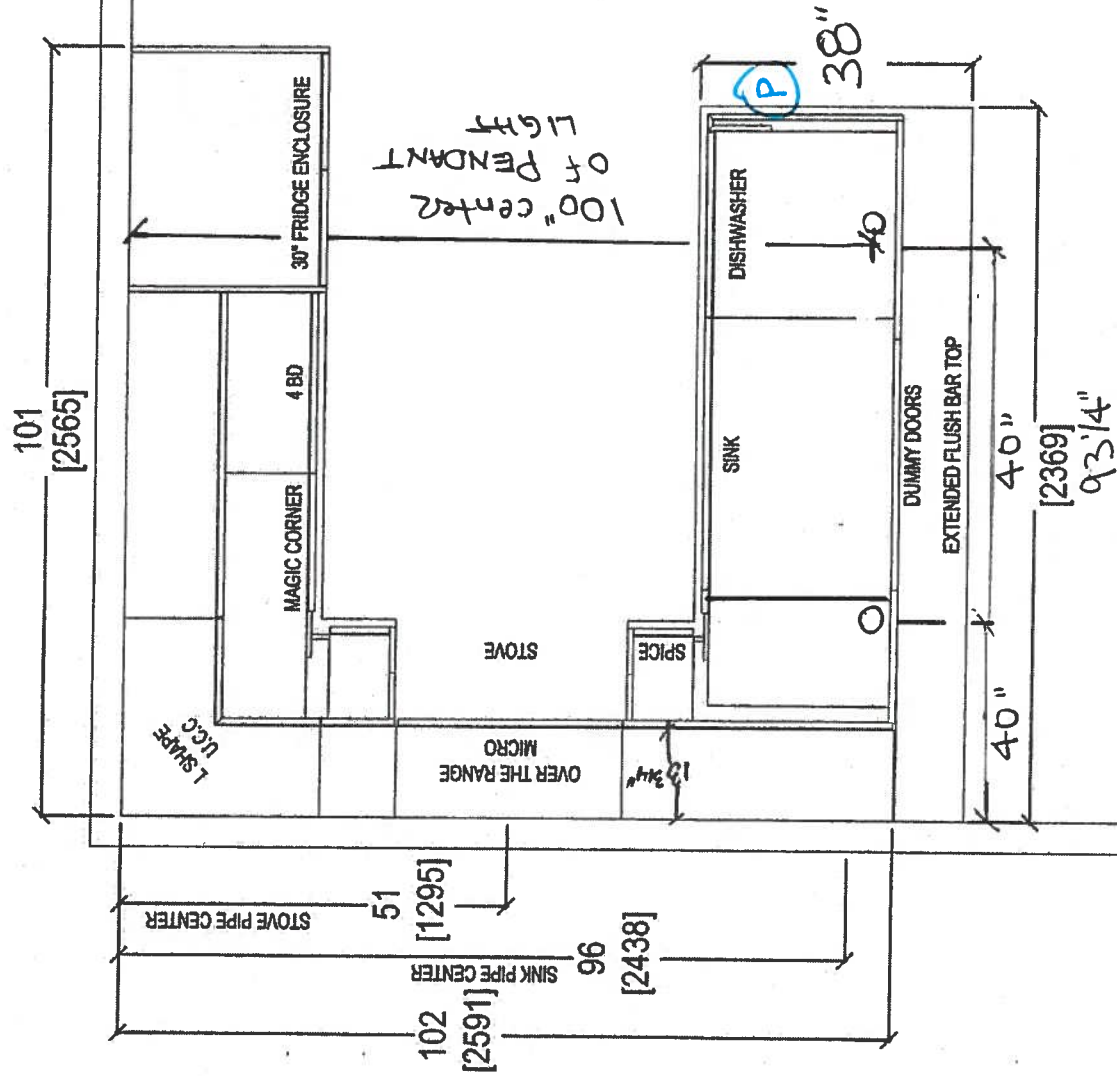


Oct. 12, 2017
(KW) (P)

CLIENT: ROYAL PINE HOMES SITE: HAMPTON PLACE PHONE: — EMAIL: —	2K-P RIVERHEAD UPGRADE PACKAGE 1		ROOM: KITCHEN FLOOR PLAN	DRAWN BY: SK	COMMENTS: PLEASE NOTE ALL DIMENSIONS ARE NOT FINAL AND ARE SUBJECT TO CHANGE UPON FINAL SITE MEASURE
	DOOR STYLE: —	DOOR HANDLE: —	SCALE: 1/2" = 1'-0"	DATE: AUG 4, 2017	
	FINISH: —	DRW HANDLE: —	PAGE: —		
	SPECIES: —	TOP: —			



PK-Pock Light

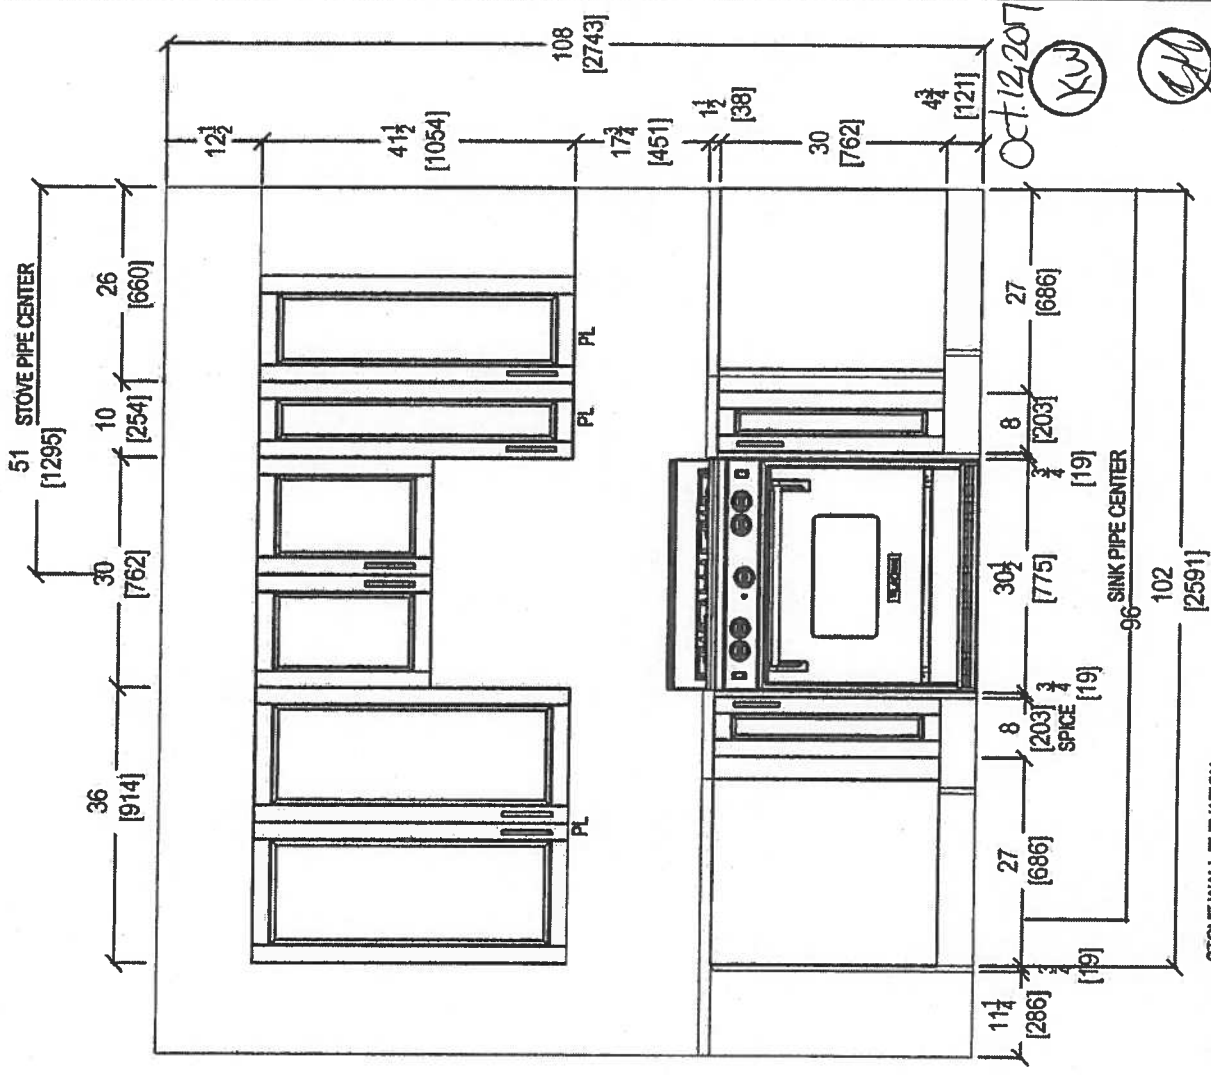

STOVE WALL ELEVATION

CLIENT: ROYAL PINE HOMES

SITE: HAMPTON PLACE

PHONE: —

EMAIL: _____

2K-P RIVERHEAD UPGRADE PACKAGE 1

DOOR STYLE:

FINISH

SPECIES:

ROOM: KITCHEN

DOCS 1142 F

DOMINION

DRAWN BY: SK

1000

[illegible]

24	10
25	10
26	10
COMMENTS:



**PLEASE NOTE ALL DIMENSIONS
ARE NOT FINAL AND ARE
SUBJECT TO CHANGE UPON
FINAL SITE MEASURE**

your kitchen, your taste.

80 SANTE DRIVE, VAUGHAN, ON L4K 3C4,
T: 416.746.1811 F: 905.761.5901

your kitchen, your taste.
80 SANTE DRIVE, VAUGHAN, ON L4K 3C4,
T: 416.746.1811 F: 905.761.5901


Suite 106 Hampton

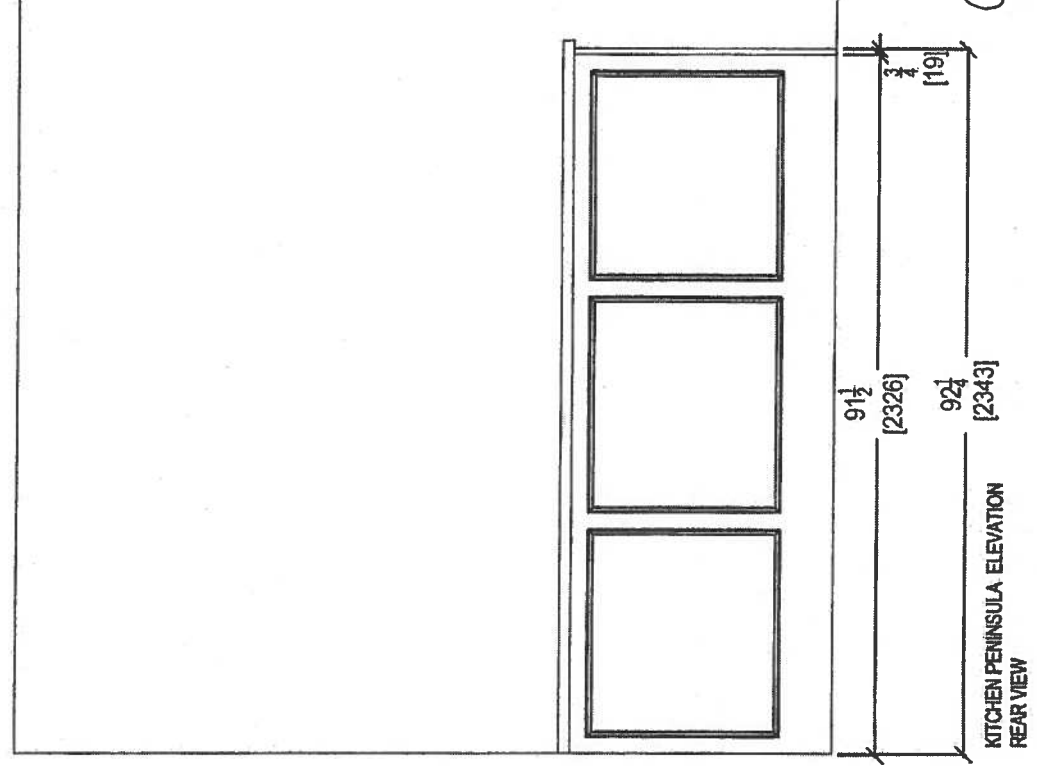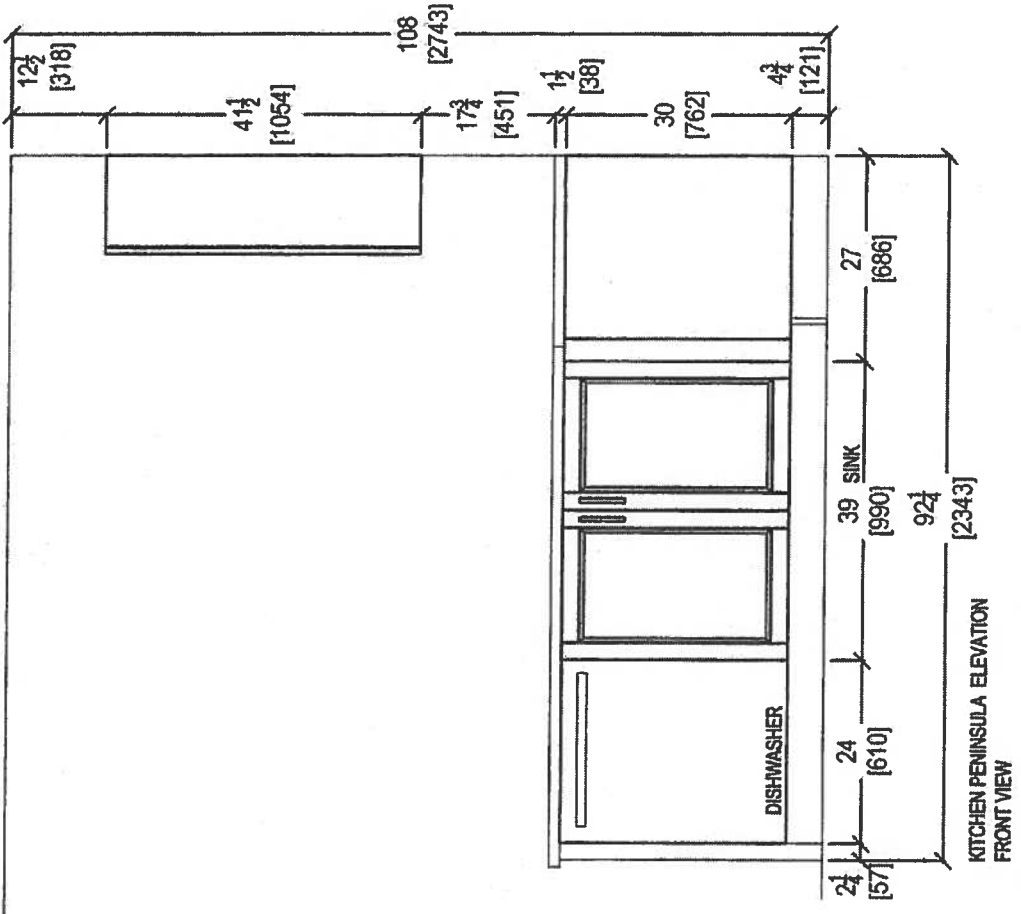


Oct. 12, 2017
KTH

 your kitchen, your style 80 SANTE DRIVE, VAUGHAN, ON L4K 3C4, T: 416.746.1811 F: 905.761.5901	CLIENT: ROYAL PINE HOMES		2K-P RIVERHEAD UPGRADE PACKAGE 1	ROOM: KITCHEN	DRAWN BY: SK	COMMENTS: PLEASE NOTE ALL DIMENSIONS ARE NOT FINAL AND ARE SUBJECT TO CHANGE UPON FINAL SITE MEASURE
	SITE: HAMPTON PLACE	DOOR STYLE: —	DOOR HANDLE: —	SCALE: 1/2" = 1'-0"		
	PHONE: —	FINISH: —	DRW HANDLE: —	DATE: AUG 4, 2017		
	EMAIL: —	SPECIES: —	TOP: —	PAGE: —		



Suite 106 Hampton

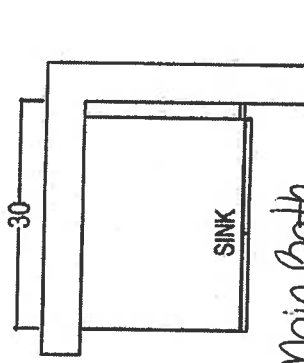

Main Bath
Raised
Height

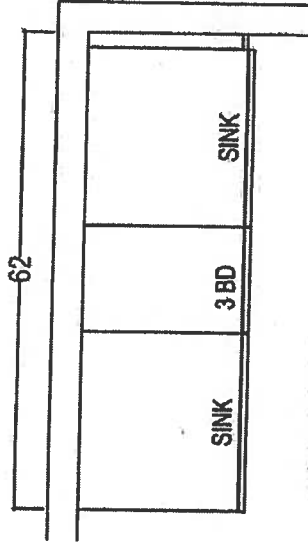


MASTER ENSUITE
Raised
Height

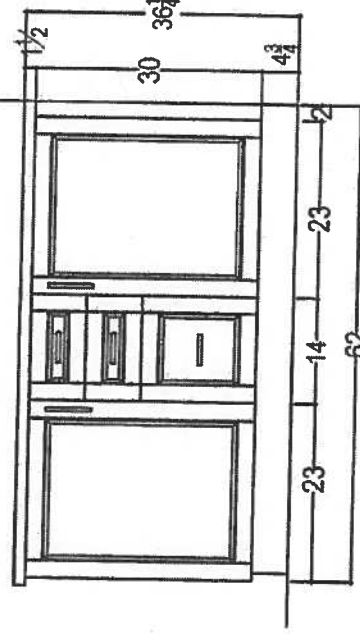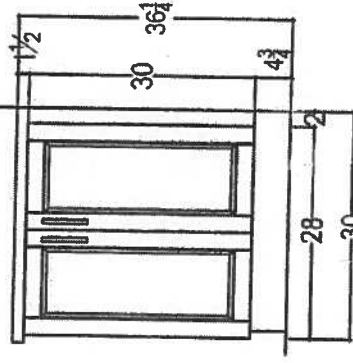

Oct. 12, 2017

KW 9/16

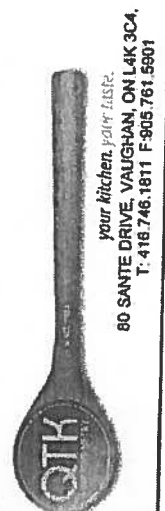

CLIENT: ROYAL PINE HOMES
SITE: HAMPTON PLACE
PHONE: —
EMAIL: —

2K-P RIVERHEAD UPGRADE PACKAGE 1
DOOR STYLE: —
FINISH: —
SPECIES: —

ROOM: —
DOOR HANDLE: —
DRW HANDLE: —
TOP: —

DRAWN BY: SK
SCALE: 1/2" = 1'-0"
DATE: AUG 4, 2017
PAGE: —


COMMENTS:

PLEASE NOTE ALL DIMENSIONS
ARE NOT FINAL AND ARE
SUBJECT TO CHANGE UPON
FINAL SITE MEASURE

Suite 106
Hampton

Living Room

→ CONDUIT =

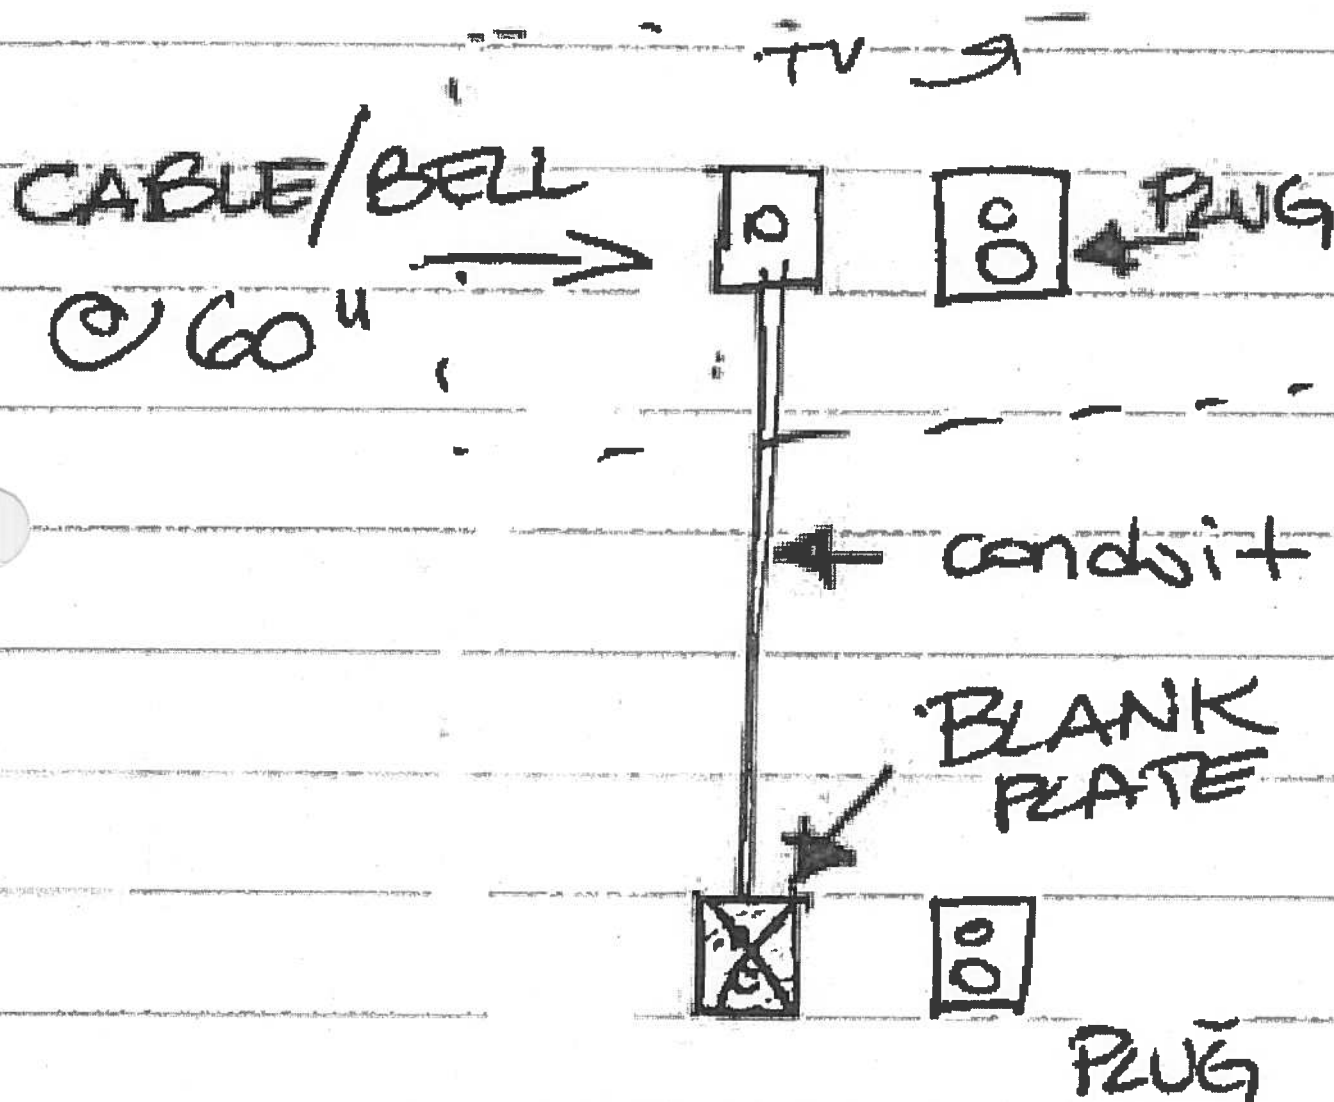

Suite 106 Hampton

Oct. 12, 2017


~~SM~~ KW

CONNOLLY Marble & Granite Ltd.

EDGE
DETAILS

004


A.

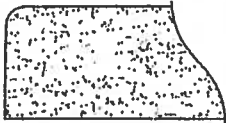

STRAIGHT EDGE
(STANDARD - 3/4")


Standard
Kitchen
Main Bath
Master Ensuite

~~I.~~

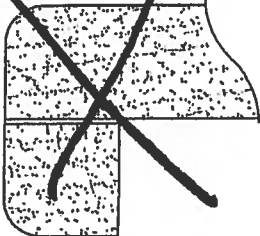

~~DOUBLE TOP "D" EDGE
(STANDARD - 1 1/2")~~

~~M.~~

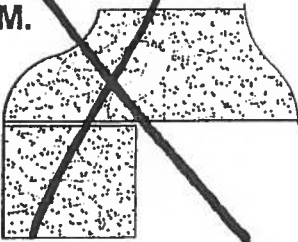

~~OGEE - SQUARE EDGE
(MED./HIGH - 1 1/2")~~

EDGING UP-GRADE OPTIONS

Suite 106 Hampton


Kitchen

Product Specification Sheet

BLANCO QUATRUS U 1 SUPER SINGLE

Satin brushed finish

PRODUCT DIMENSIONS

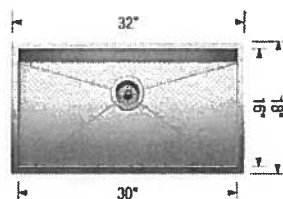

BLANCO
QUATRUS U 1
SUPER SINGLE

Colour Finish

Model No.

FEATURES / SPECIFICATIONS



Satin brushed
finish

401248

- German designed and engineered
- Premium 304 series, 18 gauge stainless steel
- 18/10 chrome-nickel content for exceptional lustre, durability and strength
- Compact sized model
- Rear-positioned drain hole for maximum usable bowl and cabinet storage space
- Zero-radius corners, X-pattern drain grooves
- 3 1/2" (90 mm) stainless steel strainer included
- Undermount clips, template included
- Limited Lifetime Warranty

DESIGN AND PLANNING TIPS

Cabinet Size: 36" (915 mm)

Depending on cabinet construction, a different cabinet size may be required.
Consult the cabinet manufacturer.

WARRANTY

Limited Lifetime warranty

Code/Standards Compliance

BLANCO sinks and faucets are third-party tested and certified to CSA, cUPC, ANSI/ASME and NSF standards and listed by applicable certification bodies. For more information on individual product listings, contact our office or listing organization.

BLANCO CANADA
100 Corporation Drive
Brampton, ON L6S 6B5


Tel: 905 494 2400
Fax: 905 494 2425
www.blancocanada.com

Toll Free: 1 877 425 2626
Toll Free: 1 877 825 2626

© 2016 BLANCO CANADA




Suite 106
Hampton

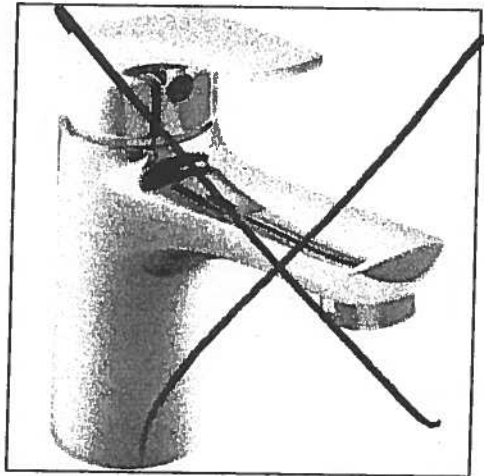


Delta Wynne Chrome Single Lever
Lavatory Faucet With Pop Up
#534LF

Master Ensuite
Shower
ceiling.

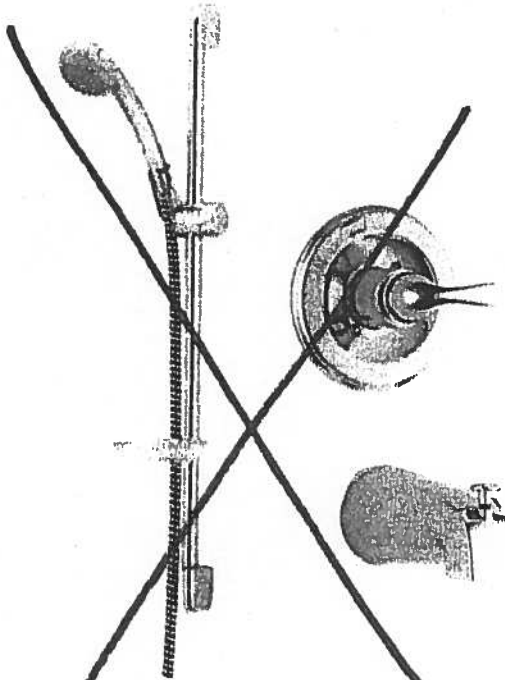

Delta Shower Trim with Tub Spout and
Hansgrohe Slide Bar with Handheld
#R10000/T13020-CDN/2001-TP/27454002/
27744000

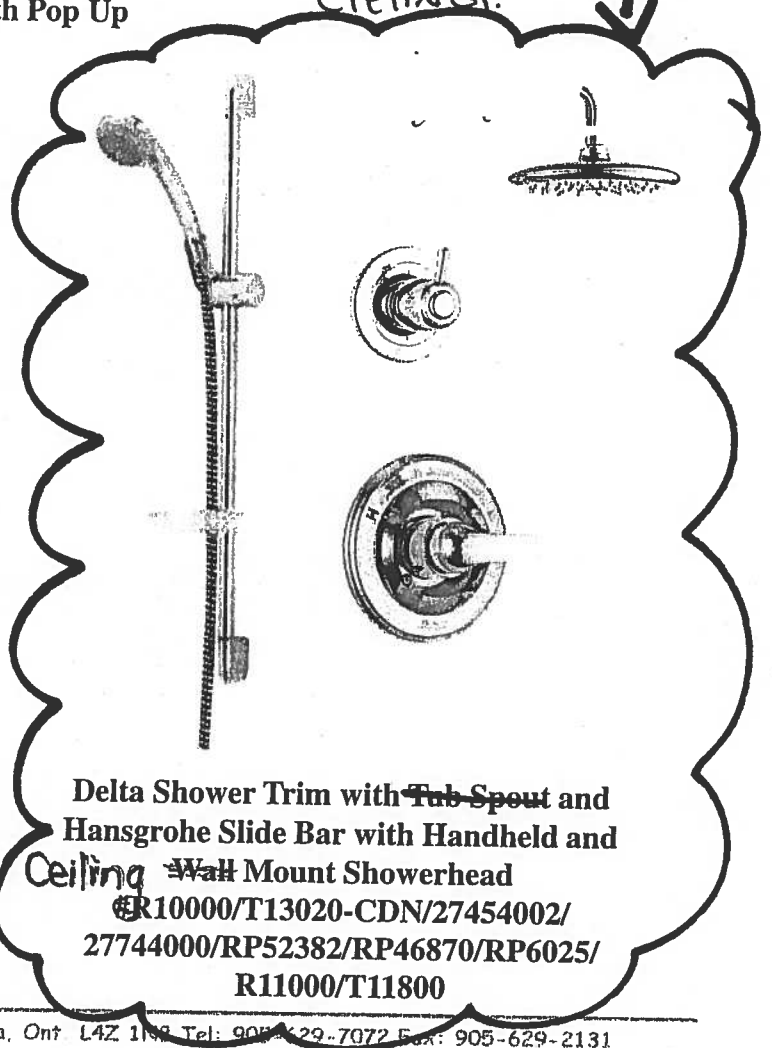

Delta Shower Trim with ~~Tub Spout~~ and
Hansgrohe Slide Bar with Handheld and
Ceiling ~~Wall~~ Mount Showerhead
#R10000/T13020-CDN/27454002/
27744000/RP52382/RP46870/RP6025/
R11000/T11800

Suite 106 Hampton

Oct. 12, 2017
(4/4) (16)

WRT318FZDM

Standard



<http://www.whirlpool.com>

0-inch Wide Top-Freezer Refrigerator with
Flexi-Slide™ Bin - 18.2 cu. ft.

Key Features:

- Flexi-Slide™ Bin
- Frameless Glass Shelves
- Electronic Temperature Control
- Clear, Humidity Controlled Crispers

Product Dimensions:

Height: 65 7/8

Width: 29 3/4

Depth: 33 1/2


Additional Information:

[Use And Care Guide](#)

[Dimension Guide](#)

[Energy Guide](#)

[Warranty Certificate](#)

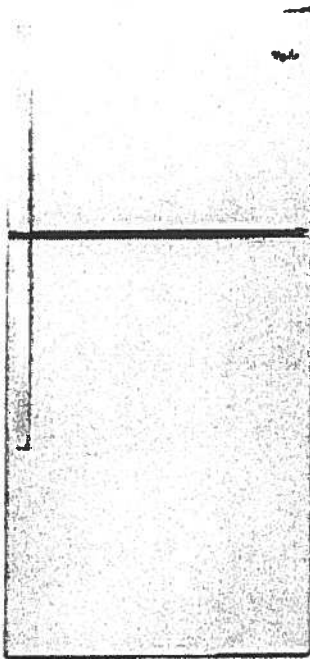

Available in:

- Black
- Monochromatic
Stainless Steel
- White



©Registered trademark/TM Trademark of Whirlpool, U.S.A. © 2013 Whirlpool Corporation. All Rights Reserved.
All other trademarks are owned by their respective companies.
Because Whirlpool Corporation policy includes a continuous commitment to improve our products, we reserve the right to change materials and specifications without notice. We also reserve the right to discontinue or transition products without notice.
Manufacturer's Suggested Retail Price (MSRP) and Minimum Advertised Price (MAP) provided for reference purposes only. Dealer alone determines advertised and retail prices.
Created On: Monday, March 14, 2016 12:09:07

Standard

Suite 106 Hampton

Oct 12, 2017



WEE510S0FS

Whirlpool® 4.8 cu. ft. Guided Electric Front Control Range
With The Easy-Wipe Ceramic Glass Cooktop

MSRP: \$1,149 00



Available Colors	
☒	Black Model: WEE510S0FB MAJOR APPLIANCE
☒	Black-on-Stainless Model: WEE510S0FS MAJOR APPLIANCE
☐	White Model: WEE510S0FW MAJOR APPLIANCE

Dimensions	
Depth	28 15/16 Inches
Width	29 7/8 Inches
Gross Weight	172 LB
Dimensions shown are for planning purposes only. For complete information, see Installation Instructions packed with product.	

Specifications	
Cooktop Features	
Cooktop Element Style	Smoothtop
Cooktop Surface Color	Color Coordinated Black on Stainless
Cooktop Surface Material	Glass
Number of Cooking Element-Burners	4
Left Front Element-Burner Power	3000W
Left Front Element-Burner Size	9"6"
Left Front Element-Burner Type	Dual
Left Rear Element-Burner Power	1200W
Left Rear Element-Burner Size	6"
Left Rear Element-Burner Type	Radiant
Right Front Element-Burner Power	3000W
Right Front Element-Burner Size	9"6"
Right Front Element-Burner Type	Dual
Right Rear Element-Burner Power	1200W
Right Rear Element-Burner Size	6"
Right Rear Element-Burner Type	Radiant
Oven Features	
Number of Oven Lights	1
Hot Surface Indicator Light	Yes
Power On Indicator Light	Yes
Light Type	Incandescent
Oven Rack Type	Standard (Both)
Controls	
Drawer Type	Storage Drawer
Selections	Clock; Timer; Warm Hold; Delay Start; Cook Time Indicator; Control Lock; Automatic Door Latch; Audible Signal; Sabbath Mode; Frozen Bake
ADA Compliant	ADA Height and Operation Compliant
Dimensions	
Depth	28 15/16 Inches
Width	29 7/8 Inches
General	
ADA Compliant	ADA Height and Operation Compliant

Key Features	
Frozen Bake™ Technology	
Guided Cooktop Controls	
Flex-Heat™ Dual Radiant Elements	
Adjustable Self-Cleaning	
Easy-Wipe Ceramic Glass Cooktop	
Temperature Sensor	
4.8 Cu. Ft. Capacity	
Keep Warm Option	
Closed Door Broiling	
Delay Cook	
Sabbath Mode	
Star-K Certified	
ADA Compliant	
#1 Selling Appliance Brand in the U.S.A.	

Product Literature	
Warranty(33.12 KB)	
Owners Manual(502.10 KB)	
Installation Instructions(995.40 KB)	
Dimension Guide(124.36 KB)	
You may need to install Adobe Acrobat Reader to view these documents.	

UPC Listing	
Model "WEE510S0FB" UPC: 883049391939	
Model "WEE510S0FS" UPC: 883049391946	
Model "WEE510S0FW" UPC: 883049391922	

Standard Suite 106 Hampton

Oct. 12, 2017

gbl kw

WMH31017FS

Whirlpool®

<http://www.whirlpool.com>

7 cu. ft. Microwave Hood Combination with
Electronic Controls

Key Features:

- Microwave Presets
- Electronic Touch Controls
- Dishwasher-Safe Turntable Plate
- 2-Speed, 300 CFM Vent Fan
- Add 30 Seconds Option
- Adjustable Cooktop Lighting
- #1 Selling Appliance Brand in the U.S.A.

Product Dimensions:

Height: 17 1/4

Width: 29 15/16

Depth: 17 7/8


Additional Information:

[Use And Care Guide](#)

[Dimension Guide](#)

[Installation Guide](#)

[Warranty Certificate](#)

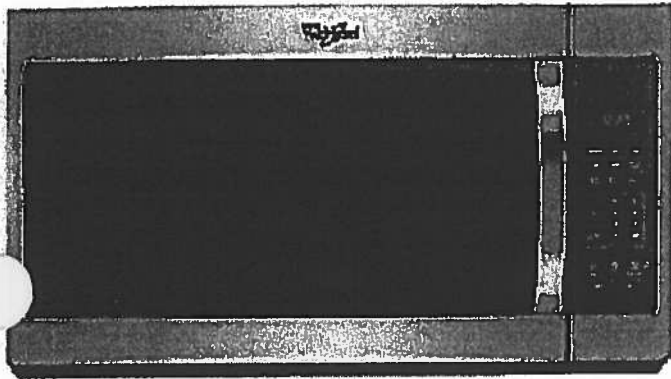

Available in:

- Black
- Silver
- Stainless Steel
- White

©Registered trademark/TM Trademark of Whirlpool, U.S.A. © 2016 Whirlpool Corporation All Rights Reserved.
All other trademarks are owned by their respective companies.
Because Whirlpool Corporation policy includes a continuous commitment to improve our products, we reserve the right to change materials and specifications without notice. We also reserve the right to discontinue or transition products without notice.
Manufacturer's Suggested Retail Price (MSRP) and Minimum Advertised Price (MAP) provided for reference purposes only. Dealer alone determines advertised and retail prices.
Created On: Tuesday, February 07, 2017 12:20:03

Standard

Suite 106 Hampton

Oct. 12, 2017


~~2/1~~ KW

WDF330PAHS

Whirlpool®

<http://www.whirlpool.com>

Heavy-Duty Dishwasher with 1-hour Wash Cycle

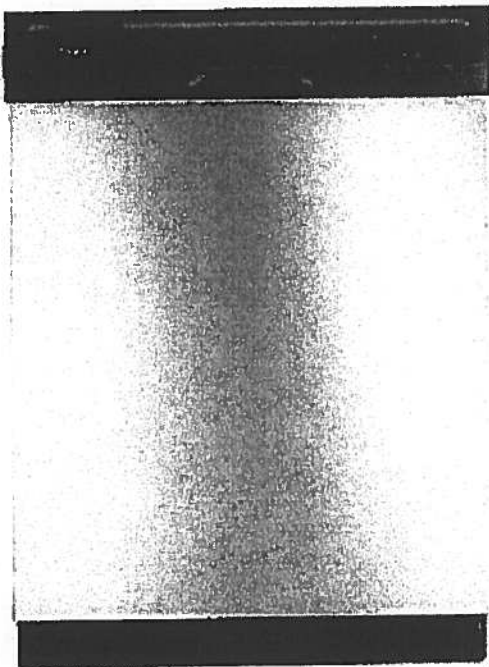

Key Features:

- 1-Hour Wash Cycle
- No One Has Fewer Repairs 20 Years in a Row
- Soil Sensor
- Normal Cycle
- Heavy Cycle
- High Temperature Wash Option
- Heated Dry Option
- Designed, Engineered and Assembled in the U.S.A. with American Pride

Product Dimensions:

Height: 34 1/2

Width: 23 7/8

Depth: 24 1/2

Additional Information:

[Use And Care Guide](#)

[Dimension Guide](#)

[Installation Guide](#)

[Energy Guide](#)

[Warranty Certificate](#)

INVESTED
IN
AMERICA



©Registered trademark/TM Trademark of Whirlpool, U.S.A. © 2016 Whirlpool Corporation. All Rights Reserved
All other trademarks are owned by their respective companies.
Because Whirlpool Corporation policy includes a continuous commitment to improve our products, we reserve the right to change materials and specifications without notice. We also reserve the right to discontinue or transition products without notice.
Manufacturer's Suggested Retail Price (MSRP) and Minimum Advertised Price (MAP) provided for reference purposes only. Dealer alone determines advertised and retail prices.
Created On: Wednesday, April 19, 2017 10:48:05

Oct. 12, 2017



Standard

Suite 106
Hampton

WET4027EW

Combination Washer/Electric Dryer



<http://www.whirlpool.com>

Key Features:

- HE Agitator with Fabric Softener Cap
- White Porcelain Basket
- AutoDry™ Drying System
- 3 Drying Temperatures
- 2.5 Cu. Ft. Washer Capacity
- 5.9 Cu. Ft. Dryer Capacity
- Fabric Softener Dispenser
- Bleach Dispenser

Product Dimensions:

Height: 71 3/4

Width: 27 1/2

Depth: 32

Electrical Requirements:

30.

Additional Information:

[Use And Care Guide](#)

[Dimension Guide](#)

[Installation Guide](#)

[Energy Guide](#)

[Warranty Certificate](#)

Available in:

☐ White

INVESTED
IN
AMERICA



©Registered trademark/TM Trademark of Whirlpool, U.S.A. © 2013 Whirlpool Corporation. All Rights Reserved.
All other trademarks are owned by their respective companies.
Because Whirlpool Corporation policy includes a continuous commitment to improve our products, we reserve the right to change materials and specifications without notice. We also reserve the right to discontinue or transition products without notice.
Manufacturer's Suggested Retail Price (MSRP) and Minimum Advertised Price (MAP) provided for reference purposes only. Dealer alone determines advertised and retail prices.
Created On: Friday, March 11 2016 12:26:17