




Glen Cove

#107

1,162 SQ FT *plus 168 sq. ft. of balcony area*

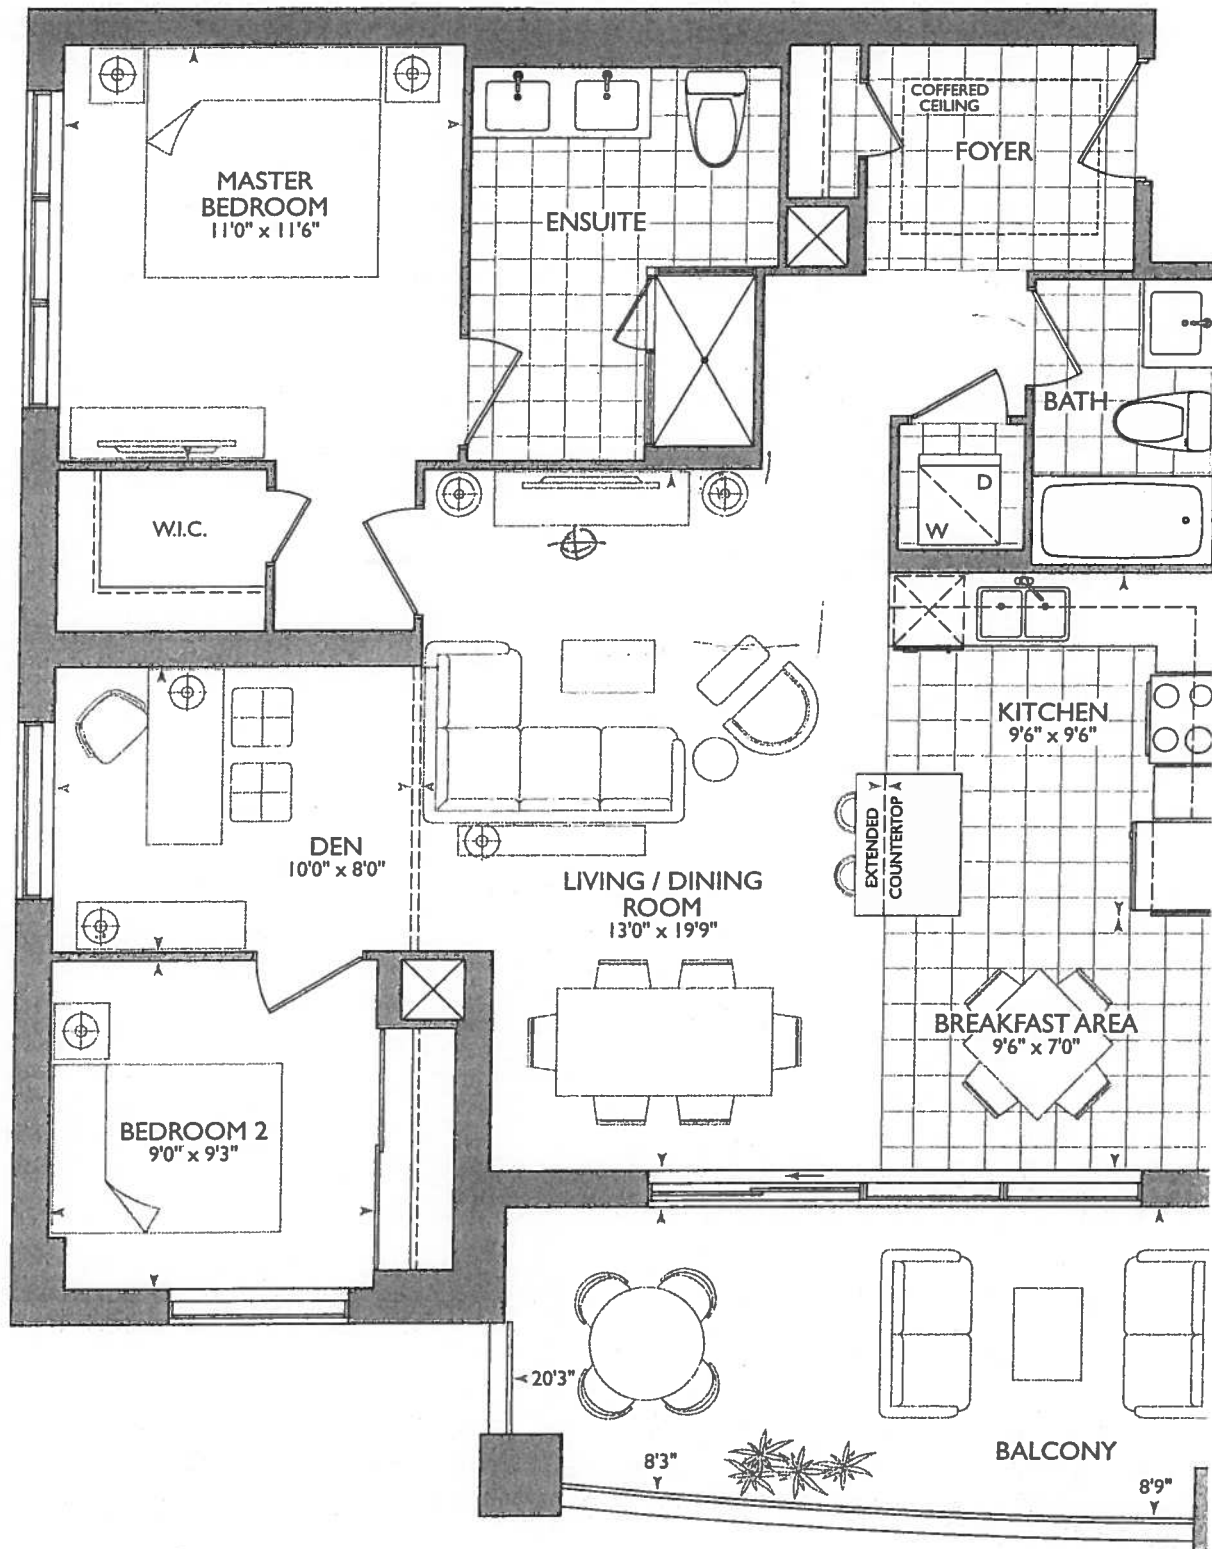

ORIGINAL
SUITE



*Smooth Ceiling

Oct. 10, 2017
 (SD) (LK)

KITCHEN


- Ⓟ = (x2) = PLUGS ISLAND
- 6'9" = STOVE PIPE CENTER
- 6'7 3/4" = SINK PIPE CENTER
- (6x) = PUCK LIGHTS.
- (1x) = CENTER LIGHT OVER ISLAND
- UP GRADE #1 - APPLIANCE PACKAGE
- MAIN @ ENSUITE RAISED VANITIES 36"14" + 3" SPLASH

* KITCHEN ISLAND EXTENDED *
 (+) STARTED TOWARDS FRIDGE/STOVE WALL

* BARRIER FREE SUITE *

• MASTER ENSUITE BUILD OUT WALLS
 BESIDE SHOWER 4" PAST SHOWER BASE.
 (if poss.)

LEGEND:	
	SECURITY PANEL
	EP ELECTRICAL PANEL
	CP COMMUNICATION PANEL
	WM WATER METER
	F FRIDGE
	DROPPED AREA
	6" CROWN MOLDING
	BARRIER FREE SUITE

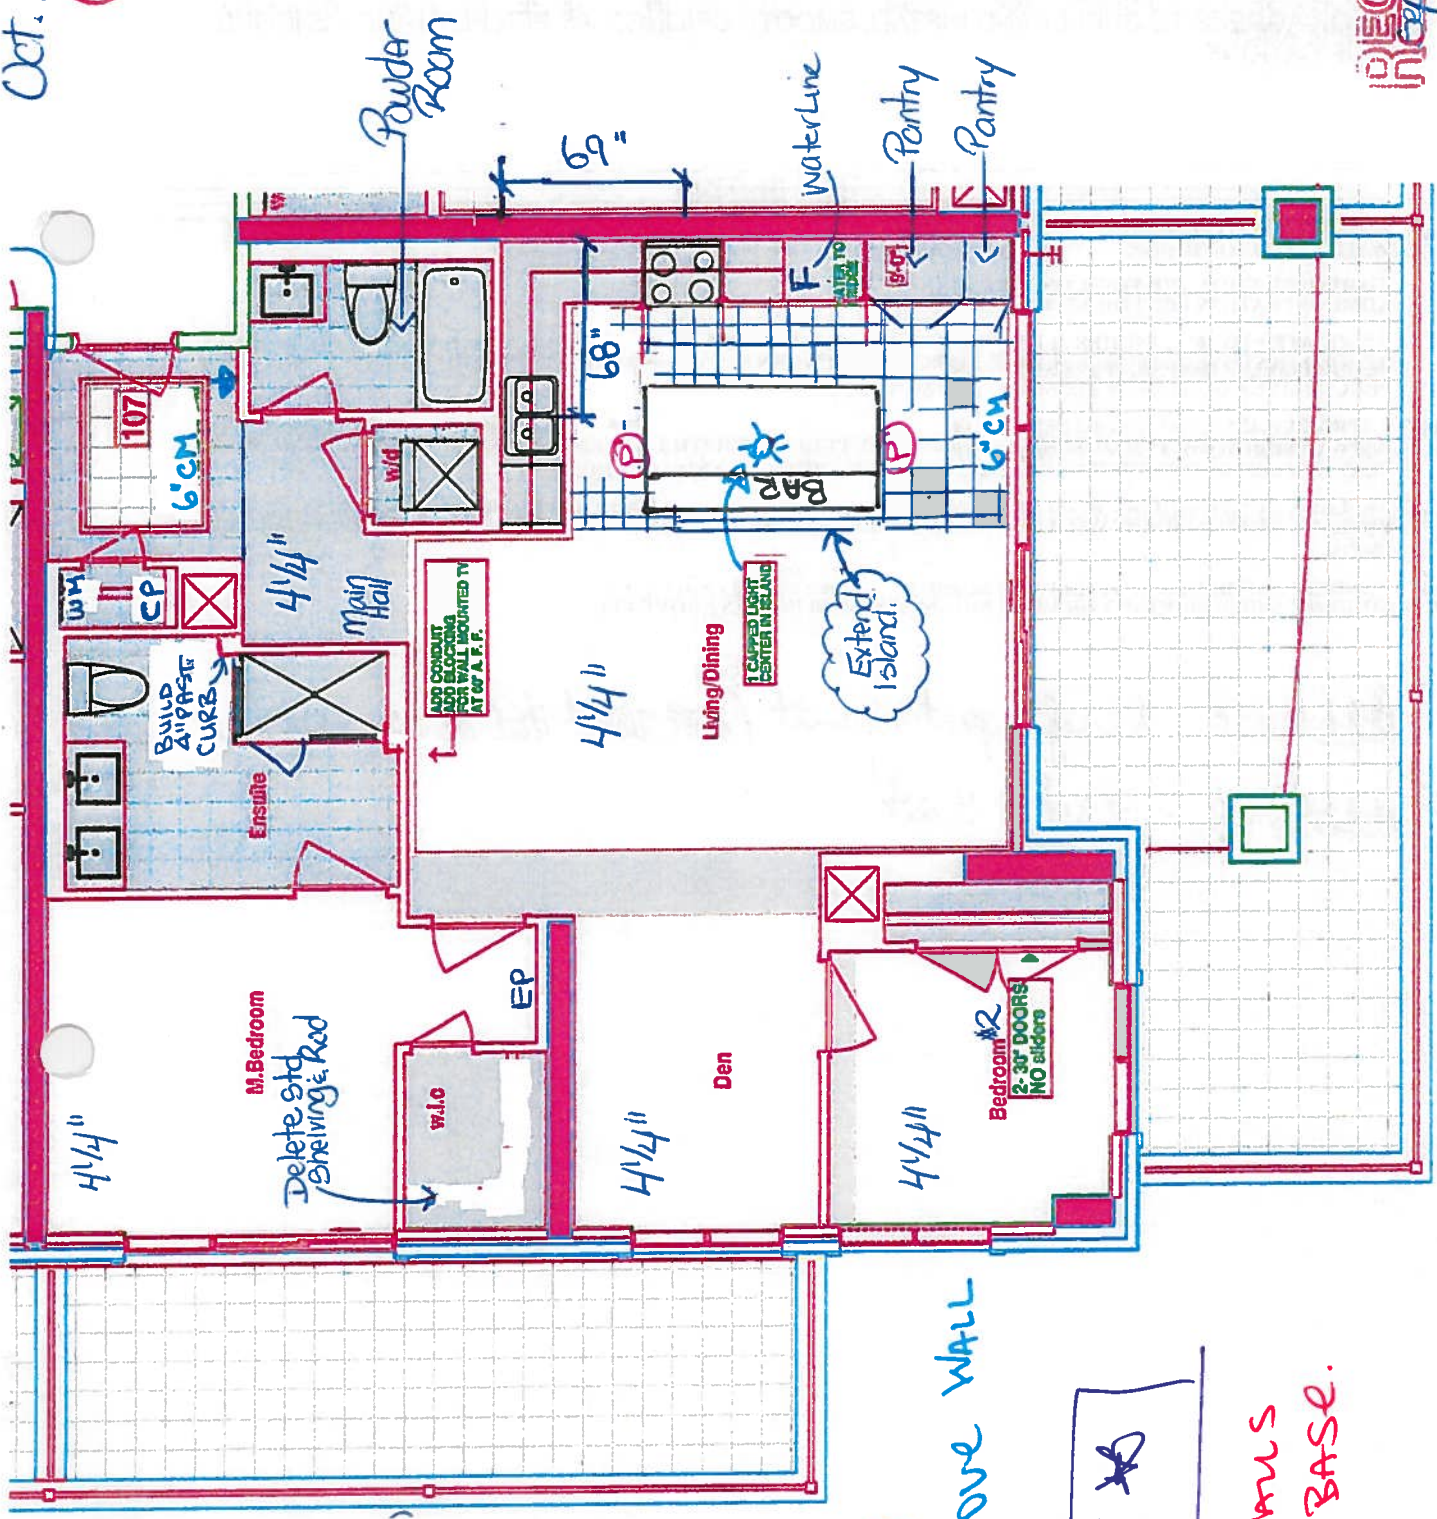

RECEIVED
 10/25/17



SITE COPY

CONSTRUCTION SUMMARY

Hampton Place

PURCHASERS: LYNDA STEWART DAME and DENIS ARMAND DAME

TEL: RES.: 905-642-2860

LOT NUMBER	PHASE	HOUSE TYPE	CLOSING DATE
107	1	GLEN COVE(2H+D-P)	06-Sep-18

Offer / Note:	PURCHASER TO RECEIVE \$10,000(INCLUDES APPLICABLE TAXES) WORTH OF UPGRADES AT THE DECOR CENTER AT TIME OF COLOUR CHART.
Offer / Note:	VENDOR AGREES TO SUPPLY AND INSTALL SMOOTH CEILINGS, AS PER PLAN AND VENDORS SPECIFICATIONS.
Offer / Note:	ADDITIONAL - SINGLE PARKING UNIT (amendment done during conditional period)
Offer / Note:	ADDITIONAL - LOCKER UNIT
Offer / Note:	WATER LINE TO FRIDGE
Offer / Note:	ADMINISTRATION FEE FOR KITCHEN CHANGE
Offer / Note:	RELOCATE STOVE 22 INCHES , LEAVE 24 INCHES BETWEEN STOVE AND FRIDGE AND SHIFT SUPPLIED KITCHEN PLUG ABOVE COUNTER, IF POSSIBLE AS PER SKETCH
Offer / Note:	EXTRA CEILING CAPPED OUTLET ABOVE ISLAND, PURCHASER WILL EXTEND SIZE OF ISLAND APPROXIMATLEY 3 FEET AT TIME OF DECOR CENTER, CENTER LIGHT ABOVE ISLAND ACCORDINGLY
Offer / Note:	REPLACE GLASS SLIDERS WITH STANDARD SWING DOORS IN BEDROOM 2 AS PER VENDORS SAMPLES (SET OF TWO)
Offer / Note:	CONDUIT AND BLOCKING FOR WALL MOUNTED TV (60 INCHES ABOVE FF)

+ NO BULKHEAD OVER ISLAND
CROWN MOULDING IN LIVING /DINING ROOM + KITCHEN +
BREAKFAST AREA



SITE COPY

CONSTRUCTION SUMMARY
Hampton Place

PURCHASERS: LYNDA STEWART DAME and DENIS ARMAND DAME

TEL: RES.: 905-642-2860

LOT NUMBER	PHASE	HOUSE TYPE	CLOSING DATE
107	1	GLEN COVE(2H+D-P)	06-Sep-18

Date Added: 11-Oct-17 Invoice Number: 6963

CLARIFICATION - BATHROOM ACCESSORIES;
POWDER ROOM & MASTER ENSUITE - DELETE Do Not Supply / Install / Credit Purchaser for builders standard ceramic bathroom accessories (toilet paper, towel bar & soap dish) throughout Powder Room & Master Ensuite
Note: (See Sketch)

1 - CLARIFICATION;
POWDER ROOM & MASTER ENSUITE - Install Builders Standard Plumbing Fixtures throughout all bathrooms where applicable. To Include; Powder Room & Master Ensuite (See Sketch)
Note: See Below Item for Upgrade Toilet at Master Ensuite

1 - MASTER ENSUITE - Install UPGRADE Toilet at Master Ensuite - CONTRAC - CALI 4.8L Elongated One Piece Toilet with Smooth Close Seat - Model # 4710-BOVU - White (See Sketch)
Note:

1 - MASTER BEDROOM - DELETE Do Not Install / Supply / Credit Purchaser for builders standard Wire Shelving & Standard Rod at Master Ensuite Closet ONLY (To be Completed ONLY IF POSSIBLE) (See Sketch)
Note: Purchaser accepts & acknowledges this upgrade request will ONLY be Completed IF POSSIBLE

1 - MASTER ENSUITE - Standard Glass Enclosure will be installed at standard height and will NOT Touch the Ceiling at the Master Ensuite shower stall. Standard Chrome Header to be Installed at Glass Enclosure. (See Sketch)
Note: Purchaser accepts & acknowledges Glass Enclosure will NOT touch the ceiling at master ensuite shower stall.

1 - BONUS PACKAGE - PURCHASER HAS APPLIED \$10,000.00 (Includes Taxes) UPGRADE PROMOTIONAL PACKAGE TOWARDS THE PURCHASE PURCHASE OF UPGRADES COMPLETED AT THE DECOR CENTRE.

1 - PURCHASER HAS ATTENDED A COLOR APPOINTMENT AT THE DECOR CENTRE AND HAS DECLINED ANY ADDITIONAL UPGRADES. Purchaser accepts and acknowledges that there will be no further changes/additions/deletions to be made upon signing on October 10,2017
Note:

1 - PURCHASER AWARE AND ACCEPTS THAT ANY CHANGES MADE TO UPGRADES AFTER SIGNING THIS PURCHASERS EXTRA FORM ARE SUBJECT TO A MINIMUM ADMINISTRATION FEE OF \$1,000 PLUS A 10% HOLDBACK FEE.
Note:

This Document is Extremely Time Sensitive - Printed 22 Jan 18 at 16:44



* INTERIOR COLOR SCHEME *

Purchasers LYNDA STEWART DAME & DENIS ARMAND DAME		Decor Consultant Melissa Di Marino	Model Type GLEN COVE(2H+D-P)	Telephone Res. / Bus (905) 642-2860 /	Project Hampton Place	osing Date 06/09/2018	Unit 107
--	--	---------------------------------------	---------------------------------	--	--------------------------	--------------------------	-------------

Page 2 of 3

CABINETS, VANITIES AND COUNTERTOPS

	Style	Countertop	Counter Edge	Handle / Knob
MAIN BATHROOM	N/A	N/A	N/A	N/A
MASTER ENSUITE	CATEGORY 2 - MAPLE - CHESTNUT QT 2503 (STD)	☒	☒ A " EDGE (STD)	B603-SC
POWDER ROOM	CATEGORY 1 - MDF - WHITE QT 1203 (STD)	☒	☒ A " EDGE (STD)	B603-SC
KITCHEN / DINETTE	CATEGORY 1 - MDF - WHITE QT 1203 (STD)	☒	☒ M " EDGE (UPG)	RC902-SN(Upg)
LAUNDRY ROOM	N/A	N/A	N/A	N/A

APPLIANCE PACKAGE

Upgrade Package #1

Std 31in Opening

PLUMBING FIXTURES

KITCHEN	Sink Model	☒ UPG - Blanco Quattrus # 401248
	Sink Faucet	☒ UPG - Delta Mateo # 9183-DST Chrome
TOILETS	Master Ensuite	☒ UPG- Contrac Cali #4710-BOVU
	Main Bathroom	N/A
	Powder Room	STANDARD
VANITY FAUCETS	Master Ensuite	STANDARD
	Main Bathroom	N/A
	Powder Room	STANDARD
VANITY SINKS	Master Ensuite	STANDARD
	Main Bathroom	N/A
	Powder Room	STANDARD
SHOWER STALL / TUBS	Master Ensuite Shower Stall	STANDARD
	Master Ensuite Tub	N/A
	Main Bathroom Tub	STANDARD

Trim

Baseboard & Casing	STANDARD
Interior Doors	STANDARD - CARRARA SMOOTH
Cornice Moulding / Medallion	
Foyer	☒ STANDARD - # CTR-611
Living Room	☒ STANDARD - # CTR-611
Dining Room	☒ STANDARD - # CTR-611
KITCHEN	☒ STANDARD - # CTR-611
Master Bedroom	N/A
Bedroom 2	N/A
Bedroom 3	N/A

Levers

Door Height	STANDARD
Door Height	STANDARD

Fireplace

Fireplace	N/A
Location Flooring	N/A
Style	N/A
Finish	N/A
Marble	N/A
Hearth	N/A

Paint Throughout

Walls	☒ BIRCH WHITE
Trim	STANDARD - WHITE

Page 2 of 3

Decor Consultant:

Melissa Di Marino

Purchaser:

LYNDA STEWART DAME

Purchaser:

DENIS ARMAND DAME

Vendor:

Hampton Place

Lot: 107 Project: Hampton Place Model: GLEN COVE(2H+D-P)

Printed Oct 10, 2017 1:49 pm

Suite 107 Hampton


(P) = 2x Plugs Island

(6x) = RUCK LIGHTS

(1x) = LIGHT Centered OVER ISLAND

UPGRADE = APPLIANCE PACKAGE

MAN/ENSUITE RANSO VANITIES 36" W x 24" D SPLASH

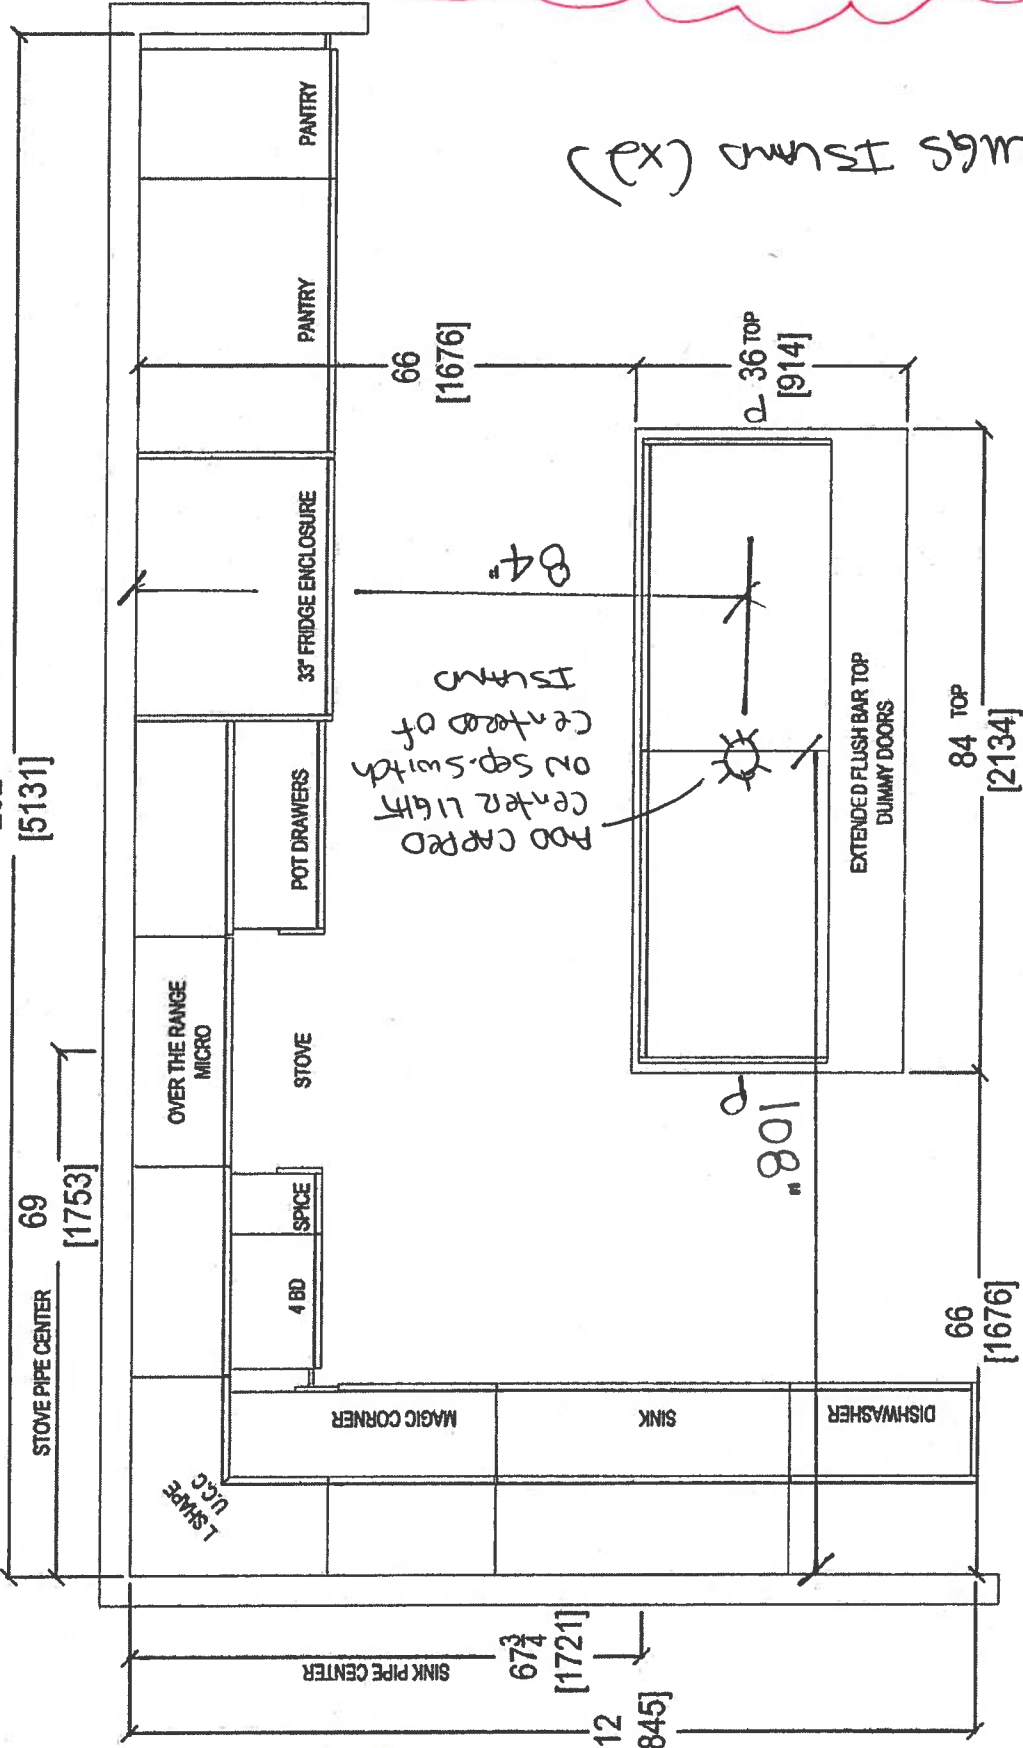

P = Plugs Island (x2)

84" Center of Island
Center light
2x sq. switch

* Kitchen Island Extended
① shifted towards fridge/stove
②


Comments:			
Client: ROYAL PINE HOMES		Unit 107 HMP	Room: KITCHEN FLOOR PLAN
Site: HAMPTON PLACE		Door Style: —	Door Handle: —
Phone: —		Finish: —	Draw Handle: —
Email: —		Species: —	Top: —
Drawn By: SK		Scale: 1/2" = 1' - 0"	Date: AUG 4, 2017
			Page: —



80 SANTE DRIVE, VAUGHAN, ON L4K 3C4,
T: 416.746.1811 F: 905.761.5901

Suite 107 Hampton

PL → Pock Light (x6)

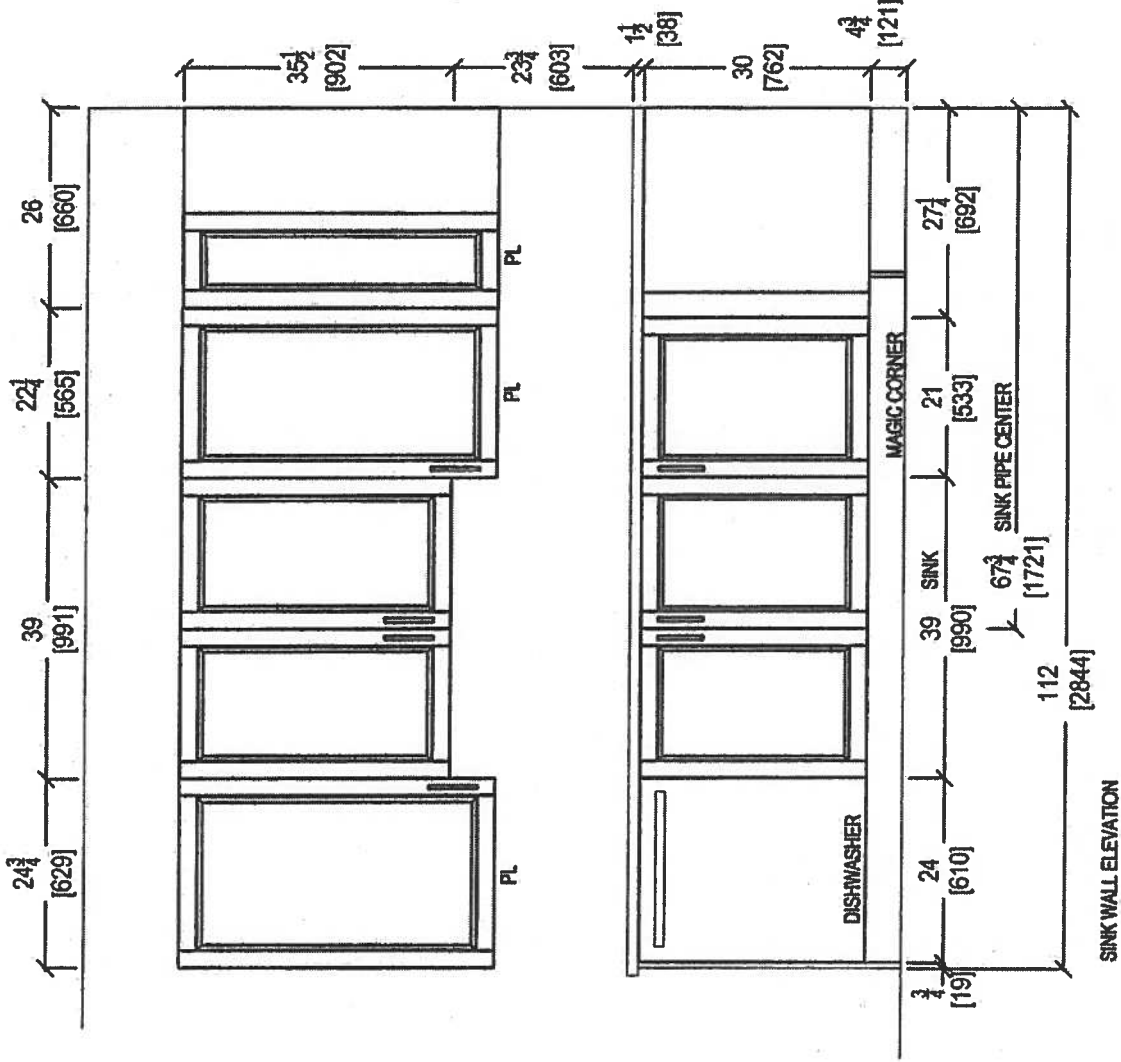


 <i>your kitchen, your taste.</i> 80 SANTE DRIVE, VAUGHAN, ON L4K 3C4, T: 416.746.1611 F: 905.781.5901	CLIENT: ROYAL PINE HOMES		UNIT 107 HMP	ROOM:	KITCHEN	DRAWN BY: SK	COMMENTS: PLEASE NOTE ALL DIMENSIONS ARE NOT FINAL AND ARE SUBJECT TO CHANGE UPON FINAL SITE MEASURE	
	SITE: HAMPTON PLACE	DOOR STYLE: ---	DOOR HANDLE: ---	SCALE: 1/2" = 1' - 0"		DATE: AUG 4, 2017		
	PHONE: ---	FINISH: ---	DRW HANDLE: ---					
	EMAIL: ---	SPECIES: ---	TOP: ---			PAGE: ---		

Suite 107 Hampton

CCT 10, 2017



PL -> Rock Light

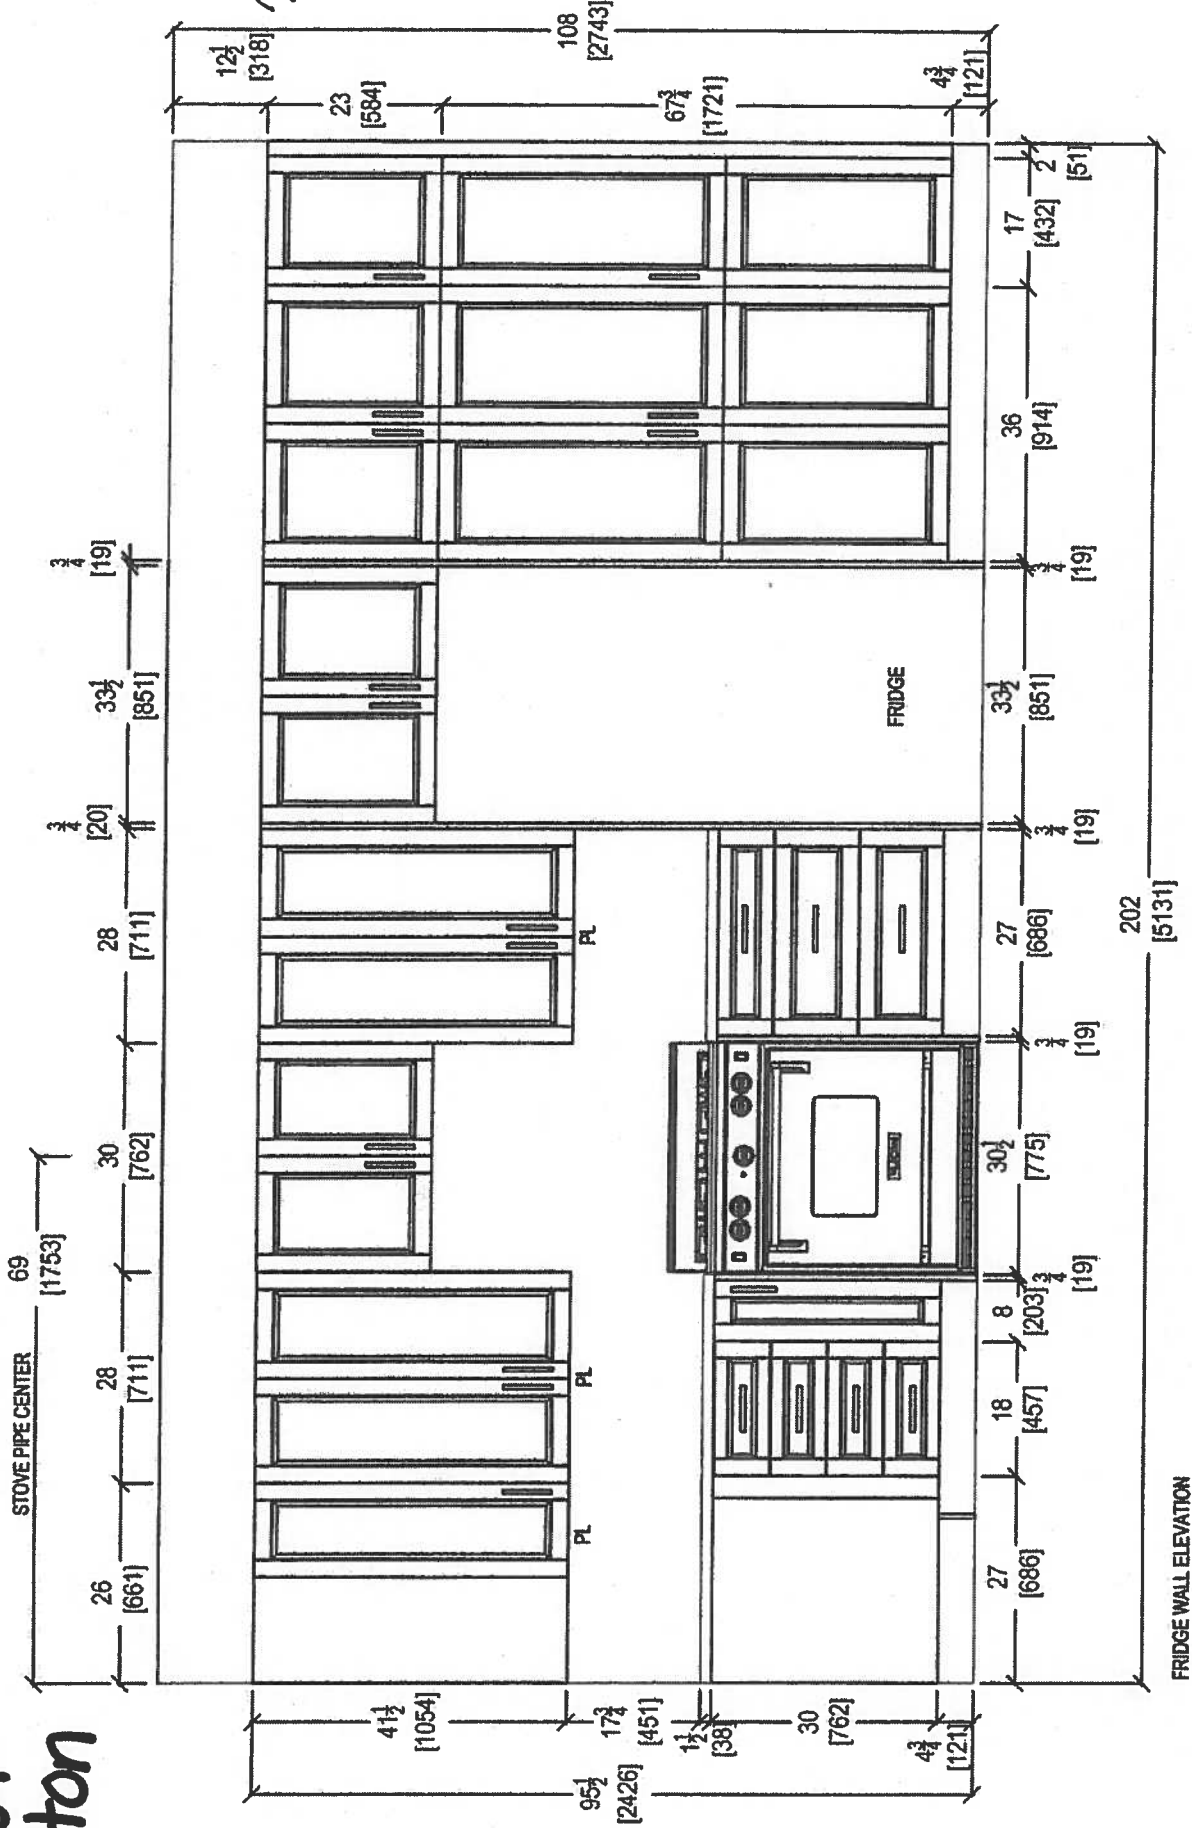


FRIDGE WALL ELEVATION


 your kitchen, your taste. 80 SANTE DRIVE VAUGHAN, ON L4K 3C4. T: 416.748.1811 F: 905.761.5901		CLIENT: ROYAL PINE HOMES SITE: HAMPTON PLACE PHONE: — EMAIL: —	UNIT 107 HMP DOOR STYLE: — FINISH: — SPECIES: —	ROOM: KITCHEN DOOR HANDLE: — DRW HANDLE: — TOP: —	DRAWN BY: SK SCALE: 1/2" = 1' - 0" DATE: AUG 4, 2017 PAGE: —	COMMENTS: PLEASE NOTE ALL DIMENSIONS ARE NOT FINAL AND ARE SUBJECT TO CHANGE UPON FINAL SITE MEASURE
---	--	---	--	--	---	---

Suite 107 Hampton

OCT 10, 2017

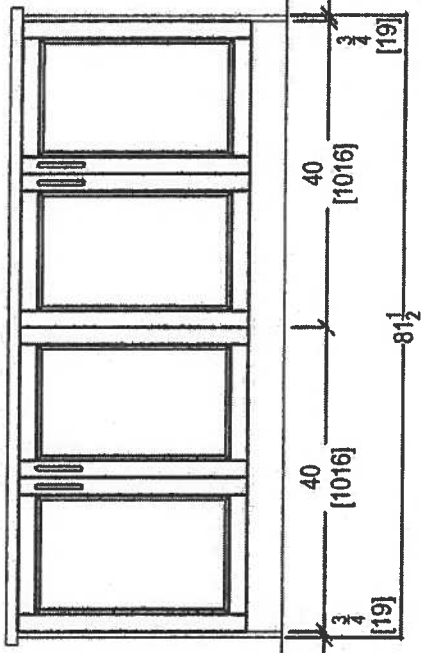

ISLAND FRONT

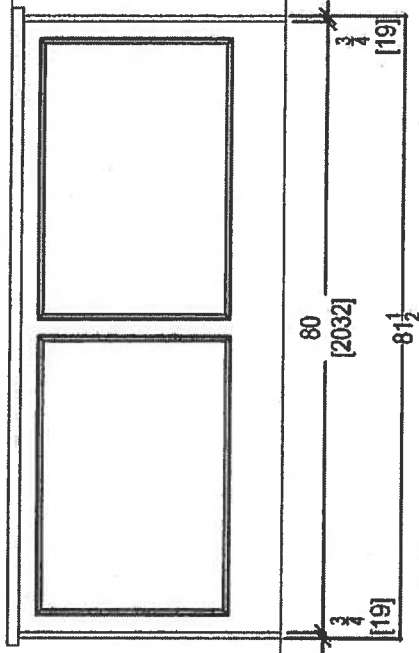

ISLAND REAR



80 SANTE DRIVE, VAUGHAN, ON L4K 3C4,
T: 416.748.1811 F: 905.781.5901

CLIENT: ROYAL PINE HOMES

SITE: HAMPTON PLACE

PHONE: —

EMAIL: —

UNIT 107 HMP

DOOR STYLE: —

FINISH: —

SPECIES: —

ROOM: KITCHEN

DOOR HANDLE: —

DRW HANDLE: —

TOP: —

DRAWN BY: SK

SCALE: 1/2" = 1'-0"

DATE: AUG 4, 2017

PAGE: —


COMMENTS:

PLEASE NOTE ALL DIMENSIONS
ARE NOT FINAL AND ARE
SUBJECT TO CHANGE UPON
FINAL SITE MEASURE

Suite 107 Hampton



CCT. 10 2017

880
AK

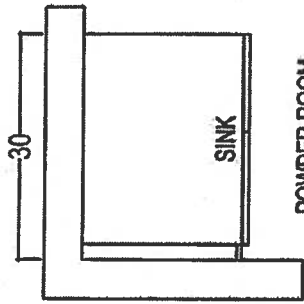


POWDER ROOM

Raised Height = 36 1/4 + 3" splash.

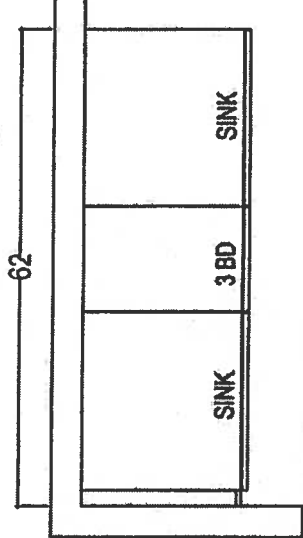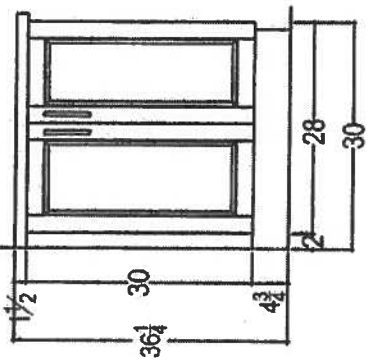

MASTER ENSUITE

Raised Height = 36 1/4 + 3" splash

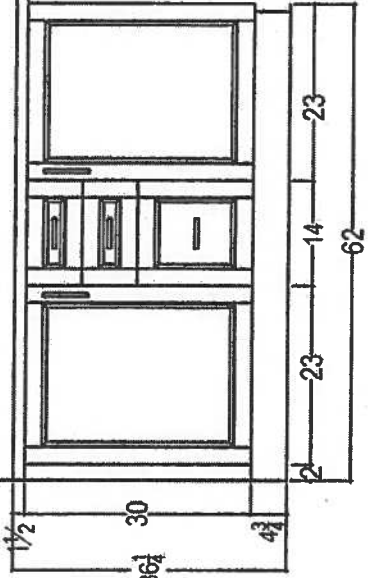


your kitchen, your taste
80 SANTE DRIVE, VAUGHAN, ON L4K 3C4,
T: 416.746.1611 F: 905.761.5501

CLIENT: ROYAL PINE HOMES	GLEN COVE 2H+ D UPGRADE PACKAGE 1	ROOM:	VANITIES	DRAWN BY: SK	COMMENTS: PLEASE NOTE ALL DIMENSIONS ARE NOT FINAL AND ARE SUBJECT TO CHANGE UPON FINAL SITE MEASURE
SITE: HAMPTON PLACE	DOOR STYLE: ---	DOOR HANDLE: ---	SCALE: 1/2" = 1'-0"	SCALE: 1/2" = 1'-0"	
PHONE: ---	FINISH: ---	DRW HANDLE: ---	DATE: AUG 4, 2017	DATE: AUG 4, 2017	
EMAIL: ---	SPECIES: ---	TOP: ---	PAGE: ---	PAGE: ---	



Suite 107
Hampton

October 10, 2011
L10 L11

CONNOLLY Marble & Granite Ltd.	EDGE DETAILS 004
---------------------------------------	------------------------------------

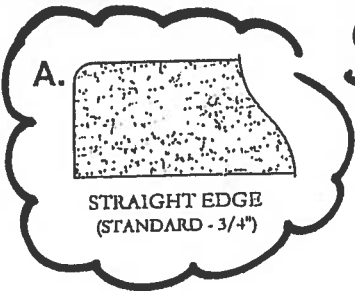

Standard
Powder Room
Master Ensuite

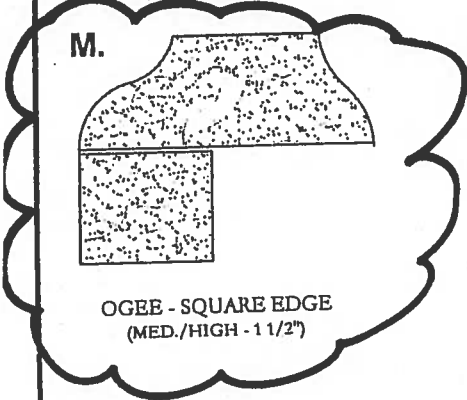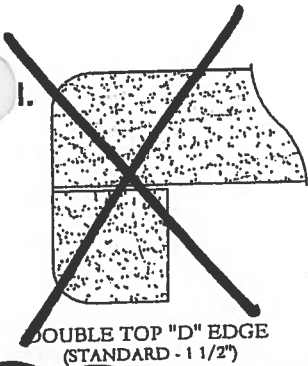


Upgrade
Kitchen

EDGING UP-GRADE OPTIONS

Suite 107
Hampton


Living Room

→ CONDUIT :

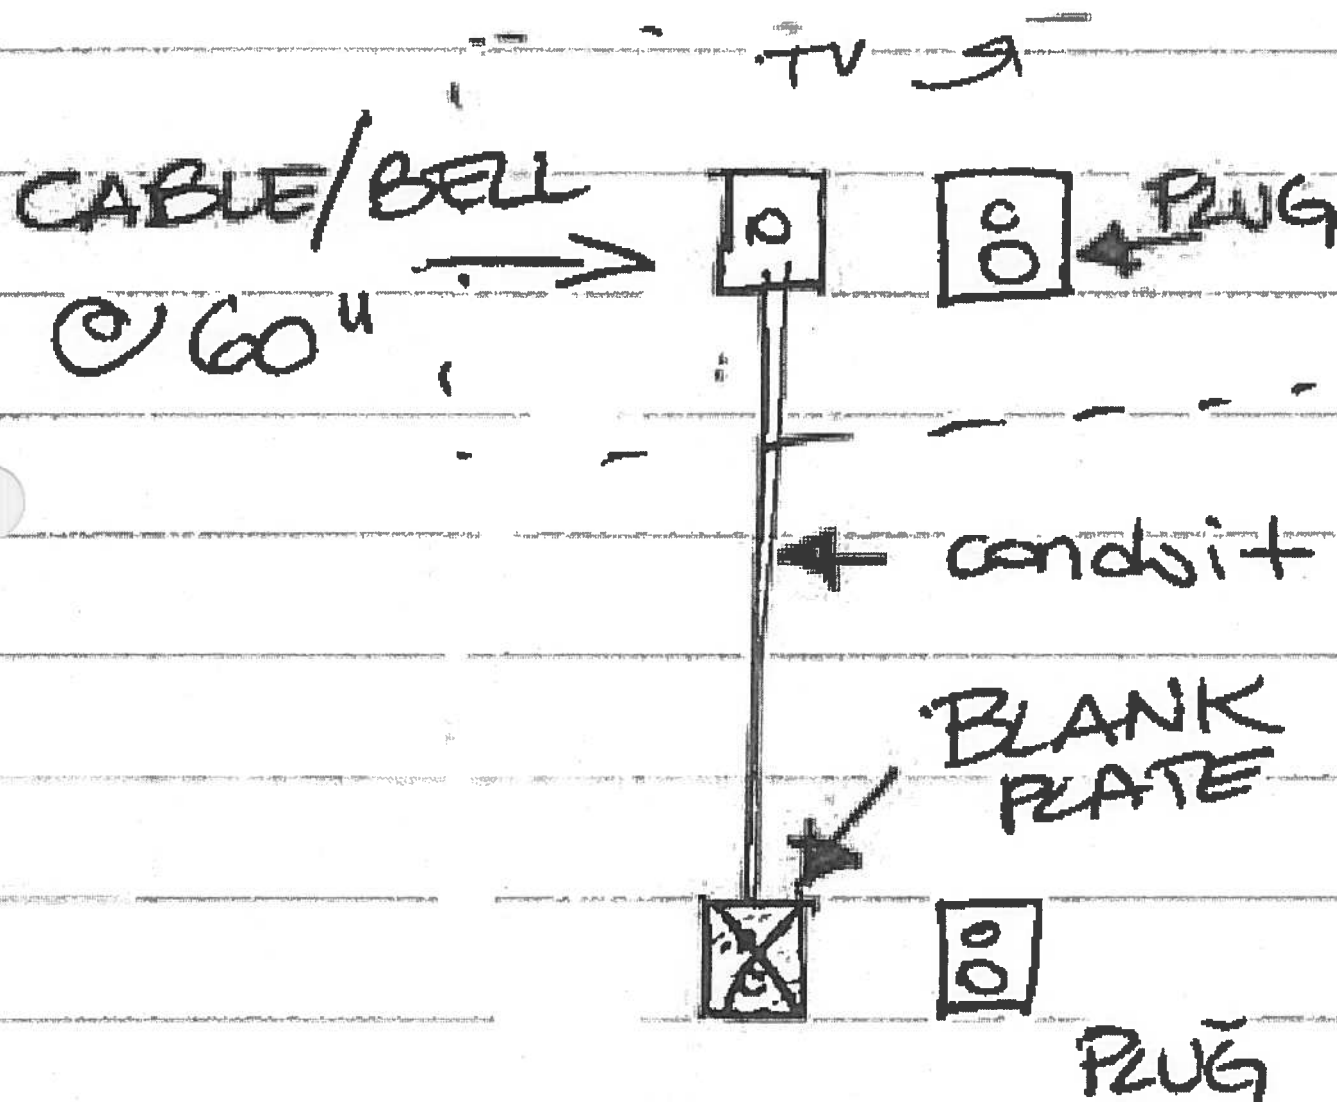



Suite 107 Hampton

Kitchen

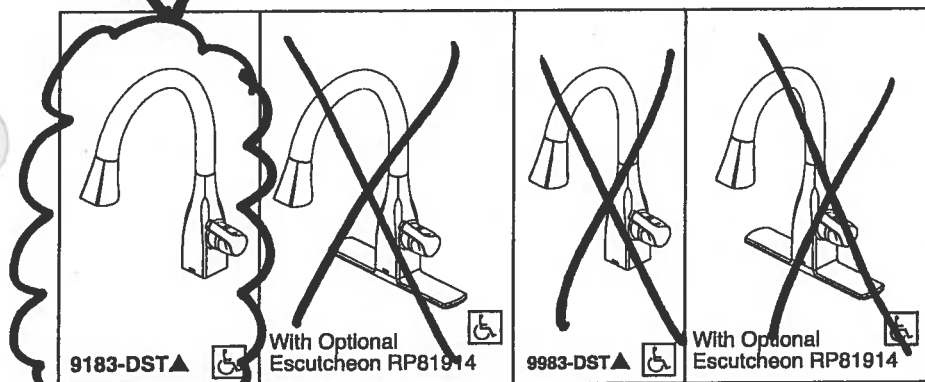

Submitted Model No.: _____

Specific Features: _____

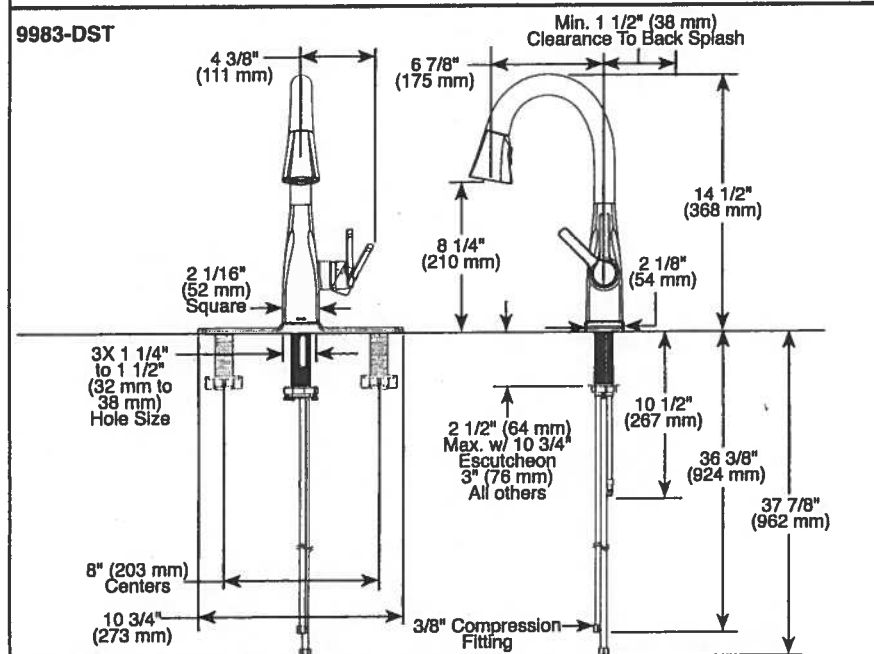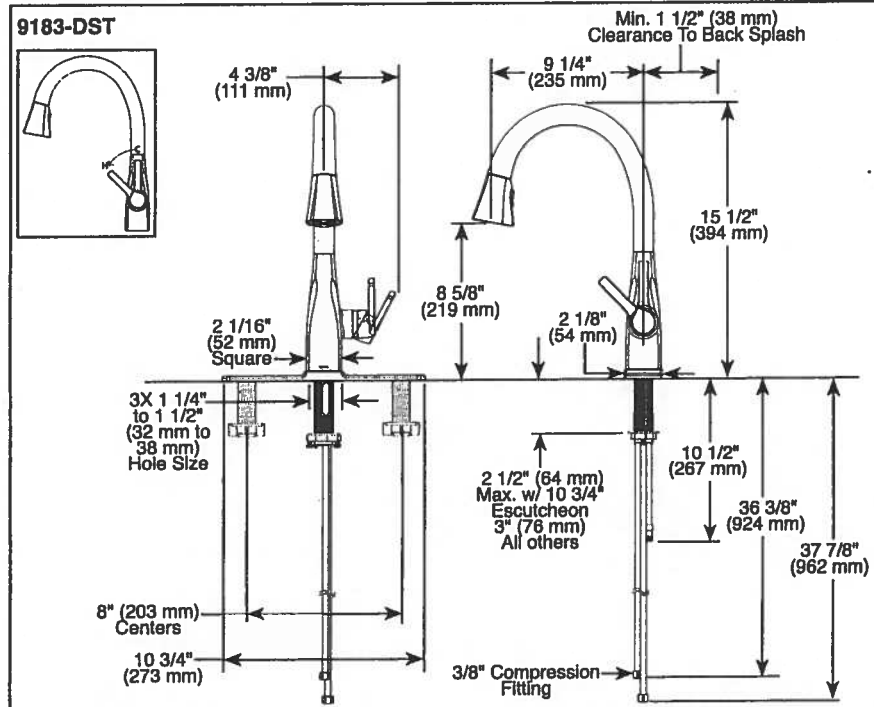

▲ Designate proper finish suffix

Delta reserves the right (1) to make changes in specifications and materials, and (2) to change or discontinue models, both without notice or obligation. Dimensions are for reference only. See current full-line price book or www.deltafaucet.com for finish options and product availability.

DSP-K-9183-DST Rev. B



KITCHEN FAUCETS

- Mateo® Collection
- Single Handle Pull-Down

FEATURES:

- DIAMOND Seal® Technology
- MagnaTite® Magnetic Docking
- Touch-Clean® Sprayhead

STANDARD SPECIFICATIONS:

- 1.8 gpm @ 60 psi, 6.8 L/min @ 414 kPa
- One or three hole mount (Escutcheon optional, not included)
- Diamond coated ceramic cartridge
- 3/8" O.D. straight, staggered PEX supply lines
- Rotating spout
- Red/Blue Indicator markings
- Two-function wand; Aerated stream or spray
- Dual integral check valves in sprayer

WARRANTY

- Lifetime limited warranty on parts (other than electronic parts and batteries) and finishes; or, for commercial users, for 5 years from date of purchase.
- 5 year limited warranty on electronic parts (other than batteries); or, for commercial users, for 1 year from the date of purchase. No warranty is provided on batteries.

COMPLIES WITH:

- ASME A112.18.1 / CSA B125.1
- ASME A112.18.6
- Indicates compliance to ICC/ANSI A117.1
- Verified compliant with .25% weighted average Pb content regulations.



55 E 111th Street, Indianapolis, Indiana 46280
350 South Edgeware Road, St. Thomas, ON N5P 4L1
© 2016 Masco Corporation of Indiana

Suite 107 Hampton

Kitchen


Product Specification Sheet

BLANCO QUATRUS U 1 SUPER SINGLE

Satin brushed finish



PRODUCT DIMENSIONS

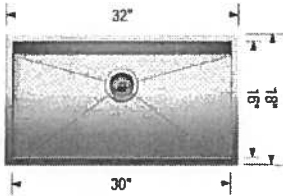

BLANCO QUATRUS U 1 SUPER SINGLE	Colour Finish	Model No.	FEATURES / SPECIFICATIONS
	Satin brushed finish	401248	• German designed and engineered • Premium 304 series, 18 gauge stainless steel • 18/10 chrome-nickel content for exceptional lustre, durability and strength • Compact sized model • Rear-positioned drain hole for maximum usable bowl and cabinet storage space • Zero-radius corners, X-pattern drain grooves • 3 1/2" (90 mm) stainless steel strainer included • Undermount clips, template included • Limited Lifetime Warranty DESIGN AND PLANNING TIPS Cabinet Size: 36" (915 mm) Depending on cabinet construction, a different cabinet size may be required. Consult the cabinet manufacturer.

WARRANTY

Limited Lifetime warranty

Code/Standards Compliance

BLANCO sinks and faucets are third-party tested and certified to CSA, cUPC, ANSI/ASME and NSF standards and listed by applicable certification bodies. For more information on individual product listings, contact our office or listing organization.

BLANCO CANADA
100 Corporation Drive
Brampton, ON L6S 6B5

Tel: 905 494 2400
Fax: 905 494 2425
www.blancocanada.com

Toll Free: 1 877 425 2626
Toll Free: 1 877 825 2626

© 2016 BLANCO CANADA

Suite 107 Hampton



UNLINED TANK
4710BOVU

4.8Lpf
1pc toilet



FEATURES

High efficiency toilet
Elongated bowl with concealed skirted trapway
Vitreous china
16 $\frac{3}{8}$ " Plus Height bowl
Soft white tank lever
12" Rough-in
2" Fully glazed ball pass trapway
3" Flapper
Siphon jet flush action
Water Surface 9 $\frac{1}{2}$ " x 6 $\frac{5}{8}$ "
Decorative soft white side caps included
Smooth close toilet seat included
15 $\frac{1}{2}$ "(W) x 28 $\frac{1}{2}$ "(D) x 29 $\frac{3}{8}$ "(H)

CERTIFICATIONS

IAPMO cUPC
US EPA WaterSense
ASME A112.19.2 / CSA B45.1-2008
ADA Guidelines & ANSI A117.1
MaP tested 800g (Lined tank)
MaP tested 1000g (Unlined tank)
LEED Compliant



COLOUR

Soft white

TOILET SEAT



Included

The images shown are a representation of the finish and color, and may not reflect every characteristic possible.

Master Ensuite

SUITE 107
HAMPTON

OCT. 13, 2017



Upgrade Package I

WRB322DMBM


Whirlpool™

<http://www.whirlpool.com>

33-inches wide Bottom-Freezer Refrigerator with
SpillGuard™ Glass Shelves - 22 cu. ft

Key Features:

- SpillGuard™ Glass Shelves
- Adaptive Defrost
- FreshFlow™ Produce Preserver
- LED Interior Lighting
- ENERGY STAR® Qualified

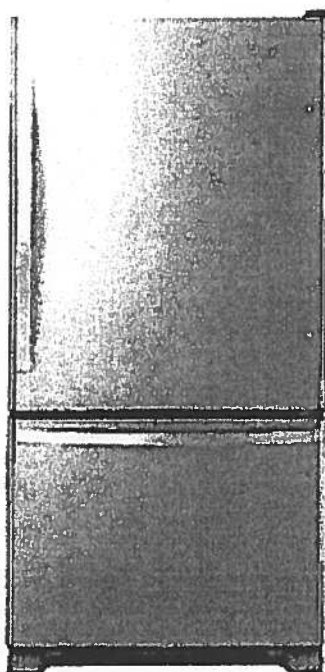

Product Dimensions:

Height: 70

Width: 32 5/8

Depth: 33 3/8

Electrical Requirements:

15

Additional Information:

[Use And Care Guide](#)

[Dimension Guide](#)

[Energy Guide](#)

[Warranty Certificate](#)

INVESTED
IN
AMERICA



©Registered trademark/TM Trademark of Whirlpool, U.S.A. © 2018 Whirlpool Corporation. All Rights Reserved.
All other trademarks are owned by their respective companies.
Because Whirlpool Corporation policy includes a continuous commitment to improve our products, we reserve the right to change materials and specifications without notice. We also reserve the right to discontinue or transition products without notice.
Manufacturer's Suggested Retail Price (MSRP) and Minimum Advertised Price (MAP) provided for reference purposes only. Dealer alone determines advertised and retail prices.
Created On: Tuesday, March 14, 2017 11:30:08

SUITE 107
HAMPTON

OCT. 10, 2017

Upgrade
Package 1



WEE745H0FS

Whirlpool®

6.4 Cu. Ft. Slide-In Electric Range with True
Convection

<http://www.whirlpool.com>



Key Features:

- Frozen Bake™ Technology
- True Convection Cooking
- FlexHeat™ Triple Radiant Element
- Convection Conversion
- AquaLift® Self-Cleaning Technology
- Temperature Sensor
- Rapid Preheat
- 6.4 Cu. Ft. Capacity
- Easy-Wipe Ceramic Glass Cooktop
- Large Oven Window
- Max Capacity Rack
- Hidden Bake Element

Product Dimensions:

Height: 36

Width: 29 7/8

Additional Information:

[Use And Care Guide](#)

[Dimension Guide](#)

[Installation Guide](#)

[Warranty Certificate](#)

INVESTED
IN
AMERICA



©Registered trademark/TM Trademark of Whirlpool, U.S.A. © 2016 Whirlpool Corporation. All Rights Reserved.
All other trademarks are owned by their respective companies.

Because Whirlpool Corporation policy includes a continuous commitment to improve our products, we reserve the right to change materials and specifications without notice. We also reserve the right to discontinue or transition products without notice.

Manufacturer's Suggested Retail Price (MSRP) and Minimum Advertised Price (MAP) provided for reference purposes only. Dealer alone determines advertised and retail prices.

Created On: Friday, January 27, 2017 10:46:47

SUITE 107
HAMPTON

OCT. 10, 2017

Upgrade Package 1



YWMH76719CS

1.9 cu. ft. Microwave Hood Combination with
TimeSavor™ Plus True Convection



<http://www.whirlpool.com>

Key Features:

- TimeSavor™ Plus True Convection Cooking System
- Steam Cooking
- Sensor Cooking
- AccuPop™ Cycle
- CleanRelease® Non-Stick Interior
- SteamClean Option
- Integrated Hidden Vent and Console
- Auto Adapt Fan
- Recessed, Stoppable Glass Turntable
- Universal Microwave Steamer
- 1.9 cu. ft. Capacity
- 1,100 Watts Cooking Power

Product Dimensions:

Height: 17 1/8

Width: 29 15/16

Depth: 18 1/2

Electrical Requirements:

15 or 20. 120 V.

Additional Information:

[Use And Care Guide](#)

[Installation Guide](#)

[Warranty Certificate](#)

Available in:

☒ Stainless Steel



©Registered trademark/TM Trademark of Whirlpool, U.S.A. © 2013 Whirlpool Corporation. All Rights Reserved.
All other trademarks are owned by their respective companies.
Because Whirlpool Corporation policy includes a continuous commitment to improve our products, we reserve the right to change materials and specifications without notice. We also reserve the right to discontinue or transition products without notice.
Manufacturer's Suggested Retail Price (MSRP) and Minimum Advertised Price (MAP) provided for reference purposes only. Dealer alone determines advertised and retail prices.
Created On: Monday, March 14, 2016 13:16:48

SUITE 107
HAMPTON

OCT. 10, 2017

Upgrade
Package 1



WDTA50SAHZ

Whirlpool®

<http://www.whirlpool.com>

Contemporary Design. Stainless Steel Tub
Dishwasher with TotalCoverage Spray Arm

Key Features:

- Sensor Cycle
- TotalCoverage Spray Arm
- 1-Hour Wash Cycle
- Tap Touch Controls

Product Dimensions:

Height: 34 1/2

Width: 23 7/8

Depth: 24 1/2

Additional Information:


[Use And Care](#)

[Dimension Guide](#)

[Installation Guide](#)

[Energy Guide](#)

[Warranty](#)

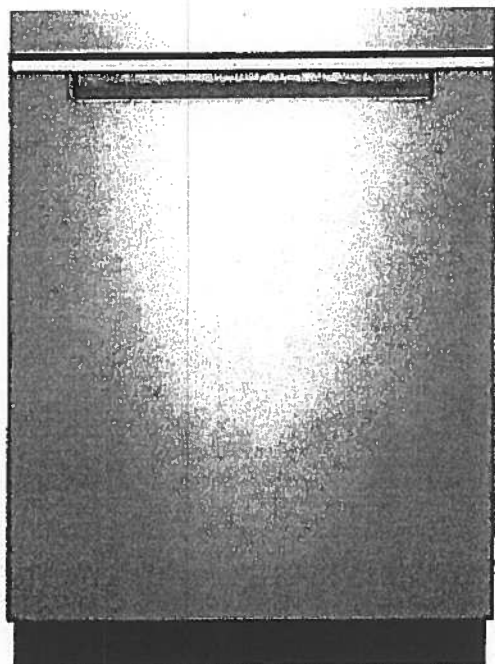

Available in:

● Black

Fingerprint Resistant Sunset Bronze

Fingerprint Resistant Black Stainless

○ White

Fingerprint Resistant Stainless Steel

INVESTED
IN
AMERICA



©Registered trademark/TM Trademark of Whirlpool, U.S.A. © 2016 Whirlpool Corporation. All Rights Reserved. All other trademarks are owned by their respective companies.

Because Whirlpool Corporation policy includes a continuous commitment to improve our products, we reserve the right to change materials and specifications without notice. We also reserve the right to discontinue or transition products without notice.

Manufacturer's Suggested Retail Price (MSRP) and Minimum Advertised Price (MAP) provided for reference purposes only. Dealer alone determines advertised and retail prices.

SUITE 107

HAMPTON

Upgrade
Package I

OCT. 10, 2017




WFW75HEFW

4.5 cu. ft. Front Load Washer with Precision
Dispense



<http://www.whirlpool.com>

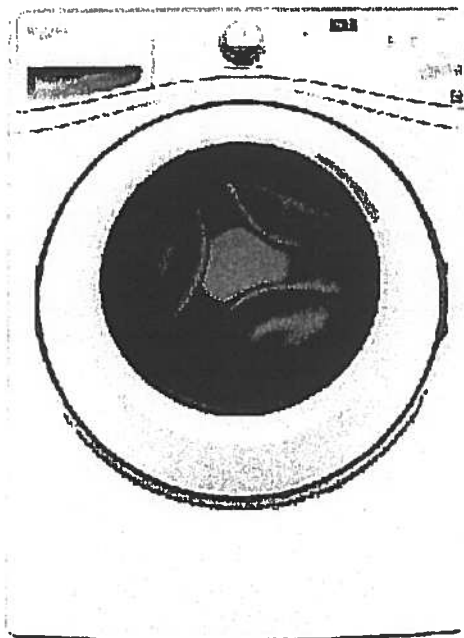

Key Features:

- Precision Dispense
- Adaptive Wash Technology
- Smooth Wave Stainless Steel Wash Basket
- 4.5 cu. ft. Capacity
- ENERGY STAR® Qualified

Product Dimensions:

Height: 39 3/4

Width: 27

Depth: 33 5/16

Electrical Requirements:

15 or 20. 120 V.

Additional Information:

[Use And Care Guide](#)

[Dimension Guide](#)

[Installation Guide](#)

[Energy Guide](#)

[Warranty Certificate](#)

INVESTED
IN
AMERICA



©Registered trademark/TM Trademark of Whirlpool, U S A. ©2013 Whirlpool Corporation All Rights Reserved.
All other trademarks are owned by their respective companies.
Because Whirlpool Corporation policy includes a continuous commitment to improve our products, we reserve
the right to change materials and specifications without notice. We also reserve the right to discontinue or
transition products without notice.
Manufacturer's Suggested Retail Price (MSRP) and Minimum Advertised Price (MAP) provided for reference
purposes only. Dealer alone determines advertised and retail prices.
Created On: Wednesday, March 23, 2016 11:51:03

SUITE 107
HAMPTON

Upgrade
Package 1

OCT. 10, 2017



YWED75HEFW

7.5 cu. ft. Duet® High Efficiency Front Load Electric
Dryer with ENERGY STAR®

Whirlpool®

<http://www.whirlpool.com>

MSRP: \$0.00

Key Features:

- Advanced Moisture Sensing System
- Quad Baffles
- Tap Touch Controls with Memory
- EcoBoost™ Option
- Wrinkle Shield™ Plus Option
- Undercounter Installation
- 7.4 Cu. Ft. Capacity
- ENERGY STAR® Qualified

Product Dimensions:

Height: 39

Width: 27


Depth: 31

Additional Information:

Use And Care

Installation Guide

Warranty

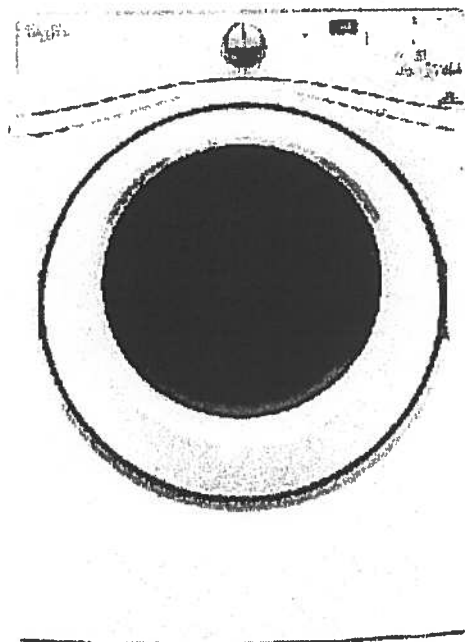

Available in:

☐ White

INVESTED
IN
AMERICA

ADA
Compliant

©Registered trademark/TM Trademark of Whirlpool, U.S.A. © 2016 Whirlpool Corporation. All Rights Reserved. All other trademarks are owned by their respective companies.

Because Whirlpool Corporation policy includes a continuous commitment to improve our products, we reserve the right to change materials and specifications without notice. We also reserve the right to discontinue or transition products without notice.

Manufacturer's Suggested Retail Price (MSRP) and Minimum Advertised Price (MAP) provided for reference purposes only. Dealer alone determines advertised and retail prices.