





Brookhaven

1,296 SQ FT *plus* 124 sq. ft. of patio area

#110

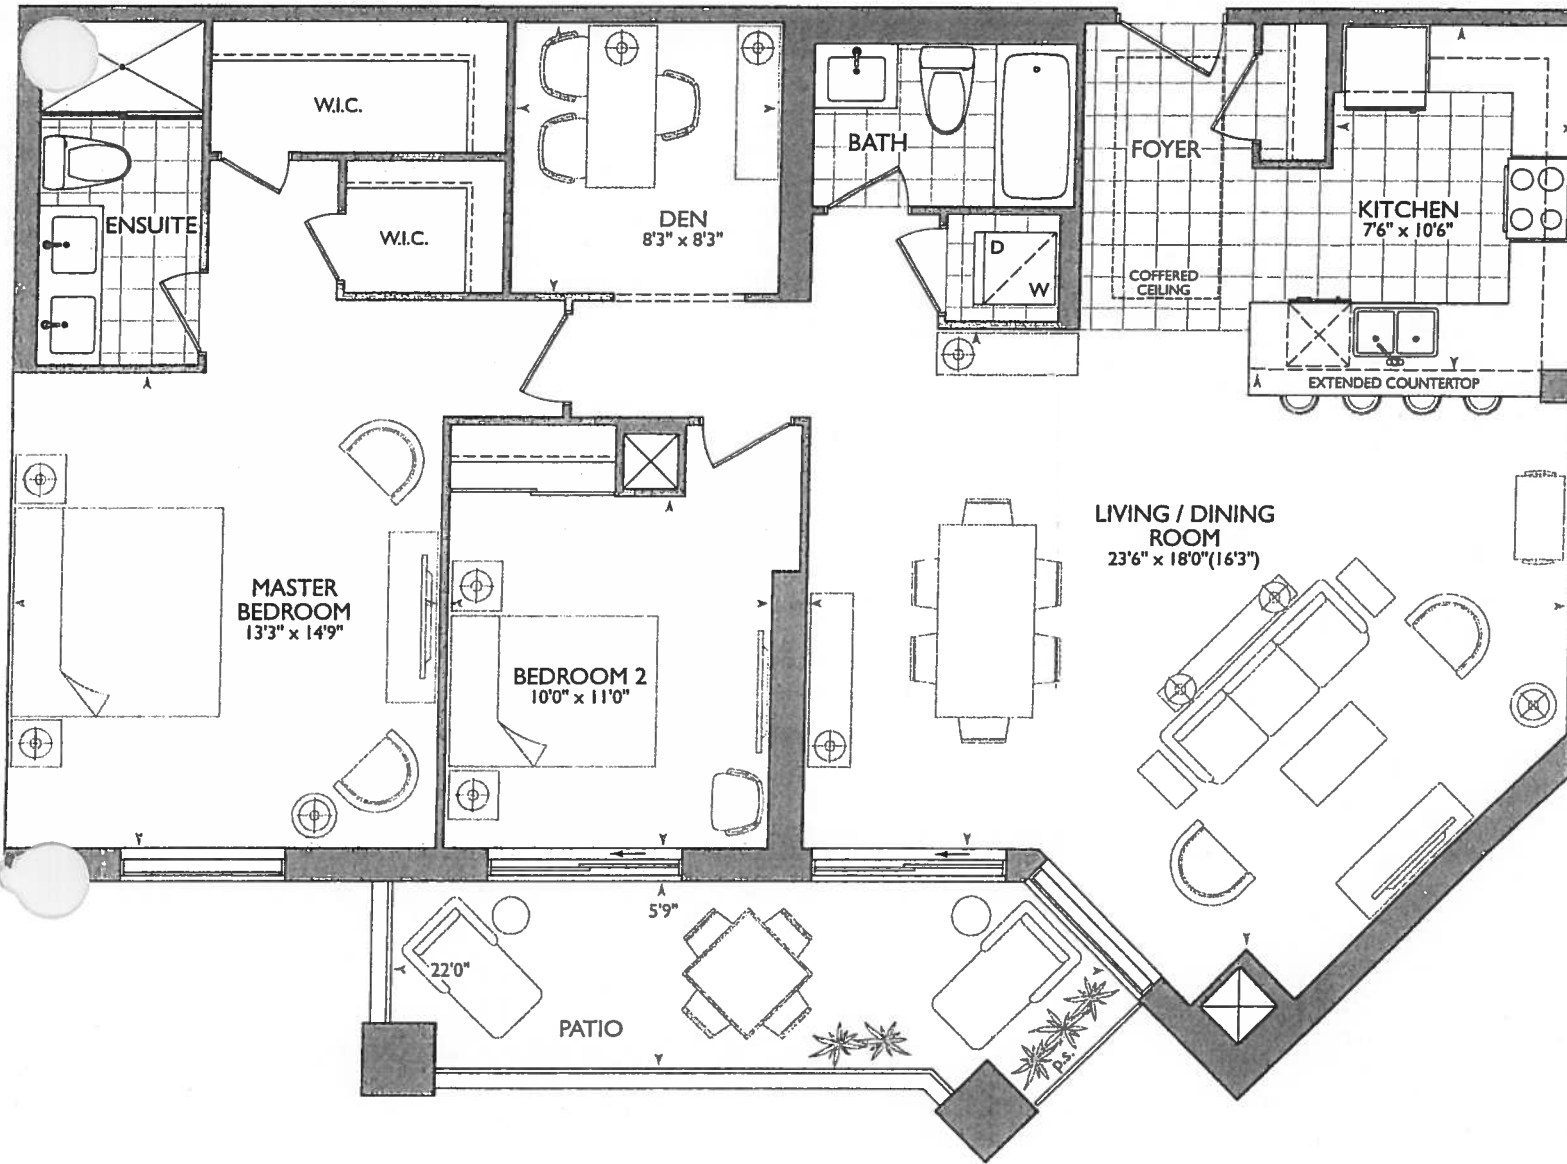

ORIGINAL SUITE

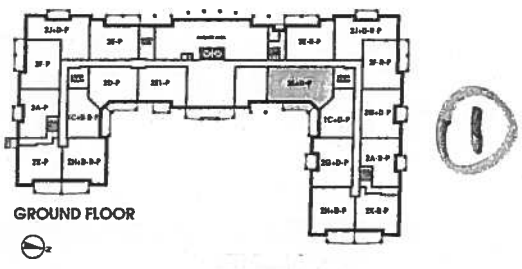

October 16, 2017


WD PD

Extended Height Doors
Throughout *

LEGEND:

- SP SECURITY PANEL
- EP ELECTRICAL PANEL
- CP COMMUNICATION PANEL
- WM WATER METER
- F FRIDGE
- DR DROPPED AREA
- 6" CROWN MOLDING

- KITCHEN**
- P-PUG PENINSULA
 - STOVE PIPE CENTER 58"
 - PLUMBING PIPE SINK CENTER 123"
 - (6x) = PUCK LIGHTS
 - URGAL = Appliance Rack-GR
 - MAIN + ENS RASCO VANITIES (NO 3" SPLASH)

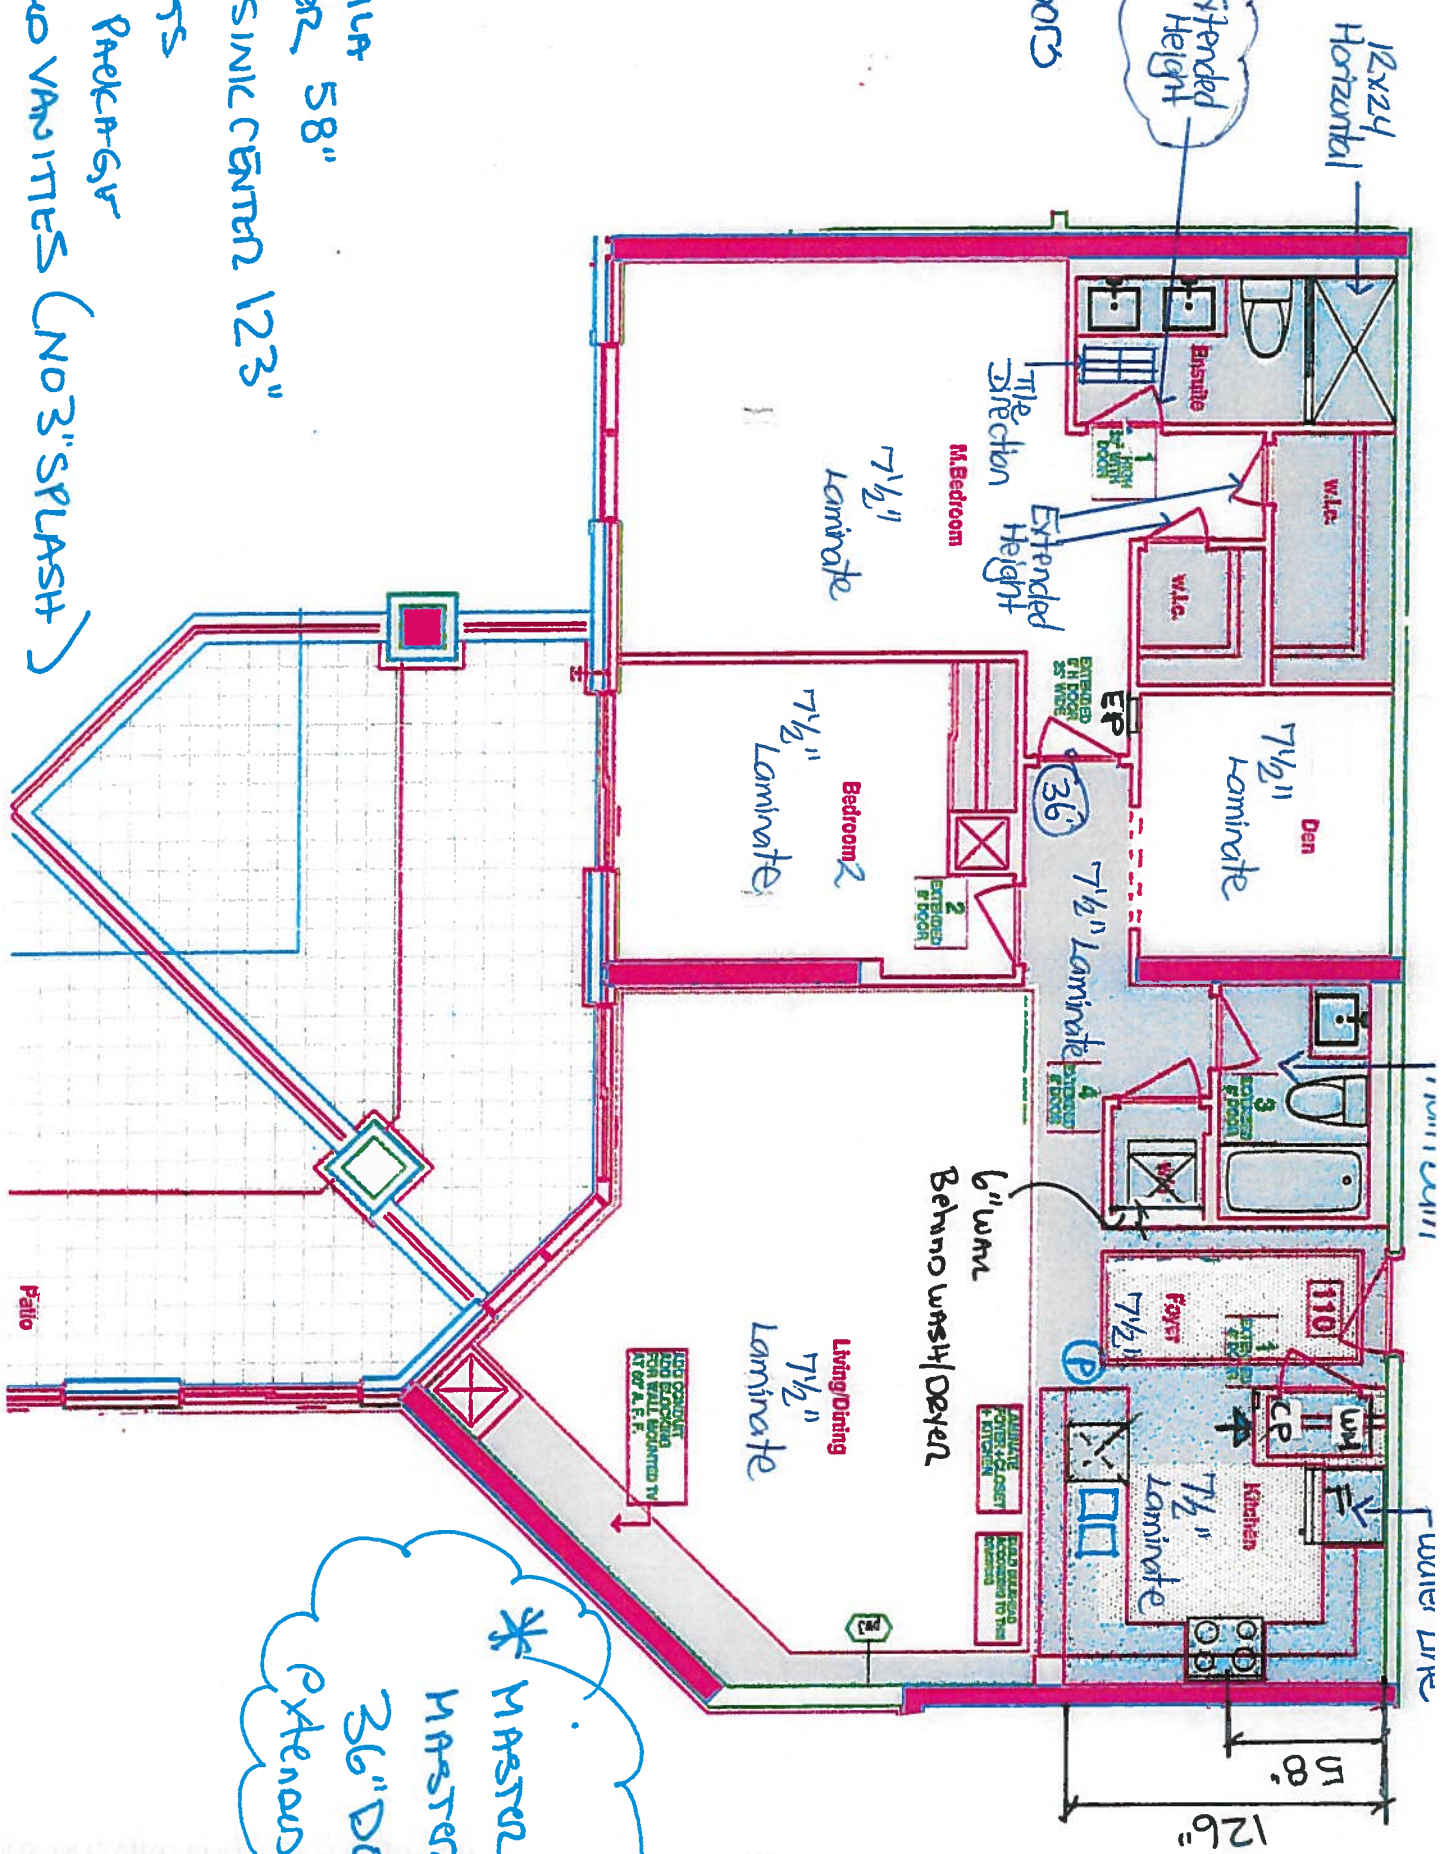

* MASTER Bedroom +
MASTER ENSUITE
36" DOORS
Extended Height

1st Floor Plan - SUITE 110 - BROOKHAVEN - 2L + D - P
HAMPTON PLACE 25 Bedford Hill Blvd - Scarsdale, NY Sep 28, 2017

RECEIVED
October 28, 2017



SITE COPY

CONSTRUCTION SUMMARY

Hampton Place

PURCHASERS: WAI HAN DUKETOVSKY and PANDO DUKETOVSKY

TEL: RES.: 905-640-0988

LOT NUMBER	PHASE	HOUSE TYPE	CLOSING DATE	
110	1	BROOKHAVEN	07-Sep-18	

Offer Workshee	THERE ARE NO UPGRADES INCLUDED IN THIS AGREEMENT OF PURCHASE AND SALE. Note:
-------------------	---

Upgrade	↑ EIGHT ↓ VENDOR TO INSTALL FIVE EXTENDED HEIGHT DOORWAYS ON FRONT CLOSET, MAIN BATH, LAUNDRY CLOSET, BEDROOM 2 AND MASTER BEDROOM (APPROXIMATE 8 FT IN HEIGHT) MASTER BEDROOM, WIC, Note: ~ MASTER ENSUITE
---------	---

Offer Upgrade	VENDOR TO INSTALL 36 INCH DOOR ON MASTER ENSUITE AND MASTER BEDROOM FOR USE WITH WHEEL CHAIR. Note:
------------------	--

Offer Upgrade	VENDOR TO INSTALL STANDARD LAMINATE IN KITCHEN, FRONT CLOSET AND FOYER AS PER VENDORS STANDARD SAMPLES. Note:
------------------	--

Offer Upgrade	VENDOR TO INSTALL CONDUIT AND BLOCKING FOR WALL MOUNTED TV (60 INCHES ABOVE FINISHED FLOOR IN LIVING ROOM AS PER SKETCH). Note:
------------------	--



SITE COPY

CONSTRUCTION SUMMARY
Hampton Place

PURCHASERS: WAI HAN DUKETOVSKY and PANDO DUKETOVSKY
TEL: RES.: 905-640-0988

LOT NUMBER	PHASE	HOUSE TYPE	CLOSING DATE
110	1	BROOKHAVEN	07-Sep-18

Date Added: 27-Oct-17 Invoice Number: 6993

1 - KITCHEN - Install WATER LINE ROUGH-IN ONLY To Fridge at Kitchen. (See Sketch)

 Priced as per Vince at Head-Office

1 - CLARIFICATION;
MASTER ENSUITE - Purchaser accepts & acknowledges the standard glass at master ensuite shower stall will NOT touch the ceiling and will receive a Standard Chrome Header. (See Sketch)
Note:

1 - PURCHASER AWARE AND ACCEPTS THAT ANY CHANGES MADE TO UPGRADES AFTER SIGNING THIS PURCHASERS EXTRA FORM ARE SUBJECT TO A MINIMUM ADMINISTRATION FEE OF \$1,000 PLUS A 10% HOLDBACK FEE.
Note:

Date Added: 16-Oct-17 Invoice Number: 6972

1 - CLARIFICATION; REFER TO APAS
LIVINGROOM - Standard electrical outlet to be installed at standard height beside conduit pipe. Additional electrical outlet to be installed beside conduit pipe & standard cable rough-in Approx. 60" AFF (See Attached Sketch)
Note: As per Vince at Head-Office

3 - INTERIOR DOORS - Install EXTENDED HEIGHT Interior Doors at Master Bedroom Walk-In Closets and Master Ensuite (x3 Doors) (See Sketch)
Note: In Addition to Upgraded Extended Height Interior Doors Included in APAS

 CHEN & BATHROOMS - SEE QUALITY TOPS & KITCHENS FOR ALL KITCHEN & BATHROOMS UPGRADES / LAYOUTS. (See d Paperwork)
Note:

1 - KITCHEN - CABINETRY - Install UPGRADE PACKAGE 1 CABINETRY - Category 3 - Fiberboard Cloud White QT 4801 - To be installed throughout kitchen, where applicable. (See Sketch)
Note:

1 - MASTER ENSUITE - Install UPGRADE PACKAGE 1 CABINETRY - Category 3 - Fiberboard Cloud White QT 4801 - To be installed throughout Master Ensuite vanity, where applicable. (See Sketch)
Note:

1 - CLARIFICATION;
MAIN BATH & MASTER ENSUITE - Install RAISED VANITY HEIGHT throughout all bathrooms. To Include; Main Bath and Master Ensuite (See Attached QTK Paperwork)
Note:

1 - KITCHEN - Install ONE (1) ADDITIONAL PUCK LIGHT (Same Switch as Standard Puck Lights) at kitchen. To be installed below kitchen cabinety, where applicable. (See Attached QTK Layout for Locations)
Note: Purchaser Paying Difference for Additional Puck Light - Standard Kitchen to Receive Five (5) Puck Lights - Upgrade Kitchen Requires Six (6) Puck Lights

1 - APPLIANCE PACKAGE - Install Upgrade Appliance Package - UPGRADE PACKAGE # 1 - To be installed throughout suite, where applicable. (See Sketch)


1 - KITCHEN - Kitchen Backsplash - Install 2ND UPGRADE Backsplash - 12x12 Mist Arabesque Glass Mosaics - To be installed throughout kitchen, where applicable. (Does not include behind the fridge or stove) (See Sketch)
Note:

1 - KITCHEN - Kitchen Sink - Install Upgrade Undermount Sink - BLANCO - Quatrus U Super Single Undermount Sink - Model # 401248 (See Sketch)
Note:

1 - KITCHEN - Kitchen Faucet - Install Standard Faucet - DELTA - Chrome Pull-Out Kitchen Faucet (Single Hole) - Model # 469LF- Chrome (See Sketch)
Note:



SITE COPY

CONSTRUCTION SUMMARY

Hampton Place

PURCHASERS: WAI HAN DUKETOVSKY and PANDO DUKETOVSKY

TEL: RES.: 905-640-0988

LOT NUMBER	PHASE	HOUSE TYPE	CLOSING DATE
110	1	BROOKHAVEN	07-Sep-18

Date Added: 16-Oct-17 Invoice Number: 6972

45 - MASTER ENSUITE - 1ST UPGRADE - PORCELAIN TILES - 12x24 H-STONE LIGHT GREY - To be installed throughout master ensuite
To be Installed Straight) (See Sketch)
Includes Larger Size

105 - MASTER ENSUITE - 1ST UPGRADE - PORCELAIN TILES - 12x24 H-STONE LIGHT GREY - To be installed throughout master ensuite
shower stall. (To be Installed Horizontally / Stacked) (See Sketch)
Note: Includes Larger Size

1 - CLARIFICATION;
MAIN BATH & MASTER ENSUITE - Install Builders Standard Plumbing Fixtures throughout all bathrooms where applicable. To Include; Main Bath
and Master Ensuite (See Sketch)
Note:

1 - CLARIFICATION;
MAIN BATH & MASTER ENSUITE - DELETE Standard 3" Splash throughout all bathroom vanity countertops, where applicable. To Include; Main
Bath & Master Ensuite (See Sketch)
Note:

1 - CLARIFICATION;
MAIN BATH & MASTER ENSUITE- DELETE Do Not Install / Supply / Credit Purchaser for builders standard ceramic bathroom accessories (toilet
paper, towel bar & soap dish) throughout all bathrooms where applicable.
Note: To Include; Main Bath & Master Ensuite (See Sketch)

1 - CLARIFICATION;
MAIN BATH & MASTER ENSUITE- DELETE Do Not Install / Supply / Credit Purchaser for builders standard mirrors throughout all bathrooms
pplicable. To Include; Main Bath and Master Ensuite (See Sketch)

1 - PURCHASER HAS ATTENDED A COLOR APPOINTMENT AT THE DECOR CENTRE AND HAS DECLINED ANY ADDITIONAL
UPGRADES. Purchaser accepts and acknowledges that there will be no further changes/additions/deletions to be made upon signing on October 16,
2017
Note:

1 - PURCHASER AWARE AND ACCEPTS THAT ANY CHANGES MADE TO UPGRADES AFTER SIGNING THIS PURCHASERS EXTRA
FORM ARE SUBJECT TO A MINIMUM ADMINISTRATION FEE OF \$1,000 PLUS A 10% HOLDBACK FEE.
Note:

This Document is Extremely Time Sensitive - Printed 22 Jan 18 at 16:47



* INTERIOR COLOR SCHEME *

Purchasers		Decor Consultant	Model Type	Telephone Res. / Bus	Project	Closing Date	Unit
WAI HAN DUKETOVSKY & PANDO DUKETOVSKY		Melissa Di Marino	BROOKHAVEN	(905) 640-0988 /	Hampton Place	07/09/2018	110

Page 1 of 3

	Flooring		Wall Tile	
	Description	Main	Accent/Insert	Pattern
MASTER ENSUITE	12x24 H-Stone Light Grey (UPG) (STRAIGHT)	12x24 H-Stone Light Grey (Horizontal)(Upg)	NONE	NONE
MAIN BATHROOM	13x13 RUSTIC GREY (STD)	8x10 GOLF GRIGIO (STD)	NONE	NONE
POWDER ROOM	N/A	N/A	N/A	N/A
KITCHEN / DINETTE	7 1/2" Torleys Forest Okanogan 9742-P (STD)	12x12 MistArabesqueGlassMosaics(UPG)	NONE	NONE
FOYER	7 1/2" Torleys Forest Okanogan 9742-P (STD)	N/A	N/A	N/A
LAUNDRY	8x8 BEHRAM PINK (STD)	N/A	N/A	N/A
LIVING ROOM	7 1/2" Torleys Forest Okanogan 9742-P (STD)			
DINING ROOM	7 1/2" Torleys Forest Okanogan 9742-P (STD)			
DEN	7 1/2" Torleys Forest Okanogan 9742-P (STD)			
MASTER BEDROOM	7 1/2" Torleys Forest Okanogan 9742-P (STD)			
BEDROOM 2	7 1/2" Torleys Forest Okanogan 9742-P (STD)			
BEDROOM 3	N/A			

Notes

Page 1 of 3



* INTERIOR CLOSING SCHEME *

Purchasers WAI HAN DUKETOVSKY & PANDO DUKETOVSKY		Decor Consultant Melissa Di Marino	Model Type BROOKHAVEN	Telephone Res. / Bus (905) 640-0988 /	Project Hampton Place	Closing Date 07/09/2018	Unit 110
---	--	---------------------------------------	--------------------------	--	--------------------------	----------------------------	-------------

CABINETS, VANITIES AND COUNTERTOPS

	Style	Countertop	Counter Edge	Handle / Knob
MAIN BATHROOM	✓ Category 2 - Maple - Pistachio QT 2503 (STD)	ASPEN TERRA WHITE (STD)	* A " EDGE (STD)	B603-SC
MASTER ENSUITE	✓ Category 3 - Fiberglass - Cloud White QT 4801 (UPG)	ASPEN TERRA WHITE (STD)	* A " EDGE (STD)	B603-SC
POWDER ROOM		N/A	N/A	N/A
KITCHEN / DINETTE	✓ CATEGORY 3 - FIBERBOARD - CLOUD WHITE QT 4801 (UPG)	ASPEN TERRA WHITE (STD)	* A " EDGE (STD)	B603-SC
LAUNDRY ROOM		N/A	N/A	N/A

APPLIANCE PACKAGE
Upgrade Package #1
Std 31in Opening

PLUMBING FIXTURES

KITCHEN	
Sink Model	✓ UPG - Blanco Super Single - # 401248
Sink Faucet	✓ STANDARD
TOILETS	
Master Ensuite	✓ STANDARD
Main Bathroom	✓ STANDARD
Powder Room	N/A
VANITY FAUCETS	
Master Ensuite	✓ STANDARD
Main Bathroom	✓ STANDARD
Powder Room	N/A
VANITY SINKS	
Master Ensuite	✓ STANDARD
Main Bathroom	✓ STANDARD
Powder Room	N/A
SHOWER STALL / TUBS	
Master Ensuite Shower Stall	✓ STANDARD
Master Ensuite Tub	N/A
Main Bathroom Tub	✓ STANDARD

Trim	
Baseboard & Casing	✓ STANDARD
Interior Doors	✓ STANDARD - CARRARA, SMOOTH

MISC. INSTALLATIONS	
Ceramic Accessories (installed by Vendor)	☐ Yes ☒ No
Bathroom Mirrors (installed by Vendor)	☐ Yes ☒ No
Wire Shelving - Closet (installed by Vendor)	☒ Yes ☐ No

Cornice Moulding / Medallion	
Foyer	✓ STANDARD - # CTR-611
Living Room	✓ STANDARD - # CTR-611
Dining Room	✓ STANDARD - # CTR-611
Den	NONE
Master Bedroom	NONE
Bedroom 2	NONE
Bedroom 3	N/A

Fireplace	N/A
Location Flooring	N/A
Style	N/A
Finish	N/A
Marble	N/A
Hearth	N/A

Paint Throughout	
Walls	STANDARD - BIRCH WHITE
Trim	STANDARD - WHITE

Decor Consultant: Melissa Di Marino
Purchaser: WAI HAN DUKETOVSKY
Purchaser: PANDO DUKETOVSKY
Vendor:

Suite 110
Hampton

54917 2nd (29)


(1x) plug PENINSULA.

UPGRADE #1- Appliance packaging

* MAIN + ENSUITE RAISED
VANITIES 36 1/4" (NO 3" SPLASH)

Oct 16, 2017

③

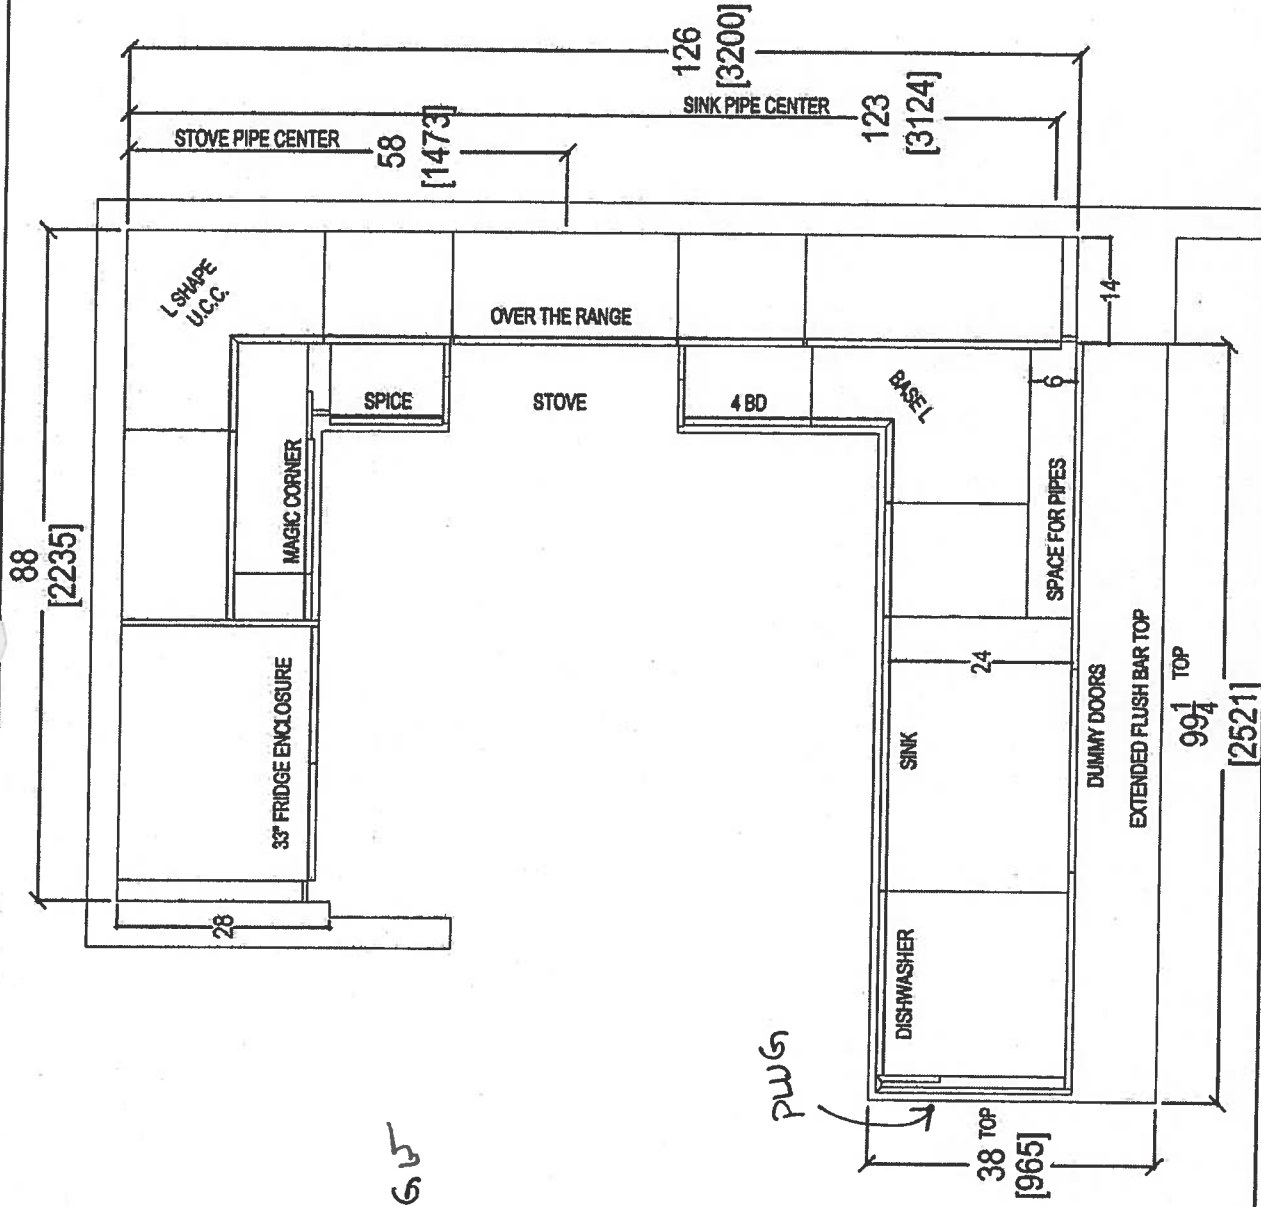

your kitchen, your taste.

your kitchen. your taste.
80 SANTE DRIVE, VAUGHAN, ON L4K 3C4,
T: 416.746.1811 F: 905.761.5901

CLIENT: ROYAL PINE HOMES

SITE. HAMPTON PLACE

PHONE: _____

EMAIL:

UNIT 110 HMP

DOOR STYLE:

FINISH:

Species

UNIT 110 HMP
BROOKHAVEN (2L+D) UPGRADE PACKAGE

DOOR STYLE: _____

FINISH:

SPECIES

ROOM: KITCHEN FLOOR PLAN

DOOR HANDLE:

DEAL HANDS

100

DRAWN BY: SK

SCALE: 1/2" = 1'-0"

DATE: OCT 18, 2017



PAGE:

COMMENTS:

**PLEASE NOTE ALL DIMENSIONS
ARE NOT FINAL AND ARE
SUBJECT TO CHANGE UPON
FINAL SITE MEASURE**

Swite 110
Hampton

PL → Puck Lights

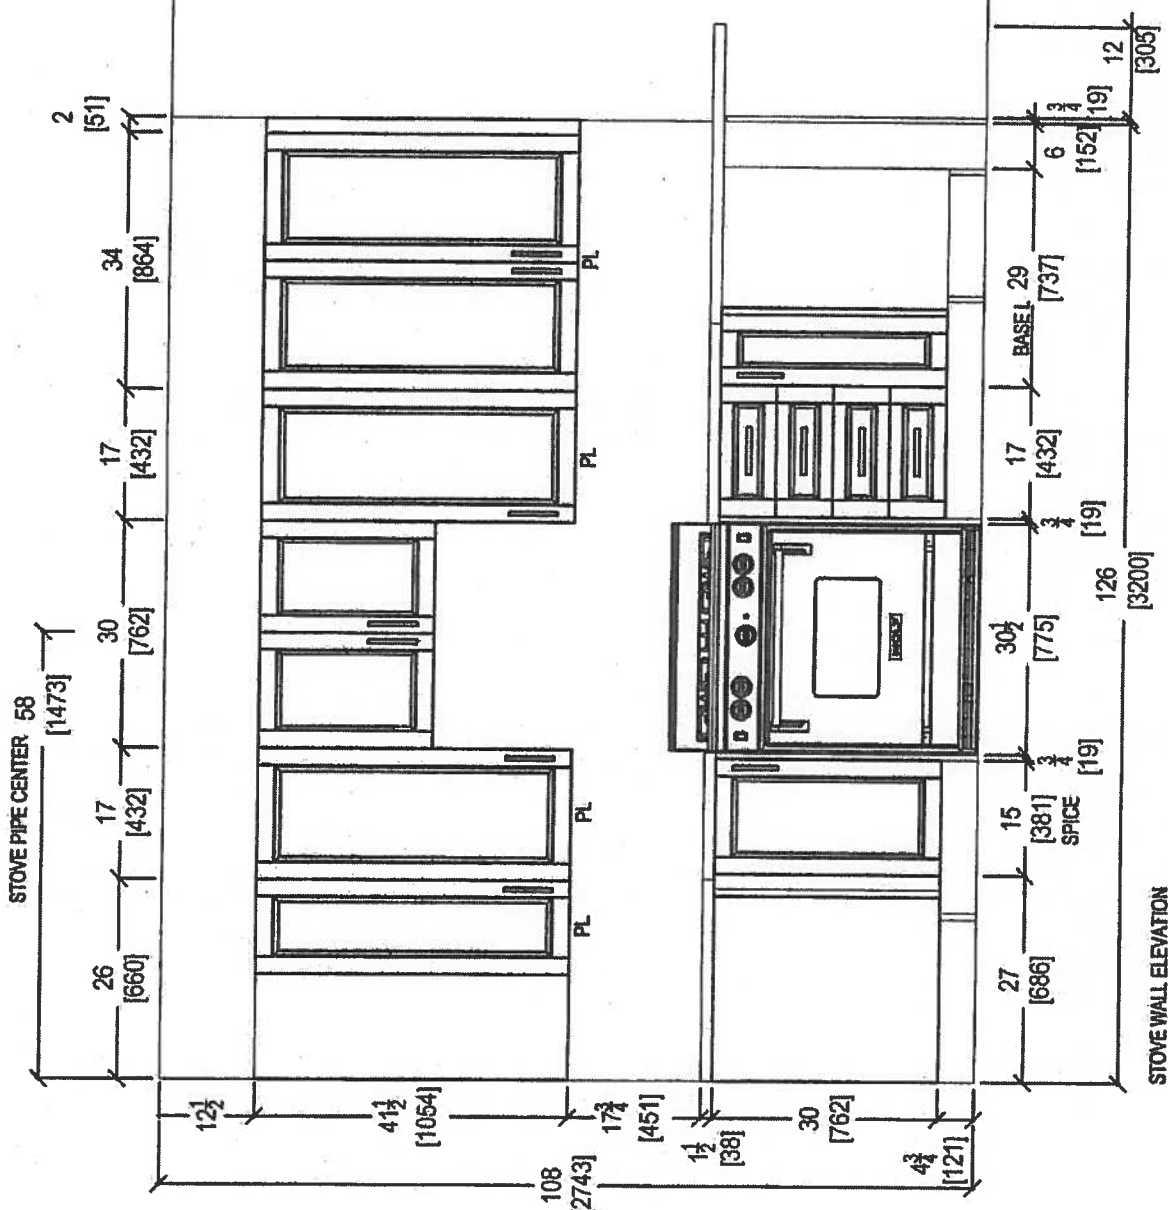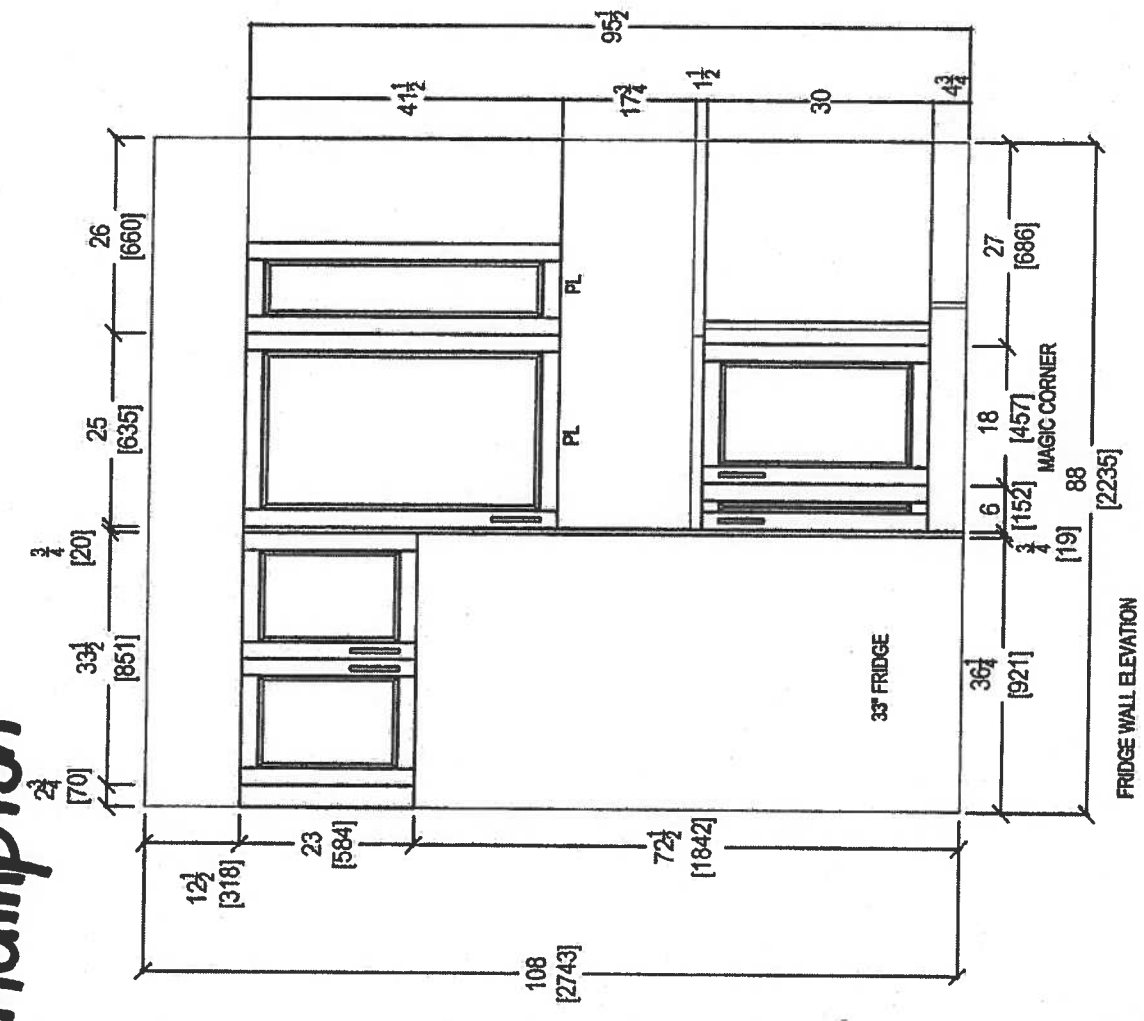



80 SANTE DRIVE, VAUGHAN, ON L4K 3C4,
T: 416.746.1811 F: 905.761.5901

CLIENT: ROYAL PINE HOMES	UNIT 110 HMP BROOKHAVEN (2L+D) UPGRADE PACKAGE	ROOM: KITCHEN	DRAWN BY: SK	COMMENTS: PLEASE NOTE ALL DIMENSIONS ARE NOT FINAL AND ARE SUBJECT TO CHANGE UPON FINAL SITE MEASURE
SITE: HAMPTON PLACE	DOOR STYLE: —	DOOR HANDLE: —	SCALE: 1/2" = 1'-0"	
PHONE: —	FINISH: —	DRW HANDLE: —	DATE: OCT 16, 2017	
EMAIL: —	SPECIES: —	TOP: —	PAGE: —	

Oct. 16, 2017

W.D.

P.D.

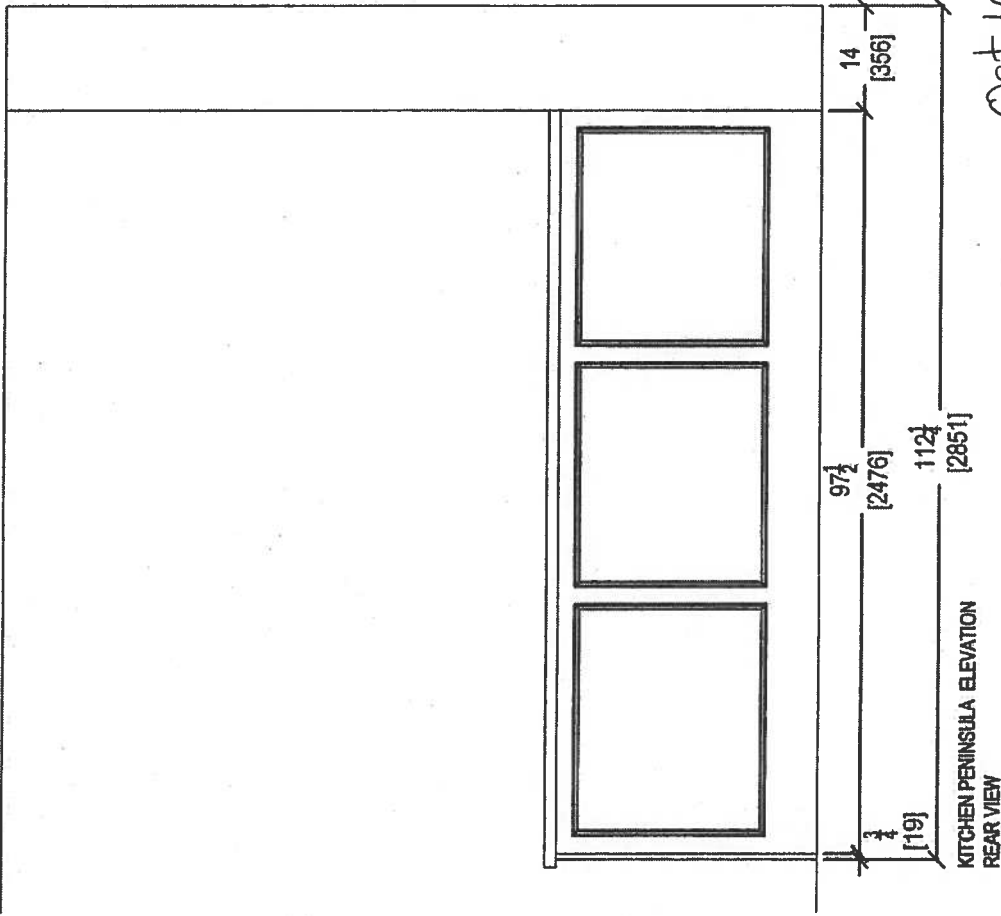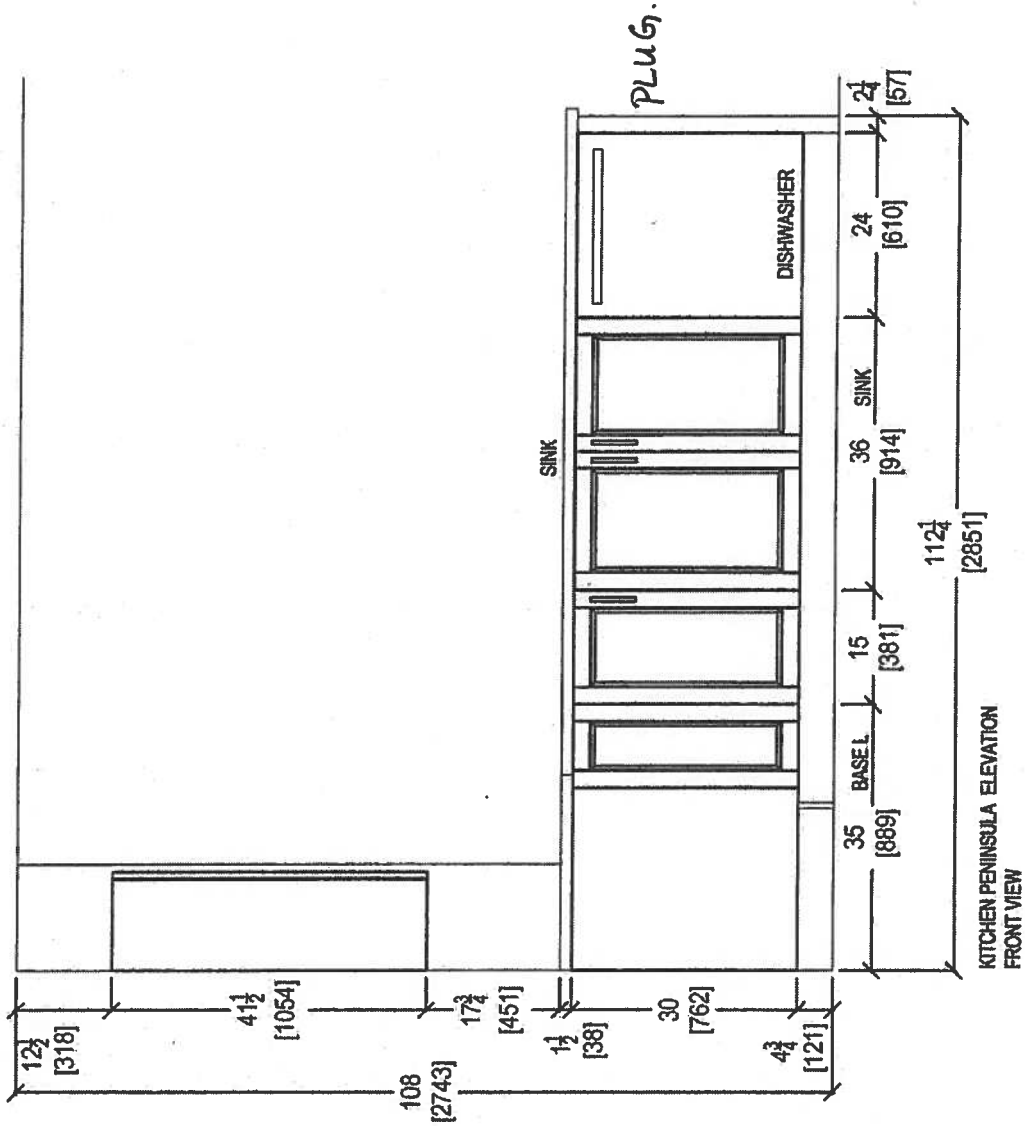


Oct 16, 2017



WD 7.5

 <i>your kitchen, your taste.</i> 80 SANTE DRIVE, VAUGHAN, ON L4K 3C4, T: 416.746.1811 F: 905.761.5901	CLIENT: ROYAL PINE HOMES		UNIT 110 HMP BROOKHAVEN (2L+D) UPGRADE PACKAGE	ROOM: KITCHEN	DRAWN BY: SK		COMMENTS: PLEASE NOTE ALL DIMENSIONS ARE NOT FINAL AND ARE SUBJECT TO CHANGE UPON FINAL SITE MEASURE
	SITE: HAMPTON PLACE	DOOR STYLE: —	DOOR HANDLE: —	SCALE: 1/2" = 1'-0"			
	PHONE: —	FINISH: —	DRW HANDLE: —	DATE: OCT 16, 2017			
	EMAIL: —	SPECIES: —	TOP: —	PAGE: —			


Suite 110 Hampton

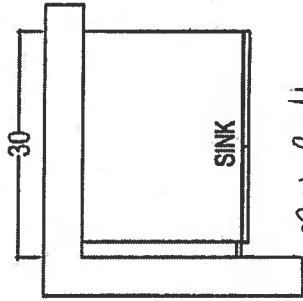

Main Bath
Raised Height

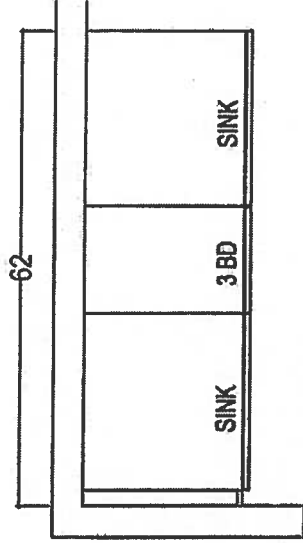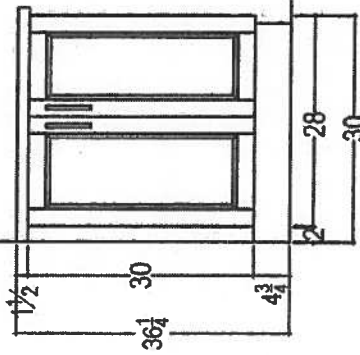

MASTER ENSUITE
Raised Height

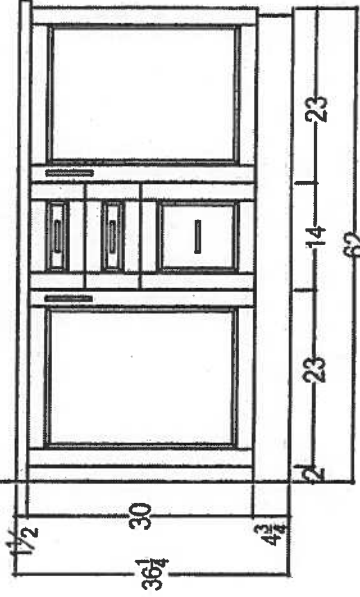

Oct. 16, 2017
WD, PT,

~~3~~ Delete 3" Splash = Connolly.



your kitchen, your taste.
80 SANTE DRIVE, VAUGHAN, ON L4K 3C4.
T: 416.748.1811 F: 905.761.5901

CLIENT: ROYAL PINE HOMES		BROOKHAVEN (2L+D) UPGRADE PACKAGE		ROOM:	VANITIES	DRAWN BY: SK	
SITE:	HAMPTON PLACE	DOOR STYLE:	---	DOOR HANDLE:	---	SCALE:	1/2" = 1'-0"
PHONE:	---	FINISH:	---	DRW HANDLE:	---	DATE:	AUG 4, 2017
EMAIL:	---	SPECIES:	---	TOP:	---	PAGE:	---

COMMENTS:

PLEASE NOTE ALL DIMENSIONS
ARE NOT FINAL AND ARE
SUBJECT TO CHANGE UPON
FINAL SITE MEASURE


Suite 110
Hampton

WD PD


CONNOLLY Marble & Granite Ltd.

EDGE
DETAILS


004

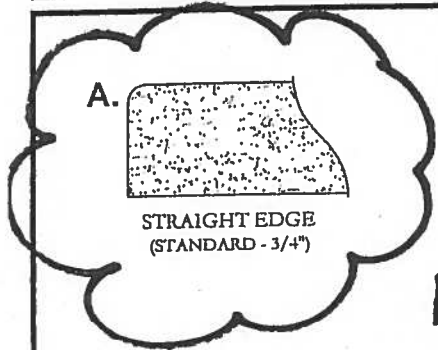

Standard
Kitchen
Main Bath
Master Ensuite

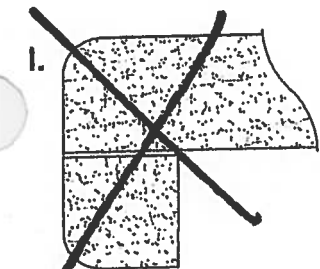

DOUBLE TOP "D" EDGE
(STANDARD - 1 1/2")

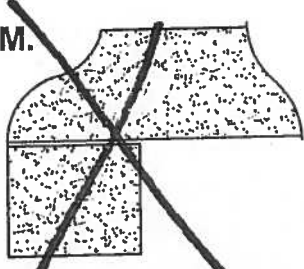

OGEE - SQUARE EDGE
(MED./HIGH - 1 1/2")

EDGING UP-GRADE OPTIONS

Suite 110
Hampton


Living Room

→ CONDUIT :

CABLE/BELL

© 60"

TV →

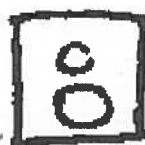

← PLUG

← conduit

BLANK
PLATE



PLUG

Suite 110 Hampton


Kitchen

Product Specification Sheet

BLANCO QUATRUS U 1 SUPER SINGLE

Satin brushed finish

PRODUCT DIMENSIONS

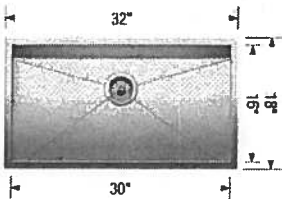

BLANCO QUATRUS U 1 SUPER SINGLE	Colour Finish	Model No.	FEATURES / SPECIFICATIONS
	Satin brushed finish	401248	• German designed and engineered • Premium 304 series, 18 gauge stainless steel • 18/10 chrome-nickel content for exceptional lustre, durability and strength • Compact sized model • Rear-positioned drain hole for maximum usable bowl and cabinet storage space • Zero-radius corners, X-pattern drain grooves • 3 1/2" (90 mm) stainless steel strainer included • Undermount clips, template included • Limited Lifetime Warranty
			DESIGN AND PLANNING TIPS Cabinet Size: 36" (915 mm) Depending on cabinet construction, a different cabinet size may be required. Consult the cabinet manufacturer.

WARRANTY

Limited Lifetime warranty

Code/Standards Compliance

BLANCO sinks and faucets are third-party tested and certified to CSA, cUPC, ANSI/ASME and NSF standards and listed by applicable certification bodies. For more information on individual product listings, contact our office or listing organization.

BLANCO CANADA
100 Corporation Drive
Brampton, ON L6S 6B5

Tel: 905 494 2400
Fax: 905 494 2425
www.blancocanada.com

Toll Free: 1 877 425 2626
Toll Free: 1 877 825 2626

© 2016 BLANCO CANADA

Suite 110
Hampton

Oct 16, 2017
(WD) (P.D.)

WRB322DMBM

Upgrade Package I

Whirlpool®

<http://www.whirlpool.com>

36-inches wide Bottom-Freezer Refrigerator with
SpillGuard™ Glass Shelves - 22 cu. ft

Key Features:

- SpillGuard™ Glass Shelves
- Adaptive Defrost
- FreshFlow™ Produce Preserver
- LED Interior Lighting
- ENERGY STAR® Qualified

ONLY
ICE
WATER

Product Dimensions:

Height: 70
Width: 32 5/8
Depth: 33 3/8

Electrical Requirements:

15


Additional Information:

[Use And Care Guide](#)

[Dimension Guide](#)

[Energy Guide](#)

[Warranty Certificate](#)

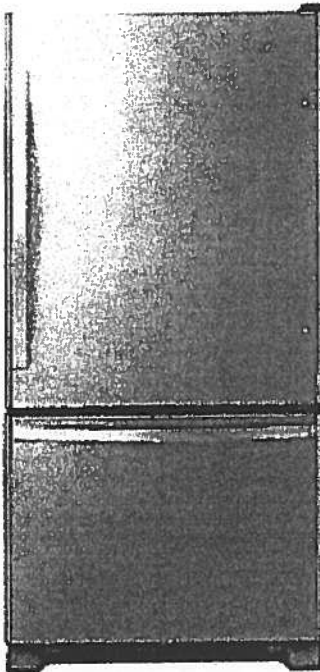

INVESTED
IN
AMERICA



©Registered trademark/TM Trademark of Whirlpool, U.S.A. © 2016 Whirlpool Corporation. All Rights Reserved.
All other trademarks are owned by their respective companies.
Because Whirlpool Corporation policy includes a continuous commitment to improve our products, we reserve the right to change materials and specifications without notice. We also reserve the right to discontinue or transition products without notice.
Manufacturer's Suggested Retail Price (MSRP) and Minimum Advertised Price (MAP) provided for reference purposes only. Dealer alone determines advertised and retail prices.
Created On: Tuesday, March 14, 2017 11:30:08

Suite 110
Hampton

OCT. 16, 2017
WL PD

Upgrade
Package I

WEE745H0FS

Whirlpool®

4 Cu. Ft. Slide-In Electric Range with True
Convection

<http://www.whirlpool.com>



Key Features:

- Frozen Bake™ Technology
- True Convection Cooking
- FlexHeat™ Triple Radiant Element
- Convection Conversion
- AquaLift® Self-Cleaning Technology
- Temperature Sensor
- Rapid Preheat
- 6.4 Cu. Ft. Capacity
- Easy-Wipe Ceramic Glass Cooktop
- Large Oven Window
- Max Capacity Rack
- Hidden Bake Element

Product Dimensions:

Height: 36

Width: 29 7/8

Additional Information:

[Use And Care Guide](#)

[Dimension Guide](#)

[Installation Guide](#)

[Warranty Certificate](#)

INVESTED
IN
AMERICA



©Registered trademark/TM Trademark of Whirlpool, U.S.A. © 2016 Whirlpool Corporation. All Rights Reserved.
All other trademarks are owned by their respective companies.
Because Whirlpool Corporation policy includes a continuous commitment to improve our products, we reserve the right to change materials and specifications without notice. We also reserve the right to discontinue or transition products without notice.
Manufacturer's Suggested Retail Price (MSRP) and Minimum Advertised Price (MAP) provided for reference purposes only. Dealer alone determines advertised and retail prices.
Created On: Friday, January 27, 2017 10:46:47

Suite 110 Hampton Upgrade Package 1

Oct 16, 2017
WD 2:30

YWMH76719CS



<http://www.whirlpool.com>

1.9 cu. ft. Microwave Hood Combination with
TimeSavor™ Plus True Convection

Key Features:

- TimeSavor™ Plus True Convection Cooking System
- Steam Cooking
- Sensor Cooking
- AccuPop™ Cycle
- CleanRelease® Non-Stick Interior
- SteamClean Option
- Integrated Hidden Vent and Console
- Auto Adapt Fan
- Recessed, Stoppable Glass Turntable
- Universal Microwave Steamer
- 1.9 cu. ft. Capacity
- 1,100 Watts Cooking Power

Product Dimensions:

Height: 17 1/8

Width: 29 15/16

Depth: 18 1/2

Electrical Requirements:

15 or 20. 120 V.

Additional Information:

[Use And Care Guide](#)

[Installation Guide](#)

[Warranty Certificate](#)

Available in:

● Stainless Steel



©Registered trademark/TM Trademark of Whirlpool, U S A. © 2013 Whirlpool Corporation. All Rights Reserved.
All other trademarks are owned by their respective companies.
Because Whirlpool Corporation policy includes a continuous commitment to improve our products, we reserve the right to change materials and specifications without notice. We also reserve the right to discontinue or transition products without notice.
Manufacturer's Suggested Retail Price (MSRP) and Minimum Advertised Price (MAP) provided for reference purposes only. Dealer alone determines advertised and retail prices.
Created On: Monday, March 14, 2016 13:16:48

Suite 110
Hampton

Oct. 16, 2017
WD PD

Upgrade Package 1

WDTA50SAHZ

Whirlpool®

<http://www.whirlpool.com>

Contemporary Design. Stainless Steel Tub
Dishwasher with TotalCoverage Spray Arm

Key Features:


- Sensor Cycle
- TotalCoverage Spray Arm
- 1-Hour Wash Cycle
- Tap Touch Controls

Product Dimensions:

Height: 34 1/2
Width: 23 7/8
Depth: 24 1/2

Additional Information:

[Use And Care](#)
[Dimension Guide](#)
[Installation Guide](#)
[Energy Guide](#)
[Warranty](#)

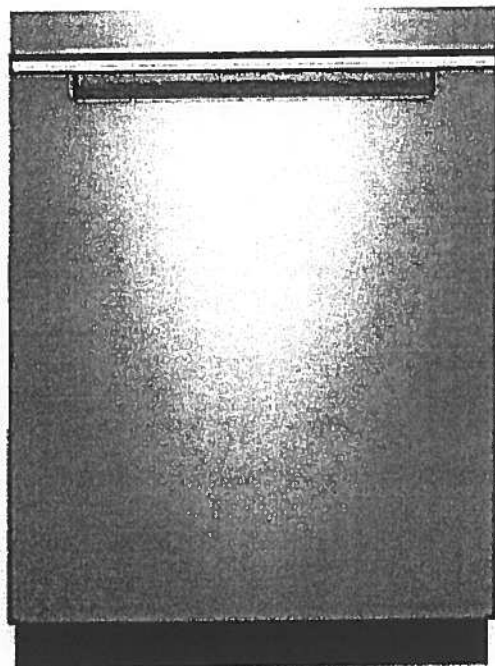

Available in:

● Black

Fingerprint Resistant Sunset Bronze

Fingerprint Resistant Black Stainless

○ White

Fingerprint Resistant Stainless Steel

INVESTED
IN
AMERICA



©Registered trademark/TM Trademark of Whirlpool, U.S.A. © 2016 Whirlpool Corporation. All Rights Reserved. All other trademarks are owned by their respective companies.

Because Whirlpool Corporation policy includes a continuous commitment to improve our products, we reserve the right to change materials and specifications without notice. We also reserve the right to discontinue or transition products without notice.

Manufacturer's Suggested Retail Price (MSRP) and Minimum Advertised Price (MAP) provided for reference purposes only. Dealer alone determines advertised and retail prices.

Suite 110 Hampton Upgrade Package 1

Oct. 16, 2017


WD PD

WFW75HEFW



<http://www.whirlpool.com>

4.5 cu. ft. Front Load Washer with Precision Dispense

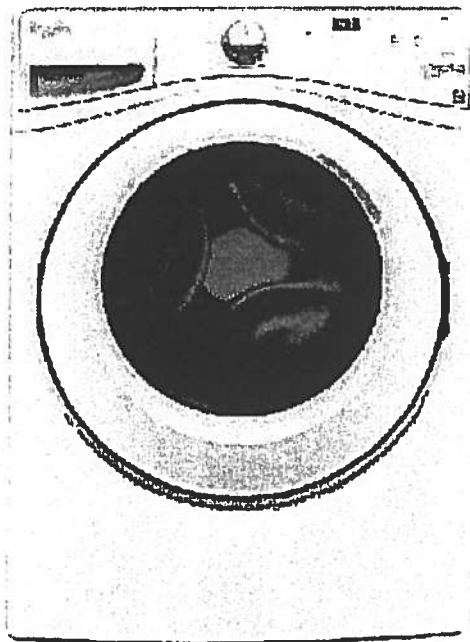

Key Features:

- Precision Dispense
- Adaptive Wash Technology
- Smooth Wave Stainless Steel Wash Basket
- 4.5 cu. ft. Capacity
- ENERGY STAR® Qualified

Product Dimensions:

Height: 39 3/4

Width: 27

Depth: 33 5/16

Electrical Requirements:

15 or 20. 120 V.

Additional Information:

[Use And Care Guide](#)

[Dimension Guide](#)

[Installation Guide](#)

[Energy Guide](#)

[Warranty Certificate](#)

INVESTED
IN
AMERICA



©Registered trademark/TM Trademark of Whirlpool, U.S.A. ©2013 Whirlpool Corporation All Rights Reserved.
All other trademarks are owned by their respective companies.
Because Whirlpool Corporation policy includes a continuous commitment to improve our products, we reserve the right to change materials and specifications without notice. We also reserve the right to discontinue or transition products without notice.
Manufacturer's Suggested Retail Price (MSRP) and Minimum Advertised Price (MAP) provided for reference purposes only. Dealer alone determines advertised and retail prices.
Created On: Wednesday, March 23, 2016 11:51:03

Suite 110
Hampton

Upgrade
Package 1

Oct. 16, 2017

WD P.S.

YWED75HEFW

Whirlpool®

<http://www.whirlpool.com>

7.4 cu. ft. Duet® High Efficiency Front Load Electric
Dryer with ENERGY STAR®

MSRP: \$0.00

Key Features:

- Advanced Moisture Sensing System
- Quad Baffles
- Tap Touch Controls with Memory
- EcoBoost™ Option
- Wrinkle Shield™ Plus Option
- Undercounter Installation
- 7.4 Cu. Ft. Capacity
- ENERGY STAR® Qualified

Product Dimensions:

Height: 39

Width: 27


Depth: 31

Additional Information:

Use And Care

Installation Guide

Warranty

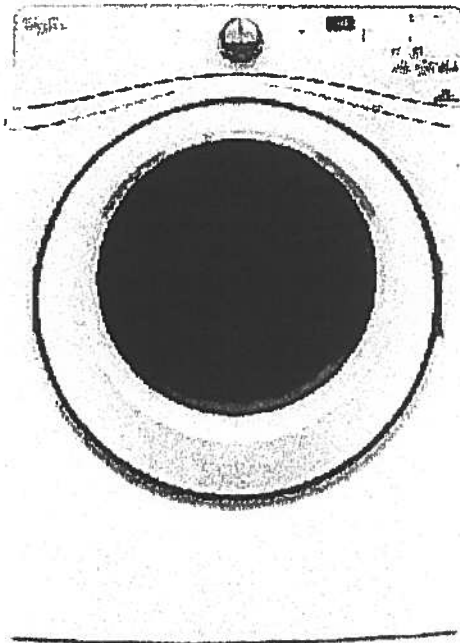

Available in:

☐ White

INVESTED
IN
AMERICA



®Registered trademark/TM Trademark of Whirlpool, U.S.A. © 2016 Whirlpool Corporation. All Rights Reserved. All other trademarks are owned by their respective companies.

Because Whirlpool Corporation policy includes a continuous commitment to improve our products, we reserve the right to change materials and specifications without notice. We also reserve the right to discontinue or transition products without notice.

Manufacturer's Suggested Retail Price (MSRP) and Minimum Advertised Price (MAP) provided for reference purposes only. Dealer alone determines advertised and retail prices.