





Remsenburg


1,031 SQ FT *plus* 124 sq. ft. of balcony area

Suite #216
ORIGINAL
Brochure


(Inventory Suite)

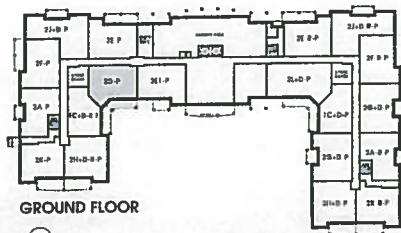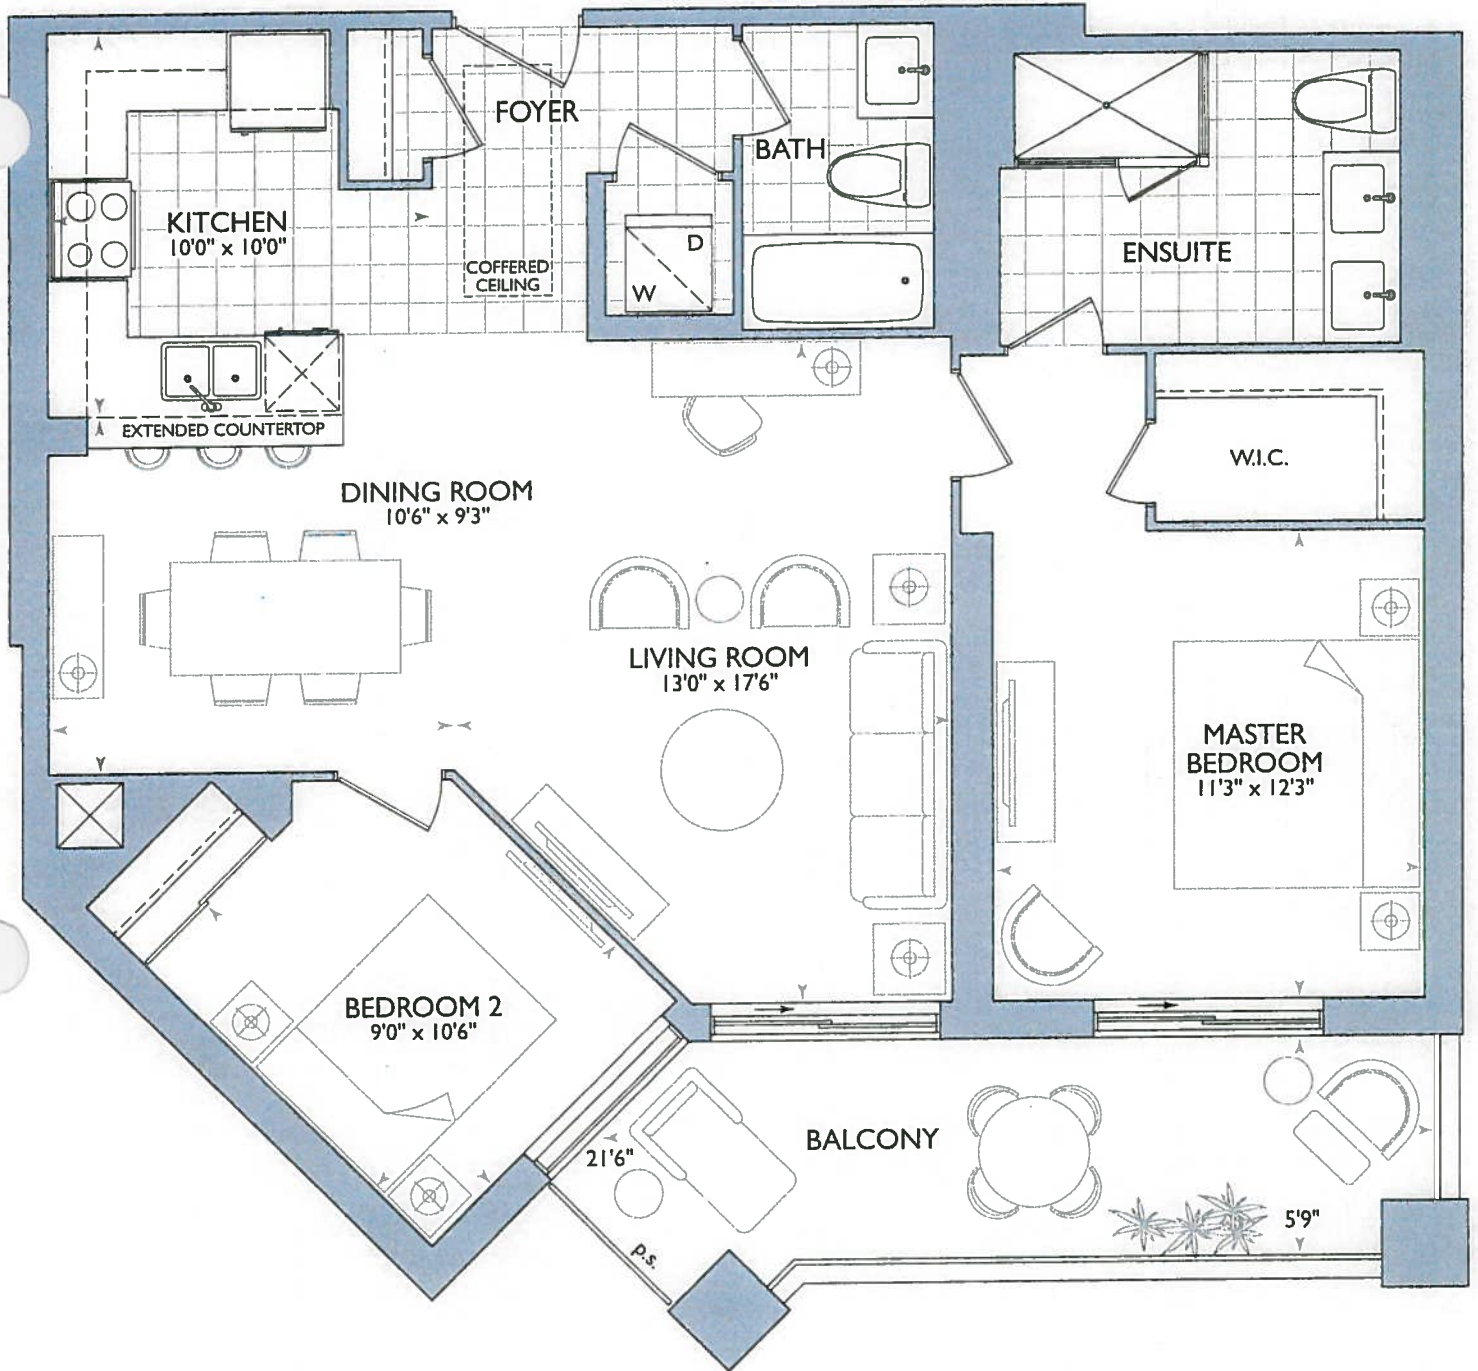

GROUND FLOOR

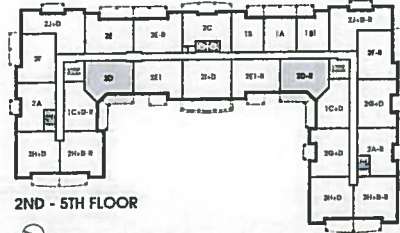

2ND - 5TH FLOOR

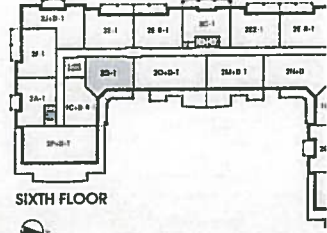


SIXTH FLOOR



KITCHEN:

- Ⓟ = PLUG PENINSULA
- (2x) = PENDANT LIGHTS OVER PENINSULA
- Kitchen Layout with STD Appliance PACKAGE
- OPT Kitchen Layout w/ 1ST UPG Appliance PACKAGE

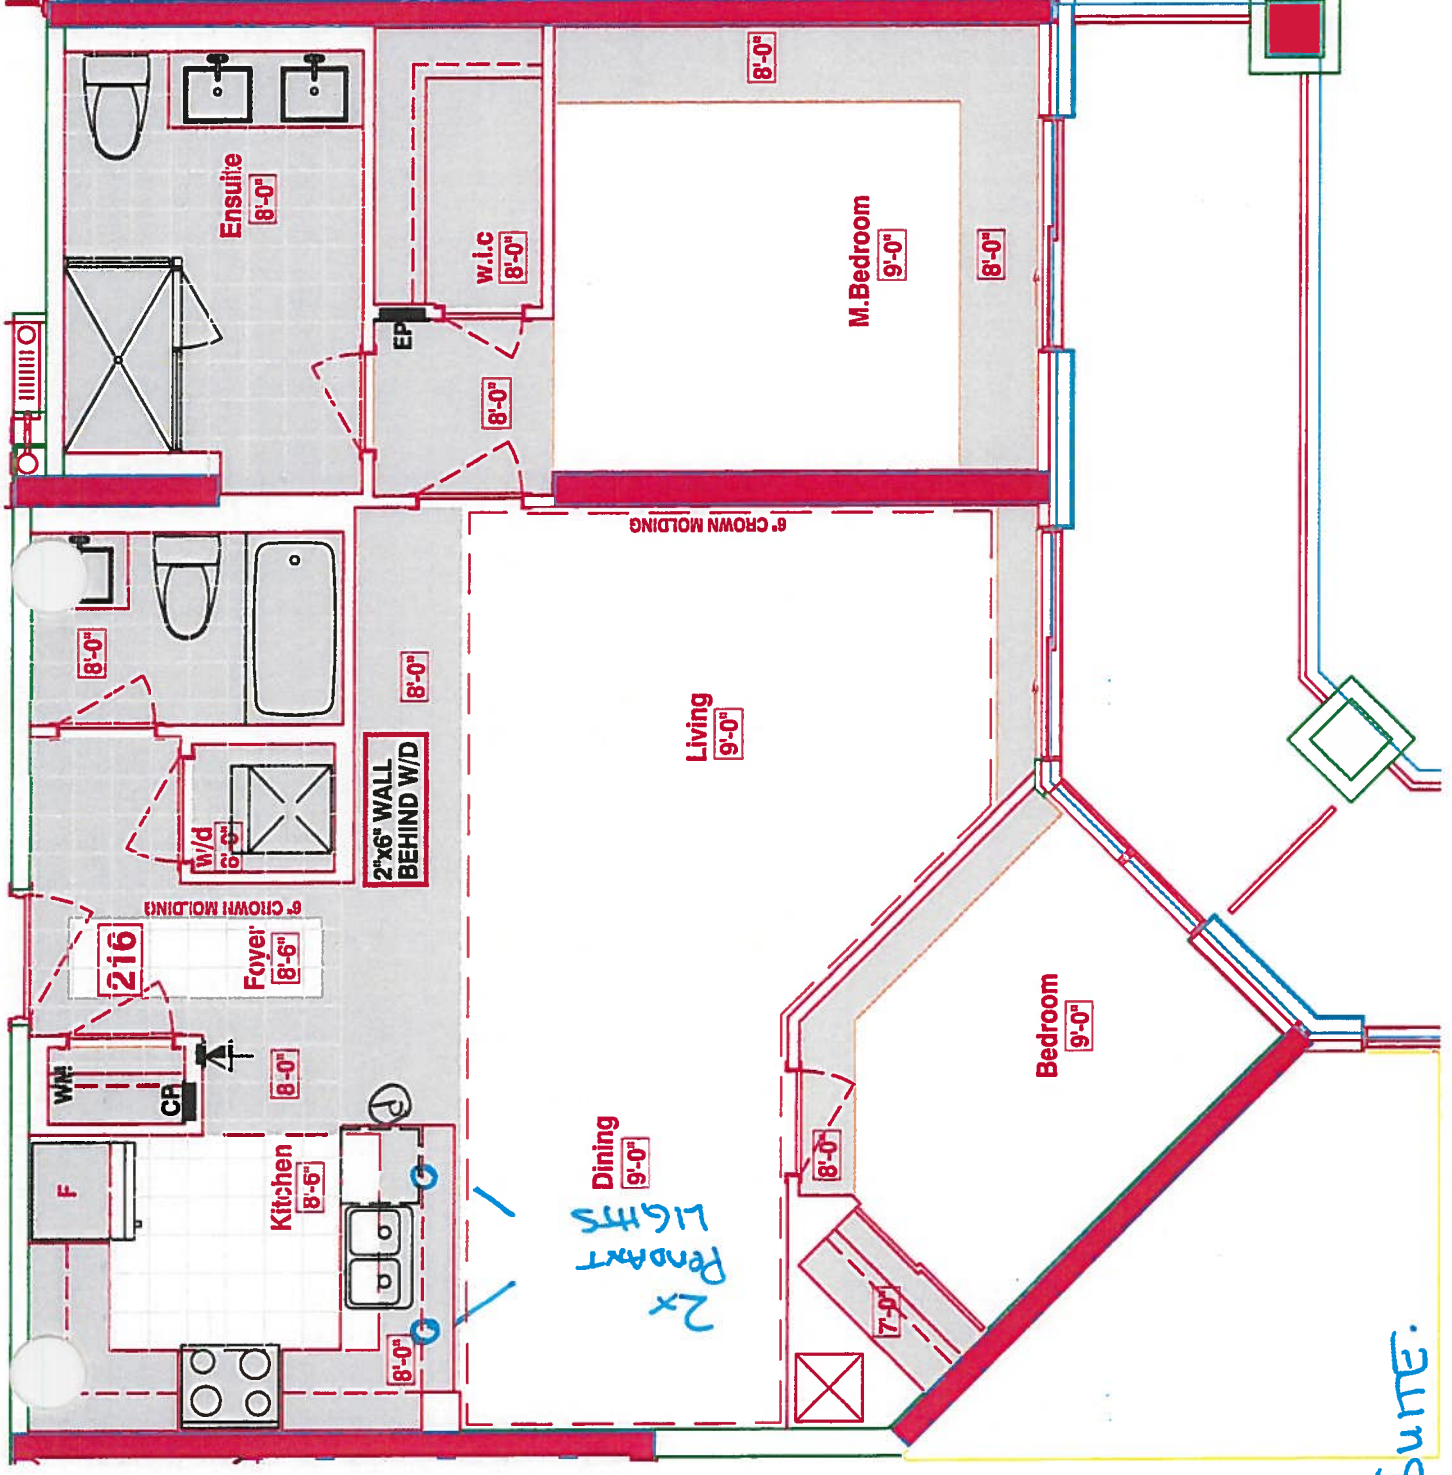


Inventory Suite.

SUITE 216- REMSENBURG - 2D-R

■ HAMPTON PLACE ■ 25 Baker Hill Blvd - Stouffville, ON ■ Jan 23, 2018

DRAWING AS PER AGREEMENT OF PURCHASE AND SALE (before decor appointment)

- Suite #216= Kitchen LAYOUT w STD Appliance PACKAGE
- (P)= PLUG PENINSULA
- (2x)= PENDANT LIGHTS OVER PENINSULA


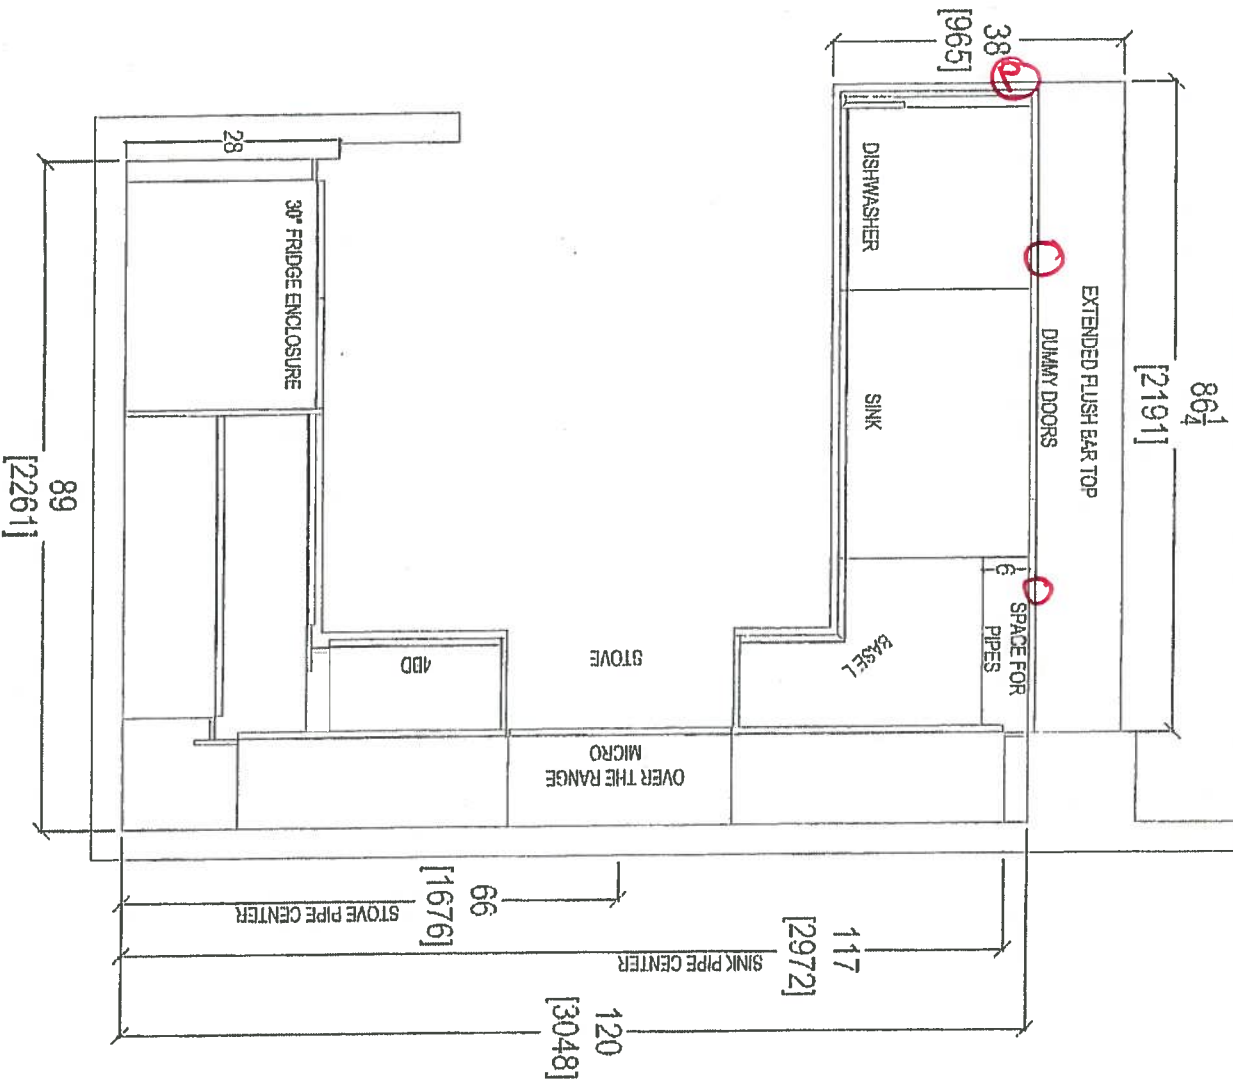


your kitchen
80 SANTE DRIVE, V
T. 416.746.1

CLIENT: ROYAL PINE HOMES	JOB NAME: 2D-P	ROOM: KITCHEN FLOOR PLAN	DRAWN BY: SK
SITE: HAMPTON PLACE	DOOR STYLE: —	DOOR HANDLE: —	SCALE: 1/2" = 1'-0"
PHONE: —	FINISH: —	DRW HANDLE: —	DATE: AUG 4, 2017
EMAIL: —	SPECIES: —	TOP: —	PAGE: —

RECEIVED
RACONCHIO

PLEASE NOTE ALL DIMENSIONS
ARE NOT FINAL AND ARE
SUBJECT TO CHANGE UPON
FINAL SITE MEASURE

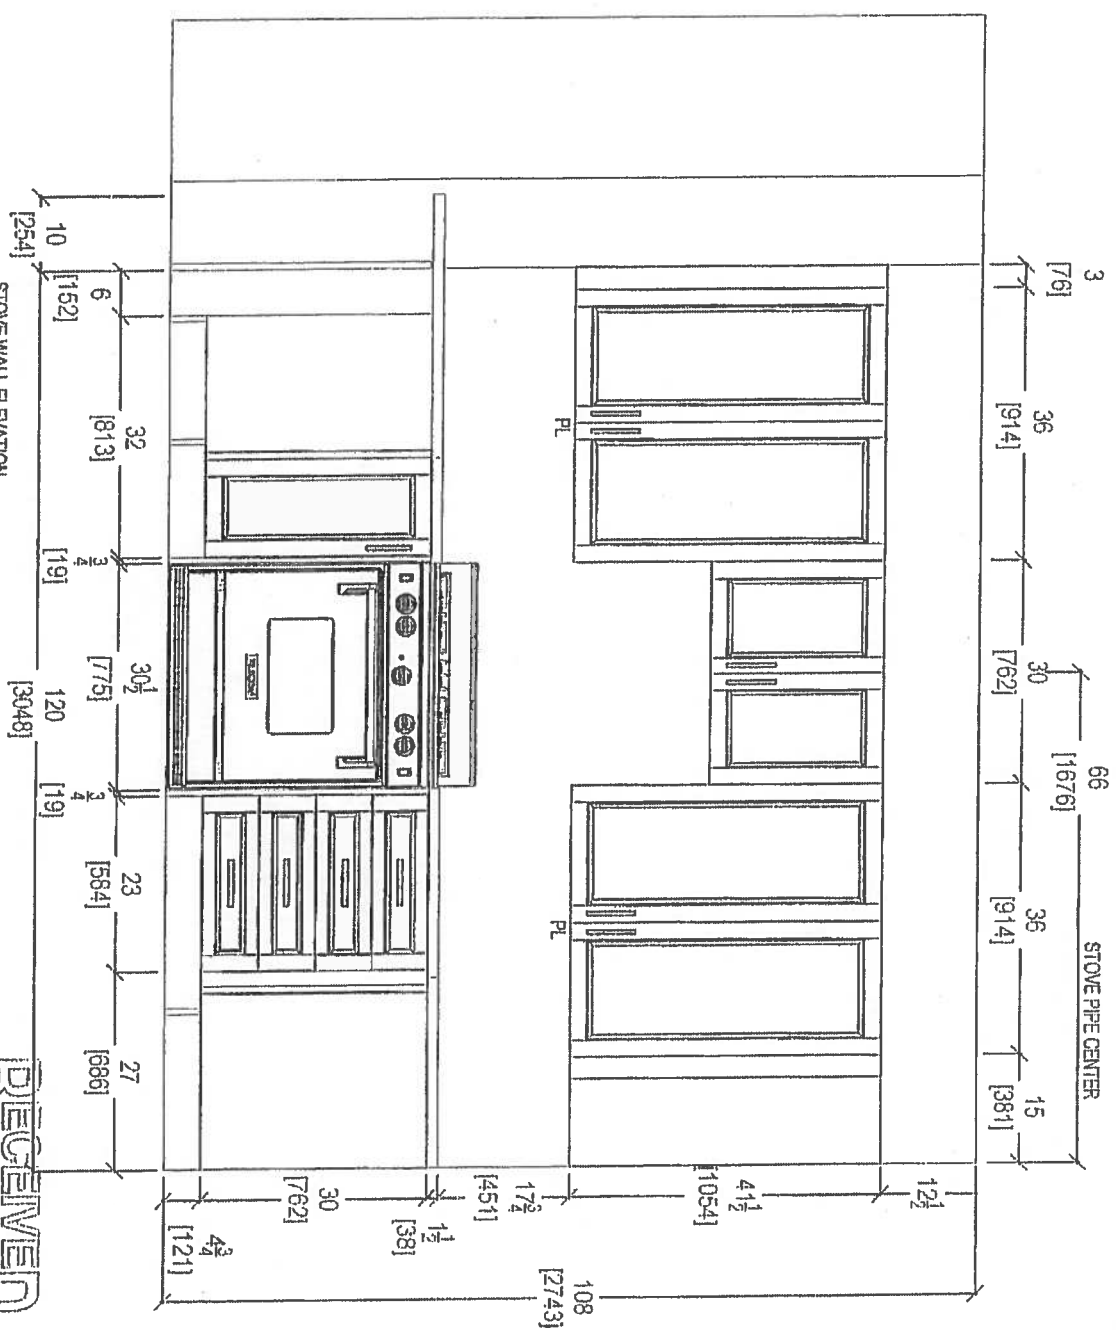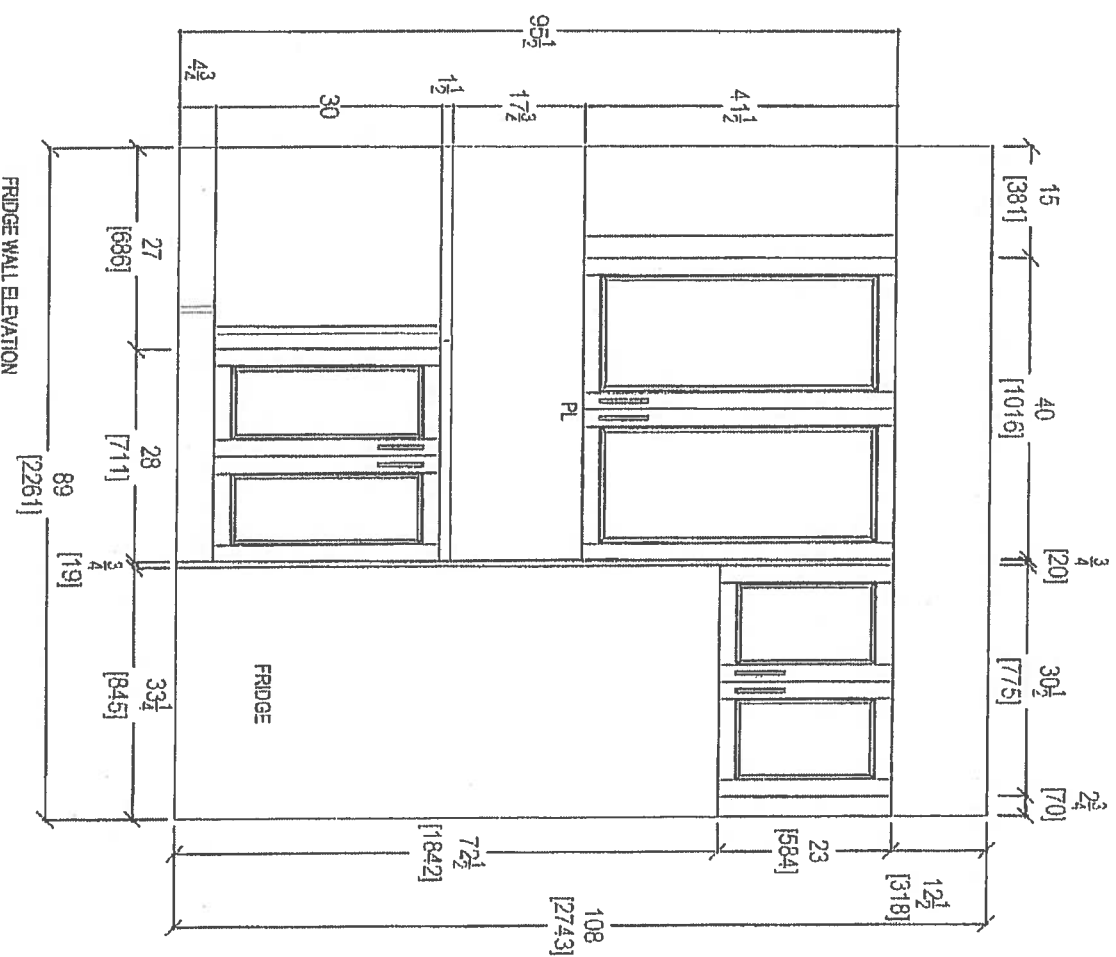

RECEIVED
Nov 6 '17

COMMENTS.

PLEASE NOTE ALL DIMENSIONS
ARE NOT FINAL AND ARE
SUBJECT TO CHANGE UPON
FINAL SITE MEASURE

CLIENT: ROYAL PINE HOMES

SITE: HAMPTON PLACE

PHONE _____

EMAIL: _____

JOB NAME: 2D-P

ROOM: KITCHEN

DRAWN BY: SK

SCHE. 175

DATE: AUG 4 2017

PAGE:

DOOR STYLE: 1

FINISH

SPECIES:

DOOR HANDLE

DRW HANDLE.

TOP.



your kitchen. 1-800-368-1000
80 SANTE DRIVE, VALLEY, ON L4K 3C4,
T: 416.746.1811 F: 416.746.6150

61.5501



80 SANTE DRIVE, VAUGHAN, ON L4K 3C4,
T: 416.743.1877


Your Kitchen, Your Way.


CLIENT: ROYAL PINE HOMES	JOB NAME: 2D-P	ROOM: KITCHEN	DRAWN BY: SK
SITE: HAMPTON PLACE	DOOR STYLE: —	DOOR HANDLE: —	SCALE: 1/2" = 1'-0"
PHONE: —	FINISH: —	DRW HANDLE: —	DATE: AUG 4, 2017
EMAIL: —	SPECIES: —	TOP: —	PAGE: —

COMMENTS:


PLEASE NOTE ALL DIMENSIONS
ARE NOT FINAL AND ARE
SUBJECT TO CHANGE UPON
FINAL SITE MEASURE

RECEIVED
Rev. C. 17


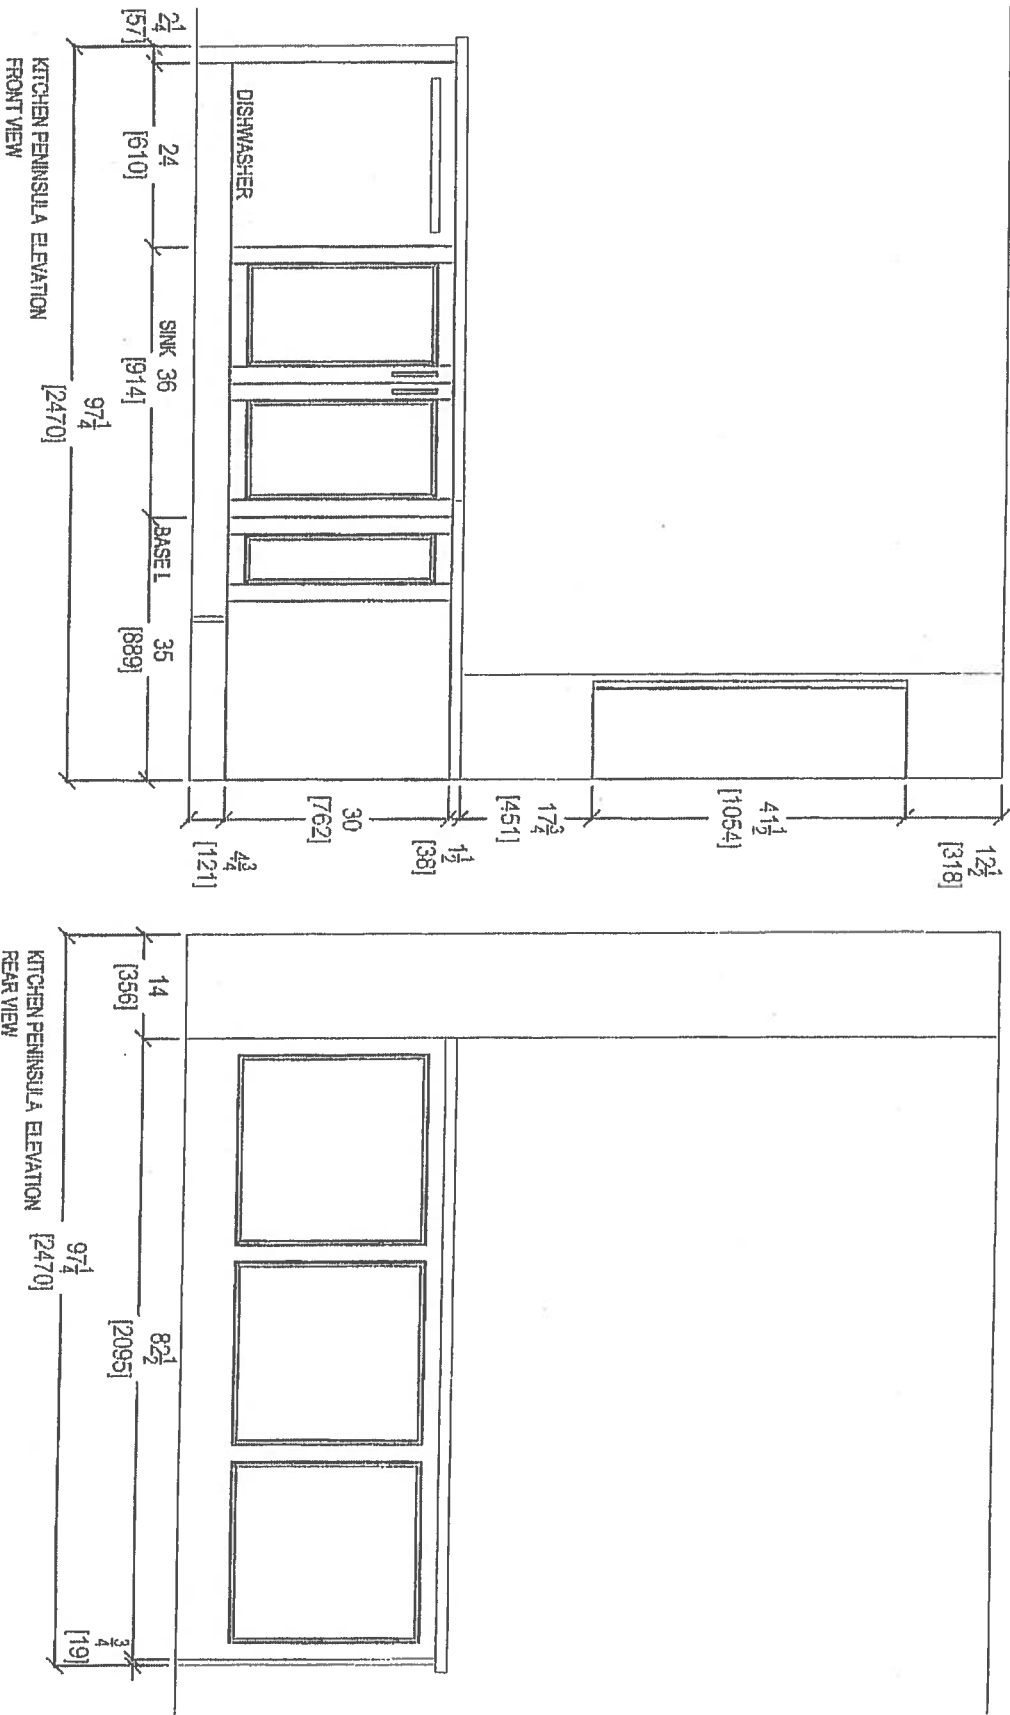


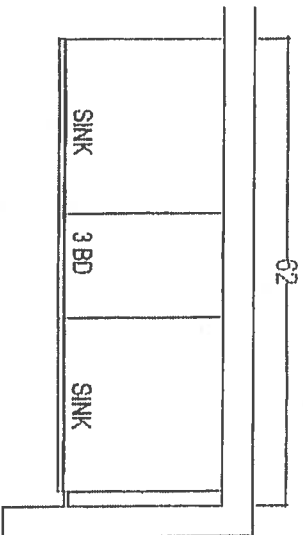


MASTER ENSUITE

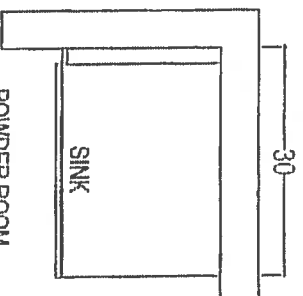

POWDER ROOM

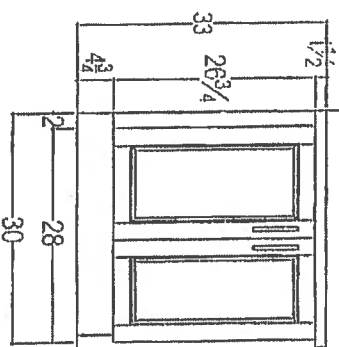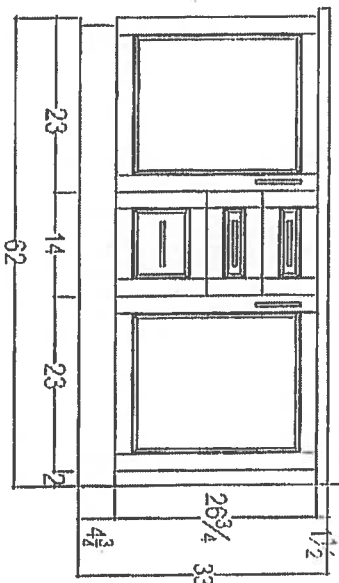

RECEIVED
11/10/17

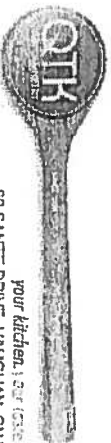


80 SANTE DRIVE, VAUGHAN, ON L4K 3C4,
T: 416.746.1871

CLIENT: ROYAL PINE HOMES	JOB NAME: 2D-P	ROOM: VANITIES	DRAWN BY: SK
SITE: HAMPTON PLACE	DOOR STYLE: —	DOOR HANDLE: —	SCALE: 1/2" = 1'-0"
PHONE: —	FINISH: —	DRW HANDLE: —	DATE: AUG 4, 2017
EMAIL: —	SPECIES: —	TOP: —	PAGE: —



COMMENTS:
PLEASE NOTE ALL DIMENSIONS
ARE NOT FINAL AND ARE
SUBJECT TO CHANGE UPON
FINAL SITE MEASURE

- o Suite #216 - Kitchen LAYOUT OPTION
with UPGRADE #1- Appliance PACKAGE
- o (P) = PLUG PENINSULA
- o (2x) = PENDANT LIGHTS OVER PENINSULA

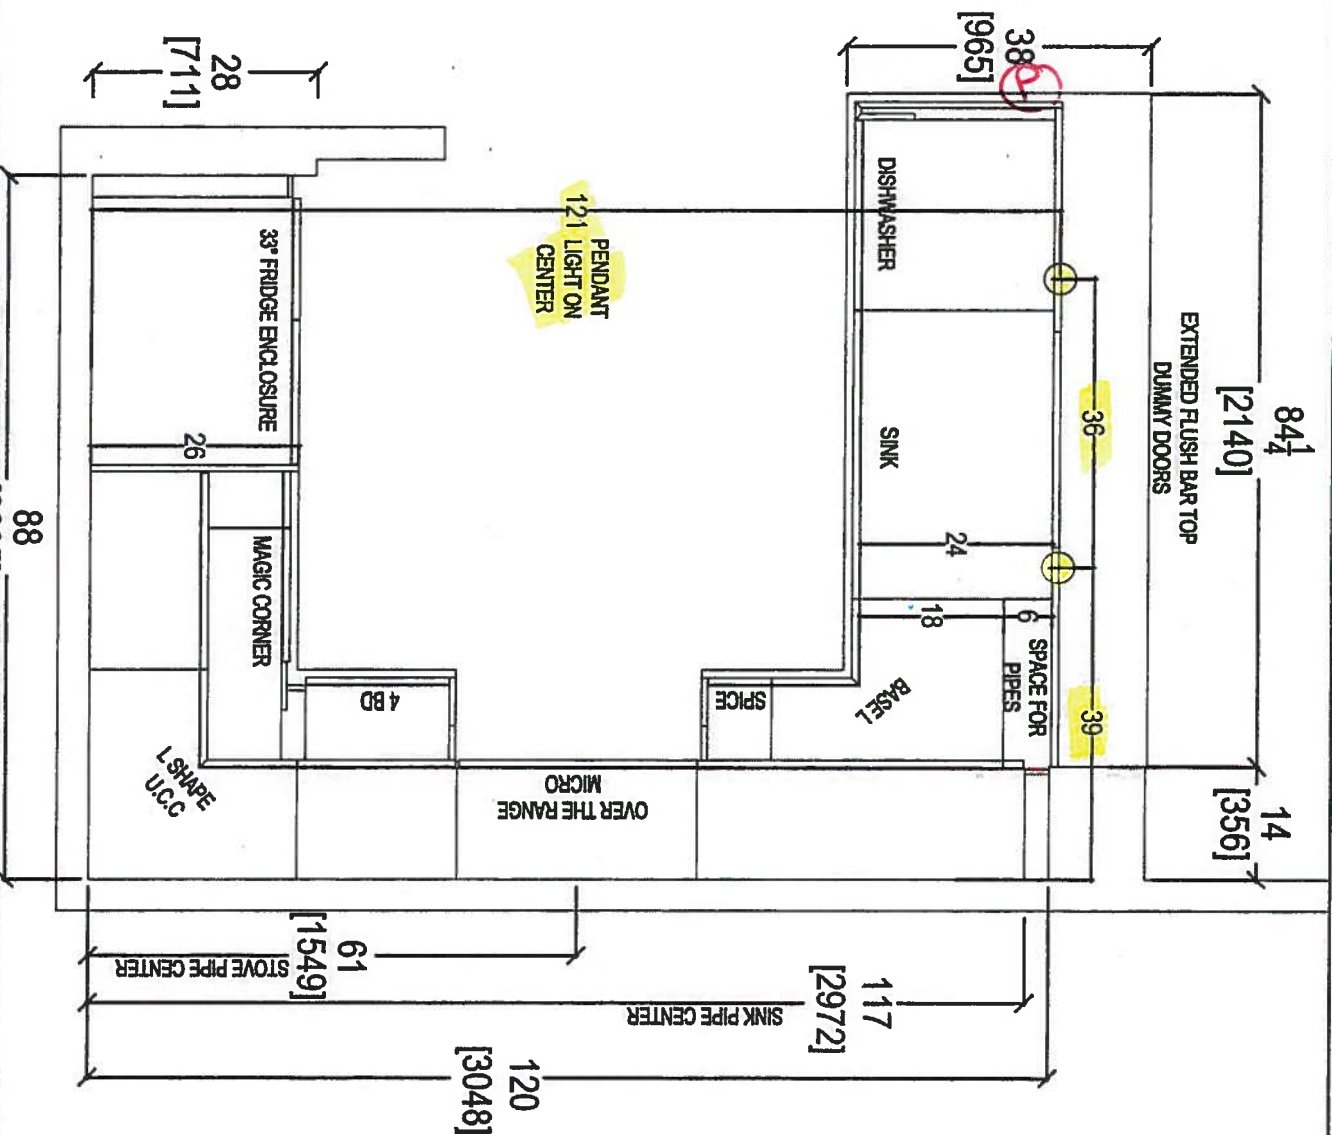

80 SANTE DRIVE, VAUGHAN, ONTARIO L4K 3C4,
T: 416.746.1811 F: 416.746.1812

CLIENT: ROYAL PINE HOMES	JOB NAME: UNIT 216 HMP	ROOM: KITCHEN FLOOR PLAN	DRAWN BY: SK	COMMENTS:
SITE: HAMPTON PLACE	DOOR STYLE: —	DOOR HANDLE: —	SCALE: 1/2" = 1'-0"	PLEASE NOTE ALL DIMENSIONS ARE NOT FINAL AND ARE SUBJECT TO CHANGE UPON FINAL SITE MEASURE
PHONE: —	FINISH: —	DRW HANDLE: —	DATE: JAN 29, 2018	
EMAIL: —	SPECIES: —	TOP: —	PAGE: —	

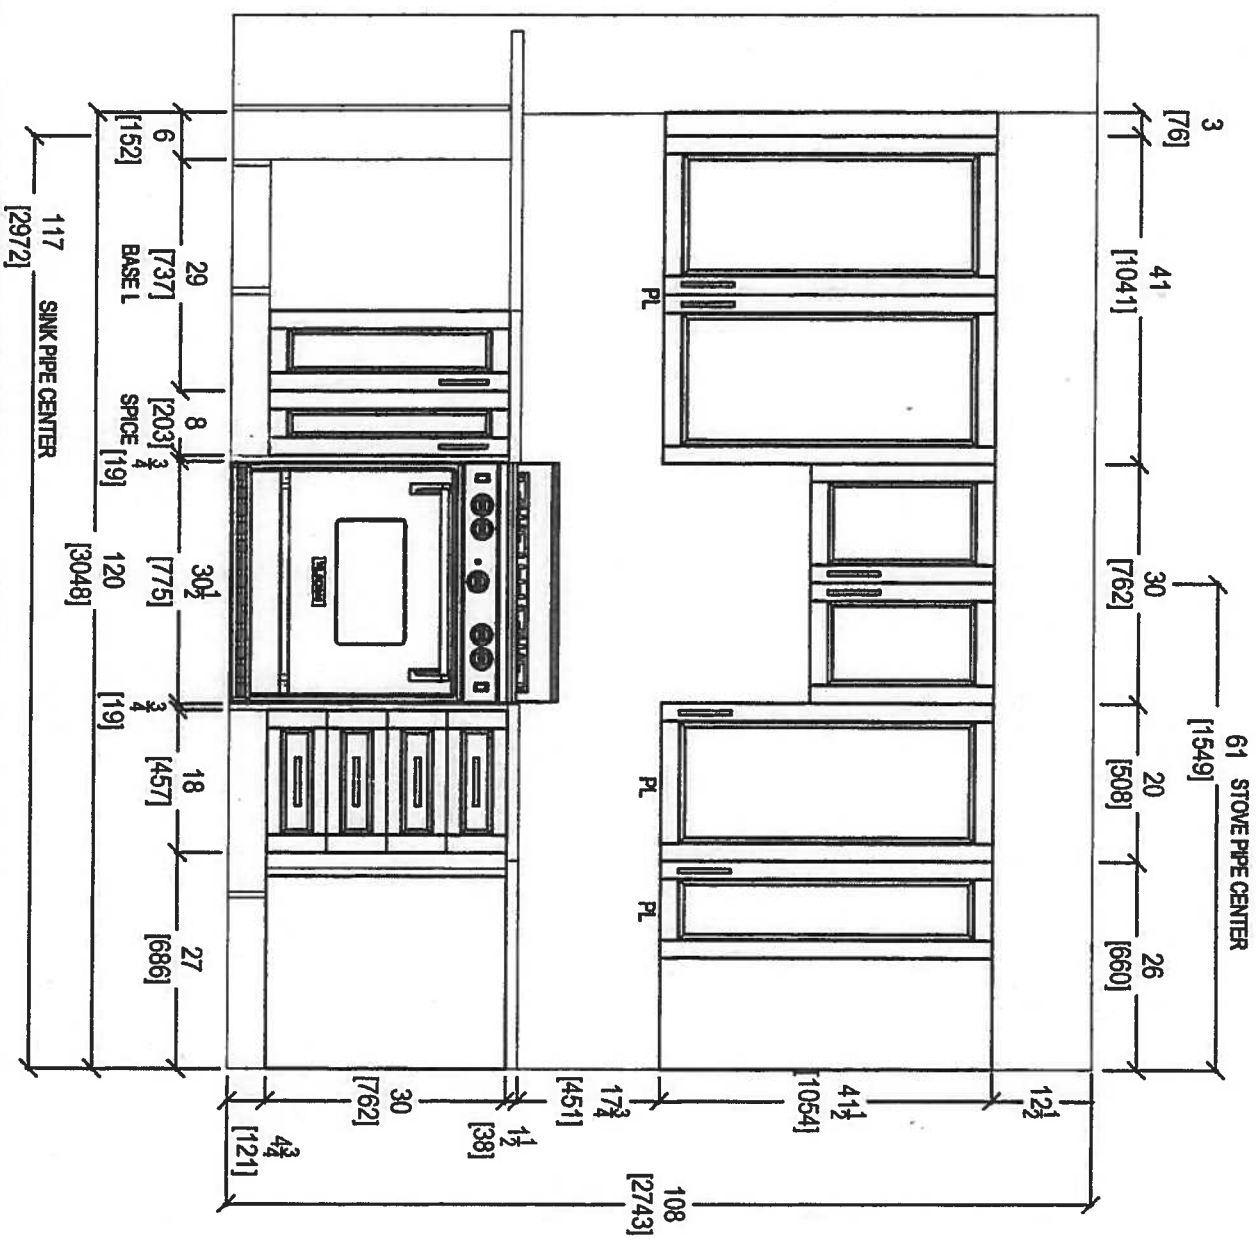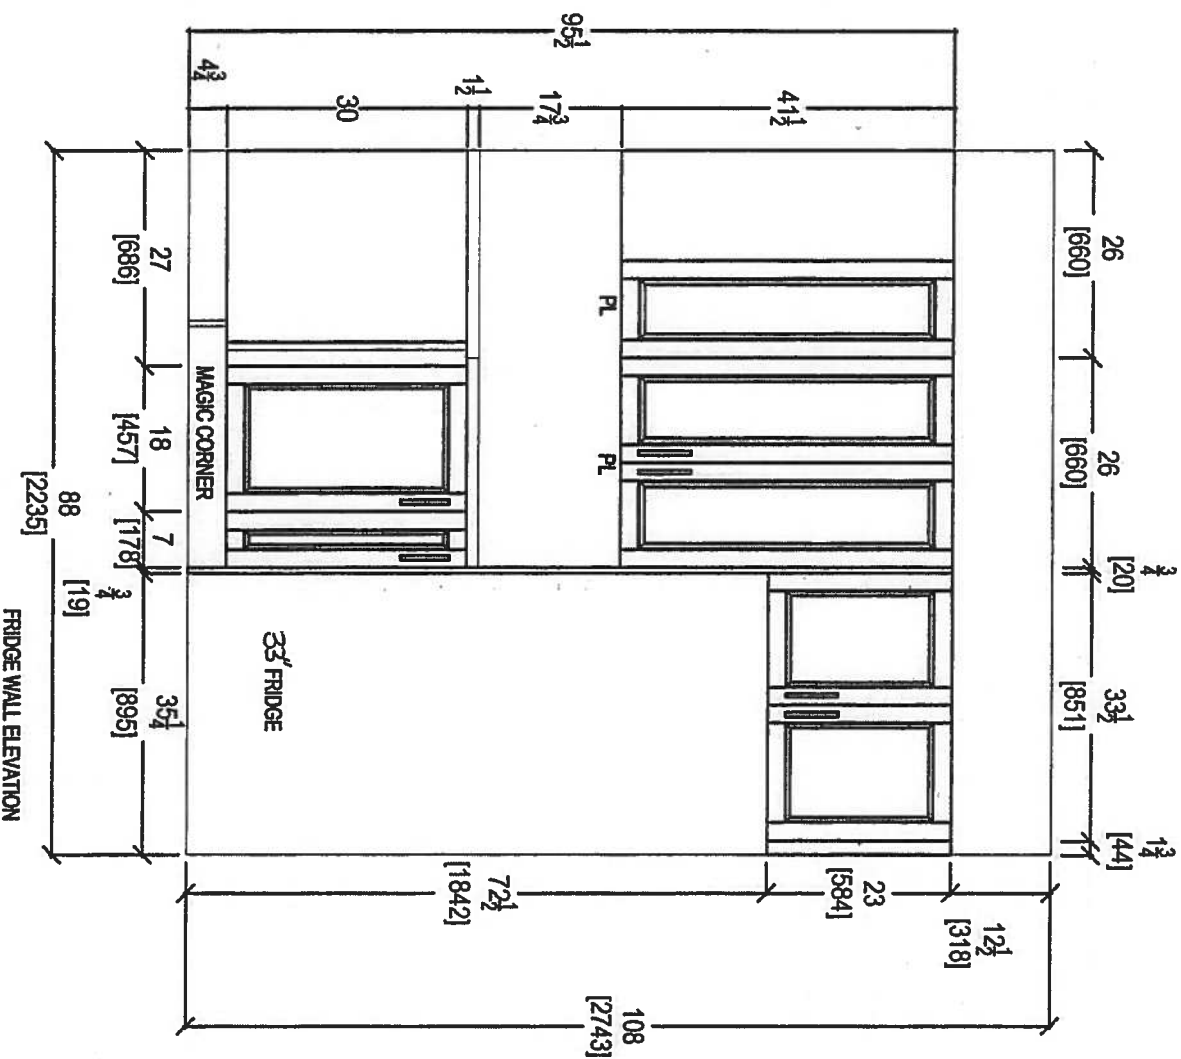

CLIENT: ROYAL PINE HOMES

JOB NAME: UNIT 218 HAMP

ROOM: KITCHEN

DRAWN BY: SK

COMMENTS:

SITE: HAMPTON PLACE

DOOR STYLE: —

DOOR HANDLE: —

SCALE: 1/2" = 1'-0"

PLEASE NOTE ALL DIMENSIONS ARE NOT FINAL AND ARE SUBJECT TO CHANGE UPON FINAL SITE MEASURE

PHONE: —

FINISH: —

DRW HANDLE: —

DATE: JAN 28 2018

PLEASE NOTE ALL DIMENSIONS ARE NOT FINAL AND ARE SUBJECT TO CHANGE UPON FINAL SITE MEASURE

EMAIL: —

SPECIES: —


TOP: —

PAGE: —

PLEASE NOTE ALL DIMENSIONS ARE NOT FINAL AND ARE SUBJECT TO CHANGE UPON FINAL SITE MEASURE



80 SANTE DRIVE, VAUGHAN, ONTARIO L4G 1S4
T: 416.746.1811 F: 416.746.1812

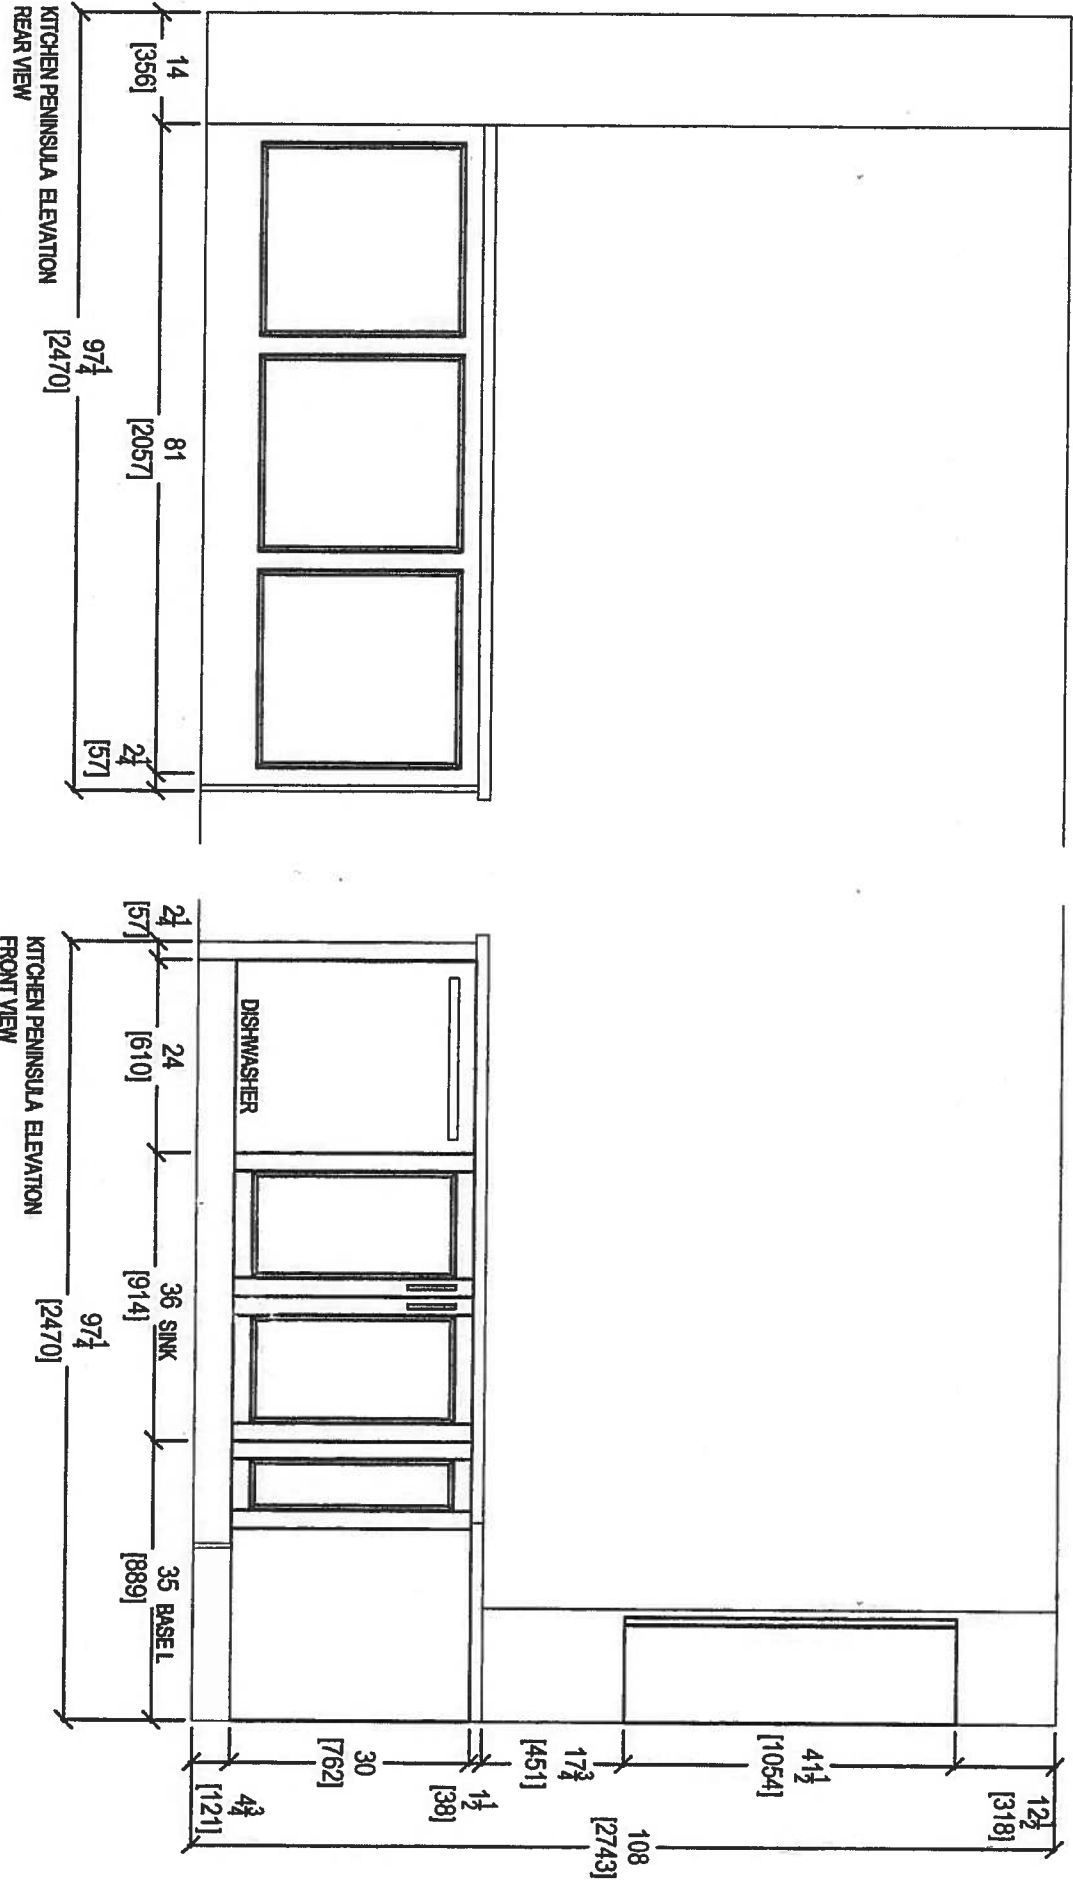


KITCHEN PENINSULA ELEVATION
REAR VIEW

KITCHEN PENINSULA ELEVATION
FRONT VIEW


QTR
your kitchen, your taste
80 SANTE DRIVE, VAUGHAN
T: 416.746.1811 F:30

CLIENT: ROYAL PINE HOMES		JOB NAME: UNIT 218 HMP		ROOM: KITCHEN		DRAWN BY: SK	
SITE: HAMPTON PLACE		DOOR STYLE: —		DOOR HANDLE: —		SCALE: 1/2" = 1' - 0"	
PHONE: —		FINISH: —		DRW HANDLE: —		DATE: JAN 29, 2018	
EMAIL: —		SPECIES: —		TOP: —		PAGE: —	



COMMENTS:
PLEASE NOTE ALL DIMENSIONS
ARE NOT FINAL AND ARE
SUBJECT TO CHANGE UPON
FINAL SITE MEASURE

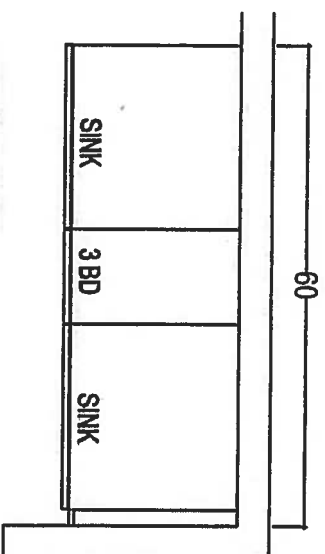

MASTER ENSUITE

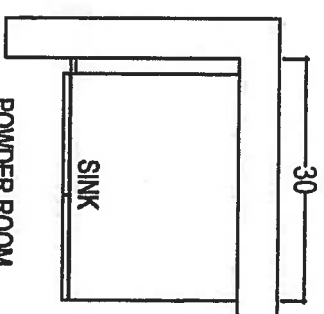

POWDER ROOM

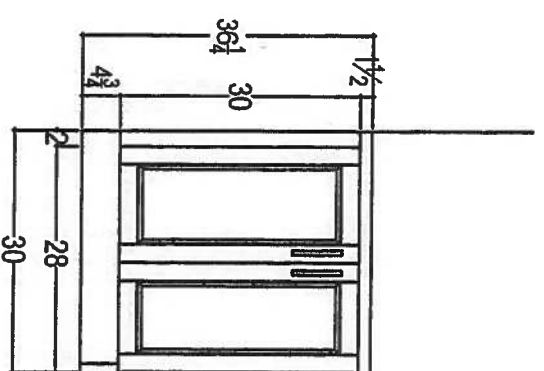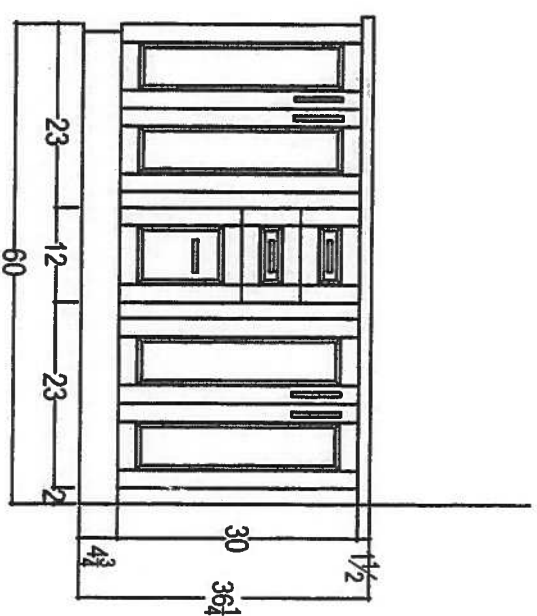

CLIENT: ROYAL PINE HOMES

JOB NAME: UNIT 216 HMP

ROOM: VANITIES

COMMENTS:

SITE: HAMPTON PLACE

DOOR STYLE: —

DOOR HANDLE: —

PLEASE NOTE ALL DIMENSIONS

PHONE: —

FINISH: —

DRW HANDLE: —

SCALE: 1/2" = 1'-0"

ARE NOT FINAL AND ARE

EMAIL: —

SPECIES: —

TOP: —

DATE: AUG 4, 2017

SUBJECT TO CHANGE UPON

—

—

—

PAGE: —

FINAL SITE MEASURE



80 SANTE DRIVE, VAUGHAN
T: 416.746.1811 F: 80