




Glen Cove

ORIGINAL SUITE


218

1,162 SQ FT *plus* 168 sq. ft. of balcony area

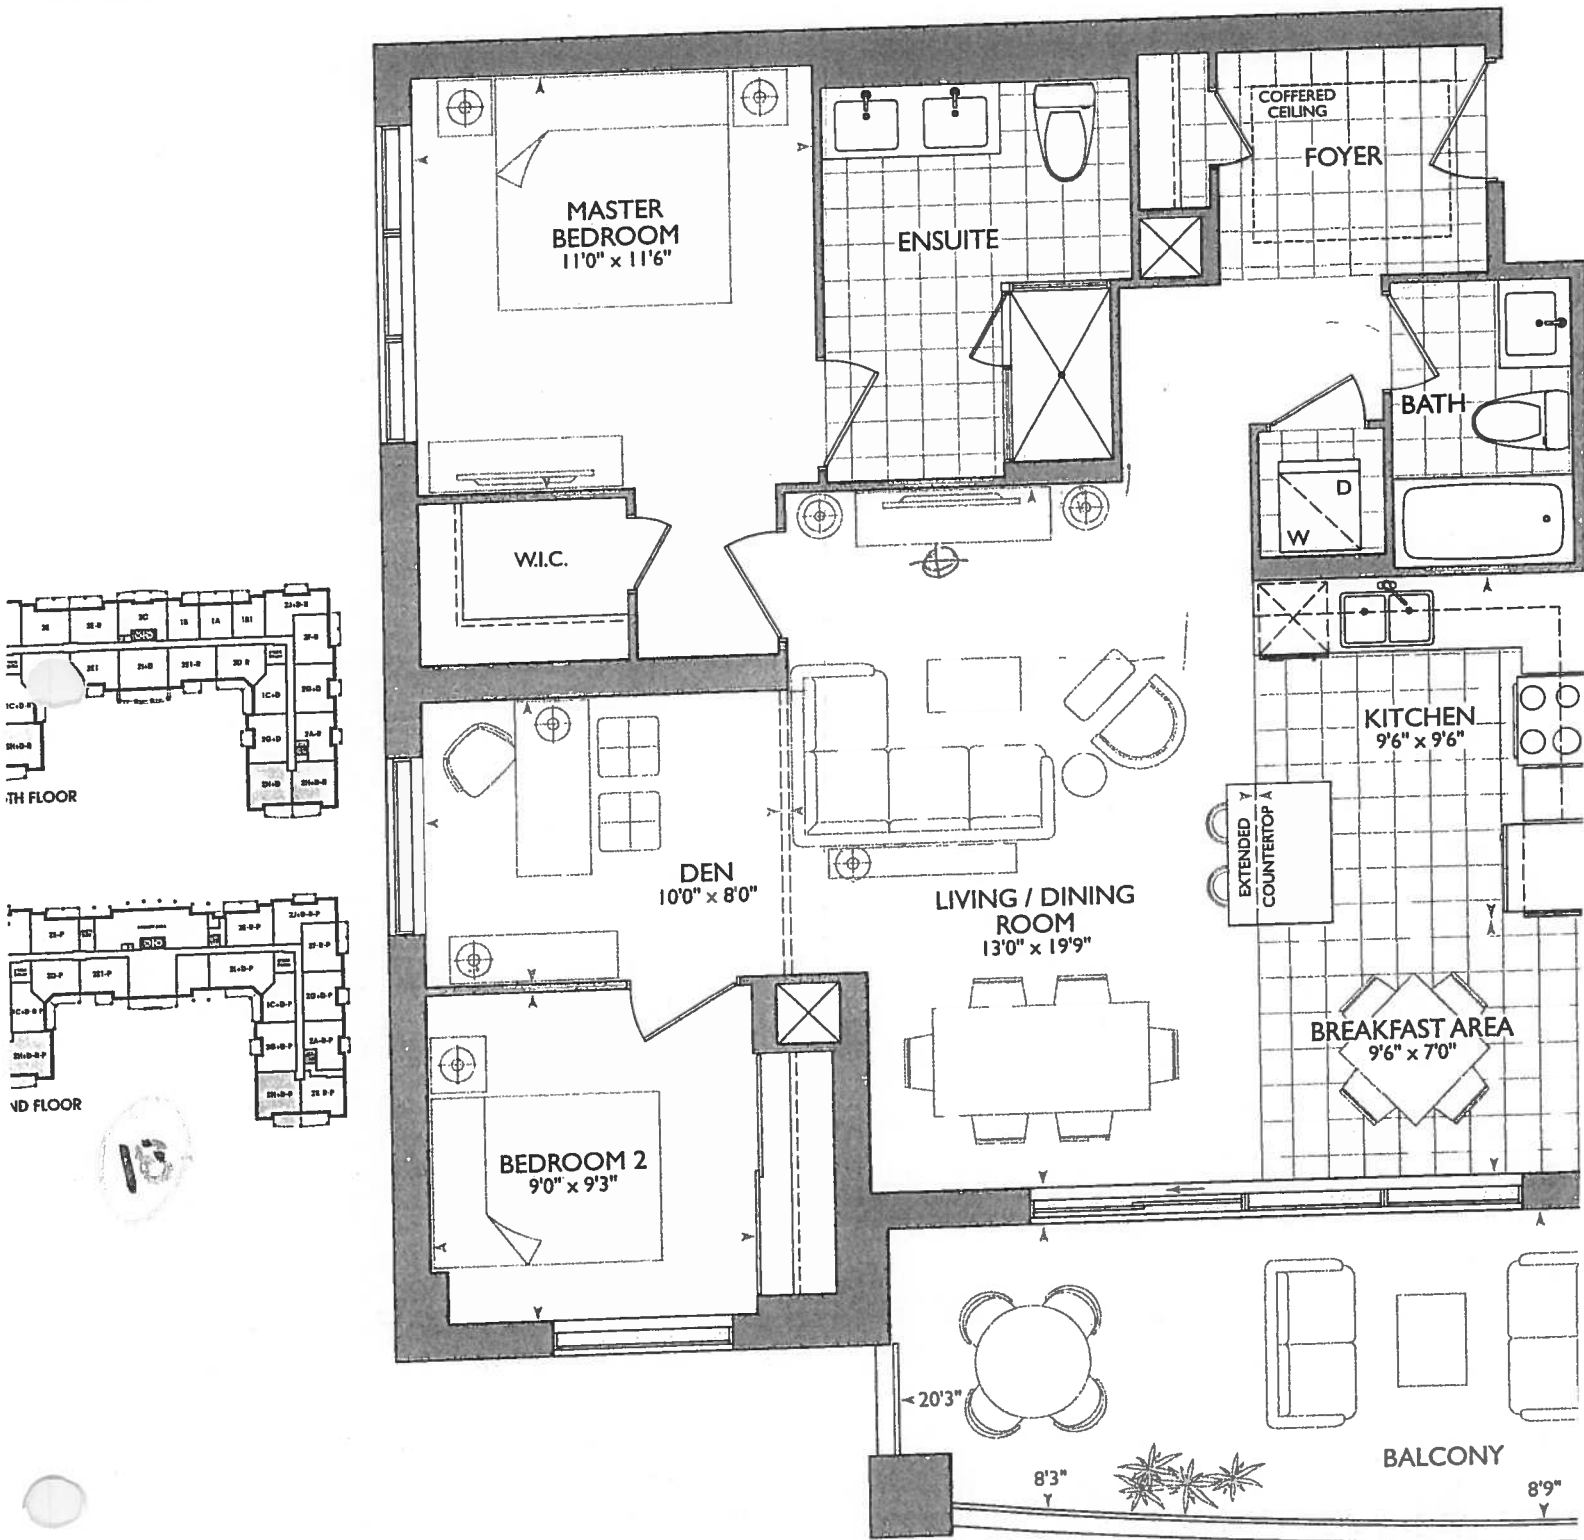

JAN 5 2018

- * BARRIER FREE SUITE
- * Delete Bathroom Mirrors + ACCESSORIES.

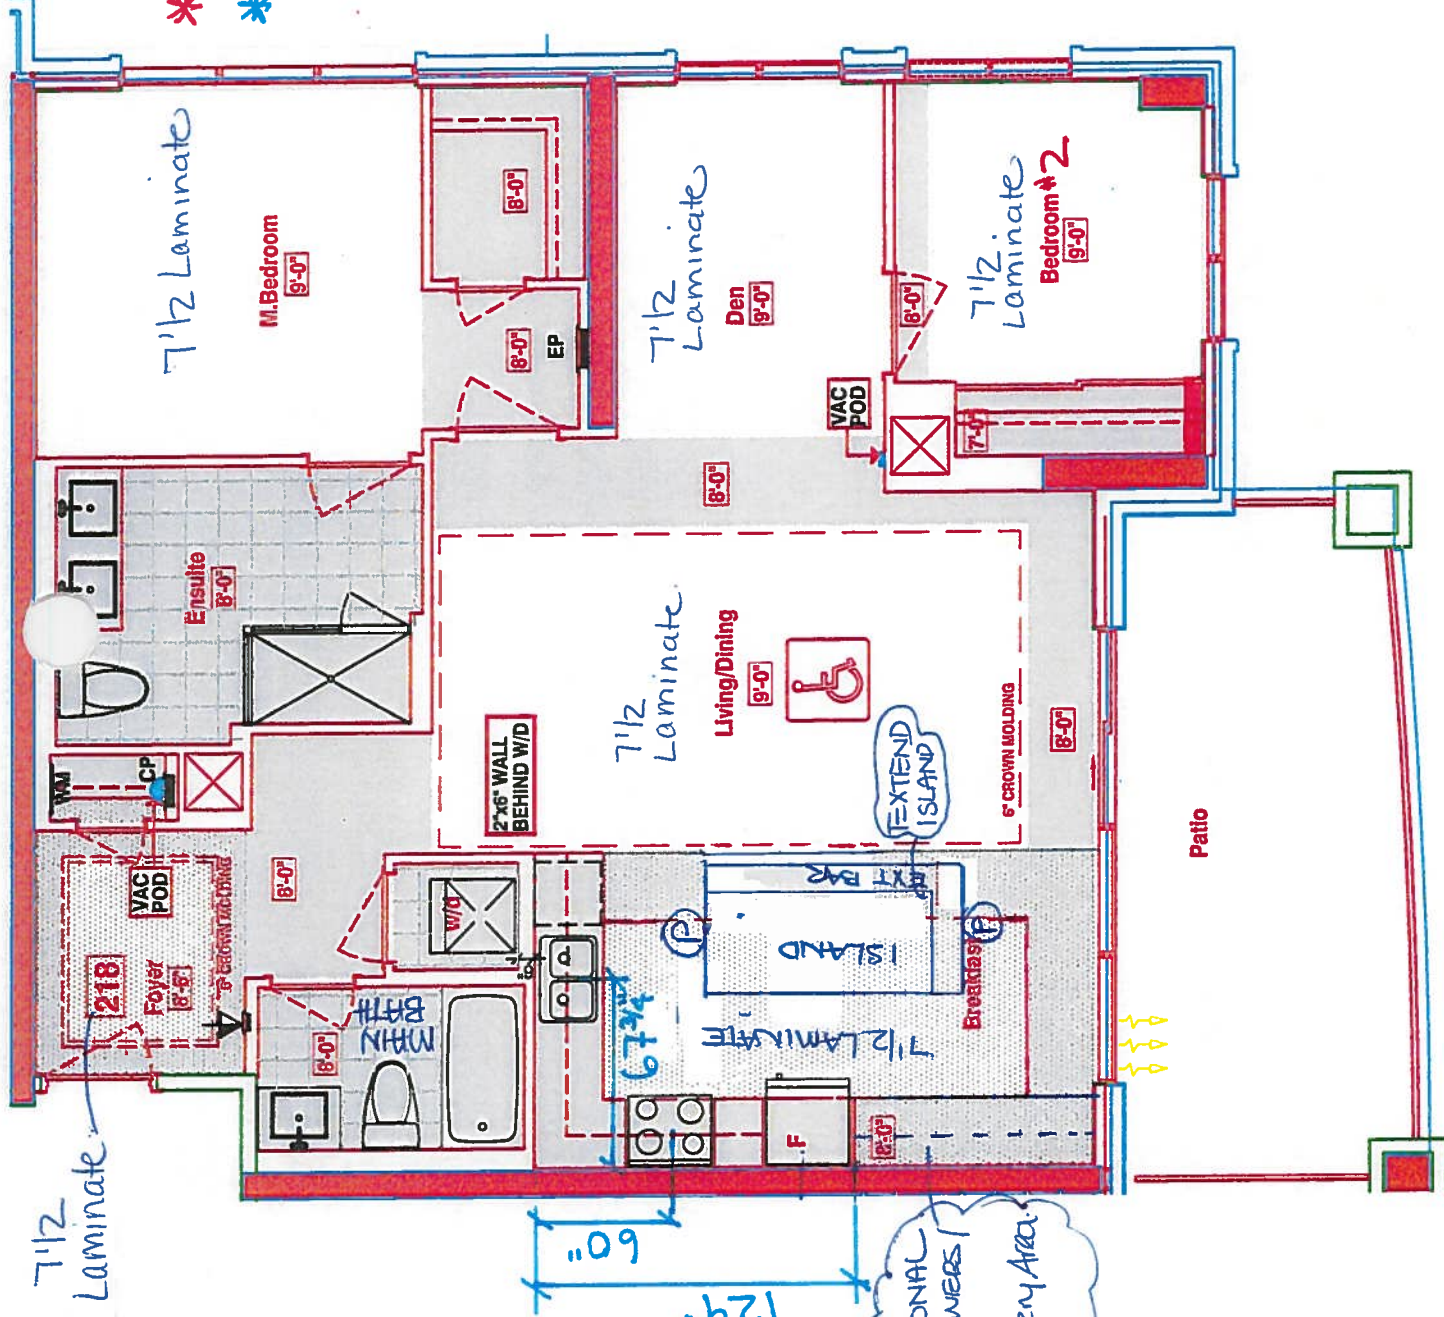

KITCHEN

- P= Plugs IN ISLAND (x2)
- KITCHEN ISLAND EXTENDED & SHIFTED TOWARDS FRIDGE WALL
- (x8) FUCH LIGHTS
- Appliance UPG #1-PACKAGE
- STOVE PIPE CENTER 60"
- SINK PIPE CENTER 67 3/4"
- MAIN & ENSUITE RAISED VANITIES 36 1/4" + 3" SPLASH.
- ADDITIONAL UPPEERS / LOWERS / COUNTRY NEW SERVING AREA.

RECEIVED
JAN 5 2018



* INTERIOR COLOUR SCHEME *

Purchaser STELLA V. COSENTINO	Decor Consultant Laura Di Pede	Model Type GLEN COVE	Telephone Res. / Bus (905) 737-0582 /	Project Hampton Place	Closing Date 20/09/2018	Unit 218
---	--	--------------------------------	---	---------------------------------	-----------------------------------	--------------------

		Wall Tile		
		Main	Accent/Insert	Pattern
MASTER ENSUITE	✓	13X13 Rustic Grey (STD)	✓	N/A
	✓	13X13 Rustic Grey (STD)	✓	N/A
POWDER ROOM	✓	N/A	✓	N/A
	✓	7 1/2" Torlys Forest Okangan 9742-P (STD)	✓	N/A
KITCHEN / DINETTE	✓	7 1/2" Torlys Forest Okangan 9742-P (STD)	✓	N/A
	✓	8X8 Behram Pink (STD)	✓	N/A
LIVING ROOM	✓	7 1/2" Torlys Forest Okangan 9742-P (STD)	✓	N/A
	✓	7 1/2" Torlys Forest Okangan 9742-P (STD)	✓	N/A
DINING ROOM	✓	7 1/2" Torlys Forest Okangan 9742-P (STD)	✓	N/A
	✓	7 1/2" Torlys Forest Okangan 9742-P (STD)	✓	N/A
DEN	✓	7 1/2" Torlys Forest Okangan 9742-P (STD)	✓	N/A
	✓	7 1/2" Torlys Forest Okangan 9742-P (STD)	✓	N/A
MASTER BEDROOM	✓	7 1/2" Torlys Forest Okangan 9742-P (STD)	✓	N/A
	✓	7 1/2" Torlys Forest Okangan 9742-P (STD)	✓	N/A
BEDROOM 2	✓	7 1/2" Torlys Forest Okangan 9742-P (STD)	✓	N/A
	✓	N/A	✓	N/A
BEDROOM 3	✓		✓	
	✓		✓	

Notes

SERVERY- Install upgraded backsplash in New Servery Area of Breakfast area -Cloud Random Strip Glass Mosaic -UPGD

Consultant:  Laura Di Pede	Purchaser:  STELLA V. COSENTINO	Vendor:  Hampton Place
--	--	--



* INTERIOR COLOUR SCHEME *

Purchaser	Decor Consultant	Model Type	Telephone Res. / Bus	Project	Closing Date	Unit
STELLA V. COSENTINO	Laura Di Pede	GLEN COVE	(905) 737-0582 /	Hampton Place	20/09/2018	218

Page 2 of 3

CABINETS, VANITIES AND COUNTERTOPS

	Style	Countertop	Counter Edge	Handle / Knob	APPLIANCE PACKAGE
MAIN BATHROOM	CATEGORY 2 Maple QT 2503 Pistachio - STD	☒ CaesarStone -Misty Carrara (UPG)	☒ "A" STD	B 603 SC	UPGRADE #1
MASTER ENSUITE	CATEGORY 2 Maple QT 2503 Pistachio - STD	☒ CaesarStone -Misty Carrara (UPG)	☒ "A" STD	B 603 SC	
POWDER ROOM	N/A	N/A	N/A	N/A	
KITCHEN / DINETTE	CATEGORY 1 QT 1203 White, STD	☒ Aspen Terra White (STD)	☒ "I" UPG	3487 128	Std 31in Opening
LAUNDRY ROOM	N/A	N/A	N/A	N/A	



PLUMBING FIXTURES


KITCHEN	☒ STANDARD	Trim	Baseboard & Casing	☒ STANDARD	Levers	☒ STANDARD
Sink Model	☒ STANDARD		Interior Doors	☒ STANDARD	Door Height	☒ STANDARD
Sink Faucet						
TOILETS						
Master Ensuite	☒ STANDARD					
Main Bathroom	☒ STANDARD					
Powder Room	N/A					
VANITY FAUCETS						
Master Ensuite	☒ STANDARD					
Main Bathroom	☒ STANDARD					
Powder Room	N/A					
VANITY SINKS						
Master Ensuite	☒ STANDARD					
Main Bathroom	☒ STANDARD					
Powder Room	N/A					
SHOWER STALL / TUBS						
Master Ensuite Shower Stall	☒ STANDARD					
Master Ensuite Tub	N/A					
Main Bathroom Tub	☒ STANDARD					

Trim	Baseboard & Casing	☒ STANDARD	Levers	☒ STANDARD
Interior Doors	☒ STANDARD		Door Height	☒ STANDARD
Cornice Moulding / Medallion		Fireplace		
Foyer	☒ CTR 611 STANDARD		Fireplace	N/A
Living Room	☒ CTR 611 STANDARD		Location Flooring	N/A
Dining Room	☒ CTR 611 STANDARD		Style	N/A
Den	N/A		Finish	N/A
Master Bedroom	N/A		Marble	N/A
Bedroom 2	N/A		Hearth	N/A
Bedroom 3	N/A			
Paint Throughout		Trim		
Walls	☒ BIRCH WHITE	WHITE		


MISC. INSTALLATIONS	
Ceramic Accessories (installed by Vendor)	☒ Yes ☐ No
Bathroom Mirrors (installed by Vendor)	☒ Yes ☐ No
Wire Shelving - Closet (installed by Vendor)	☒ Yes ☐ No

Page 2 of 3

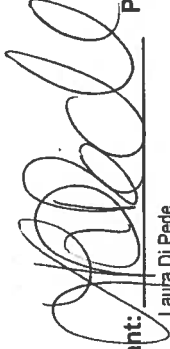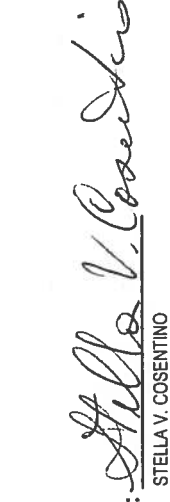
Decor Consultant:  Purchaser:  STELLA V. COSENTINO

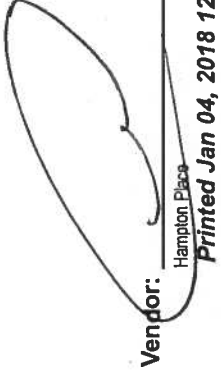Vendor:  Hampton Place
Printed Jan 04, 2018 12:55 pm

SUITE 218 HAMPTON

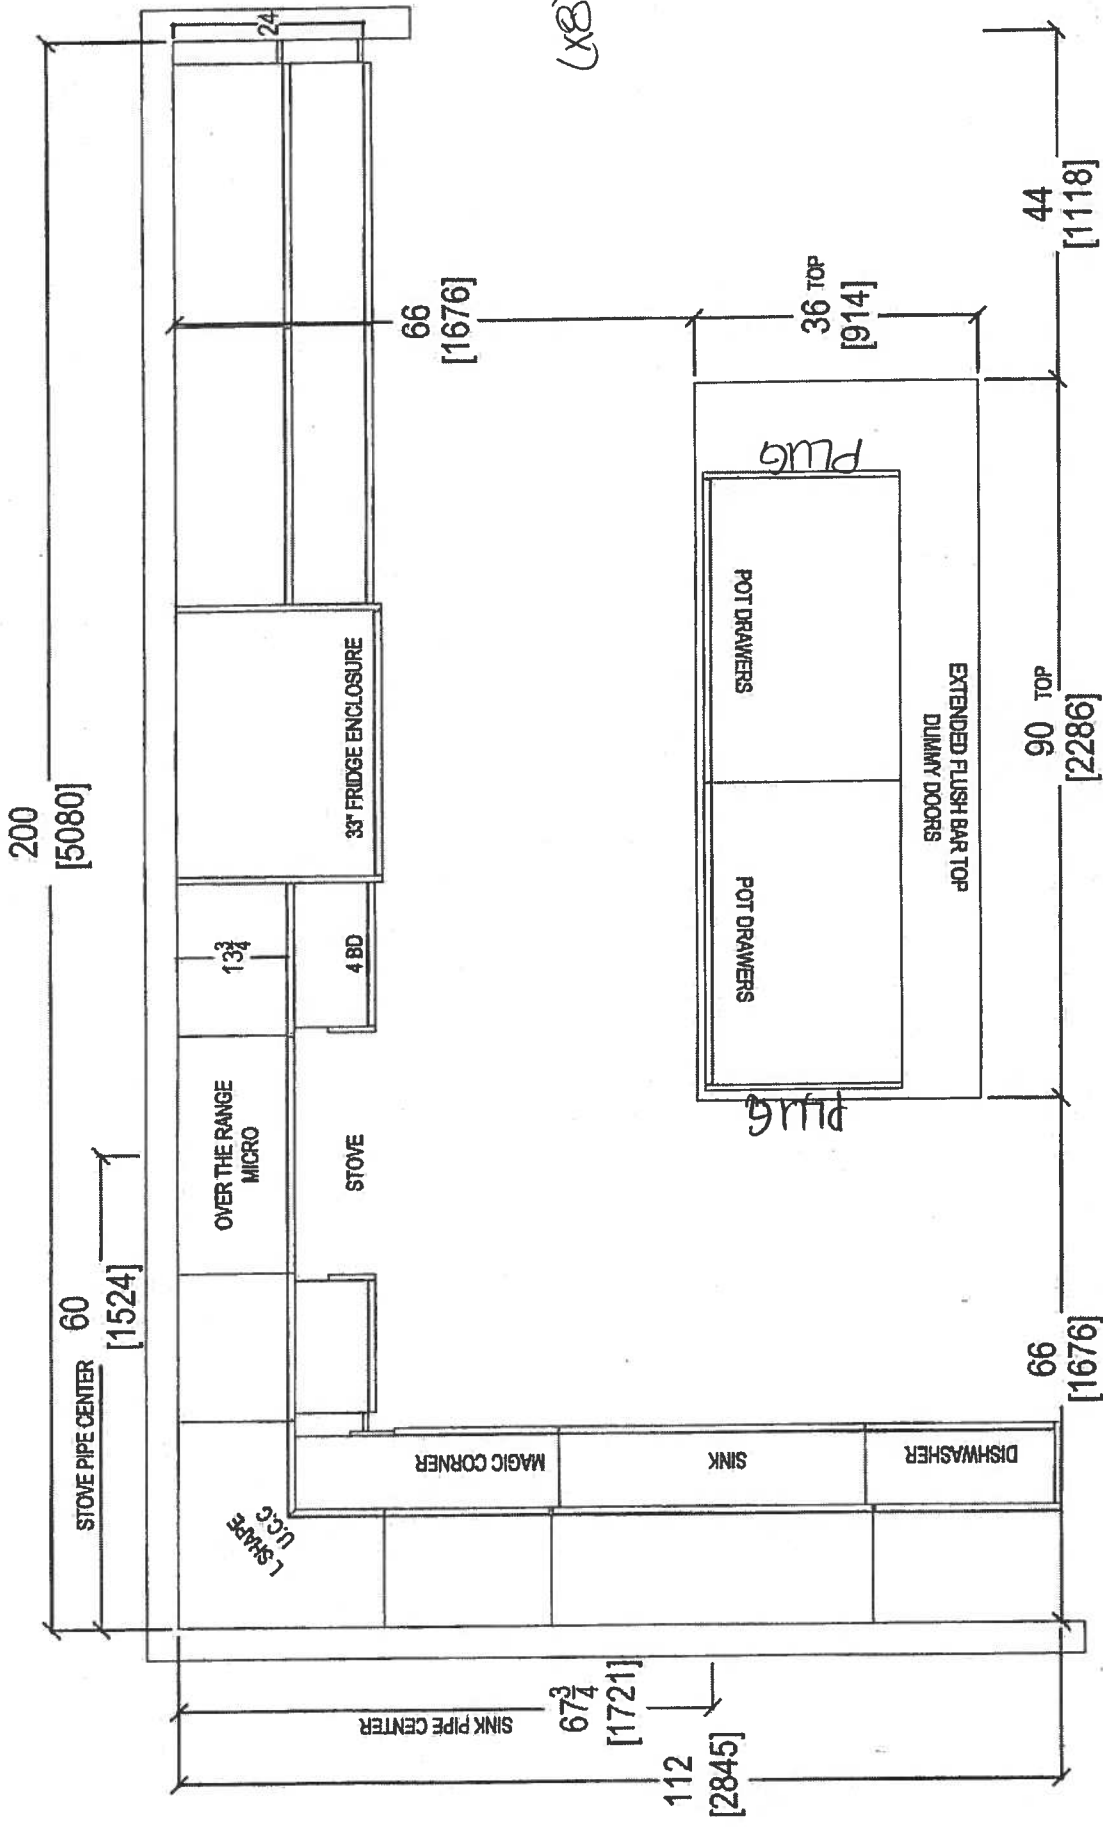

 <i>your kitchen, your style</i> 80 SANTE DRIVE, VAUGHAN, ON L4K 3C4, T: 416.748.1811 F: 905.761.5901				CLIENT: ROYAL PINE HOMES	UNIT 218 HMP	ROOM: KITCHEN FLOOR PLAN	DRAWN BY: SK		COMMENTS: PLEASE NOTE ALL DIMENSIONS ARE NOT FINAL AND ARE SUBJECT TO CHANGE UPON FINAL SITE MEASURE
SITE: HAMPTON PLACE	DOOR STYLE: —	DOOR HANDLE: —	SCALE: 1/2" = 1' - 0"						
PHONE: —	FINISH: —	DRW HANDLE: —	DATE: JAN 10, 2018						
EMAIL: —	SPECIES: —	TOP: —	PAGE: —						

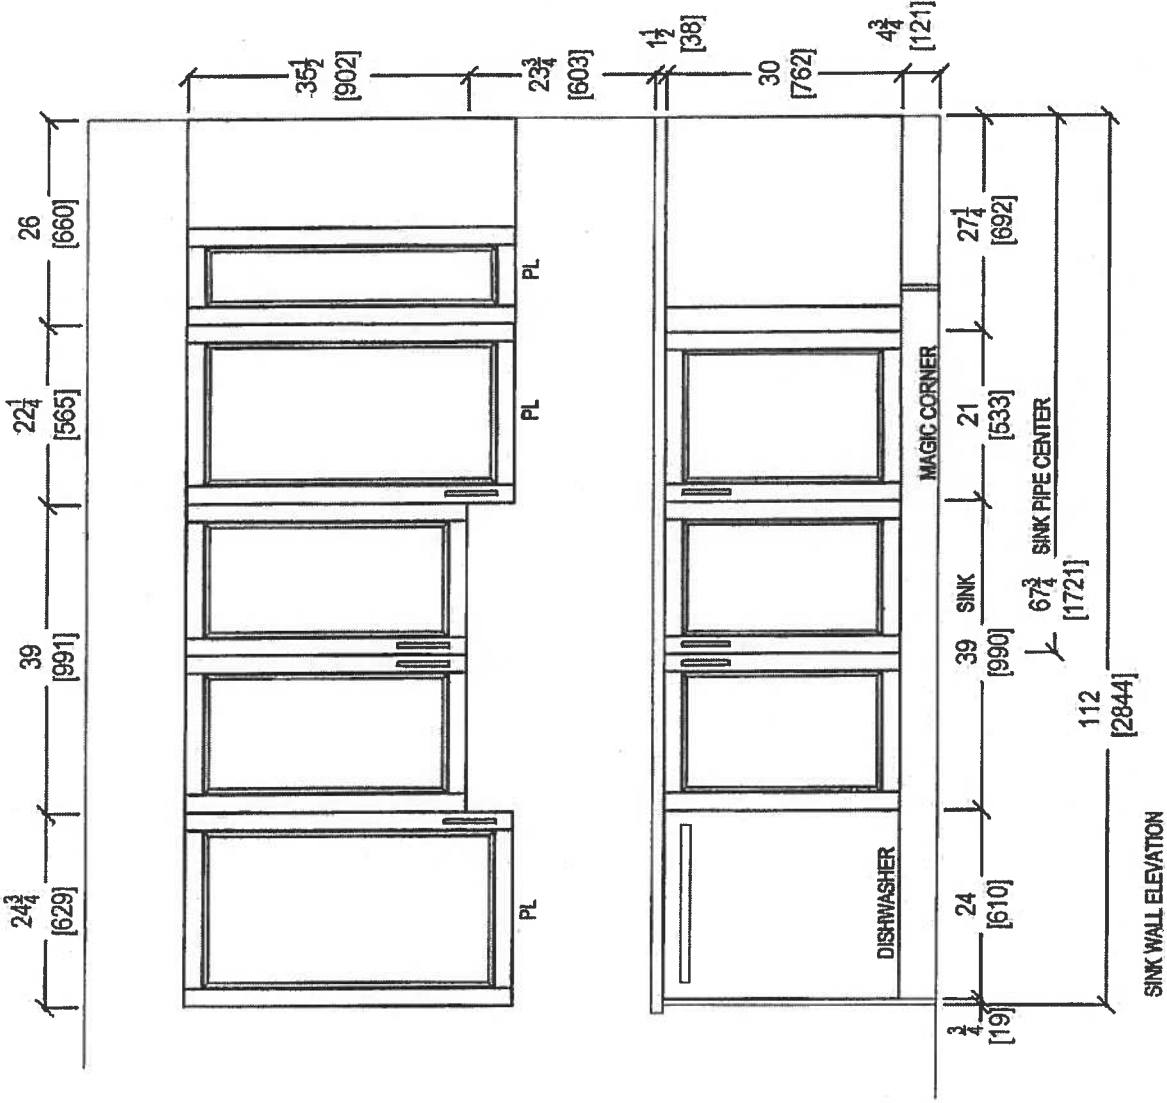

SINK WALL ELEVATION

Suite 218

JAN 10 | 18

TOTAL (x8) ROCK LIGHTS



80 SANTE DRIVE, VAUGHAN, ON L4K 3C4,
T: 416.746.1811 F: 905.781.5901

CLIENT: ROYAL PINE HOMES
SITE: HAMPTON PLACE
PHONE: —
EMAIL: —

UNIT 218 HMP
DOOR STYLE: —
FINISH: —
SPECIES: —

ROOM: KITCHEN
DOOR HANDLE: —
DRW HANDLE: —
TOP: —

DRAWN BY: SK
SCALE: 1/2" = 1' - 0"
DATE: JAN 10, 2018
PAGE: —

COMMENTS:
PLEASE NOTE ALL DIMENSIONS
ARE NOT FINAL AND ARE
SUBJECT TO CHANGE UPON
FINAL SITE MEASURE

[illegible]

QTK
KITCHEN

SINCE 1911
MADE IN U.S.A.

your kitchen, your taste


PO. BOX 1000, CHICAGO, ILL. 60601

your kitchen. your taste.
80 SANTE DRIVE, VAUGHAN, ON L4K 3C4,
T: 416.748.1811 F: 905.761.5901

CLIENT: ROYAL PINE HOMES	UNIT 218 HMP	ROOM: KITCHEN	DRAWN BY: SK	COMMENTS: PLEASE NOTE ALL DIMENSIONS ARE NOT FINAL AND ARE SUBJECT TO CHANGE UPON FINAL SITE MEASURE
SITE: HAMPTON PLACE	DOOR STYLE: —	DOOR HANDLE: —	SCALE: 1/2" = 1' - 0"	
PHONE: —	FINISH: —	DRW HANDLE: —	DATE: JAN 10, 2018	
EMAIL: —	SPECIES: —	TOP: —	PAGE: —	

COMMENTS:

PLEASE NOTE ALL DIMENSIONS
ARE NOT FINAL AND ARE
SUBJECT TO CHANGE UPON
FINAL SITE MEASURE

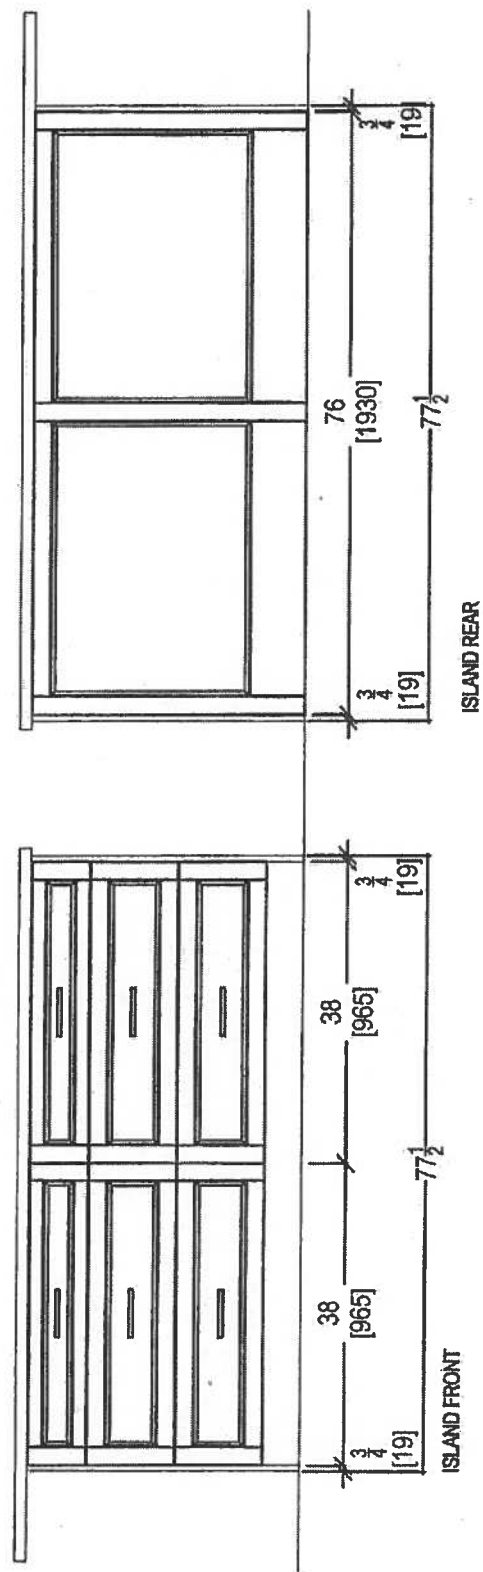


CLIENT: ROYAL PINE HOMES		UNIT 218 HMP	ROOM: KITCHEN	DRAWN BY: SK	COMMENTS: PLEASE NOTE ALL DIMENSIONS ARE NOT FINAL AND ARE SUBJECT TO CHANGE UPON FINAL SITE MEASURE
SITE: HAMPTON PLACE	DOOR STYLE: —	DOOR HANDLE: —	SCALE: 1/2" = 1' - 0"		
PHONE: —	FINISH: —	DRW HANDLE: —	DATE: JAN 10, 2018		
EMAIL: —	SPECIES: —	TOP: —	PAGE: —		


* INSTALL 3" SPLASH *

JAN 4, 2018



Handwritten signature

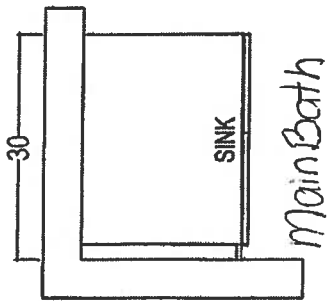

* RAISED HEIGHT *

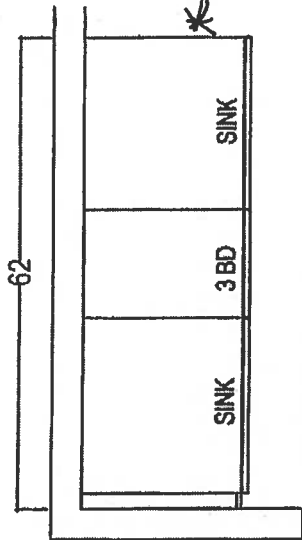

* RAISED HEIGHT *

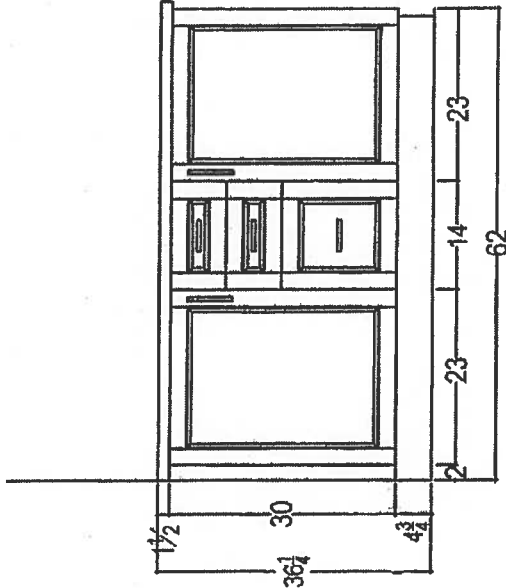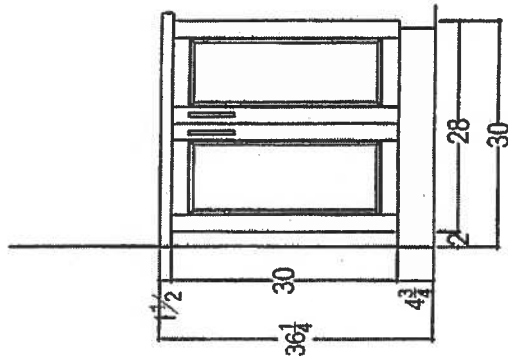

80 SANTE DRIVE, VAUGHAN, ON L4K 3C4,
T: 416.746.1811 F: 905.781.5901

CLIENT: ROYAL PINE HOMES

SITE: HAMPTON PLACE

PHONE: —

EMAIL: —

GLEN COVE 2H+ D UPGRADE PACKAGE 2

DOOR STYLE: —

FINISH: —

SPECIES: —

ROOM:

DOOR HANDLE: —

DRW HANDLE: —

TOP: —

VANITIES

DRAWN BY: SK

SCALE: 1/2" = 1'-0"

DATE: AUG 4, 2017

PAGE: —

COMMENTS:

PLEASE NOTE ALL DIMENSIONS
ARE NOT FINAL AND ARE
SUBJECT TO CHANGE UPON
FINAL SITE MEASURE

Suite 218 HAMPTON

Upgrade Package I

A/C

WRB322DMBM

Whirlpool®

36 inches wide Bottom-Freezer Refrigerator with
SpillGuard™ Glass Shelves - 22 cu. ft

<http://www.whirlpool.com>

Key Features:

- SpillGuard™ Glass Shelves
- Adaptive Defrost / *Factory Installed Icemaker*
- FreshFlow™ Produce Preserver
- LED Interior Lighting
- ENERGY STAR® Qualified

Product Dimensions:

Height: 70

Width: 32 5/8

Depth: 33 3/8

Electrical Requirements:

15


Additional Information:

[Use And Care Guide](#)

[Dimension Guide](#)

[Energy Guide](#)

[Warranty Certificate](#)

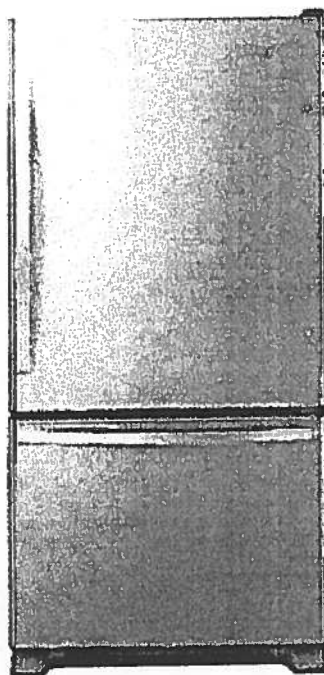

INVESTED
IN
AMERICA



©Registered trademark/TM Trademark of Whirlpool, U.S.A. © 2018 Whirlpool Corporation. All Rights Reserved.
All other trademarks are owned by their respective companies.
Because Whirlpool Corporation policy includes a continuous commitment to improve our products, we reserve the right to change materials and specifications without notice. We also reserve the right to discontinue or transition products without notice.
Manufacturer's Suggested Retail Price (MSRP) and Minimum Advertised Price (MAP) provided for reference purposes only. Dealer alone determines advertised and retail prices.
Created On: Tuesday, March 14, 2017 11:30:08

WEE745H0FS

Upgrade
Package I

W.C.

Whirlpool®

<http://www.whirlpool.com>

6.4 Cu. Ft. Slide-In Electric Range with True
Convection



Key Features:

- Frozen Bake™ Technology
- True Convection Cooking
- FlexHeat™ Triple Radiant Element
- Convection Conversion
- AquaLift® Self-Cleaning Technology
- Temperature Sensor
- Rapid Preheat
- 6.4 Cu. Ft. Capacity
- Easy-Wipe Ceramic Glass Cooktop
- Large Oven Window
- Max Capacity Rack
- Hidden Bake Element

Product Dimensions:

Height: 36

Width: 29 7/8

Additional Information:

[Use And Care Guide](#)

[Dimension Guide](#)

[Installation Guide](#)

[Warranty Certificate](#)

INVESTED
IN
AMERICA



©Registered trademark/TM Trademark of Whirlpool, U.S.A. © 2016 Whirlpool Corporation. All Rights Reserved.
All other trademarks are owned by their respective companies.
Because Whirlpool Corporation policy includes a continuous commitment to improve our products, we reserve the right to change materials and specifications without notice. We also reserve the right to discontinue or transition products without notice.
Manufacturer's Suggested Retail Price (MSRP) and Minimum Advertised Price (MAP) provided for reference purposes only. Dealer alone determines advertised and retail prices.
Created On: Friday, January 27, 2017 10:48:47

Upgrade Package 1

01/12/16

YWMH76719CS



<http://www.whirlpool.com>

1.9 cu. ft. Microwave Hood Combination with
TimeSavor™ Plus True Convection

Key Features:

- TimeSavor™ Plus True Convection Cooking System
- Steam Cooking
- Sensor Cooking
- AccuPop™ Cycle
- CleanRelease® Non-Stick Interior
- SteamClean Option
- Integrated Hidden Vent and Console
- Auto Adapt Fan
- Recessed, Stoppable Glass Turntable
- Universal Microwave Steamer
- 1.9 cu. ft. Capacity
- 1,100 Watts Cooking Power

Product Dimensions:

Height: 17 1/8

Width: 29 15/16

Depth: 18 1/2

Electrical Requirements:

15 or 20. 120 V.

Additional Information:


[Use And Care Guide](#)

[Installation Guide](#)

[Warranty Certificate](#)

Available in:

 Stainless Steel

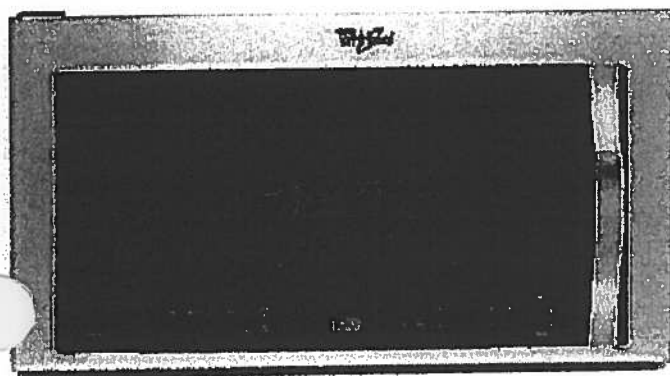

©Registered trademark/TM Trademark of Whirlpool, U.S.A. © 2013 Whirlpool Corporation. All Rights Reserved.
All other trademarks are owned by their respective companies.
Because Whirlpool Corporation policy includes a continuous commitment to improve our products, we reserve the right to change materials and specifications without notice. We also reserve the right to discontinue or transition products without notice.
Manufacturer's Suggested Retail Price (MSRP) and Minimum Advertised Price (MAP) provided for reference purposes only. Dealer alone determines advertised and retail prices.
Created On: Monday, March 14, 2016 13:16:48

Upgrade Package 1

WDTA50SAHZ

A.P.C.

Whirlpool®

<http://www.whirlpool.com>

Contemporary Design. Stainless Steel Tub
Dishwasher with TotalCoverage Spray Arm

Key Features:

- Sensor Cycle
- TotalCoverage Spray Arm
- 1-Hour Wash Cycle
- Tap Touch Controls

Product Dimensions:

Height: 34 1/2
Width: 23 7/8
Depth: 24 1/2

Additional Information:


[Use And Care](#)

[Dimension Guide](#)

[Installation Guide](#)

[Energy Guide](#)

[Warranty](#)

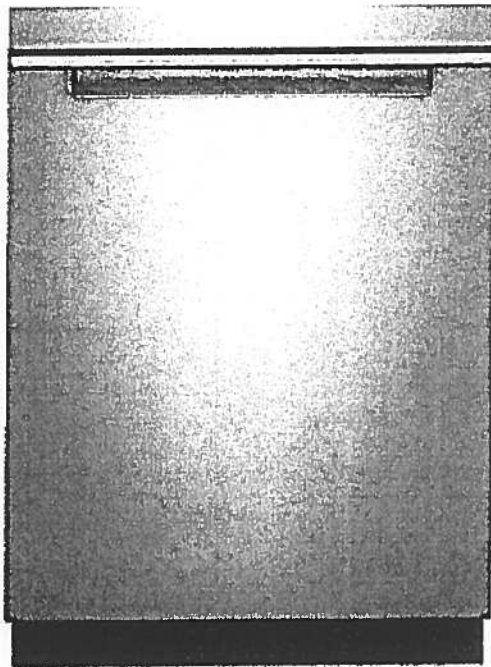

Available in:

● Black

Fingerprint Resistant Sunset Bronze

Fingerprint Resistant Black Stainless

○ White

Fingerprint Resistant Stainless Steel

INVESTED
IN
AMERICA



©Registered trademark/TM Trademark of Whirlpool, U.S.A. © 2016 Whirlpool Corporation. All Rights Reserved. All other trademarks are owned by their respective companies.

Because Whirlpool Corporation policy includes a continuous commitment to improve our products, we reserve the right to change materials and specifications without notice. We also reserve the right to discontinue or transition products without notice.

Manufacturer's Suggested Retail Price (MSRP) and Minimum Advertised Price (MAP) provided for reference purposes only. Dealer alone determines advertised and retail prices.

Upgrade Package 1


[Handwritten signature]

WFW75HEFW



<http://www.whirlpool.com>

4.5 cu. ft. Front Load Washer with Precision
Dispense

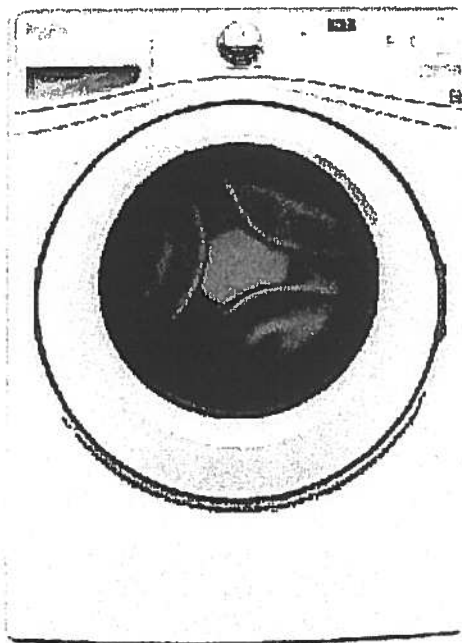

Key Features:

- Precision Dispense
- Adaptive Wash Technology
- Smooth Wave Stainless Steel Wash Basket
- 4.5 cu. ft. Capacity
- ENERGY STAR® Qualified

Product Dimensions:

Height: 39 3/4

Width: 27

Depth: 33 5/16

Electrical Requirements:

15 or 20. 120 V.

Additional Information:

[Use And Care Guide](#)

[Dimension Guide](#)

[Installation Guide](#)

[Energy Guide](#)

[Warranty Certificate](#)

INVESTED
IN
AMERICA



©Registered trademark/TM Trademark of Whirlpool, U.S.A. ©2013 Whirlpool Corporation All Rights Reserved.
All other trademarks are owned by their respective companies.
Because Whirlpool Corporation policy includes a continuous commitment to improve our products, we reserve the right to change materials and specifications without notice. We also reserve the right to discontinue or transition products without notice.
Manufacturer's Suggested Retail Price (MSRP) and Minimum Advertised Price (MAP) provided for reference purposes only. Dealer alone determines advertised and retail prices.
Created On: Wednesday, March 23, 2016 11:51:03

Upgrade Package 1

S.D.C.

YWED75HEFW

Whirlpool®

8.5 cu. ft. Duet® High Efficiency Front Load Electric
Washer with ENERGY STAR®

<http://www.whirlpool.com>

MSRP: \$0.00

Key Features:

- Advanced Moisture Sensing System
- Quad Baffles
- Tap Touch Controls with Memory
- EcoBoost™ Option
- Wrinkle Shield™ Plus Option
- Undercounter Installation
- 7.4 Cu. Ft. Capacity
- ENERGY STAR® Qualified

Product Dimensions:

Height: 39

Width: 27


Depth: 31

Additional Information:

[Use And Care](#)

[Installation Guide](#)

[Warranty](#)

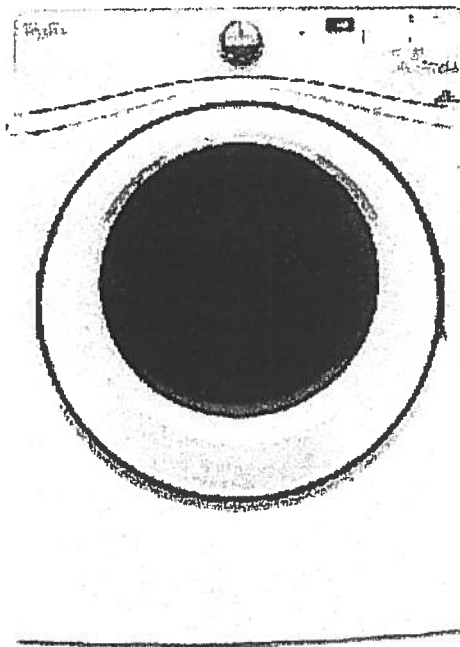

Available in:

☐ White

INVESTED
IN
AMERICA

ADA
Compliant

®Registered trademark/TM Trademark of Whirlpool, U.S.A. © 2016 Whirlpool Corporation. All Rights Reserved. All other trademarks are owned by their respective companies.

Because Whirlpool Corporation policy includes a continuous commitment to improve our products, we reserve the right to change materials and specifications without notice. We also reserve the right to discontinue or transition products without notice.

Manufacturer's Suggested Retail Price (MSRP) and Minimum Advertised Price (MAP) provided for reference purposes only. Dealer alone determines advertised and retail prices.

Countertop Edges

* SUITE 218 HAMPTON *

CONNOLLY Marble & Granite Ltd.

EDGE
DETAILS

004


A.



STRAIGHT EDGE
(STANDARD - 3/4")

* MASTER ENSUITE *
* MAIN BATH *.

I.

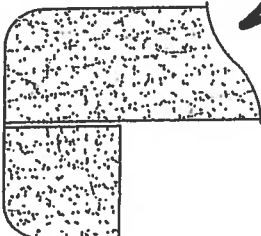

DOUBLE TOP "D" EDGE
(STANDARD - 1 1/2")

* KITCHEN *

JAN 4 2018

Dec.

M.



SQ. EDGE - SQUARE EDGE
(MED./HIGH - 1 1/2")

EDGING UP-GRADE OPTIONS