


Suite 301/302
ORIGINAL LAYOUT.

Inventory Suite

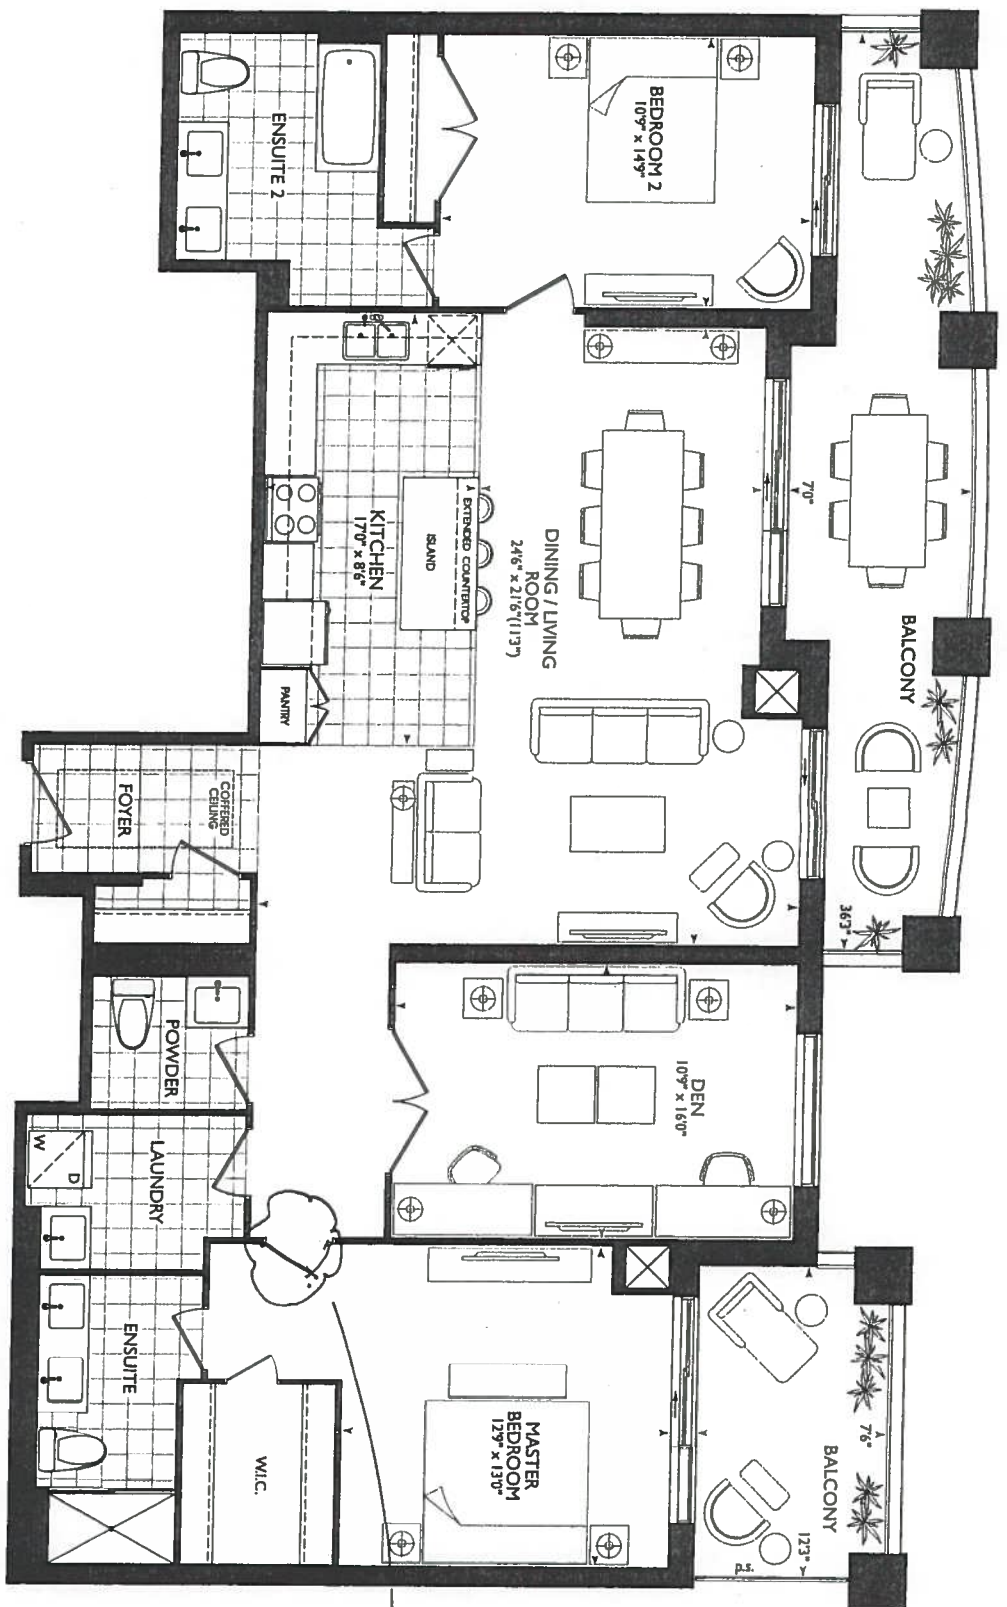


CHANGING SWING

2B+D
1,645 SQ. FT.

LONG ISLAND
301/302

К И Т Е Н .

- OPT. OF STD OR 1ST UPGRADE
- Kitchen CABINETS
- OPT OF STD OR 1ST UPG
- Appliance PKG.
- (P) = 2x PLUGS ISLAND
- 5x: PUCK LIGHTS (STD)
- 6x: PUCK LIGHTS 1ST UPG.

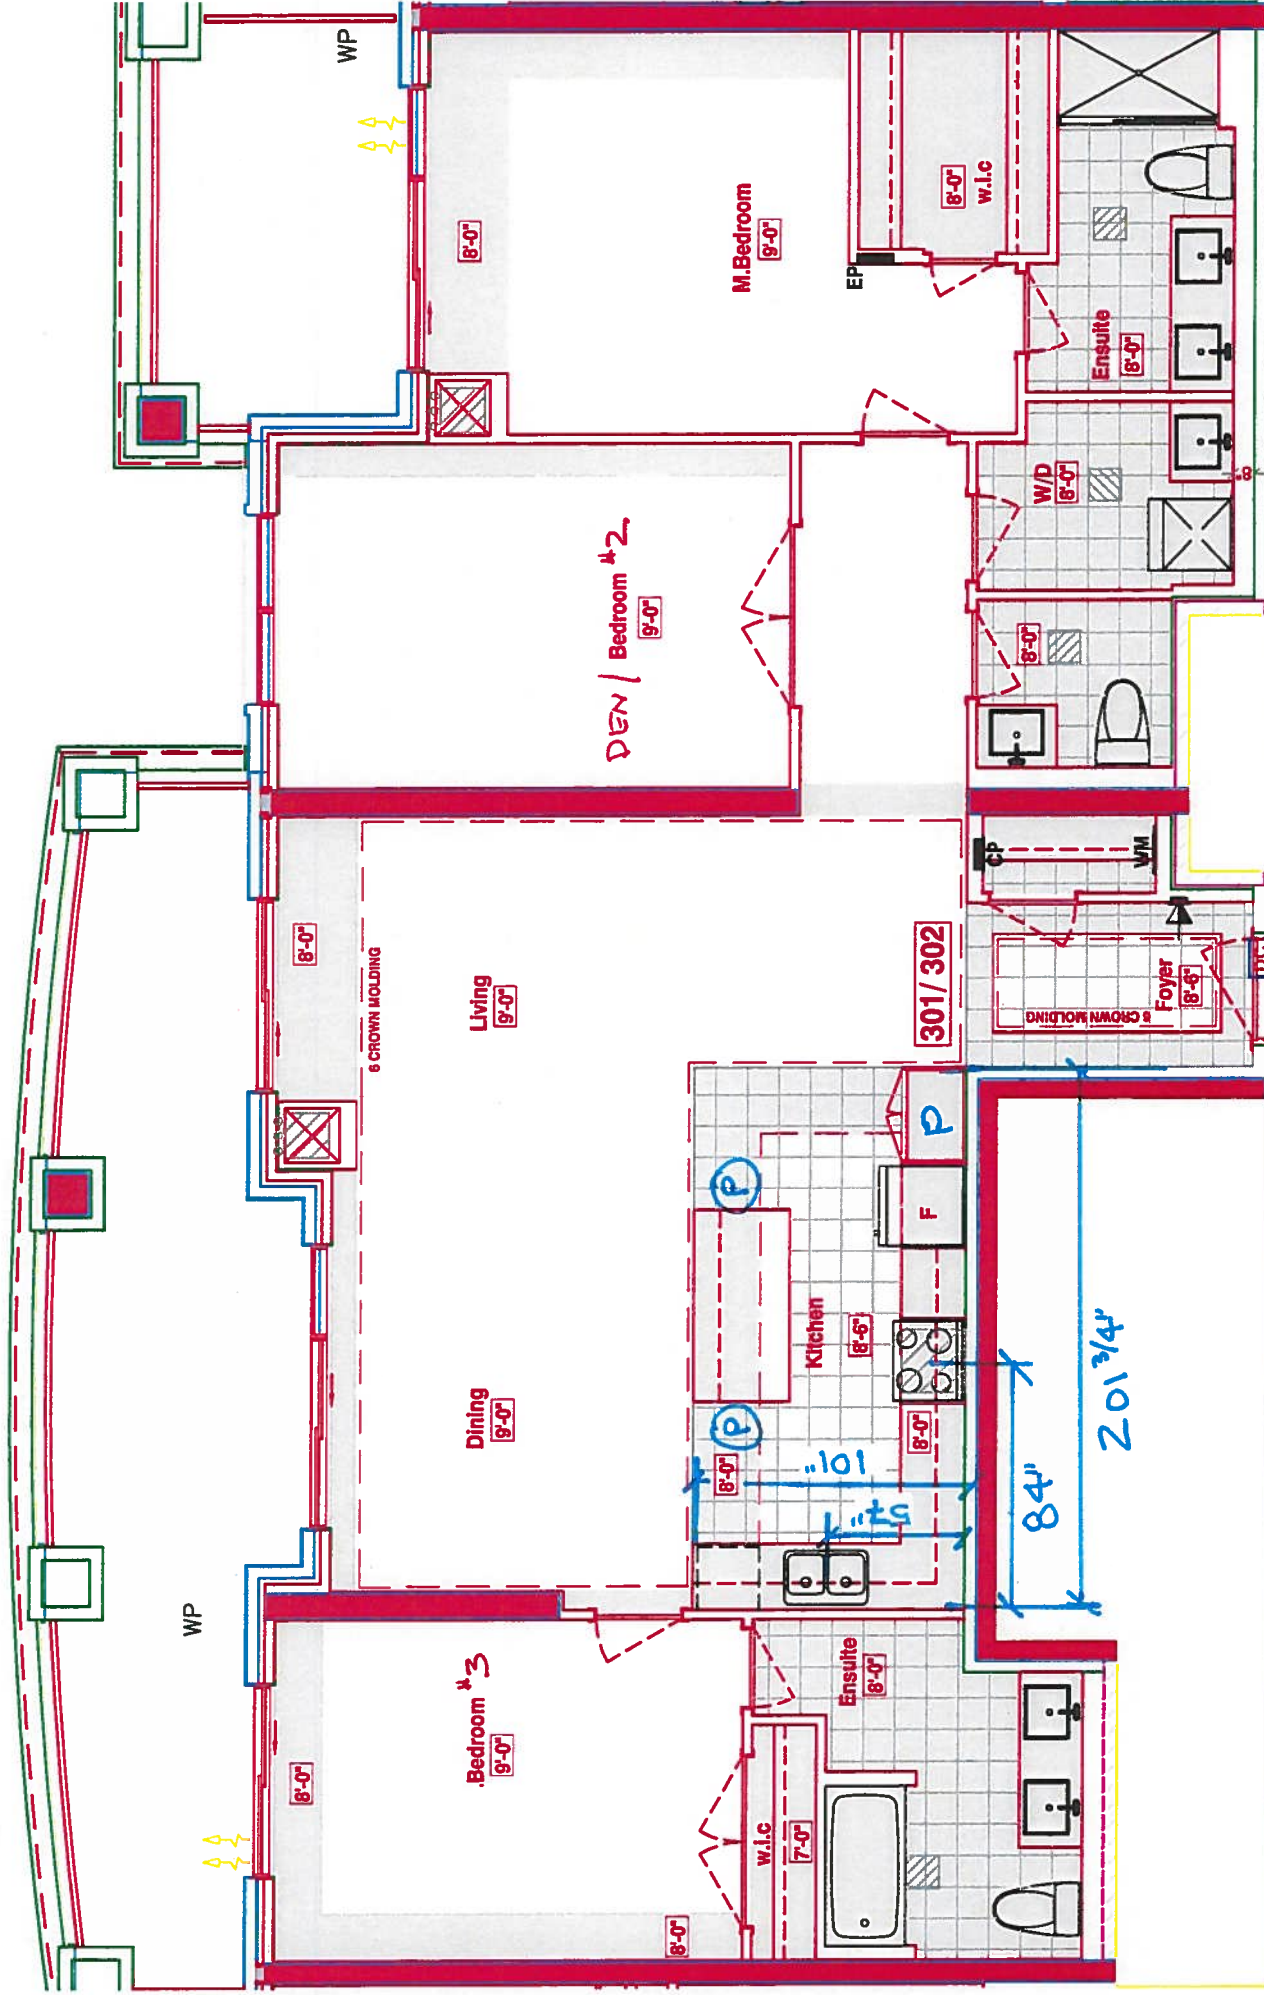

SUITES 301/ 302 - LONG ISLAND


■ Royal Pine Homes ■ 25 Baker Hill Blvd - Stauffville, ON ■ Feb 14, 2018

DRAWING AS PER AGREEMENT OF PURCHASE AND SALE (before decor appointment)

SUITE 301/302


INVENTORY SUITE

- UPG #1- KITCHEN CABINETS
- UPG #1- APPLIANCE PACKAGE
- (P) = 2x PUCKS ISLAND
- 6x = PUCK LIGHTS (5x=STD)

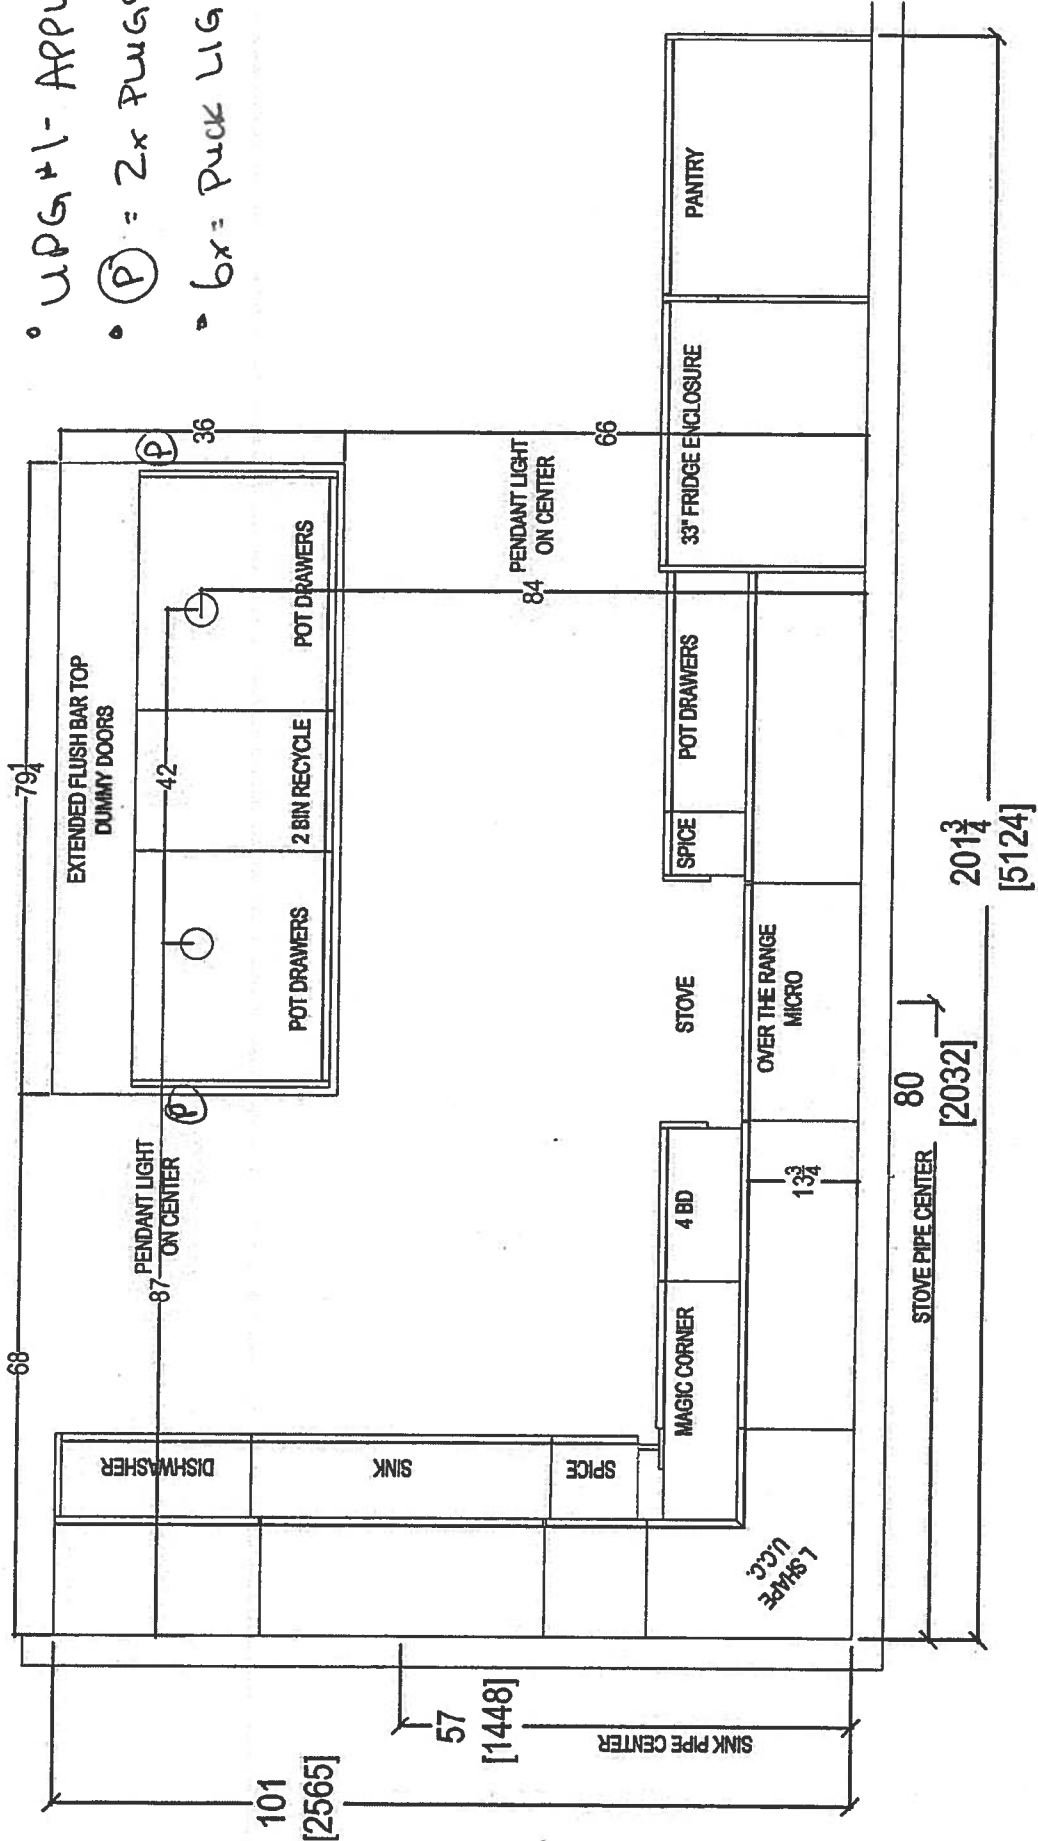

your kitchen, your taste.
80 SANTE DRIVE, VAUGHAN, ON L4K 3C4,
T: 416.746.1811 F: 905.761.5801

CLIENT: ROYAL PINE HOMES		UNIT 301-302 HMP	UPG #1.	ROOM: KITCHEN FLOOR PLAN	DRAWN BY: SK	COMMENTS: PLEASE NOTE ALL DIMENSIONS ARE NOT FINAL AND ARE SUBJECT TO CHANGE UPON FINAL SITE MEASURE	
SITE	HAMPTON PLACE	DOOR STYLE: —		DOOR HANDLE: —	SCALE: 1/2" = 1'-0"		
PHONE: —		FINISH: —		DRW HANDLE: —	DATE: FEB 13, 2018		
EMAIL: —		SPECIES: —		TOP: —	PAGE: —		





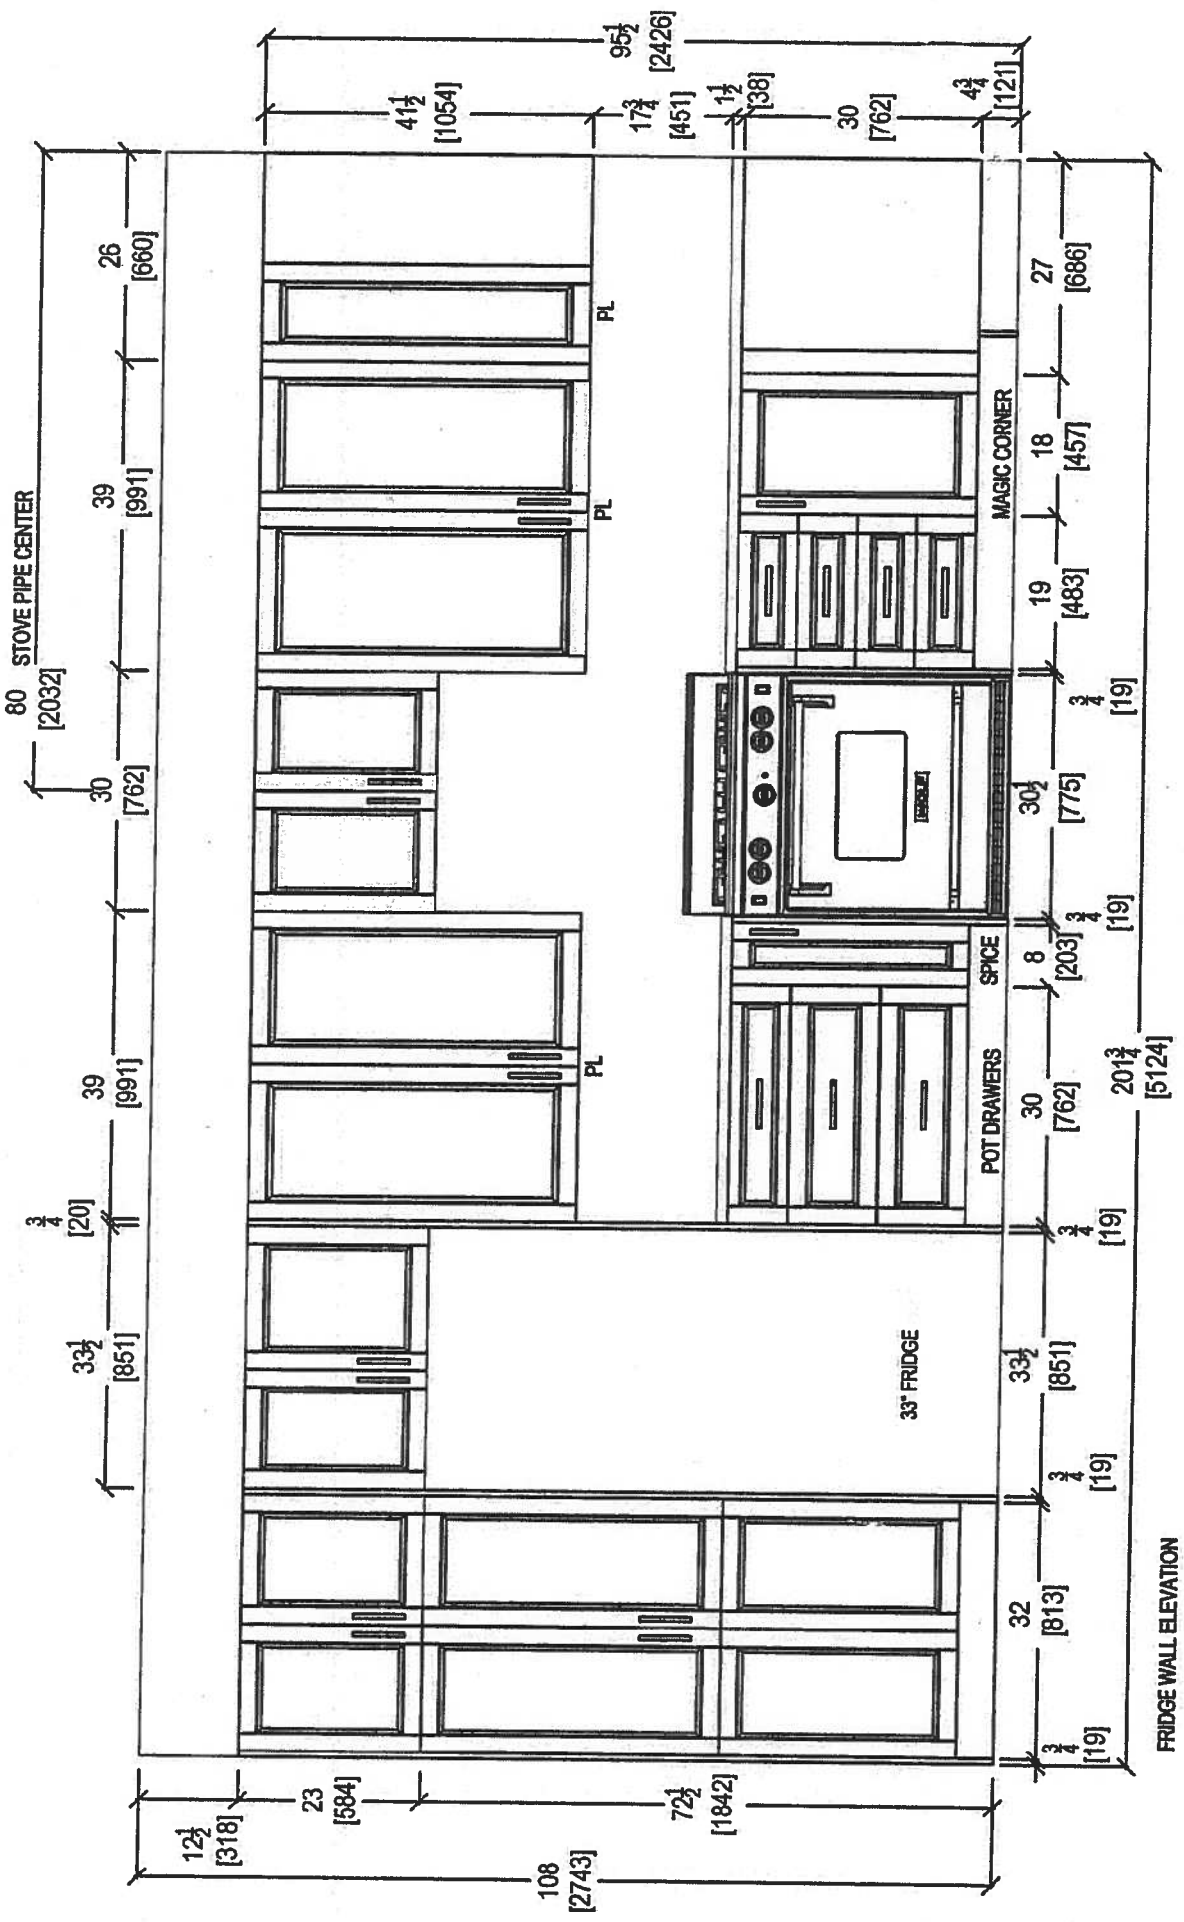


FRIDGE WALL ELEVATION




your kitchen, your taste.
 80 SANTE DRIVE, VAUGHAN, ON L4K 3C4,
 T: 416.746.1811 F: 905.761.5901

CLIENT: ROYAL PINE HOMES		UNIT 301-302 IMP	ROOM: KITCHEN	DRAWN BY: SK	COMMENTS: PLEASE NOTE ALL DIMENSIONS ARE NOT FINAL AND ARE SUBJECT TO CHANGE UPON FINAL SITE MEASURE
SITE: HAMPTON PLACE		DOOR STYLE: —	DOOR HANDLE: —	SCALE: 1/2" = 1'-0"	
PHONE: —		FINISH: —	DRW HANDLE: —	DATE: FEB 13, 2018	
EMAIL: —		SPECIES: —	TOP: —	PAGE: —	

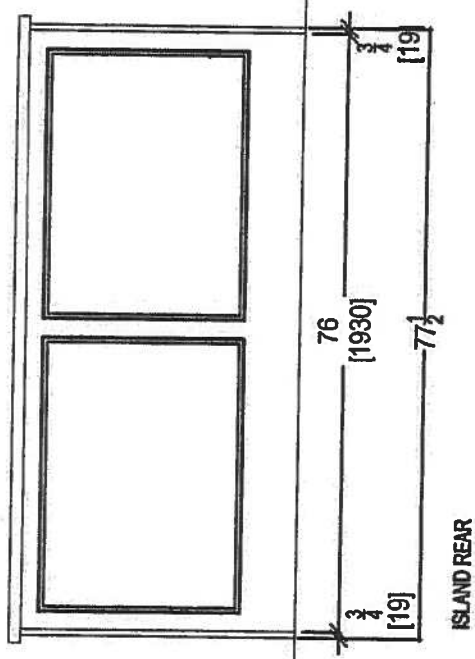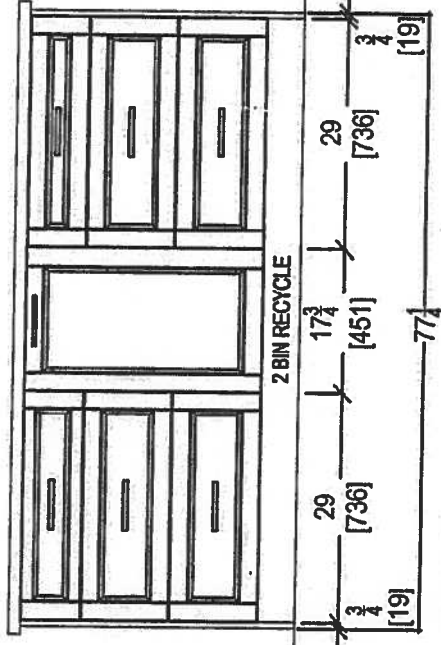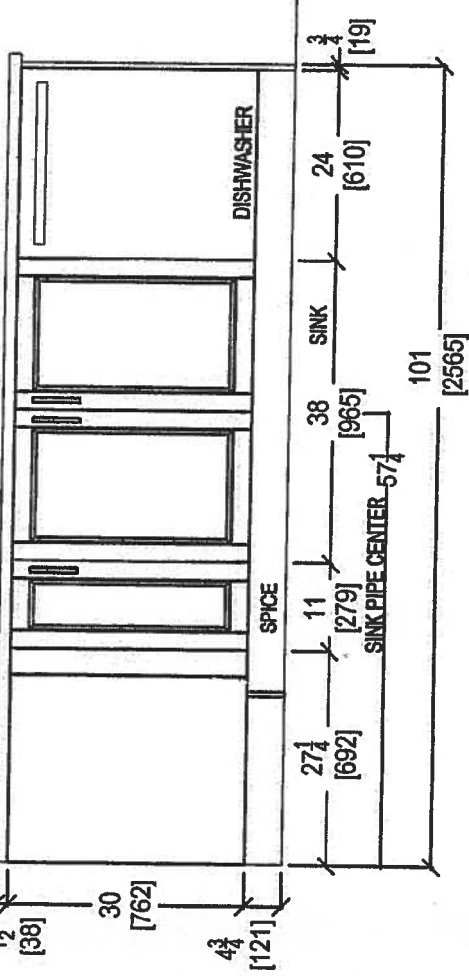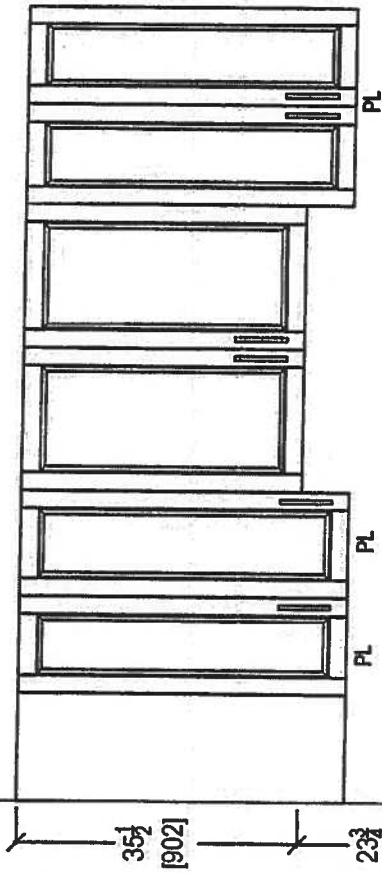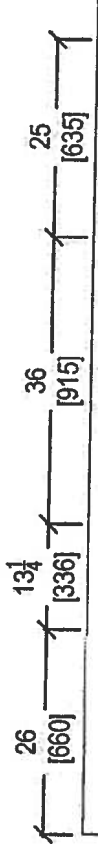


80 SANTE DRIVE, VAUGHAN, ON L4K 3C4,
T: 416.746.1811 F: 906.761.5801


CLIENT: ROYAL PINE HOMES		UNIT 301-302 HMP	ROOM: KITCHEN	DRAWN BY: SK	COMMENTS: PLEASE NOTE ALL DIMENSIONS ARE NOT FINAL AND ARE SUBJECT TO CHANGE UPON FINAL SITE MEASURE
SITE: HAMPTON PLACE	DOOR STYLE: —	DOOR HANDLE: —	SCALE: 1/2" = 1' - 0"		
PHONE: —	FINISH: —	DRW HANDLE: —	DATE: FEB 13, 2018		
EMAIL: —	SPECIES: —	TOP: —	PAGE: —		

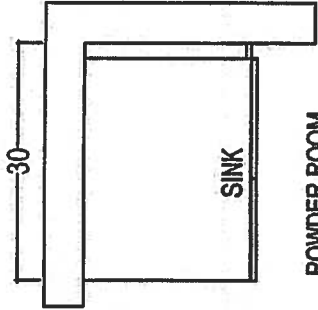


POWDER ROOM

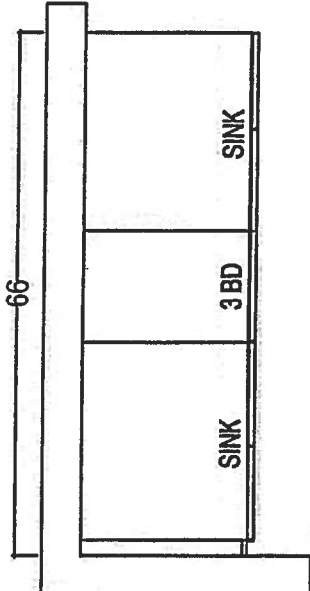





ENSUITE2

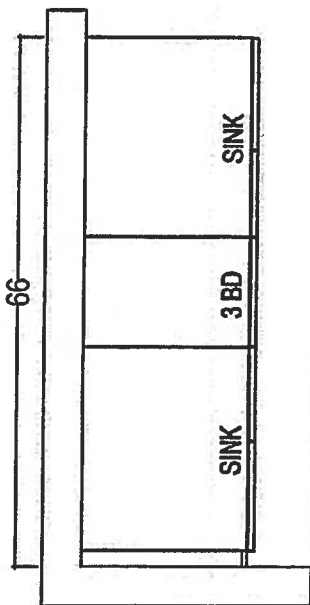

MASTER ENSUITE

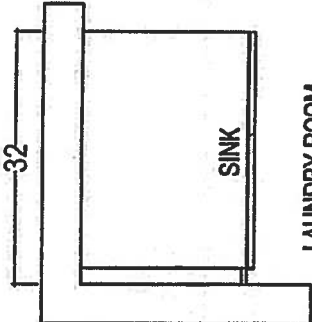

LAUNDRY ROOM

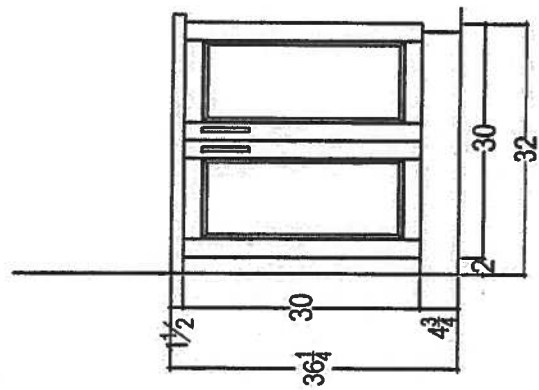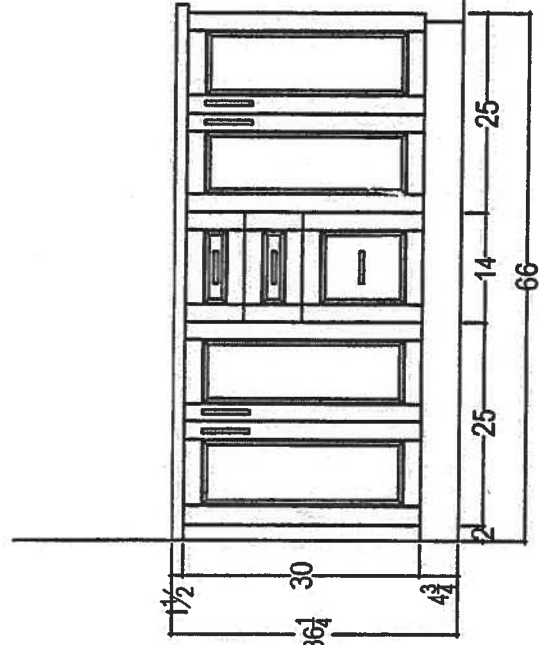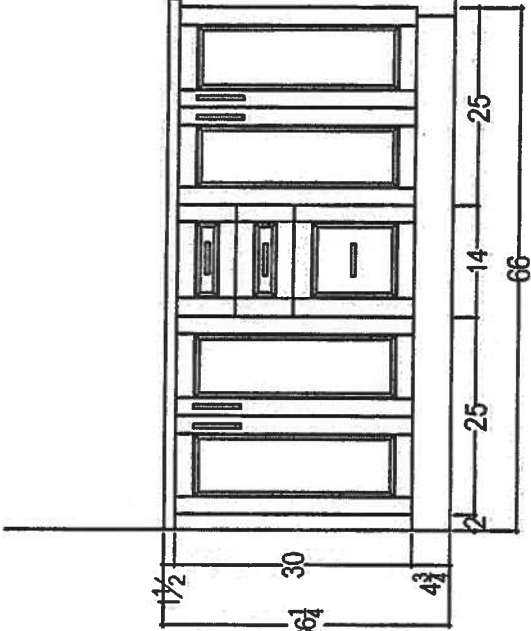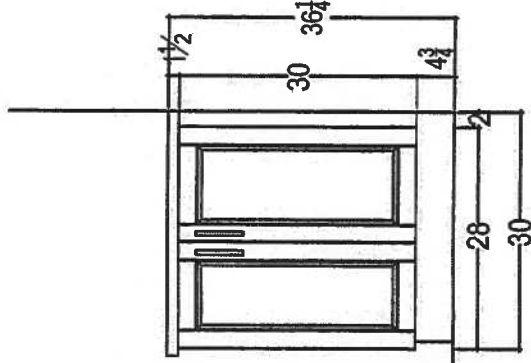


80 SANTE DRIVE, VAUGHAN, ON L4K 3C4,
T: 416.746.1811 F: 905.761.5801

 <i>your kitchen, your taste.</i> 80 SANTE DRIVE, VAUGHAN, ON L4K 3C4, T: 416.748.1811 F: 905.761.5901		CLIENT: ROYAL PINE HOMES		UNIT 301-302 HMP		ROOM:		VANITIES		DRAWN BY: SK		COMMENTS: PLEASE NOTE ALL DIMENSIONS ARE NOT FINAL AND ARE SUBJECT TO CHANGE UPON FINAL SITE MEASURE
SITE		HAMPTON PLACE		DOOR STYLE: —		DOOR HANDLE: —		SCALE: 1/2" = 1' - 0"				
PHONE: —		—		FINISH: —		DRW HANDLE: —		DATE: FEB 13, 2018				
EMAIL: —		—		SPECIES: —		TOP: —		PAGE: —				

Suite 301/302

Inventory Suite

- STD Kitchen Cabinet
- STD APPLIANCE PACKAGE
- (P) = 2x PLUGS ISLAND
- 5x = PUCK LIGHTS

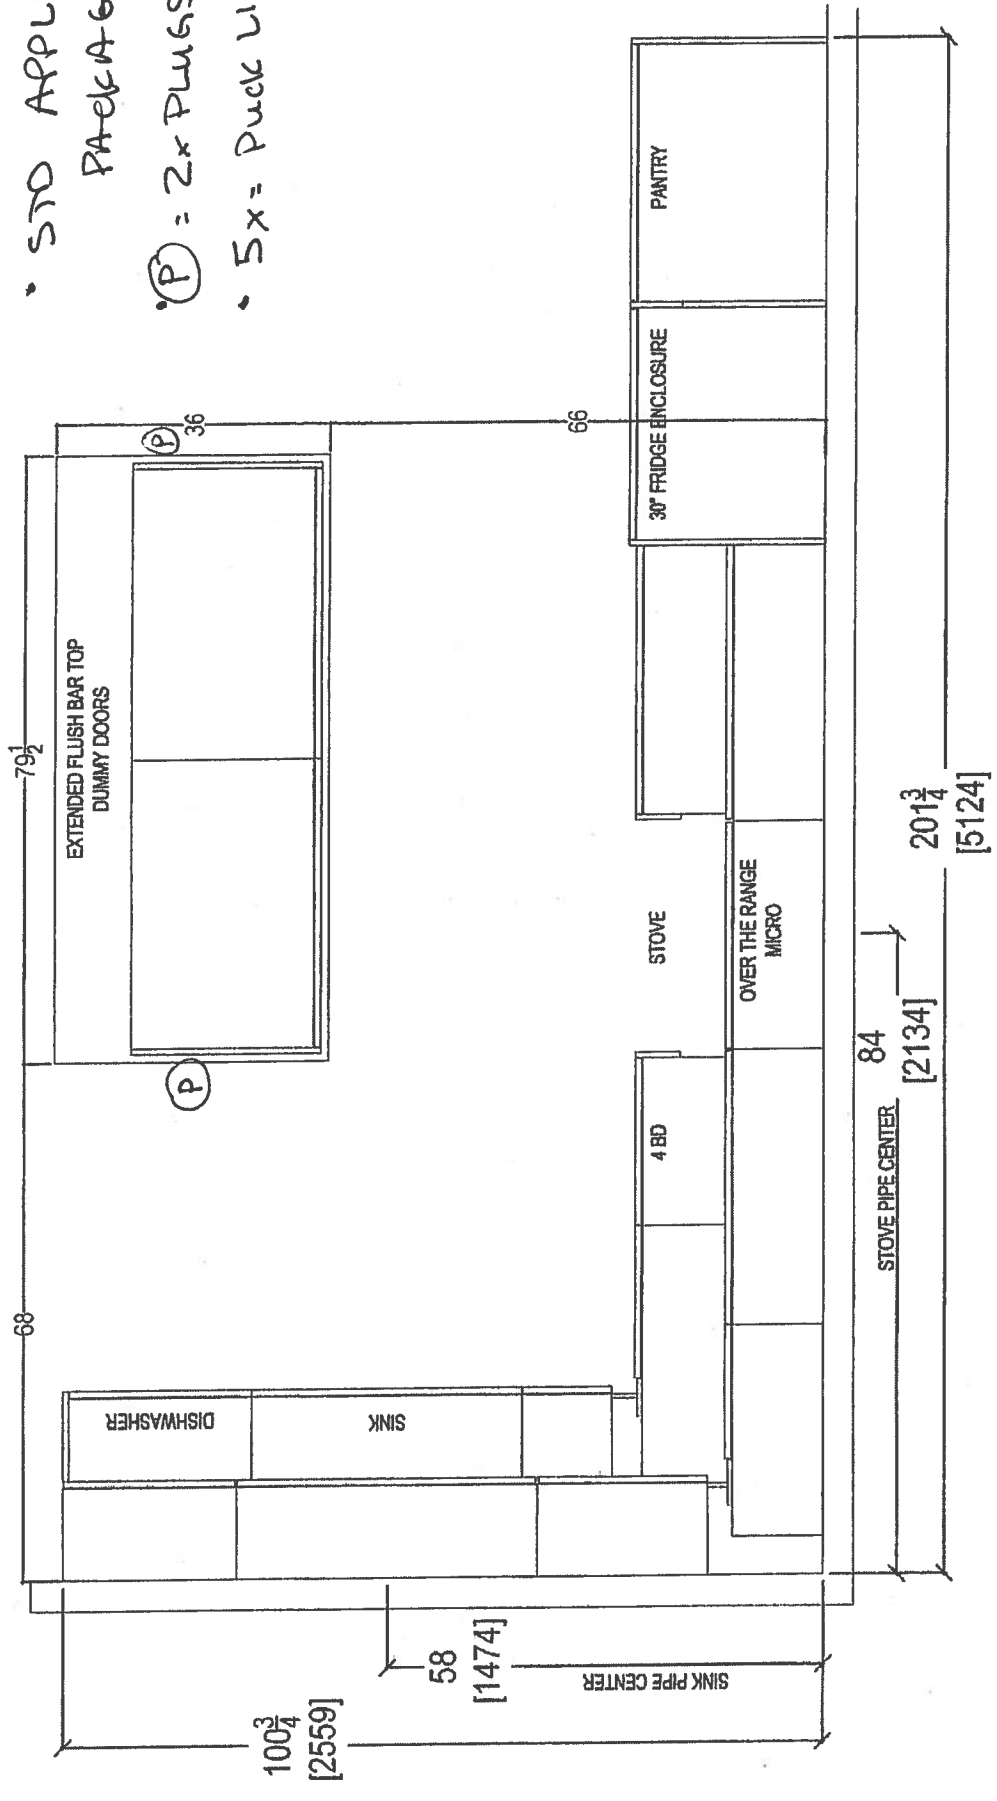

RECEIVED
10.10.17

Suite 301/302 STD

 your kitchen your style 80 SANTE DRIVE, VAUGHAN, ON L4K 3C4, T: 416.746.1811 F: 905.761.5901		CLIENT: ROYAL PINE HOMES	2B+D LONG ISLAND	ROOM: KITCHEN FLOOR PLAN	DRAWN BY: SK	COMMENTS: PLEASE NOTE ALL DIMENSIONS ARE NOT FINAL AND ARE SUBJECT TO CHANGE UPON FINAL SITE MEASURE
SITE: HAMPTON PLACE	DOOR STYLE: —	DOOR HANDLE: —	SCALE: 1/2" = 1' - 0"			
PHONE: —	FINISH: —	DRW HANDLE: —	DATE: AUG 4, 2017			
EMAIL: —	SPECIES: —	TOP: —	PAGE: —			



your kitchen. your life.
80 SANTE DRIVE, VAUGHAN, ON L4K 3C4,
T: 416.746.1811 F: 905.761.5901



QTK
Barbecued Pork



SANTITAS

your kitchen, your taste



80 SANTA FE AVENUE, SANTA FE, NM 87501

your kitchen. your taste.
80 SANTE DRIVE, VAUGHAN, ON L4K 3C4;
T: 416.746.1811 F: 905.781.5901



CLIENT: ROYAL PINE HOMES	2B+D LONG ISLAND			ROOM:	KITCHEN	DRAWN BY: SK	COMMENTS: PLEASE NOTE ALL DIMENSIONS ARE NOT FINAL AND ARE SUBJECT TO CHANGE UPON FINAL SITE MEASURE
SITE: HAMPTON PLACE	DOOR STYLE:	—		DOOR HANDLE:	12" x 1" - 0"		
PHONE: —	FINISH:	—		DRW HANDLE:	—		
EMAIL: —	SPECIES:	—		TOP:	—		

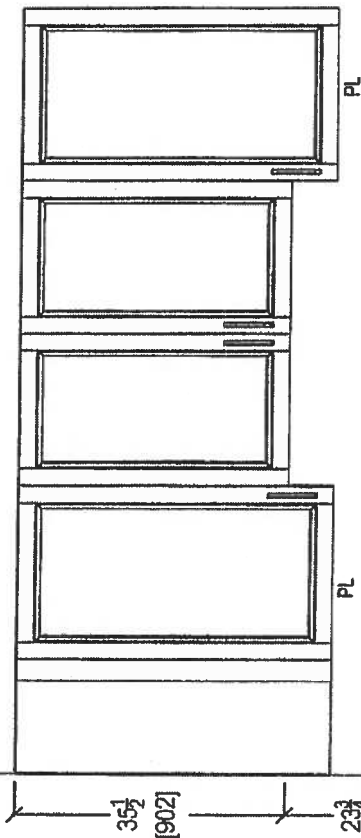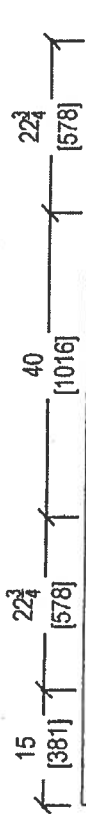



SINK PIPE CENTER 58

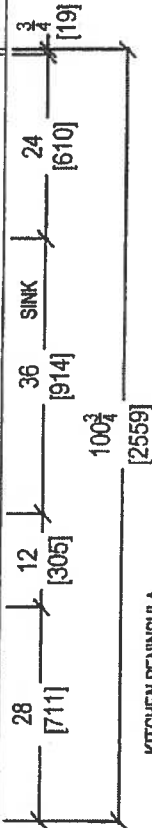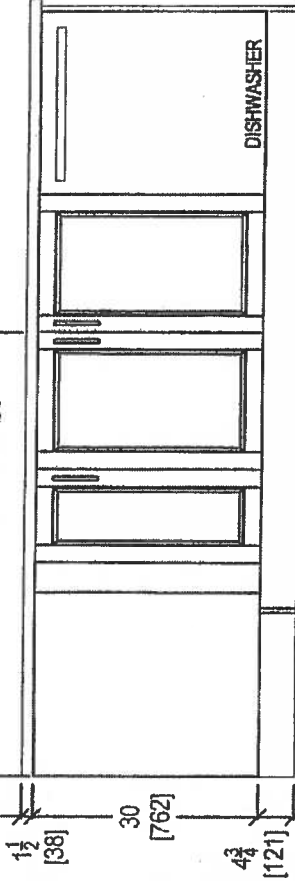

KITCHEN PENINSULA
ELEVATION
FRONT VIEW

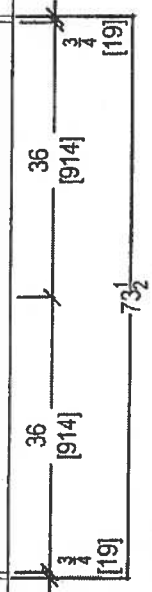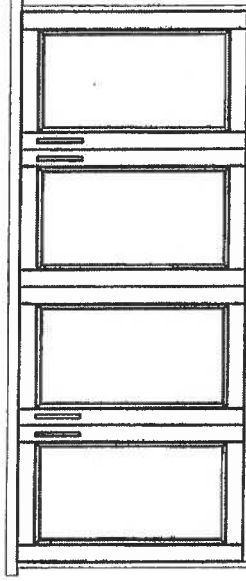

ISLAND FRONT

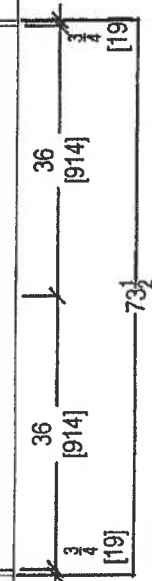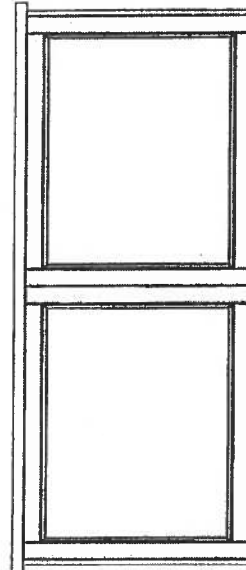







ISLAND REAR

RECEIVED
inca 1017

 <i>your kitchen. your taste.</i> 80 SANTE DRIVE, VAUGHAN, ON L4K 3C4, T: 416.746.1811 F: 905.761.5901				CLIENT: ROYAL PINE HOMES		2B+D LONG ISLAND		ROOM: KITCHEN	DRAWN BY: SK		COMMENTS: PLEASE NOTE ALL DIMENSIONS ARE NOT FINAL AND ARE SUBJECT TO CHANGE UPON FINAL SITE MEASURE
SITE: HAMPTON PLACE		DOOR STYLE: —		DOOR HANDLE: —		SCALE: 1/2" = 1' - 0"					
PHONE: —		FINISH: —		DRW HANDLE: —		DATE: AUG 4, 2017					
EMAIL: —		SPECIES: —		TOP: —		PAGE: —					



80 SANTE DRIVE, VAUGHAN, ON L4K 3C4,
T: 416.746.1811 F: 905.781.5901

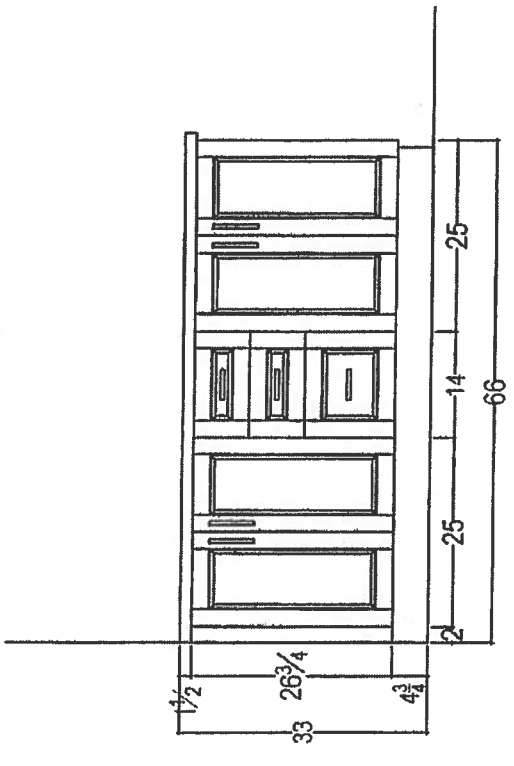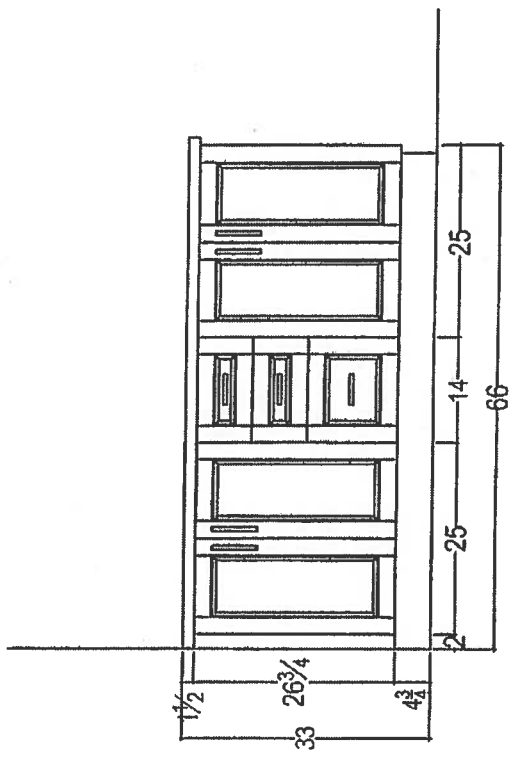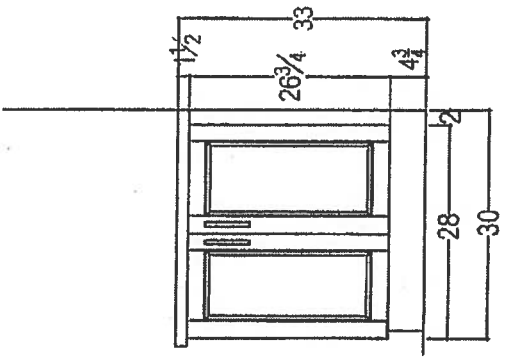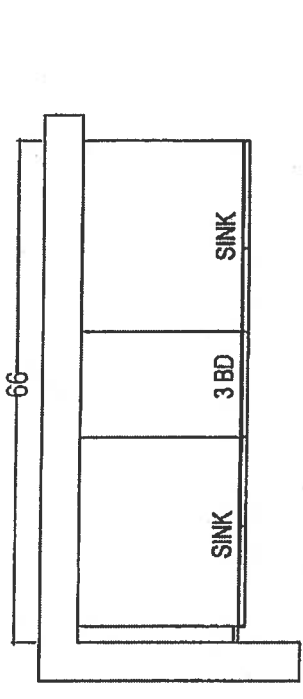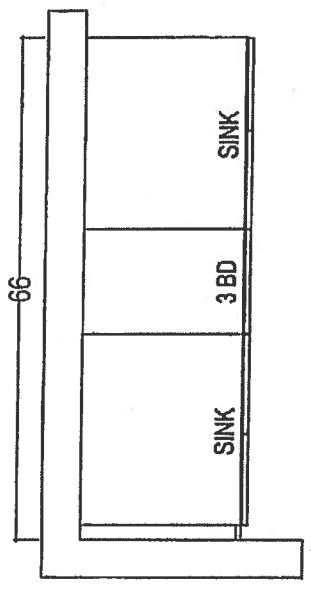
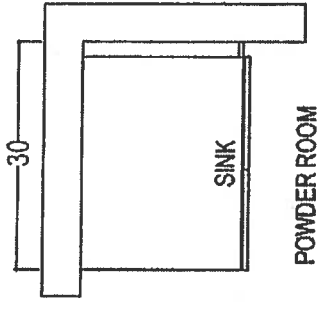


80 SANTE DRIVE, VAUGHAN, ON L4K 3C4.
T: 416.748.1811 F: 905.761.5801

2B+D LONG ISLAND

CLIENT: ROYAL PINE HOMES	ROOM:	DRAWN BY: SK	COMMENTS: PLEASE NOTE ALL DIMENSIONS ARE NOT FINAL AND ARE SUBJECT TO CHANGE UPON FINAL SITE MEASURE
SITE: HAMPTON PLACE	DOOR HANDLE: —	SCALE: 1/2" = 1' - 0"	
PHONE: —	DRW HANDLE: —	DATE: AUG 4, 2017	
EMAIL: —	TOP: —	PAGE: —	

RECEIVED
ROYAL PINE HOMES

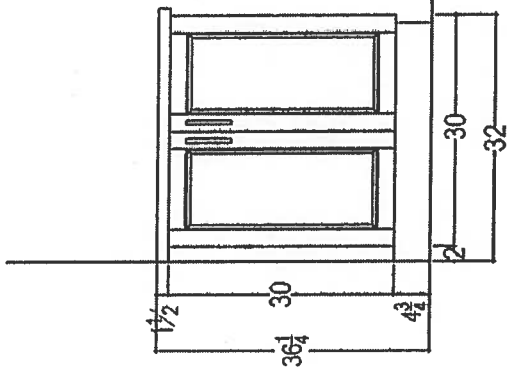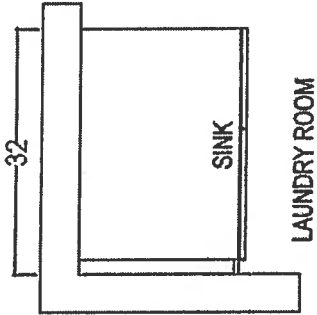

RECEIVED
Received

 your kitchen, your table. 80 SANTE DRIVE, VAUGHAN, ON L4K 3C4, T: 416.748.1811 F: 905.761.5901	CLIENT: ROYAL PINE HOMES		2B+D LONG ISLAND		ROOM: LAUNDRY	DRAWN BY: SK	COMMENTS: PLEASE NOTE ALL DIMENSIONS ARE NOT FINAL AND ARE SUBJECT TO CHANGE UPON FINAL SITE MEASURE
	SITE: HAMPTON PLACE		DOOR STYLE: —		DOOR HANDLE: —	SCALE: 1/2" = 1' - 0"	
	PHONE: —		FINISH: —		DRW HANDLE: —	DATE: AUG 4, 2017	
	EMAIL: —		SPECIES: —		TOP: —	PAGE: —	