



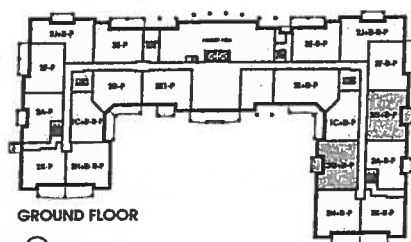


Noyac Bay

1,121 SQ FT *plus 81 sq. ft. of balcony area*


#307
ORIGINAL
LAYOUT
INVENTORY
SUITE

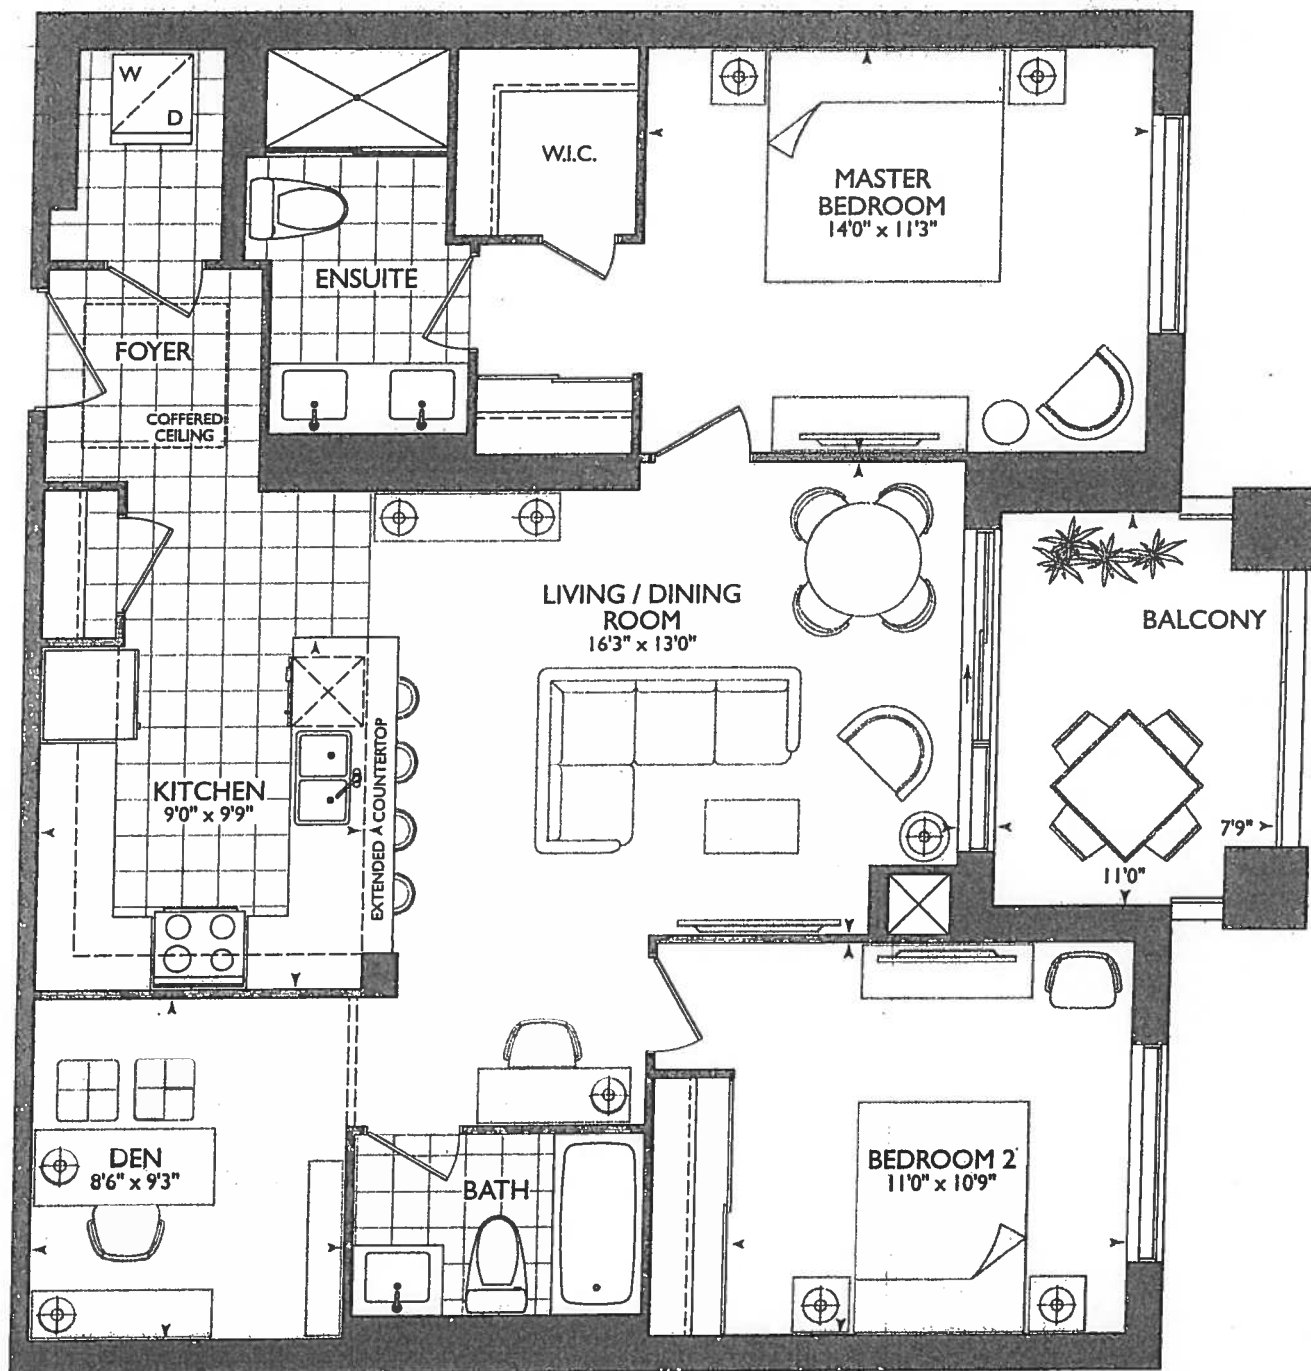

GROUND FLOOR

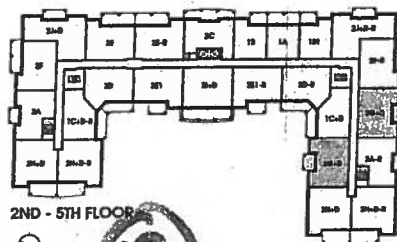

2ND - 5TH FLOOR

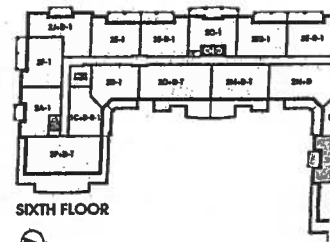

SIXTH FLOOR

NOYAC BAY: 307

- ENSUITE WALL REVISED AS PER ARCHITECTURE DRAWINGS
- LAUNDRY DOOR SWING TO OPEN AGAINST THE ENSUITE WALL




KITCHEN

- CHOICE OF STD KITCHEN LAYOUT w/ STD APPLIANCE PACKAGE
OR
- OPT UPG#1-KITCHEN LAYOUT WITH UPGRADE #1 APPLIANCE PACKAGE
(see separate layouts)

(2x6 wall behind w/d)

- #307 - INVENTORY SUITE
- *REVISED LAUNDRY DOOR SWING, AS PER THIS BROCHURE
- *REVISED ENSUITE WALL AS PER THIS BROCHURE.

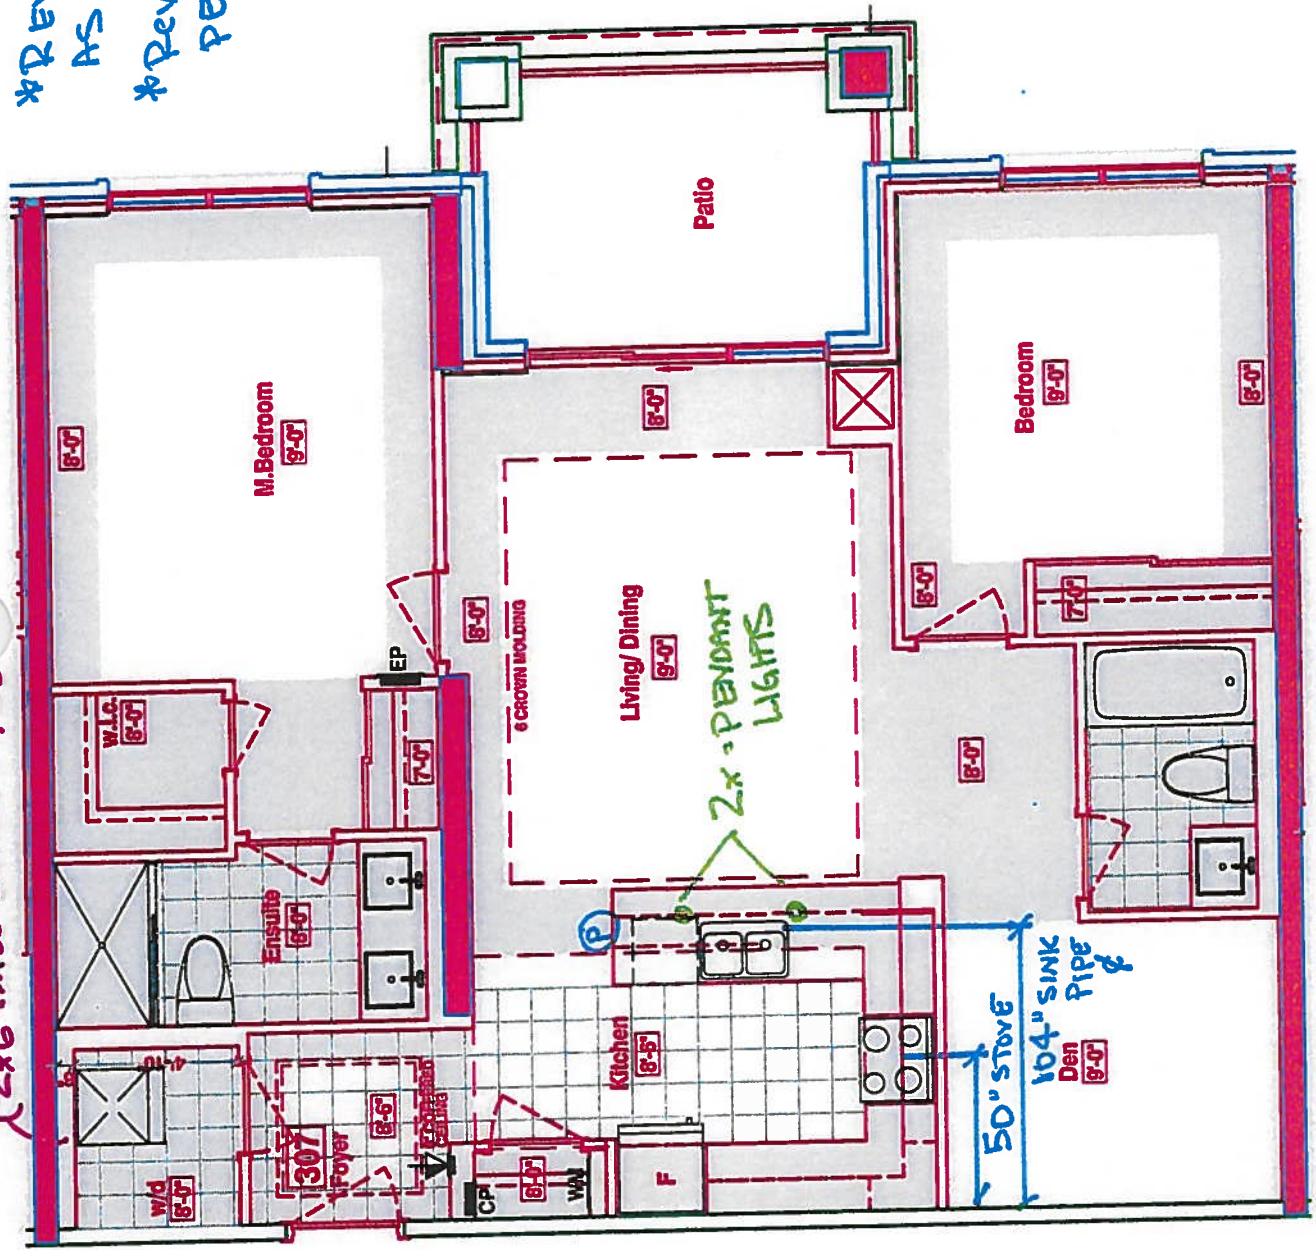

6" WALL BEHIND W/D

ELIMINATE JOG AT FRIDGE WALL

LEGEND:

SECURITY PANEL

EP

CP

WM

F

DROPPED AREA

6" CROWN MOLDING

ELECTRICAL PANEL


COMMUNICATION PANEL

WATER METER

FRIDGE

Suite #307

- STD KITCHEN LAYOUT
- STD APPLIANCE PACKAGE
- (P) = PLUG PENINSULA.
- 2x = PENDANT LIGHTS OVER PENINSULA (upg)
- 4x = PUCK LIGHTS

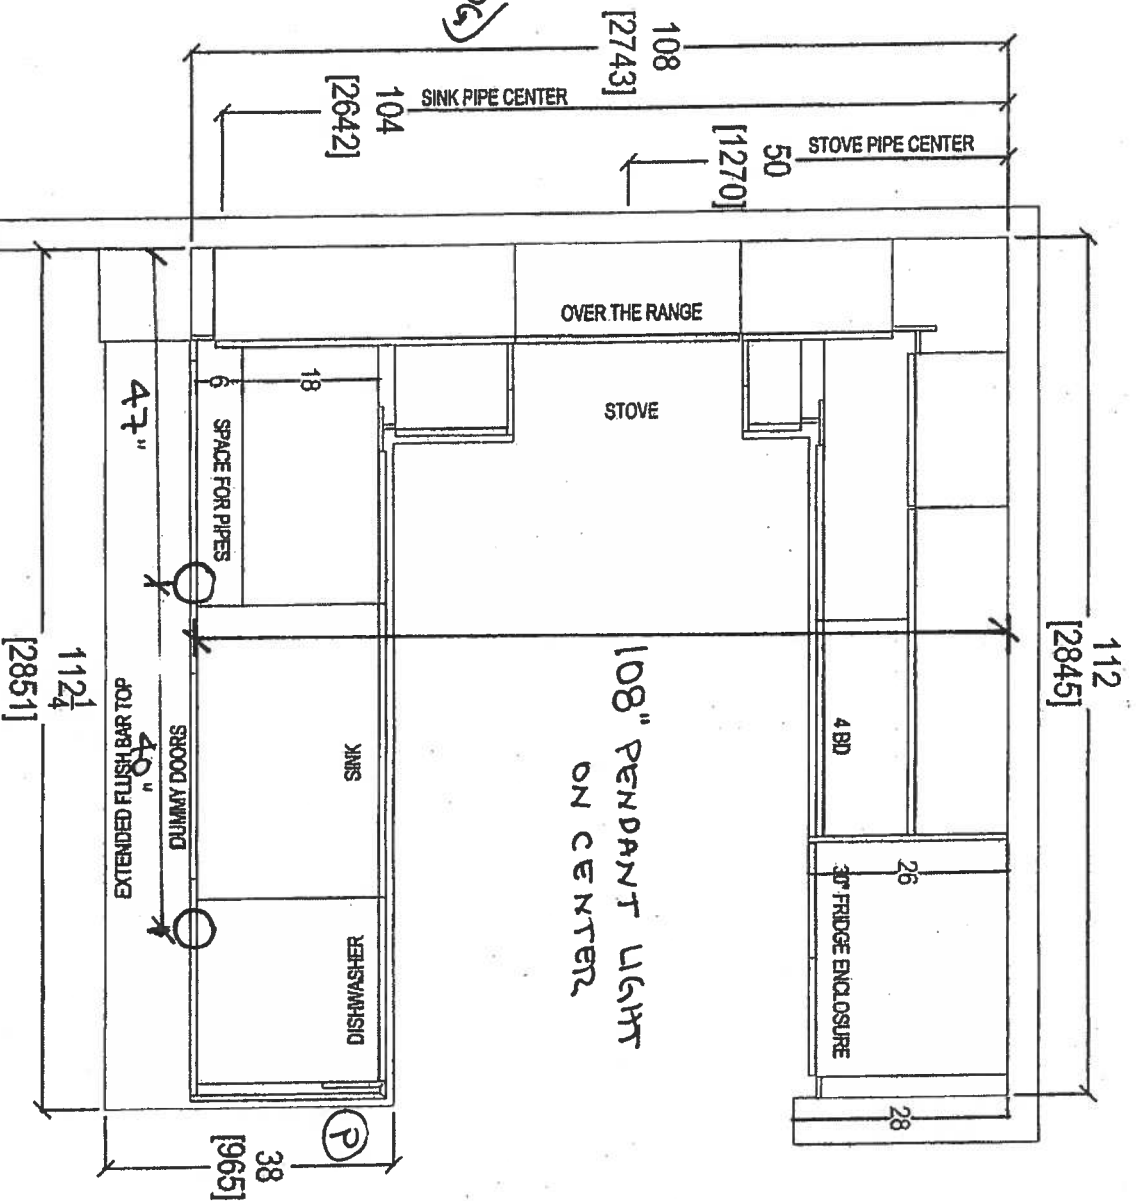

RECEIVED
NOV 17 2017

CLIENT: ROYAL PINE HOMES

JOB NAME: 2G+ D

ROOM: KITCHEN FLOOR PLAN

DRAWN BY: SK

SITE: HAMPTON PLACE

DOOR STYLE: —

DOOR HANDLE: —

SCALE: 1/2" = 1'-0"

PHONE: —

FINISH: —

DRW HANDLE: —

DATE: AUG 4, 2017

EMAIL: —

SPECIES: —


TOP: —

PAGE: —


COMMENTS:
PLEASE NOTE ALL DIMENSIONS
ARE NOT FINAL AND ARE
SUBJECT TO CHANGE UPON
FINAL SITE MEASURE




your kitchen, your life
80 SANTE DRIVE, VAUGHAN, ONTARIO L4K 3C4,
T: 416.748.1811 F: 905.748.1811

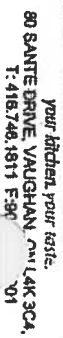

**KITCHEN PENINSULA ELEVATION
FRONT VIEW**

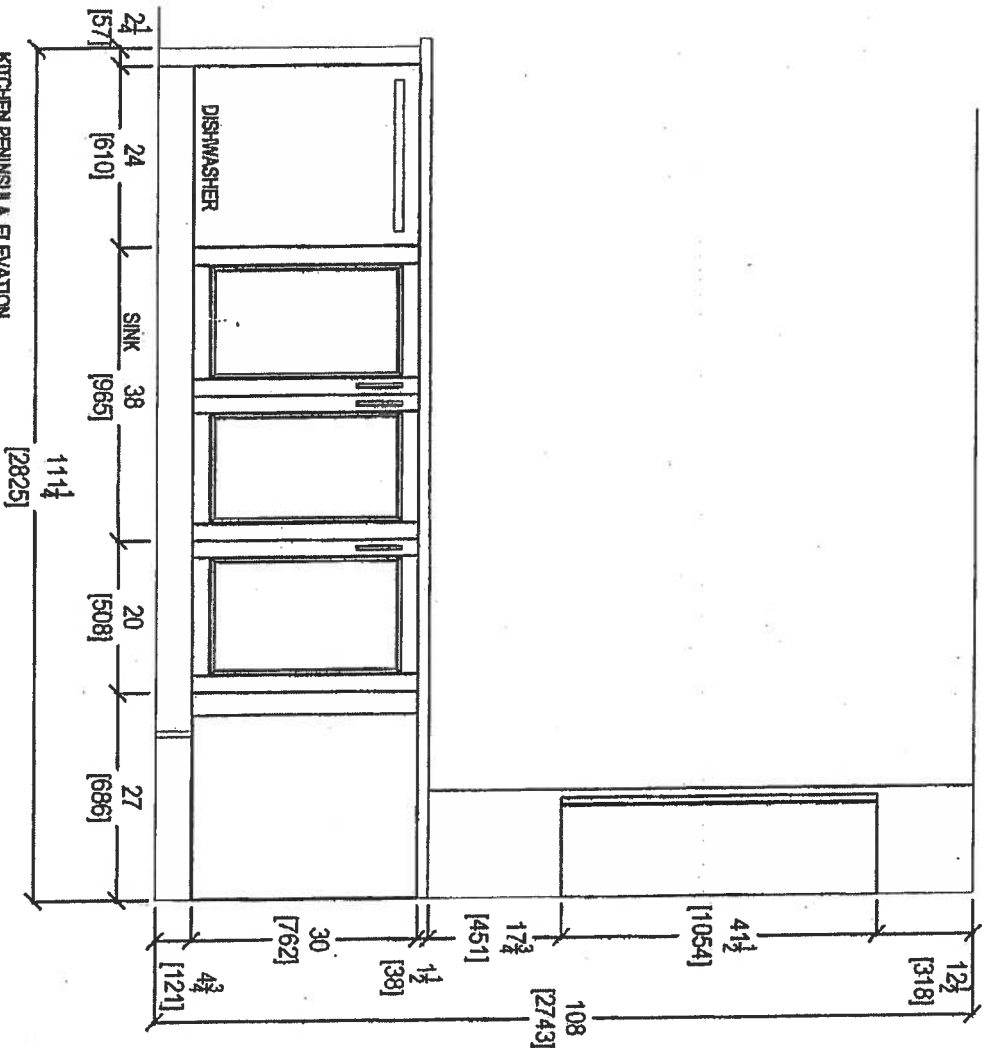

**KITCHEN PENINSULA ELEVATION
REAR VIEW**

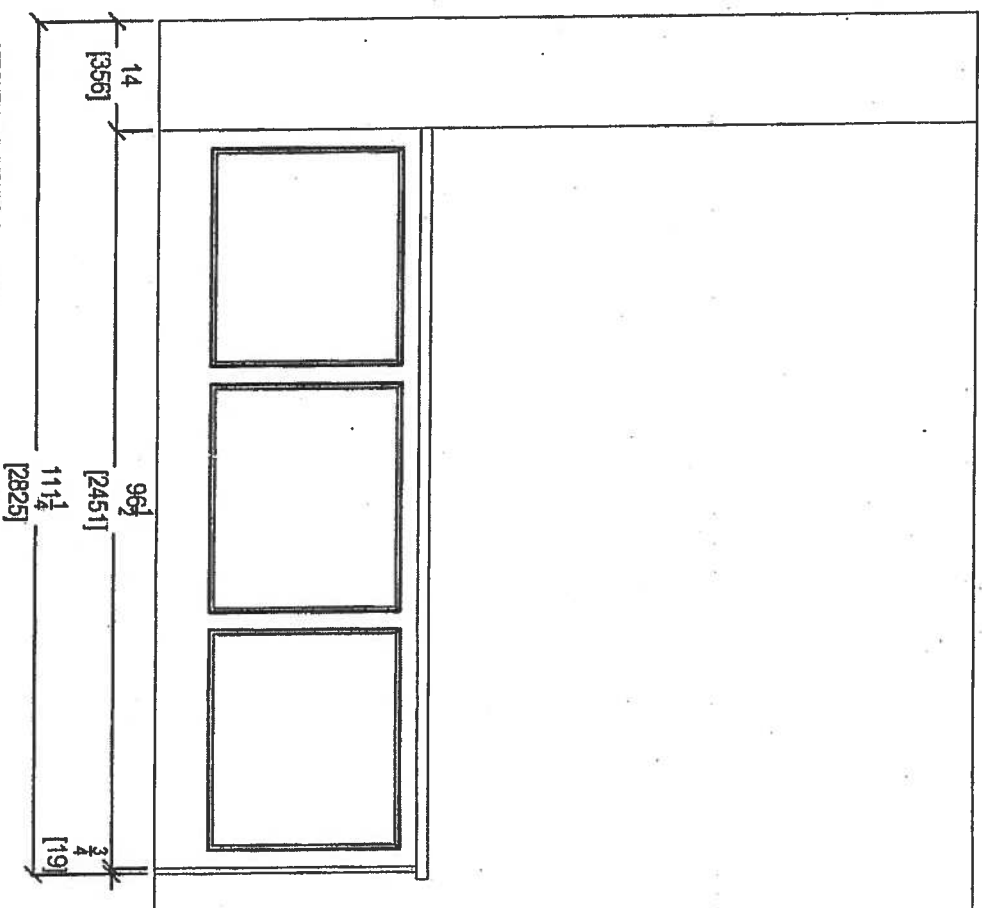

RECEIVED
NOV 6 1977

CLIENT: ROYAL PINE HOMES

JOB NAME: 2G+D

ROOM: KITCHEN

DRAWN BY: SK

COMMENTS:

SITE: HAMPTON PLACE

DOOR STYLE: _____

DOOR HANDLE: _____

SCALE: 1/2" = 1'-0"

PLEASE NOTE ALL DIFFERENCES

PHONE _____

FINISH:

DRAW HANDLE:

DATE: AUG 4 2007

ARE NOT FINAL AND ARE
SUBJECT TO CHANGE UPON


EMAIL: _____

SPECIES: _____


TOP:

PAGE: '



FINAL SITE MEASURE

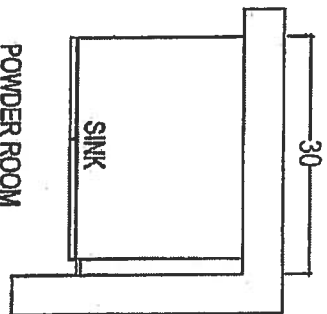

POWDER ROOM

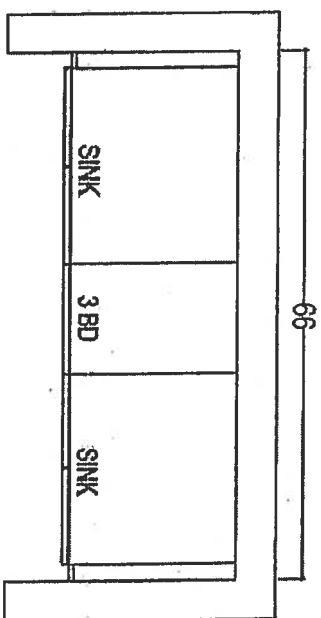

MASTER ENSUITE

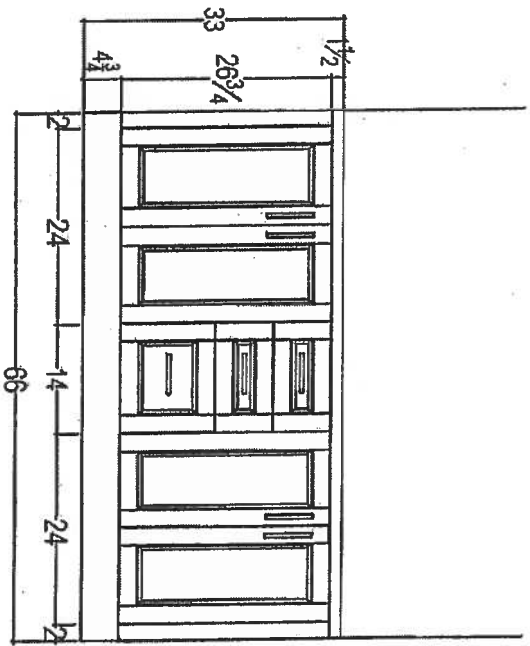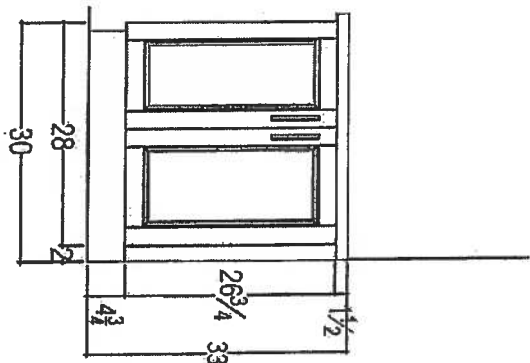


RECEIVED
11-20-18

 your hidden, your hidden 80 SANTE DRIVE, VAUGHAN T: 416.746.1811 F: 905 3CA		CLIENT: ROYAL PINE HOMES SITE: HAMPTON PLACE PHONE: — EMAIL: —	JOB NAME: 2G+ D DOOR STYLE: — FINISH: — SPECIES: —	ROOM: VANITIES DOOR HANDLE: — DRW HANDLE: — TOP: —	DRAWN BY: SK SCALE: 1/2" = 1'-0" DATE: AUG 4, 2017 PAGE: —	COMMENTS: PLEASE NOTE ALL DIMENSIONS ARE NOT FINAL AND ARE SUBJECT TO CHANGE UPON FINAL SITE MEASURE
--	--	---	---	---	---	--


Suite 307
 • OPTIONAL UPG#1- Kitchen
 Layout with UPG#1-
 APPLIANCE PACKAGE

- (P) = Plug Perin Suit.
- 6x = Puck Lights (5x is 4x)
- 2x = Pendant Lights
 over Perin Suit (UPG)

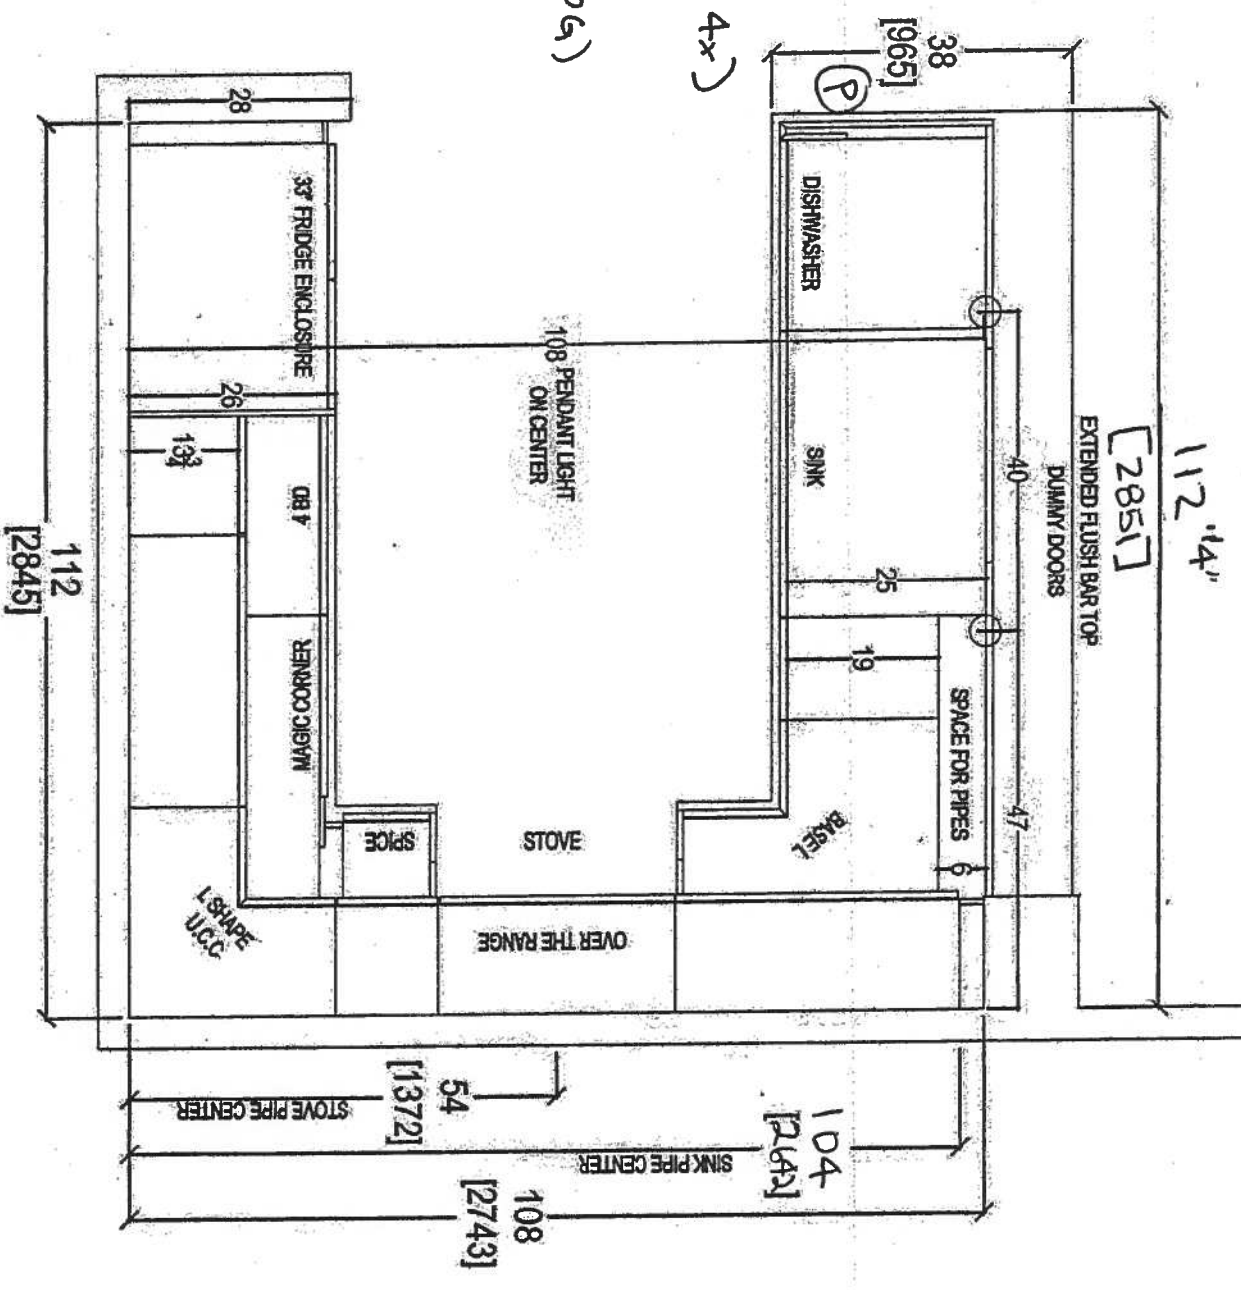

CLIENT: ROYAL PINE HOMES	JOB NAME: UNIT 307 MAP	ROOM: KITCHEN FLOOR PLAN	DRAWN BY: SK	COMMENTS:
SITE: HAMPTON PLACE	DOOR STYLE: —	DOOR HANDLE: —	SCALE: 1/2" = 1'-0"	PLEASE NOTE ALL DIMENSIONS ARE NOT FINAL AND ARE SUBJECT TO CHANGE UPON FINAL SITE MEASURE
PHONE: —	FINISH: —	DRY HANDLE: —	DATE: FEB 13, 2018	
EMAIL: —	SPECIES: —	TOP: —	PAGE: —	



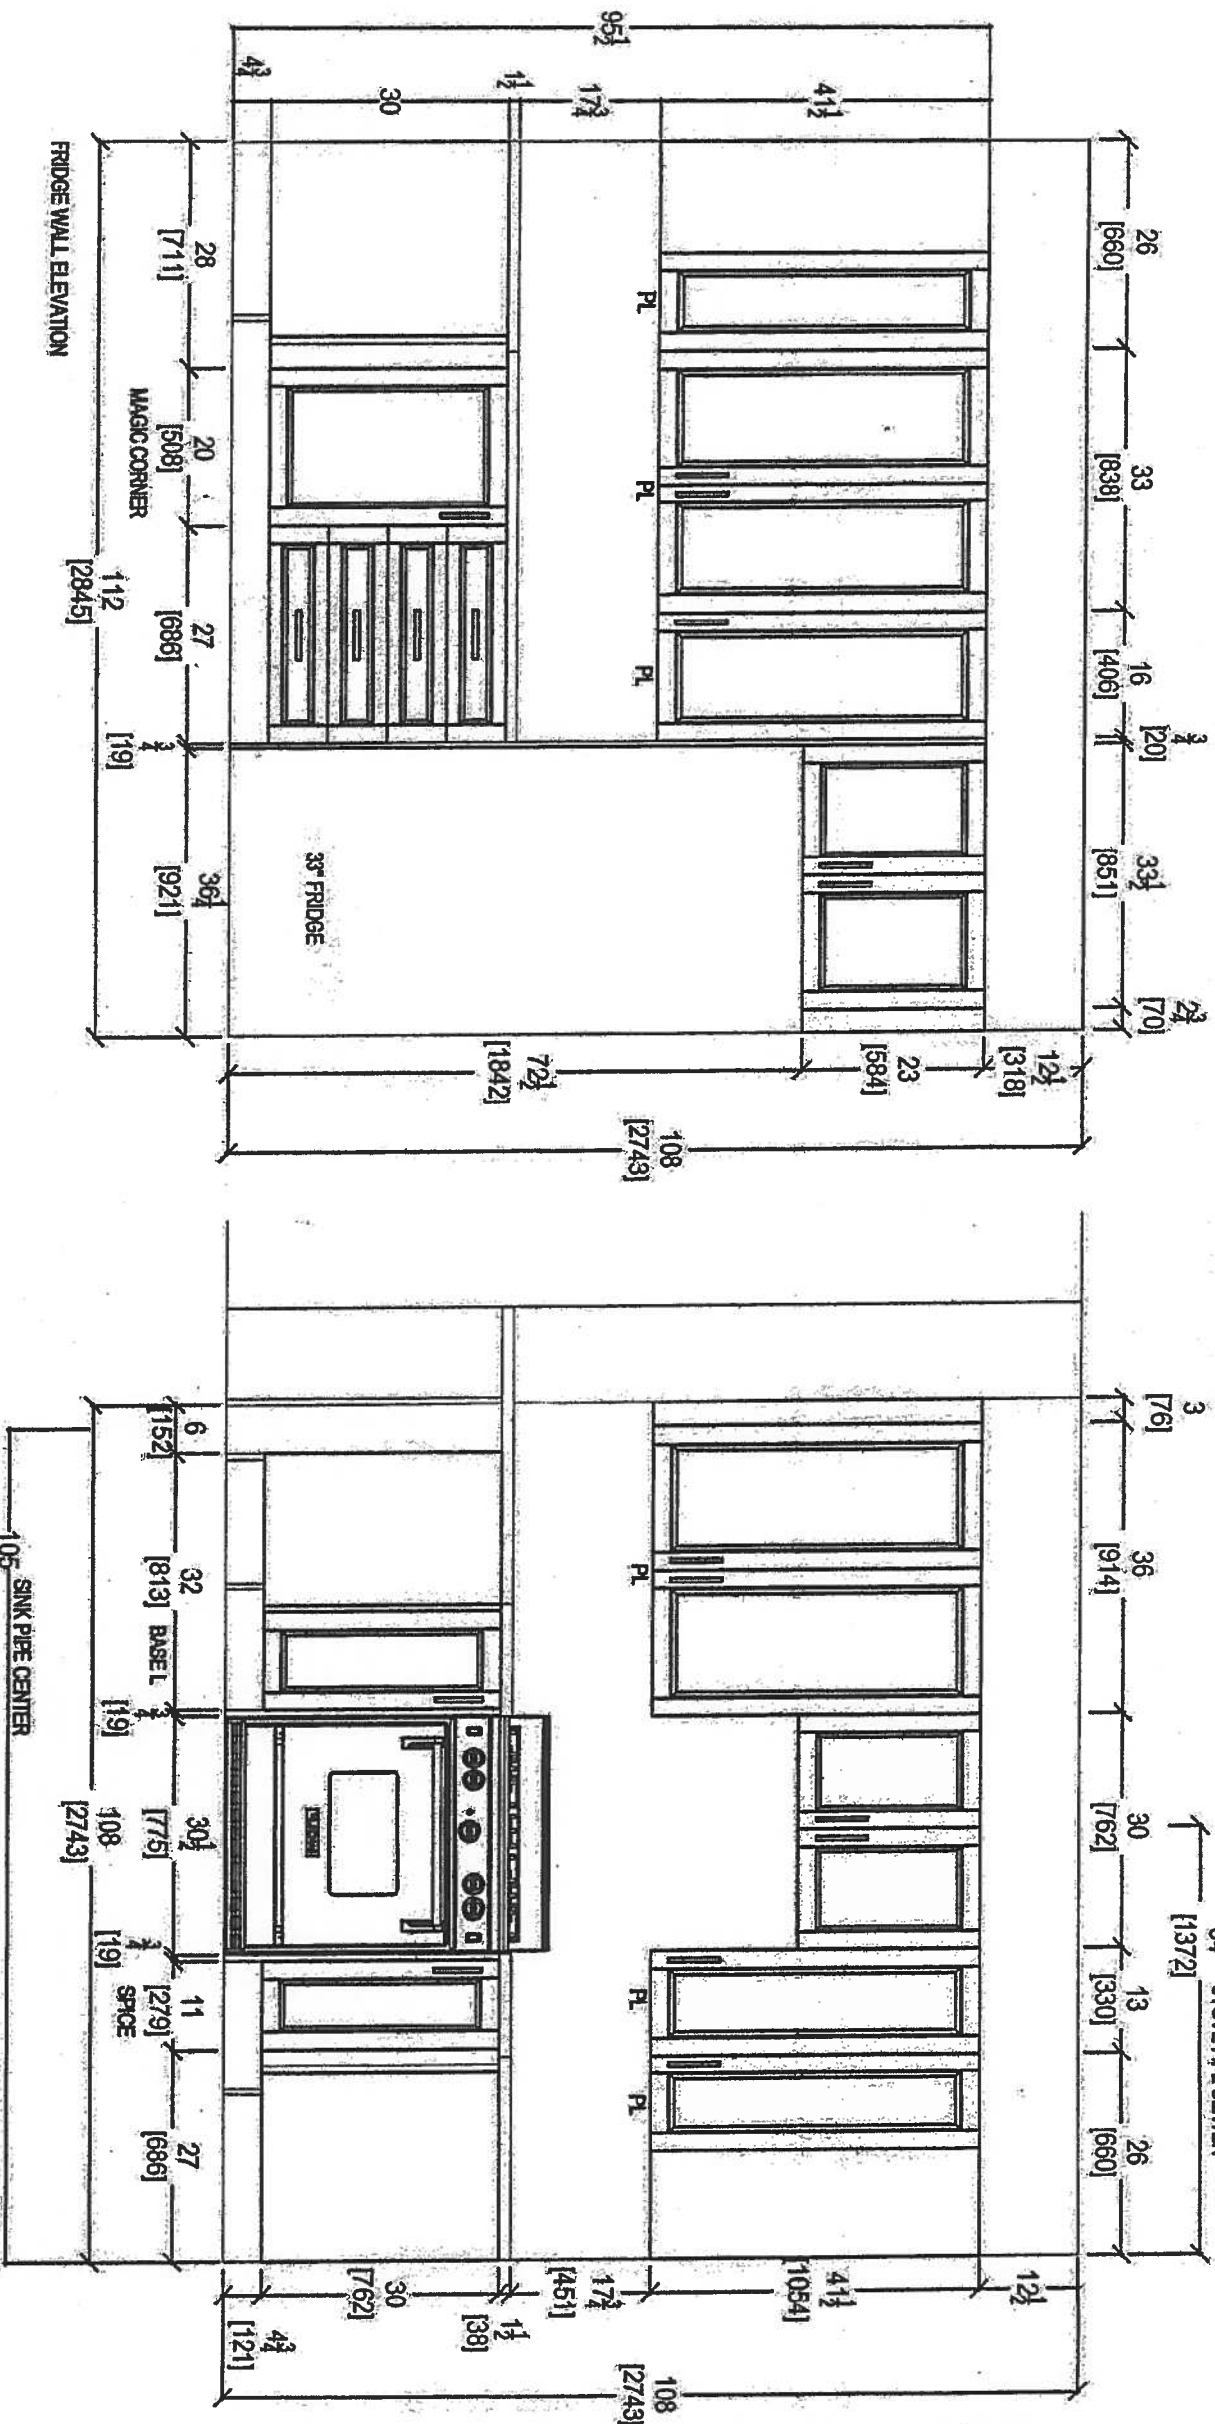

CLIENT: ROYAL PINE HOMES

JOB NAME: UNIT 307 HAP

ROOM: KITCHEN

DRAWN BY: SK

COMMENTS:

SITE: HAMPTON PLACE

DOOR STYLE: ---

DOOR HANDLE: ---

SCALE: 1/2" = 1'-0"

PLEASE NOTE ALL DIMENSIONS ARE NOT FINAL AND ARE SUBJECT TO CHANGE UPON FINAL SITE MEASURE

PHONE: ---

FINISH: ---

DRV HANDLE: ---

DATE: FEB 13, 2018

EMAIL: ---


SPECIES: ---

TOP: ---


PAGE: ---



80 SANTI DRIVE, VALGUSHAN, T. 416.746.1811 F. 303.1

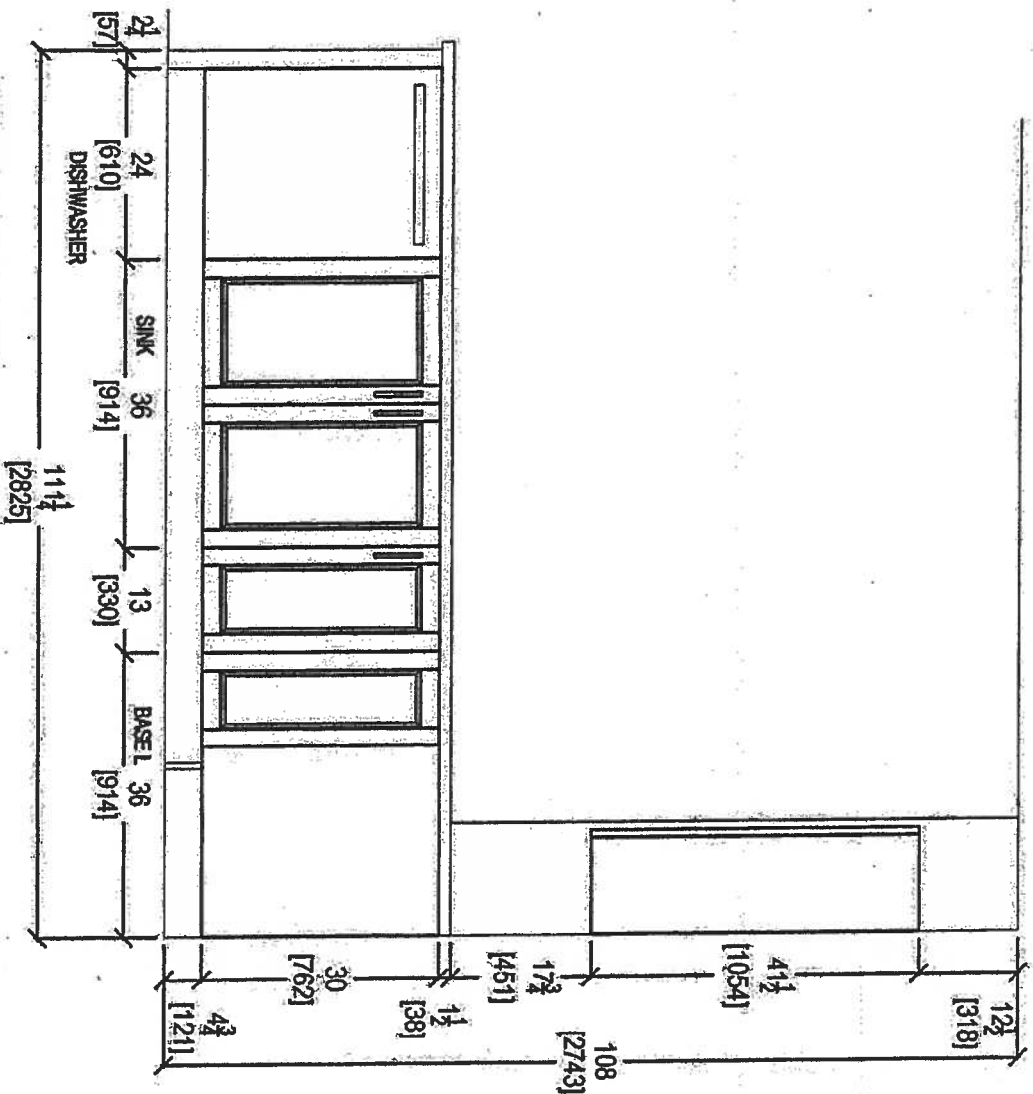

KITCHEN PENINSULA ELEVATION
FRONT VIEW




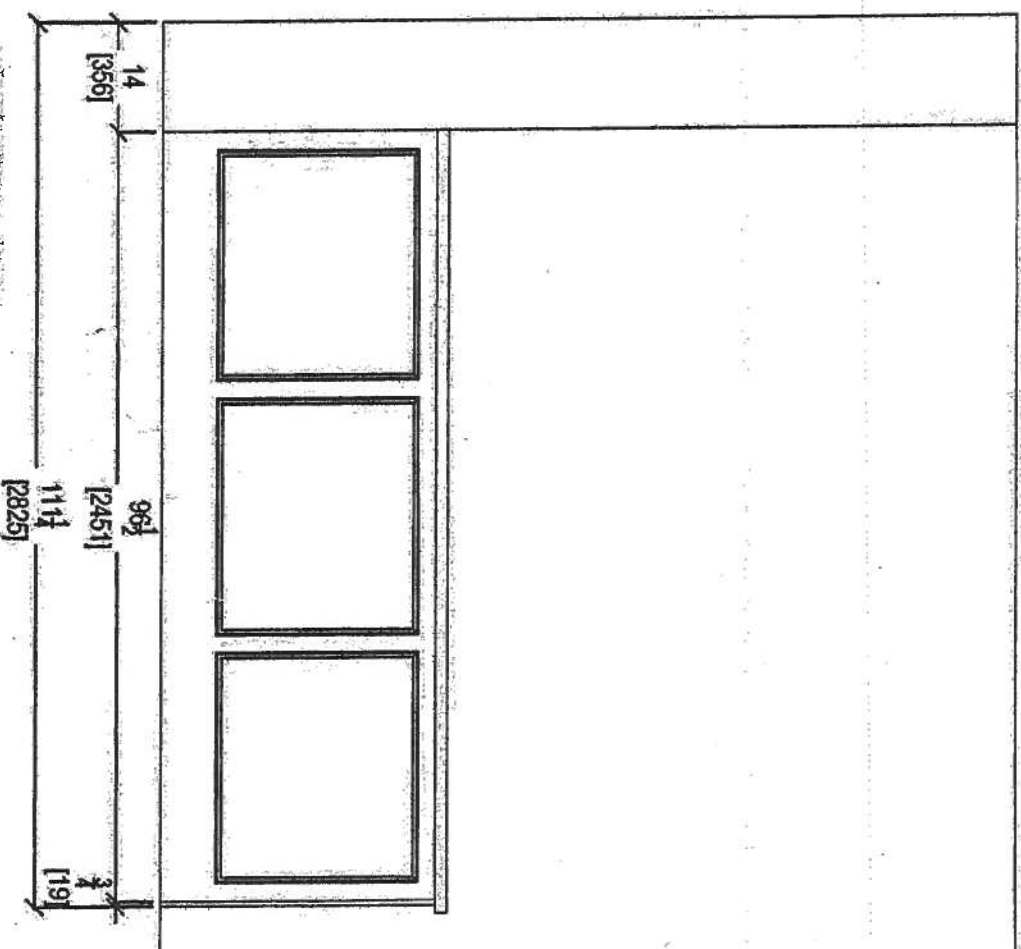


KITCHEN PENINSULA ELEVATION
REAR VIEW



80 SANTE DRIVE, VALHALLA, NY
T: 416.746.1811 F: 908.761

CLIENT: ROYAL PINE HOMES	JOB NAME: UNIT 807 HMP	ROOM: KITCHEN	DRAWN BY: SK	COMMENTS:
SITE: HAMPTON PLACE	DOOR STYLE: —	DOOR HANDLE: —	SCALE: 1/2" = 1'-0"	PLEASE NOTE ALL DIMENSIONS ARE NOT FINAL AND ARE SUBJECT TO CHANGE UPON FINAL SITE MEASURE
PHONE: —	FINISH: —	DRY/HANDLE: —	DATE: FEB 13, 2018	
EMAIL: —	SPECIES: —	TOP: —	PAGE: —	

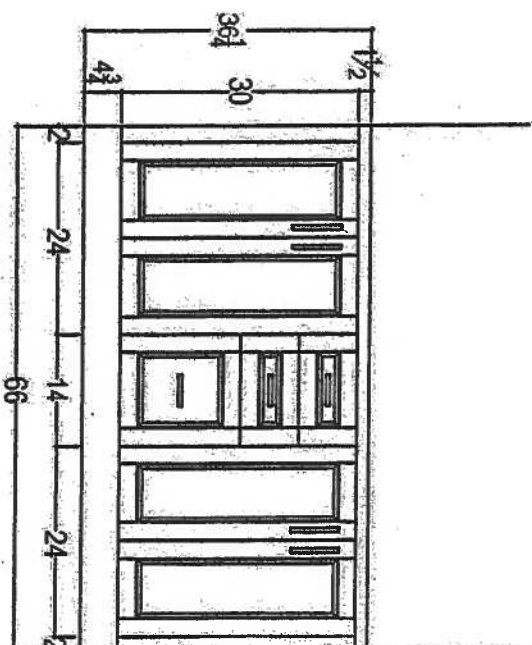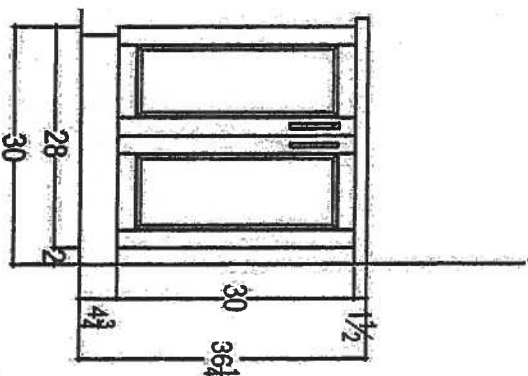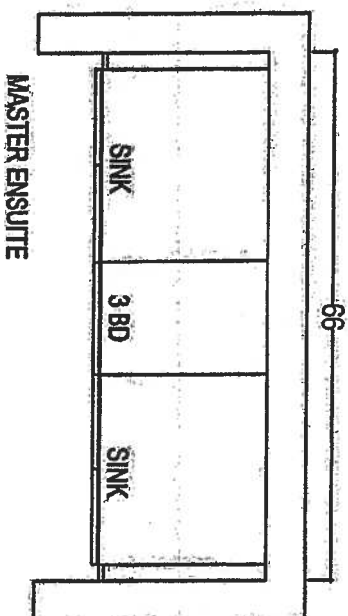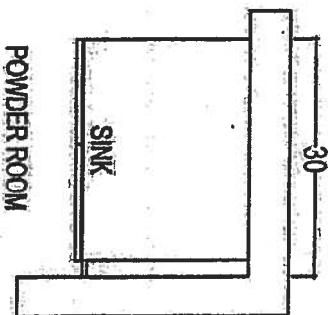

CLIENT: ROYAL PINE HOMES

JOB NAME: UNIT 307 HMP

ROOM: VANITIES

DRAWN BY: SK

SITE: HAMPTON PLACE

DOOR STYLE: —

DOOR HANDLE: —

SCALE: 1/2" = 1'-0"

PHONE: —

FINISH: —

DRW HANDLE: —

DATE: FEB 13, 2018

EMAIL: —

SPECIES: —

TOR: —

PAGE: —

COMMENTS:

PLEASE NOTE ALL DIMENSIONS
ARE NOT FINAL AND ARE
SUBJECT TO CHANGE UPON
FINAL SITE MEASURE



80 SANTE DRIVE, VAUGHAN, ONT L4V 1P1
T: 416.748.1811 F: 905.761.4111