



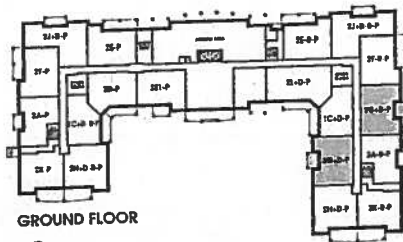


Noyac Bay

1,121 SQ FT *plus 81 sq. ft. of balcony area*


SUITE 311
ORIGINAL
LAYOUT
INVENTORY
SUITE

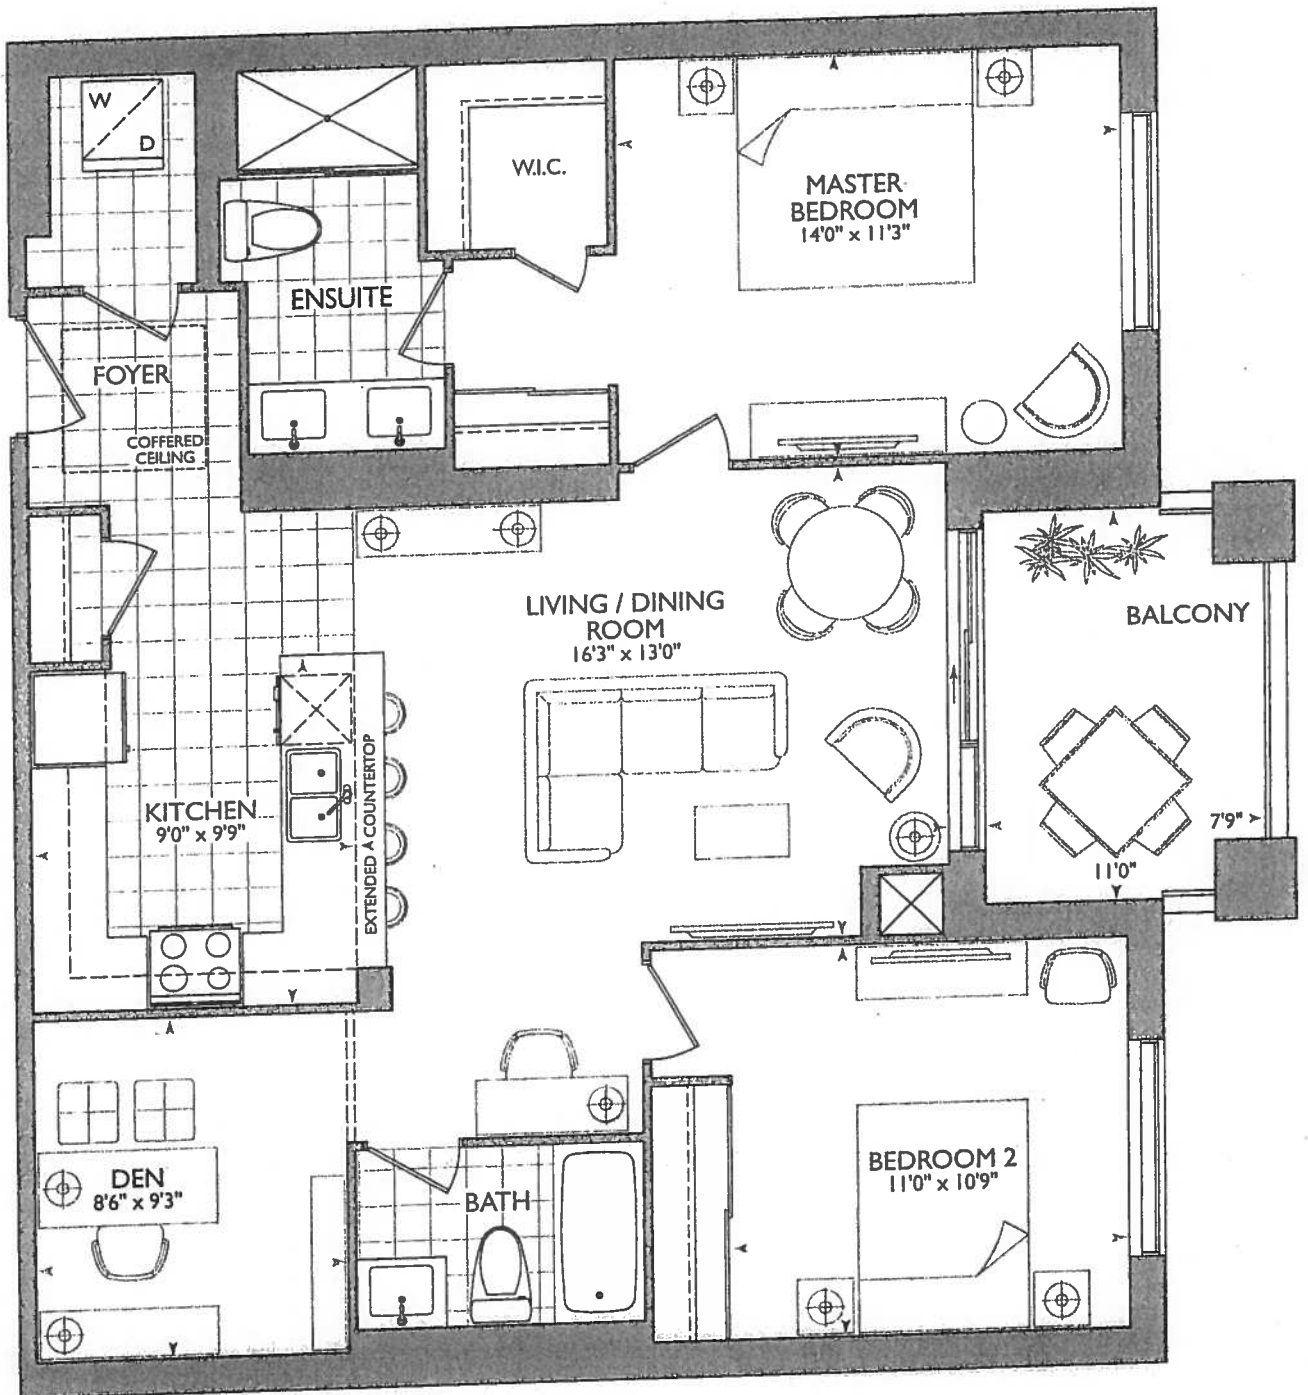

GROUND FLOOR

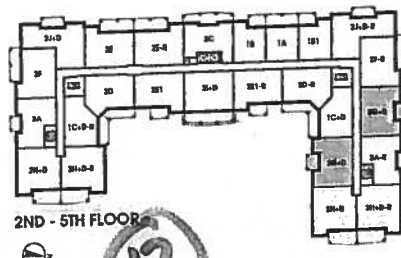

2ND - 5TH FLOOR

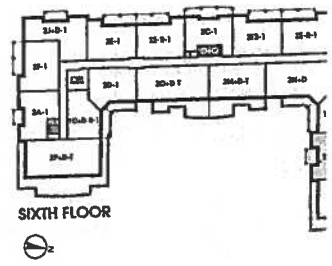

SIXTH FLOOR

NOYAC BAY: 311

- ENSUITE WALL REVISED AS PER ARCHITECTURE DRAWINGS
- LAUNDRY DOOR SWING TO OPEN AGAINST THE ENSUITE WALL


SWIFT 311
INVESTORS

- CHOICE OF STD KITCHEN LAYOUT W/ STD APPLIANCES PACKAGE

021

• OPT UPG #1 - KITCHEN LAYOUT WITH UPG #1 APPLIANCE PACKAGE

(see separate kit layout)

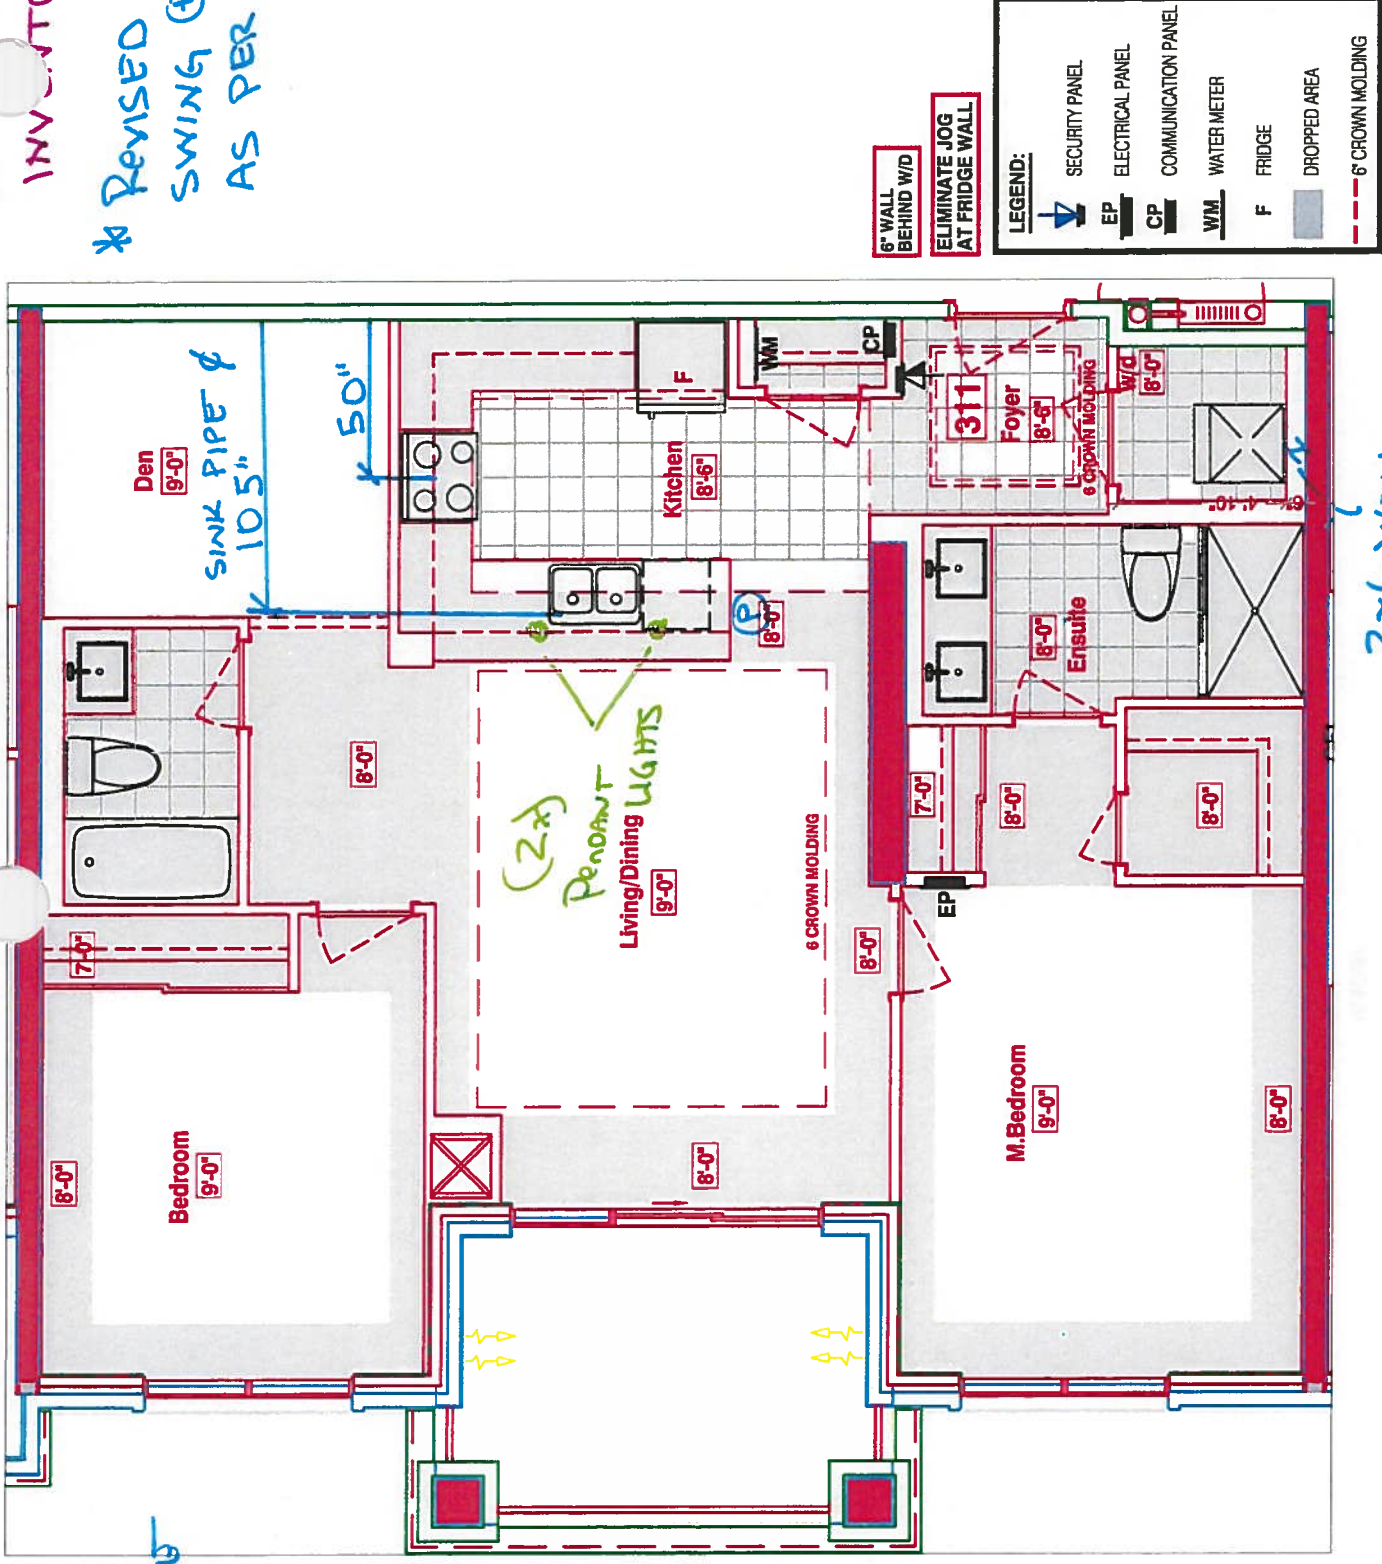**SUITES 311 - NOYAK BAY**

■ Royal Pine Homes ■ 25 Baker Hill Blvd - Storffville, ON ■ Feb 14, 2018

DRAWING AS PER AGREEMENT OF PURCHASE AND SALE (before decor appointment)

BETHND WASHAN | DRYER

Suite # 311

STD KITCHEN
LAYOUT


STD APPLIANCE
PACKAGE

(P) = Plug

PENNUM SURF

(4x) = Puck Lights

(2x) Pendant Lights
(UPG.)

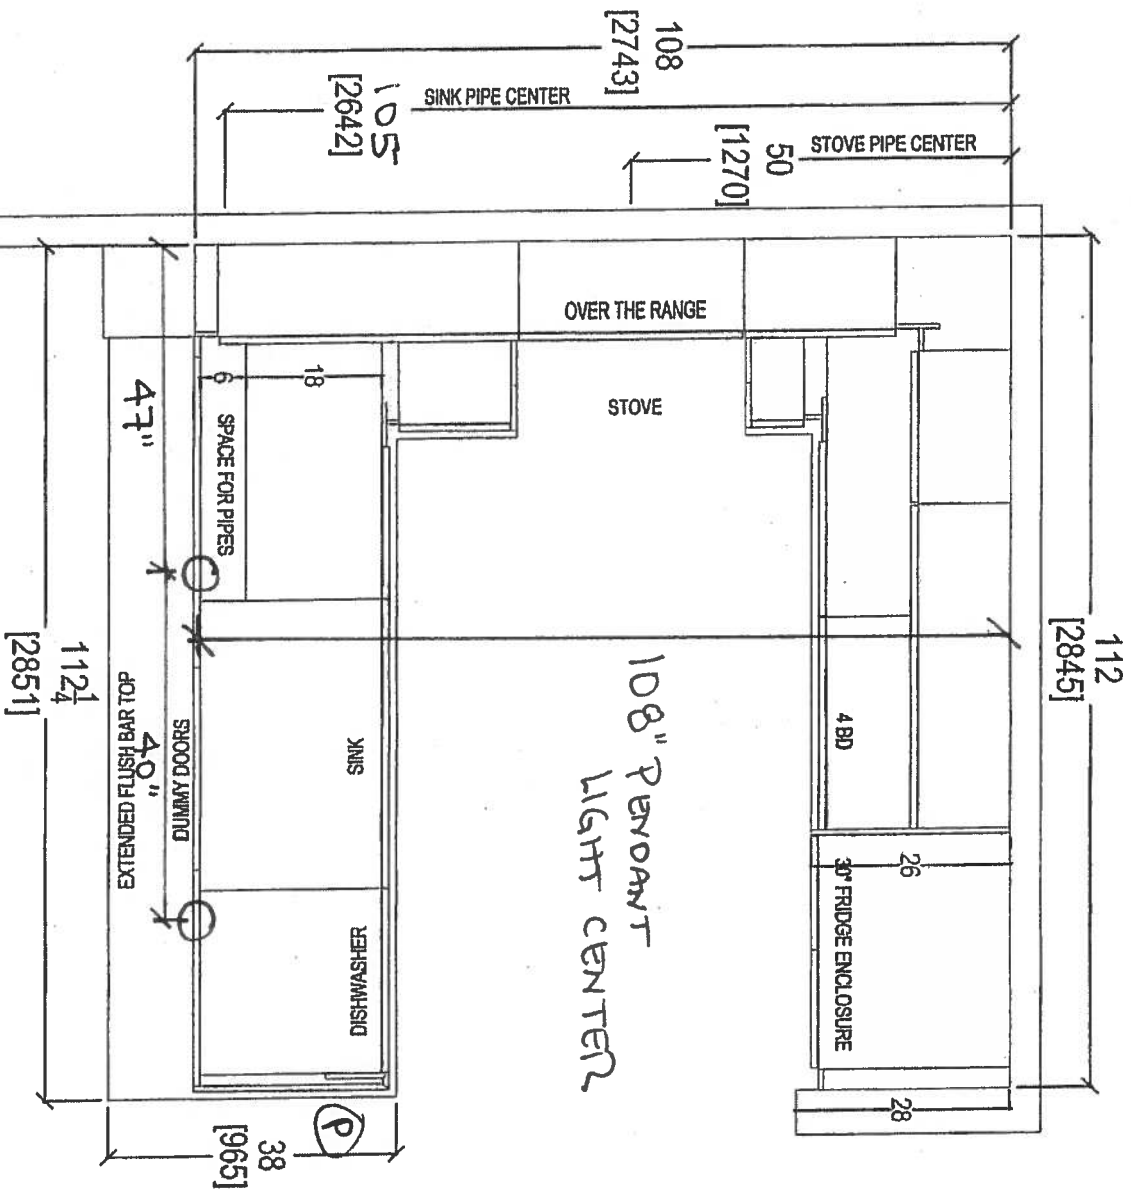


RECEIVED
JUN 17 2017



80 SANITE DRIVE, VAUGHAN ON L4K 3C4,
T: 416.746.1811 / F: 416.746.1801

CLIENT: ROYAL PINE HOMES	JOB NAME: 2G+ D	ROOM: KITCHEN FLOOR PLAN	DRAWN BY: SK	COMMENTS:
SITE: HAMPTON PLACE	DOOR STYLE: —	DOOR HANDLE: —	SCALE: 1/2" = 1' - 0"	PLEASE NOTE ALL DIMENSIONS ARE NOT FINAL AND ARE SUBJECT TO CHANGE UPON FINAL SITE MEASURE
PHONE: —	FINISH: —	DRW HANDLE: —	DATE: AUG 4, 2017	
EMAIL: —	SPECIES: —	TOP: —	PAGE: —	

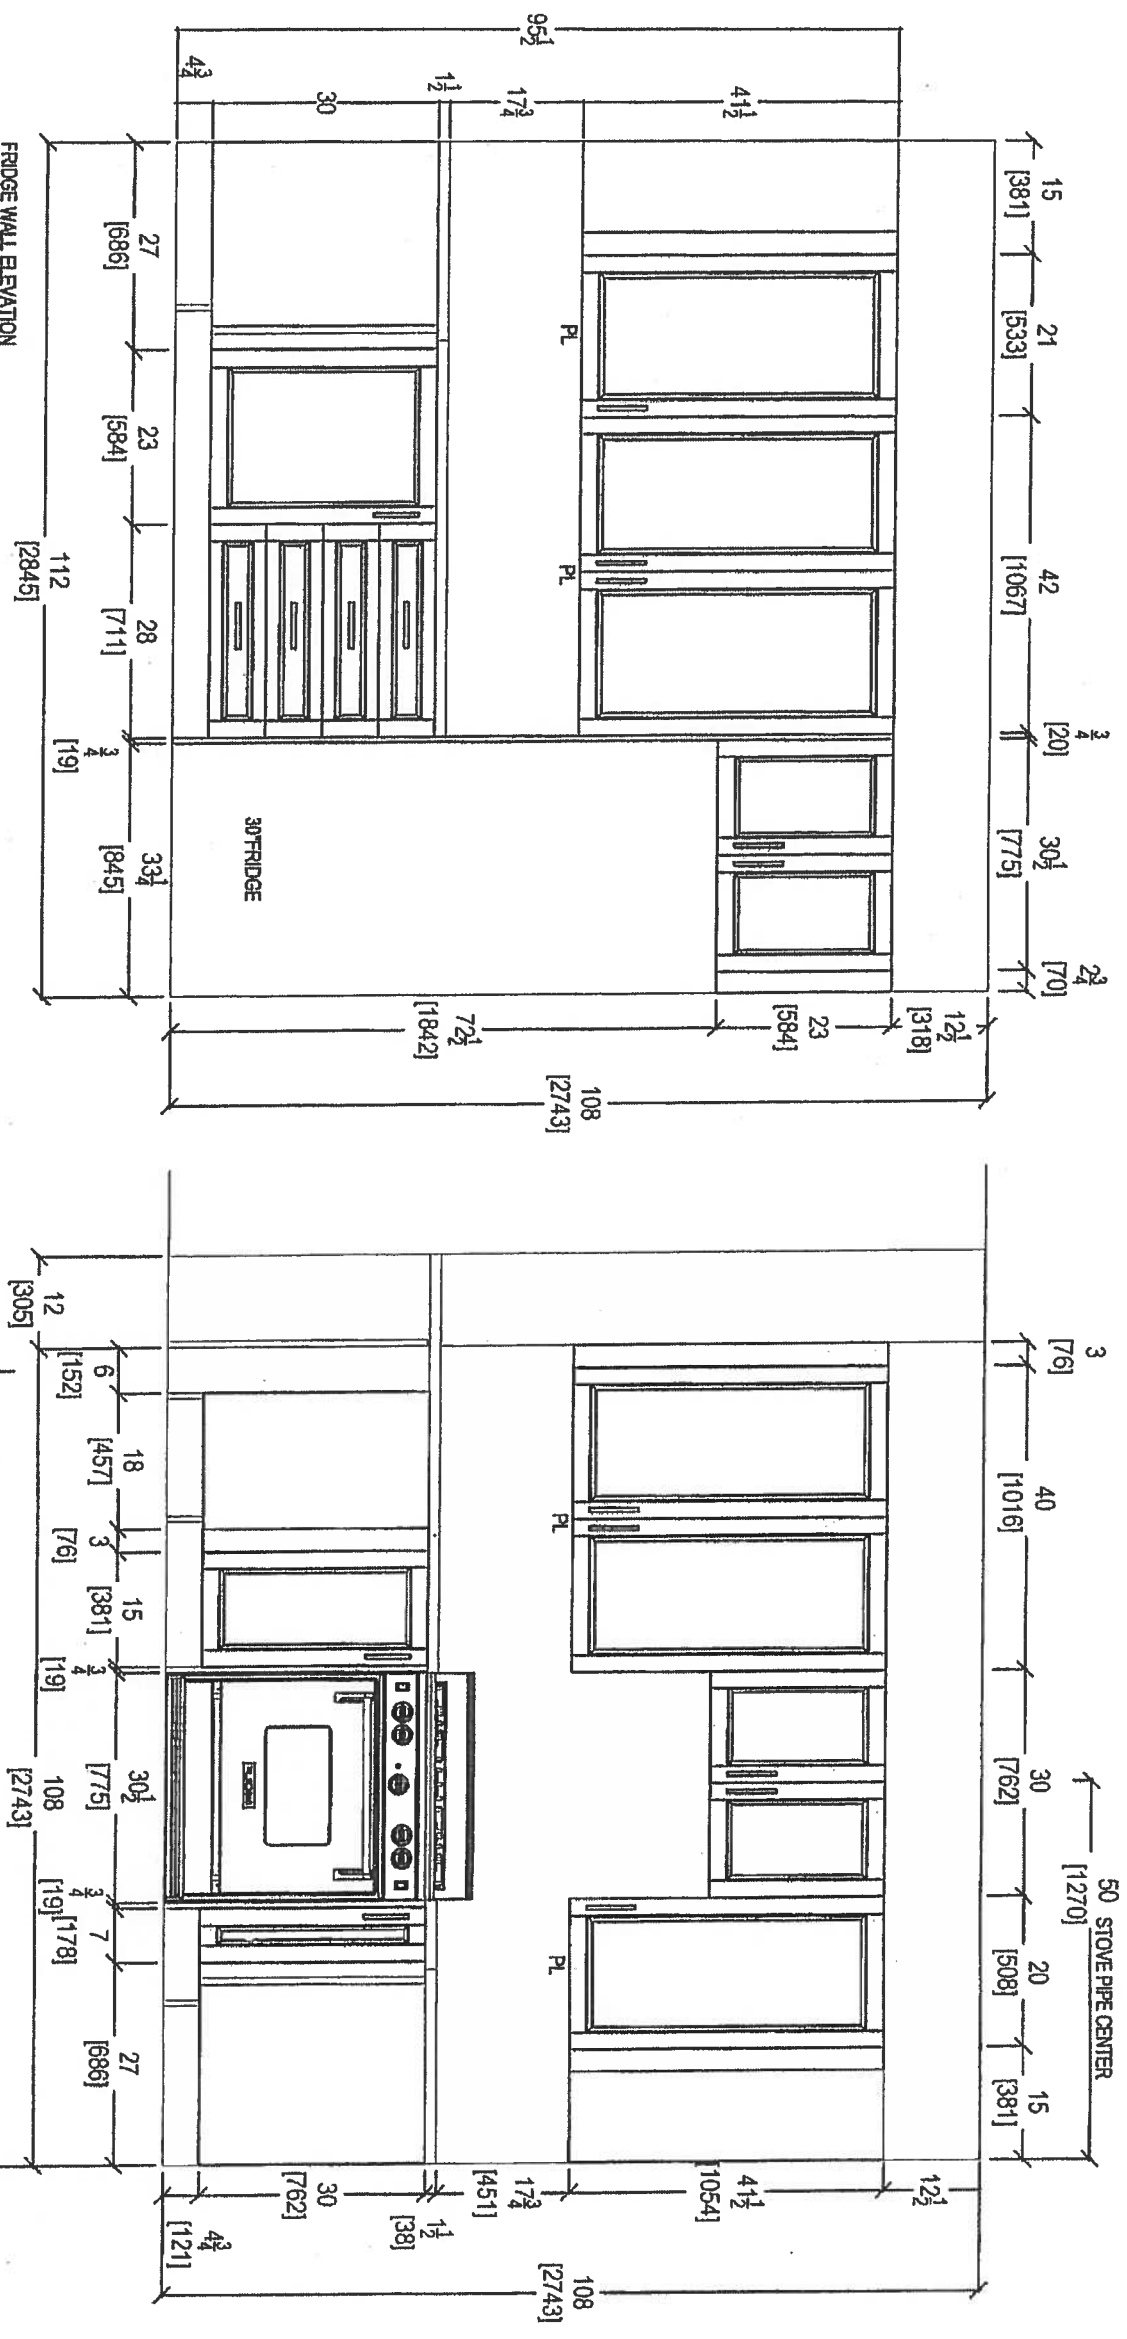

RECEIVED
NOV 6 17 2017



105 SINK PIPE CENTER
12667

STONE WALL ELEVATION

CLIENT: ROYAL PINE HOMES		JOB NAME: 2G+ D		DRAWN BY: SK		COMMENTS: PLEASE NOTE ALL DIMENSIONS ARE NOT FINAL AND ARE SUBJECT TO CHANGE UPON FINAL SITE MEASURE
SITE: HAMPTON PLACE		DOOR STYLE: —		DOOR HANDLE: —		
PHONE: —		FINISH: —		DATE: AUG 4, 2017		
EMAIL: —		SPECIES: —		PAGE: —		



your kitchen, your size
80 SANTE DRIVE, VAUGHAN, ON L4K 3C4,
T: 416.748.1811 F: 416.748.15901



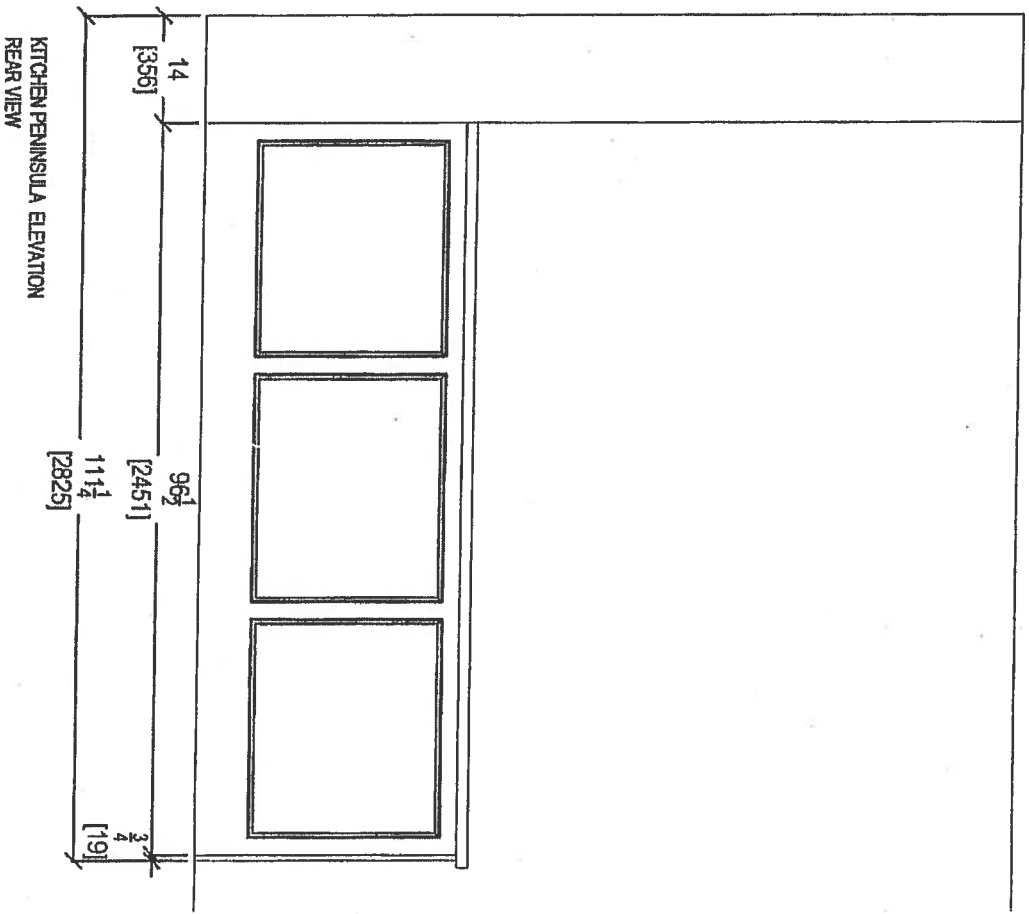
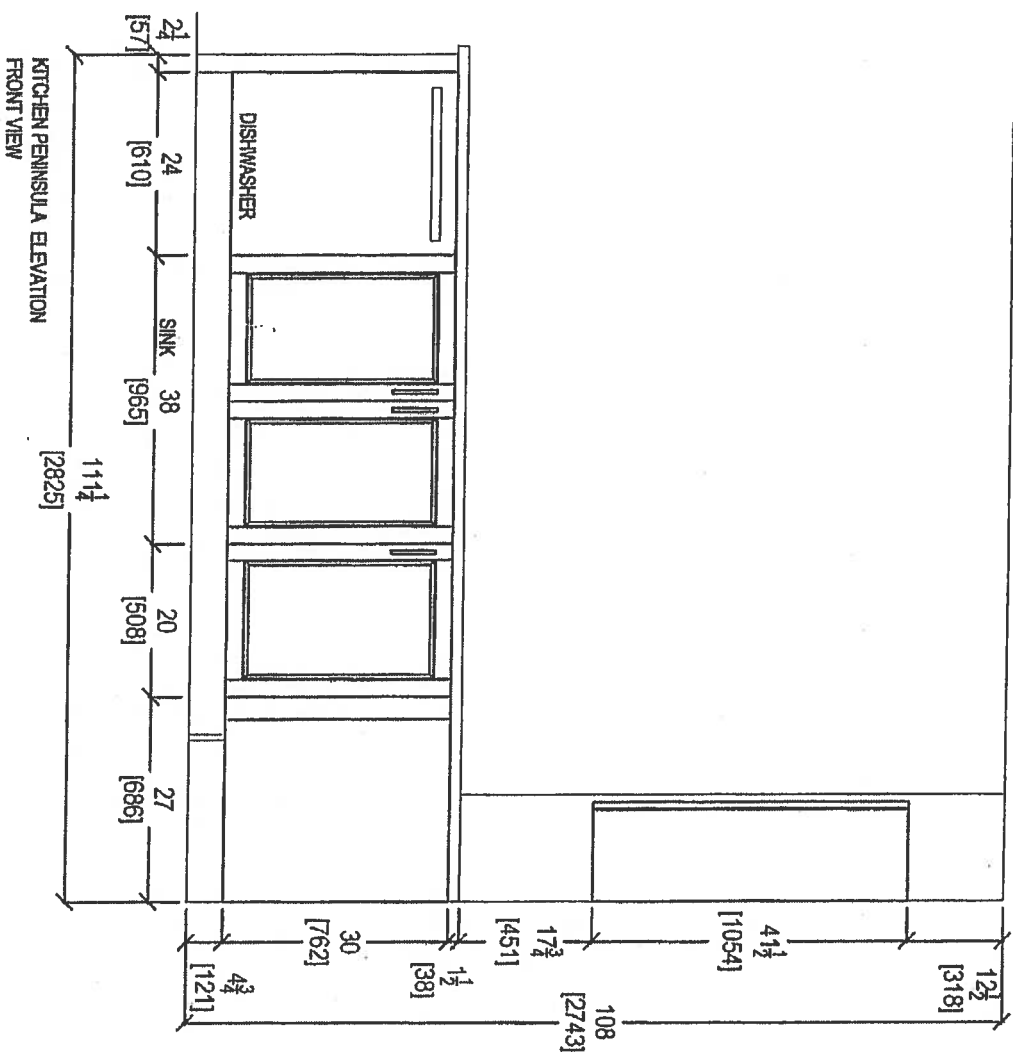


RECEIVED
11/11/17



your kitchen, your life.
80 SANTE DRIVE, VAUGHAN, ON L4K 3C4,
T: 416.746.1811 F: 905.761.5901

CLIENT: ROYAL PINE HOMES		JOB NAME: 2G+ D		ROOM: KITCHEN		DRAWN BY: SK		COMMENTS: PLEASE NOTE ALL DIMENSIONS ARE NOT FINAL AND ARE SUBJECT TO CHANGE UPON FINAL SITE MEASURE	
SITE:	HAMPTON PLACE	DOOR STYLE:	—	DOOR HANDLE:	—	SCALE:	1/2" = 1'-0"		
PHONE:	—	FINISH:	—	DRW HANDLE:	—	DATE:	AUG 4, 2017		
EMAIL:	—	SPECIES:	—	TOP:	—	PAGE:	—		

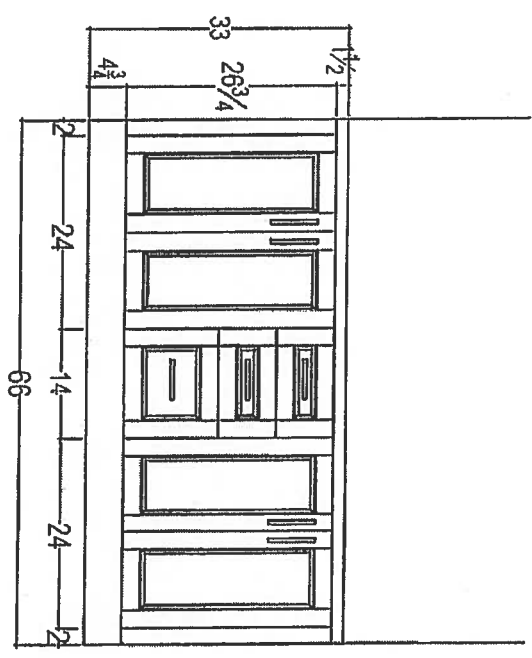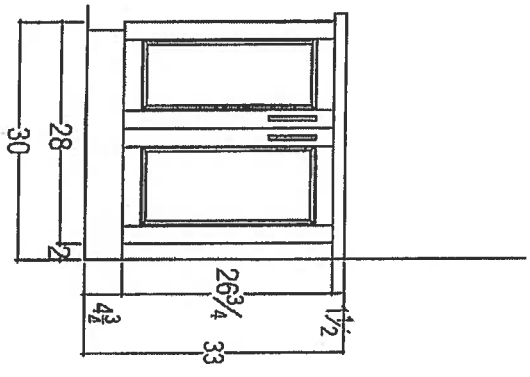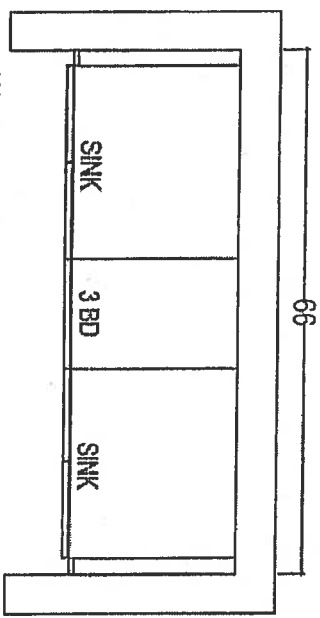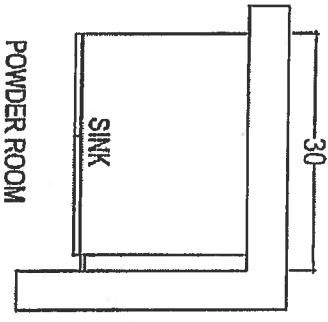

RECEIVED
12-28-18

CLIENT: ROYAL PINE HOMES	JOB NAME: 2G+D	ROOM: VANITIES	DRAWN BY: SK
SITE: HAMPTON PLACE	DOOR STYLE: --	DOOR HANDLE: --	SCALE: 1/2" = 1'-0"
PHONE: --	FINISH: --	DRW HANDLE: --	DATE: AUG 4, 2017
EMAIL: --	SPECIES: --	TOP: --	PAGE: --




your kitchen, your life.
80 SANTE DRIVE, VAUGHAN, ONTARIO L4K 3C4,
T: 416.746.1811 F: 416.746.1812

PLEASE NOTE ALL DIMENSIONS
ARE NOT FINAL AND ARE
SUBJECT TO CHANGE UPON
FINAL SITE MEASURE

Suite 311



• OPT. UPGRADES #1
KITCHEN LAYOUT WITH
UPGRADE #1 APPLIANCE
PACKAGE

Ⓟ = Plug Peninsula
6x = Puck Lights (4x std)
2x = PENDANT LIGHTS
over Peninsula (UPG)

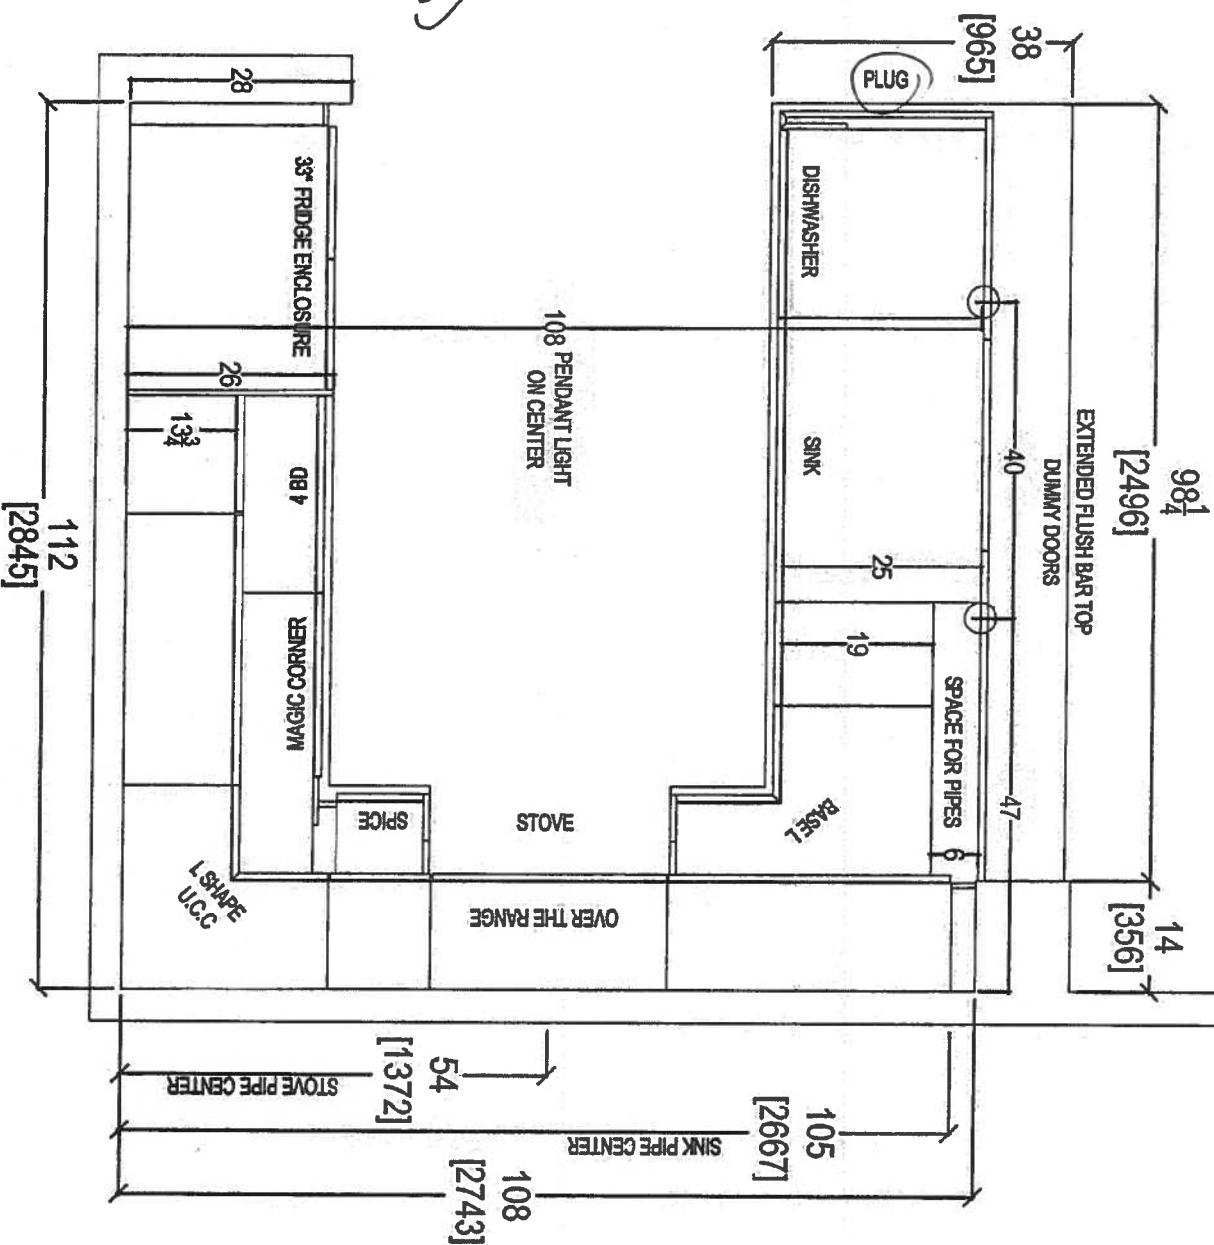

80 SANTE DRIVE, VAUGHAN, ON
T: 416.746.1811 F: 905.76

CLIENT: ROYAL PINE HOMES	JOB NAME: UNIT 311 HMP	ROOM: KITCHEN FLOOR PLAN	DRAWN BY: SK	COMMENTS:
SITE: HAMPTON PLACE	DOOR STYLE: —	DOOR HANDLE: —	SCALE: 1/2" = 1'-0"	PLEASE NOTE ALL DIMENSIONS ARE NOT FINAL AND ARE SUBJECT TO CHANGE UPON FINAL SITE MEASURE
PHONE: —	FINISH: —	DRW HANDLE: —	DATE: FEB 13, 2018	
EMAIL: —	SPECIES: —	TOP: —	PAGE: —	

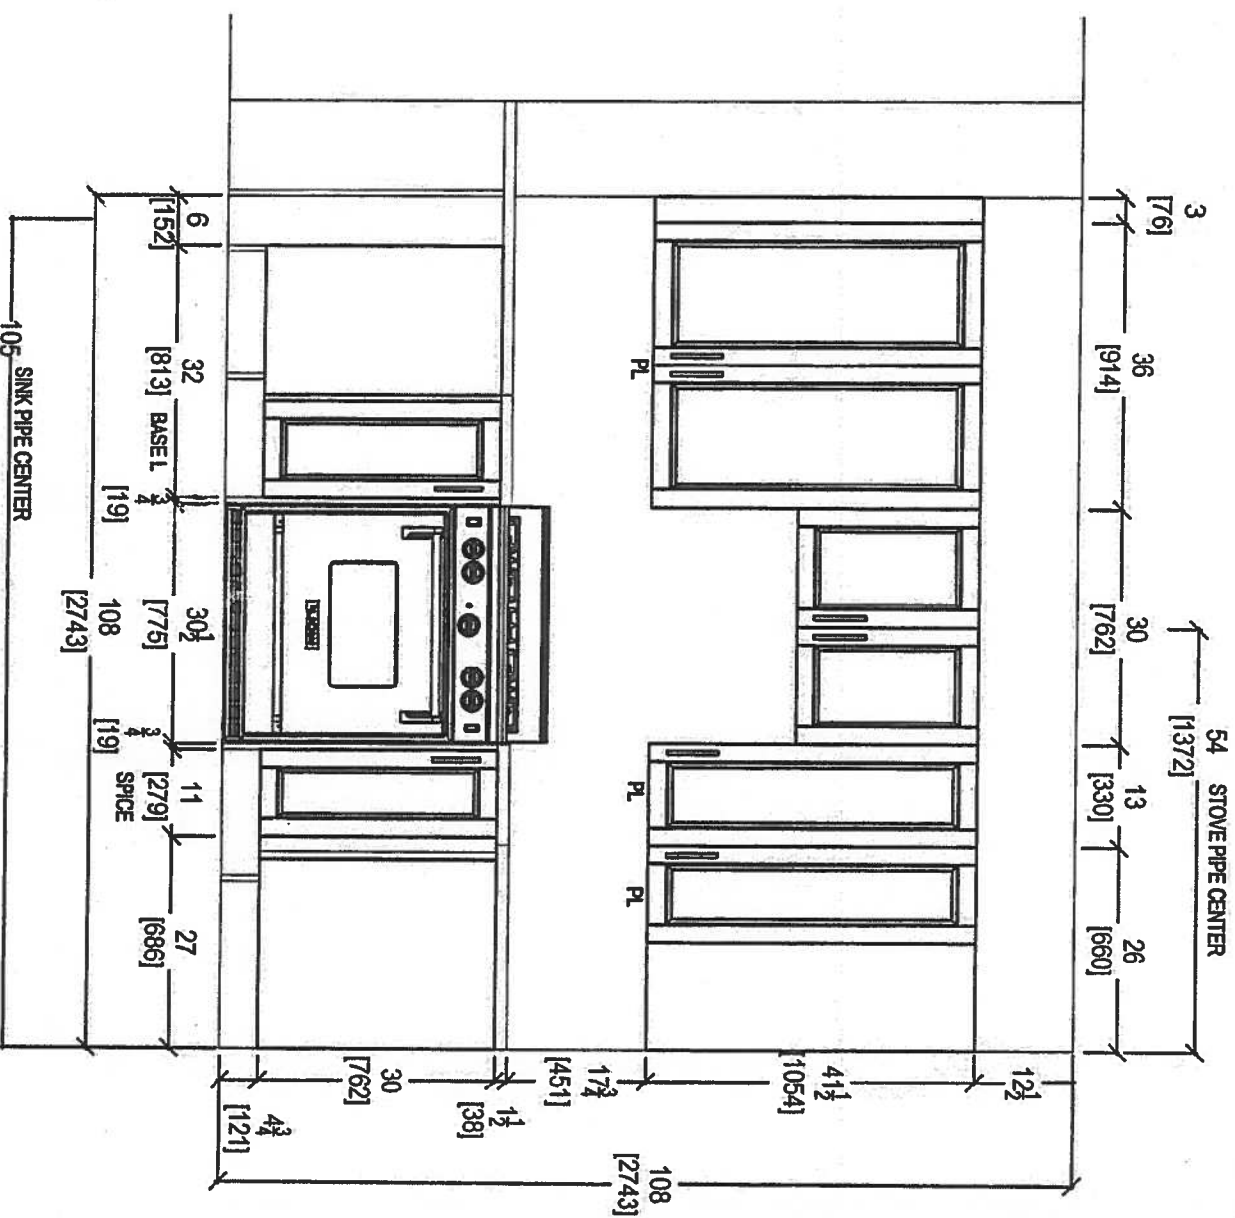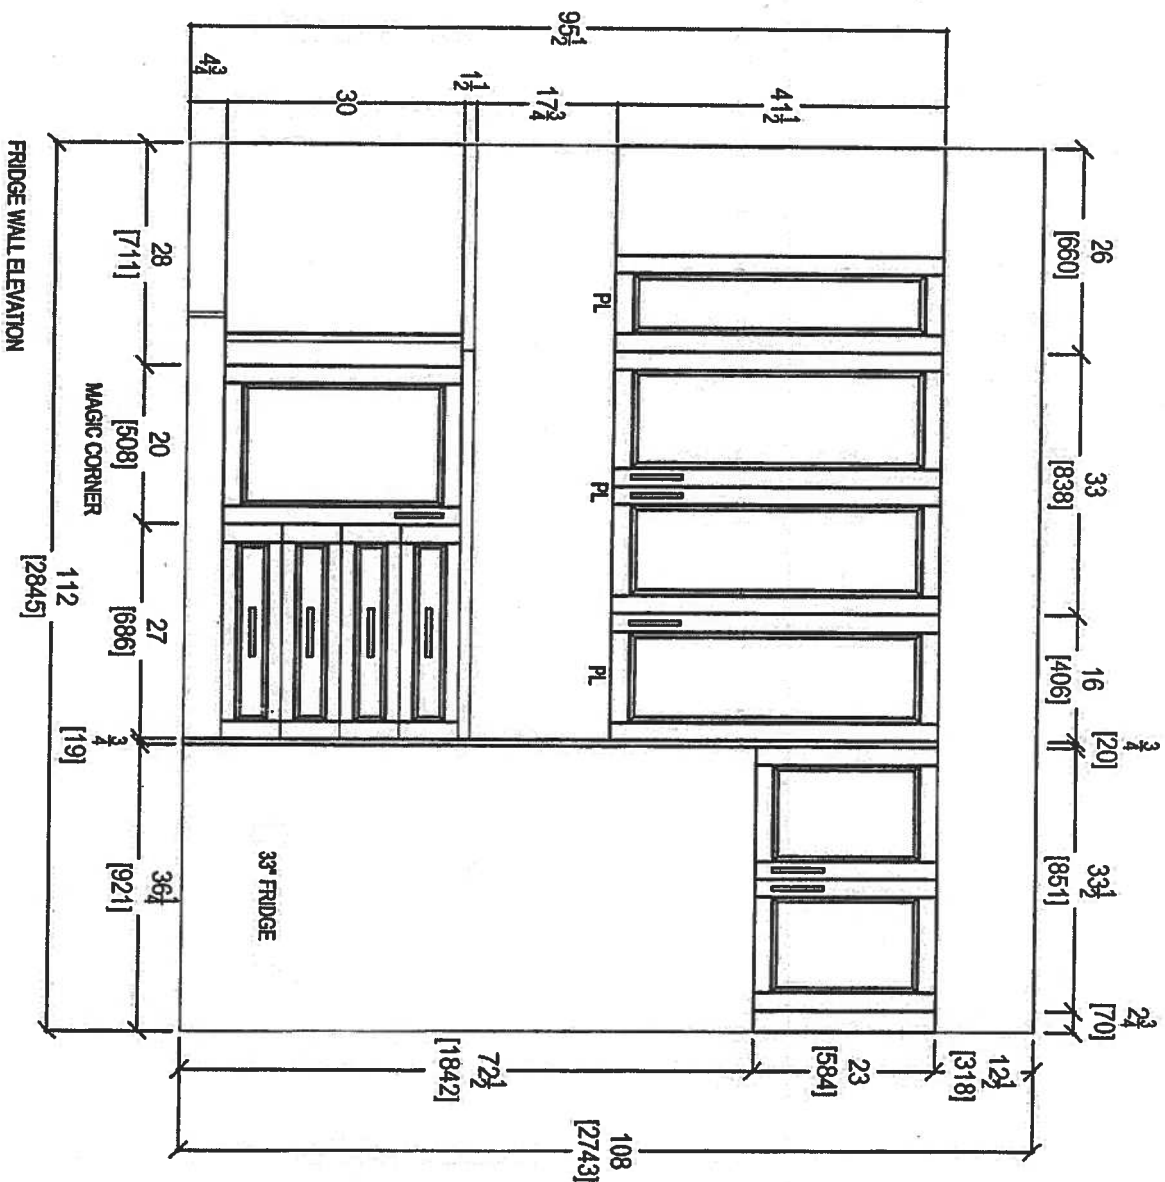

STOVE WALL ELEVATION

CLIENT: ROYAL PINE HOMES

JOB NAME: UNIT 311 HMP

ROOM: KITCHEN I

DRAWN BY: SK

COMMENTS:

SITE: HAMPTON PLACE

DOOR STYLE: —

DOOR HANDLE: —

SCALE: 1/2" = 1'-0"

PHONE: —

FINISH: —

DRW HANDLE: —

DATE: FEB 13, 2018

80 SANTE DRIVE, VAUGHAN,
T: 416.746.1811 F: 905. —


SPECIES: —

TOP: —


PAGE: —

PLEASE NOTE ALL DIMENSIONS
ARE NOT FINAL AND ARE
SUBJECT TO CHANGE UPON
FINAL SITE MEASURE



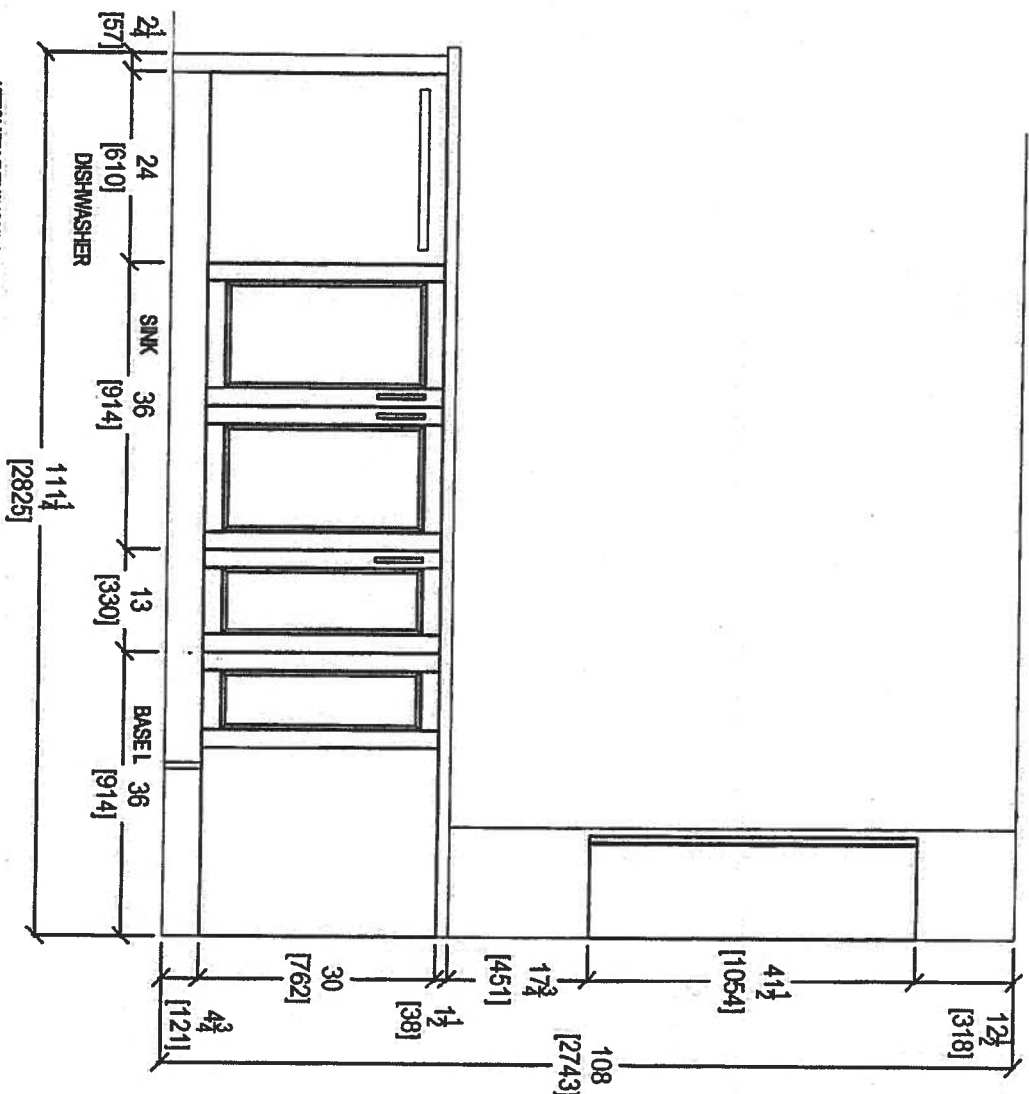

KITCHEN PENINSULA ELEVATION
FRONT VIEW

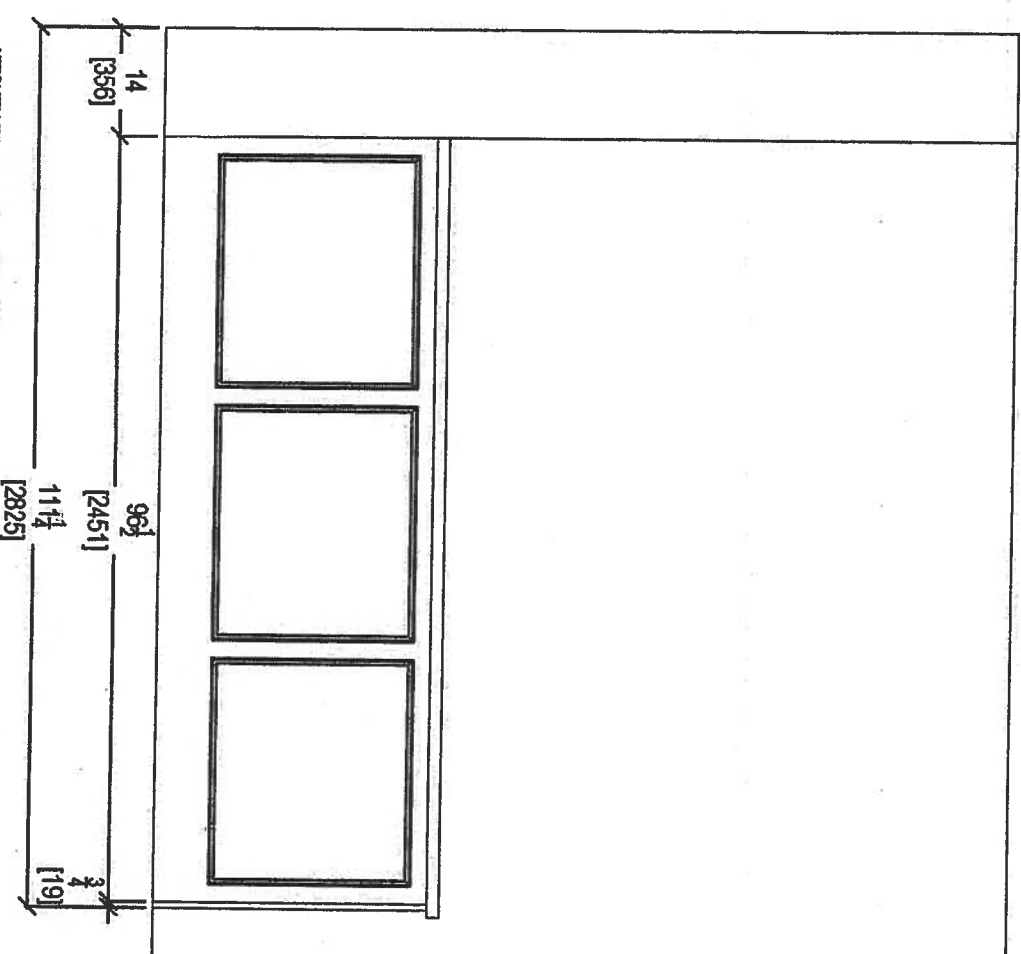





KITCHEN PENINSULA ELEVATION
REAR VIEW



80 SANTE DRIVE, VAUGHAN,
ONT. L4V 1P4
C4,
T: 416.746.1811 F: 905.746.1811

CLIENT: ROYAL PINE HOMES	JOB NAME: UNIT 311 HMP	ROOM: KITCHEN	DRAWN BY: SK
SITE: HAMPTON PLACE	DOOR STYLE: —	DOOR HANDLE: —	SCALE: 1/2" = 1'-0"
PHONE: —	FINISH: —	DRW HANDLE: —	DATE: FEB 13, 2018
EMAIL: —	SPECIES: —	TOP: —	PAGE: —

COMMENTS:
PLEASE NOTE ALL DIMENSIONS
ARE NOT FINAL AND ARE
SUBJECT TO CHANGE UPON
FINAL SITE MEASURE

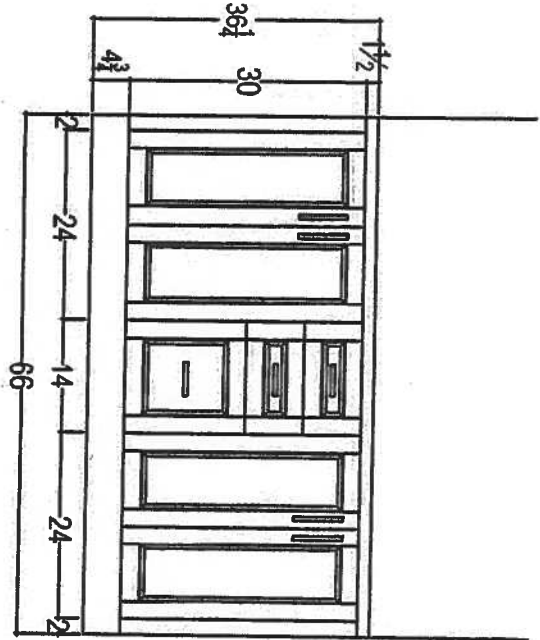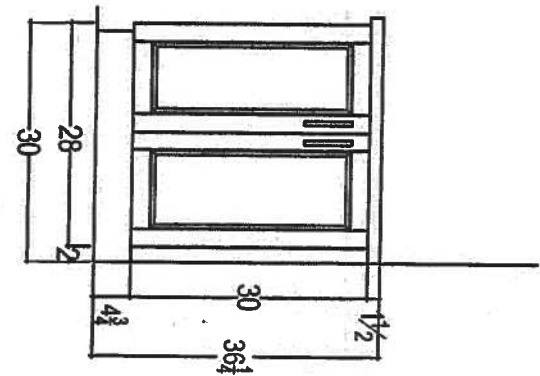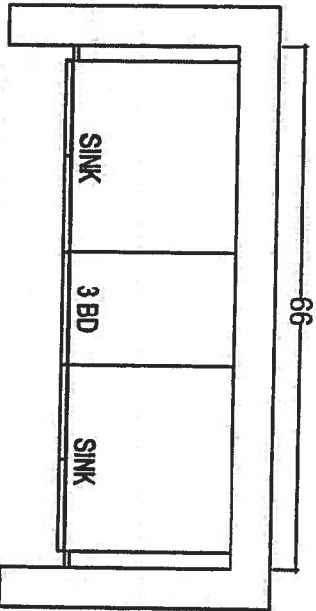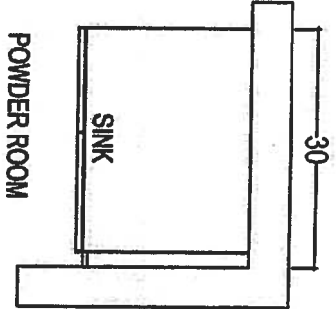

80 SANTE DRIVE, VAUGHAN,
T: 416 746.1811 F: 905

CLIENT: ROYAL PINE HOMES	UNIT 311 HMP	ROOM: VANITIES	DRAWN BY: SK
SITE: HAMPTON PLACE	DOOR STYLE: —	DOOR HANDLE: —	SCALE: 1/2" = 1'-0"
PHONE: —	FINISH: —	DRW HANDLE: —	DATE: FEB 13, 2018
EMAIL: —	SPECIES: —	TOP: —	PAGE: —

COMMENTS:
PLEASE NOTE ALL DIMENSIONS
ARE NOT FINAL AND ARE
SUBJECT TO CHANGE UPON
FINAL SITE MEASURE