







# Remsenburg

1,031 SQ FT *plus* 124 sq. ft. of balcony area


Suite #317

ORIGINAL  
LAYOUT

INVENTORY  
SUITE

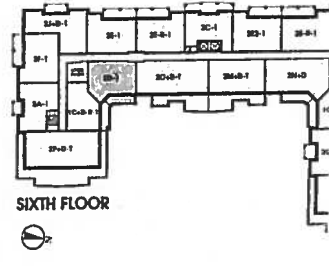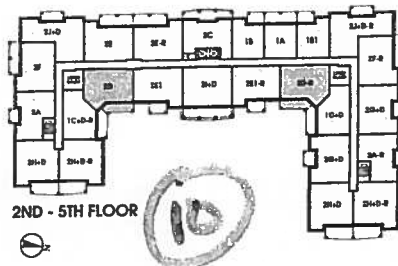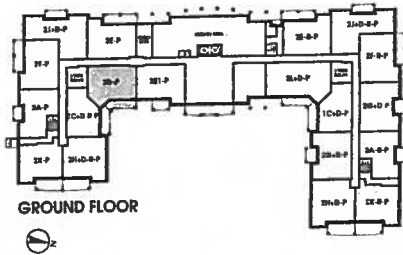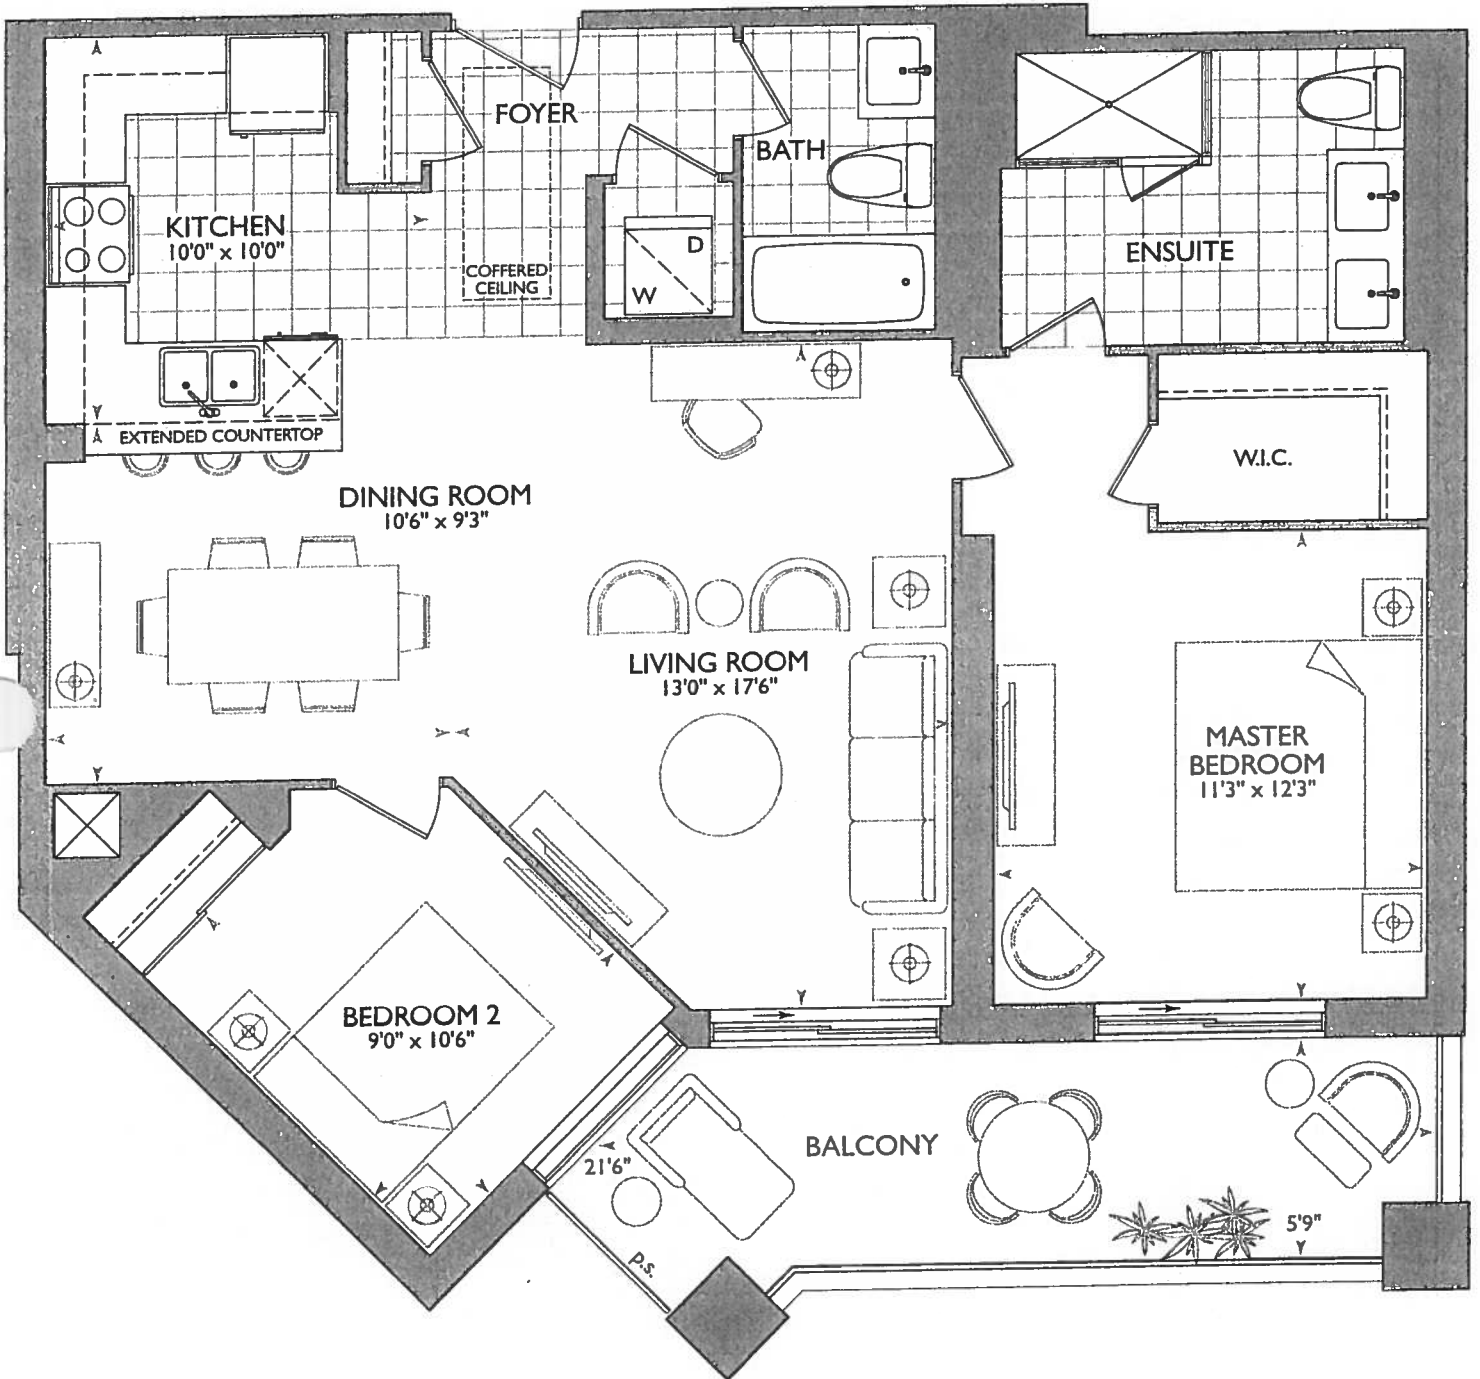

SUITE 317  
INVENTORY  
SUITE

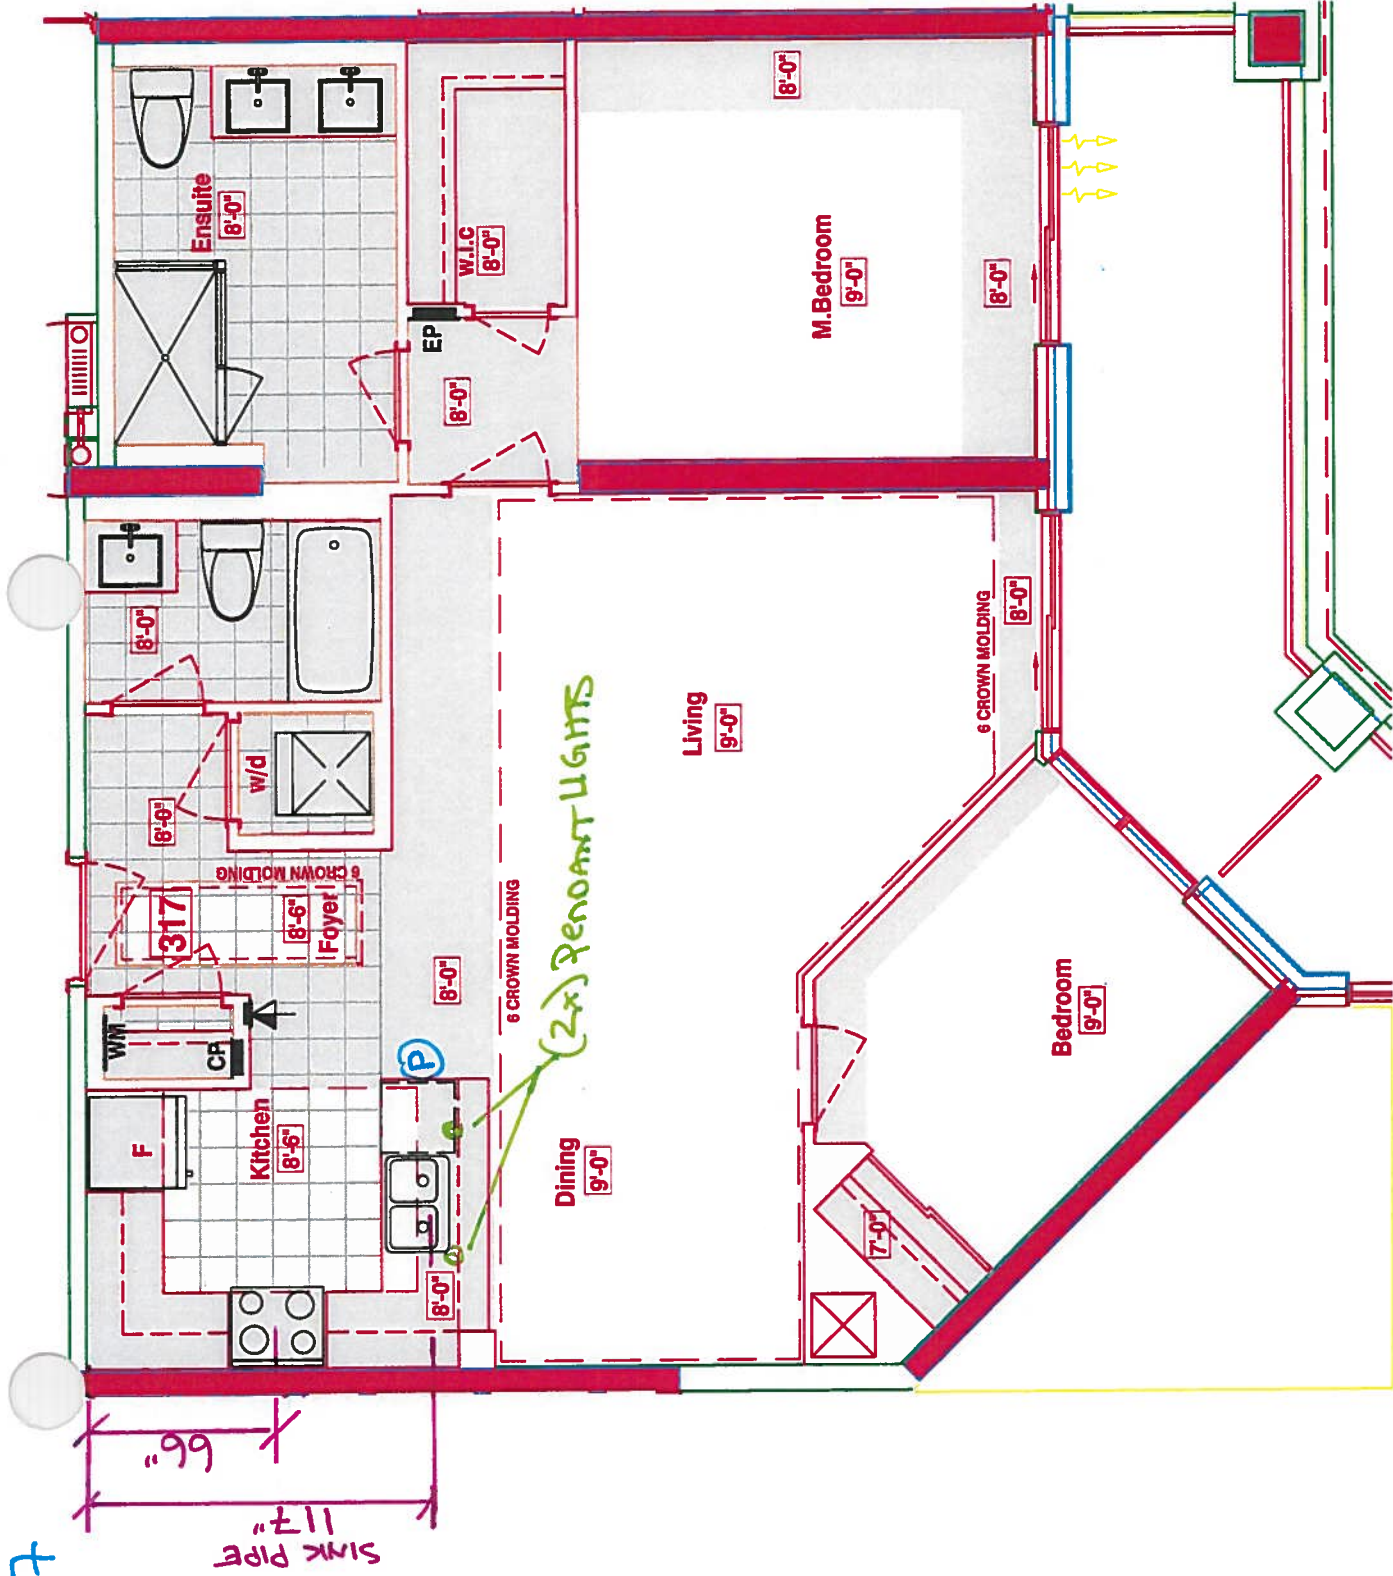

- KITCHEN**
- OPTION OF USING STD KITCHEN LAYOUT W/ STD APPLIANCE PACKAGE OR
  - UPG #1 - KITCHEN LAYOUT W/ UPG #1 - APPLIANCE PACKAGE (P) PLUG PENINSULA
  - See separate OPTION LAYOUTS


| LEGEND: |                     |
|---------|---------------------|
|         | SECURITY PANEL      |
|         | ELECTRICAL PANEL    |
|         | COMMUNICATION PANEL |
|         | WATER METER         |
|         | FRIDGE              |
|         | DROPPED AREA        |
|         | 6" CROWN MOLDING    |

SUITE 317 - REMSENBURG

Royal Pine Homes 25 Baker Hill Blvd - Stouffville, ON Feb 14, 2018

Suite #317 (Inventory)

- SMO KITCHEN LAYOUT
- SMO APPLIANCE PACKAGE
- (P) = Plug PENINSULA
- 3x = Puck LIGHTS
- 2x = Pendent LIGHTS (UPG)
- over PENINSULA

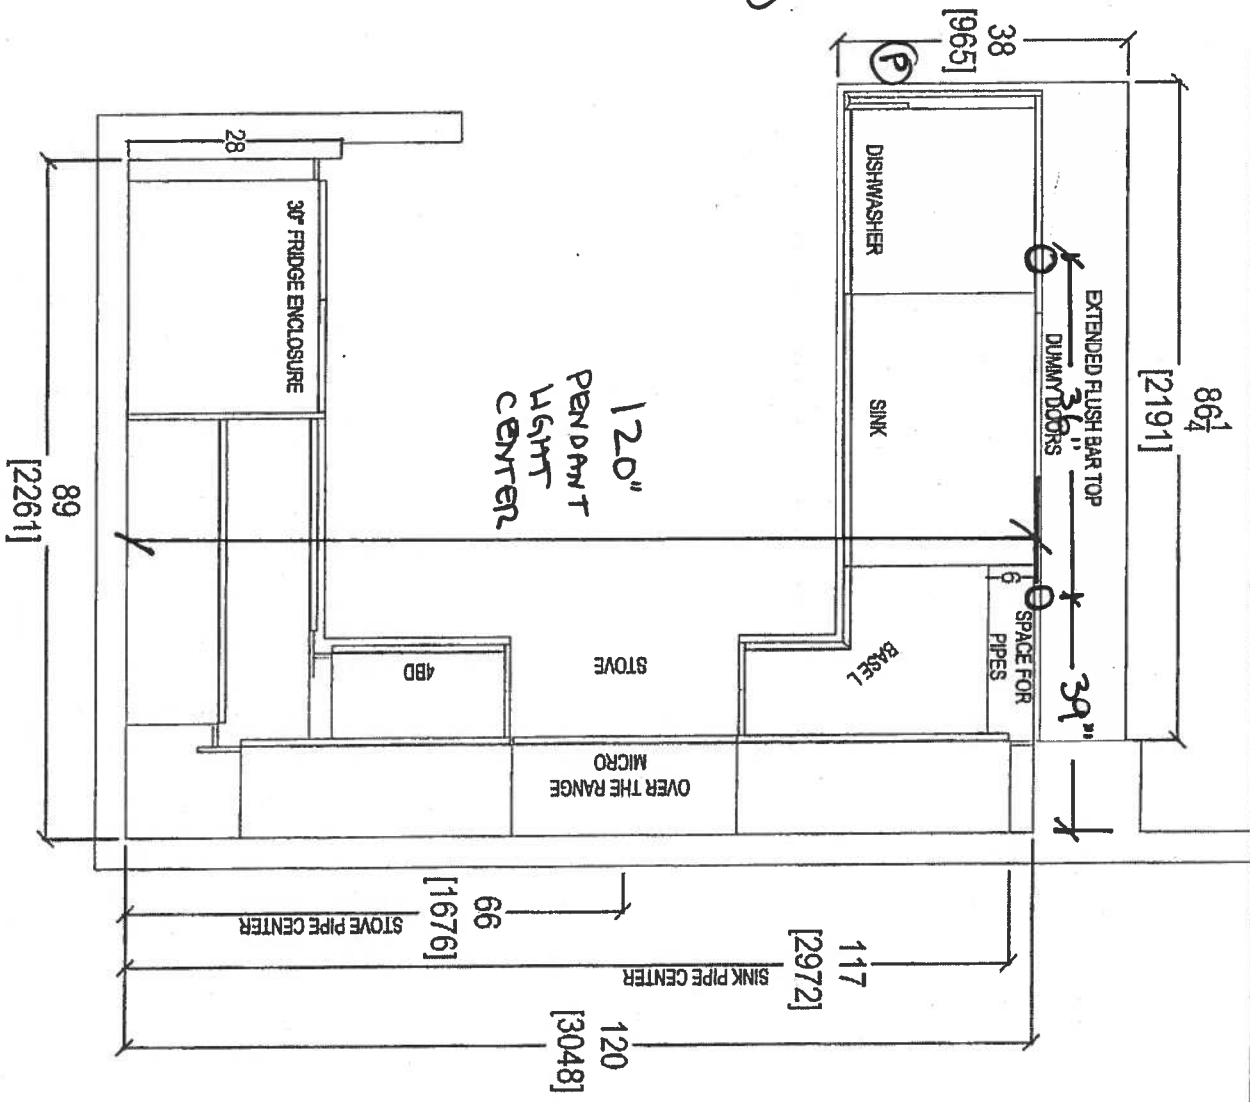

RECEIVED  
1 AUG 17 2017

CLIENT: ROYAL PINE HOMES

JOB NAME: 2D-P

ROOM: KITCHEN FLOOR PLAN

DRAWN BY: SK

COMMENTS:

SITE: HAMPTON PLACE

DOOR STYLE: —

DOOR HANDLE: —

SCALE: 1/2" = 1' - 0"

PLEASE NOTE ALL DIMENSIONS ARE NOT FINAL AND ARE SUBJECT TO CHANGE UPON FINAL SITE MEASURE

PHONE: —

FINISH: —

DRW HANDLE: —

DATE: AUG 4, 2017

EMAIL: —



SPECIES: —

TOP: —

PAGE: —



80 SANTE DRIVE, VAUGHAN, ONT L4K 3C4,  
T: 416.740.1811 F: 416.740.1812

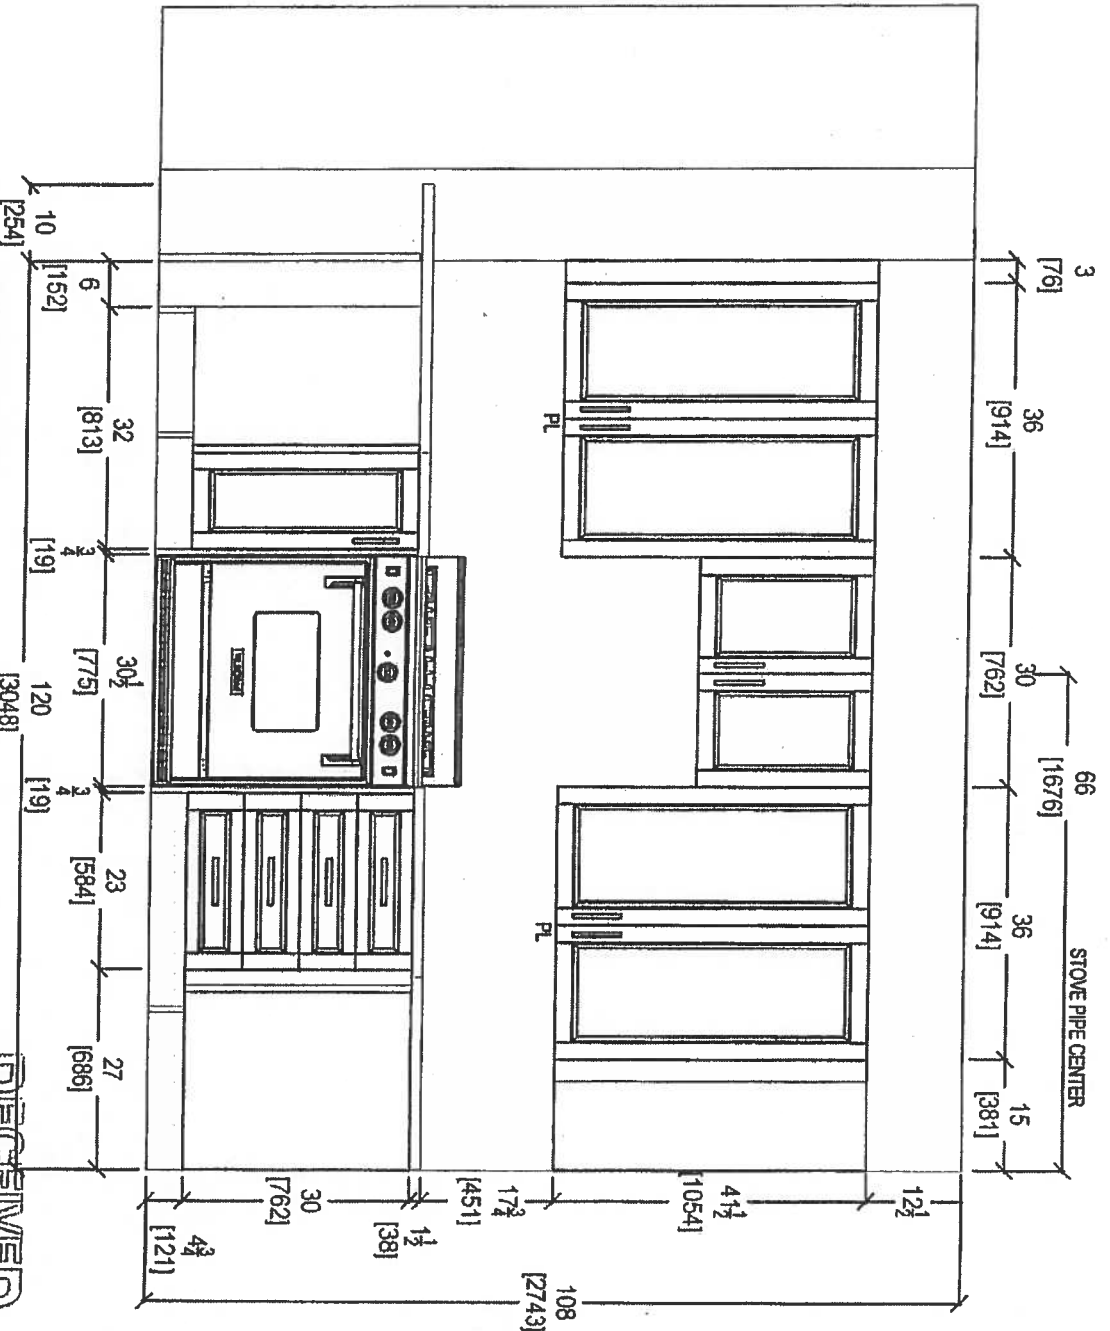
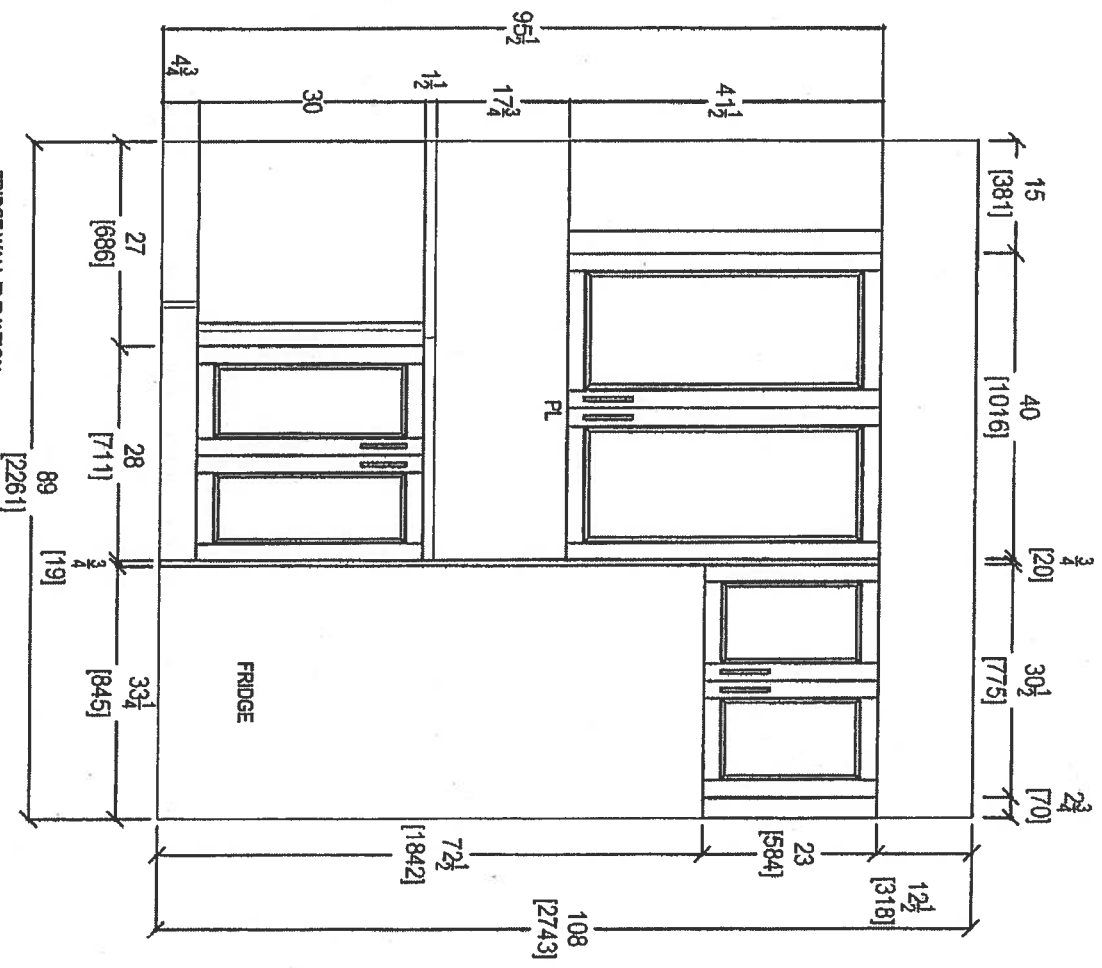


RECEIVED  
RAC 1172

|                          |                |                |                     |
|--------------------------|----------------|----------------|---------------------|
| CLIENT: ROYAL PINE HOMES | JOB NAME: 2D-P | ROOM: KITCHEN  | DRAWN BY: SK        |
| SITE: HAMPTON PLACE      | DOOR STYLE: —  | DOOR HANDLE: — | SCALE: 1/2" = 1'-0" |
| PHONE: —                 | FINISH: —      | DRW HANDLE: —  | DATE: AUG 4, 2017   |
| EMAIL: —                 | SPECIES: —     | TOP: —         | PAGE: —             |

**QTK**  
your kitchen, your time.  
80 SANTE DRIVE, VAUGHAN, ONT. L4K 3C4,  
T: 416.746.1611 F: 416.746.1612

PLEASE NOTE ALL DIMENSIONS  
ARE NOT FINAL AND ARE  
SUBJECT TO CHANGE UPON  
FINAL SITE MEASURE

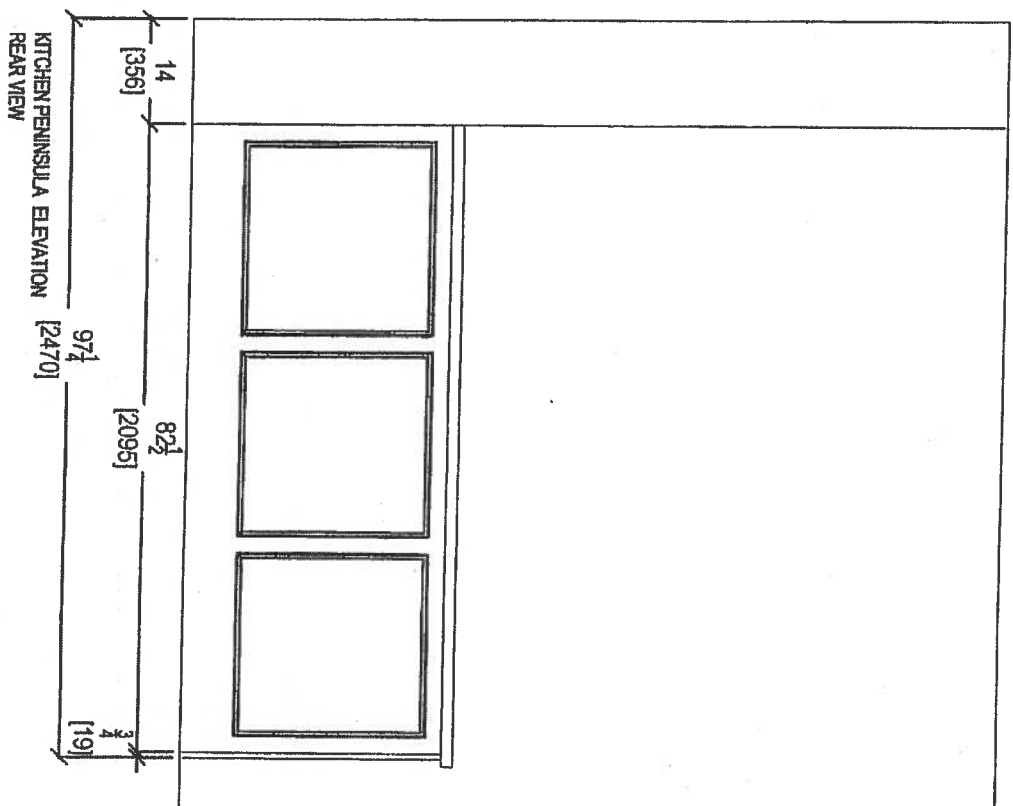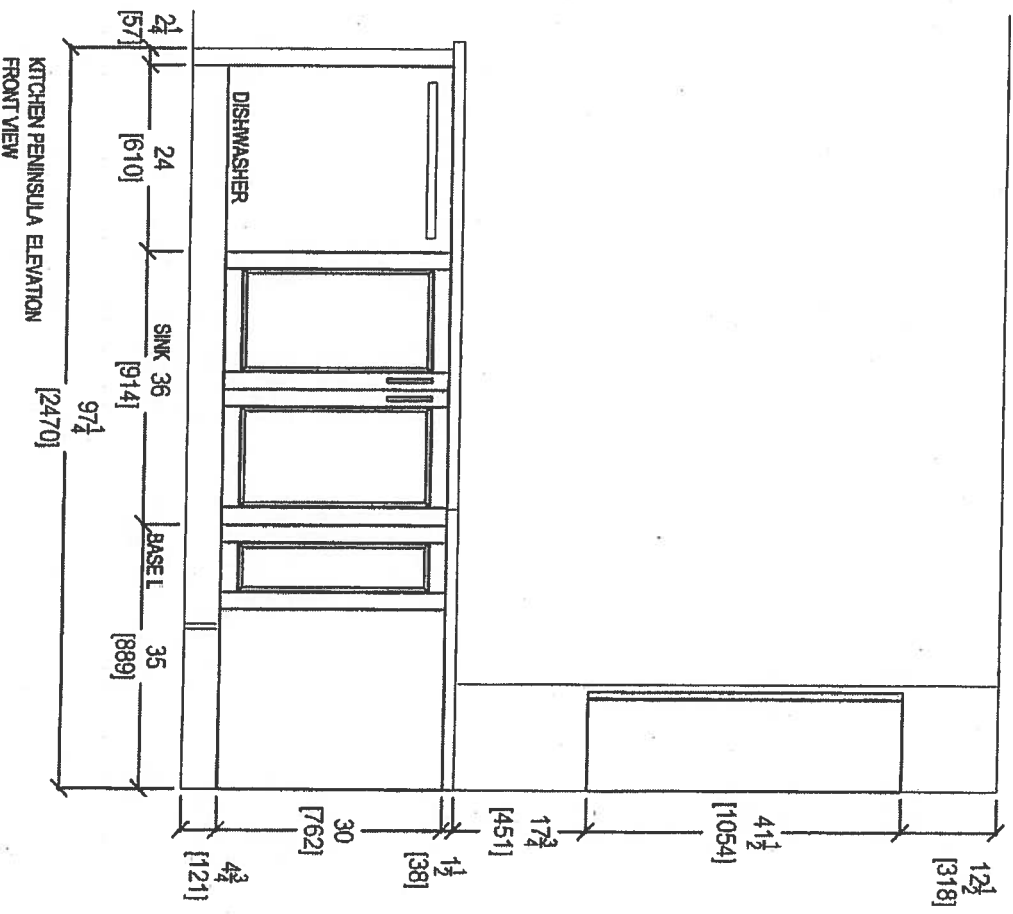


80 SANTE DRIVE, VAUGHAN, ON L4K 3C4,  
T: 416.748.1811 F: 416.748.1801


|                          |                |                |                     |
|--------------------------|----------------|----------------|---------------------|
| CLIENT: ROYAL PINE HOMES | JOB NAME: 2D-P | ROOM: KITCHEN  | DRAWN BY: SK        |
| SITE: HAMPTON PLACE      | DOOR STYLE: —  | DOOR HANDLE: — | SCALE: 1/2" = 1'-0" |
| PHONE: —                 | FINISH: —      | DRW HANDLE: —  | DATE: AUG 4, 2017   |
| EMAIL: —                 | SPECIES: —     | TOP: —         | PAGE: —             |

RECEIVED  
Rev. C. 17



COMMENTS:  
PLEASE NOTE ALL DIMENSIONS  
ARE NOT FINAL AND ARE  
SUBJECT TO CHANGE UPON  
FINAL SITE MEASURE

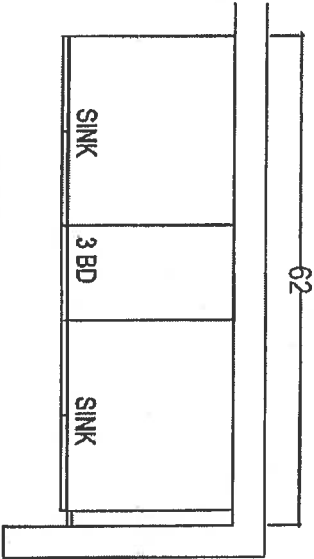

MASTER ENSUITE

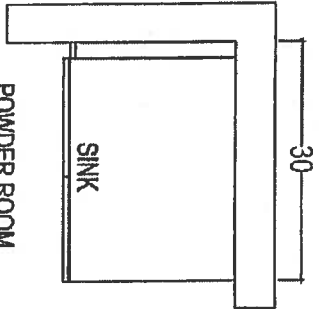

POWDER ROOM

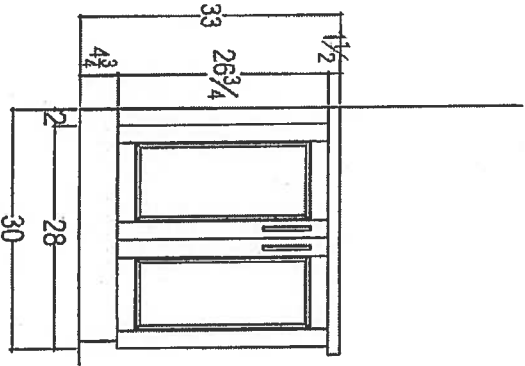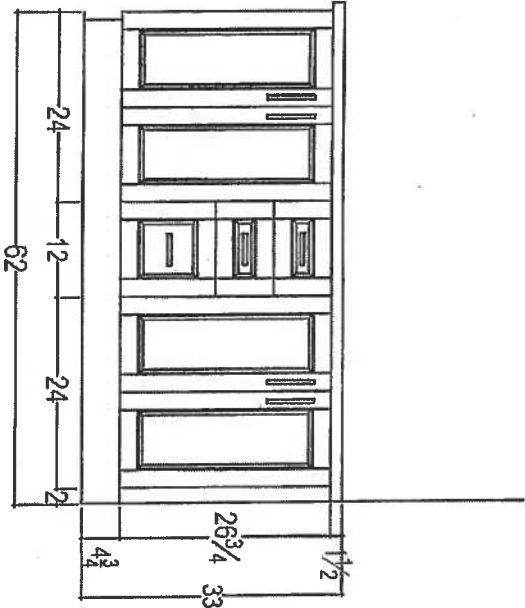

RECEIVED  
12/28/17

CLIENT: ROYAL PINE HOMES

JOB NAME: 2D-P

ROOM: VANITIES

DRAWN BY: SK

COMMENTS:

SITE: HAMPTON PLACE

DOOR STYLE: —

DOOR HANDLE: —

SCALE: 1/2" = 1'-0"

PLEASE NOTE ALL DIMENSIONS  
ARE NOT FINAL AND ARE  
SUBJECT TO CHANGE UPON  
FINAL SITE MEASURE

PHONE: —

FINISH: —

DRAW HANDLE: —

DATE: AUG 4, 2017

EMAIL: —

SPECIES: —

TOP: —


PAGE: —



80 SANTE DRIVE, VAUGHAN, ONTARIO  
T: 416.746.1811 F: 416.746.1811

SUITE # 317 (INVENTORY)  
OPTIONAL  
UPG #1 - KITCHEN LAYOUT  
WITH UPG #1 APPLIANCE  
PACKAGE

- (P) - PLUG PENINSULA
- (5x) - PUCK LIGHTS (3x ARE STD)
- (2x) - PENDANT LIGHTS UPG  
OVER PENINSULA

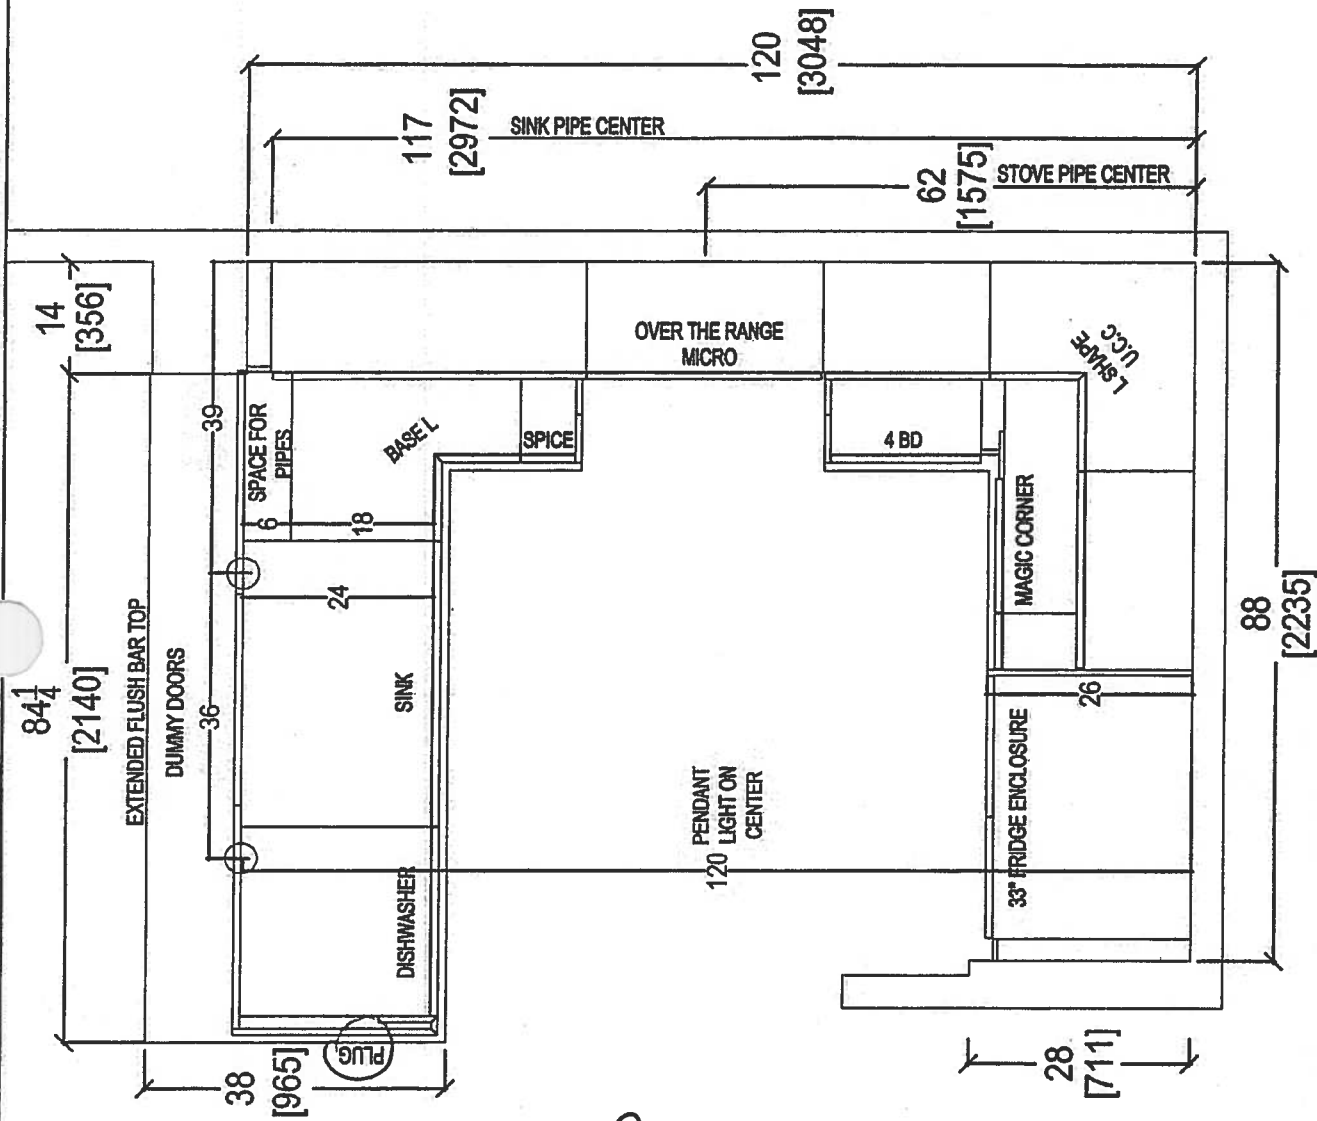

80 SANTE DRIVE, VAUGHAN, ON L4K 3C4,  
T: 416.746.1811 F: 905.761.5901

CLIENT: ROYAL PINE HOMES

SITE: HAMPTON PLACE

PHONE: --

EMAIL: --

JOB NAME: UNIT 317 HMP

DOOR STYLE: --

FINISH: --

SPECIES: --

ROOM: KITCHEN

DOOR HANDLE: --

DRW HANDLE: --

TOP: --

DRAWN BY: SK



SCALE: 1/2" = 1'-0"

DATE: FEB 13, 2018

PAGE: --


COMMENTS:

PLEASE NOTE ALL DIMENSIONS  
ARE NOT FINAL AND ARE  
SUBJECT TO CHANGE UPON  
FINAL SITE MEASURE

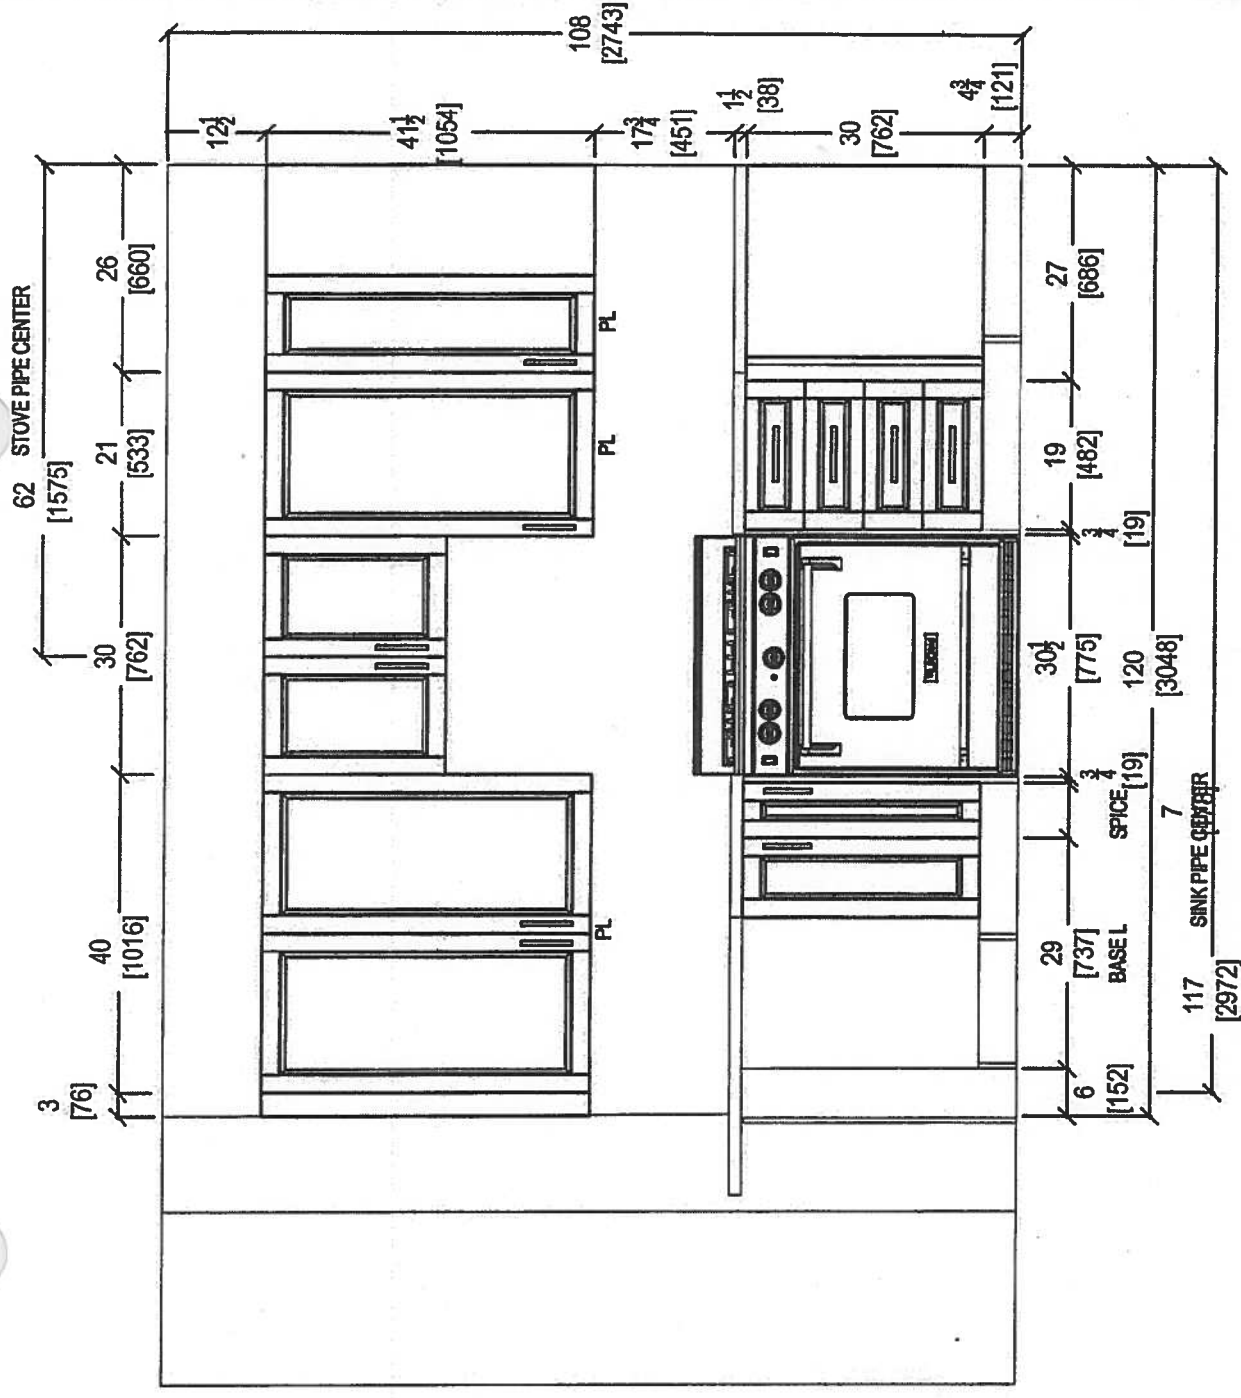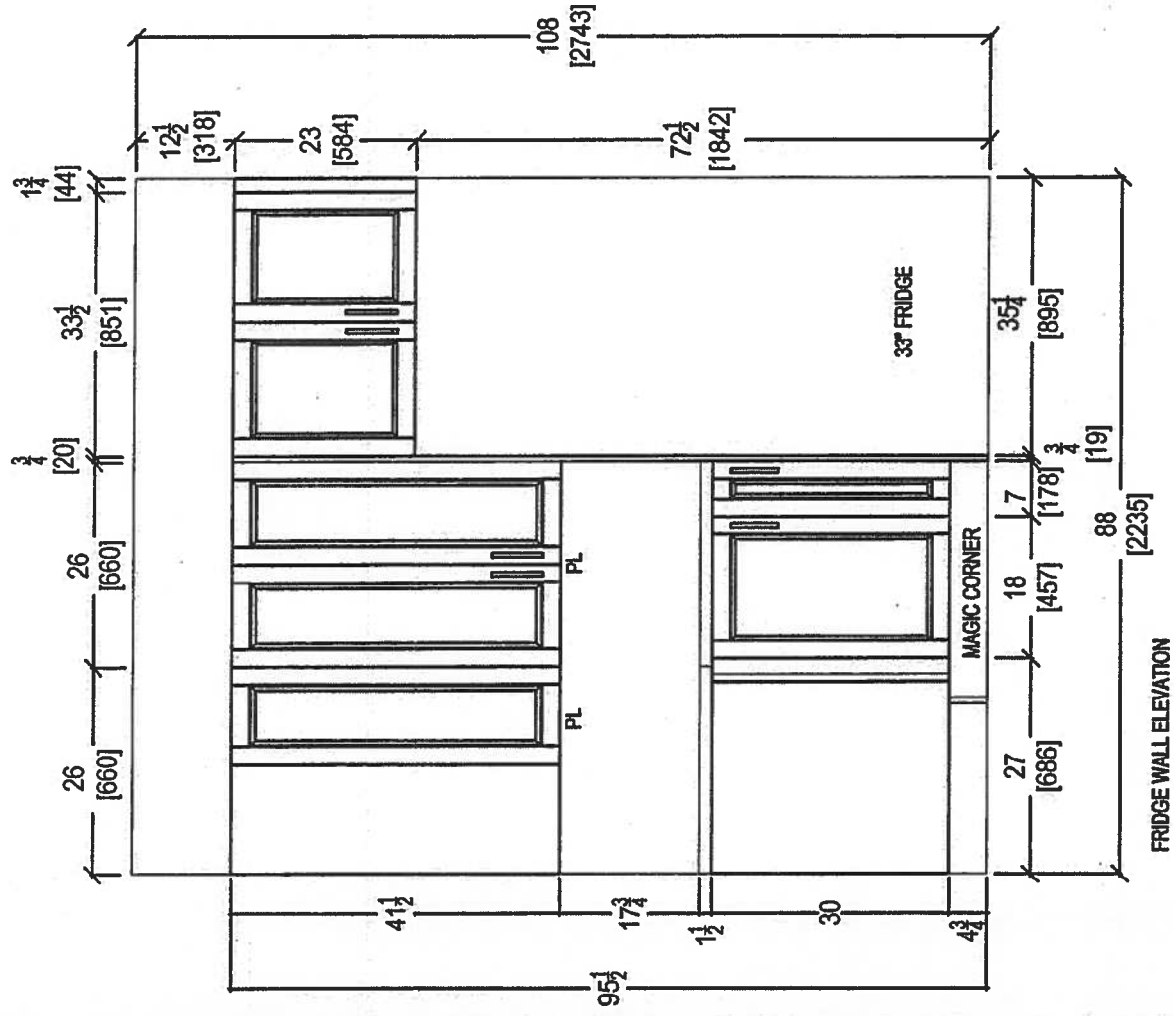


|                                                                                                                                                                                                               |                          |                        |                |                       |                                                                                                                                |
|---------------------------------------------------------------------------------------------------------------------------------------------------------------------------------------------------------------|--------------------------|------------------------|----------------|-----------------------|--------------------------------------------------------------------------------------------------------------------------------|
|  <p><i>your kitchen, your taste.</i></p> <p>80 SANTE DRIVE, VAUGHAN, ON L4K 3C4,<br/>T: 416.746.1811 F: 905.761.5801</p> | CLIENT: ROYAL PINE HOMES | JOB NAME: UNIT 317 HMP | ROOM: KITCHEN  | DRAWN BY: SK          | <p>COMMENTS:</p> <p>PLEASE NOTE ALL DIMENSIONS<br/>ARE NOT FINAL AND ARE<br/>SUBJECT TO CHANGE UPON<br/>FINAL SITE MEASURE</p> |
|                                                                                                                                                                                                               | SITE: HAMPTON PLACE      | DOOR STYLE: —          | DOOR HANDLE: — | SCALE: 1/2" = 1' - 0" |                                                                                                                                |
|                                                                                                                                                                                                               | PHONE: —                 | FINISH: —              | DRW HANDLE: —  | DATE: FEB 13, 2018    |                                                                                                                                |
|                                                                                                                                                                                                               | EMAIL: —                 | SPECIES: —             | TOP: —         | PAGE: —               |                                                                                                                                |
|                                                                                                                                                                                                               |                          |                        |                |                       |                                                                                                                                |





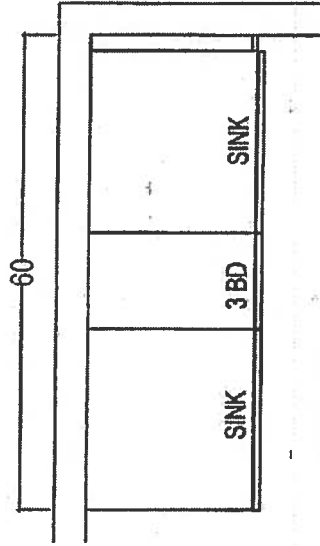

MASTER ENSUITE

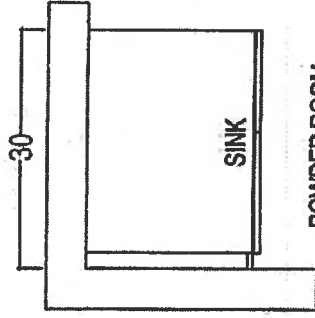

POWDER ROOM

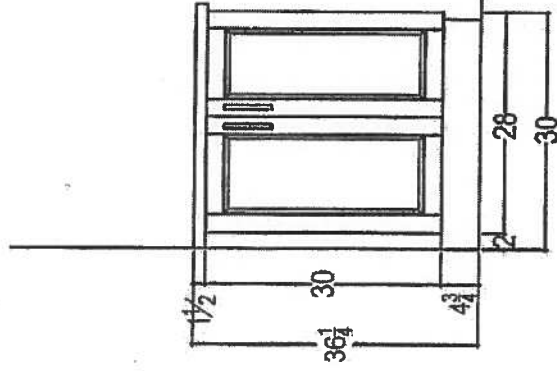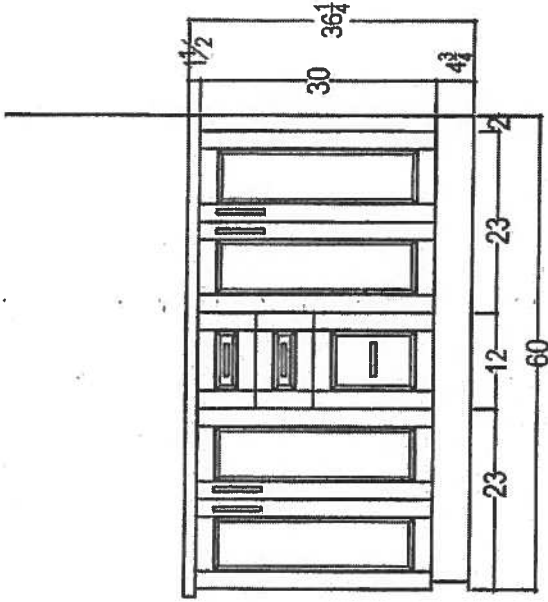

**OTK**  
Your kitchen, your taste.  
80 SANTE DRIVE, VAUGHAN, ON L4K 3C4,  
T: 416.748.1811 F: 905.761.5901

CLIENT: ROYAL PINE HOMES

SITE: HAMPTON PLACE

PHONE: —

EMAIL: —

JOB NAME: UNIT 317 HMP

DOOR STYLE: —

FINISH: —

SPECIES: —

ROOM:

VANITIES

SCALE: 1/2" = 1' - 0"

DATE: FEB 14, 2018

PAGE: —

COMMENTS:

PLEASE NOTE ALL DIMENSIONS  
ARE NOT FINAL AND ARE  
SUBJECT TO CHANGE UPON  
FINAL SITE MEASURE