



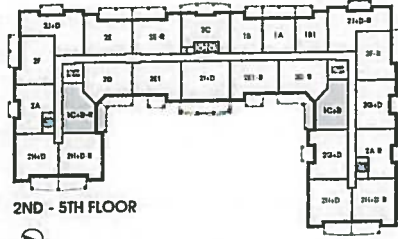

Sag Harbor

878 SQ FT plus 119 sq. ft. of balcony area

ORIGINAL Suite
Suite 412

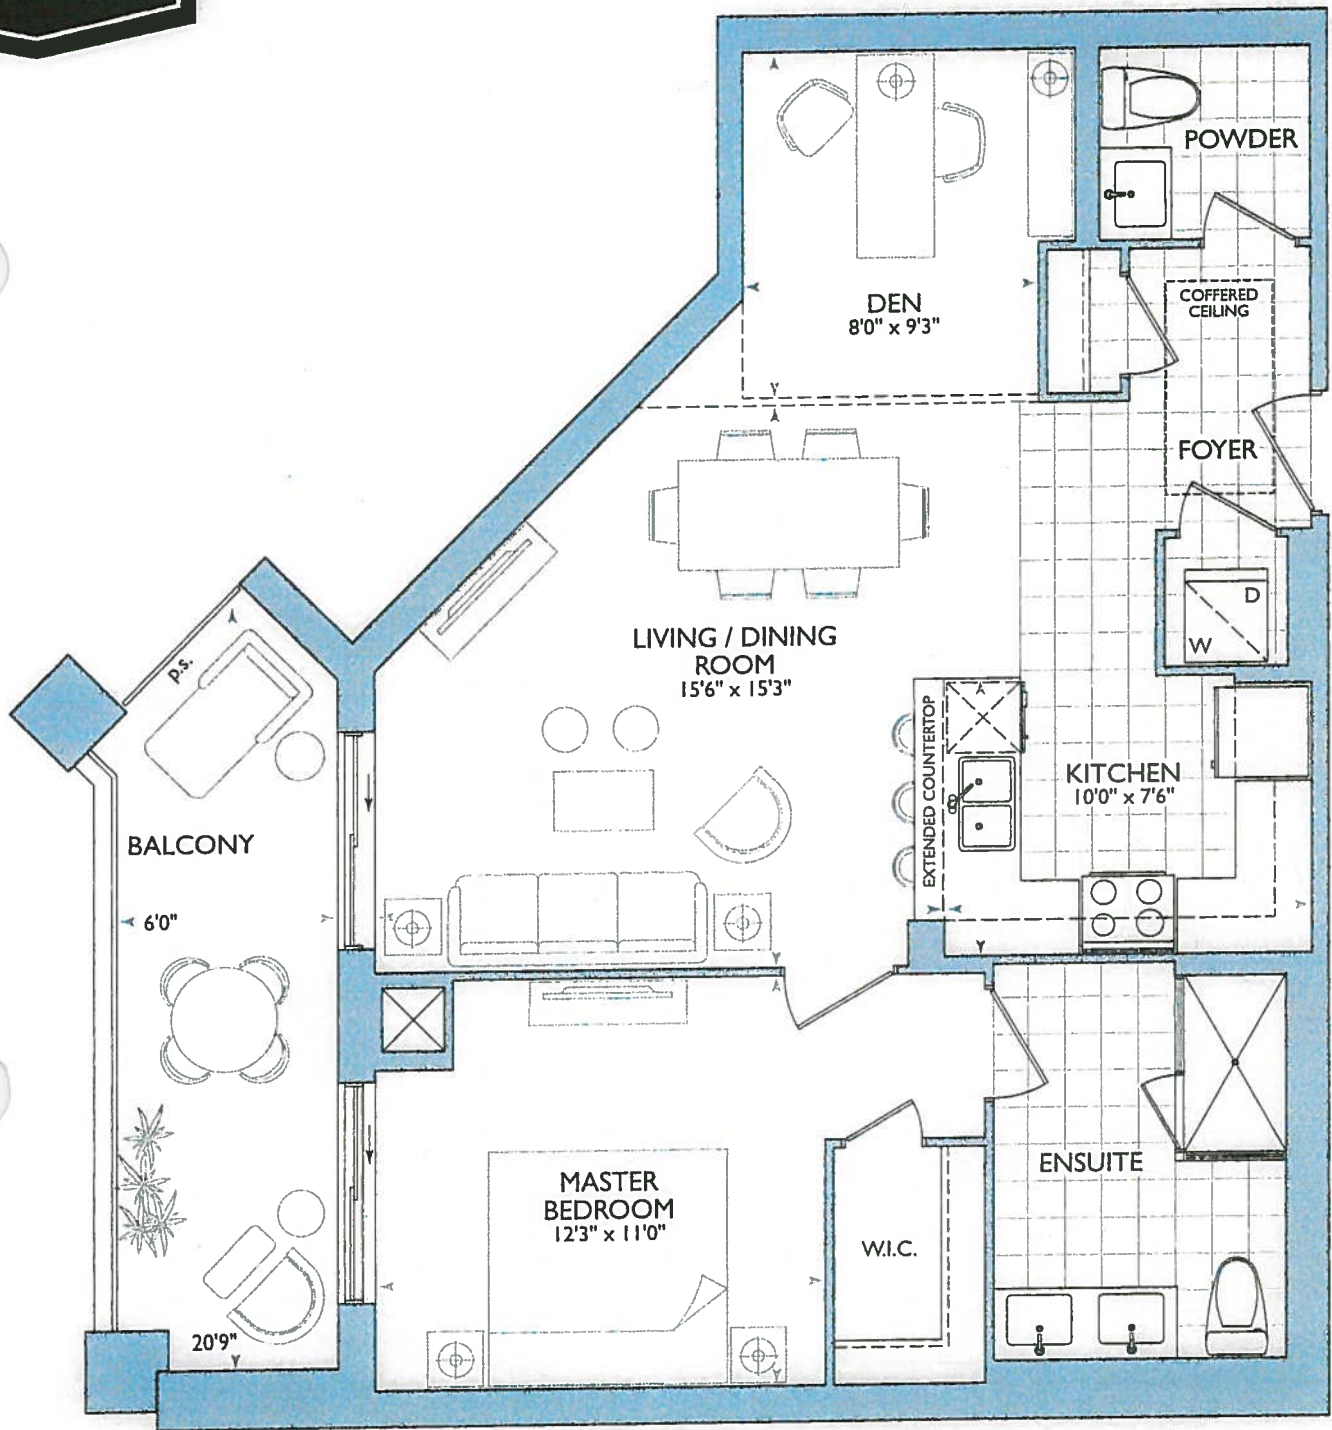

SAG HARBOUR: 412

- MOVE FRONT DOOR (FOR 6" WALL BEHIND WASHER/ DRYER)

Suite 412 - Inventory Suite

* Move Front Door - Due to 6" wall added behind w/d.

KITCHEN

• Option of using std kitchen layout w std appliance package.

OR

• 1st upgrade kitchen layout w 1st upg appliance package


(P) = Plug Peninsula

2x = Pendant Lights

(see both kitchen layout options)

• 66" stove pipe center



• 117" sink pipe center

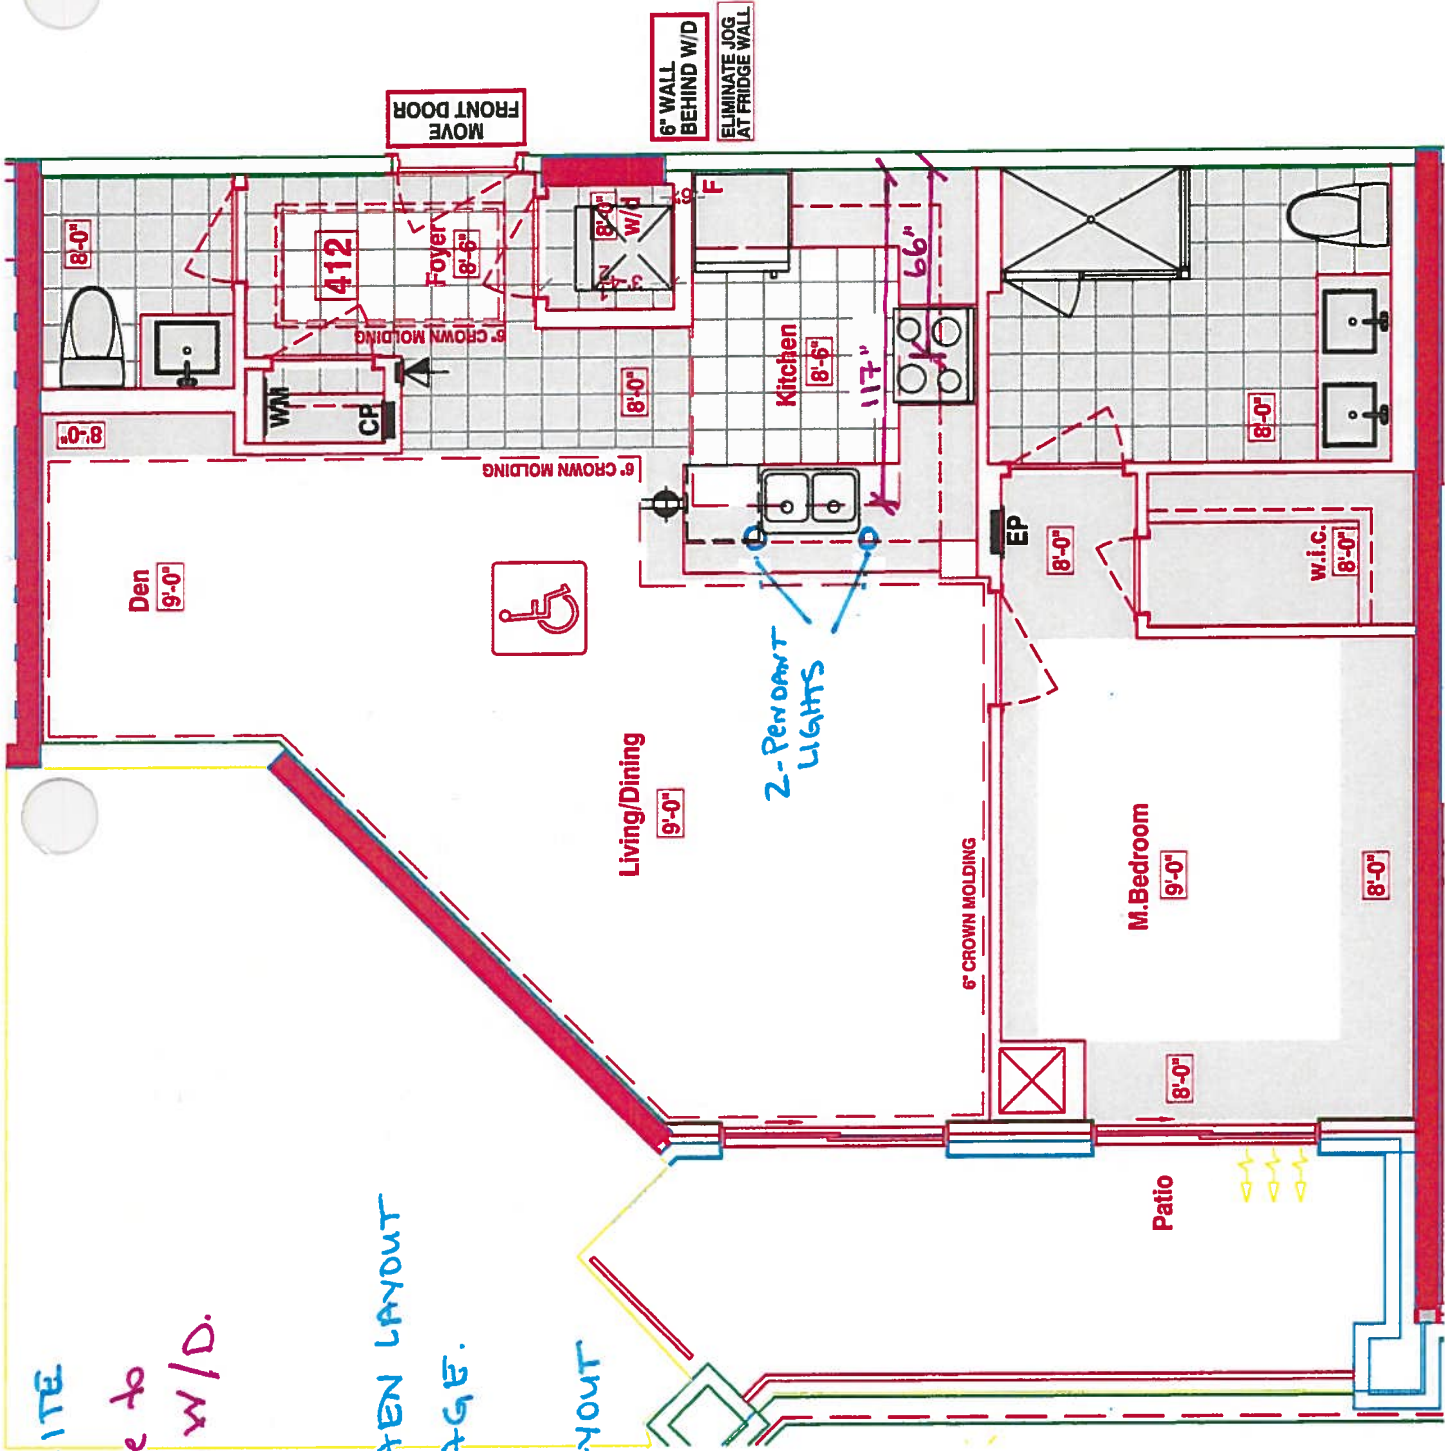

- STO KITCHEN LAYOUT
- STO APPLIANCE PACKAGE
- $\textcircled{P}$ = Plug Peninsula.
- 3x = Truck Lights
- 2x = Pendant Lights.



 your kitchen		80 SANTE DRIVE, VICTORIA T: 416 746 1811 ON L4K 3C4 761 5901	
CLIENT: ROYAL PINE HOMES	1C+D SAG HARBOR		ROOM: KITCHEN FLOOR PLAN
SITE: HAMPTON PLACE	DOOR STYLE: —	DOOR HANDLE: —	SCALE: 1/2" = 1' - 0"
PHONE: —	FINISH: —	DRW HANDLE: —	DATE: AUG 4, 2017
EMAIL: —	SPECIES: —	TOP: —	PAGE: —
COMMENTS: PLEASE NOTE ALL DIMENSIONS ARE NOT FINAL AND ARE SUBJECT TO CHANGE UPON FINAL SITE MEASURE			

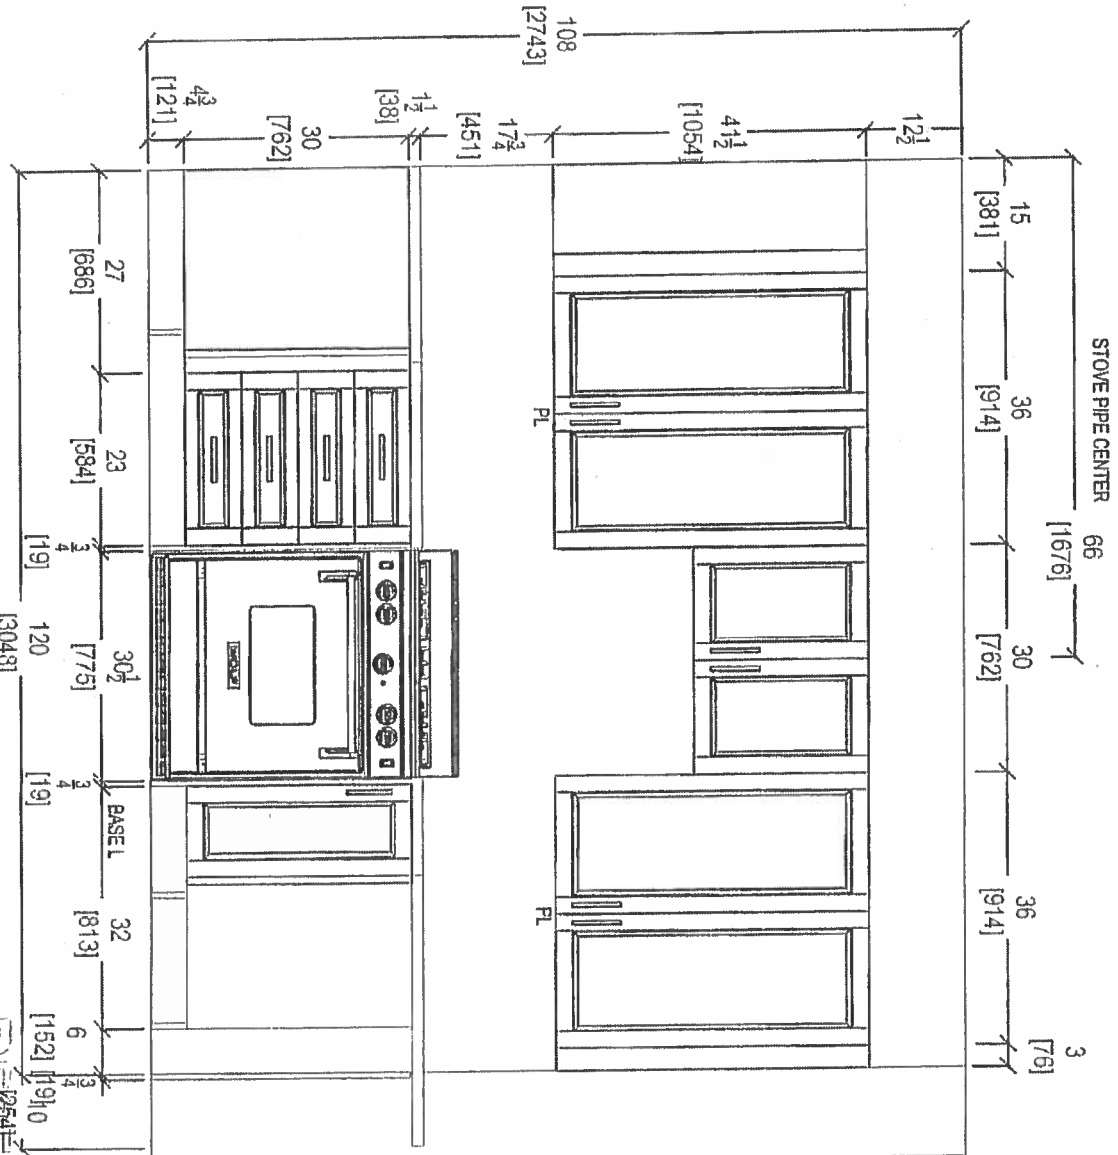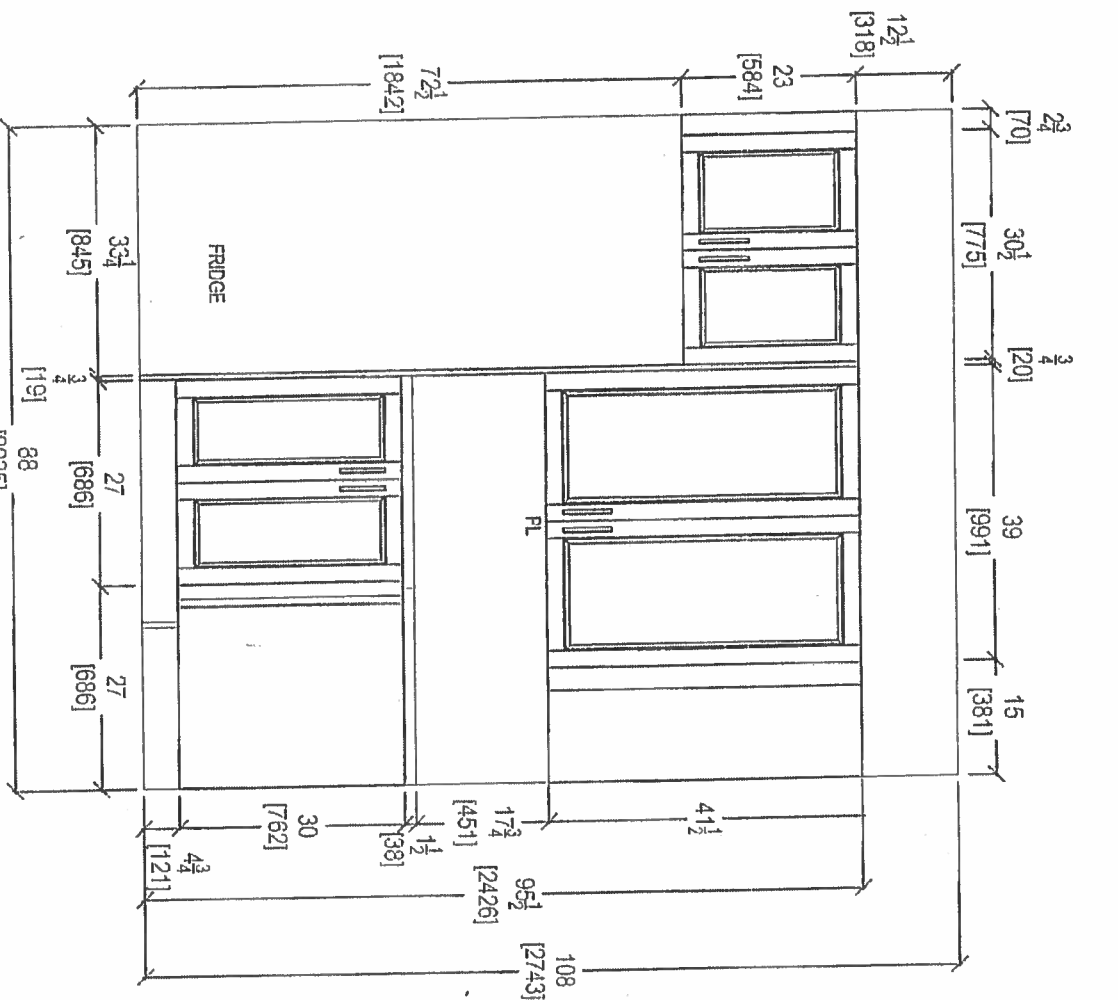


RECEIVED
 08/04/17
 08/04/17

CLIENT: ROYAL PINE HOMES		1C+D SAG HARBOR		ROOM: KITCHEN		DRAWN BY: SK		COMMENTS:	
SITE: HAMPTON PLACE		DOOR STYLE: —		DOOR HANDLE: —		SCALE: 1/2" = 1' - 0"		PLEASE NOTE ALL DIMENSIONS ARE NOT FINAL AND ARE SUBJECT TO CHANGE UPON FINAL SITE MEASURE	
PHONE: —		FINISH: —		DRAW HANDLE: —		DATE: AUG 4, 2017			
EMAIL: —		SPECIES: —		TOP: —		PAGE: —			



80 SANTE DRIVE, VALENTIA, QLD 4070
 T: 416 746 1800

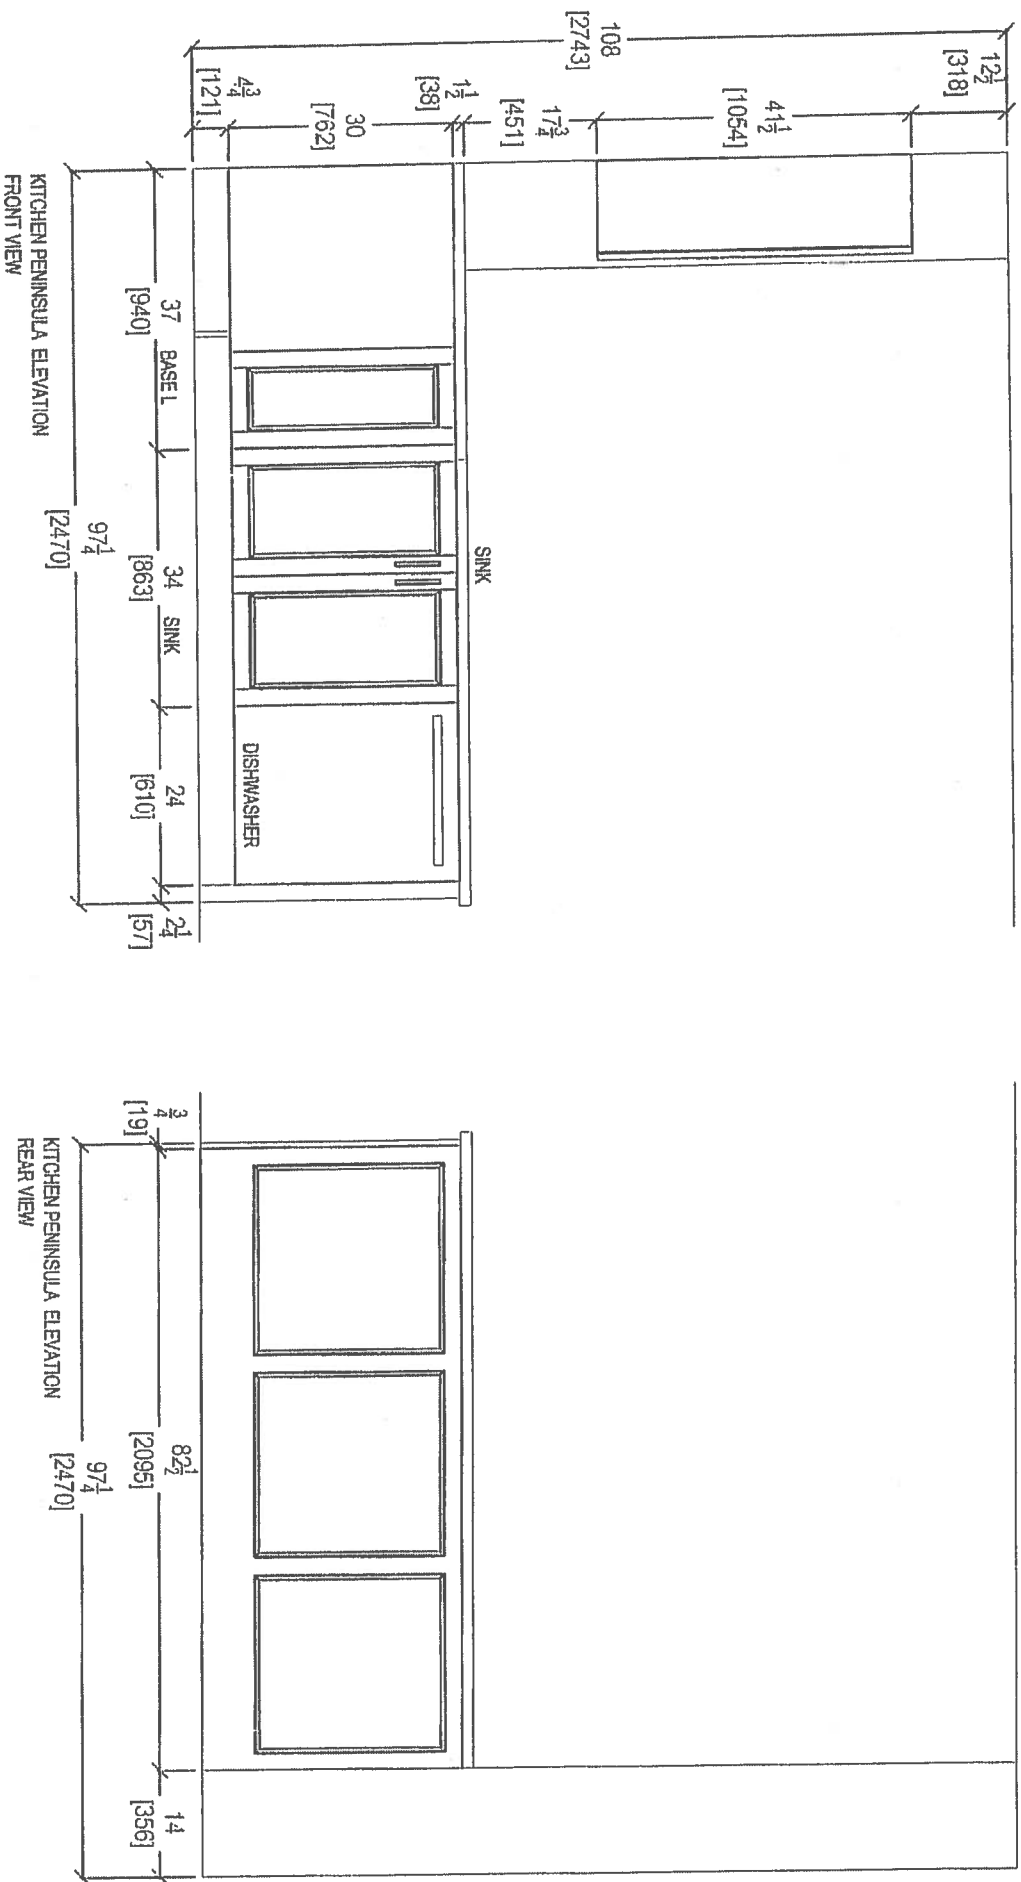


80 SANTE DRIVE, VA
T: 416.746.18


ON L4K 3C4,
61 5901

CLIENT: ROYAL FINE HOMES		1C+D SAG HARBOR		ROOM: KITCHEN	DRAWN BY: SK
SITE: HAMPTON PLACE	DOOR STYLE: —	DRW HANDLE: —	SCALE: 1/2" = 1'-0"	COMMENTS:	
PHONE: —	FINISH: —	DATE: AUG 4, 2017			
EMAIL: —	SPECIES: —	PAGE: —			



RECEIVED
R
17

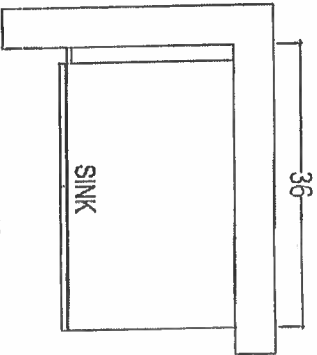

POWDER ROOM

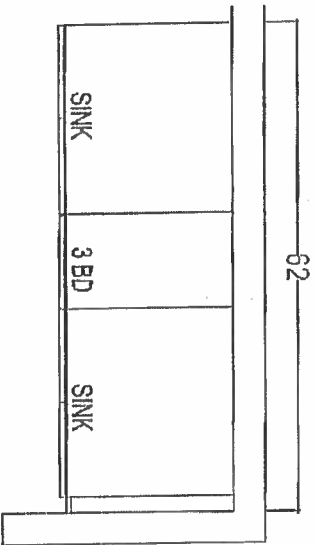

MASTER ENSUITE

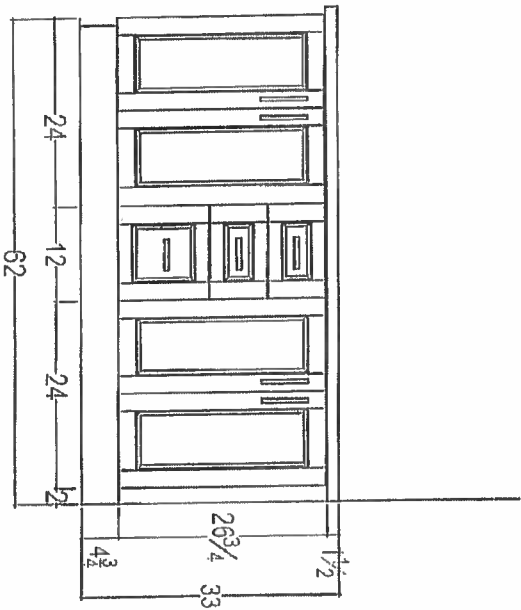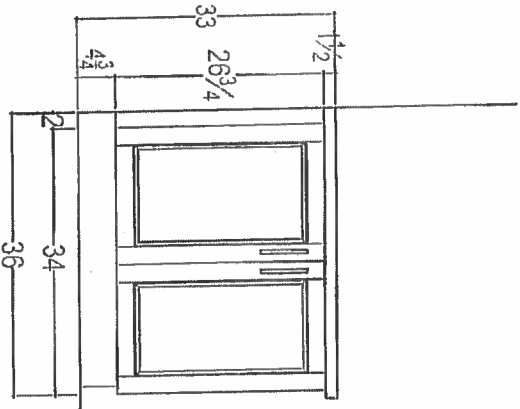

RECEIVED
11-28-18

CLIENT: ROYAL PINE HOMES

1C+D SAG HARBOR

ROOM

VANITIES

DRAWN BY: SK

COMMENTS:

SITE: HAMPTON PLACE

DOOR STYLE: —

DOOR HANDLE: —

SCALE: 1/2" = 1'-0"

PHONE: —

FINISH: —

DRW HANDLE: —

DATE: AUG 4, 2017

EMAIL: —

SPECIES: —

TOP: —

PAGE: —


PLEASE NOTE ALL DIMENSIONS
ARE NOT FINAL AND ARE
SUBJECT TO CHANGE UPON
FINAL SITE MEASURE



80 SANTE DRIVE, VAU
T. 476 746 1811 F. 476 751 5901

N LAK 3C4

- UPG #1 - KITCHEN LAYOUT
- UPG #1 - APPLIANCE PACKAGE
- (P) = PLUG PENINSULA
- 5x = PUCK LIGHTS
- 2x = PENDANT LIGHTS.


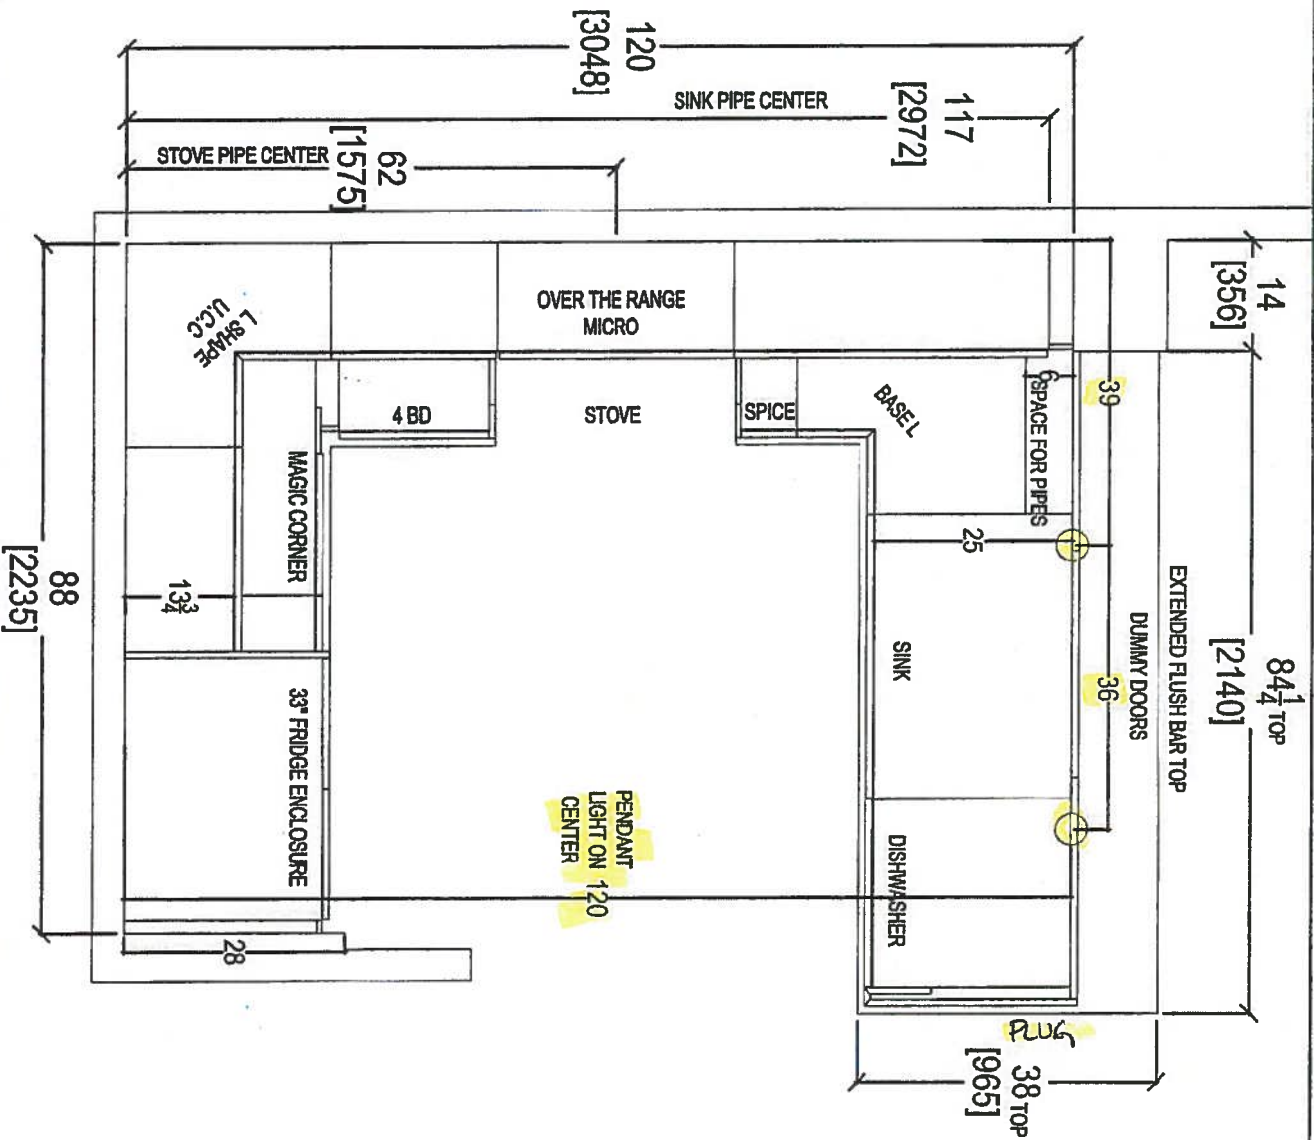


CLIENT: ROYAL PINE HOMES	UNIT: 412 HMP	ROOM: KITCHEN FLOOR PLAN	DRAWN BY: SK
SITE: HAMPTON PLACE	DOOR STYLE: --	DOOR HANDLE: --	SCALE: 1/2" = 1' - 0"
PHONE: --	FINISH: --	DRW HANDLE: --	DATE: FEB 16, 2018
EMAIL: --	SPECIES: --	TOP: --	PAGE: --



80 SANTE DRIVE, VAUGHAN, ONT. L4K 3C4,
T: 416.746.1811 F: 516.5901


COMMENTS:
PLEASE NOTE ALL DIMENSIONS
ARE NOT FINAL, AND ARE
SUBJECT TO CHANGE UPON
FINAL SITE MEASURE

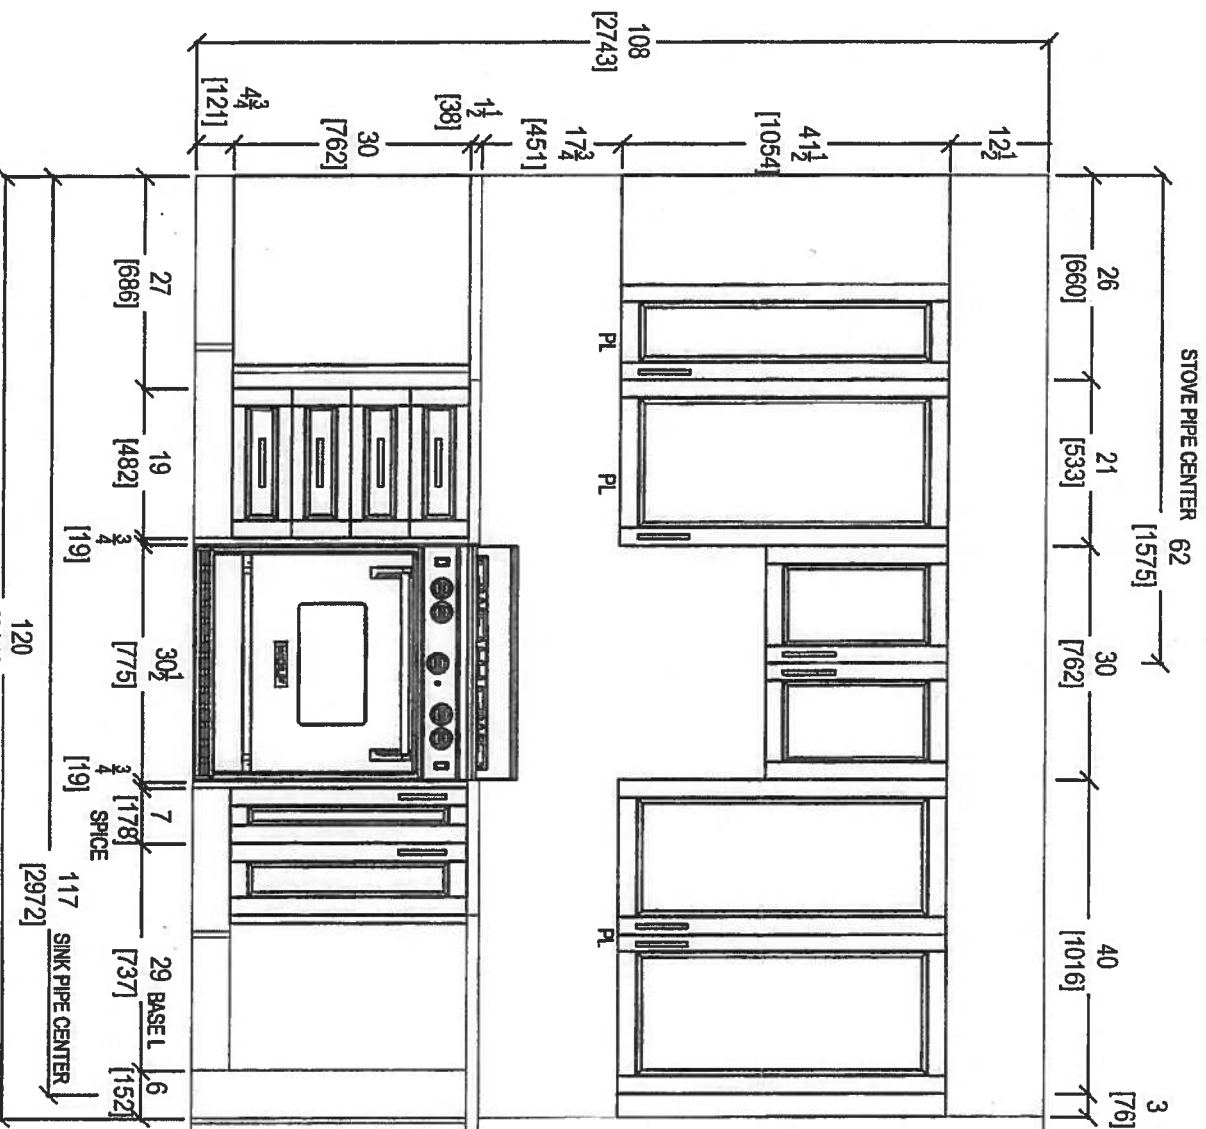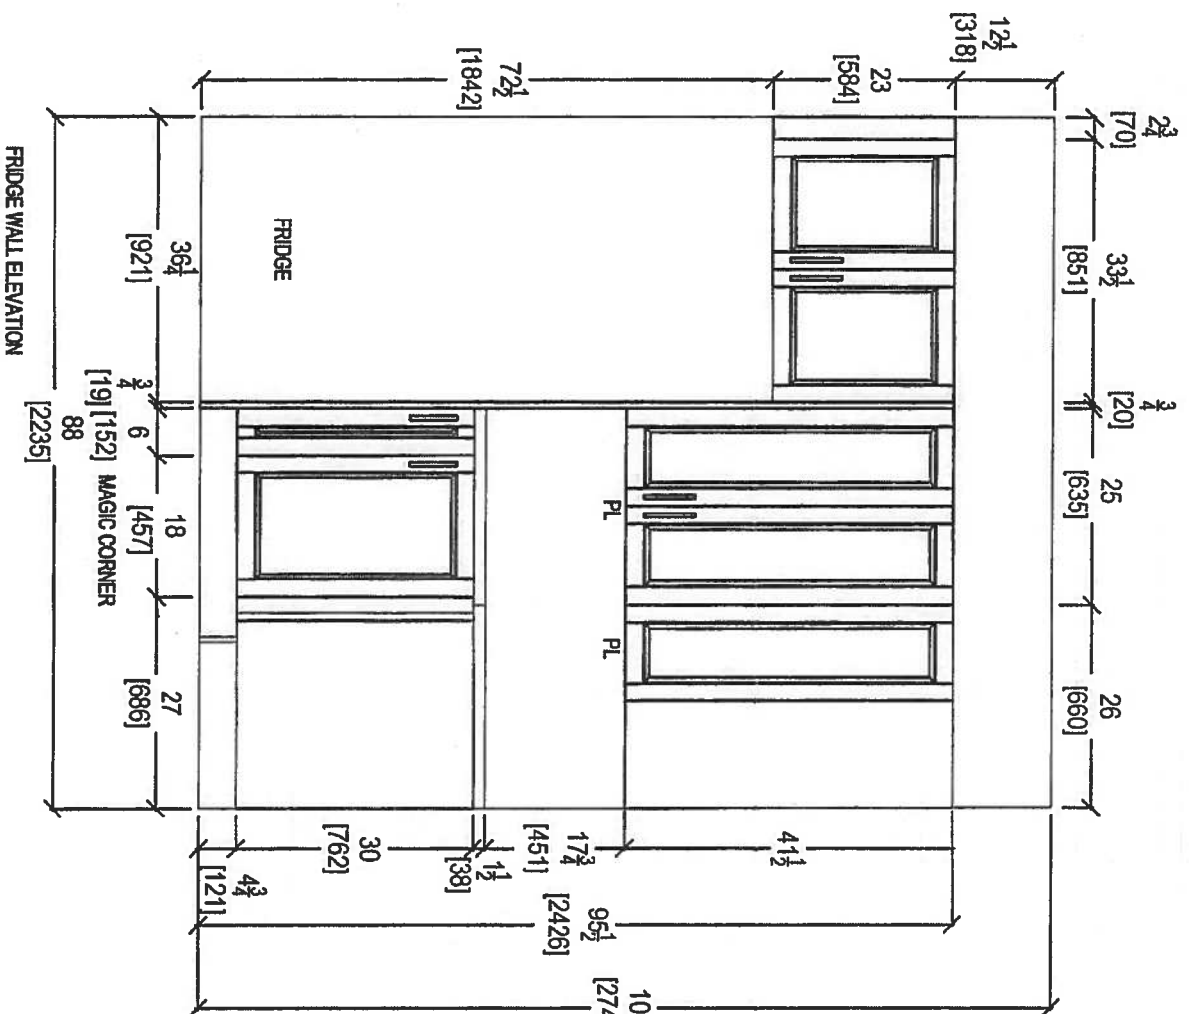


your kitchen,
80 SANTE DRIVE, VAUGHAN,
T: 416.746.1811 F: 905.479.3801

CLIENT: ROYAL PINE HOMES	UNIT 412 HMP	ROOM: KITCHEN	DRAWN BY: SK
SITE: HAMPTON PLACE	DOOR STYLE: —	DOOR HANDLE: —	SCALE: 1/2" = 1' - 0"
PHONE: —	FINISH: —	DRW HANDLE: —	DATE: FEB 16, 2018
EMAIL: —	SPECIES: —	TOP: —	PAGE: —

PLEASE NOTE ALL DIMENSIONS
ARE NOT FINAL AND ARE
SUBJECT TO CHANGE UPON
FINAL SITE MEASURE

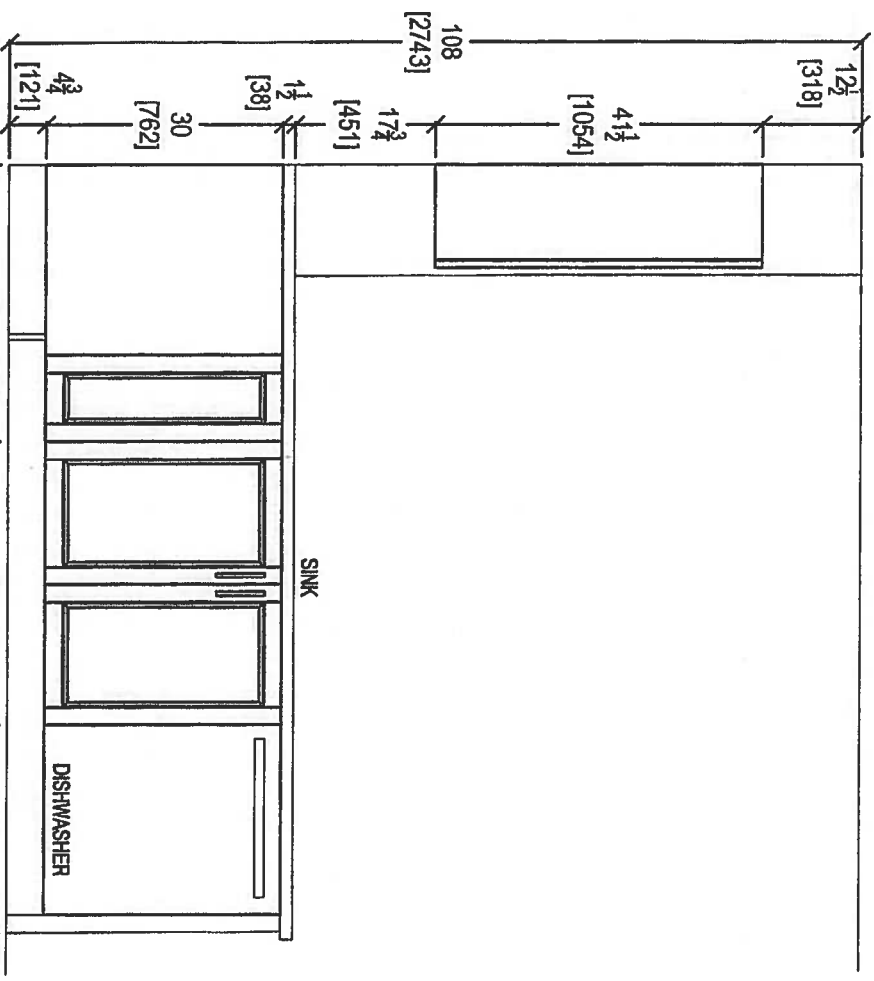

KITCHEN PENINSULA ELEVATION
FRONT VIEW

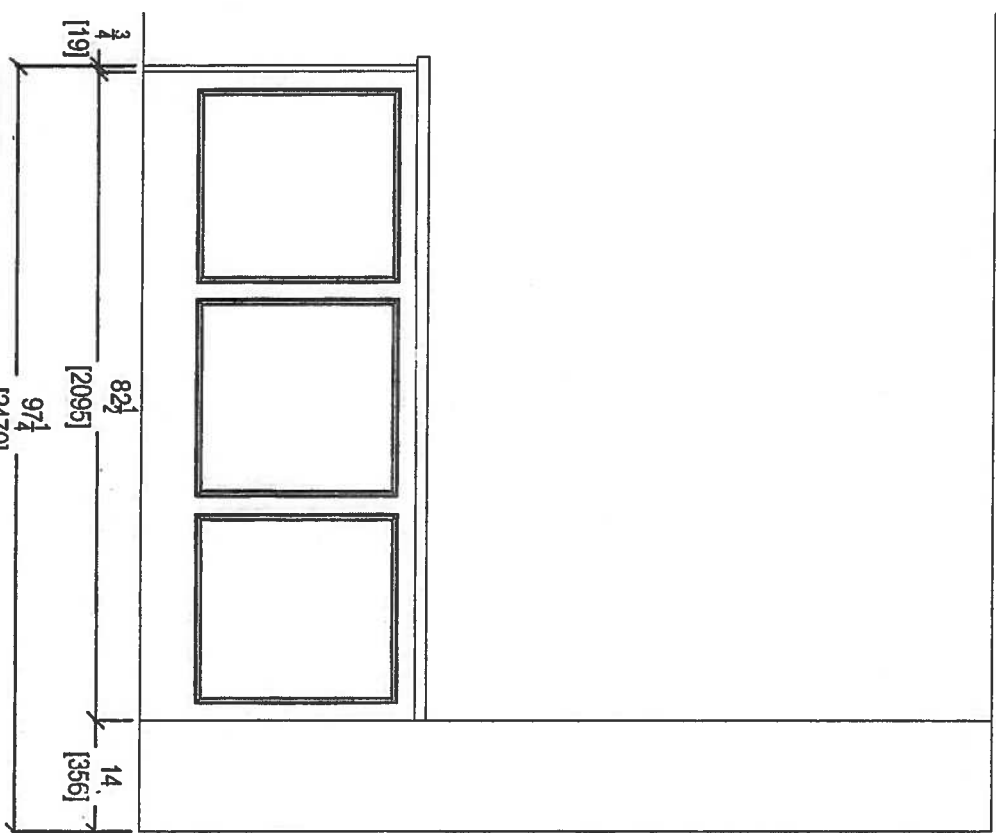


KITCHEN PENINSULA ELEVATION
REAR VIEW

CLIENT: ROYAL PINE HOMES	UNIT 412 HMP	ROOM: KITCHEN	DRAWN BY: SK
SITE: HAMPTON PLACE	DOOR STYLE: —	DOOR HANDLE: —	SCALE: 1/2" = 1' - 0"
PHONE: —	FINISH: —	DRW HANDLE: —	DATE: FEB 16 2018
EMAIL: —	SPECIES: —	TOP: —	PAGE: —


COMMENTS:





80 SANTE DRIVE, VAUGHAN, ONTARIO L4K 3C4,
T. 416.748.1811 F. 905.748.1391

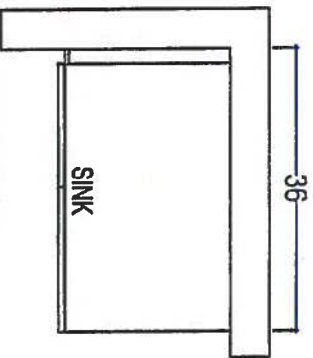

POWDER ROOM

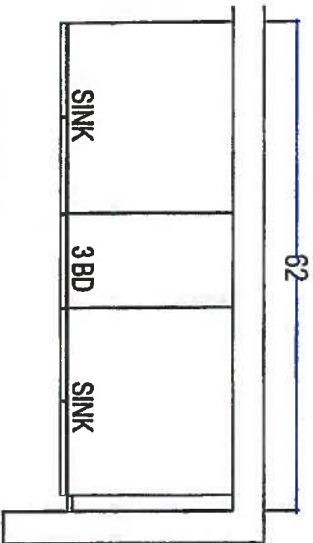

MASTER ENSUITE

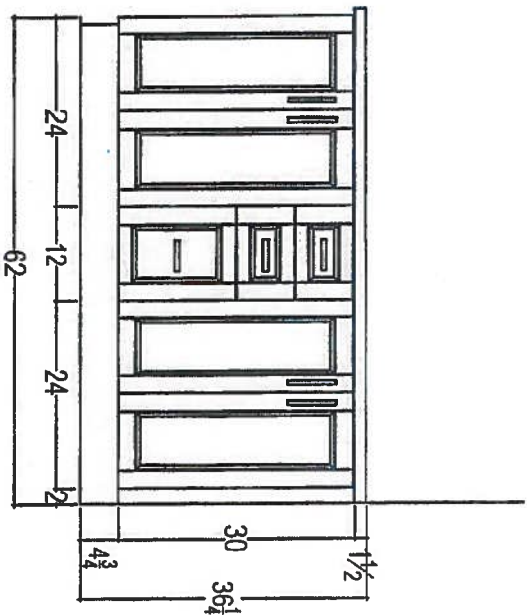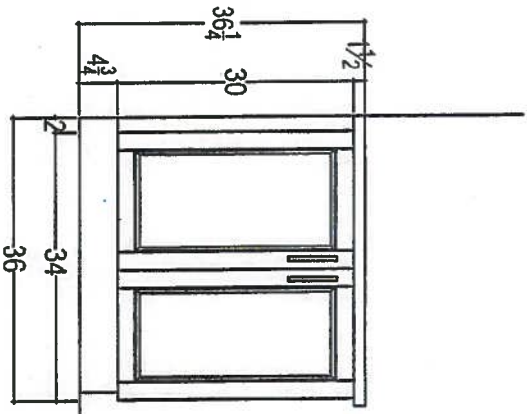

CLIENT: ROYAL PINE HOMES	UNIT 412 HMP	ROOM: VANITIES	DRAWN BY: SK
SITE: HAMPTON PLACE	DOOR STYLE:	DOOR HANDLE: —	SCALE: 1/2" = 1'-0"
PHONE: —	FINISH: —	DRW HANDLE: —	DATE: FEB 16, 2018
EMAIL: —	SPECIES: —	TOP: —	PAGE: —

COMMENTS:
PLEASE NOTE ALL DIMENSIONS
ARE NOT FINAL AND ARE
SUBJECT TO CHANGE UPON
FINAL SITE MEASURE



80 SANTE DRIVE, VAUGHAN, ONTARIO L4K 3C4,
T: 416.746.1811 F: 800.615.901