

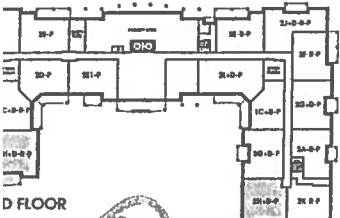


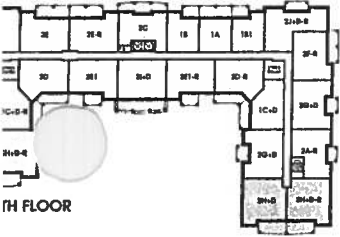

SUITE 414

Glen Cove ORIGINAL LAYOUT

1,162 SQ FT *plus 168 sq. ft. of balcony area*

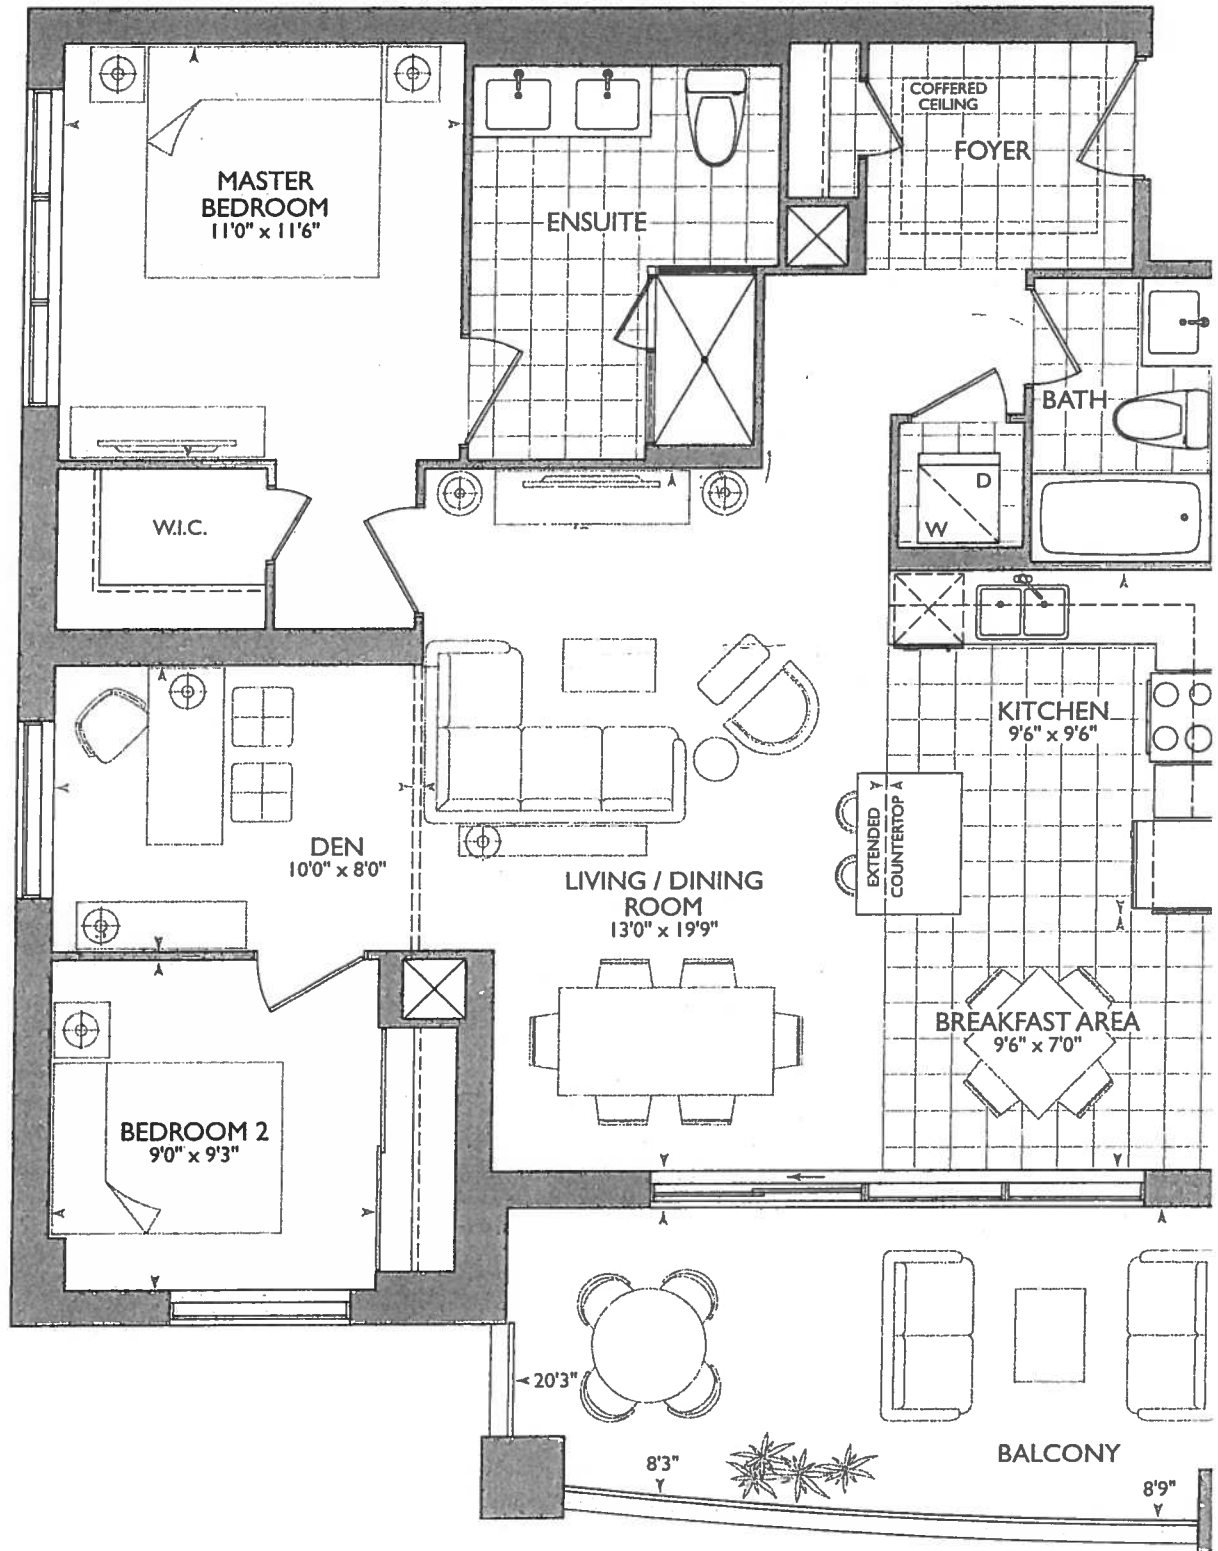


16

December 13, 2017

APL

WJ

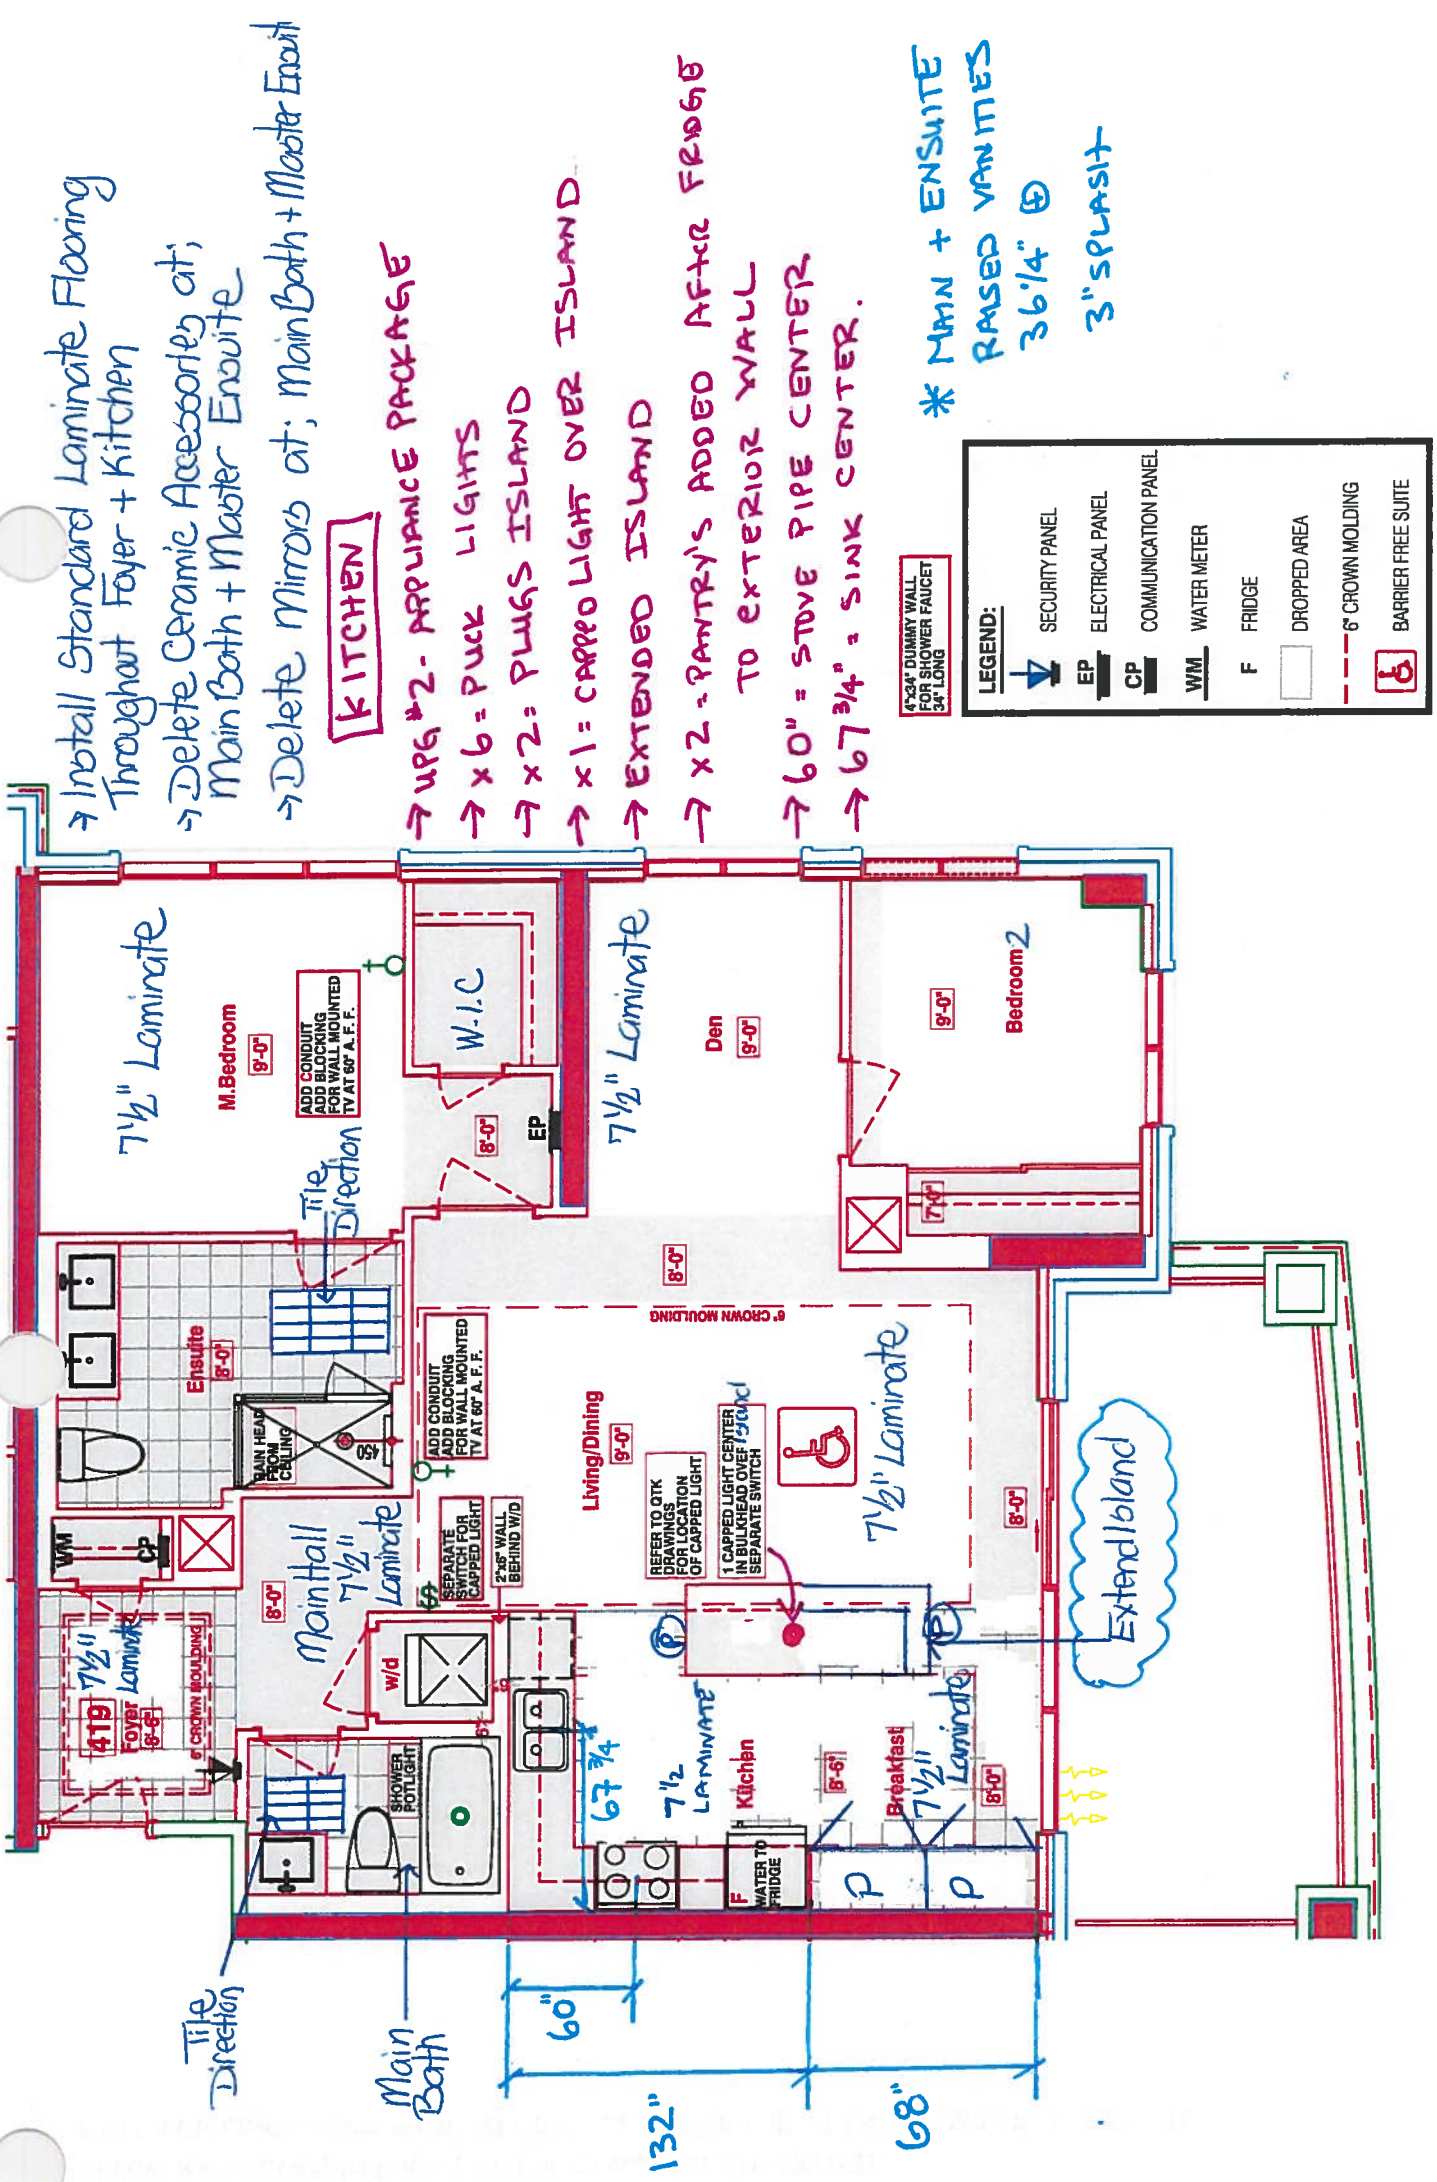

- Install Standard Laminate Flooring Throughout Foyer + Kitchen
- Delete Ceramic Accessories at; Main Bath + Master Ensuite
- Delete Mirrors at; Main Bath + Master Ensuite

KITCHEN

- UPG #2- APPLIANCE PACKAGE
- x 6 = PUCK LIGHTS
- x 2 = PLUGS ISLAND
- x 1 = CARRO LIGHT OVER ISLAND
- EXTENDED ISLAND
- x 2 = PANTRY'S ADDED AFTER FRIDGE TO EXTERIOR WALL
- 60" = STOVE PIPE CENTER
- 67 3/4" = SINK CENTER.

* MAIN + ENSUITE
RAISED VANITIES
36 1/4" @
3" SPLASH

4"x34" DUMMY WALL
FOR SHOWER FAUCET
34" LONG

LEGEND:	
	SECURITY PANEL
	ELECTRICAL PANEL
	COMMUNICATION PANEL
	WATER METER
	FRIDGE
	DROPPED AREA
	6" CROWN MOLDING
	BARRIER FREE SUITE

RECEIVED
12/13/2017

SUITE 419-GLEN COVE

Royal Pine Homes 25 Baker Hill Blvd - Stouffville, ON Dec 13, 2017



CONSTRUCTION SUMMARY

Hampton Place

PURCHASERS: ANGELA CORNACCHIA and ANTHONY CORNACCHIA

TEL: RES.: 416-499-1690 BUS.: 416-716-5845

LOT NUMBER	PHASE	HOUSE TYPE	CLOSING DATE
419	1	GLEN COVE	15-Oct-18

Offer Worksheet	PURCHASERS WILL HAVE THE OPTION TO CHANGE STANDARD TILE TO STANDARD LAMINATE IN THE FOYER, KITCHEN AND BREAKFAST AREA AT TIME OF THEIR DECOR APPOINTMENT AT NO CHARGE. Note:
--------------------	---

Offer Worksheet	ADDITIONAL - SINGLE PARKING UNIT Note:
--------------------	---

Offer Upgrade	WATER LINE TO FRIDGE Note:
------------------	-------------------------------

Offer Upgrade	CONDUIT AND BLOCKING FOR WALL MOUNTED TV (60 INCHES ABOVE FINISHED FLOOR) IN MASTER BEDROOM AND LIVING AREA AS PER SKETCH Note:
------------------	--

Offer Upgrade	RAINHEAD FROM CEILING IN MASTER ENSUITE, FROM VENDORS STANDARD SAMPLES Note:
------------------	---

Offer Upgrade	SHOWER POTLIGHT IN MAIN BATH NOT ON SEPARATE SWITCH. Note:
------------------	---

Offer Upgrade	EXTRA CEILING CAPPED OUTLET CENTERED OVER THE ISLAND ON SEPARATE SWITCH. Note:
------------------	---





SITE COPY

CONSTRUCTION SUMMARY

Hampton Place

PURCHASERS: ANGELA CORNACCHIA and ANTHONY CORNACCHIA

TEL: RES.: 416-499-1690 BUS.: 416-716-5845

LOT NUMBER	PHASE	HOUSE TYPE	CLOSING DATE	
419	1	GLEN COVE	15-Oct-18	

Date Added: 13-Dec-17 Invoice Number: 7056

1 - CLARIFICATION; REFER TO APAS;
GROOM - Standard electrical outlet to be installed at standard height beside conduit pipe Additional electrical outlet to be installed beside
t pipe & standard cable rough-in Approx. 60" AFF (See Attached Sketch)
Note: As per Vince at Head-Office

1 - CLARIFICATION; REFER TO APAS;
MasterBedroom - Standard electrical outlet to be installed at standard height beside conduit pipe Additional electrical outlet to be installed beside
conduit pipe & standard cable rough-in Approx. 60" AFF
Note: (See Attached Sketch)
As per Vince at Head-Office

1 - KITCHEN & BATHROOMS - SEE QUALITY TOPS & KITCHENS FOR ALL KITCHEN & BATHROOMS UPGRADES / LAYOUTSs
(Upgrade Package #3) (See Attached QTK Paperwork)
Note:

2 - KITCHEN - Install TWO (2) ADDITIONAL PUCK LIGHTS (Same Switch as Standard Puck Lights) at kitchen. To be installed below kitchen
cabinetry, where applicable. (See Attached QTK Layout for Locations)
Note: Purchaser Paying Difference for Additional Puck Lights - Standard Kitchen to Receive Four (4) Puck Lights - Upgrade Kitchen
Requires Six (6) Puck Lights

1 - KITCHEN - CABINETRY HARDWARE - Install UPGRADE PACKAGE # 3 HARDWARE - To be installed throughout kitchen, where
applicable. (See Sketch)
Note:

1 - KITCHEN - CABINETRY HARDWARE - MIX & MATCH UPGRADE HARDWARE - To be installed throughout kitchen cabinetry, where
applicable. (See Sketch)
Install Upgrade Handle - Style # RC-930-SN - Cabinetry Doors
Upgrade Knob - Style # RC-924-SN - Drawers

1 - KITCHEN - Install ADDITIONAL Standard GRANITE COUNTERTOP - To be installed throughout kitchen, where applicable. (See Attached
Revised QTK Layout)
Note: Priced as per Orlando at Connolly

1 - KITCHEN - COUNTERTOP EDGING - Install UPGRADE " M " EDGING - To be installed throughout kitchen countertop, where applicable. (See
Attached Revised QTK Layout)
Note: Priced as per Orlando at Connolly

1 - DISCLAIMER - GRANITE COUNTERTOP;
KITCHEN - Due to the many variables that can affect the pattern, colour and/or design and "pitting" of natural products, granite installed will not be
identical to the samples displayed.
Note: Every effort is made to provide granite countertops as close as possible but the vendor is not responsible for results which differ
from the sample displayed. All countertop surfaces may have seams, and product pattern and shade can change in areas containing
seams.

1 - DISCLAIMER - STONE COUNTERTOP;
KITCHEN - Stone slabs vary in size & all seams are visible & the fabricator reserves the right to position the seams as necessary.
Note:

1 - KITCHEN - Kitchen Sink - Install Standard Undermount Sink - BLANCO Horizon Plus U2 Undermount Sink (8") - Model # 401234
Note:

1 - KITCHEN - Kitchen Faucet - Install Standard Faucet - DELTA Chrome Pull-Out Kitchen Faucet (Single Hole) - Model # 469LF - Chrome
Note:

1 - APPLIANCE PACKAGE - Install Upgrade Appliance Package - UPGRADE APPLIANCE PACKAHGE # 2 - To be installed throughout suite,
where applicable. (See Sketch)
Note:

1 - CLARIFICATION;
MAIN BATH & MASTER ENSUITE - Install RAISED VANITY HEIGHTS at Main Bath and Master Ensuite Vanity Countertops, where applicable.
(See Attached QTK Paperwork)
Note:



SITE COPY

CONSTRUCTION SUMMARY

Hampton Place

PURCHASERS: ANGELA CORNACCHIA and ANTHONY CORNACCHIA

TEL: RES.: 416-499-1690 BUS.: 416-716-5845

LOT NUMBER	PHASE	HOUSE TYPE	CLOSING DATE	
419	1	GLEN COVE	15-Oct-18	

Date Added: 13-Dec-17 Invoice Number: 7056

30 - MAIN BATH - 2ND UPGRADE - PORCELAIN TILES - 12x24 LANCASTER GREY - To be installed throughout main bath floor (To be installed Straight) (See Sketch) Note: Includes Rectified
75 - MAIN BATH - 2ND UPGRADE - PORCELAIN TILES - 12x24 LANCASTER GREY - To be installed throughout main bath tub/shower enclosure (To be Installed Horizontally / Stacked) (See Sketch) Note: Includes Rectified
80 - MASTER ENSUITE - 2ND UPGRADE - PORCELAIN TILES - 12x24 LANCASTER GREY - To be installed throughout master ensuite floor (To be Installed Straight) (See Sketch) Note: Includes Rectified
70 - MASTER ENSUITE - 2ND UPGRADE - PORCELAIN TILES - 12x24 LANCASTER GREY - To be installed throughout master ensuite shower stall. (To be Installed Horizontally / Stacked) (See Sketch) Note: Includes Rectified
1 - MAIN BATH & MASTER ENSUITE - Install Standard Granite Countertop - SERENATA GRANITE - To be installed throughout Main Bath and Master Ensuite Vanity Countertops, where applicable. (See Sketch) Note:
1 - CLARIFICATION; MAIN BATH & MASTER ENSUITE - Install Standard 3" Splash throughout Main Bath and Master Ensuite Vanity Countertops, where applicable. (See Sketch) Note:
1 - DISCLAIMER - GRANITE COUNTERTOP; MAIN BATH & MASTER ENSUITE - Due to the many variables that can affect the pattern, colour and/or design and "pitting" of natural products, granite installed will not be identical to the samples displayed. Note: Every effort is made to provide granite countertops as close as possible but the vendor is not responsible for results which differ from the sample displayed. All countertop surfaces may have seams, and product pattern and shade can change in areas containing seams.
1 - DISCLAIMER - STONE COUNTERTOP; MAIN BATH & MASTER ENSUITE - Stone slabs vary in size & all seams are visible & the fabricator reserves the right to position the seams as necessary. Note:
1 - MAIN BATH - TOILET - Install Upgrade Toilet - CONTRAC CALI - Elongated One Piece Toilet - Model # 4710-BOVU - White (See Sketch) Note:
1 - MASTER ENSUITE - TOILET - Install Upgrade Toilet - CONTRAC CALI - Elongated One Piece Toilet - Model # 4710-BOVU - White (See Sketch) Note:
1 - CLARIFICATION - REFER TO APAS; MASTER ENSUITE - Install Rain Shower Head from Ceiling at Master Ensuite Shower Stall - DELTA - Shower Trim and Hansgrohe Slide Bar with Handheld and Ceiling Mount Showerhead Note: Model # R10000 / T13020-CDN/27454002 / 277440 / RP52382 / RP46870 / RP6025 / R11000 / T11800 - Chrome (See Sketch)
1 - CLARIFICATION; MAIN BATH & MASTER ENSUITE - DELETE Do Not Install / Supply / Credit Purchaser for builders standard ceramic bathroom accessories (toilet paper, towel bar & soap dish) throughout all bathrooms where applicable. Note: To Include; Main Bath & Master Ensuite (See Sketch)
1 - CLARIFICATION; MAIN BATH & MASTER ENSUITE - DELETE Do Not Install / Supply / Credit Purchaser for builders standard Bathroom Mirrors, throughout all bathrooms, where applicable. To Include; Main Bath and Master Ensuite. (See Sketch) Note:



SITE COPY

CONSTRUCTION SUMMARY

Hampton Place

PURCHASERS: ANGELA CORNACCHIA and ANTHONY CORNACCHIA

TEL: RES.: 416-499-1690 BUS.: 416-716-5845

LOT NUMBER	PHASE	HOUSE TYPE	CLOSING DATE
419	1	GLEN COVE	15-Oct-18

Date Added: 13-Dec-17 Invoice Number: 7056

1 - CLARIFICATION;
MASTER ENSUITE - Purchaser accepts & acknowledges the standard frameless glass enclosure at master ensuite shower stall will NOT touch the
and will receive a Standard Chrome Header. (See Sketch)
Note:

1 - PURCHASER TO RECEIVE A FURTHER DISCOUNT OF; \$1,829.16 (Before Taxes) HAS BEEN APPLIED TO UPGRADES COMPLETED AT
THE DECOR CENTRE. - APPROVED AS PER STEVE C.
Note:

1 - PURCHASER HAS ATTENDED A COLOR APPOINTMENT AT THE DECOR CENTRE AND HAS DECLINED ANY ADDITIONAL
UPGRADES. Purchaser accepts and acknowledges that there will be no further changes/additions/deletions to be made upon signing on December
13,2017
Note:

1 - PURCHASER AWARE AND ACCEPTS THAT ANY CHANGES MADE TO UPGRADES AFTER SIGNING THIS PURCHASERS EXTRA
FORM ARE SUBJECT TO A MINIMUM ADMINISTRATION FEE OF \$1,000 PLUS A 10% HOLDBACK FEE.
Note:

This Document is Extremely Time Sensitive - Printed 1 Mar 18 at 14:57





* INTERIOR CLOUTIER SCHEME *

Decor Consultant

Model Type

Teléfono Res / Bus

Project

Closing Date

11311

ANGELA CORNACCHIA & ANTHONY CORNACCHIA

Melissa Di Marino

GLEN COVE

(116) 100 1600 1/116 716 E04E

11

1#14010010

3

—Wall Tile—

Flooring

[illegible]

Notes

KITCHEN - CABINETRY HARDWARE - INSTALL UPGRADE KNOB - STYLE # RC-924-SN - THROUGHOUT KITCHEN DRAWERS
KITCHEN - CABINETRY HARDWARE - INSTALL UPGRADE HANDLE - STYLE # RC-930-SN - THROUGHOUT KITCHEN CABINETRY DOORS

Page 1 of 3

Consultant:

Melissa Di Marino

Purchaser:

ANGELA CORNACCHIA

Purch

ANTHONY CORDELLA

Vendor:

Hammond Place

Lot: 419 Project: Hampton Place Model: GLEN COVE

Printed Dec 13, 2017 12:29 pm



* INTERIOR CUR SCHEME *

Purchasers ANGELA CORNACCHIA & ANTHONY CORNACCHIA		Decor Consultant Melissa Di Marino	Model Type GLEN COVE	Telephone Res. / Bus (416) 499-1690 / (416) 716-5845	Project Hampton Place	Closing Date 15/10/2018	Unit 419
--	--	---------------------------------------	-------------------------	---	--------------------------	----------------------------	-------------

CABINETS, VANITIES AND COUNTERTOPS				
	Style	Countertop	Counter Edge	Handle / Knob
MAIN BATHROOM	CATEGORY 2 - MAPLE - PISTACHIO QT 2503 (STD)	SERENATA GRANITE (STD)	A " EDGE (STD)	3487-128
MASTER ENSUITE	CATEGORY 2 - MAPLE - PISTACHIO QT 2503 (STD)	SERENATA GRANITE (STD)	A " EDGE (STD)	3487-128
POWDER ROOM	N/A	N/A	N/A	N/A
KITCHEN / DINETTE	CATEGORY 1 - FIBERBOARD - WHITE QT 1203 (STD)	BIANCO ANTICO GRANITE (STD)	M " EDGE (UPG)	*See Notes*
LAUNDRY ROOM	N/A	N/A	N/A	N/A

APPLIANCE PACKAGE
Upgrade Package #2

Std 31in Opening

PLUMBING FIXTURES	
KITCHEN	
Sink Model	STANDARD
Sink Faucet	STANDARD
TOILETS	
Master Ensuite	UPGRADE - Contrac Call #4710-BOVU
Main Bathroom	UPGRADE - Contrac Call #4710-BOVU
Powder Room	N/A
VANITY FAUCETS	
Master Ensuite	STANDARD
Main Bathroom	STANDARD
Powder Room	N/A
VANITY SINKS	
Master Ensuite	STANDARD
Main Bathroom	STANDARD
Powder Room	N/A
SHOWER STALL / TUBS	
Master Ensuite Shower Stall	STANDARD
Master Ensuite Tub	N/A
Main Bathroom Tub	STANDARD


Trim	
Baseboard & Casing	STANDARD
Interior Doors	STANDARD - CARRARA, SMOOTH
Cornice Moulding / Medallion	
Foyer	STANDARD - #CTR-611
Living Room	STANDARD - #CTR-611
Dining Room	STANDARD - #CTR-611
Den	NONE
Master Bedroom	NONE
Bedroom 2	NONE
Bedroom 3	N/A

MISC. INSTALLATIONS	
Ceramic Accessories (installed by Vendor)	☐ Yes ☒ No
Bathroom Mirrors (installed by Vendor)	☐ Yes ☒ No
Wire Shelving - Closet (installed by Vendor)	☒ Yes ☐ No

Paint Throughout	Trim
Walls	STANDARD - BIRCH WHITE
	STANDARD - WHITE

Decor Consultant: Melissa Di Marino
Purchaser: ANGELA CORNACCHIA
Purchaser: ANTHONY CORNACCHIA
Vendor:

Suite 418 Hampton

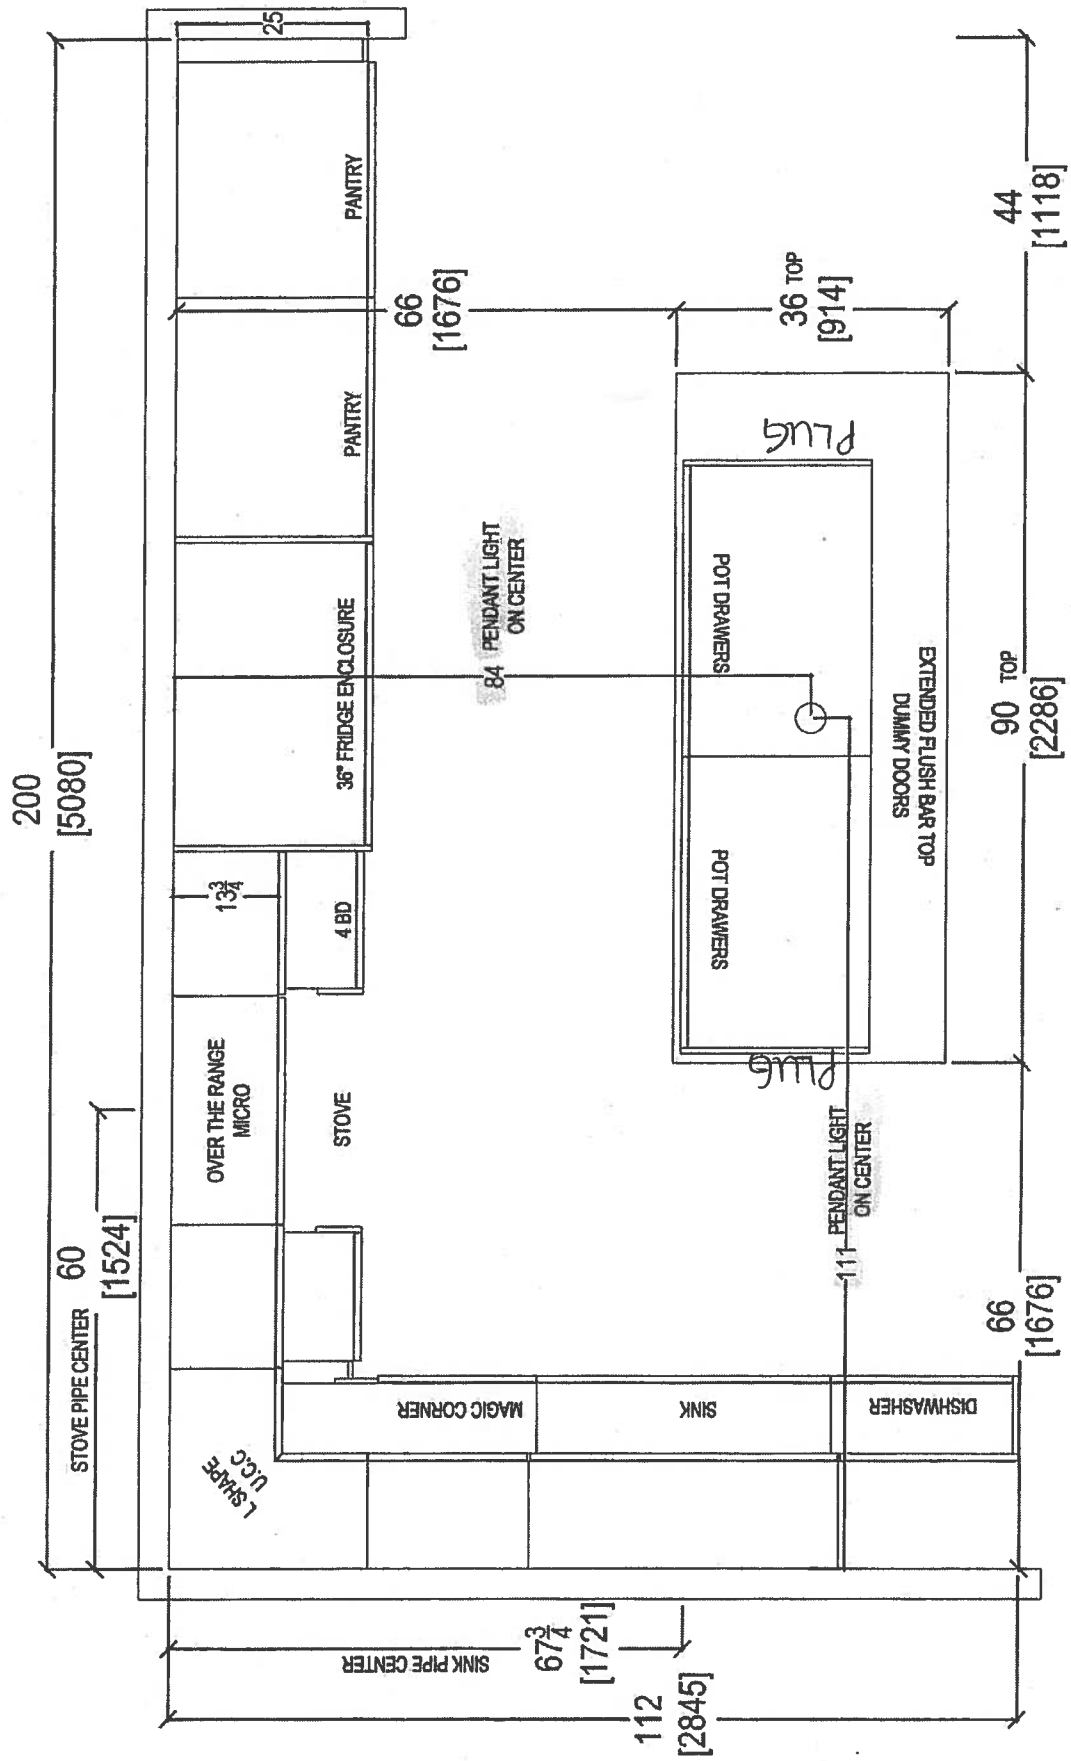


- UPG #2 - APPLIANCE PACKAGES
- X6 = RUCK LIGHTS
- X2 = PLUGS ISLAND
- X1 = CAPPED CIELING LIGHT ISLAND
- X2 = PANTRY'S ADDED AFTER FRIDGE
- EXTENDED ISLAND.
- MAIN + ENS RAISED VANITIES 36 1/4" (+) 3" SPLASH



80 SANTE DRIVE, VAUGHAN, ON L4K 3C4,
T: 416.746.1811 F: 905.761.5901

CLIENT: ROYAL PINE HOMES SITE: HAMPTON PLACE PHONE: --- EMAIL: ---	UNIT 418 HMP	ROOM:	KITCHEN FLOOR PLAN	DRAWN BY: SK	COMMENTS: PLEASE NOTE ALL DIMENSIONS ARE NOT FINAL AND ARE SUBJECT TO CHANGE UPON FINAL SITE MEASURE
	DOOR STYLE: ---	DOOR HANDLE: ---	SCALE: 1/2" = 1'-0"	SCALE: 1/2" = 1'-0"	
	FINISH: ---	DRW HANDLE: ---	DATE: FEB 20, 2018	DATE: FEB 20, 2018	
	SPECIES: ---	TOP: ---	PAGE: ---	PAGE: ---	


Suite 419 Hampton PL-Pock Light (x6)

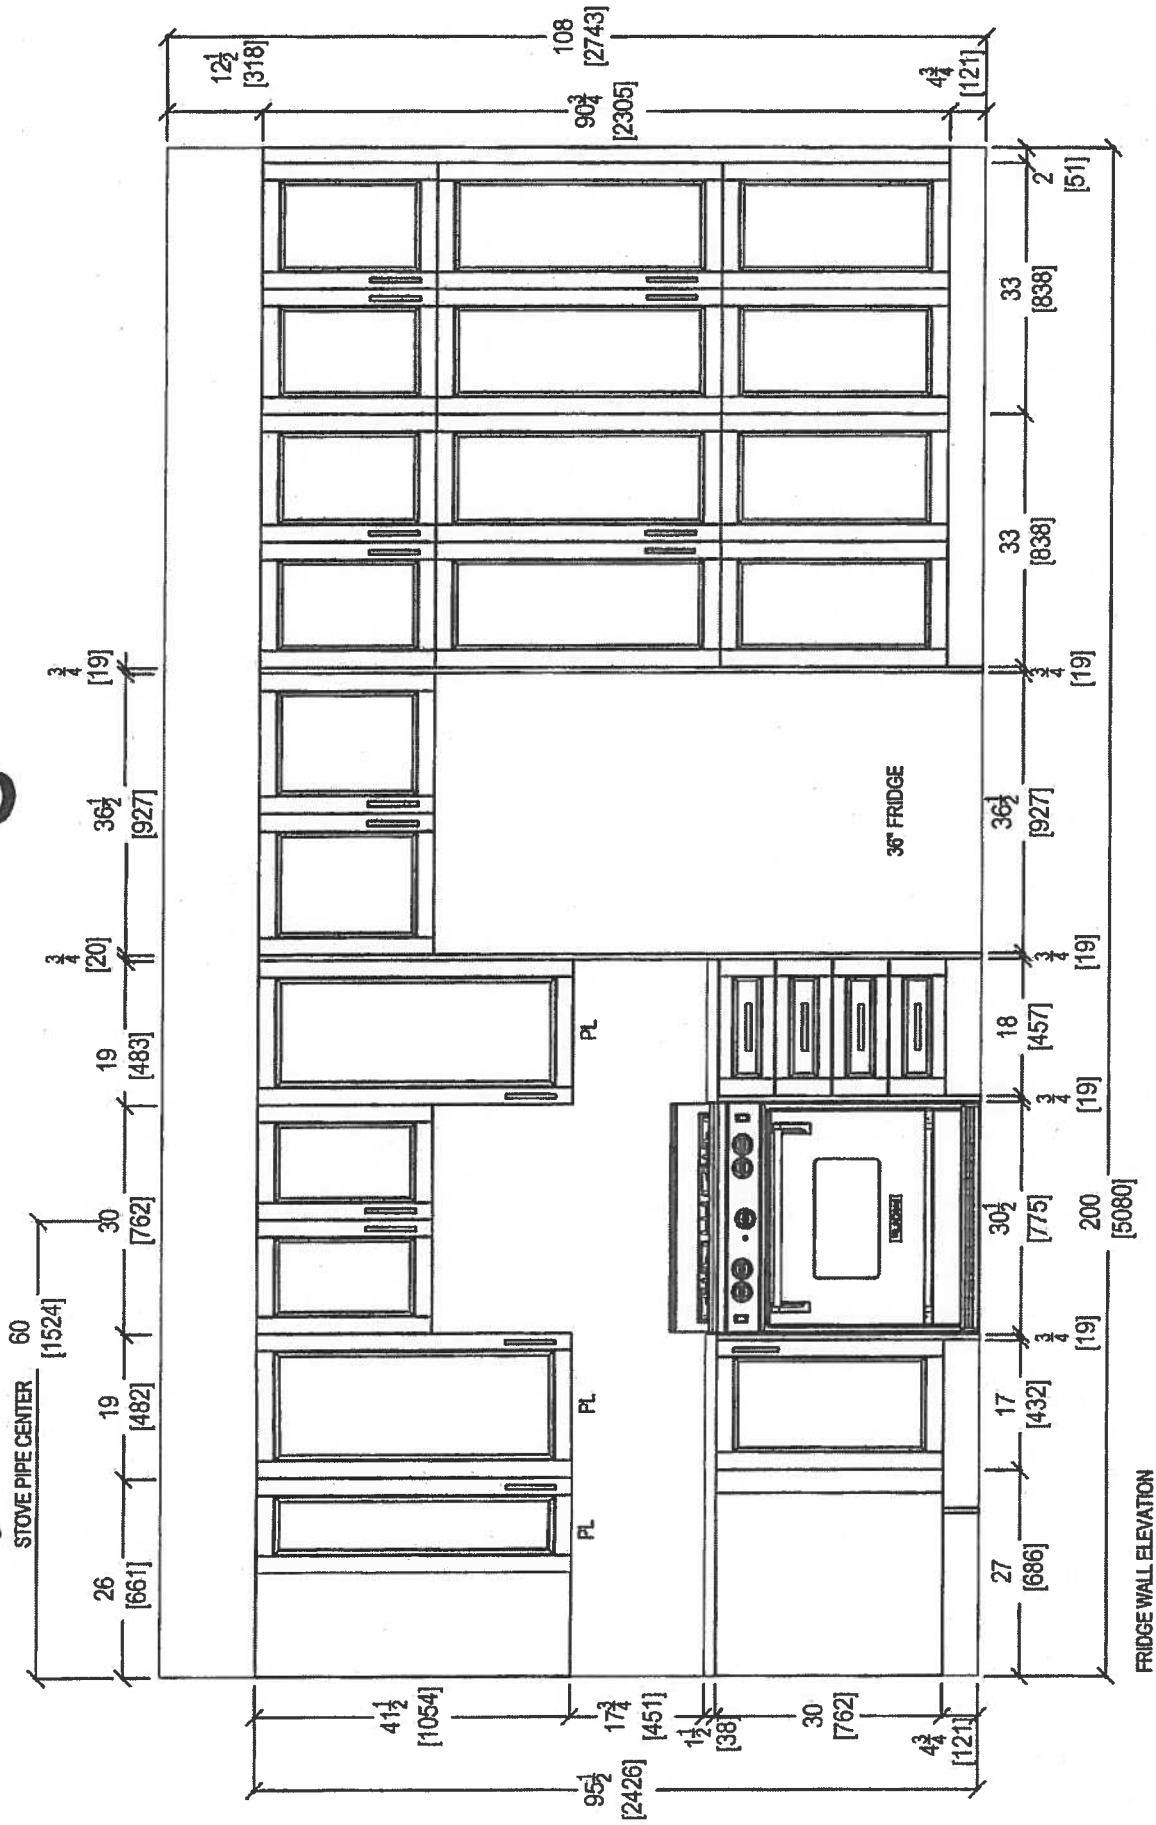


FRIDGE WALL ELEVATION

 your kitchen, your taste. 80 SANTE DRIVE, VAUGHAN, ON L4K 3C4, T: 416.746.1811 F: 905.761.5901	CLIENT: ROYAL PINE HOMES	UNIT <u>114</u> ^{4th} _{FL}	ROOM: KITCHEN	DRAWN BY: SK	COMMENTS: PLEASE NOTE ALL DIMENSIONS ARE NOT FINAL AND ARE SUBJECT TO CHANGE UPON FINAL SITE MEASURE
	SITE: HAMPTON PLACE	DOOR STYLE: —	DOOR HANDLE: —	SCALE: 1/2" = 1' - 0"	
	PHONE: —	FINISH: —	DRW HANDLE: —	DATE: FEB 20, 2018	
	EMAIL: —	SPECIES: —	TOP: —	PAGE: —	

Suite 419 Hampton PL-Pink Light (x6)

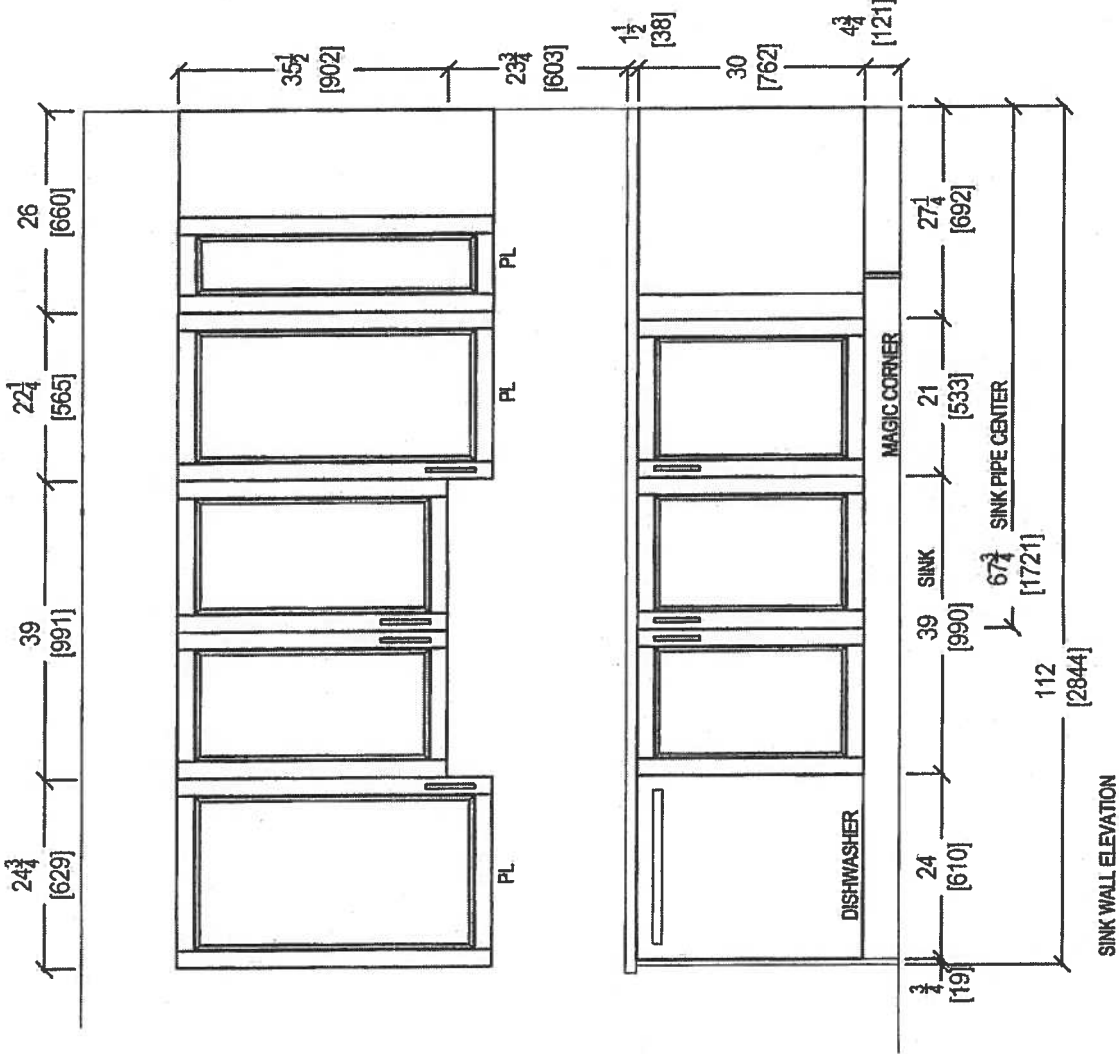

 your kitchen, your taste. 80 SANTE DRIVE, VAUGHAN, ON L4K 3C4, T: 416.748.1811 F: 905.761.9801	CLIENT: ROYAL PINE HOMES		UNIT 419 HMP	ROOM: KITCHEN	DRAWN BY: SK		COMMENTS: PLEASE NOTE ALL DIMENSIONS ARE NOT FINAL AND ARE SUBJECT TO CHANGE UPON FINAL SITE MEASURE
	SITE: HAMPTON PLACE		DOOR STYLE: —	DOOR HANDLE: —		SCALE: 1/2" = 1' - 0"	
	PHONE: —		FINISH: —	DRW HANDLE: —		DATE: FEB 20, 2018	
	EMAIL: —		SPECIES: —	TOP: —		PAGE: —	

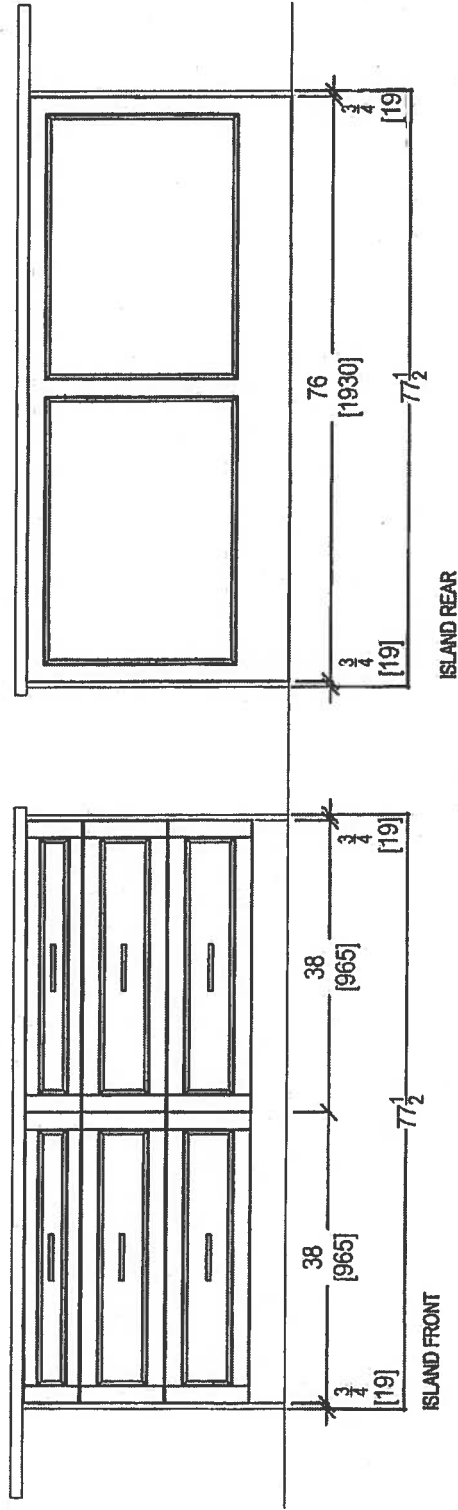

CLIENT: ROYAL PINE HOMES
SITE: HAMPTON PLACE
PHONE: —
EMAIL: —


UNIT 410 HMP
DOOR STYLE: —
FINISH: —
SPECIES: —

ROOM: KITCHEN
DOOR HANDLE: —
DRW HANDLE: —
TOP: —



DRAWN BY: SK
SCALE: 1/2" = 1' - 0"
DATE: FEB 20, 2018
PAGE: —

COMMENTS:
PLEASE NOTE ALL DIMENSIONS
ARE NOT FINAL AND ARE
SUBJECT TO CHANGE UPON
FINAL SITE MEASURE

Install 3" Splash

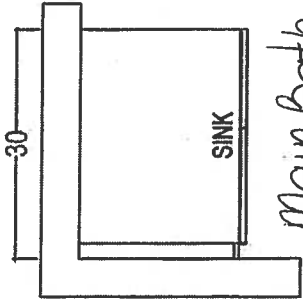


Main Bath
Raised Height

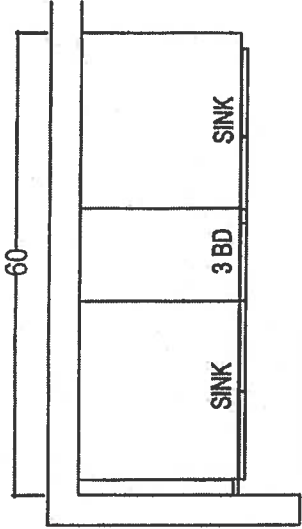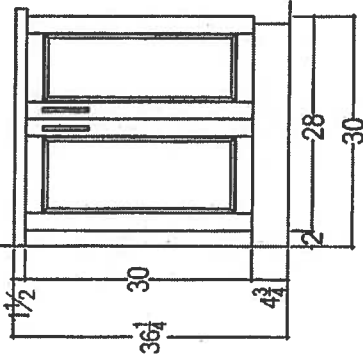

MASTER ENSUITE

Raised Height

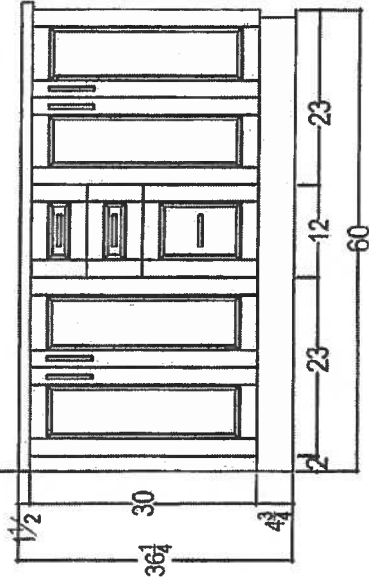

80 SANTE DRIVE, VAUGHAN, ON L4K 3C4,
T: 416.748.1811 F: 905.761.5901

CLIENT: ROYAL PINE HOMES		UNIT 419 HMP	ROOM:	VANITIES	DRAWN BY: SK		COMMENTS: PLEASE NOTE ALL DIMENSIONS ARE NOT FINAL AND ARE SUBJECT TO CHANGE UPON FINAL SITE MEASURE
SITE:	HAMPTON PLACE	DOOR STYLE: —	DOOR HANDLE: —	SCALE: 1/2" = 1'-0"			
PHONE: —	FINISH: —	DRW HANDLE: —	DATE: FEB 20, 2018	DATE: FEB 20, 2018			
EMAIL: —	SPECIES: —	TOP: —	PAGE: —	PAGE: —			

Suite 419
Hampton

Upgrade
Package 2



INSIDEADVANTAGE⁺



<http://www.insideadvantage.com>

Product Dimensions:

Height: 72
Width: 35 3/4
Depth: 30 1/4

Electrical Requirements:

15 Amps.

Available In:

- ☒ Stainless Steel
- ☒ Black
- ☐ White


KRFC302ESS

22 cu.ft. 36-Inch Width Counter Depth French Door Refrigerator
with Interior Dispense

KRFC302ESS

Key Features:

- ExtendFresh™ Temperature Management System
- Interior Water Dispenser
- Professionally-Inspired Design
- Produce Preserver
- Humidity-Controlled Crispers
- FreshChill™ Temperature-Controlled Full-Width Pantry
- Pull-Out Tri-Level Freezer Drawer
- SatinGlide® System
- LED Lighting
- Star-K Certified
- Automatic Ice Maker
- Max Cool

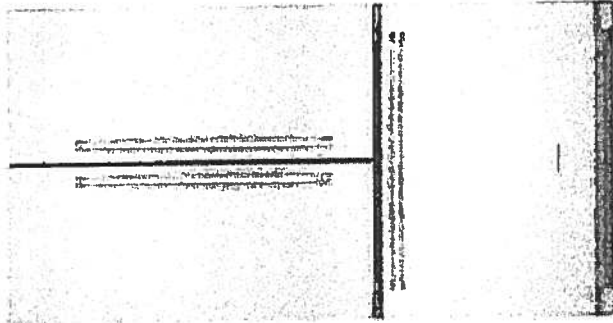

INVENTED
IN
AMERICA

Because Whirlpool Corporation policy includes a continuous commitment to improve our products, we reserve the right to change materials and specifications without notice. We also reserve the right to discontinue or transition products without notice.

® reg. Registered trademark/™ Trademark of Whirlpool U.S.A. © 2013 Whirlpool Corporation. All Rights Reserved. All other trademarks are owned by their respective companies.

Created On: Wednesday, April 22, 2015 15:51:04

Suite 419
Hampton

Upgrade
Package 2




KSEB900ESS

KitchenAid

36-Inch 5-Element Electric Convection Slide-In
Range with Baking Drawer

<http://www.kitchenaid.com>

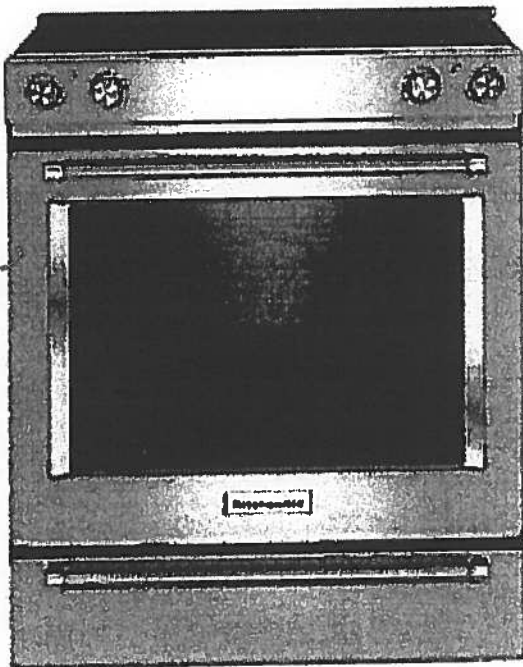

Key Features:

- Baking Drawer
- Even-Heat™ True Convection
- Wireless Probe
- Steam Rack
- 7.1 Cu Ft. Total Capacity
- 5 Cooking Elements Including a Warm Zone
- EasyConvect™ Conversion
- FIT Guarantee
- Aqualift®
- Glass Touch Controls
- Side Trim Accessory Kit

Product Dimensions:

Height: 36

Width: 29 7/8

Electrical Requirements:

40 Amps.

Additional Information:

[Use And Care Guide](#)

[Dimension Guide](#)

[Installation Guide](#)

[Warranty Certificate](#)

Available in:

- Black
- Stainless Steel
- White

INVESTED
IN
AMERICA

ADA
Compliant

©Registered trademark/TM Trademark of Whirlpool, U.S.A. © 2013 Whirlpool Corporation. All Rights Reserved.
All other trademarks are owned by their respective companies.
Because Whirlpool Corporation policy includes a continuous commitment to improve our products, we reserve the right to change materials and specifications without notice. We also reserve the right to discontinue or transition products without notice.
Manufacturer's Suggested Retail Price (MSRP) and Minimum Advertised Price (MAP) provided for reference purposes only. Dealer alone determines advertised and retail prices.
Created On: Tuesday, December 22, 2015 14:04:50

Suite 419 Hampton Upgrade Package 2




KMHP519ESS

1200-Watt Convection Microwave with High-Speed
Cooking - 30"

KitchenAid

<http://www.kitchenaid.com>

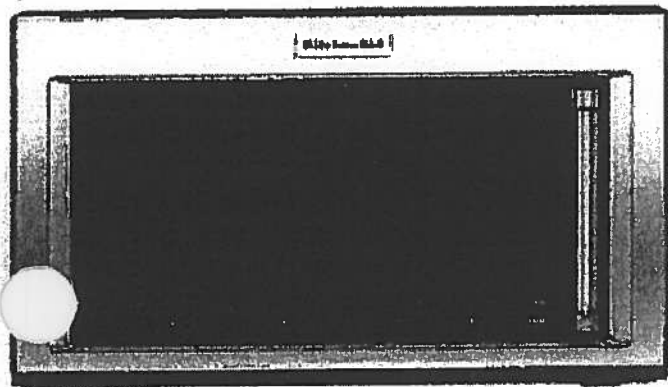

Key Features:

- High-Speed Cooking
- Convection Cooking
- Professionally-Inspired Design Including Handle, Badge, Graphics, Chrome Chamfer.
- Cookshield Finish
- Crispwave™ Technology and Crisper Pan
- 1200 Watts Power
- 1.9 Cu. Ft. Capacity
- Halogen Cavity Lights and Task Light
- Steam Cleaning Function
- Keep Warm Function
- Sound-Based Popcorn Function

Product Dimensions:

Height: 17 1/8

Width: 30

Depth: 17

Electrical Requirements:

15.

Additional Information:

[Use And Care](#)

[Dimension Guide](#)

[Installation Guide](#)

[Warranty](#)

Available In:



Stainless Steel

©Registered trademark/TM Trademark of Whirlpool, U.S.A. ©2016 Whirlpool Corporation All Rights Reserved All other trademarks are owned by their respective companies.

Because Whirlpool Corporation policy includes a continuous commitment to improve our products, we reserve the right to change materials and specifications without notice. We also reserve the right to discontinue or transition products without notice.

Manufacturer's Suggested Retail Price (MSRP) and Minimum Advertised Price (MAP) provided for reference purposes only. Dealer alone determines advertised and retail prices.

Suite 419 Hampton Upgrade Package 2



KDTM354ESS

KitchenAid®

<http://www.kitchenaid.com>

dBA Dishwasher with Clean Water Wash System



Key Features:

- Clean Water Wash System
- ProScrub® Option
- Professionally-Inspired Design
- Advanced ProDry™ System
- ProWash™ Cycle
- SatinGlide® Max Rails (Upper Rack)
- Sliding Tines in the Lower Rack
- 2 Rows Fold-Down Tines in Upper Rack
- Fold-Down Tines in the Lower Rack
- 2 Fold-Down Cup Shelves with Integrated Stemware Holders
- Utility Basket (Upper Rack)
- Express Wash

Product Dimensions:

Height: 34 1/2

Width: 23 7/8

Depth: 24 3/4

Electrical Requirements:

15 Amps.

Additional Information:

[Use And Care Guide](#)

[Dimension Guide](#)

[Installation Guide](#)

[Energy Guide](#)

[Warranty Certificate](#)

Available in:

 Stainless Steel

INVESTED
IN
AMERICA

®Registered trademark/TM Trademark of Whirlpool, U.S.A. © 2013 Whirlpool Corporation. All Rights Reserved.
All other trademarks are owned by their respective companies.
Because Whirlpool Corporation policy includes a continuous commitment to improve our products, we reserve the right to change materials and specifications without notice. We also reserve the right to discontinue or transition products without notice.
Manufacturer's Suggested Retail Price (MSRP) and Minimum Advertised Price (MAP) provided for reference purposes only. Dealer alone determines advertised and retail prices.
Created On: Friday, March 04, 2016 16:36:55

Suite 419
Hampton

Upgrade
Package 2




WED85HEFC

Whirlpool®

<http://www.whirlpool.com>

7.4 cu. ft. Electric Dryer with Quick Dry Cycle

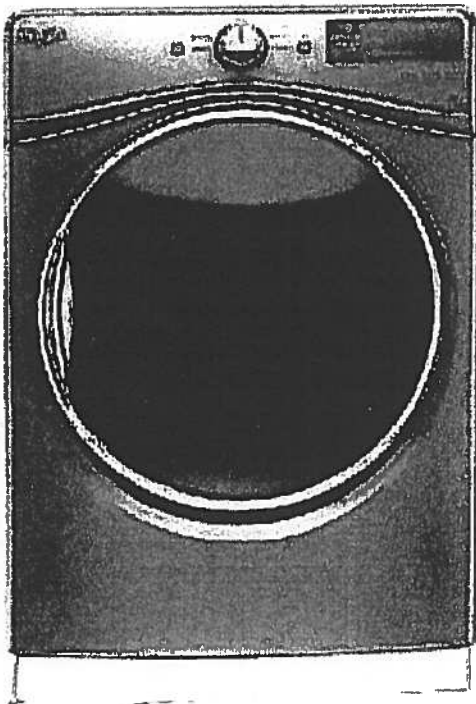

Key Features:

- Advanced Moisture Sensing System
- Tap Touch Controls with Memory
- EcoBoost™ Option
- Steam Refresh Cycle
- Wrinkle Shield™ Option
- Quad Baffles
- 7.4 Cu. Ft. Capacity
- Undercounter Installation
- ENERGY STAR® Qualified
- Sanitize Cycle
- Quick Dry Cycle

Product Dimensions:

Height: 39

Width: 27

Depth: 31

Additional Information:

[Use And Care Guide](#)

[Dimension Guide](#)

[Installation Guide](#)

[Warranty Certificate](#)

INVESTED
IN
AMERICA



©Registered trademark/TM Trademark of Whirlpool, U.S.A. © 2016 Whirlpool Corporation. All Rights Reserved
All other trademarks are owned by their respective companies
Because Whirlpool Corporation policy includes a continuous commitment to improve our products, we reserve the right to change materials and specifications without notice. We also reserve the right to discontinue or transition products without notice
Manufacturer's Suggested Retail Price (MSRP) and Minimum Advertised Price (MAP) provided for reference purposes only. Dealer alone determines advertised and retail prices
Created On: Thursday, March 23, 2017 17:33:37

Suite 419 Hampton Upgrade Package 2


WFW85HEFC

4.5 cu. ft. Front Load Washer with TumbleFresh™
option



 **Whirlpool®**

<http://www.whirlpool.com>

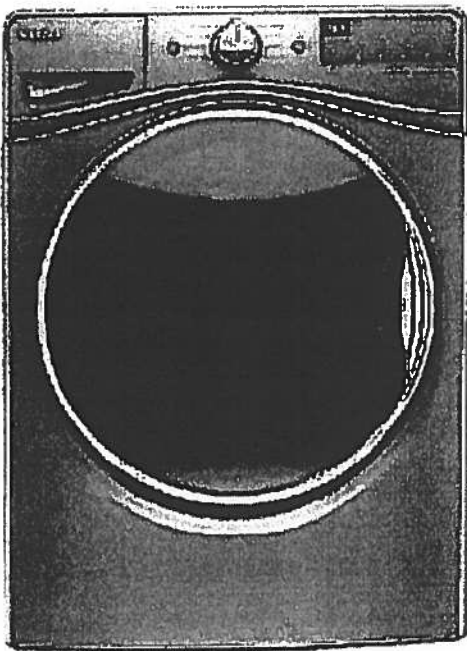

Key Features:

- TumbleFresh™ Option
- ColorLast™ Cycle
- Presoak Option
- EcoBoost™ Option
- Precision Dispense
- Steam Clean Option
- Adaptive Wash Technology
- Smooth Wave Stainless Steel Wash Basket
- 4.5 cu. ft. Capacity
- Undercounter Installation
- Add-A-Garment
- ENERGY STAR® Certified

Product Dimensions:

Height: 39 3/4

Width: 27

Depth: 33 5/16

Additional Information:

[Use And Care Guide](#)

[Dimension Guide](#)

[Installation Guide](#)

[Energy Guide](#)

[Warranty Certificate](#)

Available in:

- ☒ Chrome Shadow
☐ White

INVESTED
IN
AMERICA



©Registered trademark/TM Trademark of Whirlpool, U.S.A. © 2016 Whirlpool Corporation. All Rights Reserved.
All other trademarks are owned by their respective companies.
Because Whirlpool Corporation policy includes a continuous commitment to improve our products, we reserve the right to change materials and specifications without notice. We also reserve the right to discontinue or transition products without notice.
Manufacturer's Suggested Retail Price (MSRP) and Minimum Advertised Price (MAP) provided for reference purposes only. Dealer alone determines advertised and retail prices.
Created On: Wednesday, December 14, 2016 18:12:43

Suite 419 Hampton

→ Main Bath → Master Ensuite

CALI

4.8Lpf / 1.28Gpf 1PC 16⁷/₈" HIGH ELONGATE

- ☐ 4740BOV Lined Tank
- ☐ 4710BOVU Unlined Tank

Product Specs:

- High efficiency toilet
- 4.8Lpf/1.28Gpf
- Elongated bowl with concealed skirted trapway
- Vitreous china
- 16⁷/₈" Plus Height bowl
- Soft white tank lever
- 12" (305mm) Rough-in
- 2" Fully glazed ball pass trapway
- 3" Flapper
- Siphon jet flush action
- Water surface (240mm x 170mm) 9¹/₂" x 6¹/₂"
- Decorative chrome and soft white side caps included
- Smooth close toilet seat included

Overall Dimensions:

392mm (W) x 725mm (D) x 760mm (H)
15¹/₂" (W) x 28¹/₂" (D) x 29³/₄" (H)

Compliance Certifications:

Meets or exceeds the following:

- IAPMO cUPC
- US EPA WaterSense
- ASME A 12.19.2 / CSA B45.1-2013
- ADA Guidelines & ANSI A117.1
- MaP Tested 1000g
- LEED Compliant


Shipping:

Cube 9.39
GW 92.50lbs



Notes:

This toilet is designed to rough-in at a minimum dimension of 305mm (12") from finished wall to C/L of outlet. Supply line not included with fixture and must be ordered separately.
Important: Dimensions of fixtures are nominal and may vary within the range of tolerances established by ASME standard A112.19.2. These measurements are subject to change or cancellation. No responsibility is assumed for use of superseded or voided pages.
Products are designed to comply ADA/ANSI A117.1 Standard. It shall be the responsibility of the installer to comply with the local disability codes and standards prior to installing the product.

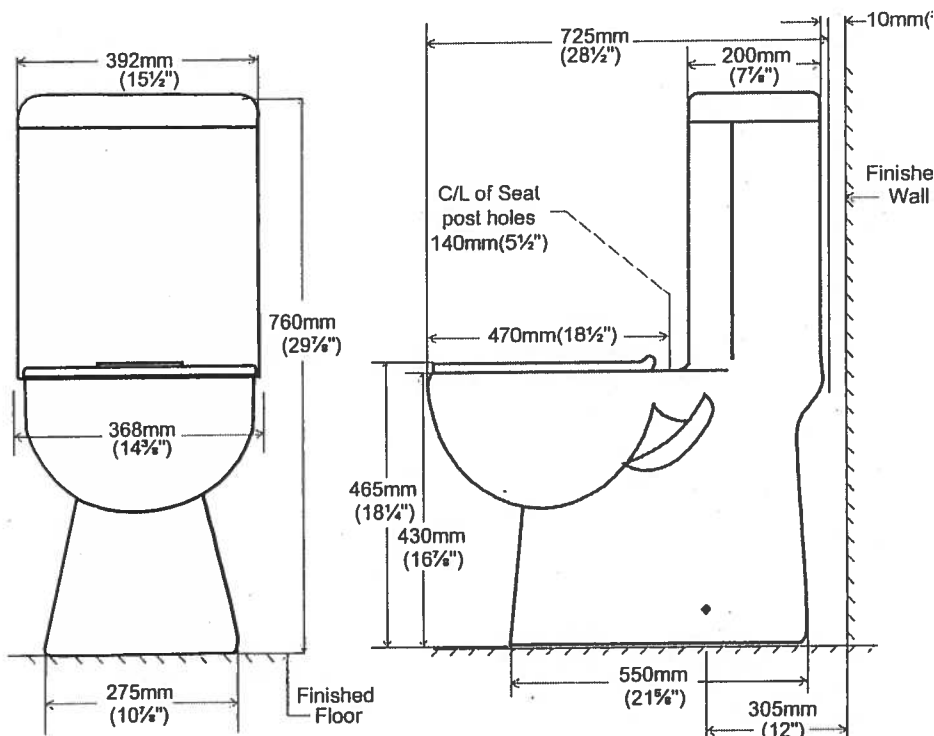

contrac


5970 Chedworth Way, Unit A, Mississauga, ON, Canada L5R 3V5
www.contrac.ca

Revised: January 201

Standard




Suite 419
Hampton

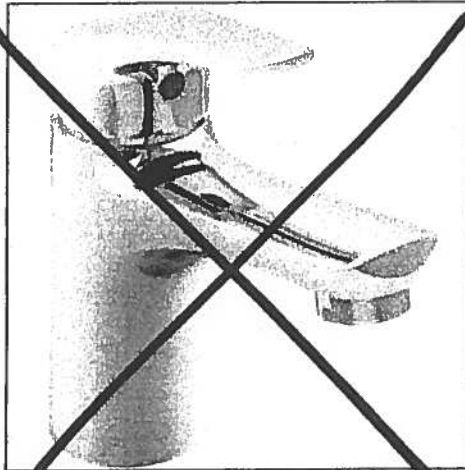


Delta Wynne Chrome Single Lever
Lavatory Faucet With Pop Up
#534LF

Master Ensuite
Shower Stall

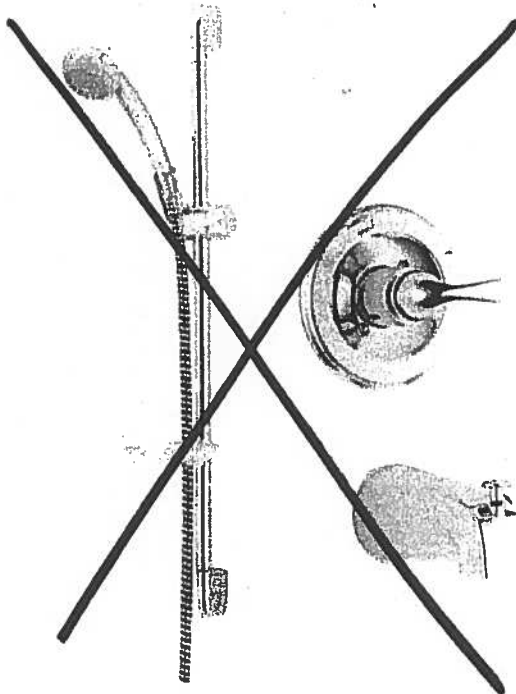

Delta Shower Trim with Tub Spout and
Hansgrohe Slide Bar with Handheld
#R10000/T13020-CDN/2001-TP/27454002/
27744000

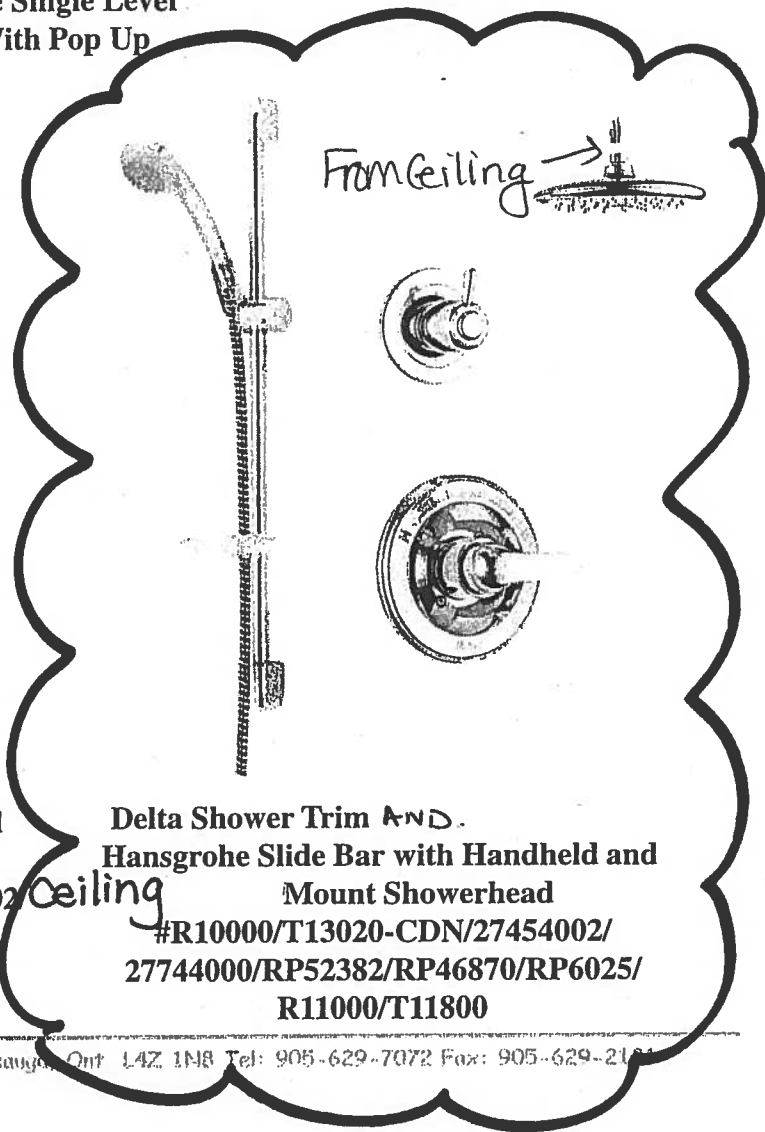



Delta Shower Trim AND
Hansgrohe Slide Bar with Handheld and
Mount Showerhead
#R10000/T13020-CDN/27454002/
27744000/RP52382/RP46870/RP6025/
R11000/T11800

Countertop Edges
Suite 419
Hampton


Dec. 13, 2017

CONNOLLY Marble & Granite Ltd.	EDGE DETAILS	004
--------------------------------	-----------------	-----

Standard:
Main Bath
Master Ensuite

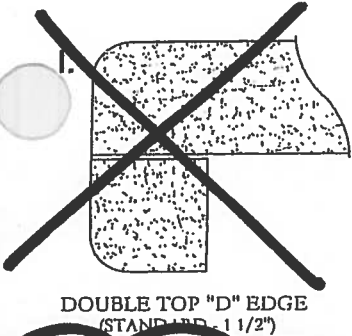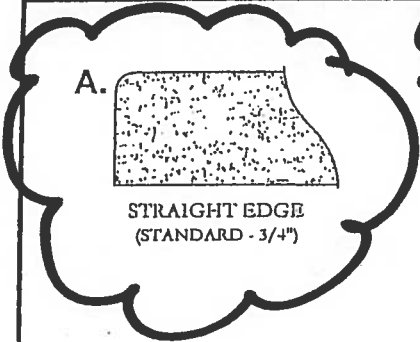

Upgrade:
Kitchen

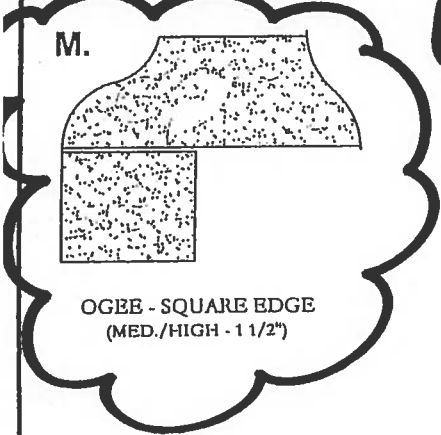

Suite 419
Hampton

→ Living Room
→ Master Bedroom

→ CONDUIT :

CABLE/BELL

@ 60"

TV →



← PLUG

← conduit

BLANK
PLATE



PLUG