

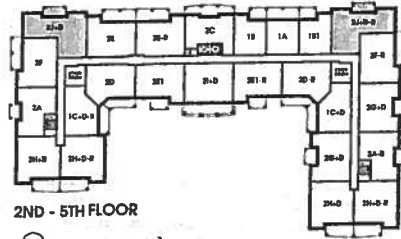


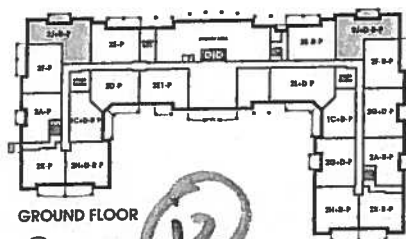

Laurel

1,230 SQ FT *plus* 91 sq. ft. of balcony area

SUITE 505
ORIGINAL LAYOUT

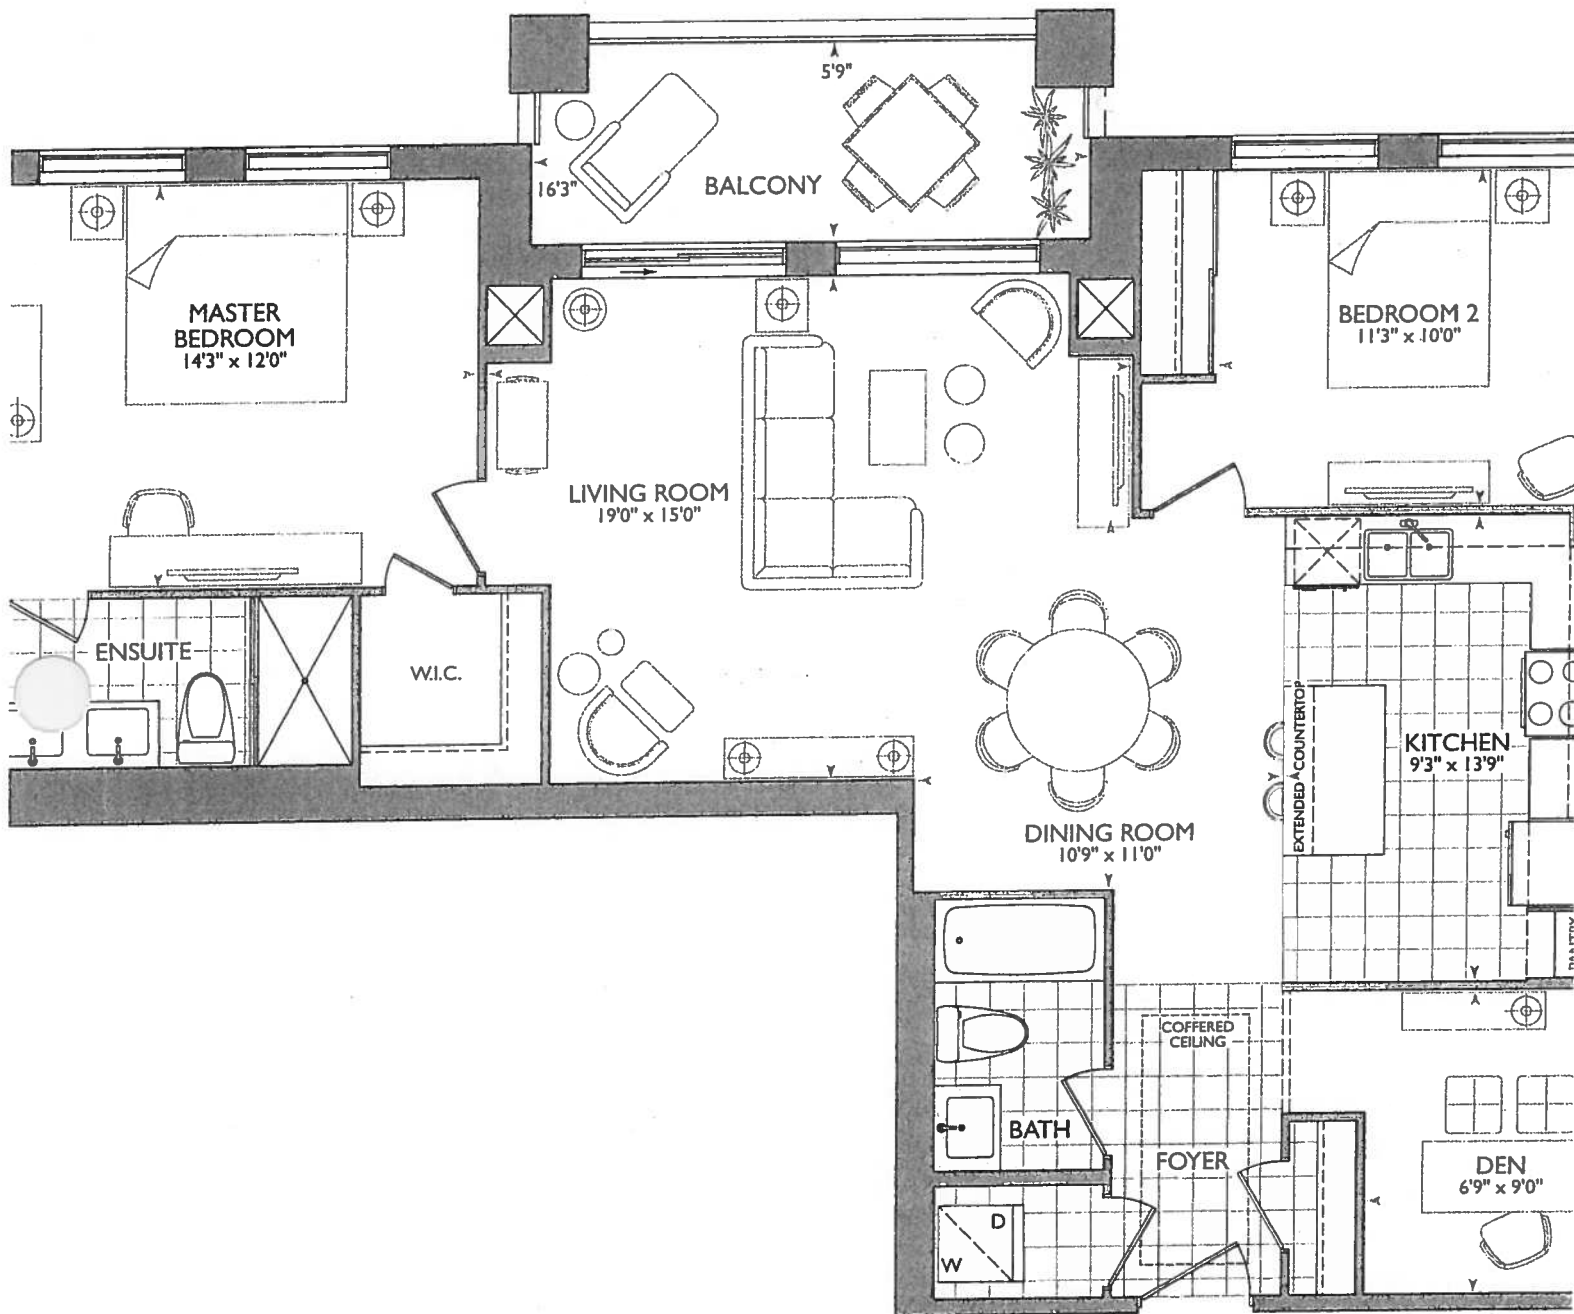

February 27, 2018

*DELETE ALL BATHROOM ACCESSORIES


KITCHEN

- UPG #1 - APPLIANCE PACKAGE
- (x4) - PUCK LIGHTS
- (x2) - PLUGS ISLAND
- (x2) - CAPPED LIGHTS OVER ISLAND.
- 70" SINK PIPE CENTER
- 64" STOVE PIPE CENTER
- DELETE BACK SLASH.

LEGEND:

	SECURITY PANEL
	ELECTRICAL PANEL
	COMMUNICATION PANEL
	WATER METER
	FRIDGE
	DROPPED AREA
	6" CROWN MOLDING

RECEIVED
R010112018

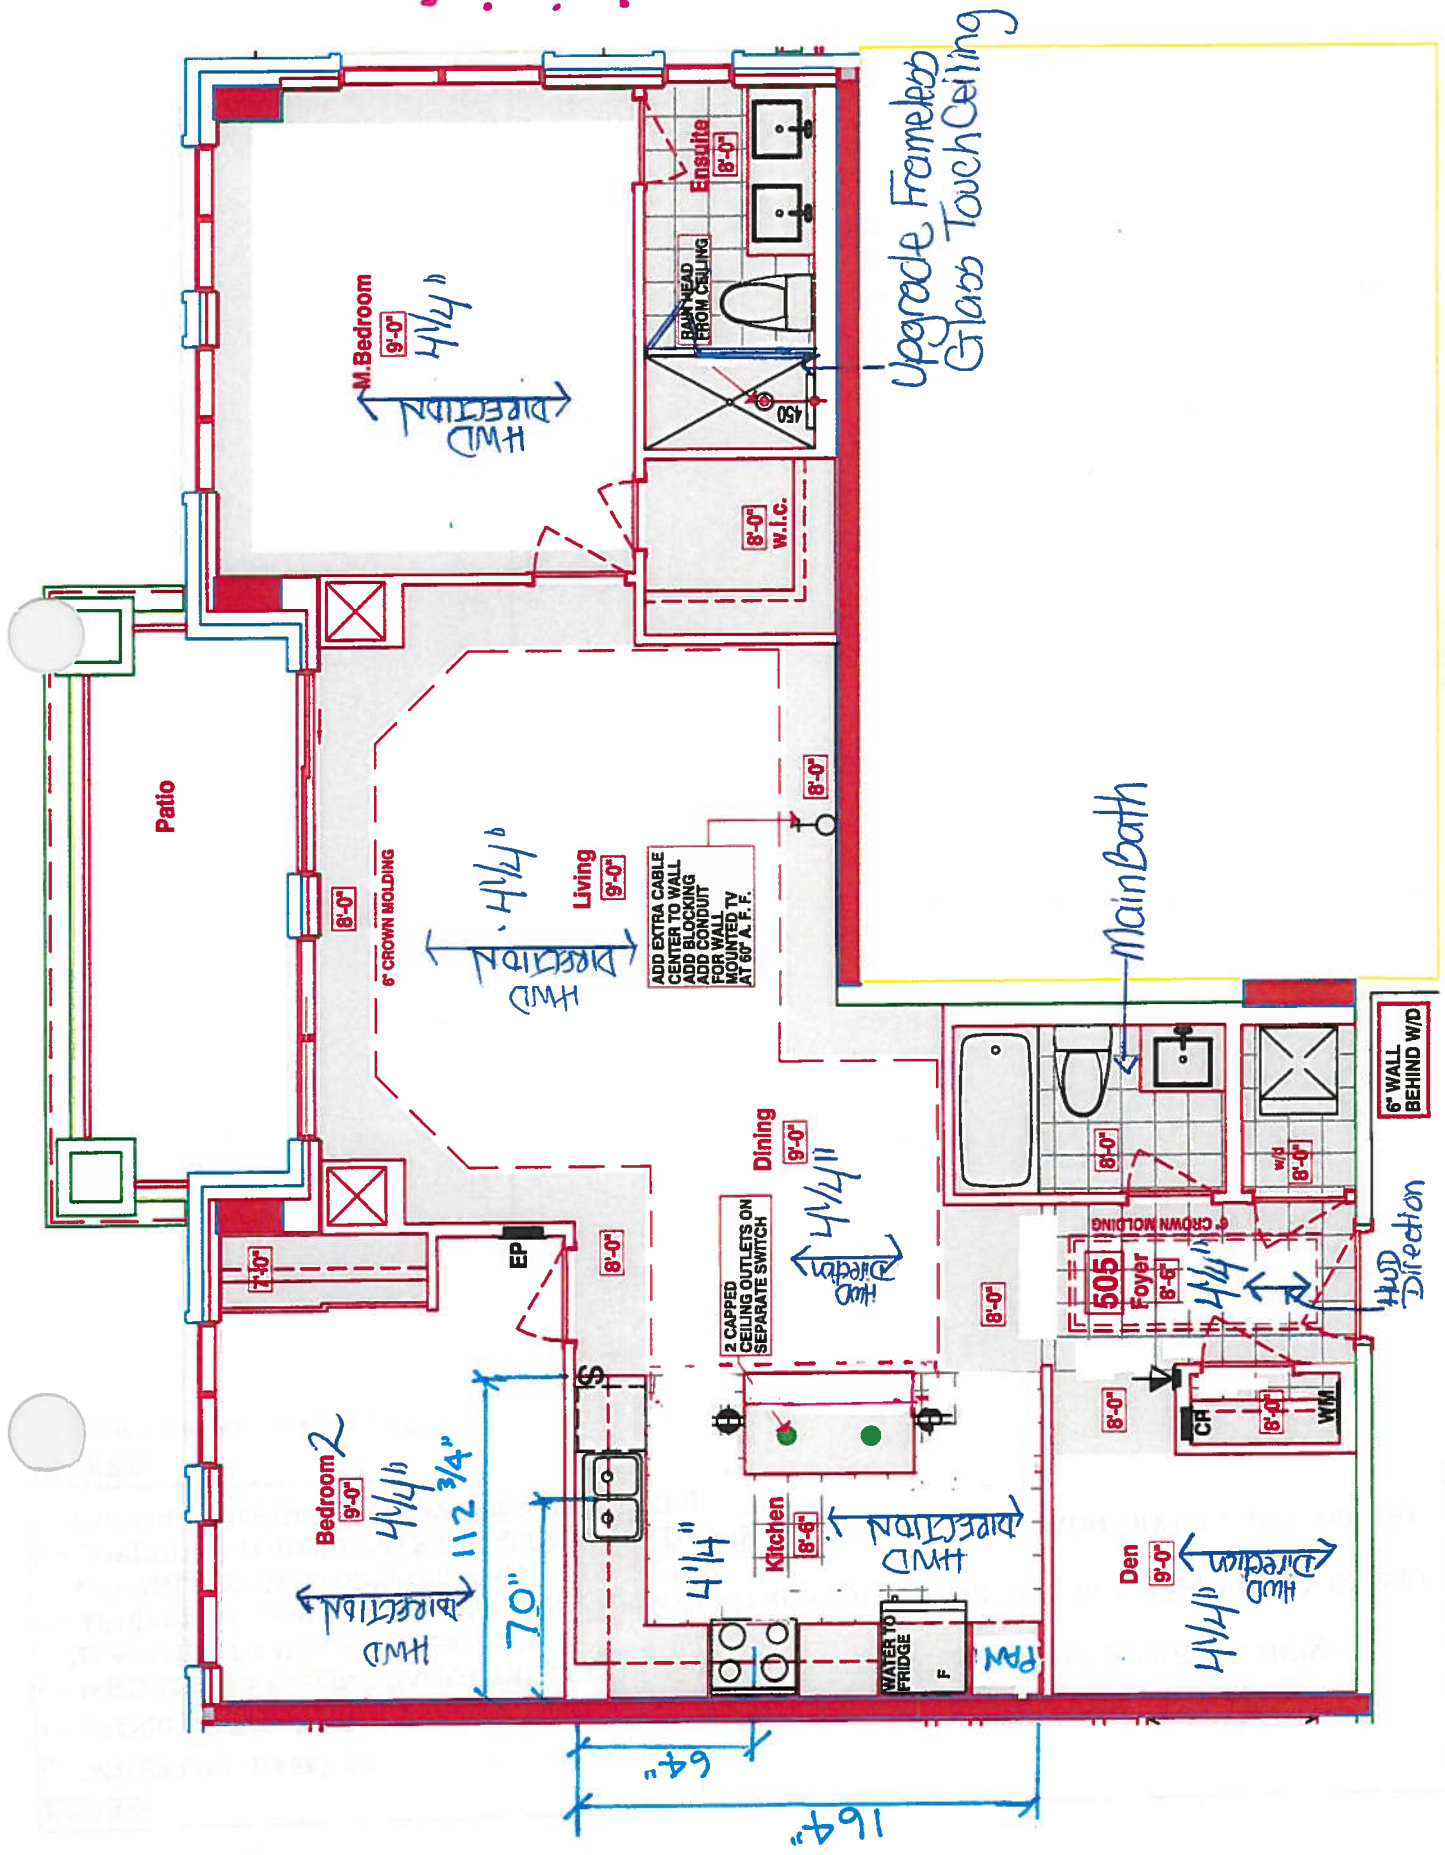



CONSTRUCTION SUMMARY

Hampton Place

PURCHASERS: GARY W. JAROSZ and GABRIELLA JAROSZ

TEL: RES.: 905-472-6816 BUS.: 416-294-3607

LOT NUMBER	PHASE	HOUSE TYPE	CLOSING DATE
505	1	LAUREL	30-Oct-18

Offer Workshee	ADDITIONAL - SINGLE PARKING UNIT Note:
-------------------	---

Upgrade	ADDITIONAL - LOCKER UNIT Note:
---------	-----------------------------------

Offer Upgrade	WATER LINE TO FRIDGE Note:
------------------	-------------------------------

Offer Upgrade	RAINHEAD FROM CEILING IN MASTER ENSUITE SHOWER, FROM VENDORS STANDARD SAMPLES Note:
------------------	--

Offer Upgrade	INSTALL TWO CEILING CAPPED OUTLETS ON SEPARATE SWITCH, CENTERED IN BULKHEAD ABOVE ISLAND IN KITCHEN AS PER SKETCH Note:
------------------	--

Offer Upgrade	ADDITIONAL CABLE OUTLET IN LIVING ROOM CENTERED EQUALLY ON WALL BETWEEN WALK IN CLOSET AND WALL TOWARD DINING ROOM AS PER SKETCH Note:
------------------	---

Offer Upgrade	CONDUIT AND BLOCKING FOR WALL MOUNTED TV IN LIVING ROOM WHERE ADDITIONAL CABLE OUTLET WAS ADDED (60 INCHES ABOVE FINISHED FLOOR) Note:
------------------	---





SITE COPY

CONSTRUCTION SUMMARY
Hampton Place

PURCHASERS: GARY W. JAROSZ and GABRIELLA JAROSZ TEL: RES.: 905-472-6816 BUS.: 416-294-3607

LOT NUMBER	PHASE	HOUSE TYPE	CLOSING DATE	
505	1	LAUREL	30-Oct-18	

Date Added: 28-Feb-18 Invoice Number: 7122

1 - CLARIFICATION; REFER TO APAS;
LIVINGROOM - Standard electrical outlet to be installed at standard height beside conduit pipe Additional electrical outlet to be installed beside pipe & standard cable rough-in Approx. 60" AFF (See Attached Sketch)
As per Vince at Head-Office

1 - FOYER & KITCHEN - Install Standard Laminate Flooring in lieu of Standard Porcelain Tiles throughout Foyer and Kitchen, where applicable (See Sketch)
Note:

1,015 - HARDWOOD FLOORING - Install prefinished 4 1/4" x 1/2" Stained Red Oak Floaring Lock Flooring in lieu of standard laminate flooring. To installed throughout suite, where applicable.
Note: To Include; Foyer, Kitchen, Den, Living Room, Dining Room, Master Bedroom and Bedroom #2 (See Sketch)

1 - CLARIFICATION;
HARDWOOD FLOORING - Purchaser has requested the floating hardwood flooring be installed Vertically from Front Door. (Please Refer to Sketch for Direction of Hardwood) (See Sketch)
Note: Approved as per Vince at head-office
The Above Request will Only be Completed IF POSSIBLE

1 - LAUNDRY ROOM - 2ND UPGRADE - PORCELAIN TILES - 13x13 HELLO SILVER - To be installed throughout laundry room floor (See Sketch)
Note:

1 - KITCHEN & BATHROOMS - Purchaser has DECLINED All Upgrades offered during decor appointment at the decor centre for kitchen & bathroom cabinetry. Standard Kitchen Layout & Standard Bathroom Vanities to be installed as per standard plan. (See Sketch)
Note:

1 - KITCHEN - CABINETRY - UPGRADE PACKAGE #1 - Category 3 Fiberboard Cloud White QT 4401 - To be installed throughout kitchen, where applicable (See Sketch)
Note:

1 - KITCHEN - CABINETRY HARDWARE - MIX & MATCH STANDARD CABINETRY HARDWARE - To be installed throughout kitchen, where applicable (See Sketch)
Standard Handle - Style #3487-128 - Kitchen Drawers
Standard Knob - Style #B603-SC - Kitchen Cabinets
Note:

1 - MAIN BATH - CABINETRY - UPGRADE PACKAGE #1 - Category 3 Fiberboard Cloud White QT 4401 - To be installed throughout main bath vanity, where applicable (See Sketch)
Note:

1 - KITCHEN - Install Standard Granite Countertop - BIANCO ANTICO - To be installed throughout kitchen, where applicable. (does not include granite backsplash) (See Sketch)
Note:

1 - KITCHEN - COUNTERTOP EDGING - Install UPGRADE " I " EDGING - To be installed throughout kitchen countertop, where applicable (See Sketch)
Note:

1 - DISCLAIMER - GRANITE COUNTERTOP;
KITCHEN - Due to the many variables that can affect the pattern, colour and/or design and "pitting" of natural products, granite installed will not be identical to the samples displayed.
Note: Every effort is made to provide granite countertops as close as possible but the vendor is not responsible for results which differ from the sample displayed. All countertop surfaces may have seams, and product pattern and shade can change in areas containing seams.

1 - DISCLAIMER - STONE COUNTERTOP;
KITCHEN -
Note: Stone slabs vary in size & all seams are visible & the fabricator reserves the right to position the seams as necessary.

1 - KITCHEN - Kitchen Backsplash - DELETE - Do Not Install / Supply / Credit Purchaser for Builders Standard Kitchen Backsplash (See Sketch)
Note:



SITE COPY

CONSTRUCTION SUMMARY

Hampton Place

PURCHASERS: GARY W. JAROSZ and GABRIELLA JAROSZ

TEL: RES.: 905-472-6816 BUS.: 416-294-3607

LOT NUMBER	PHASE	HOUSE TYPE	CLOSING DATE	
505	1	LAUREL	30-Oct-18	

Date Added: 28-Feb-18 Invoice Number: 7122

1 - KITCHEN - Kitchen Sink - Install Standard Undermount Sink - BLANCO Horizon Plus U2 Undermount Sink (8") - Model # 401234

1 - KITCHEN - Kitchen Faucet - Install Standard Faucet - DELTA Chrome Pull-Out Kitchen Faucet (Single Hole) - Model # 469LF - Chrome

Note:

1 - APPLIANCE PACKAGE - Install Upgrade Appliance Package - UPGRADE PACKAGE #1 - To be installed throuhgout suite, where applicable (See Sketch)

Note:

1 - MAIN BATH - 2ND UPGRADE - CAESARSTONE COUNTERTOP - 5141 FROSTY CARRINA - To be installed throughout main bath vanity, where applicable (Includes 3" Splash)

Note:

1 - MASTER ENSUITE - 2ND UPGRADE - CAESARSTONE COUNTERTOP - 5141 FROSTY CARRINA - To be installed throughout master ensuite vanity, where applicable (Includes 3" Splash)

Note:

1 - CLARIFICATION;
MAIN BATH & MASTER ENSUITE - Install Standard 3" Splash throughout Main Bath and Master Ensuite vanity countertops, where applicable (See Sketch)

Note:

1 - MASTER ENSUITE - Install UPGRADE FRAMELESS GLASS SHOWER ENCLOSURE at Master Ensuite shower stall. Glass to Extend Up to the ceiling (See Sketch)

1 - CLARIFICATION - REFER TO APAS;
MASTER ENSUITE - Install Rain Shower Head from Ceiling at Master Ensuite Shower Stall - DELTA - Shower Trim and Hansgrohe Slide Bar with Handheld and Ceiling Mount Showerhead

Note: Model # R10000 / T13020-CDN/27454002 / 277440 / RP52382 / RP46870 / RP6025 / R11000 / T11800 - Chrome (See Sketch)

1 - CLARIFICATION;
MAIN BATH & MASTER ENSUITE - Install Standard Plumbing Fixtures throughout Main Bath and Master Ensuite, where applicable (See Sketch)

Note:

1 - CLARIFICATION;
MAIN BATH & MASTER ENSUITE - DELETE Do Not Install / Supply / Credit Purchaser for builders standard ceramic bathroom accessories (toilet paper, towel bar & soap dish) throughout all bathrooms where applicable

Note: To Include; Main Bath & Master Ensuite (See Sketch)

1 - PURCHASER HAS ATTENDED A COLOR APPOINTMENT AT THE DECOR CENTRE AND HAS DECLINED ANY ADDITIONAL UPGRADES. Purchaser accepts and acknowledges that there will be no further changes/additions/deletions to be made upon signing on February 21,2018

Note:

1 -PURCHASER AWARE AND ACCEPTS THAT ANY CHANGES MADE TO UPGRADES AFTER SIGNING THIS PURCHASERS EXTRA ARE SUBJECT TO A MINIMUM ADMINISTRATION FEE OF \$1,000 PLUS A 10% HOLDBACK FEE.

This Document is Extremely Time Sensitive - Printed 19 Mar 18 at 11:33



* INTERIOR

OUR SCHEME *

Purchasers

GARY W. JAROSZ & GABRIELLA JAROSZ

Decor Consultant

Melissa Di Marino

Model Type

LAUREL

Telephone Res. / Bus

(905) 472-6816 / (416) 294-3607

Project

Hampton Place

Closing Date

30/10/2018

Unit

505

Page 1 of 3

MASTER ENSUITE

MAIN BATHROOM

POWDER ROOM

KITCHEN / DINETTE

FOYER

LAUNDRY

LIVING ROOM

DINING ROOM

DEN

MASTER BEDROOM

BEDROOM 2

BEDROOM 3

Flooring


Description	Wall Tile
13x13 HELLO SILVER (STD)	Main 8x10 CARRARA MATT (STD)
13x13 HELLO SILVER (STD)	8x10 CARRARA MATT (STD)
N/A	N/A
1/4" Mirage Red Oak Charcoal (SemiGloss) (Upg)	DELETE - Do Not Install / Supply / Credit
1/4" Mirage Red Oak Charcoal (SemiGloss) (Upg)	N/A
13x13 HELLO SILVER (UPG)	N/A
1/4" Mirage Red Oak Charcoal (SemiGloss) (Upg)	
1/4" Mirage Red Oak Charcoal (SemiGloss) (Upg)	
N/A	

Notes

KITCHEN CABINETRY HARDWARE - INSTALL STANDARD HANDLE - STYLE #3487-128 - THROUGHOUT KITCHEN DRAWERS
KITCHEN CABINETRY HARDWARE - INSTALL STANDARD KNOB - STYLE #B603-SC - THROUGHOUT KITCHEN CABINETS

Page 1 of 3

Consultant: 
Melissa Di Marino

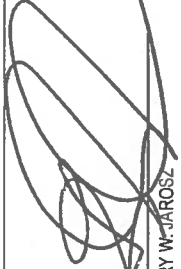Purchaser: 
GARY W. JAROSZ

Purchaser: 
GABRIELLA JAROSZ

Vendor: 
Hampton Place



* INTERIOR * OUR SCHEME *

Purchasers		Decor Consultant	Model Type	Telephone Res. / Bus	Project	Closing Date	Unit
GARY W. JAROSZ & GABRIELLA JAROSZ		Melissa Di Marino	LAUREL	(905) 472-6816 / (416) 294-3607	Hampton Place	30/10/2018	505

Page 2 of 3

CABINETRY, VANITIES AND COUNTERTOPS

Style	Countertop	Counter Edge	Handle / Knob
☒ CATEGORY 3 - FIBERBOARD - CLOUD WHITE QT 4401 (UPG)	☒ 5141 Frosty Carina CaesarStone (Upg)	☒ A * EDGE (STD)	B603-SC
☒ CATEGORY 2 - MAPLE - PISTACHIO QT 2503 (STD)	☒ 5141 Frosty Carina CaesarStone (Upg)	☒ A * EDGE (STD)	B603-SC
☐ N/A	☐ N/A	☐ N/A	☐ N/A
☒ CATEGORY 3 - FIBERBOARD - CLOUD WHITE QT 4401 (UPG)	☒ BIANCO ANTICO GRANITE (STD)	☒ I * EDGE (UPG)	*See Notes*
☐ N/A	☐ N/A	☐ N/A	☐ N/A
☐	☐	☐	☐
☐	☐	☐	☐

APPLIANCE PACKAGE

Upgrade
Package #1

Std 31in Opening

PLUMBING FIXTURES

KITCHEN	
Sink Model	☒ STANDARD
Sink Faucet	☒ STANDARD
TOILETS	
Master Ensuite	☒ STANDARD
Main Bathroom	☒ STANDARD
Powder Room	☐ N/A
VANITY FAUCETS	
Master Ensuite	☒ STANDARD
Main Bathroom	☒ STANDARD
Powder Room	☐ N/A
VANITY SINKS	
Master Ensuite	☒ STANDARD
Main Bathroom	☒ STANDARD
Powder Room	☐ N/A
SHOWER STALL / TUBS	
Master Ensuite Shower Stall	☒ STANDARD
Master Ensuite Tub	☐ N/A
Main Bathroom Tub	☒ STANDARD

Trim

Baseboard & Casing	☒ STANDARD
Interior Doors	☒ STANDARD - CARRARA SMOOTH
Cornice Moulding / Medallion	
Foyer	☒ STANDARD - #CTR-611
Living Room	☒ STANDARD - #CTR-611
Dining Room	☒ STANDARD - #CTR-611
Den	☐ NONE
Master Bedroom	☐ NONE
Bedroom 2	☐ NONE
Bedroom 3	☐ N/A

Levers

Door Height	☒ STANDARD
	☐ STANDARD

Fireplace


Location	☐ N/A
Flooring	☐ N/A
Style	☐ N/A
Finish	☐ N/A
Marble	☐ N/A
Hearth	☐ N/A


Paint Throughout

Walls	☒ STANDARD - BIRCH WHITE
Trim	☒ STANDARD - WHITE

Page 2 of 3


Decor Consultant: 
Melissa Di Marino

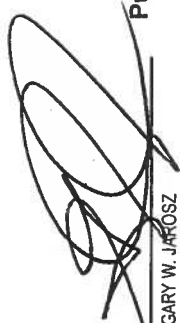Purchaser: 
GARY W. JAROSZ

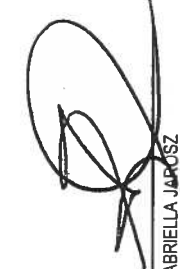Purchaser: 
GABRIELLA JAROSZ

Vendor: 
Hampton Place

Suite 505 Hampton

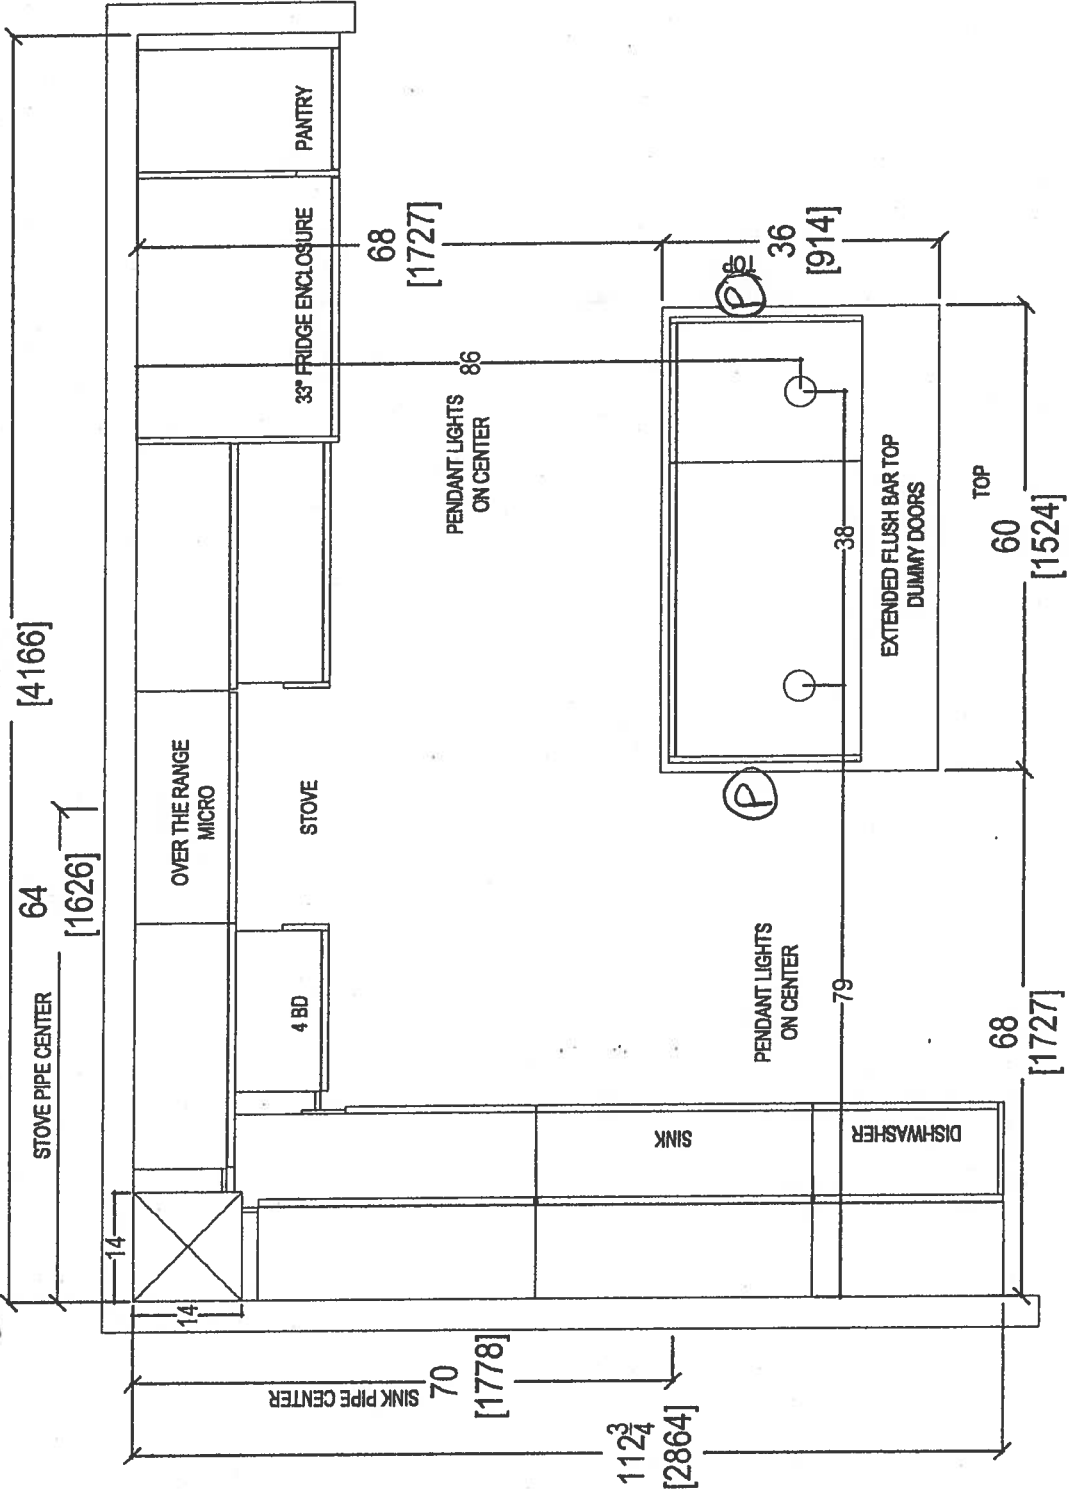

- UPG #1 - APPLIANCE PACKAGE
- (x4) - PUCK LIGHTS
- (x2) - PLUGS ISLAND.
- (x2) - CAPPED LIGHTS OVER ISLAND.
- DELETE BACKSPLASH.




80 SANTE DRIVE, VAUGHAN, ON L4K 3C4.
T: 416.746.1811 F: 905.761.5901

CLIENT: ROYAL PINE HOMES		JOB NAME: UNIT 505 HMP	ROOM:	KITCHEN FLOOR PLAN	DRAWN BY: SK	COMMENTS: PLEASE NOTE ALL DIMENSIONS ARE NOT FINAL AND ARE SUBJECT TO CHANGE UPON FINAL SITE MEASURE
SITE: HAMPTON PLACE	DOOR STYLE: —	DOOR HANDLE: —	SCALE: 1/2" = 1' - 0"			
PHONE: —	FINISH: —	DRW HANDLE: —	DATE: MARCH 5, 2018			
EMAIL: —	SPECIES: —	TOP: —	PAGE: —			

Suite 505
Hampton

Rock Light (X4)

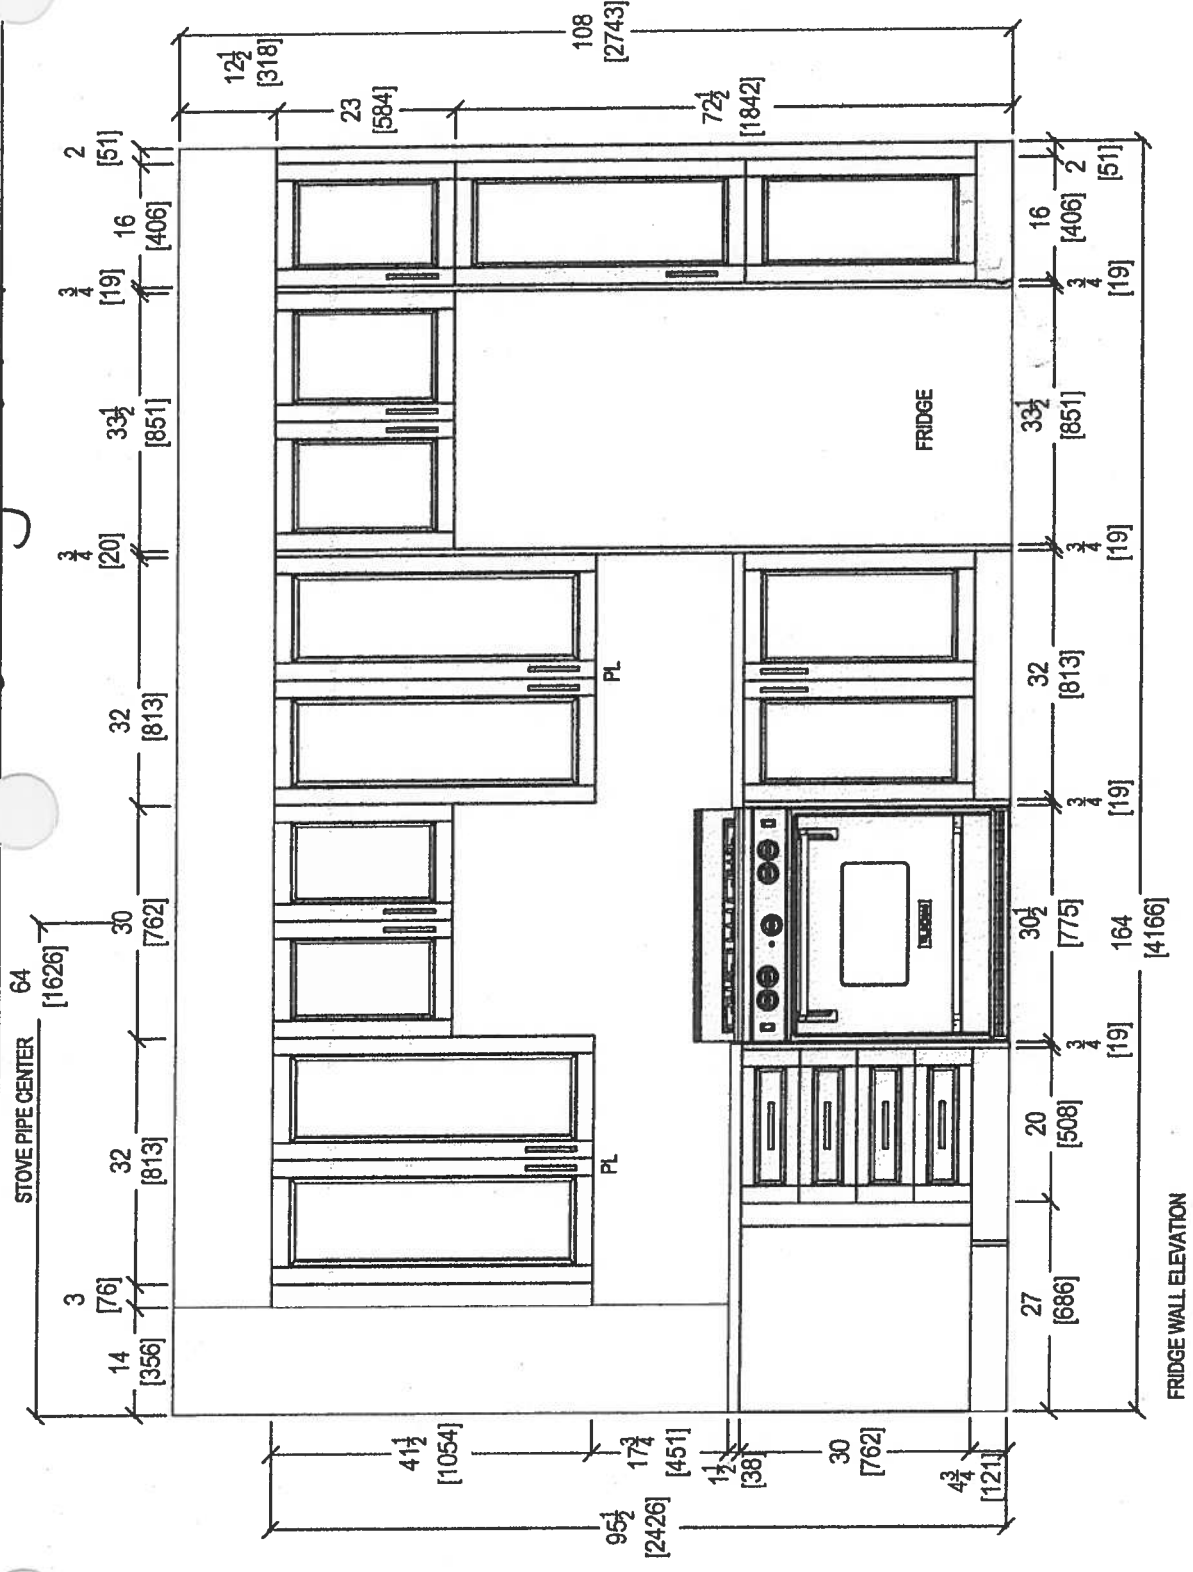


FRIDGE WALL ELEVATION



80 SANTE DRIVE, VAUGHAN, ON L4K 3C4,
T: 416.746.1811 F: 905.761.5901

CLIENT: ROYAL PINE HOMES	JOB NAME: UNIT 505 HMP	ROOM: KITCHEN	DRAWN BY: SK	COMMENTS:
SITE: HAMPTON PLACE	DOOR STYLE: —	DOOR HANDLE: —	SCALE: 1/2" = 1'-0"	PLEASE NOTE ALL DIMENSIONS ARE NOT FINAL AND ARE SUBJECT TO CHANGE UPON FINAL SITE MEASURE
PHONE: —	FINISH: —	DRW HANDLE: —	DATE: MARCH 5, 2018	
EMAIL: —	SPECIES: —	TOP: —	PAGE: —	

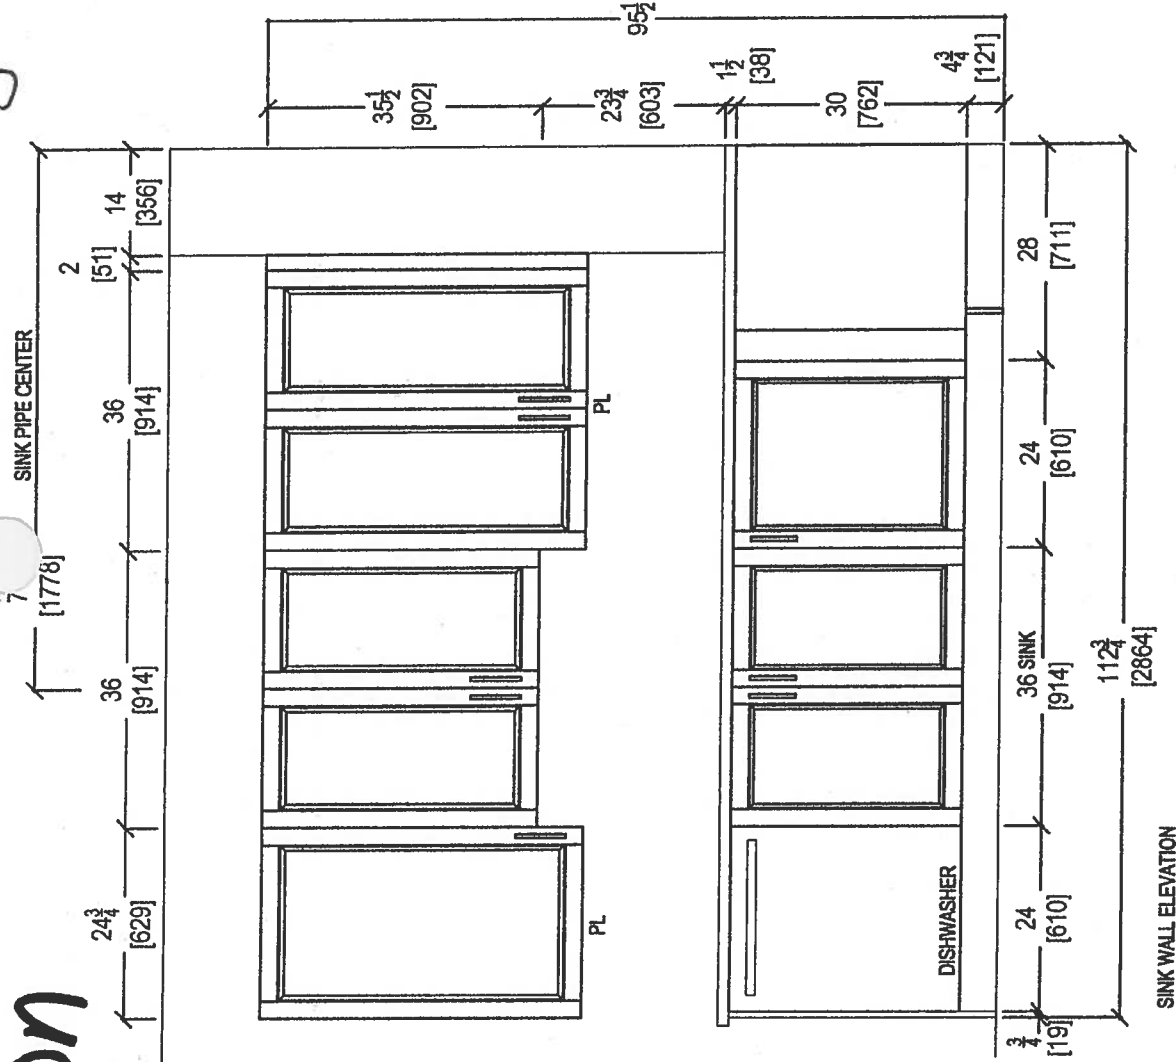


SINK WALL ELEVATION


your kitchen, your taste.
80 SANTE DRIVE, VAUGHAN, ON L4K 3C4,
T: 416.746.1811 F: 905.761.5901

CLIENT: ROYAL PINE HOMES	JOB NAME: UNIT 505 HMP	ROOM: KITCHEN	DRAWN BY: SK	COMMENTS: PLEASE NOTE ALL DIMENSIONS ARE NOT FINAL AND ARE SUBJECT TO CHANGE UPON FINAL SITE MEASURE
SITE: HAMPTON PLACE	DOOR STYLE: —	DOOR HANDLE: —	SCALE: 1/2" = 1' - 0"	
PHONE: —	FINISH: —	DRW HANDLE: —	DATE: MARCH 5, 2018	
EMAIL: —	SPECIES: —	TOP: —	PAGE: —	

Suite 503 Hampton




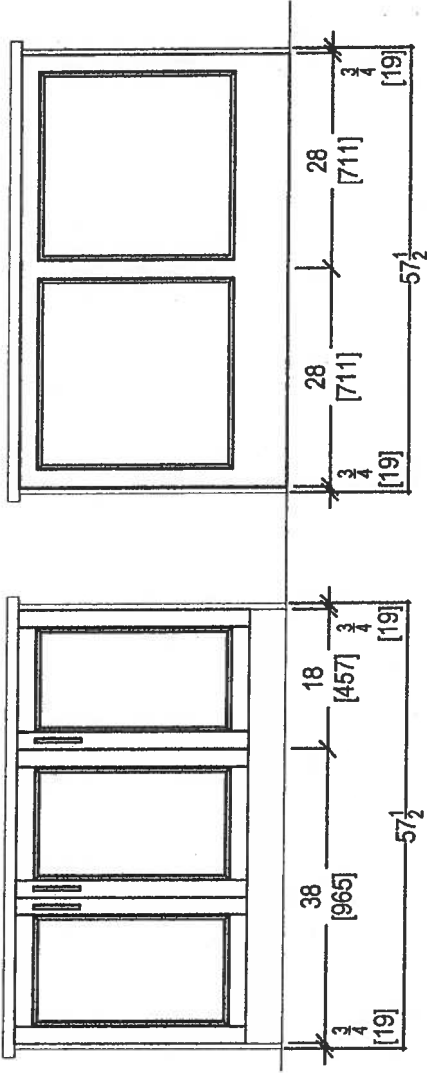


your kitchen, your taste.
80 SANTE DRIVE, VAUGHAN, ON L4K 3C4,
T: 416.746.1811 F: 905.761.5901

CLIENT: ROYAL PINE HOMES		JOB NAME: UNIT 503 HMP	ROOM: KITCHEN	DRAWN BY: SK	COMMENTS: PLEASE NOTE ALL DIMENSIONS ARE NOT FINAL AND ARE SUBJECT TO CHANGE UPON FINAL SITE MEASURE
SITE: HAMPTON PLACE	DOOR STYLE: —	DOOR HANDLE: —	SCALE: 1/2" = 1' - 0"		
PHONE: —	FINISH: —	DRW HANDLE: —	DATE: MARCH 5, 2018		
EMAIL: —	SPECIES: —	TOP: —	PAGE: —		

Suite 505, Hampton

Install 3" Splash

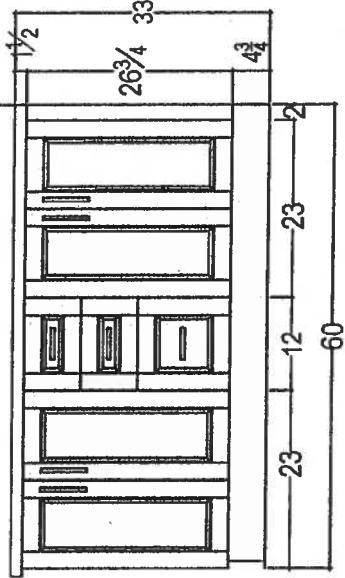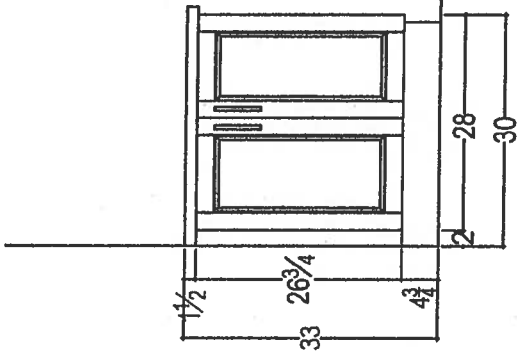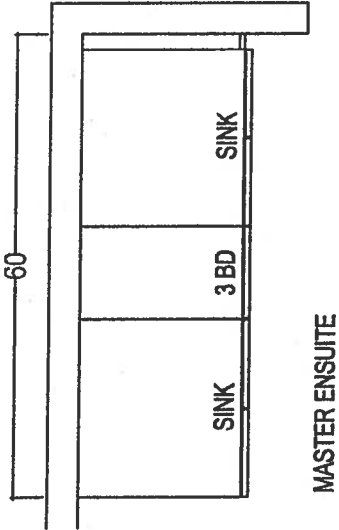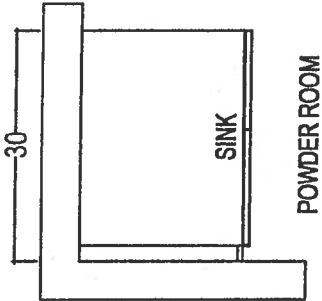

80 SANTE DRIVE, VAUGHAN, ON L4K 3C4,
T: 416.746.1811 F: 905.761.5901

CLIENT: ROYAL PINE HOMES
SITE: HAMPTON PLACE
PHONE: ---
EMAIL: ---

JOB NAME: UNIT 505 HMP
DOOR STYLE: ---
FINISH: ---
SPECIES: ---

ROOM: VANITIES
DOOR HANDLE: ---
DRW HANDLE: ---
TOP: ---

DRAWN BY: SK
SCALE: 1/2" = 1'-0"
DATE: MARCH 5, 2018
PAGE: ---

COMMENTS:
PLEASE NOTE ALL DIMENSIONS
ARE NOT FINAL AND ARE
SUBJECT TO CHANGE UPON
FINAL SITE MEASURE

Suite 505
Hampton


Upgrade
Package I

WRB322DMBM

Whirlpool®

33-inches wide Bottom-Freezer Refrigerator with
SpillGuard™ Glass Shelves - 22 cu. ft

<http://www.whirlpool.com>

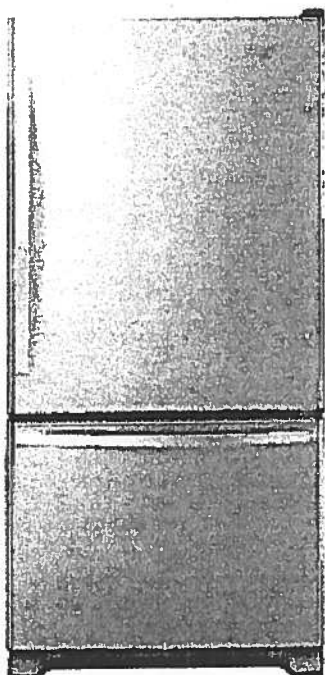

Key Features:

- SpillGuard™ Glass Shelves
- Adaptive Defrost / *Factory Installed Ice Maker*
- FreshFlow™ Produce Preserver
- LED Interior Lighting
- ENERGY STAR® Qualified

Product Dimensions:

Height: 70
Width: 32 5/8
Depth: 33 3/8

Electrical Requirements:

15

Additional Information:

[Use And Care Guide](#)
[Dimension Guide](#)
[Energy Guide](#)
[Warranty Certificate](#)

INVESTED
IN
AMERICA



©Registered trademark/TM Trademark of Whirlpool, U.S.A. © 2018 Whirlpool Corporation. All Rights Reserved.
All other trademarks are owned by their respective companies.
Because Whirlpool Corporation policy includes a continuous commitment to improve our products, we reserve the right to change materials and specifications without notice. We also reserve the right to discontinue or transition products without notice.
Manufacturer's Suggested Retail Price (MSRP) and Minimum Advertised Price (MAP) provided for reference purposes only. Dealer alone determines advertised and retail prices.
Created On: Tuesday, March 14, 2017 11:30:08

Suite 505
Hampton


Upgrade
Package I

WEE745H0FS

Whirlpool®

6.4 Cu. Ft. Slide-In Electric Range with True
Convection

<http://www.whirlpool.com>

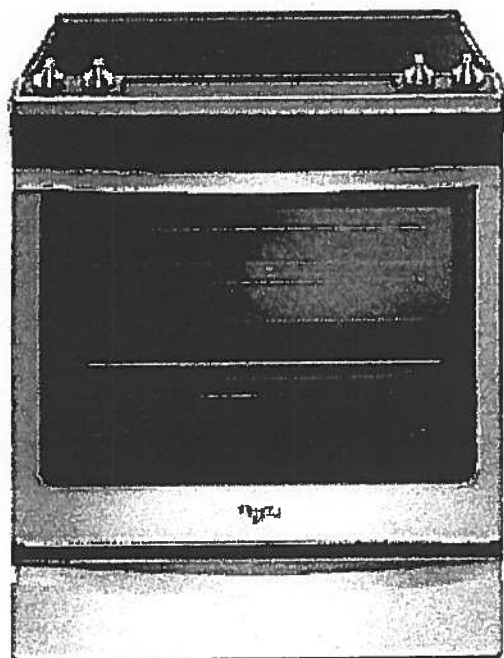

Key Features:

- Frozen Bake™ Technology
- True Convection Cooking
- FlexHeat™ Triple Radiant Element
- Convection Conversion
- AquaLift® Self-Cleaning Technology
- Temperature Sensor
- Rapid Preheat
- 6.4 Cu. Ft. Capacity
- Easy-Wipe Ceramic Glass Cooktop
- Large Oven Window
- Max Capacity Rack
- Hidden Bake Element

Product Dimensions:

Height: 36

Width: 29 7/8

Additional Information:

[Use And Care Guide](#)

[Dimension Guide](#)

[Installation Guide](#)

[Warranty Certificate](#)

INVESTED
IN
AMERICA



©Registered trademark/TM Trademark of Whirlpool, U.S.A. © 2016 Whirlpool Corporation. All Rights Reserved.
All other trademarks are owned by their respective companies.
Because Whirlpool Corporation policy includes a continuous commitment to improve our products, we reserve
the right to change materials and specifications without notice. We also reserve the right to discontinue or
transition products without notice.
Manufacturer's Suggested Retail Price (MSRP) and Minimum Advertised Price (MAP) provided for reference
purposes only. Dealer alone determines advertised and retail prices.
Created On: Friday, January 27, 2017 10:46:47

Suite 505
Hampton

Upgrade
Package 1



YWMH76719CS

1.9 cu. ft. Microwave Hood Combination with
TimeSaver™ Plus True Convection



<http://www.whirlpool.com>

Key Features:

- TimeSaver™ Plus True Convection Cooking System
- Steam Cooking
- Sensor Cooking
- AccuPop™ Cycle
- CleanRelease® Non-Stick Interior
- SteamClean Option
- Integrated Hidden Vent and Console
- Auto Adapt Fan
- Recessed, Stoppable Glass Turntable
- Universal Microwave Steamer
- 1.9 cu. ft. Capacity
- 1,100 Watts Cooking Power

Product Dimensions:

Height: 17 1/8

Width: 29 15/16

Depth: 18 1/2

Electrical Requirements:

15 or 20. 120 V.

Additional Information:


[Use And Care Guide](#)

[Installation Guide](#)

[Warranty Certificate](#)

Available in:

 Stainless Steel

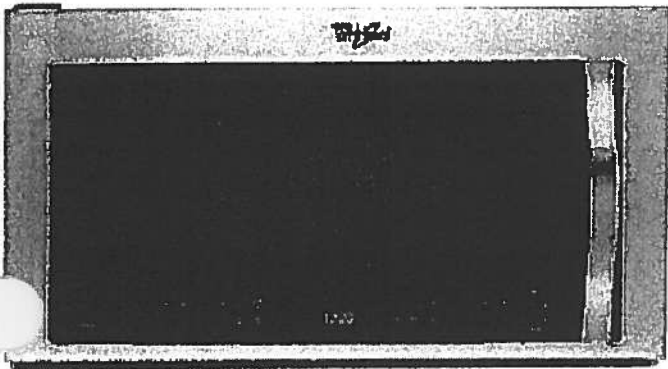

©Registered trademark/TM Trademark of Whirlpool, U S A. © 2013 Whirlpool Corporation. All Rights Reserved
All other trademarks are owned by their respective companies.

Because Whirlpool Corporation policy includes a continuous commitment to improve our products, we reserve the right to change materials and specifications without notice. We also reserve the right to discontinue or transition products without notice.

Manufacturer's Suggested Retail Price (MSRP) and Minimum Advertised Price (MAP) provided for reference purposes only. Dealer alone determines advertised and retail prices.

Created On: Monday, March 14, 2016 13:16:48

Suite 505
Hampton

Upgrade
Package 1

[Handwritten signature]

WDTA50SAHZ

Whirlpool®

<http://www.whirlpool.com>

Contemporary Design. Stainless Steel Tub
Dishwasher with TotalCoverage Spray Arm

Key Features:


- Sensor Cycle
- TotalCoverage Spray Arm
- 1-Hour Wash Cycle
- Tap Touch Controls

Product Dimensions:

Height: 34 1/2
Width: 23 7/8
Depth: 24 1/2

Additional Information:

[Use And Care](#)
[Dimension Guide](#)
[Installation Guide](#)
[Energy Guide](#)
[Warranty](#)

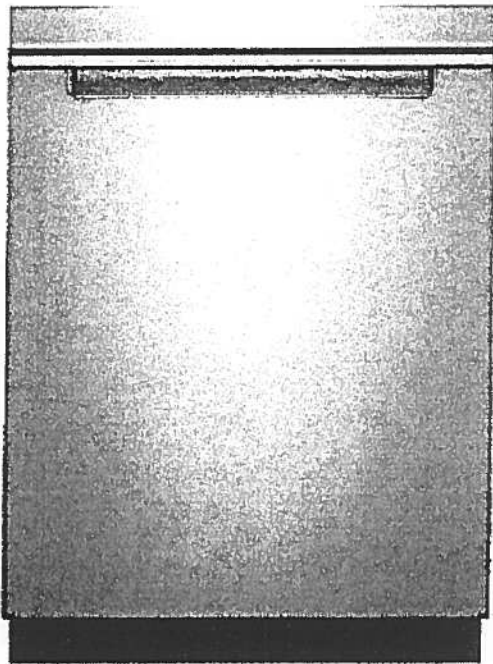

Available in:

☒ Black

Fingerprint Resistant Sunset Bronze

Fingerprint Resistant Black Stainless

☐ White

Fingerprint Resistant Stainless Steel

INVESTED
IN
AMERICA



©Registered trademark/TM Trademark of Whirlpool, U.S.A. © 2016 Whirlpool Corporation. All Rights Reserved. All other trademarks are owned by their respective companies.

Because Whirlpool Corporation policy includes a continuous commitment to improve our products, we reserve the right to change materials and specifications without notice. We also reserve the right to discontinue or transition products without notice.

Manufacturer's Suggested Retail Price (MSRP) and Minimum Advertised Price (MAP) provided for reference purposes only. Dealer alone determines advertised and retail prices.

Suite 505
Hampton

Upgrade
Package I




WFW75HEFW

4.5 cu. ft. Front Load Washer with Precision
Dispense



<http://www.whirlpool.com>

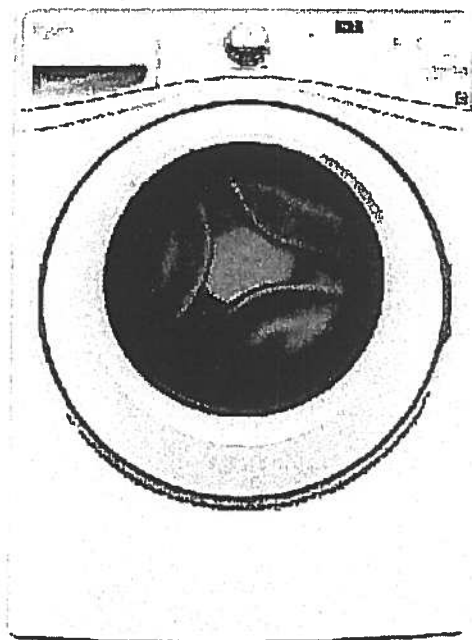

Key Features:

- Precision Dispense
- Adaptive Wash Technology
- Smooth Wave Stainless Steel Wash Basket
- 4.5 cu. ft. Capacity
- ENERGY STAR® Qualified

Product Dimensions:

Height: 39 3/4

Width: 27

Depth: 33 5/16

Electrical Requirements:

15 or 20. 120 V.

Additional Information:

[Use And Care Guide](#)

[Dimension Guide](#)

[Installation Guide](#)

[Energy Guide](#)

[Warranty Certificate](#)

INVESTED
IN
AMERICA



©Registered trademark/TM Trademark of Whirlpool, U.S.A. ©2013 Whirlpool Corporation All Rights Reserved.
All other trademarks are owned by their respective companies.
Because Whirlpool Corporation policy includes a continuous commitment to improve our products, we reserve
the right to change materials and specifications without notice. We also reserve the right to discontinue or
transition products without notice.
Manufacturer's Suggested Retail Price (MSRP) and Minimum Advertised Price (MAP) provided for reference
purposes only. Dealer alone determines advertised and retail prices.
Created On: Wednesday, March 23, 2016 11:51:03

Suite 505 Hampton Upgrade Package 1



YWED75HEFW

8.5 cu. ft. Duet® High Efficiency Front Load Electric
Dryer with ENERGY STAR®

Whirlpool®

<http://www.whirlpool.com>

MSRP: \$0.00

Key Features:

- Advanced Moisture Sensing System
- Quad Baffles
- Tap Touch Controls with Memory
- EcoBoost™ Option
- Wrinkle Shield™ Plus Option
- Undercounter Installation
- 7.4 Cu. Ft. Capacity
- ENERGY STAR® Qualified

Product Dimensions:

Height: 39

Width: 27


Depth: 31

Additional Information:

[Use And Care](#)

[Installation Guide](#)

[Warranty](#)

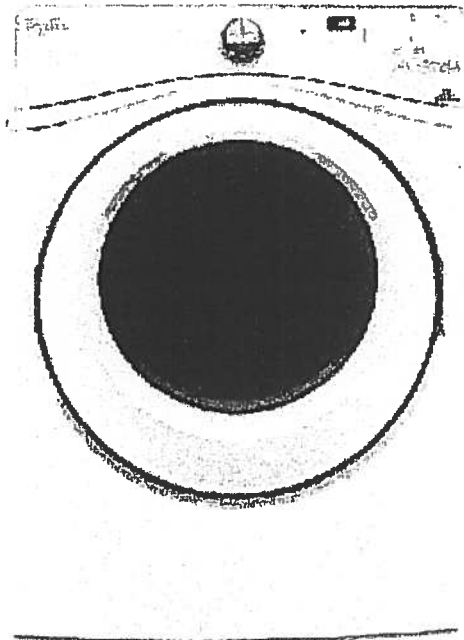

Available in:

☐ White

INVESTED
IN
AMERICA



®Registered trademark/TM Trademark of Whirlpool, U.S.A. © 2016 Whirlpool Corporation. All Rights Reserved. All other trademarks are owned by their respective companies.


Because Whirlpool Corporation policy includes a continuous commitment to improve our products, we reserve the right to change materials and specifications without notice. We also reserve the right to discontinue or transition products without notice.

Manufacturer's Suggested Retail Price (MSRP) and Minimum Advertised Price (MAP) provided for reference purposes only. Dealer alone determines advertised and retail prices.

Standard




Suite 505
Hampton

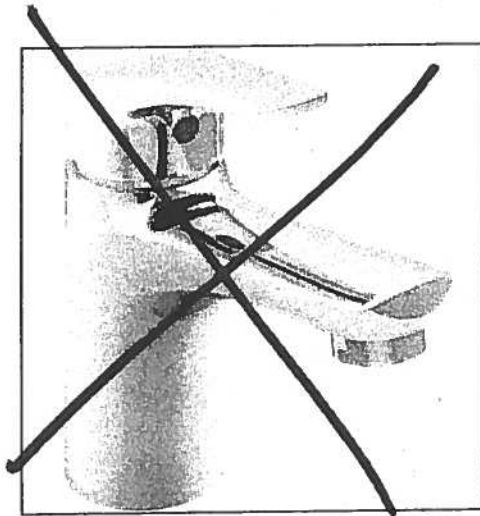


Delta Wynné Chrome Single Lever
Lavatory Faucet With Pop Up
#534LF

Master Ensuite
Shower Stall

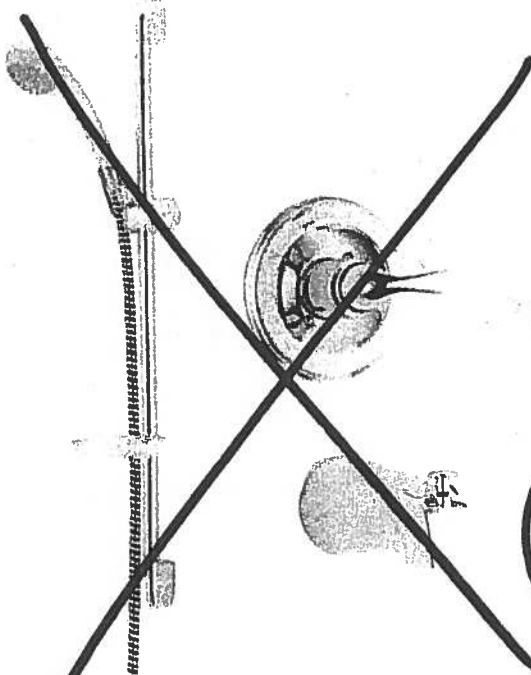

Delta Shower Trim with Tub Spout and
Hansgrohe Slide Bar with Handheld
#R10000/T13020-CDN/2001-TP/27454002/
27744000

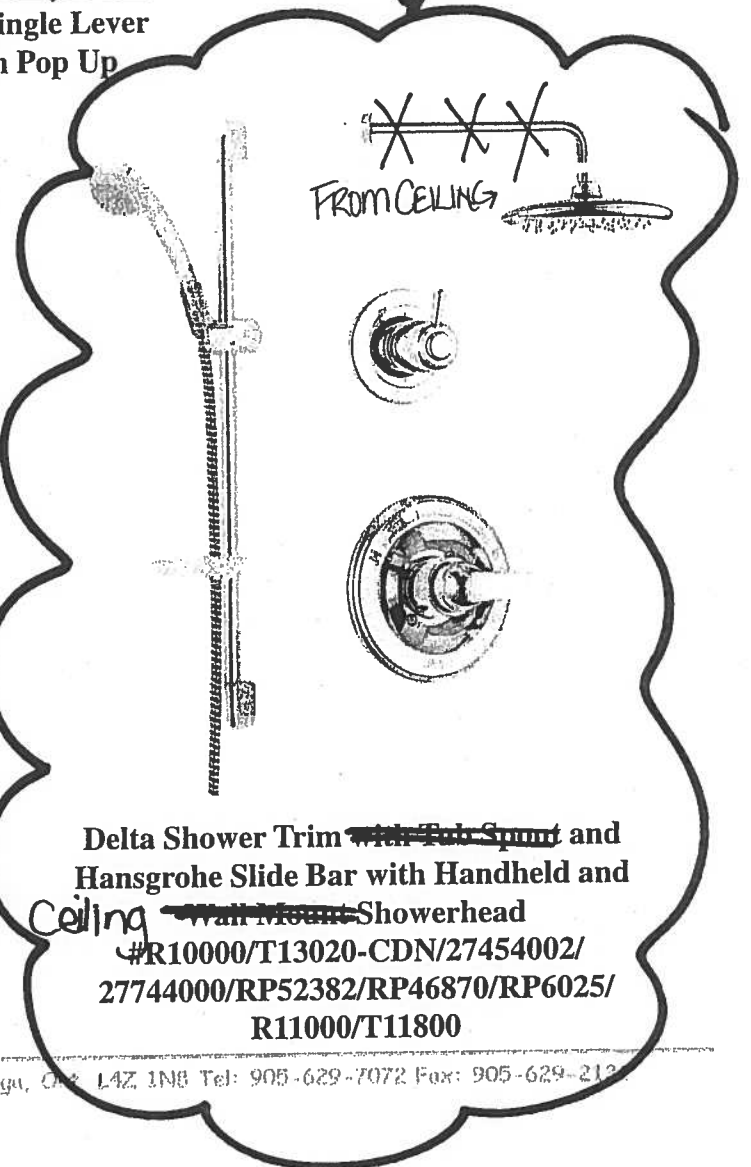


Delta Shower Trim ~~with Tub Spout~~ and
Hansgrohe Slide Bar with Handheld and
~~Wall Mount~~ Showerhead
#R10000/T13020-CDN/27454002/
27744000/RP52382/RP46870/RP6025/
R11000/T11800

Suite 505
Hampton

Living Room

→ CONDUIT:

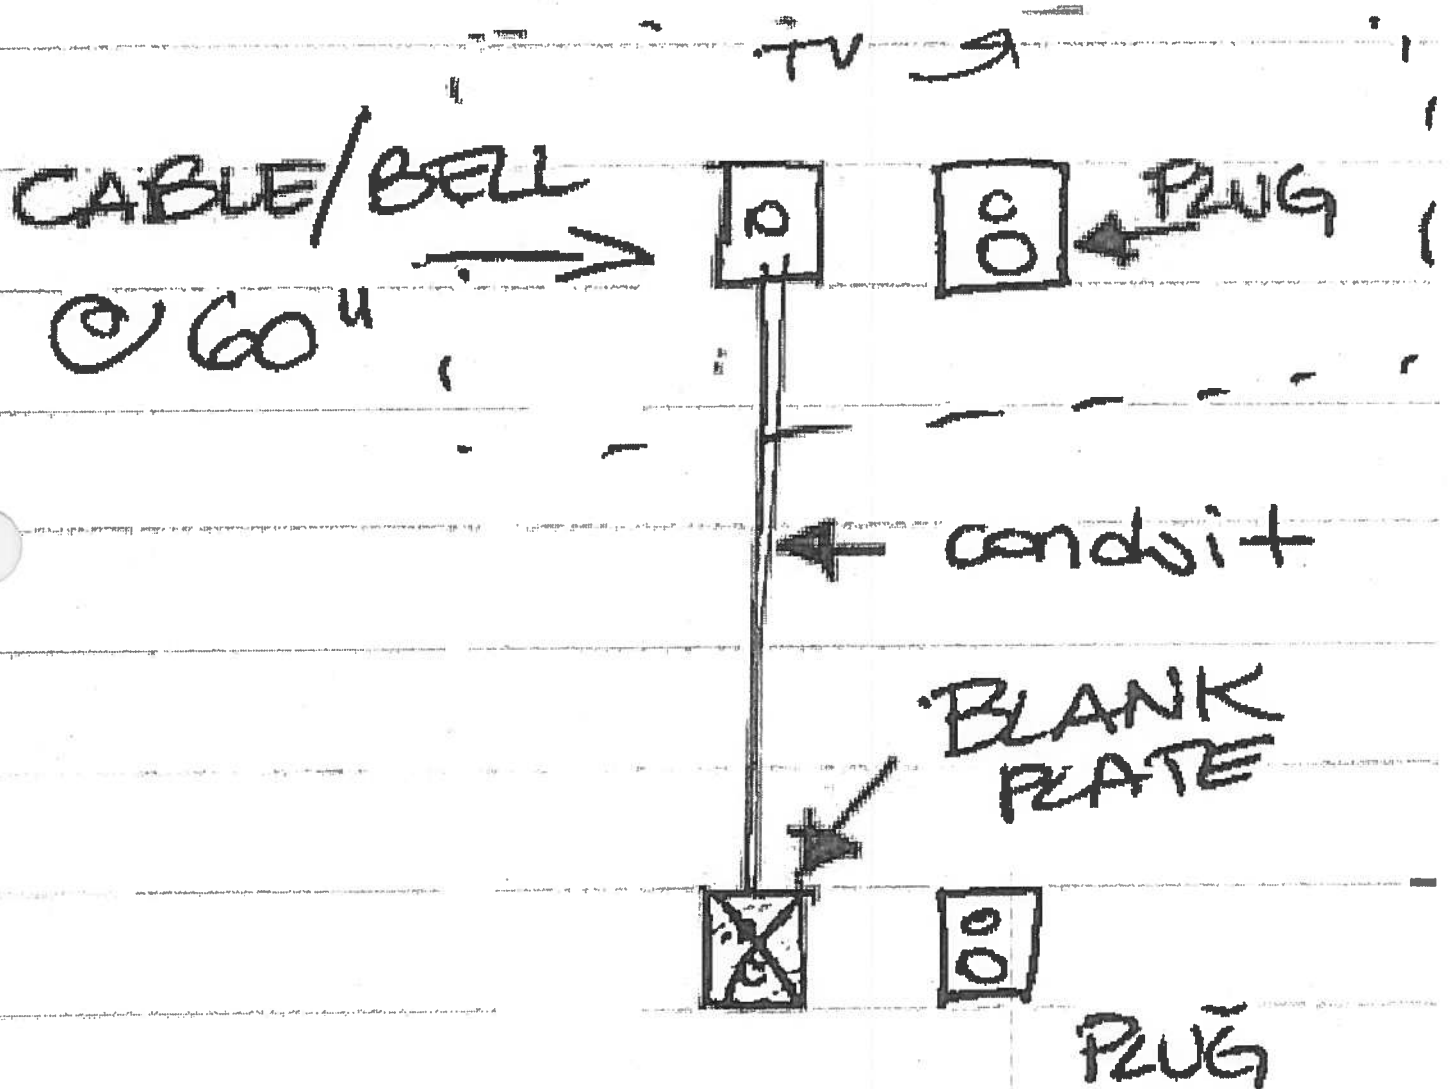

Countertop Edges

Suite 505

Hampton



CONNOLLY Marble & Granite Ltd.

EDGE
DETAILS

004


A.



STRAIGHT EDGE
(STANDARD - 3/4")

Standard:
Main Bath
Master Ensuite


I.

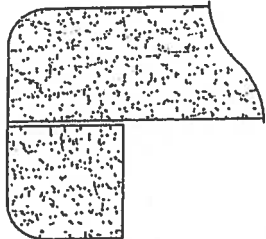

DOUBLE TOP "D" EDGE
(STANDARD - 1 1/2")

Upgrade:
Kitchen

M.

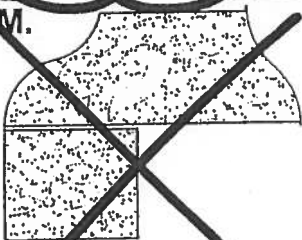

G GEE - SQUARE EDGE
(MED./HIGH - 1 1/2")

EDGING UP-GRADE OPTIONS