





Noyac Bay


Suite 507.

1,121 SQ FT *plus 81 sq. ft. of balcony area*


INVENTORY SUITE
ORIGINAL LAYOUT
(OLD).

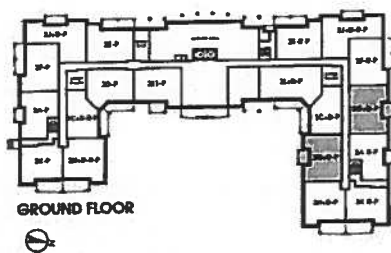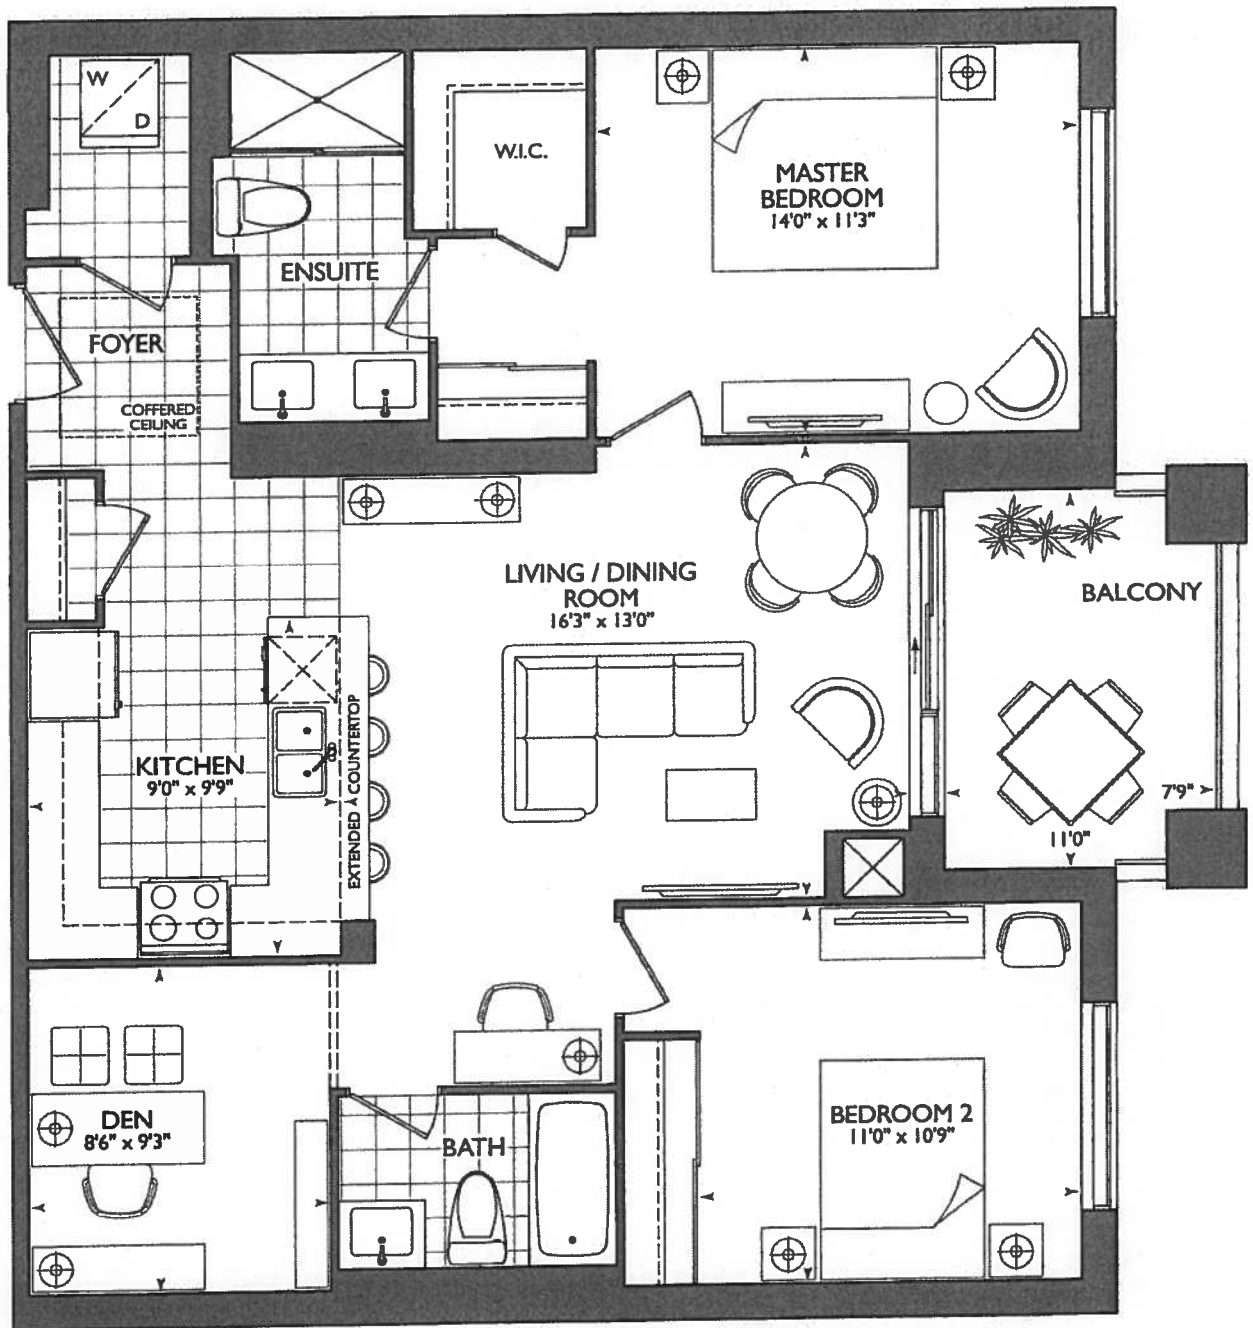

GROUND FLOOR

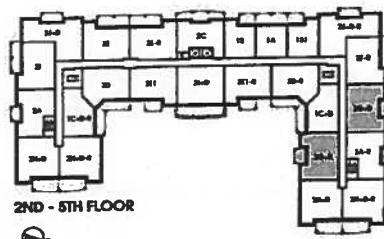

2ND - 5TH FLOOR

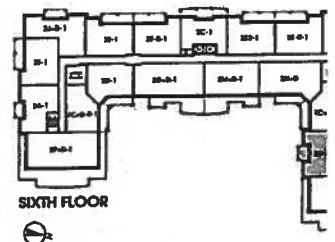

SIXTH FLOOR








Noyac Bay

1,121 SQ FT *plus* 76sq. ft. of balcony area

SUITE 507
ORIGINAL LAYOUT
INVENTORY SUITE
(new)

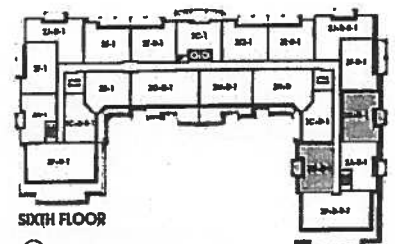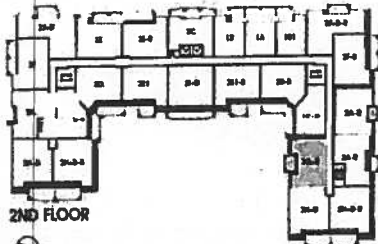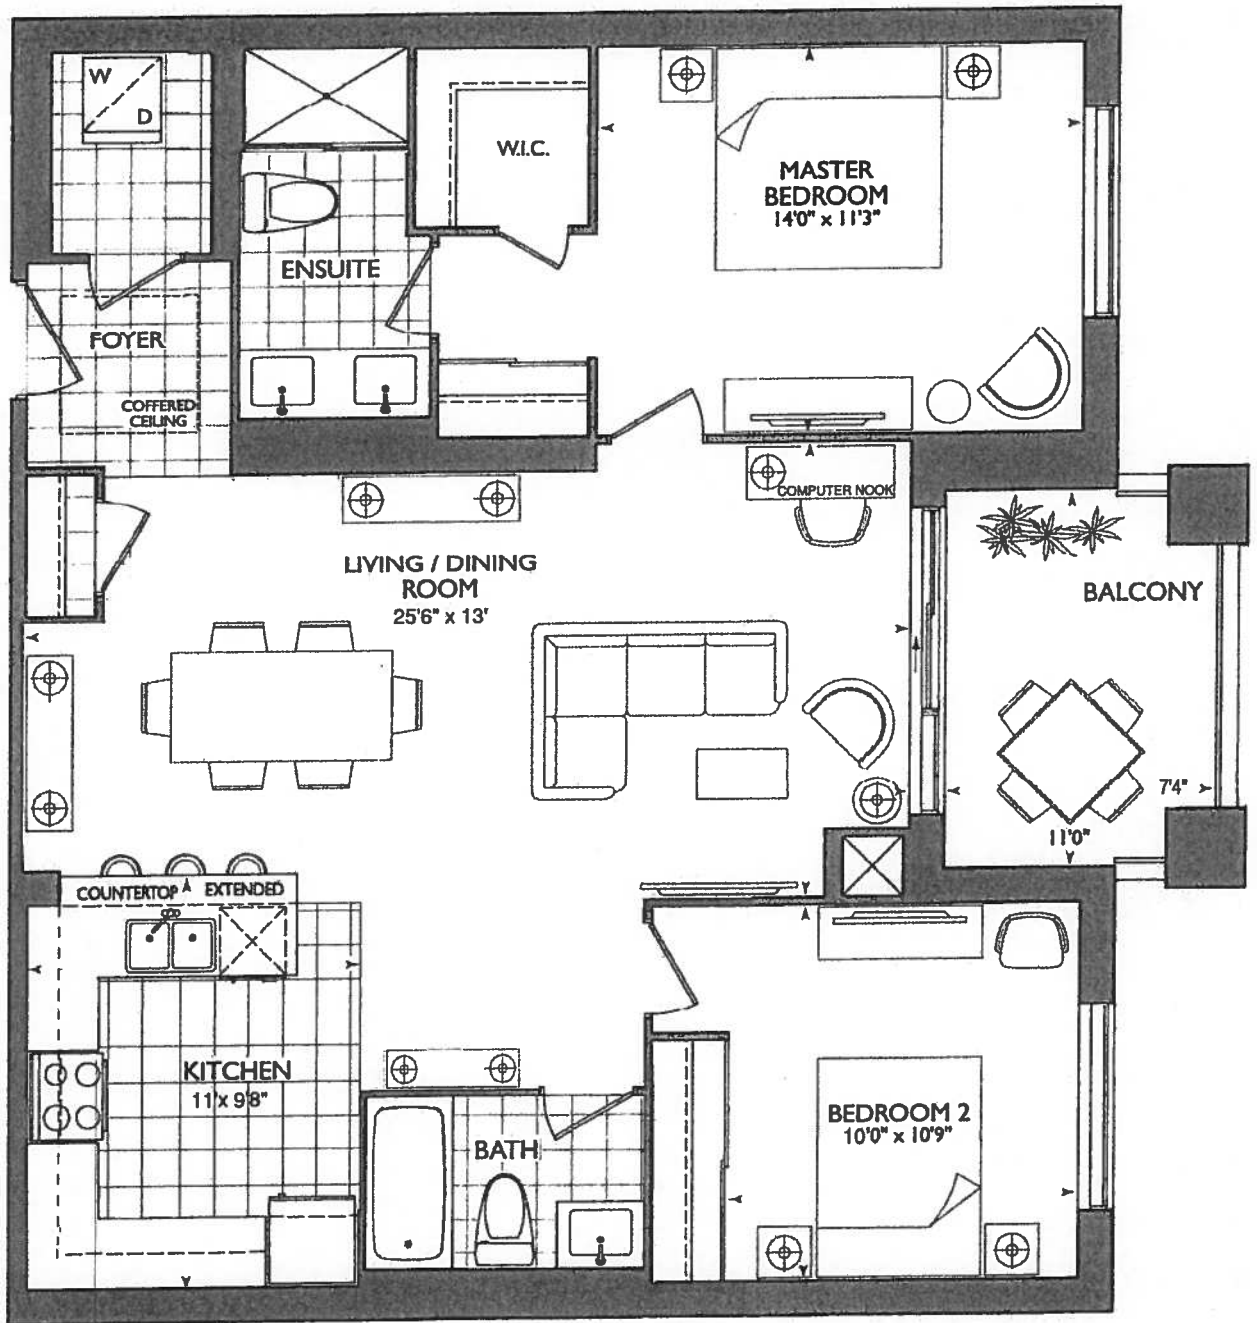

Plans and specifications are subject to change without notice. Actual usable floor space may vary from the stated floor area. All renderings are artist's concept. E. & O. E.



*** KITCHEN ***

OR

CAN UPGRADE AT DECOR CENTER

- (x2) CAPPED PENDANT
- (x1) PLUG PENINSULA
- (x) PUCK LIGHTS

***SEE ATTACHED UPG.**


#1- KITCHEN LAYOUT WITH 1ST UPG. APPLIANCE PACKAGE

BEHIND W/D



- NEW PLAIN
- REMOVED DEN
- REVISED KITCHEN


***REVISED LAUNDRY DOOR SWING & ENSUITE WALL AS PER THIS BROCHURE**

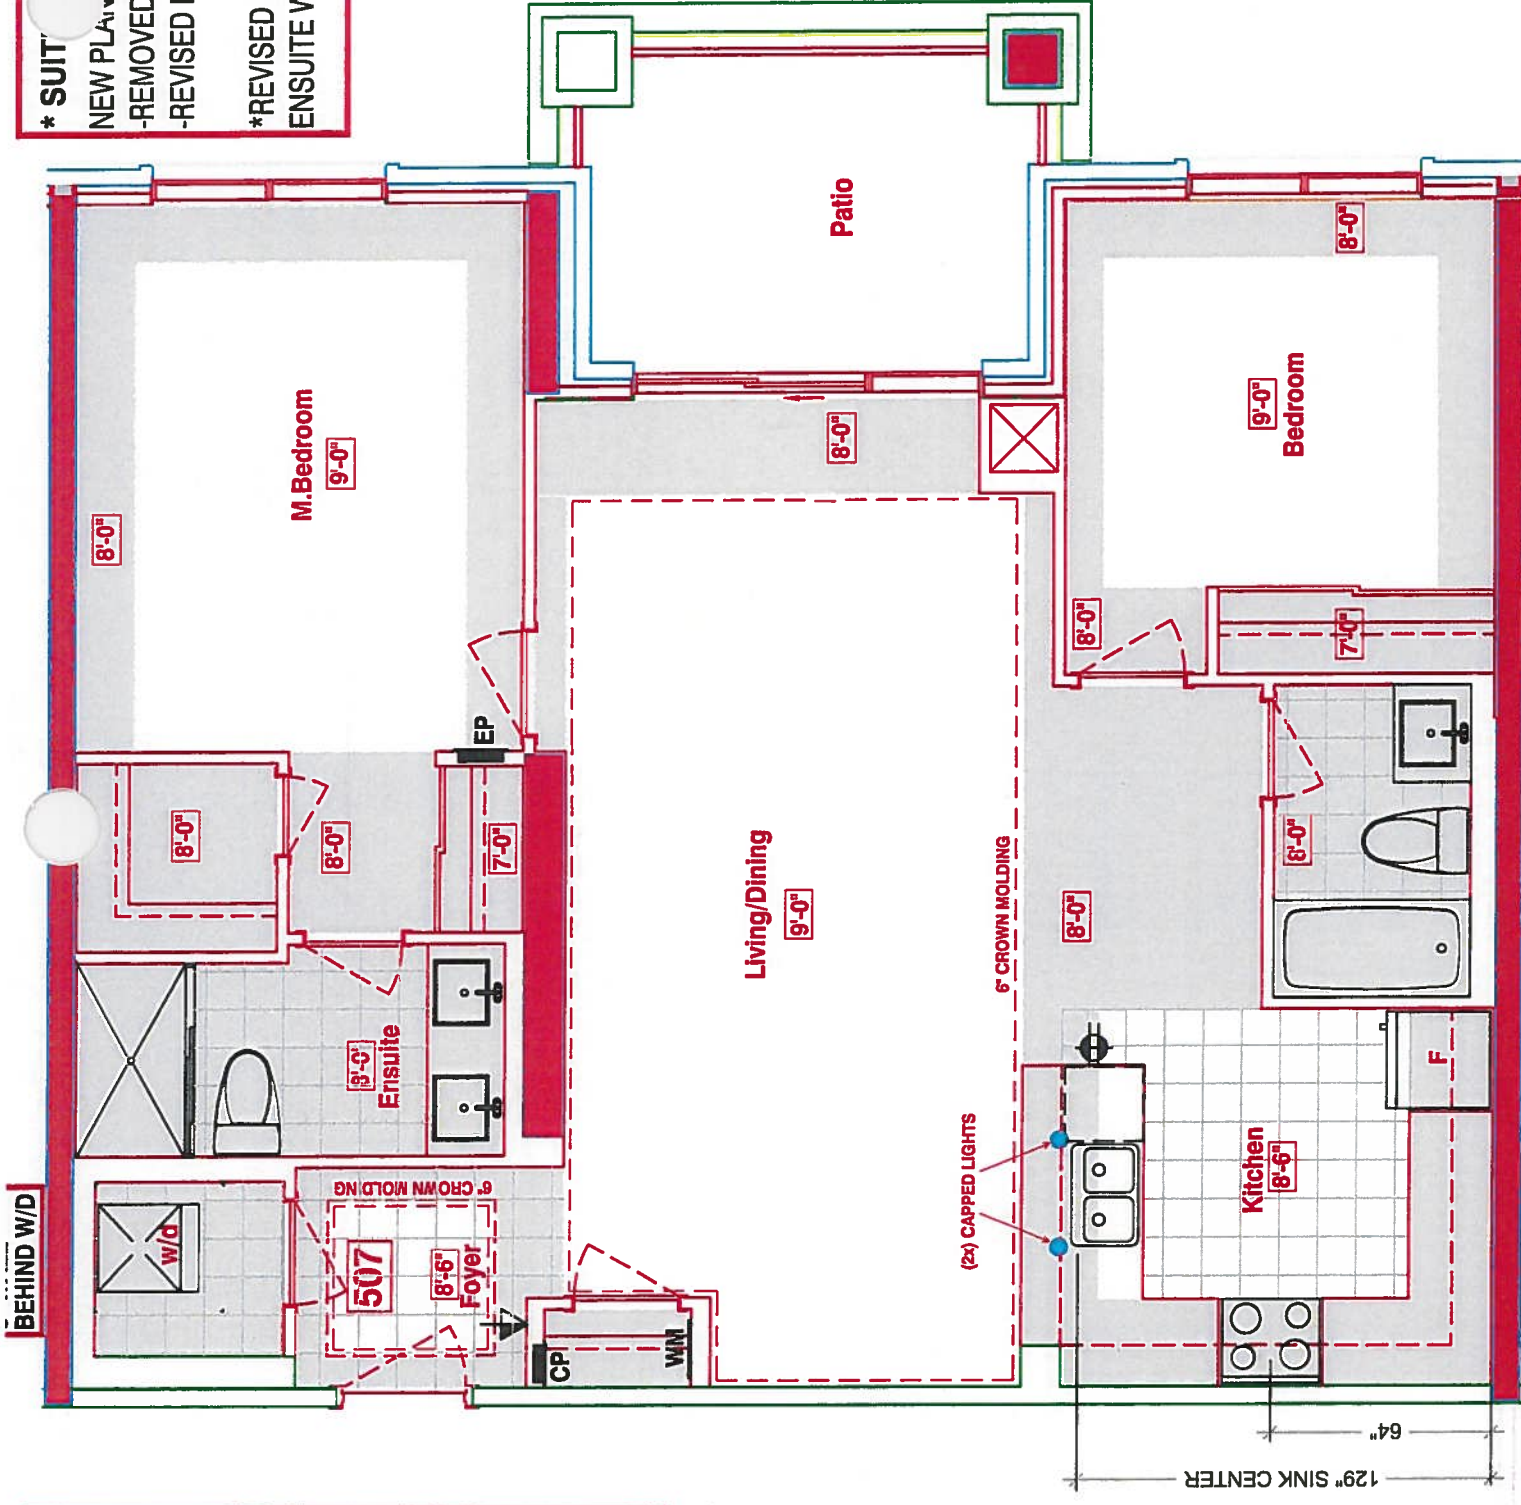

LEGEND:


	SECURITY PANEL
	ELECTRICAL PANEL
	COMMUNICATION PANEL
	WATER METER
	FRIDGE
	DROPPED AREA
	6" CROWN MOLDING

SUITES 507 - NOYAC BAY (Inventory suite)

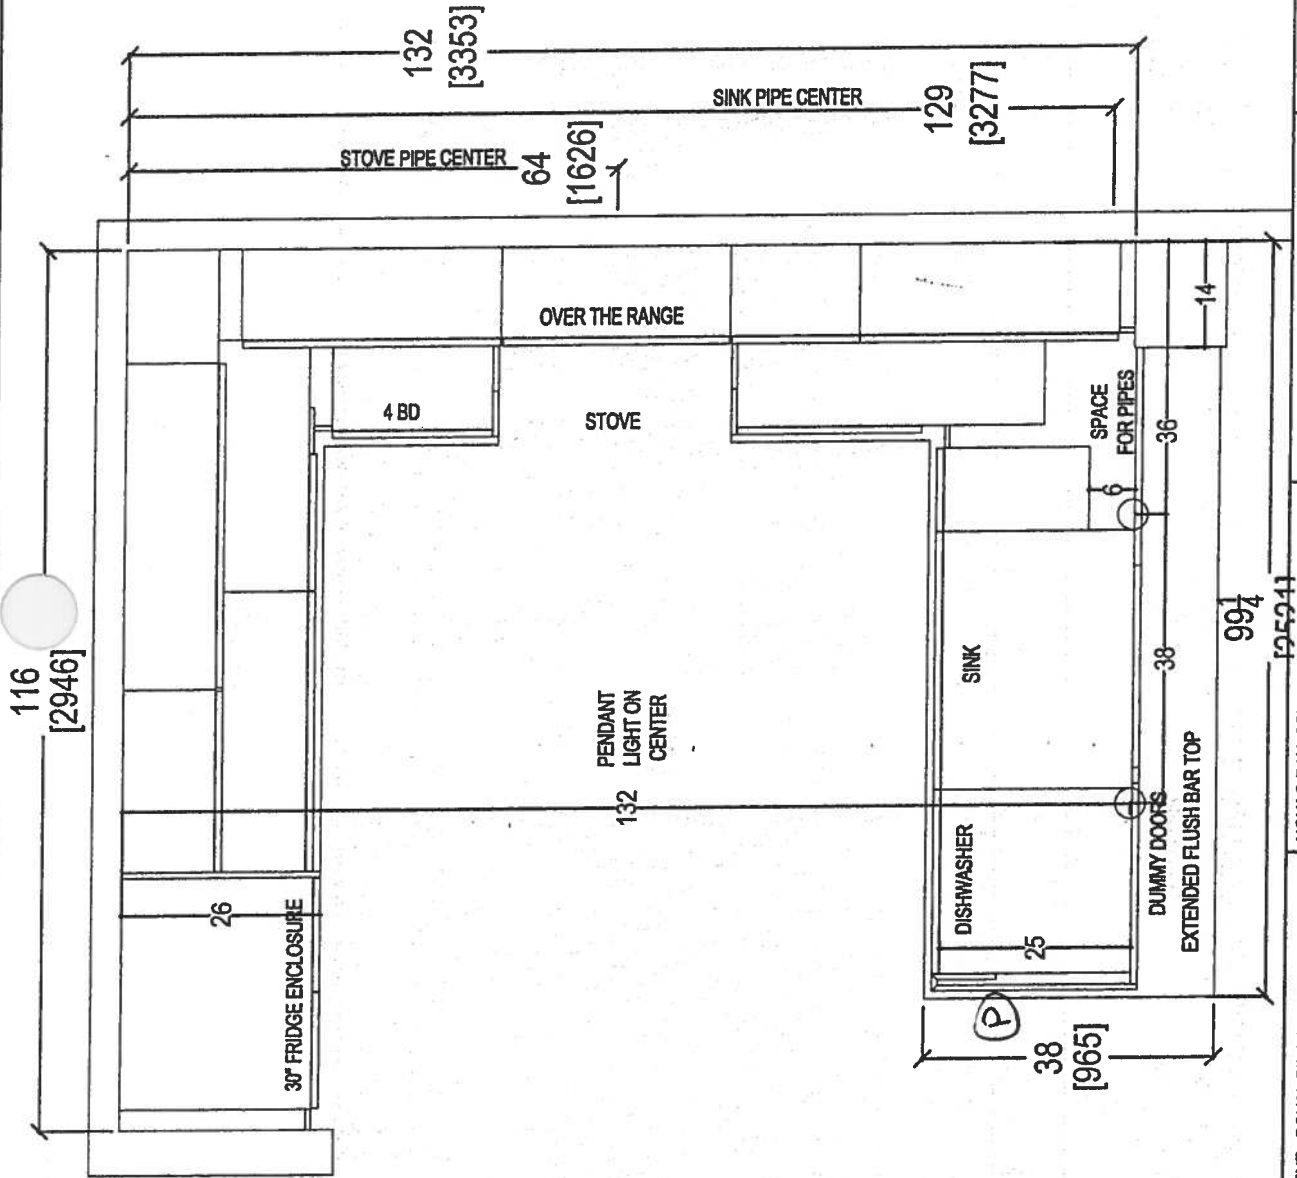


- #507 - INVENTORY SUITE
- STD KITCHEN LAYOUT
 - STD APPLIANCE PKG.
 - (x1) = PLUG PENINSULA
 - (x2) = CAPPED PENDANT LIGHTS
 - (x5) = PUCK LIGHTS

 your kitchen, your taste. 80 SANTE DRIVE, VAUGHAN, ON L4K 3C4, T: 416.748.1811 F:905.761.5901	CLIENT: ROYAL PINE HOMES		NOYAC BAY (2G)		ROOM: KITCHEN FLOOR PLAN		DRAWN BY: SK		COMMENTS: PLEASE NOTE ALL DIMENSIONS ARE NOT FINAL AND ARE SUBJECT TO CHANGE UPON FINAL SITE MEASURE
	SITE: HAMPTON PLACE		DOOR STYLE: —		DOOR HANDLE: —		SCALE: 1/2" = 1'-0"		
	PHONE: —		FINISH: —		DRW HANDLE: —		DATE: MARCH 8, 2018		
	EMAIL: —		SPECIES: —		TOP: —		PAGE: —		

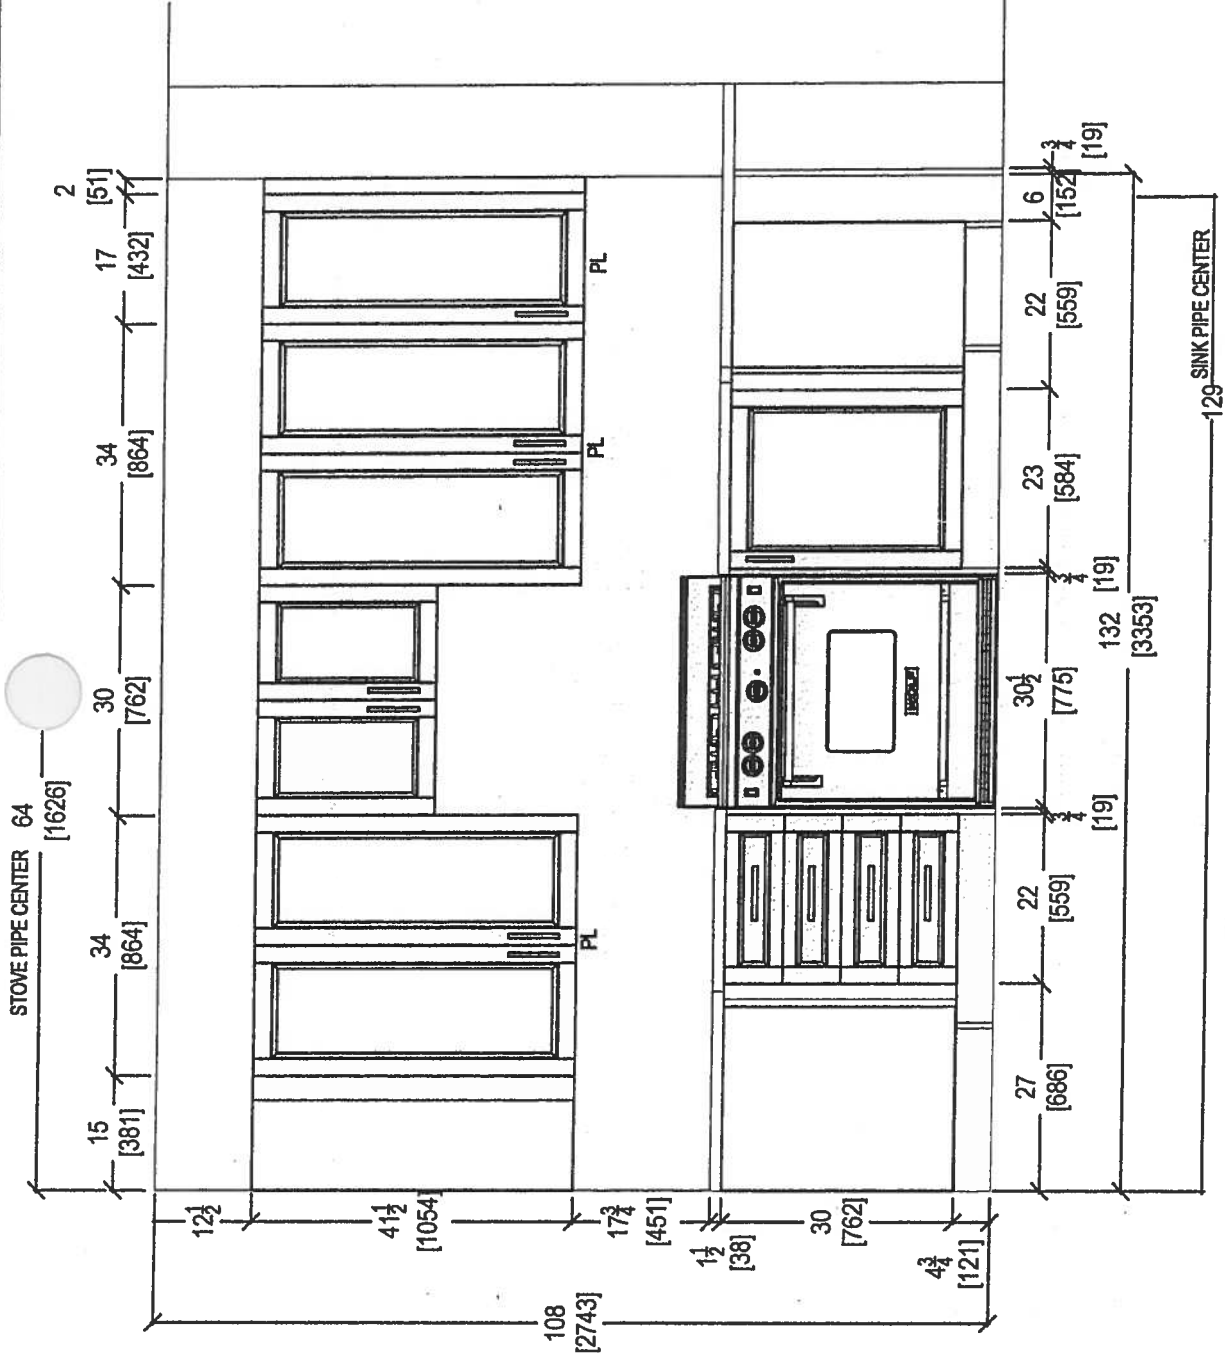



80 SANTE DRIVE, VAUGHAN, ON L4K 3C4,
T: 416.746.1811 F: 905.781.5901

CLIENT: ROYAL PINE HOMES	NOYAC BAY (2G)	ROOM: KITCHEN	DRAWN BY: SK	COMMENTS: PLEASE NOTE ALL DIMENSIONS ARE NOT FINAL AND ARE SUBJECT TO CHANGE UPON FINAL SITE MEASURE
SITE: HAMPTON PLACE	DOOR STYLE: —	DOOR HANDLE: —	SCALE: 1/2" = 1' - 0"	
PHONE: —	FINISH: —	DRW HANDLE: —	DATE: MARCH 8, 2018	
EMAIL: —	SPECIES: —	TOP: —	PAGE: —	

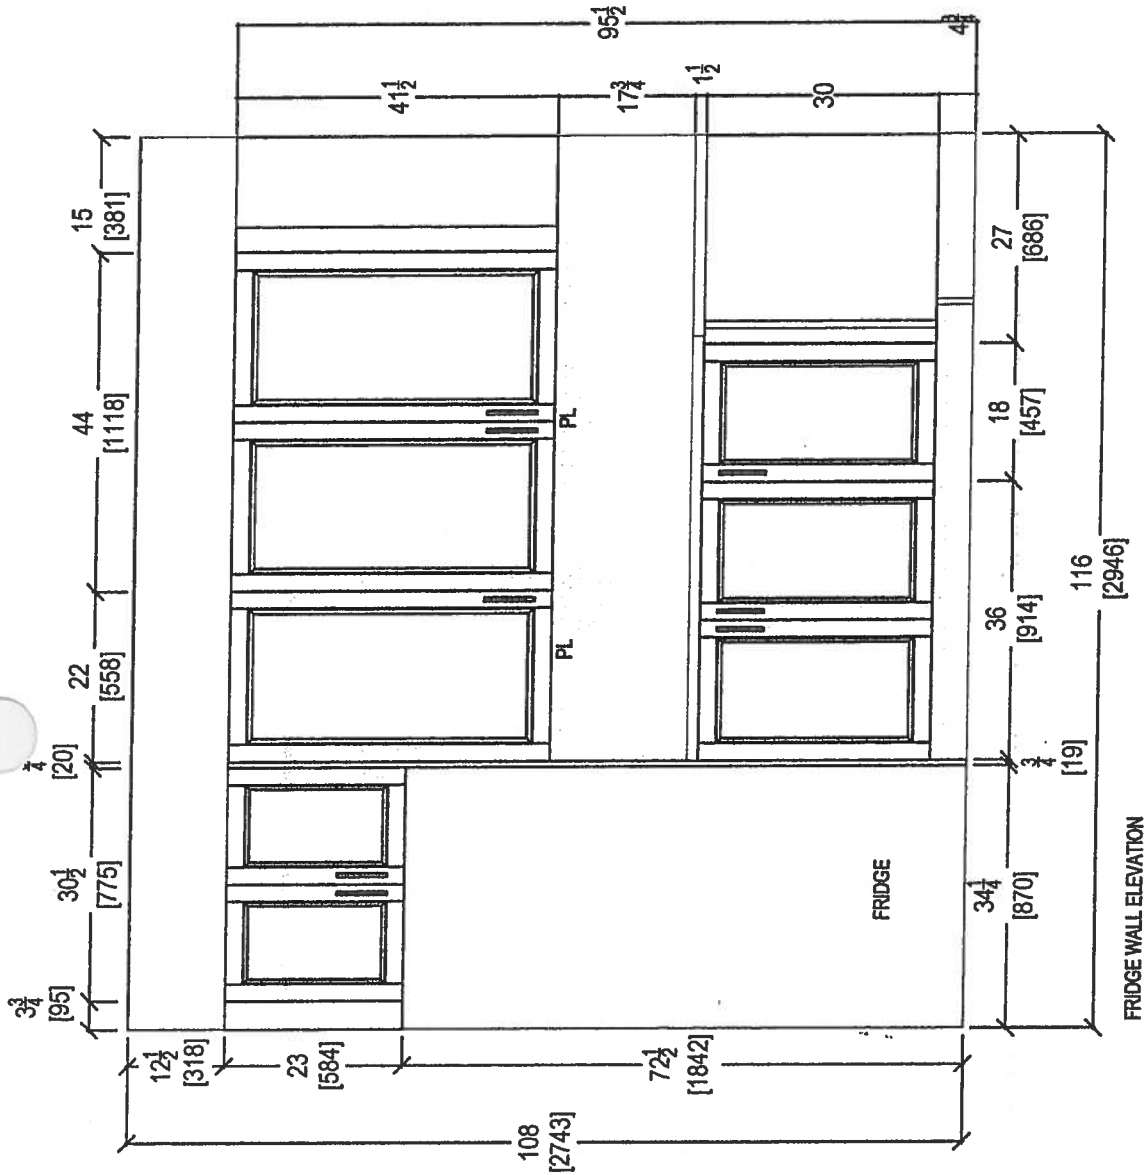


80 SANTE DRIVE, VAUGHAN, ON L4K 3C4,
T: 416.746.1811 F: 905.761.5901

CLIENT: ROYAL PINE HOMES SITE: HAMPTON PLACE PHONE: — EMAIL: —	NOYAC BAY (2G)	ROOM: KITCHEN	DRAWN BY: SK	COMMENTS: PLEASE NOTE ALL DIMENSIONS ARE NOT FINAL AND ARE SUBJECT TO CHANGE UPON FINAL SITE MEASURE
	DOOR STYLE: —	DOOR HANDLE: —	SCALE: 1/2" = 1'-0"	
	FINISH: —	DRW HANDLE: —	DATE: MARCH 8, 2018	
	SPECIES: —	TOP: —	PAGE: —	

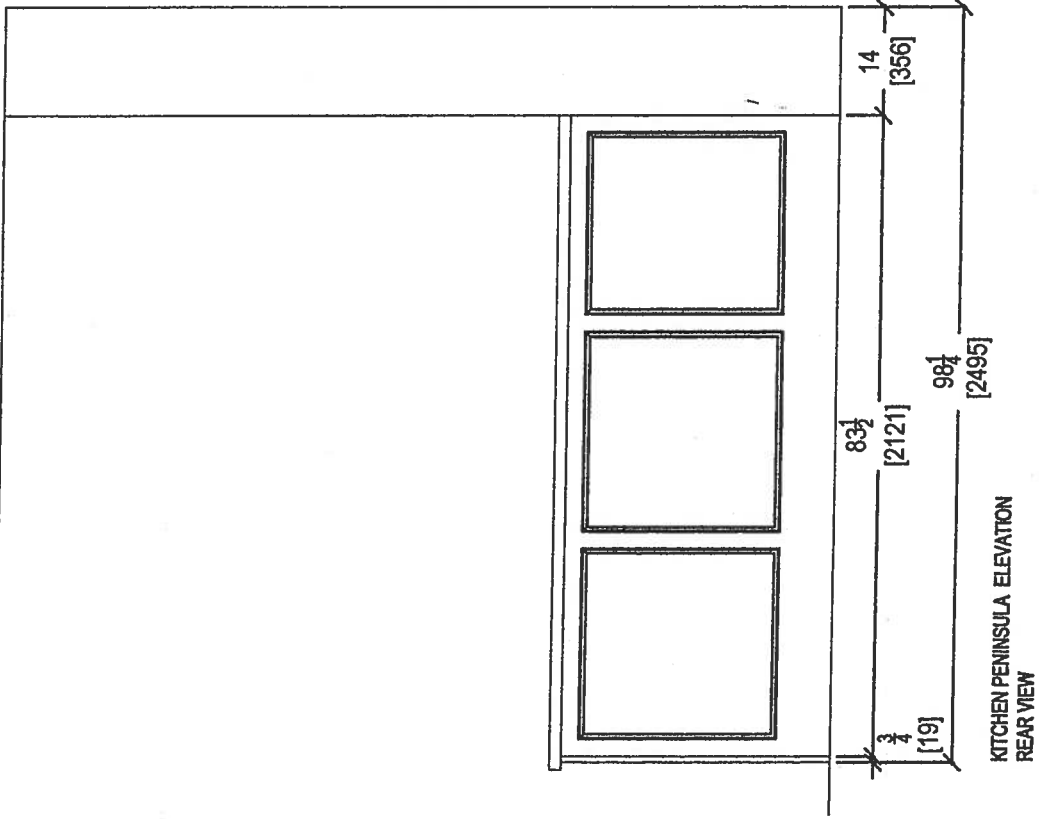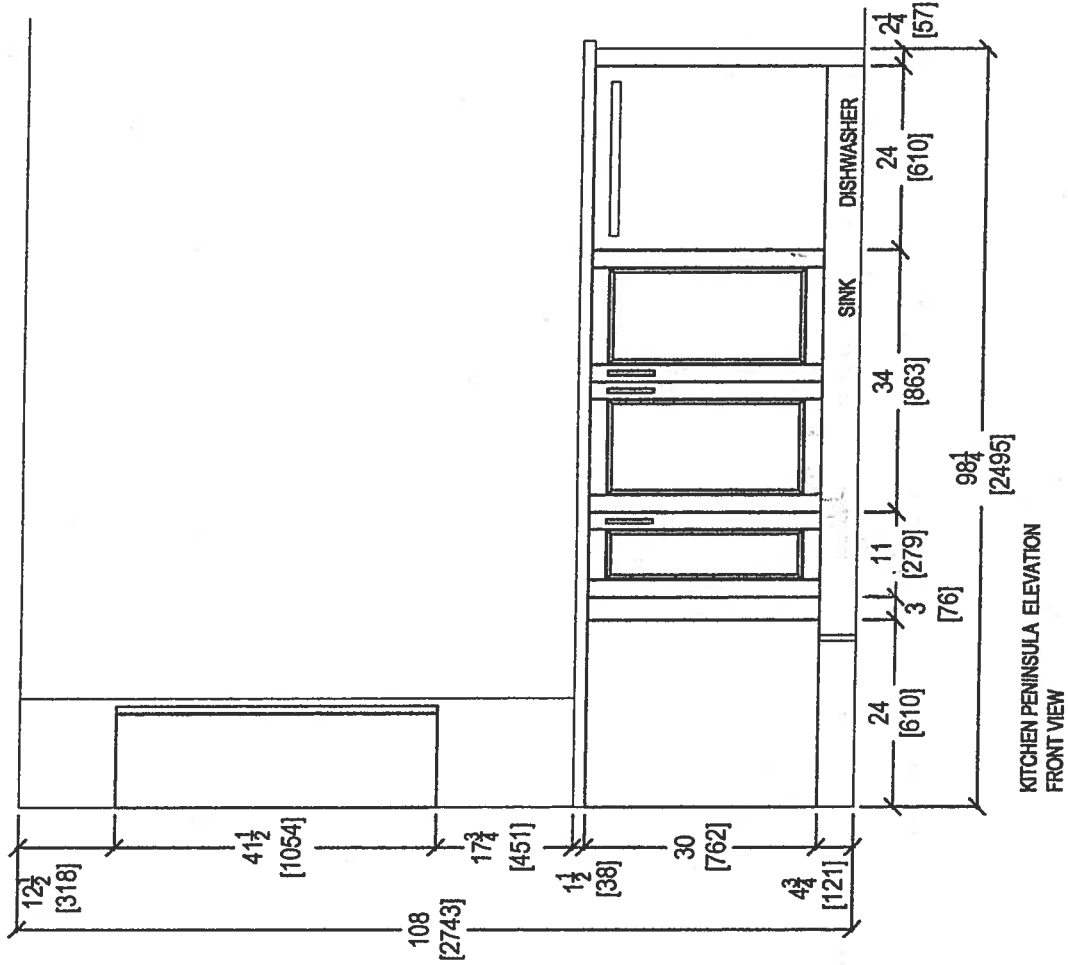

your kitchen, your taste.
80 SANTE DRIVE, VAUGHAN, ON L4K 3C4,
T: 416.748.1811 F: 905.781.5901

CLIENT: ROYAL PINE HOMES		NOYAC BAY (2G)		ROOM: KITCHEN		DRAWN BY: SK		COMMENTS: PLEASE NOTE ALL DIMENSIONS ARE NOT FINAL AND ARE SUBJECT TO CHANGE UPON FINAL SITE MEASURE
SITE: HAMPTON PLACE		DOOR STYLE: —		DOOR HANDLE: —		SCALE: 1/2" = 1' - 0"		
PHONE: —		FINISH: —		DRW HANDLE: —		DATE: MARCH 8, 2018		
EMAIL: —		SPECIES: —		TOP: —		PAGE: —		

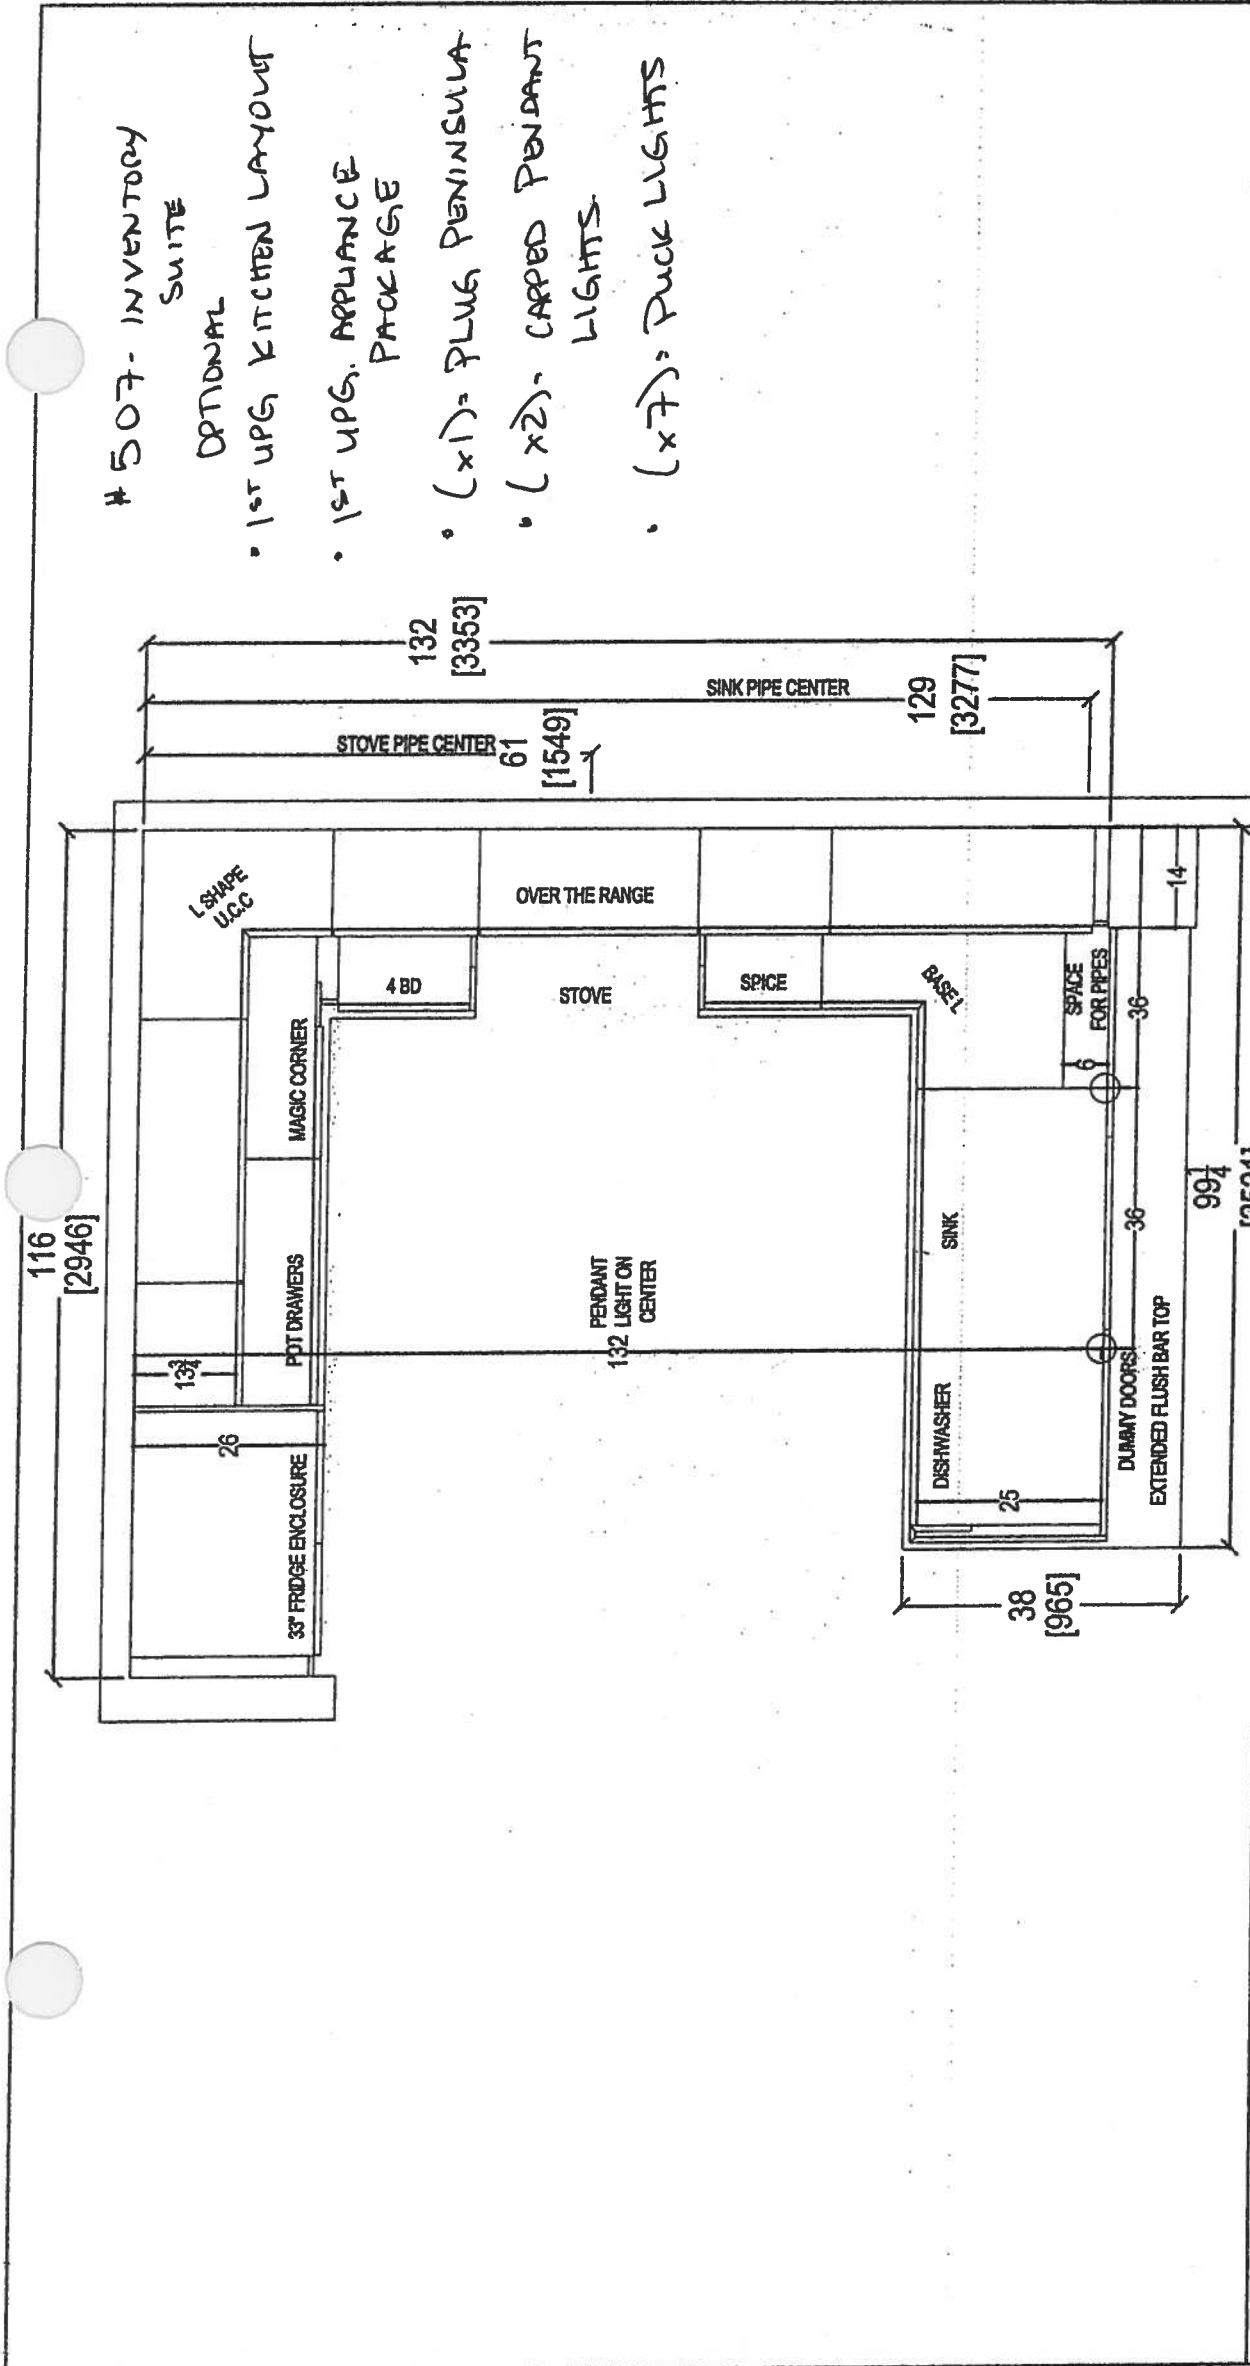



- #507- INVENTORY SUITE
- OPTIONAL
- 1ST UPG. KITCHEN LAYOUT
 - 1ST UPG. APPLANCE PACKAGE
 - (x1) = PLUG PENINSULA
 - (x2) = CAPED PENDANT LIGHTS
 - (x7) = PUCK LIGHTS

CLIENT: ROYAL PINE HOMES		NOYAC BAY (2G) UPGRADE PACKAGE	ROOM: KITCHEN FLOOR PLAN	DRAWN BY: SK	COMMENTS: PLEASE NOTE ALL DIMENSIONS ARE NOT FINAL AND ARE SUBJECT TO CHANGE UPON FINAL SITE MEASURE
SITE: HAMPTON PLACE	DOOR STYLE: —	DOOR HANDLE: —	SCALE: 1/2" = 1'-0"		
PHONE: —	FINISH: —	DRW HANDLE: —	DATE: MARCH 8, 2018		
EMAIL: —	SPECIES: —	TOP: —	PAGE: —		




80 SANTE DRIVE, VAUGHAN, ON L4K 3C4,
T: 416.746.1811 F: 905.761.5901




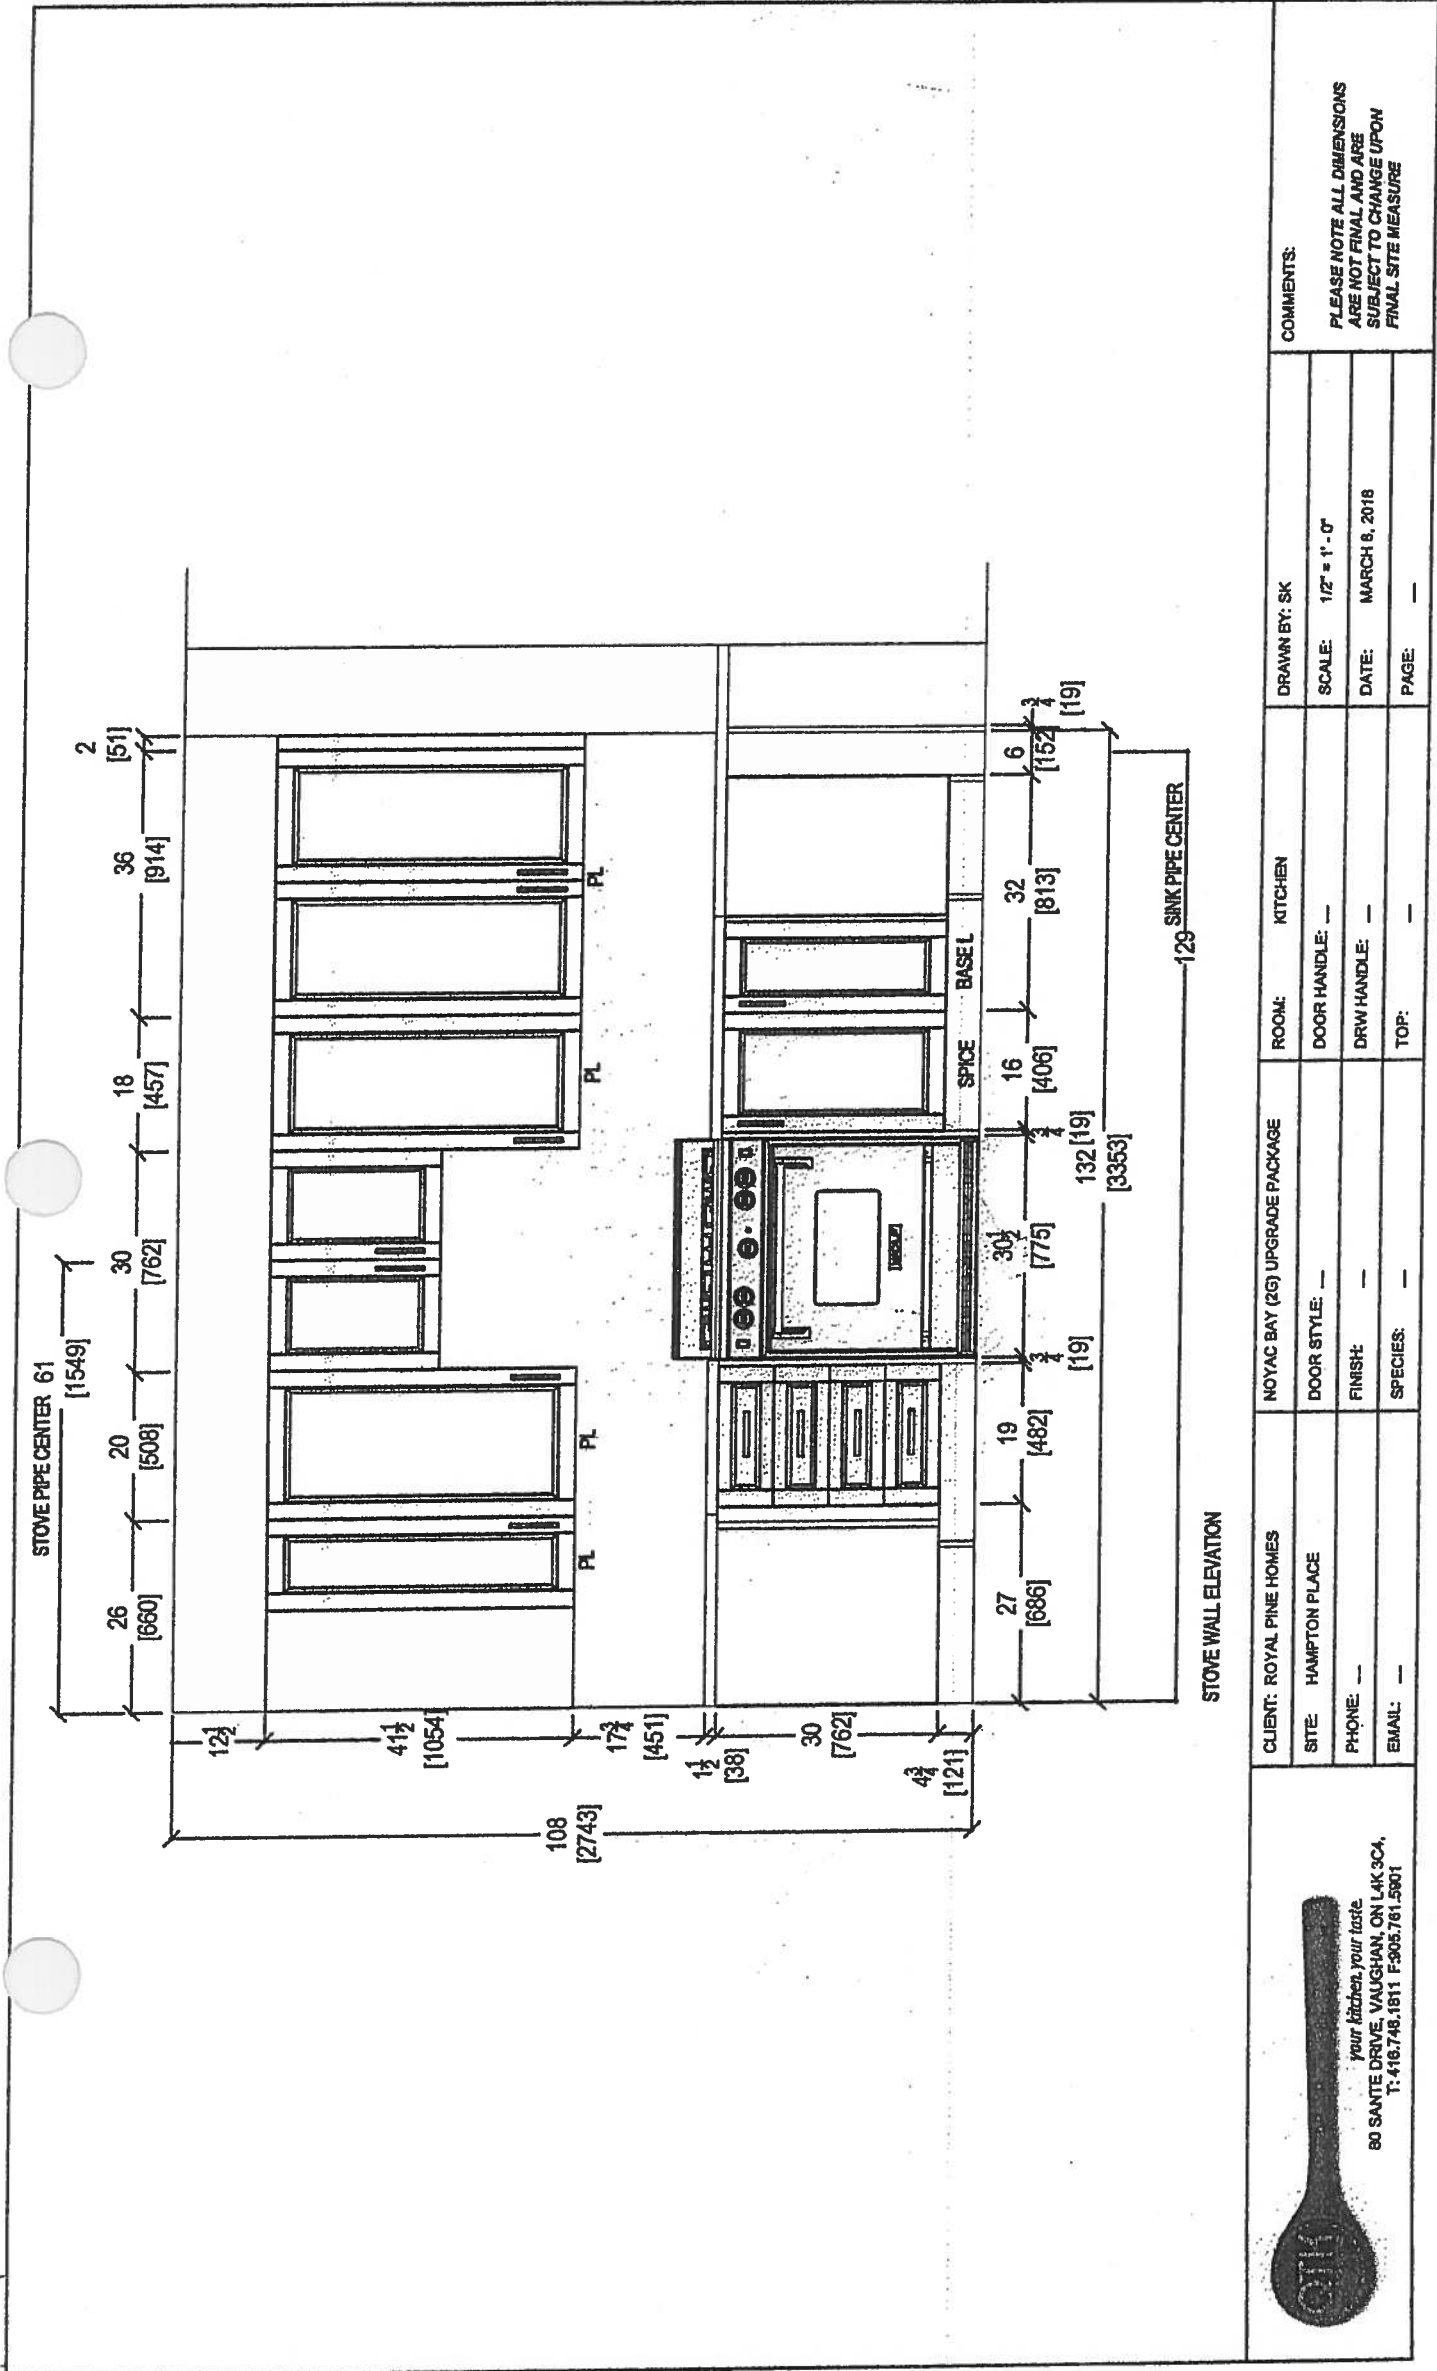


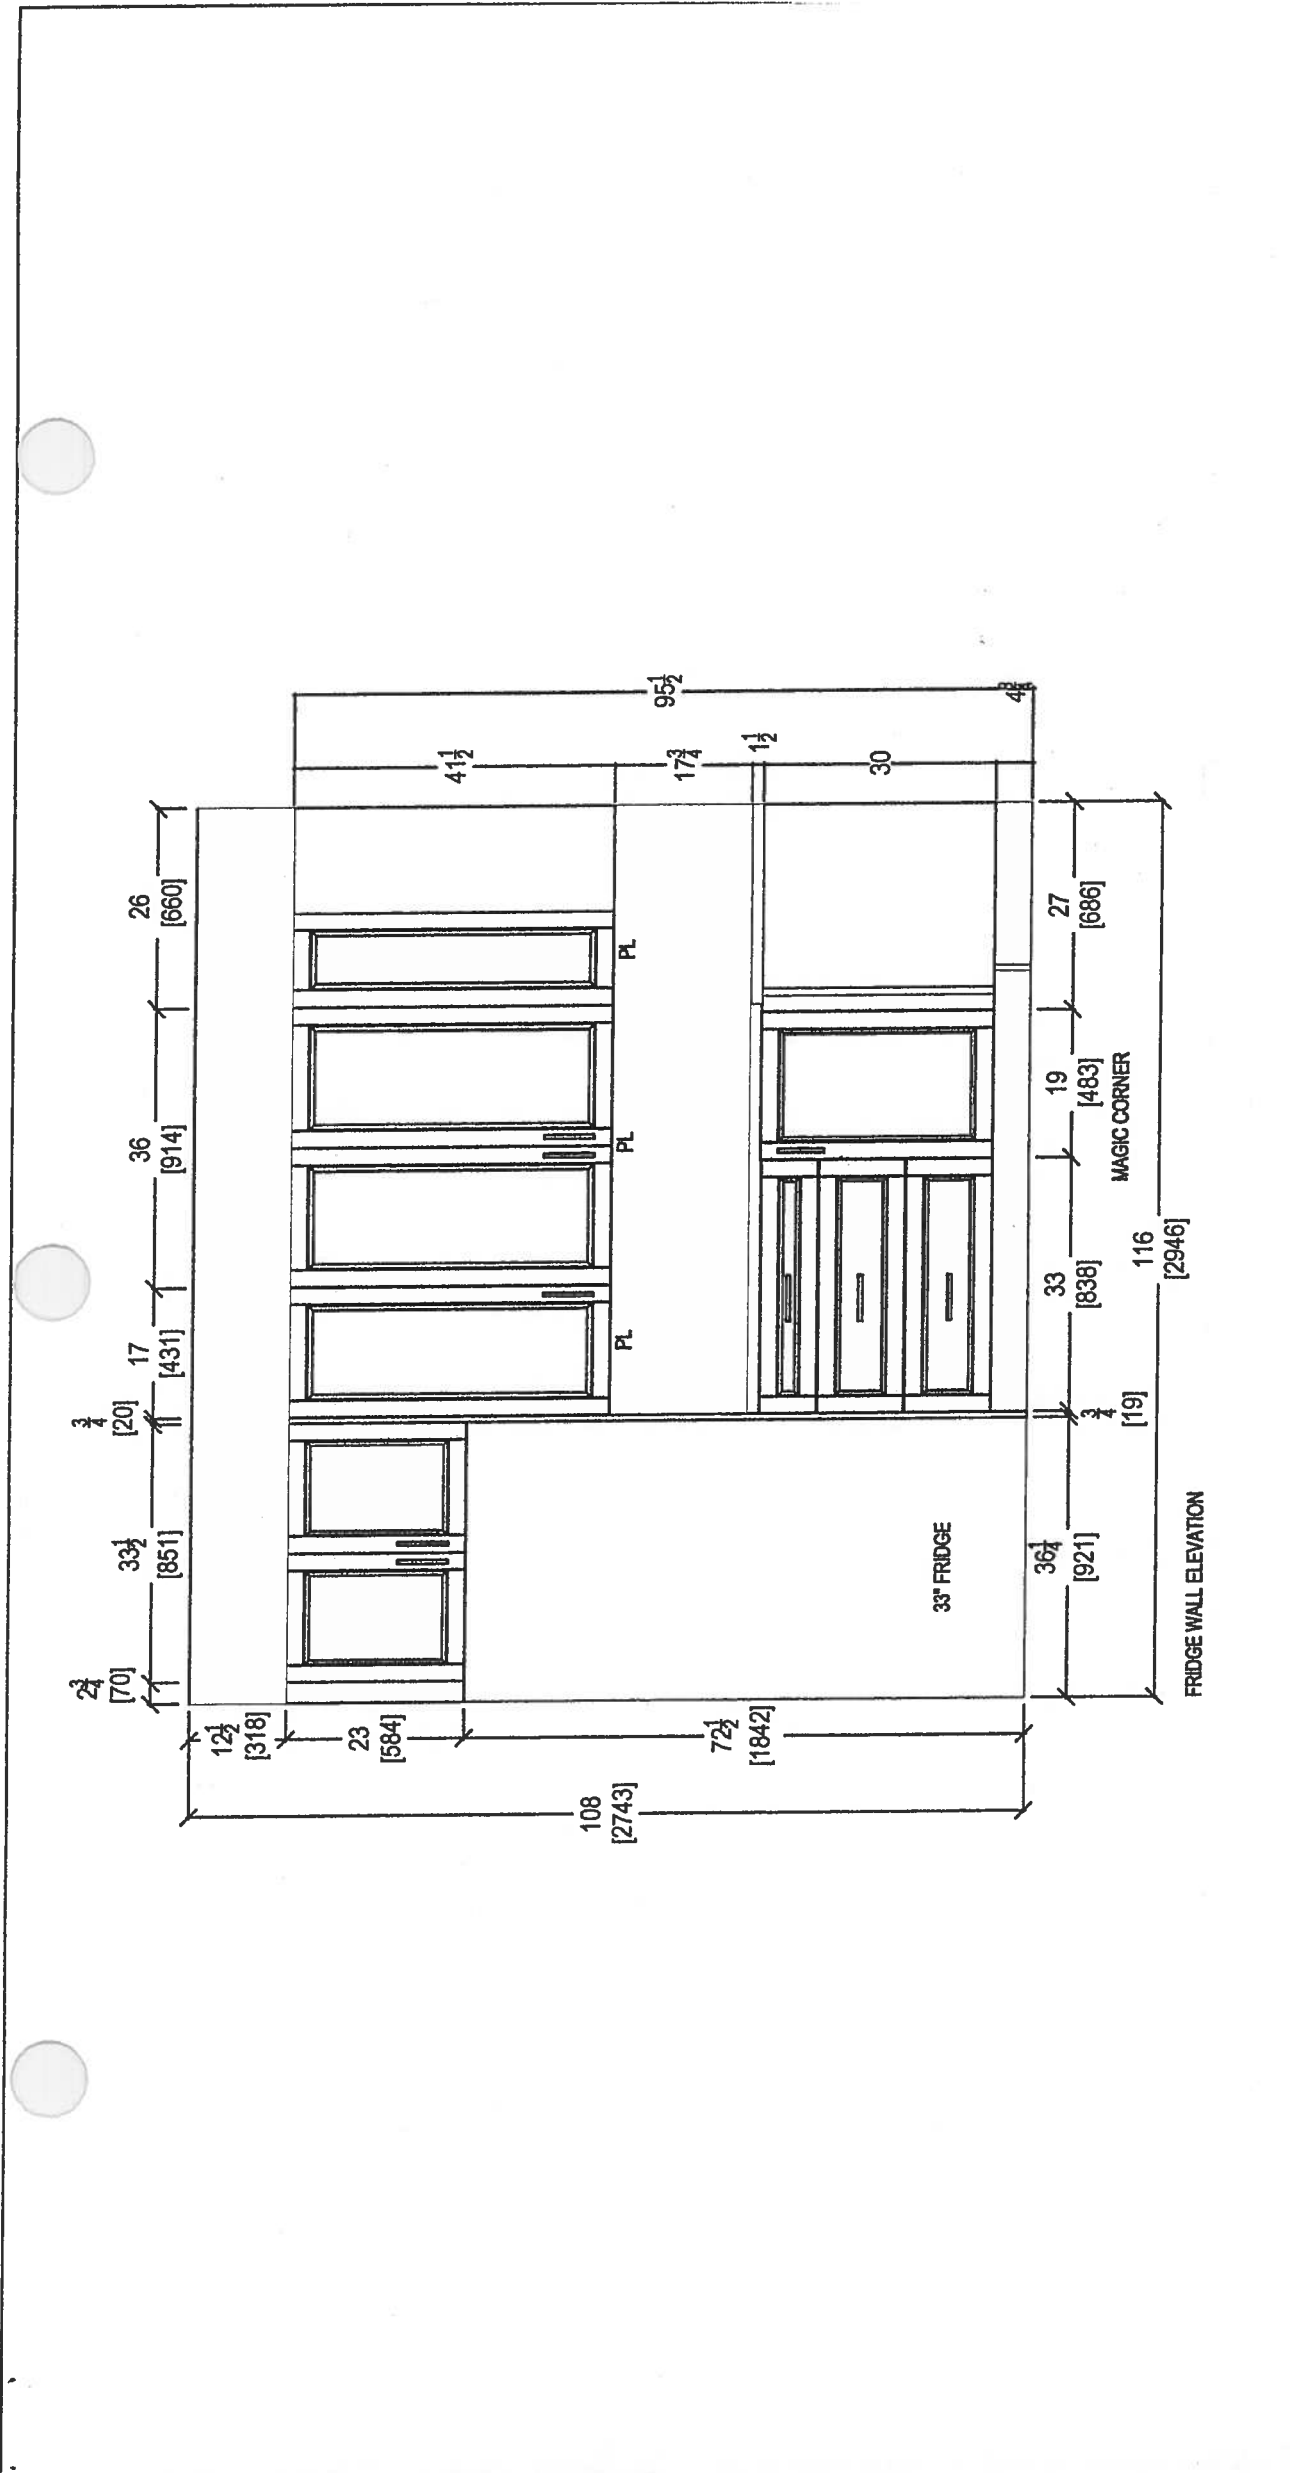

 <i>your kitchen, your taste.</i> 80 SANTE DRIVE, VAUGHAN, ON L4K 3C4, T: 416.746.1811 F: 905.781.5901	CLIENT: ROYAL PINE HOMES		NOYAC BAY (2G) UPGRADE PACKAGE		ROOM: KITCHEN	DRAWN BY: SK	COMMENTS: PLEASE NOTE ALL DIMENSIONS ARE NOT FINAL AND ARE SUBJECT TO CHANGE UPON FINAL SITE MEASURE
	SITE: HAMPTON PLACE		DOOR STYLE: —		DOOR HANDLE: —		
	PHONE: —		FINISH: —		DRW HANDLE: —		
	EMAIL: —		SPECIES: —		TOP: —		
						SCALE: 1/2" = 1' - 0"	
						DATE: MARCH 8, 2018	
						PAGE: —	

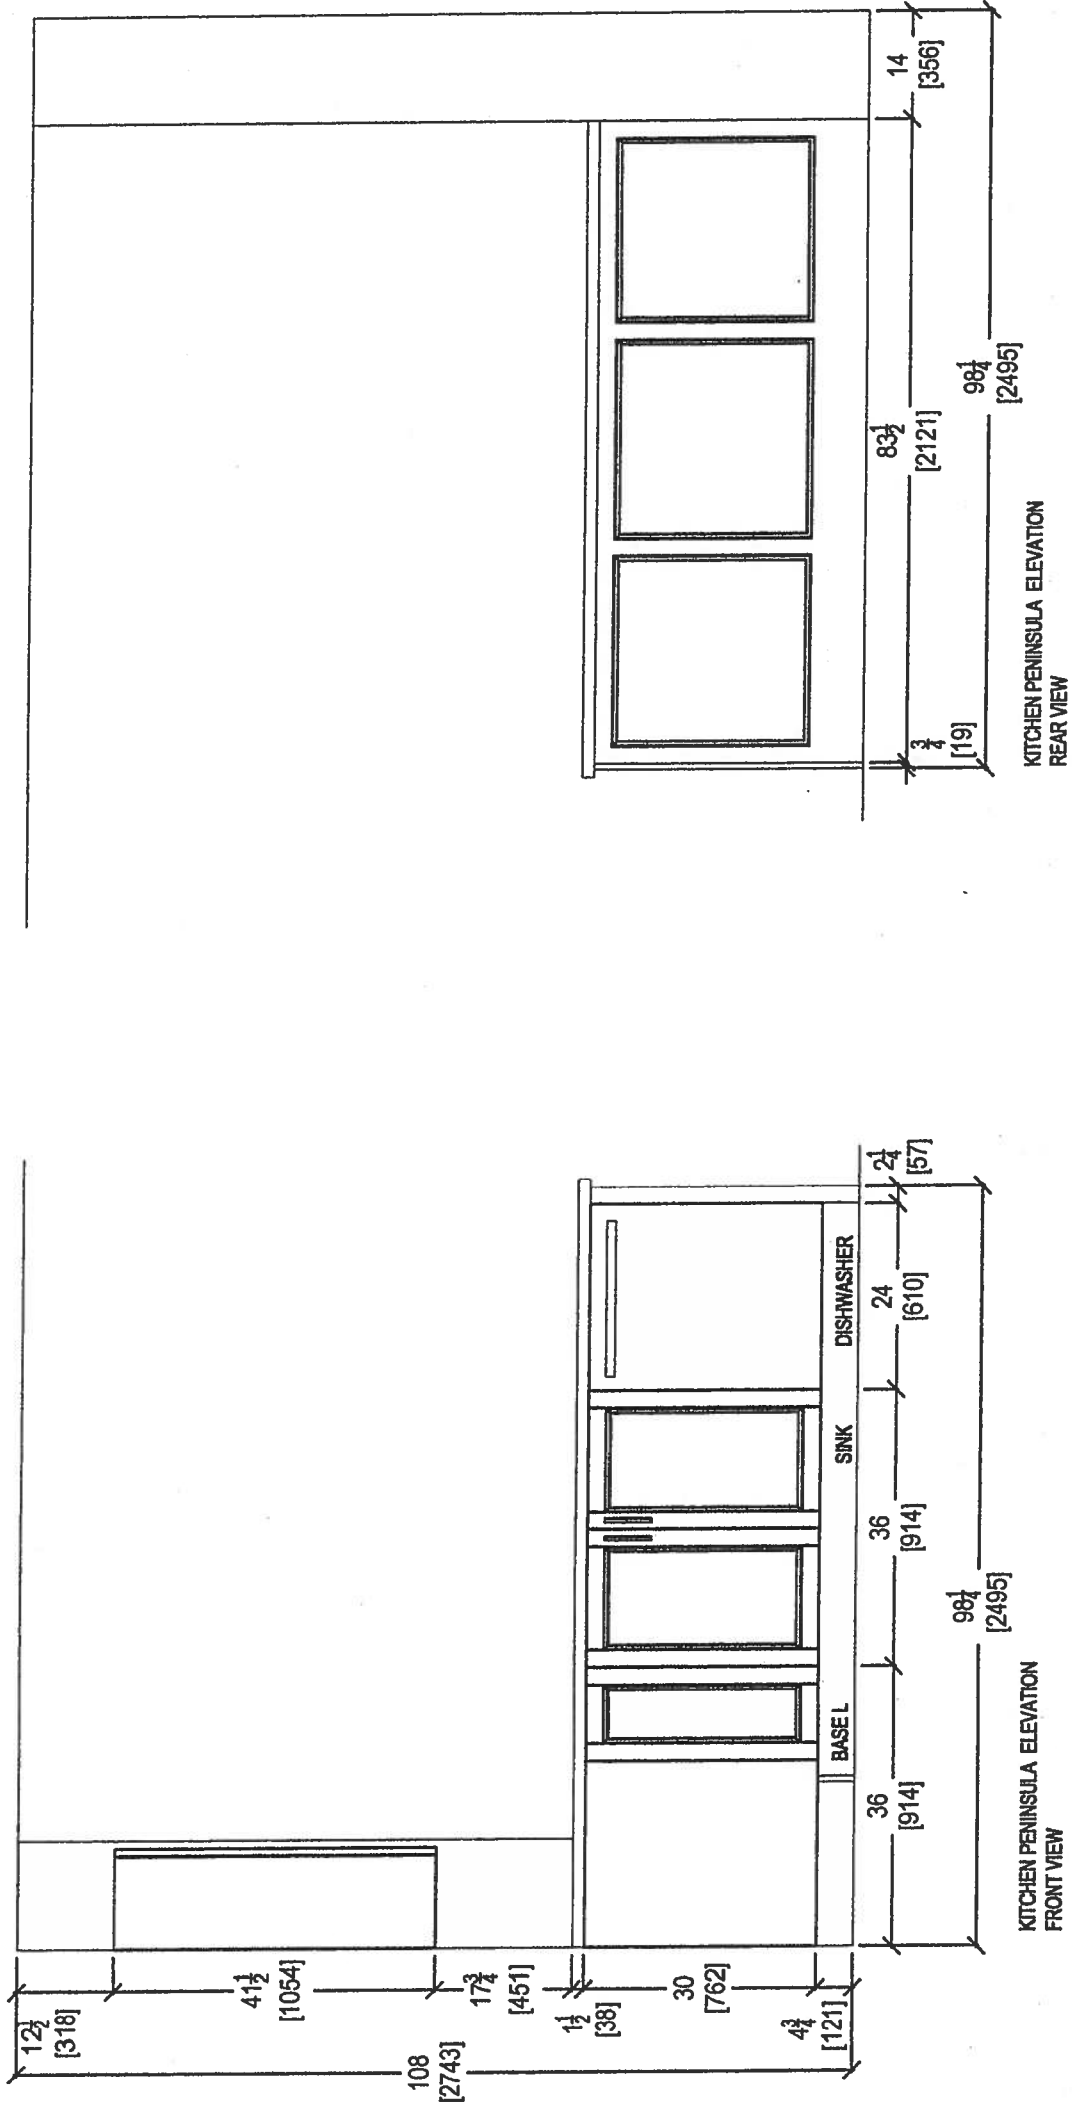

	CLIENT: ROYAL PINE HOMES		NOYAC BAY (2G) UPGRADE PACKAGE		ROOM: KITCHEN	DRAWN BY: SK		COMMENTS: PLEASE NOTE ALL DIMENSIONS ARE NOT FINAL AND ARE SUBJECT TO CHANGE UPON FINAL SITE MEASURE
	SITE: HAMPTON PLACE		DOOR STYLE: —		DOOR HANDLE: —	SCALE: 1/2" = 1' - 0"		
	PHONE: —		FINISH: —		DRW HANDLE: —	DATE: MARCH 8, 2018		
	EMAIL: —		SPECIES: —		TOP: —	PAGE: —		

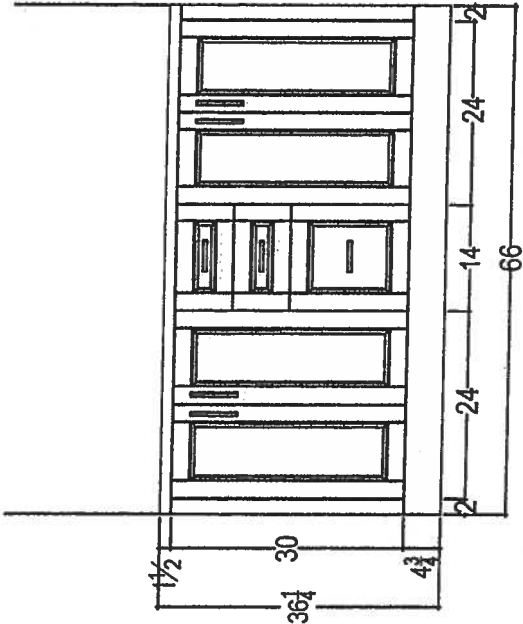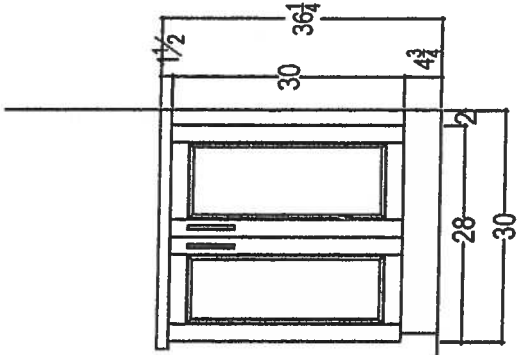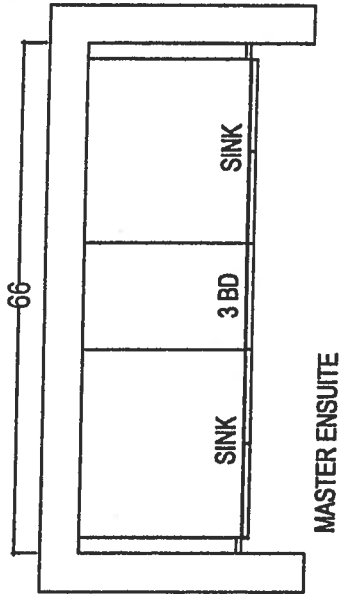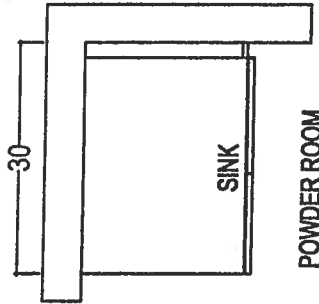

80 SANTE DRIVE, VAUGHAN, ON L4K 3C4,
T: 416.746.1811 F: 905.781.5901

CLIENT: ROYAL PINE HOMES	NOYAC BAY (2G) UPGRADE PACKAGE	ROOM:	DRAWN BY: SK	COMMENTS: PLEASE NOTE ALL DIMENSIONS ARE NOT FINAL AND ARE SUBJECT TO CHANGE UPON FINAL SITE MEASURE
SITE: HAMPTON PLACE	DOOR STYLE: —	DOOR HANDLE: —	SCALE: 1/2" = 1' - 0"	
PHONE: —	FINISH: —	DRW HANDLE: —	DATE: MARCH 8, 2018	
EMAIL: —	SPECIES: —	TOP: —	PAGE: —	