

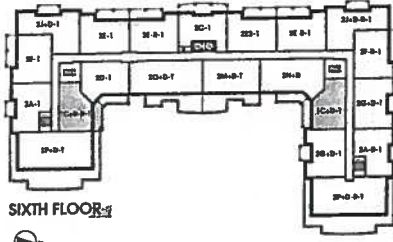


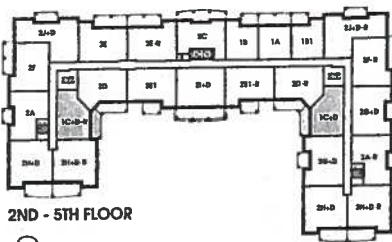

Sag Harbor

878 SQ FT *plus 119 sq. ft. of balcony area*

2nd - INVENTORY
SUITE
ORIGINAL SUITE
LAYOUT.

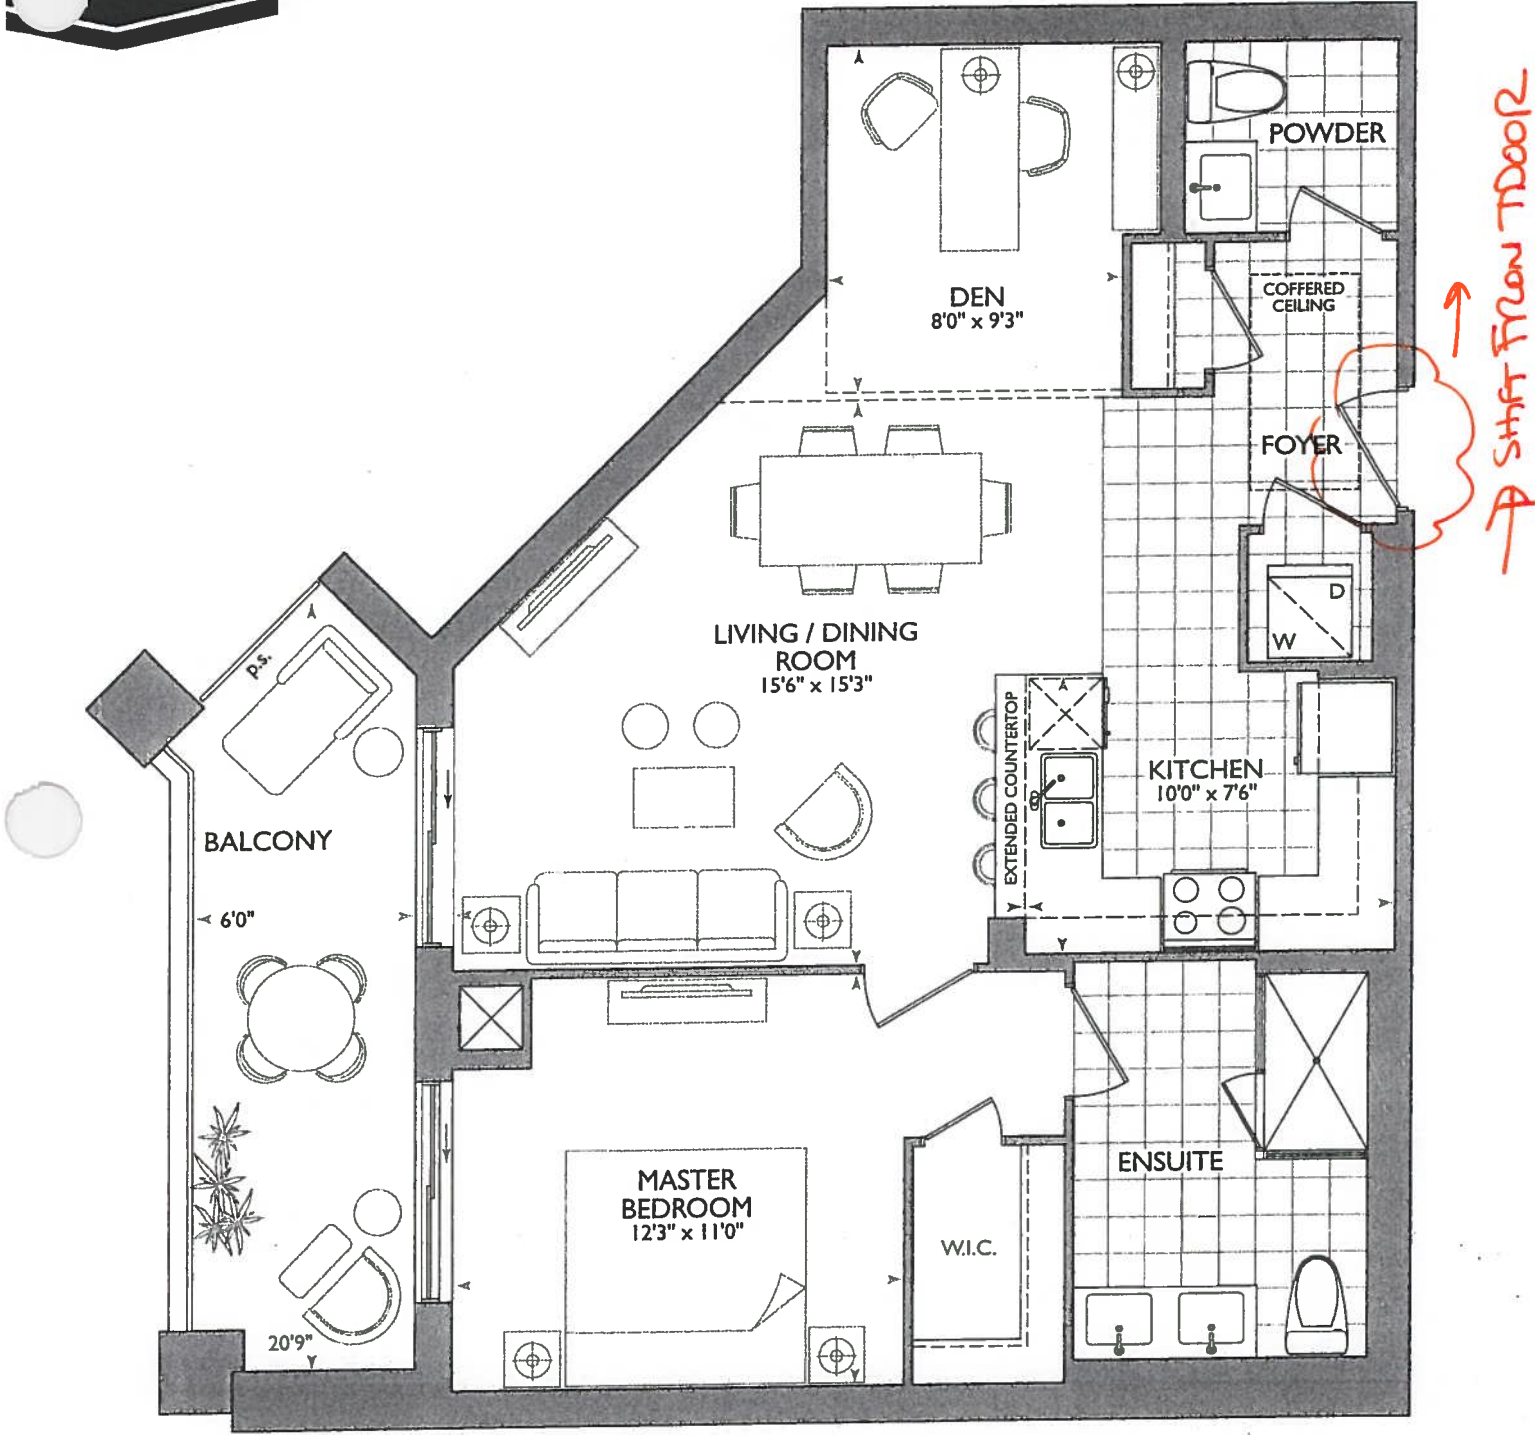

* BARRIER FREE S.E.*

SUITE 512 - INVENTORY SUITE


KITCHEN

- STD KITCHEN LAYOUT
- STD APPLIANCE PKG.
- (x1) = PLUG PENINSULA
- (x2) = CAPPED PENDANT LIGHTS OVER PENINSULA
- (x3) = PLUG LIGHTS
- 66" STOVE CENTER
- 117" SINK PIPE CENTER

OPTIONAL

- 1ST UPGRADE KITCHEN w/ 1ST UPGRADE APPLIANCE PACKAGE
- See ATTACHED 1ST UPGRADE KITCHEN LAYOUT


* Shift Front Door Due to 6" wall BEHIND WASH/DRYER

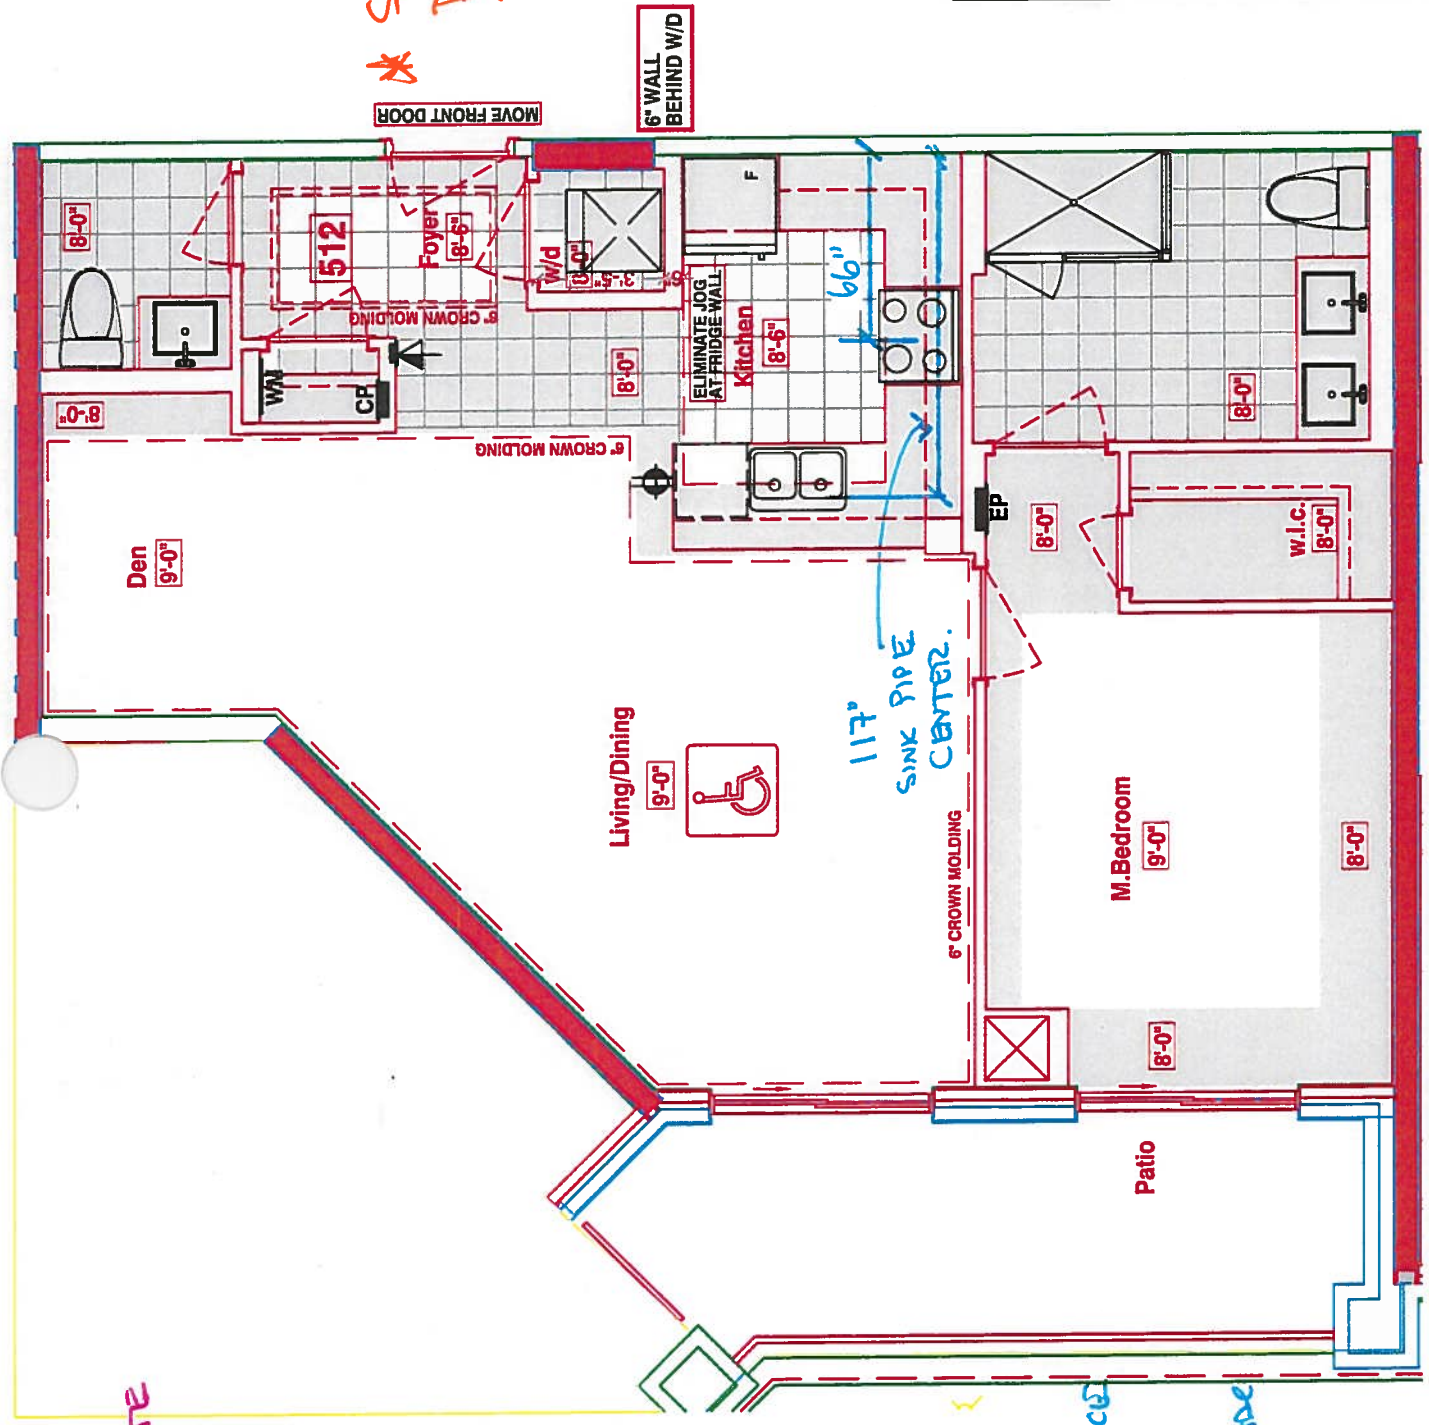

LEGEND:

- SECURITY PANEL
- ELECTRICAL PANEL
- COMMUNICATION PANEL
- WATER METER
- FRIDGE
- DROPPED AREA
- 6" CROWN MOLDING
- BARRIER FREE SUITE


Suite 512- INVENTORY SUITE
• STD KITCHEN LAYOUT
• STD APPLIANCE PACKAGE
• (x1)- PLUG PENINSULA
• (x3)- PUCK LIGHTS
• (x2)- CAPPED PENDANT
LIGHTS.

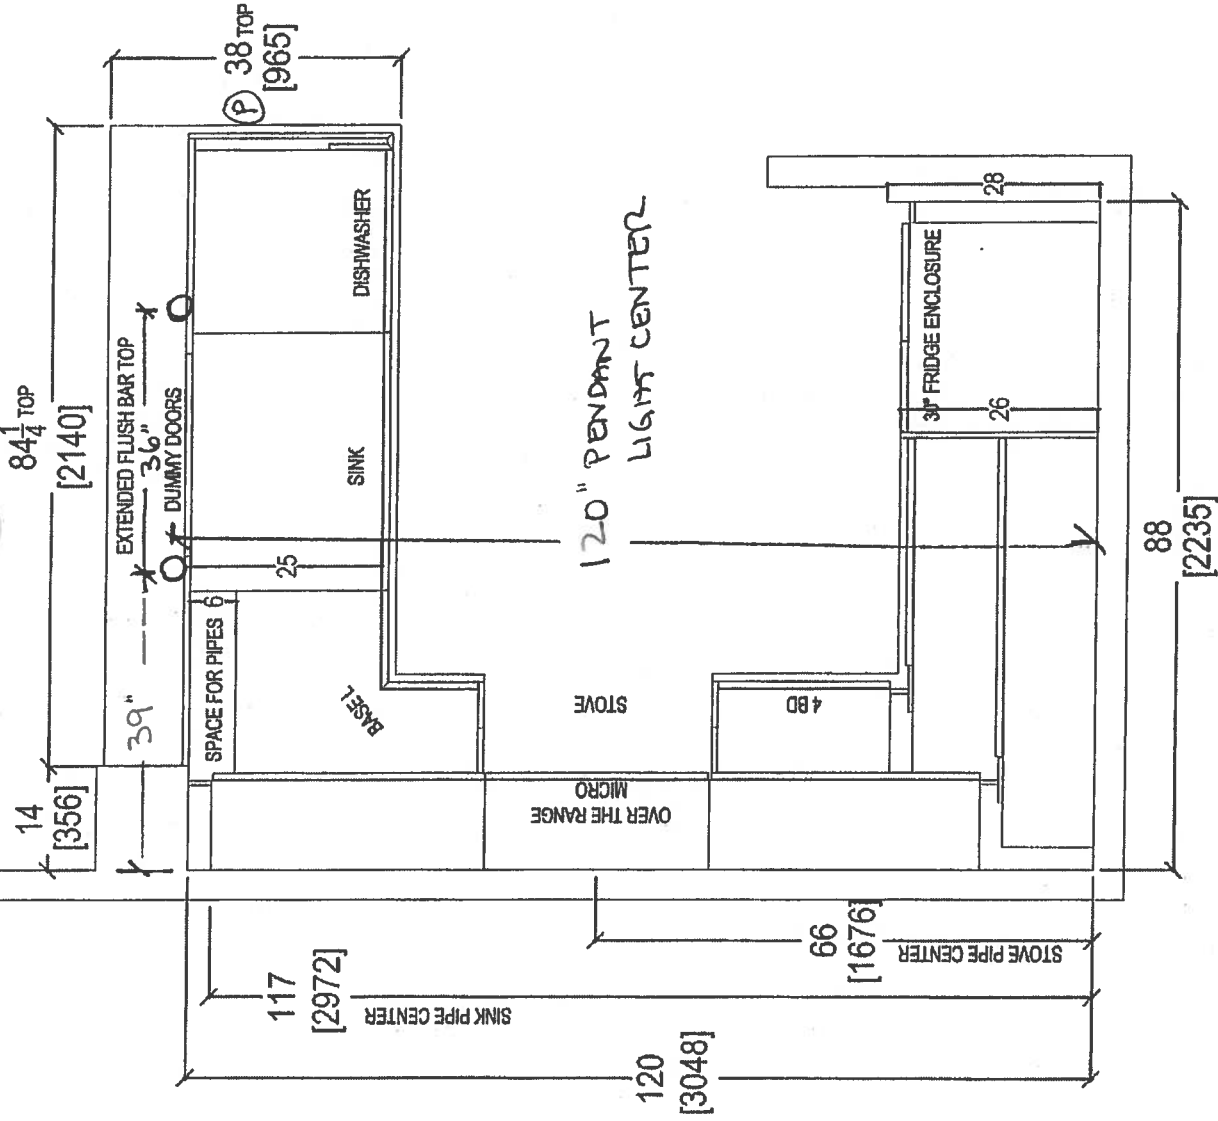


RECEIVED
11/11/17

 your kitchen, your way. 80 SANTE DRIVE, VAUGHAN, ON L4K 3C4. T: 416.746.1811 F: 905.761.5901	CLIENT: ROYAL PINE HOMES		1C+D SAG HARBOR		ROOM:	KITCHEN FLOOR PLAN	DRAWN BY: SK	COMMENTS: PLEASE NOTE ALL DIMENSIONS ARE NOT FINAL AND ARE SUBJECT TO CHANGE UPON FINAL SITE MEASURE	
	SITE:	HAMPTON PLACE	DOOR STYLE:	—	DOOR HANDLE:	—	SCALE:		1/2" = 1' - 0"
	PHONE:	---	FINISH:	—	DRW HANDLE:	—	DATE:		AUG 4, 2017
	EMAIL:	—	SPECIES:	—	TOP:	—	PAGE:		—

STOVE PIPE CENTER 66
15 [381] 36 [914] 30 [762] 36 [914] 3 [76]


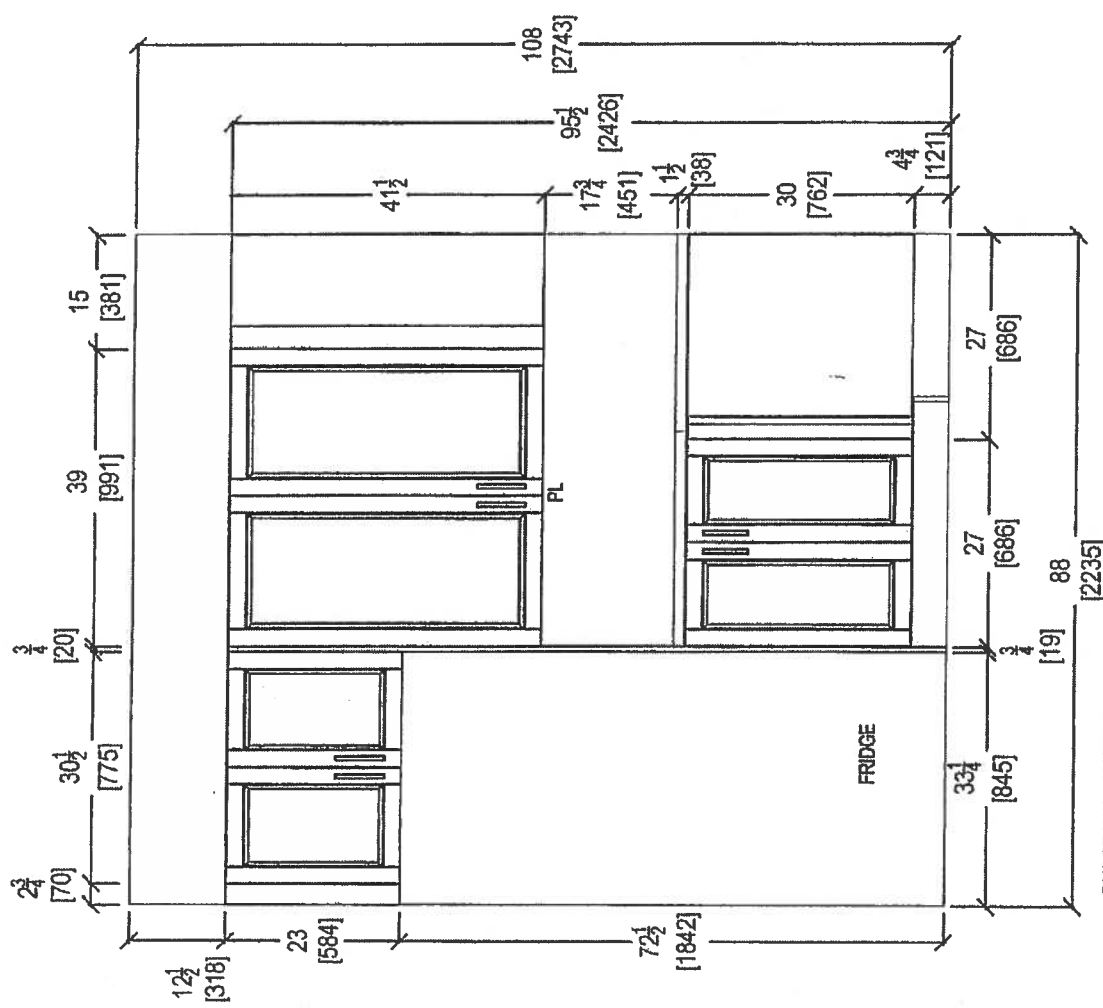


STOVE WALL ELEVATION

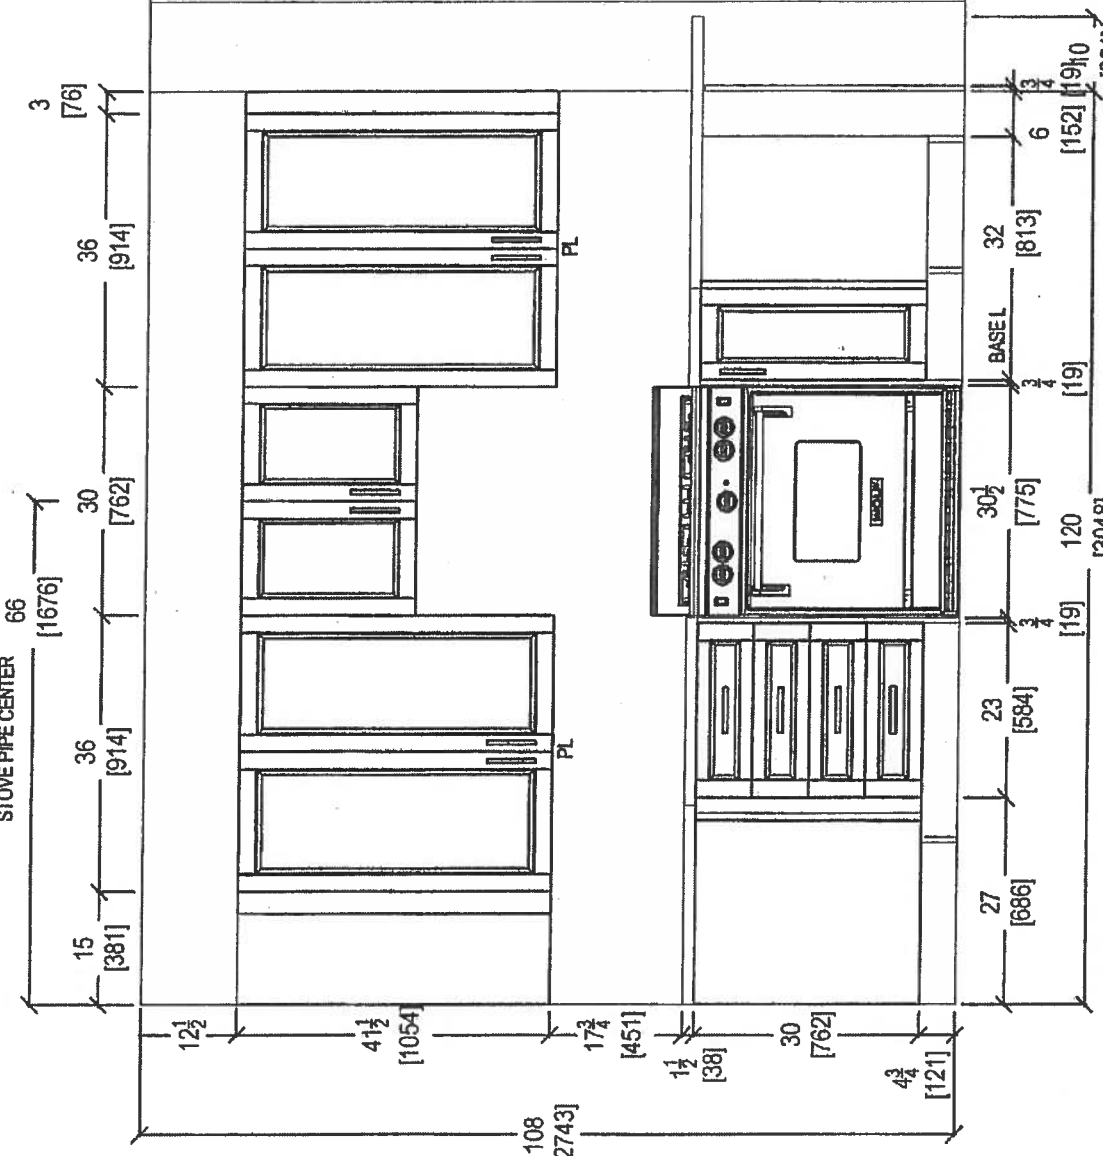

RECEIVED
2017 AUG 4

CLIENT: ROYAL PINE HOMES		ROOM: KITCHEN	DRAWN BY: SK	COMMENTS:	
SITE: HAMPTON PLACE	DOOR STYLE: —	DOOR HANDLE: —	SCALE: 1/2" = 1'-0"	PLEASE NOTE ALL DIMENSIONS ARE NOT FINAL AND ARE SUBJECT TO CHANGE UPON FINAL SITE MEASURE	
PHONE: —	FINISH: —	DRW HANDLE: —	DATE: AUG 4, 2017		
EMAIL: —	SPECIES: —	TOP: —	PAGE: —		



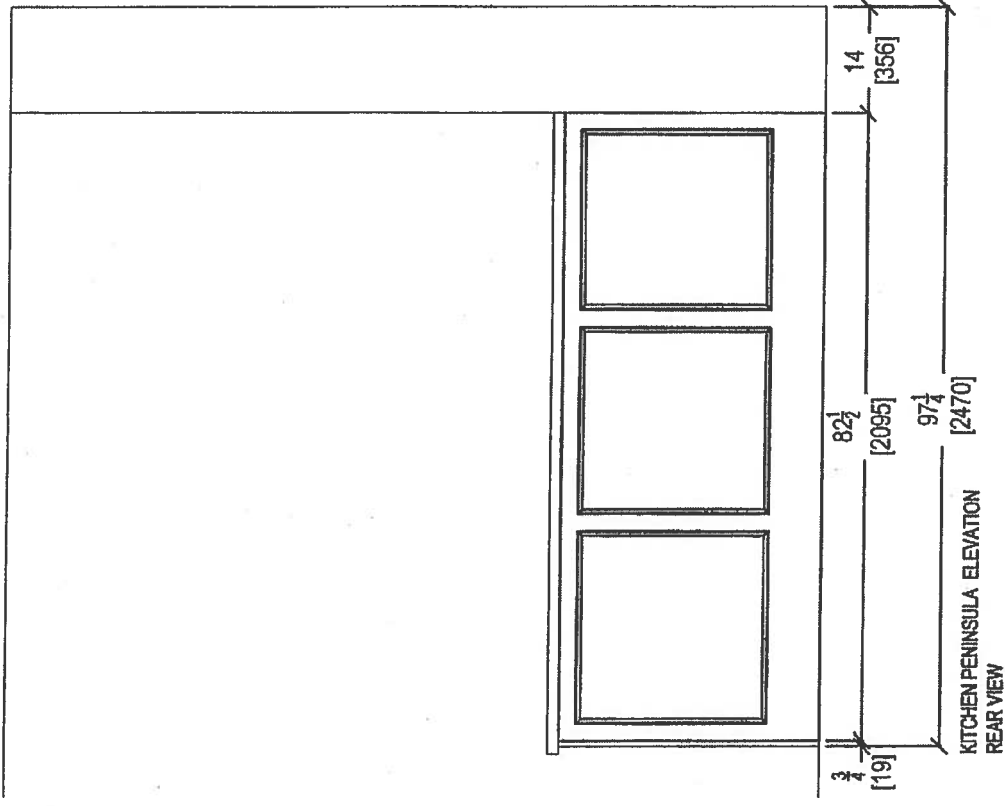
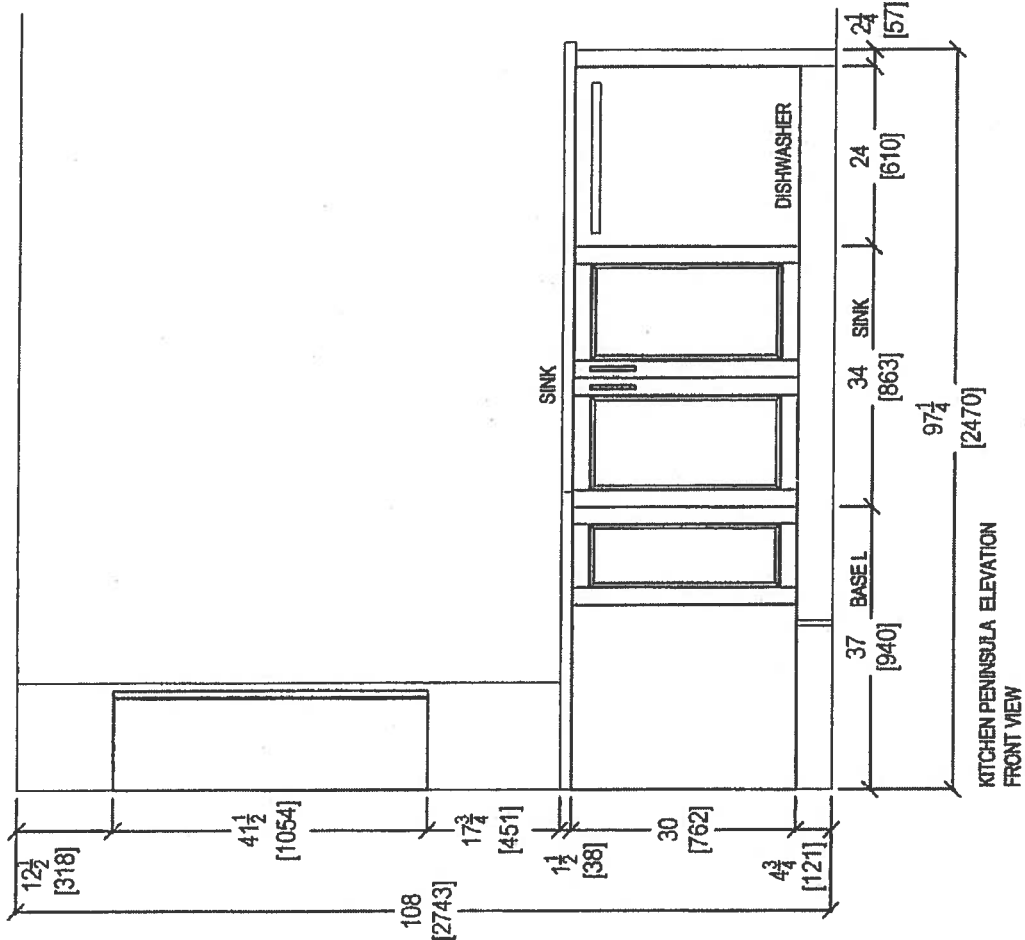


CTK
your kitchen, your style.

80 SANTE DRIVE, VAUGHAN, ON L4K 3C4.
T: 416.748.1811 F: 905.761.5901

CLIENT: ROYAL PINE HOMES		1C+D SAG HARBOR		ROOM: KITCHEN	DRAWN BY: SK		COMMENTS: RECEIVED NOV 6 17
SITE:	HAMPTON PLACE	DOOR STYLE:	—	DOOR HANDLE:	—	SCALE: 1/2" = 1'-0"	
PHONE:	—	FINISH:	—	DRW HANDLE:	—	DATE: AUG 4, 2017	
EMAIL:	—	SPECIES:	—	TOP:	—	PAGE: —	

RECEIVED
RPN 6-17

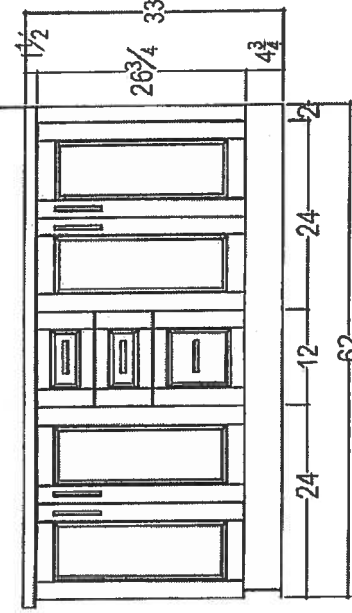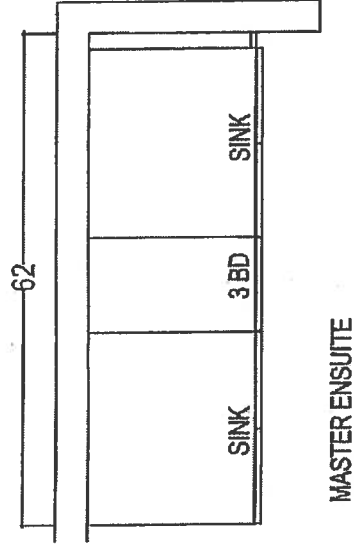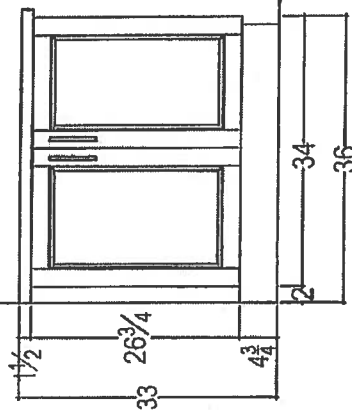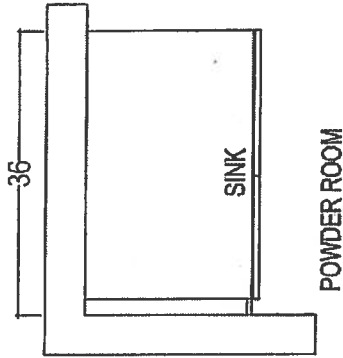


RECEIVED
11 FEB 2018

 your kitchen, your life. 80 SANTE DRIVE, VAUGHAN, ON L4K 3C4, T: 416.746.1811 F: 905.761.5901	CLIENT: ROYAL PINE HOMES		1C+D SAG HARBOR		ROOM:	VANITIES	DRAWN BY: SK	COMMENTS: PLEASE NOTE ALL DIMENSIONS ARE NOT FINAL AND ARE SUBJECT TO CHANGE UPON FINAL SITE MEASURE
	SITE: HAMPTON PLACE		DOOR STYLE: —		DOOR HANDLE: —		SCALE: 1/2" = 1' - 0"	
	PHONE: —		FINISH: —		DRW HANDLE: —		DATE: AUG 4, 2017	
	EMAIL: —		SPECIES: —		TOP: —		PAGE: —	

Suite - Inventory Suite

OPTIONAL


- 1st Upgrade Appliance Pkg.
- 1st Upgrade Kitchen
- (x1) = Plug Peninsula
- (x5) = Rack Lights
- (x2) = Carved Pendant Lights

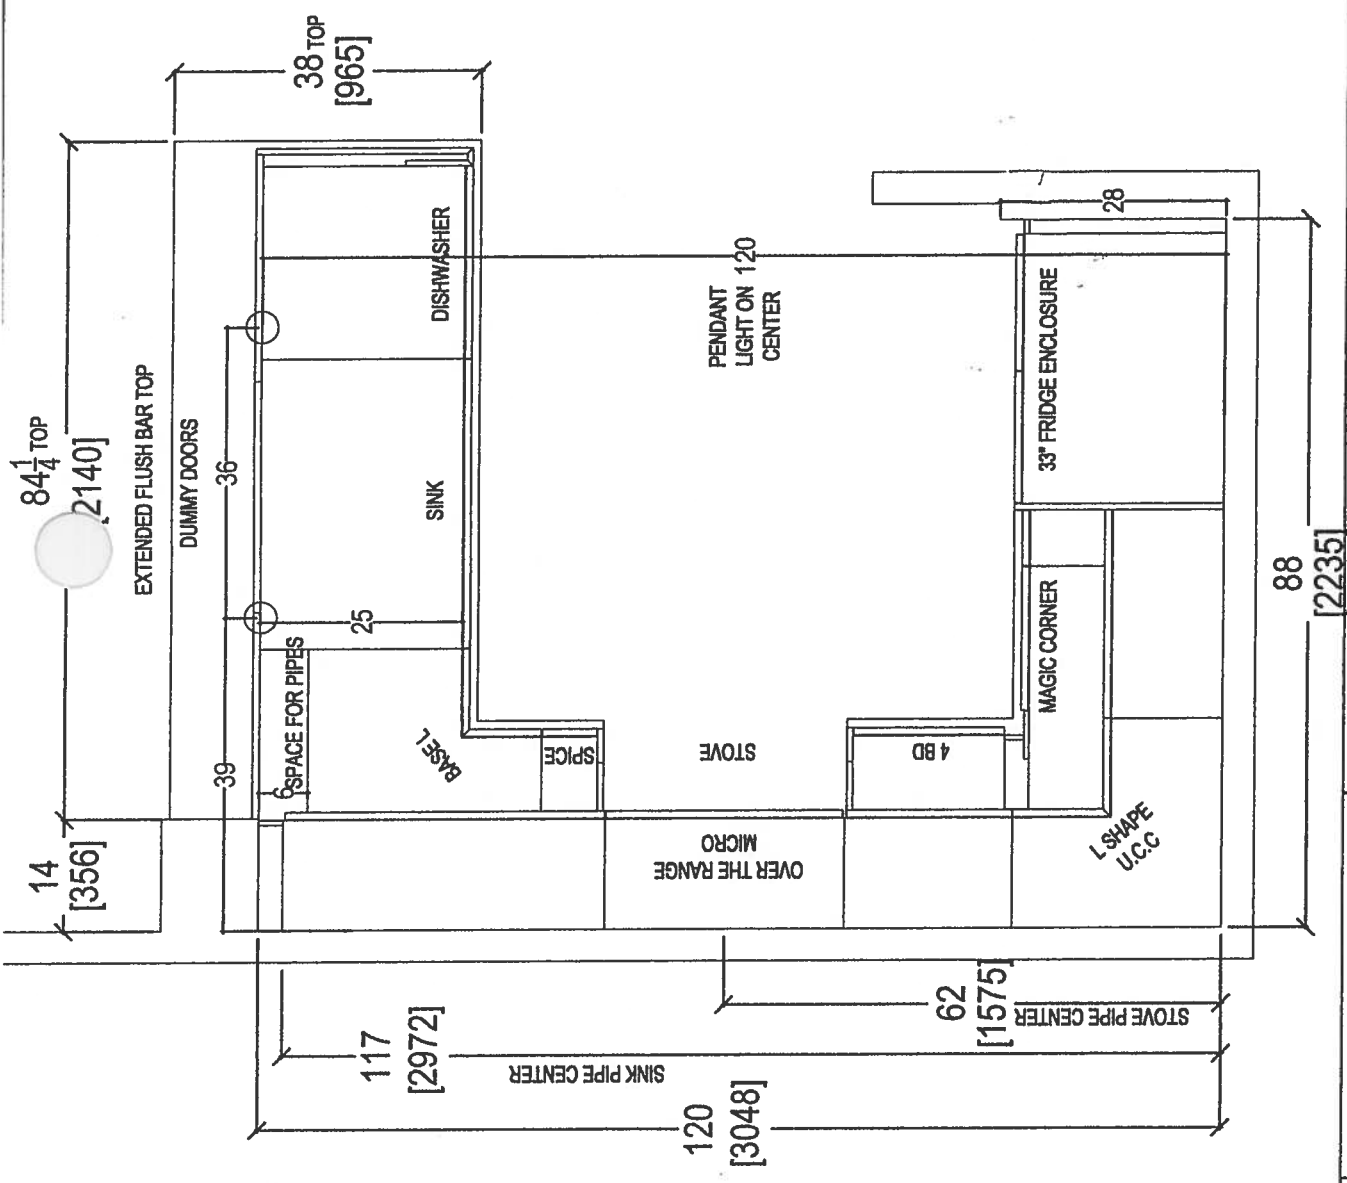

CLIENT: ROYAL PINE HOMES		UNIT 512 HMP	1st Upgrade Kitchen	ROOM:	KITCHEN FLOOR PLAN	DRAWN BY: SK	COMMENTS: PLEASE NOTE ALL DIMENSIONS ARE NOT FINAL AND ARE SUBJECT TO CHANGE UPON FINAL SITE MEASURE
SITE:	HAMPTON PLACE	DOOR STYLE:	---	DOOR HANDLE:	---	SCALE: 1/2" = 1'-0"	
PHONE:	---	FINISH:	---	DRW HANDLE:	---	DATE: MARCH 7, 2018	
EMAIL:	---	SPECIES:	---	TOP:	---	PAGE: ---	




80 SANTE DRIVE, VAUGHAN, ON L4K 3C4,
T: 416.746.1811 F: 905.781.5901




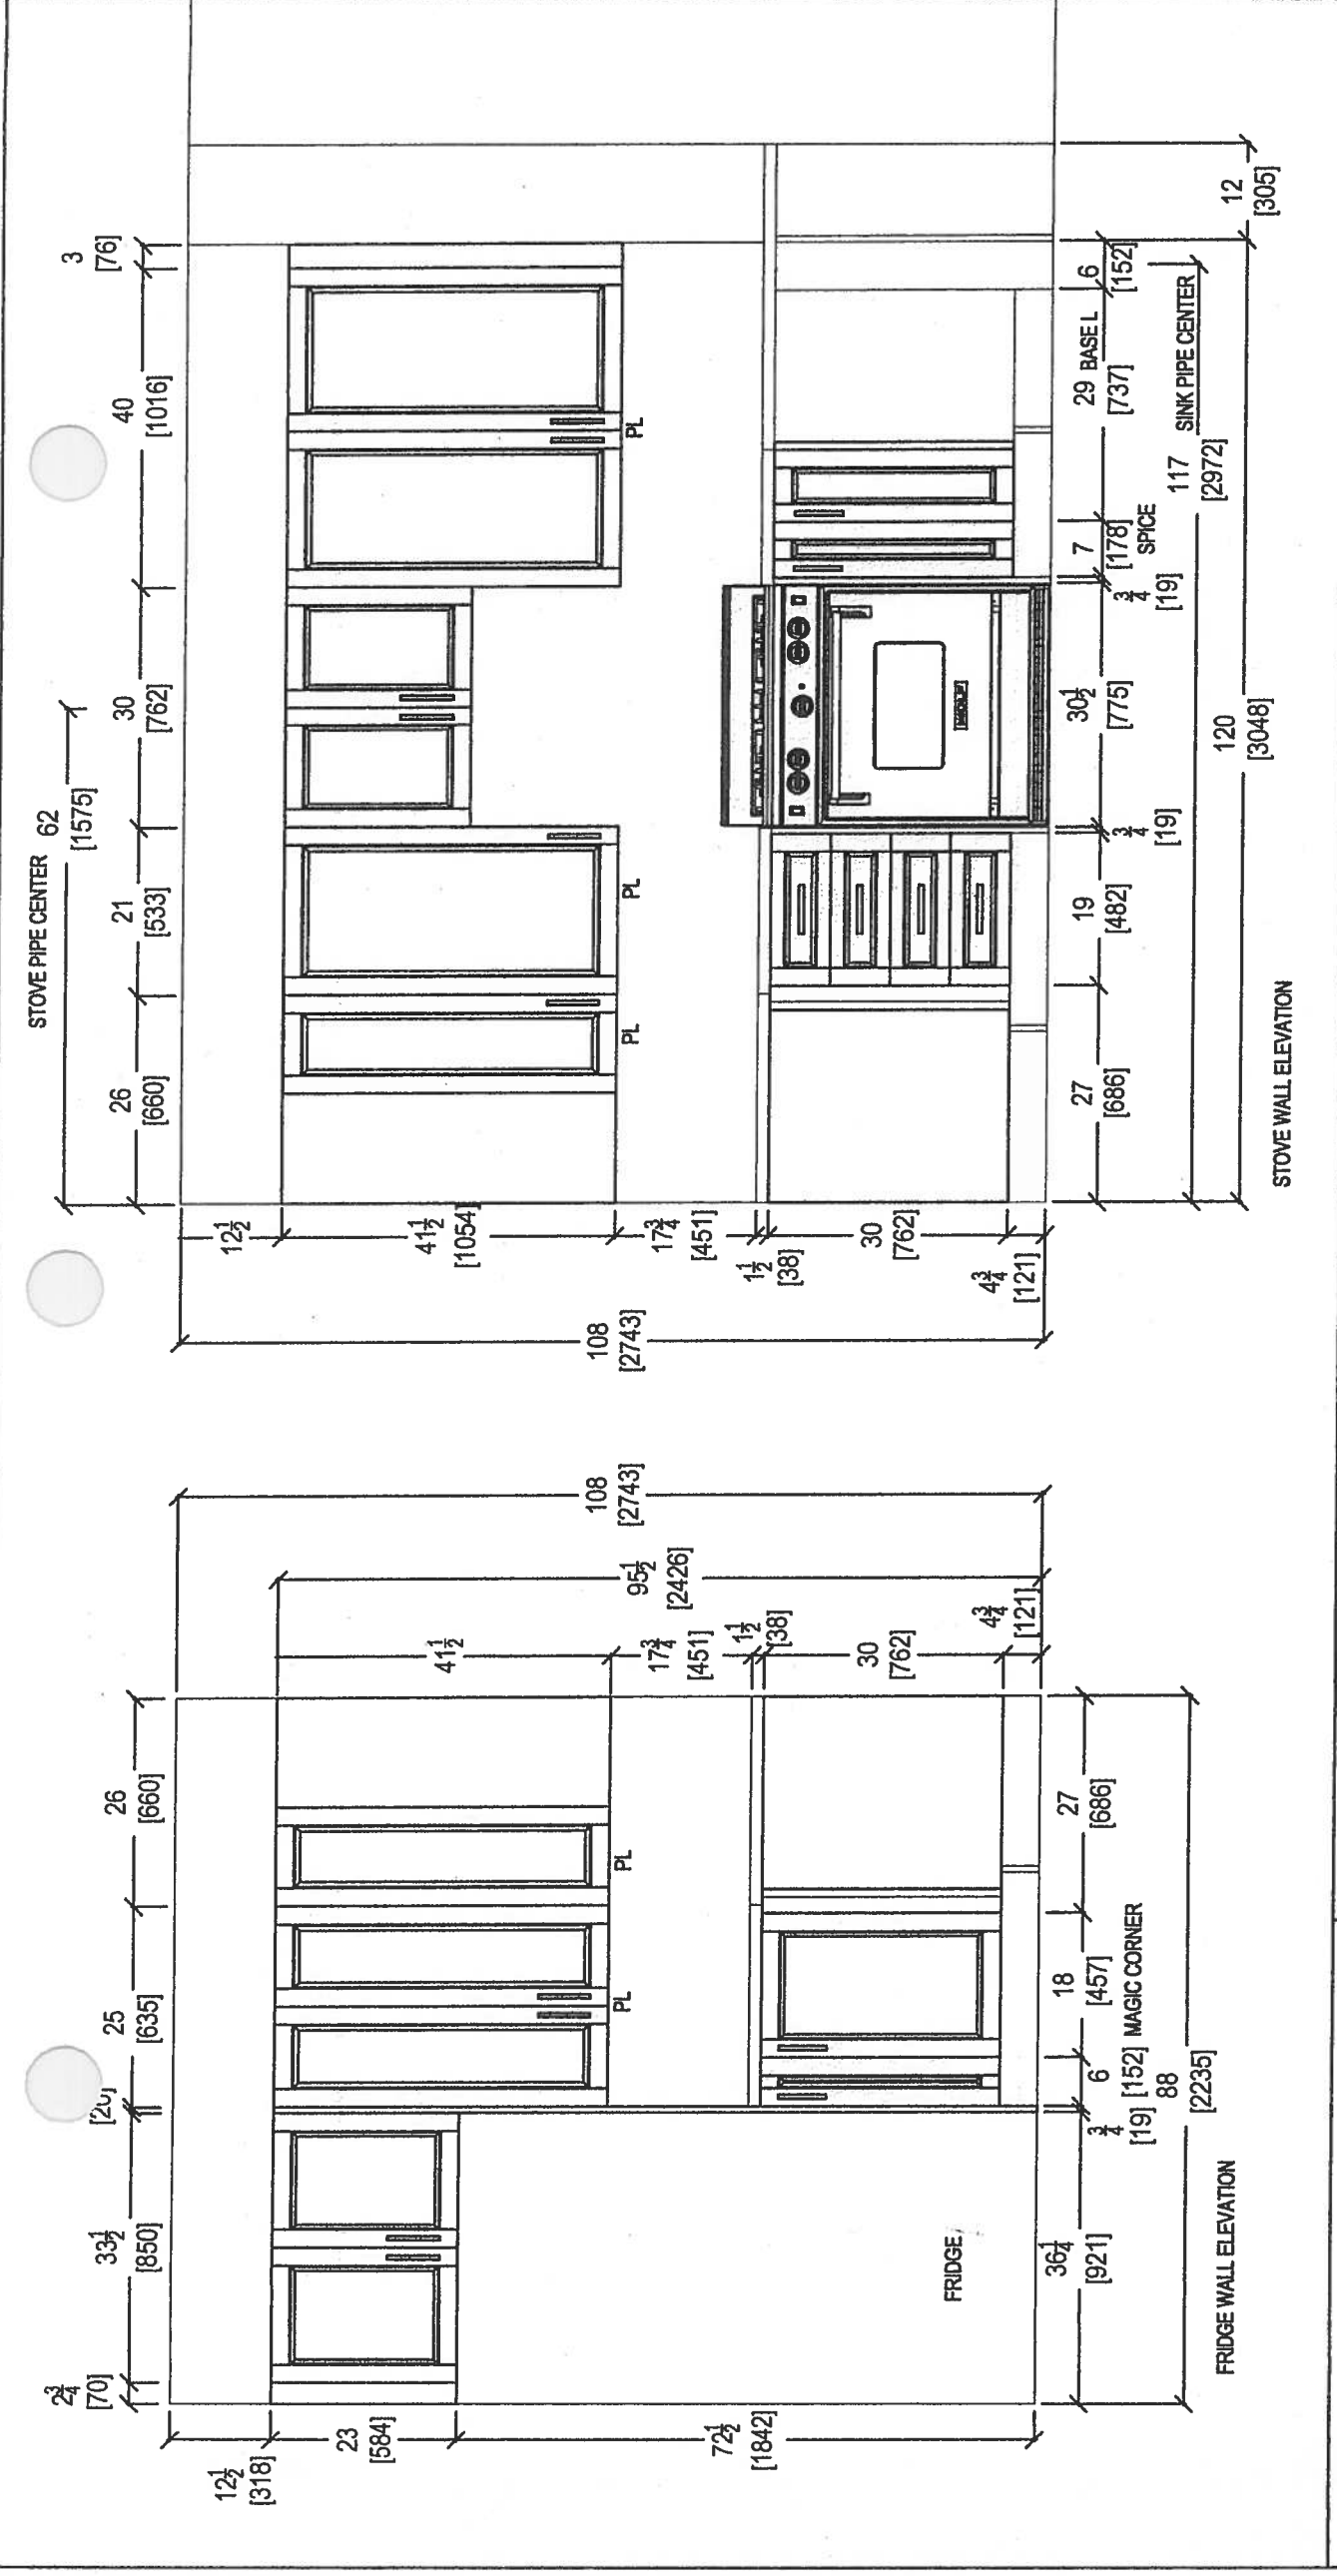


 <i>your kitchen, your taste.</i> 80 SANTE DRIVE, VAUGHAN, ON L4K 3C4, T: 416.746.1811 F: 905.761.5901		CLIENT: ROYAL PINE HOMES	UNIT 512 HMP		ROOM: KITCHEN	DRAWN BY: SK	COMMENTS: PLEASE NOTE ALL DIMENSIONS ARE NOT FINAL AND ARE SUBJECT TO CHANGE UPON FINAL SITE MEASURE
SITE: HAMPTON PLACE	DOOR STYLE: —	DOOR HANDLE: —	SCALE: 1/2" = 1' - 0"				
PHONE: —	FINISH: —	DRW HANDLE: —	DATE: MARCH 7, 2018				
EMAIL: —	SPECIES: —	TOP: —	PAGE: —				



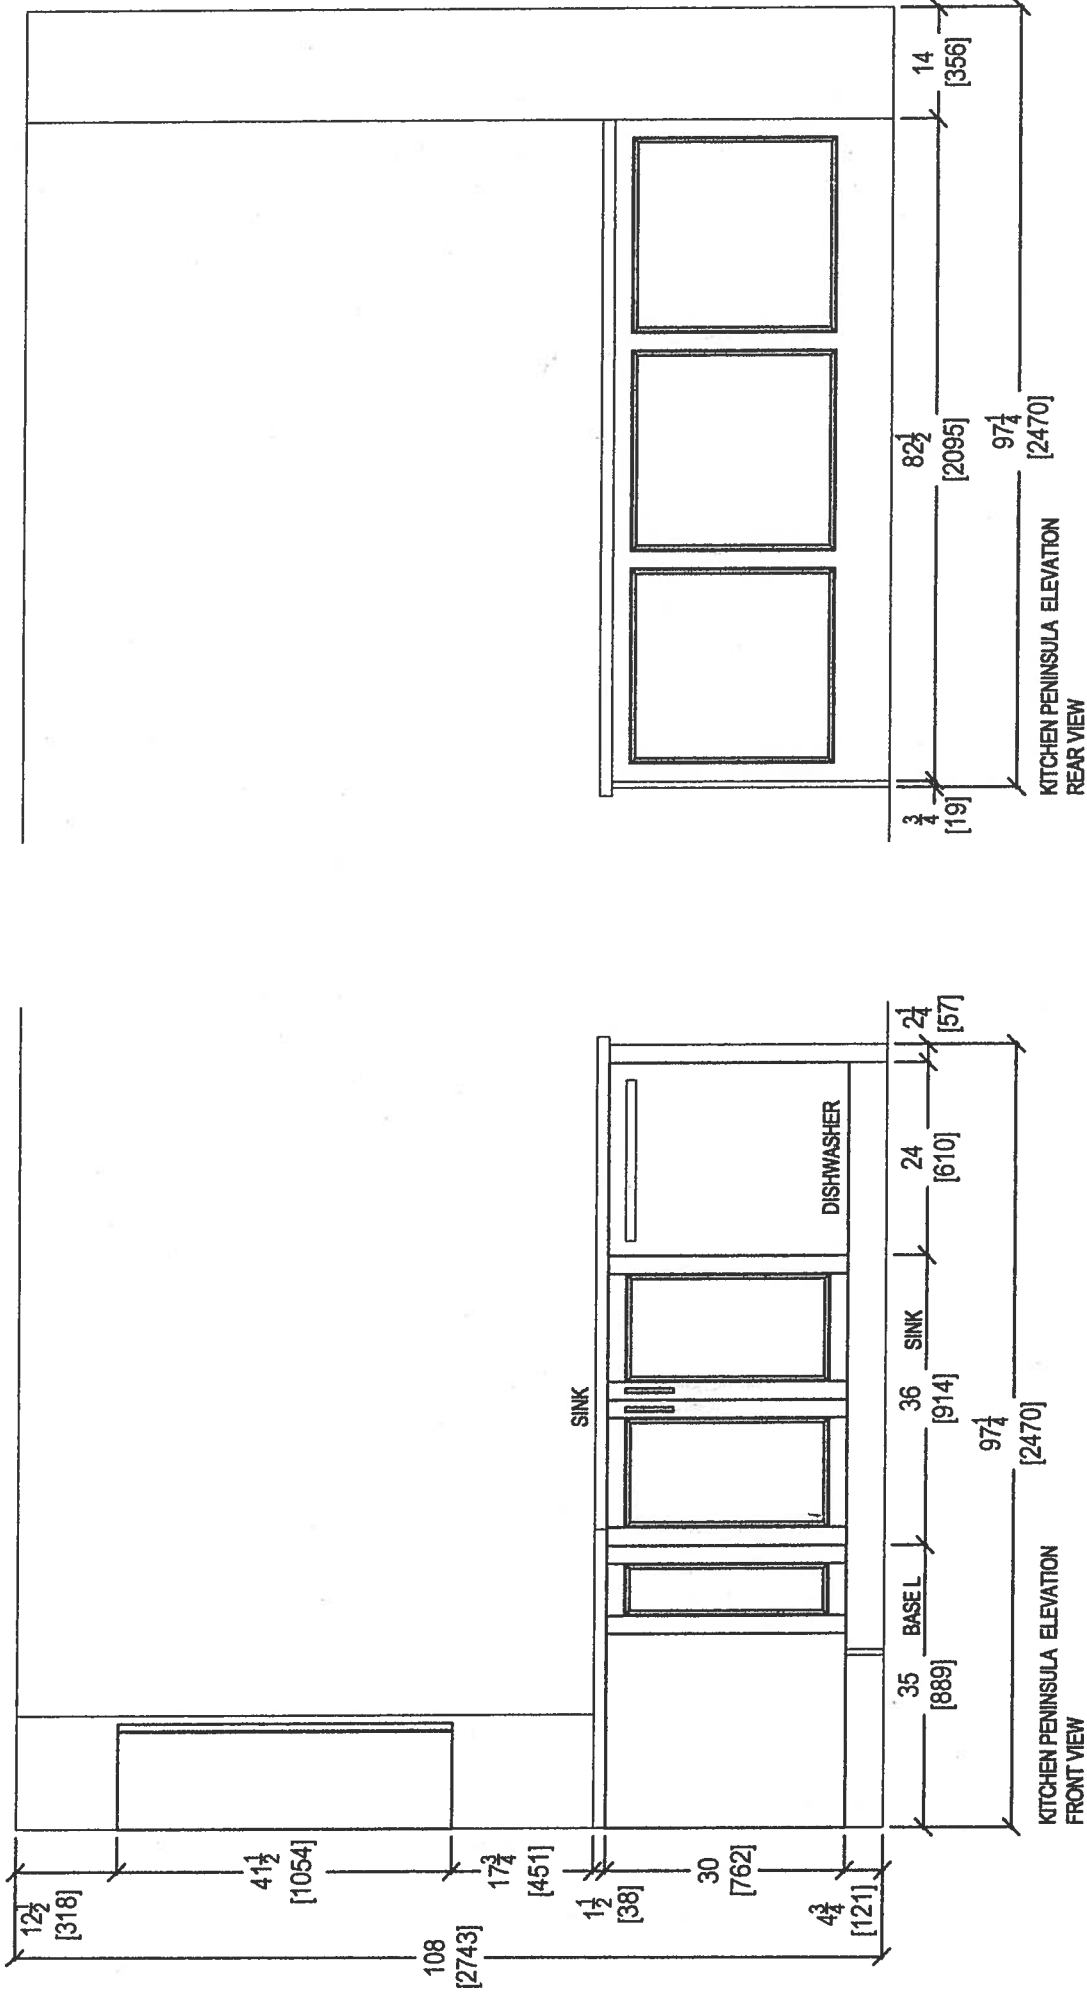

 <i>your kitchen, your taste.</i> 80 SANTE DRIVE, VAUGHAN, ON L4K 3C4, T: 416.746.1811 F: 905.761.5901	CLIENT: ROYAL PINE HOMES		UNIT 512 HMP		ROOM: KITCHEN	DRAWN BY: SK	COMMENTS:
	SITE: HAMPTON PLACE		DOOR STYLE: —		DOOR HANDLE: —	SCALE: 1/2" = 1' - 0"	
	PHONE: —		FINISH: —		DRW HANDLE: —	DATE: MARCH 7, 2018	
	EMAIL: —		SPECIES: —		TOP: —	PAGE: —	

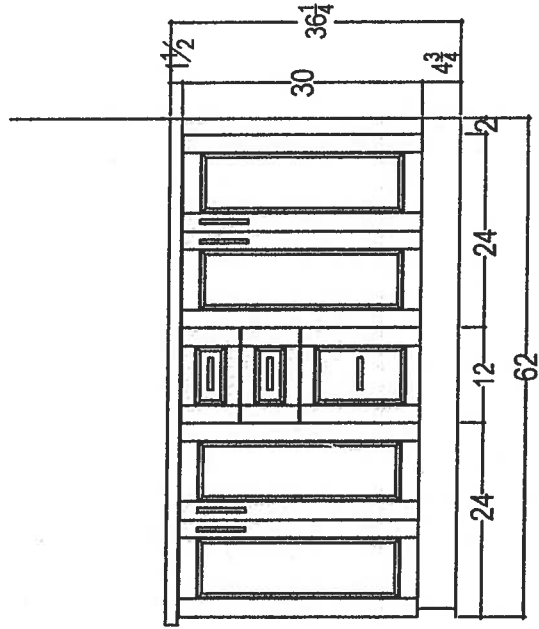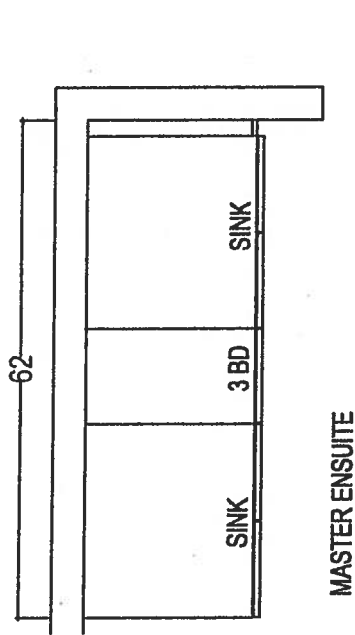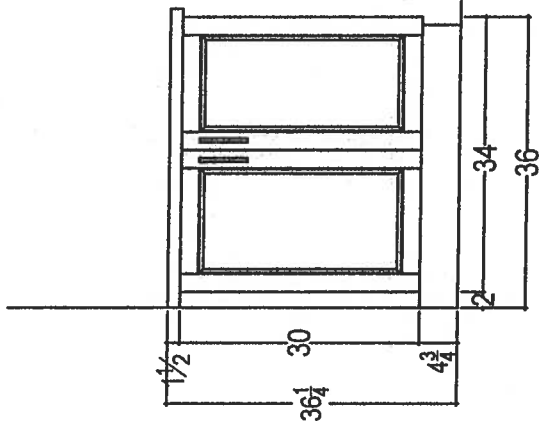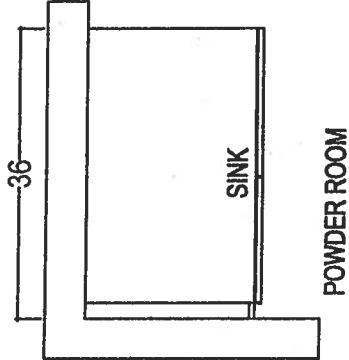

80 SANTE DRIVE, VAUGHAN, ON L4K 3C4,
T: 416.748.1811 F: 905.761.5901

CLIENT: ROYAL PINE HOMES		UNIT 512 HMP		ROOM:	VANITIES	DRAWN BY: SK		COMMENTS: PLEASE NOTE ALL DIMENSIONS ARE NOT FINAL AND ARE SUBJECT TO CHANGE UPON FINAL SITE MEASURE
SITE:	HAMPTON PLACE	DOOR STYLE:	—	DOOR HANDLE:	—	SCALE:	1/2" = 1' - 0"	
PHONE:	—	FINISH:	—	DRW HANDLE:	—	DATE:	MARCH 7, 2018	
EMAIL:	—	SPECIES:	—	TOP:	—	PAGE:	—	