

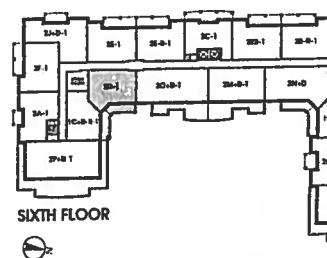
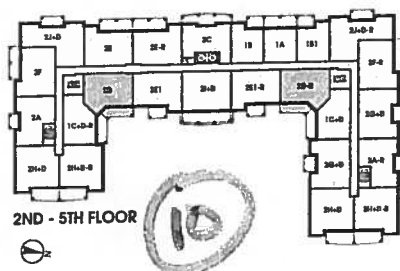


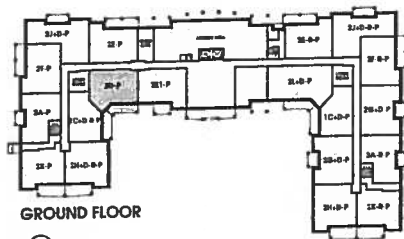

Remsenburg

1,031 SQ FT *plus 124 sq. ft. of balcony area*

SUITE 517
ORIGINAL
LAYOUT

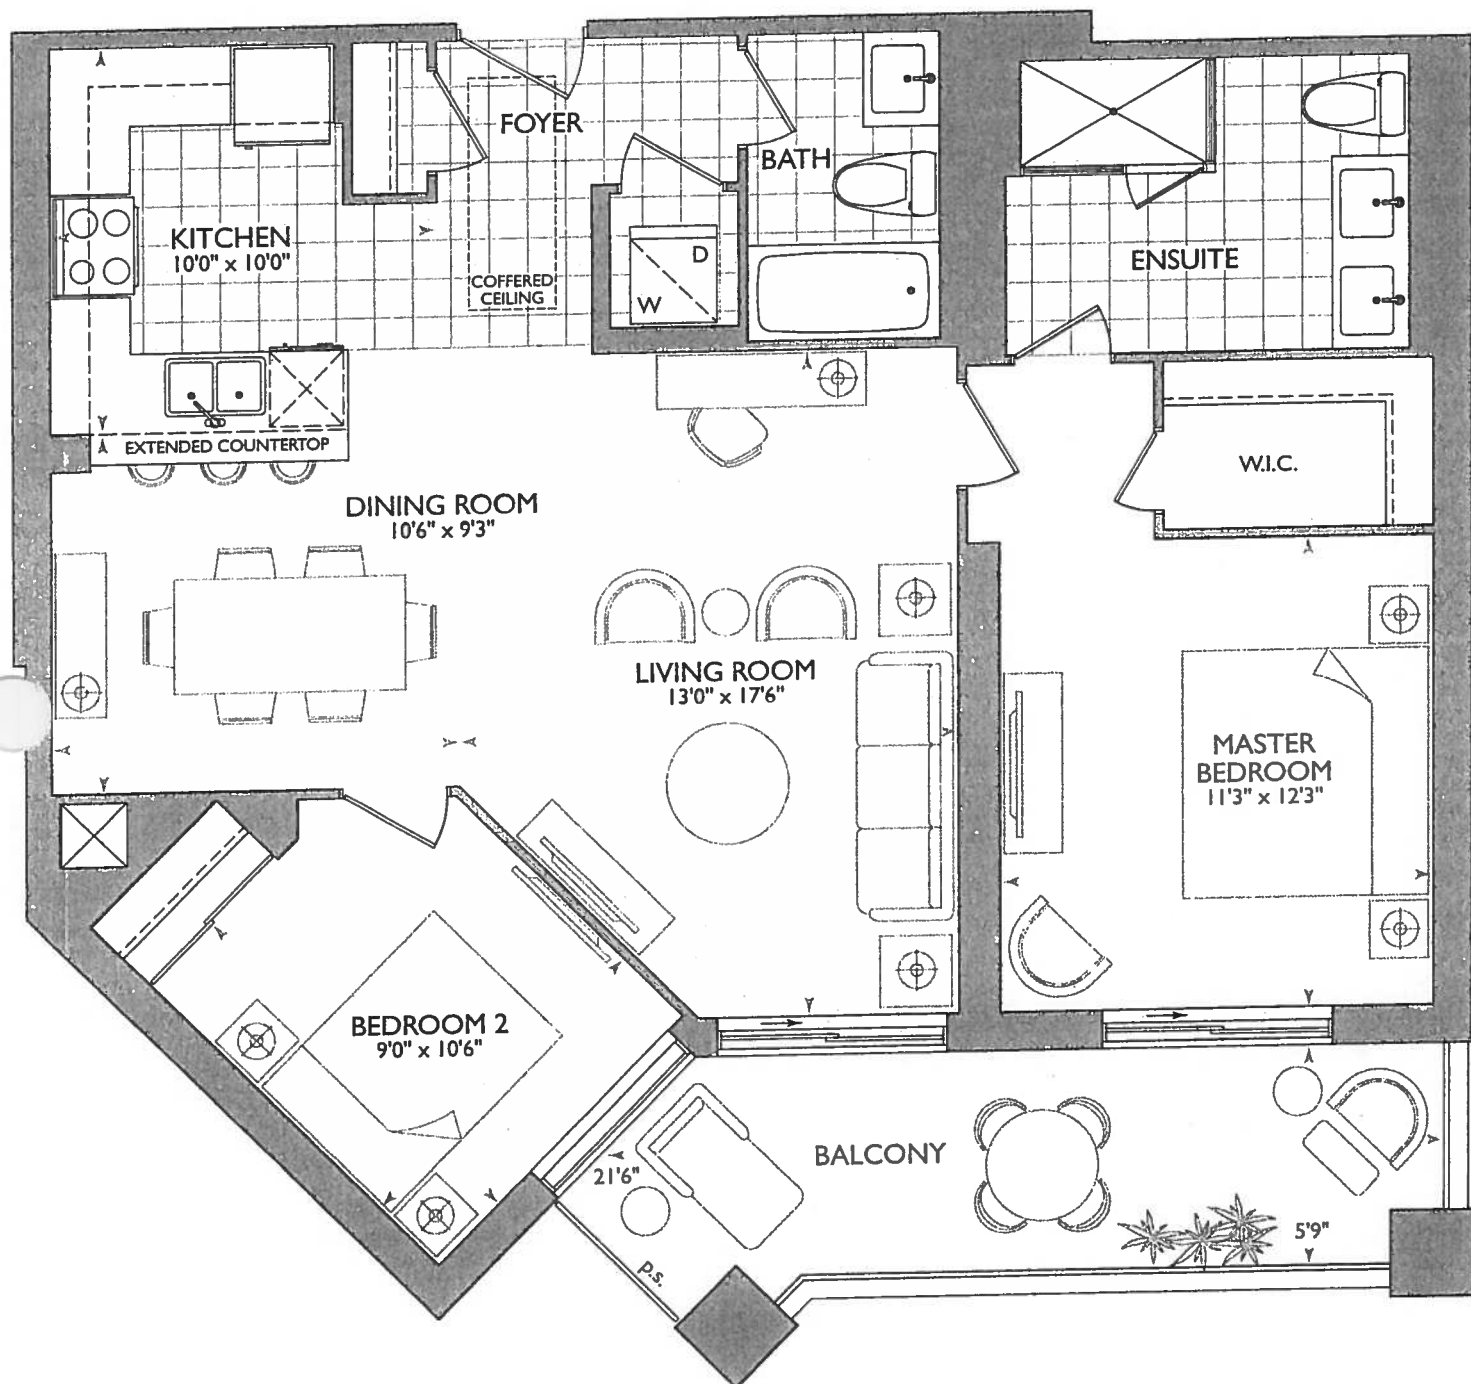

January 4, 2018


AS

117" SINK PIPE CENTER

61"

KITCHEN

- STD APPLIANCE PACKAGE
- x 5 = PUCK LIGHTS
- (P) = PLUG PENINSULA
- 61" STOVE PIPE CENTER
- 117" SINK PIPE CENTER
- * MAIN + ENSUITE 36 1/4" RAISED VANITIES + 3" SPLASH.

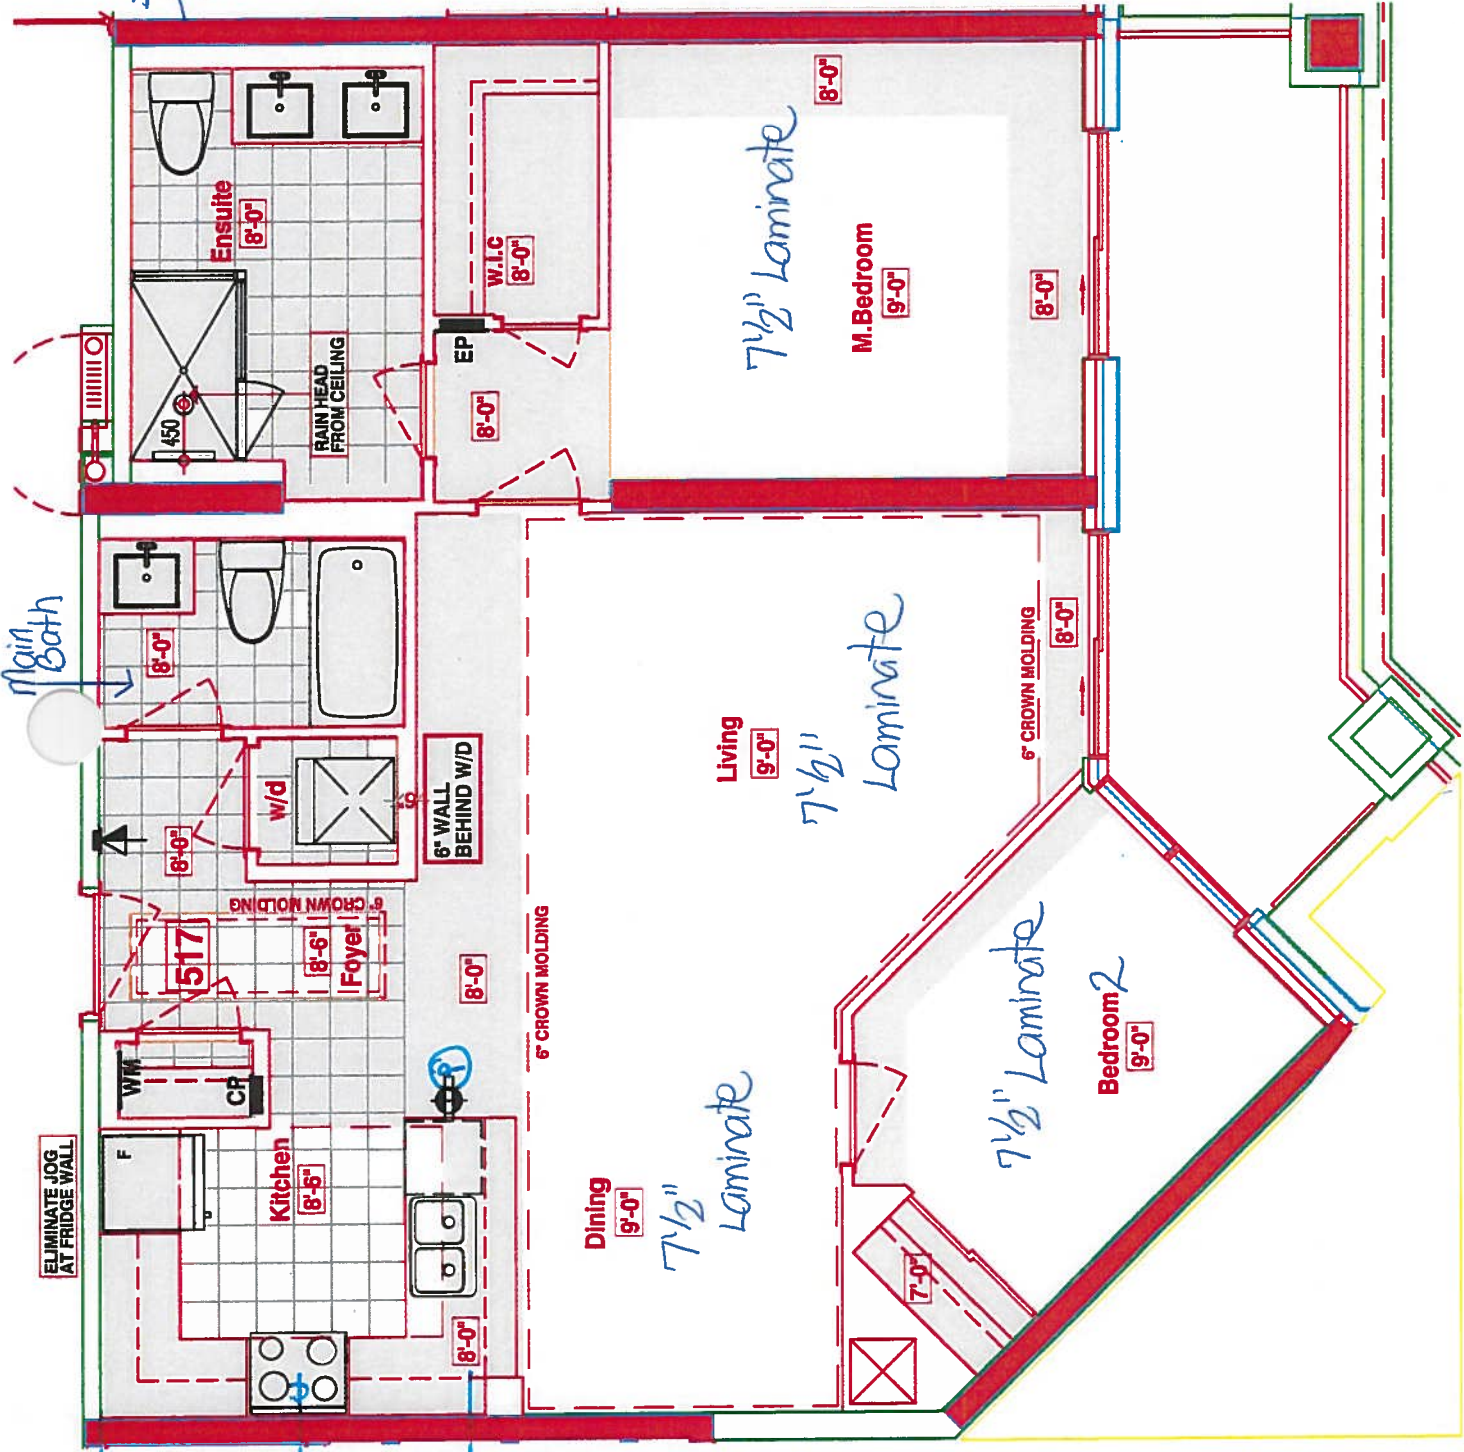

RECEIVED
Rosenzweig

SUITE 517 - REMSENBURG

Royal Pine Homes 25 Baker Hill Blvd - Stouffville, ON Dec 21, 2017



CONSTRUCTION SUMMARY

Hampton Place

PURCHASER: AARON DAVID JAMES

TEL: RES.: 905-640-0343

LOT NUMBER	PHASE	HOUSE TYPE	CLOSING DATE	
517	1	REMSENBURG	25-Oct-18	

Offer Workshee	PURCHASER TO RECEIVE \$5,000(INCLUDES APPLICABLE TAXES) WORTH OF UPGRADES AT THE DECOR CENTER AT TIME OF COLOUR CHART. Note:
-------------------	---

er Upgrade	RAINHEAD FROM CEILING IN MASTER ENSUITE , FROM VENDORS STANDARD SAMPLES Note:
---------------	--

Offer Upgrade	PURCHASER HAS USED \$1073.50 (INCLUDING HST) FROM THEIR \$5000 (INCLUDING TAXES) WORTH OF UPGRADES TO SPEND AT THE DECOR CENTER. PURCHASER NOW HAS \$3926.50 (INCLUDING TAXES) TO SPEND AT THE DECOR CENTER AT THE TIME OF THE COLOUR CHART Note:
------------------	--



SITE COPY

CONSTRUCTION SUMMARY

Hampton Place

PURCHASER: AARON DAVID JAMES

TEL: RES.: 905-640-0343

LOT NUMBER	PHASE	HOUSE TYPE	CLOSING DATE	
517	1	REMSENBURG	25-Oct-18	

Date Added: 04-Jan-18

Invoice Number: 7074

1 - KITCHEN & BATHROOMS - SEE QUALITY TOPS & KITCHENS FOR ALL KITCHEN & BATHROOMS UPGRADES / LAYOUTS (See Attached QTK Paperwork)

2 - KITCHEN - Install TWO (2) ADDITIONAL PUCK LIGHTS (Same Switch as Standard Puck Lights) at kitchen. To be installed below kitchen cabinetry, where applicable. (See Attached QTK Layout for Locations)
Note: Purchaser Paying Difference for Additional Puck Lights - Standard Kitchen to Receive Three (3) Puck Lights - Upgrade Kitchen Requires Five (5) Puck Lights

1 - KITCHEN - CABINETRY HARDWARE - Install UPGRADE PACKAGE # 1 HARDWARE - STYLE # 53529-G10 - To be installed throughout kitchen cabinetry, where applicable. (See Sketch)
Note:

1 - KITCHEN - Install Standard Granite Countertop - BIANCO ANTICO - To be installed throughout kitchen, where applicable (does not include granite backsplash) (See Sketch)
Note:

1 - DISCLAIMER - GRANITE COUNTERTOP;
KITCHEN - Due to the many variables that can affect the pattern, colour and/or design and "pitting" of natural products, granite installed will not be identical to the samples displayed.
Note: Every effort is made to provide granite countertops as close as possible but the vendor is not responsible for results which differ from the sample displayed. All countertop surfaces may have seams, and product pattern and shade can change in areas containing seams.

1 - DISCLAIMER - STONE COUNTERTOP;
KITCHEN - Stone slabs vary in size & all seams are visible & the fabricator reserves the right to position the seams as necessary.
Note:

1 - KITCHEN - Kitchen Sink - Install Upgrade Undermount Sink - BLANCO Quatrus R15 Undermount Sink - Model # 401519 (See Attached)
Note:

1 - KITCHEN - Kitchen Faucet - Install Standard Faucet - DELTA Chrome Pull-Out Kitchen Faucet (Single Hole) - Model # 469LF - Chrome
Note:

1 - APPLIANCE PACKAGE - Install STANDARD APPLIANCE PACKAGE - To be installed throughout suite, where applicable (See Sketch)
Note:

1 - MAIN BATH & MASTER ENSUITE - Install RAISED VANITY HEIGHTS at Main Bath and Master Ensuite Vanities, where applicable. (See Attached QTK Paperwork)
Note:

1 - MAIN BATH & MASTER ENSUITE - Install Standard Granite Countertop - BIANCO ANTICO - To be installed throughout Main Bath & Master Ensuite vanities, where applicable (Includes 3" Splash) (See Sketch)
Note:

1 - CLARIFICATION;
MAIN BATH & MASTER ENSUITE - Install Standard 3" Splash throughout Main Bath and Master Ensuite Vanity countertops, where applicable. (See Sketch)

1 - DISCLAIMER - GRANITE COUNTERTOP;
MAIN BATH & MASTER ENSUITE - Due to the many variables that can affect the pattern, colour and/or design and "pitting" of natural products, granite installed will not be identical to the samples displayed.
Note: Every effort is made to provide granite countertops as close as possible but the vendor is not responsible for results which differ from the sample displayed. All countertop surfaces may have seams, and product pattern and shade can change in areas containing seams.

1 - DISCLAIMER - STONE COUNTERTOP;
MAIN BATH & MASTER ENSUITE - Stone slabs vary in size & all seams are visible & the fabricator reserves the right to position the seams as necessary.
Note:



SITE COPY

CONSTRUCTION SUMMARY

Hampton Place

PURCHASER: AARON DAVID JAMES

TEL: RES.: 905-640-0343

LOT NUMBER	PHASE	HOUSE TYPE	CLOSING DATE	
517	1	REMSENBURG	25-Oct-18	

Date Added: 04-Jan-18

Invoice Number: 7074

1 - CLARIFICATION;
MAIN BATH & MASTER ENSUITE - Install Standard Plumbing Fixtures throughout Main Bath and Master Ensuite where applicable. (See Sketch)

1 - CLARIFICATION - REFER TO APAS;
MASTER ENSUITE - Install Rain Shower Head from Ceiling at Master Ensuite Shower Stall - DELTA - Shower Trim and Hansgrohe Slide Bar with Handheld and Ceiling Mount Showerhead
Note: Model # R10000 / T13020-CDN/27454002 / 277440 / RP52382 / RP46870 / RP6025 / R11000 / T11800 - Chrome (See Sketch)

1 - CLARIFICATION;
MASTER ENSUITE - Purchaser accepts & acknowledges the standard frameless glass enclosure at master ensuite shower stall will NOT touch the ceiling and will receive a Standard Chrome Header. (See Sketch)
Note:

1 - CLARIFICATION;
MAIN BATH & MASTER ENSUITE - DELETE Do Not Install / Supply / Credit Purchaser for builders standard ceramic bathroom accessories (toilet paper, towel bar & soap dish) throughout all bathrooms where applicable.
Note: To Include; Main Bath & Master Ensuite (See Sketch)

1 - BONUS PACKAGE - PURCHASER HAS APPLIED \$3,926.50 (Includes Taxes) WORTH OF UPGRADE PROMOTIONAL PACKAGE TOWARDS THE PURCHASE OF UPGRADES COMPLETED AT THE DECOR CENTRE.
Note:

1 - PURCHASER HAS ATTENDED A COLOR APPOINTMENT AT THE DECOR CENTRE AND HAS DECLINED ANY ADDITIONAL UPGRADES. Purchaser accepts and acknowledges that there will be no further changes/additions/deletions to be made upon signing on January 4, 2018

1 - PURCHASER AWARE AND ACCEPTS THAT ANY CHANGES MADE TO UPGRADES AFTER SIGNING THIS PURCHASERS EXTRA FORM ARE SUBJECT TO A MINIMUM ADMINISTRATION FEE OF \$1,000 PLUS A 10% HOLDBACK FEE.
Note:

This Document is Extremely Time Sensitive - Printed 5 Mar 18 at 15:33





* INTERIOR OUR SCHEME *


Purchaser AARON DAVID JAMES		Decor Consultant Melissa Di Marino	Model Type REMSENBURG	Telephone Res. / Bus (905) 640-0343 /	Project Hampton Place	Closing Date 25/10/2018	Unit 517
--------------------------------	--	---------------------------------------	--------------------------	--	--------------------------	----------------------------	-------------

Page 1 of 3

	Flooring		Wall Tile		
	Description	Main	Accent/Insert	Pattern	
✓ MASTER ENSUITE	✓ 13x13 HELLO SILVER (STD)	✓ 8x10 GOLF GRIGIO (STD)	NONE	NONE	
✓ MAIN BATHROOM	✓ 13x13 HELLO SILVER (STD)		NONE	NONE	
POWDER ROOM					
✓ KITCHEN / DINETTE	✓ 20x20 PULPIS GRIS (STRAIGHT) (STD)	✓ 12x12 TwilightMocha GlassMosaics (STD)	NONE	NONE	
✓ FOYER	✓ 20x20 PULPIS GRIS (STRAIGHT) (STD)		N/A	N/A	
✓ LAUNDRY	✓ 8x8 BEHRAM PINK (STD)		N/A	N/A	
LIVING ROOM					
DINING ROOM					
DEN					
MASTER BEDROOM					
BEDROOM 2					
BEDROOM 3					

Notes

Page 1 of 3

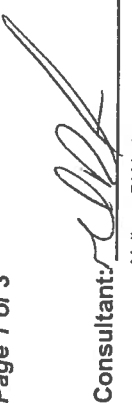Consultant:  Melissa Di Marino

Purchaser:  AARON DAVID JAMES

Vendor:  Hampton Place



* INTERIOR OUR SCHEME *

Purchaser AARON DAVID JAMES	Decor Consultant Melissa Di Marino	Model Type REMSENBURG	Telephone Res. / Bus (905) 640-0343 /	Project Hampton Place	Closing Date 25/10/2018	Unit 517
--------------------------------	---------------------------------------	--------------------------	--	--------------------------	----------------------------	-------------

Page 2 of 3

CABINETRY, VANITIES AND COUNTERTOPS

Style	Countertop	Counter Edge	Handle / Knob
MAIN BATHROOM CATEGORY 2 - MAPLE - SMOKEHOUSE QT 2503 (STD)	BIANCO ANTICO GRANITE (STD)	* A" EDGE (STD)	B603-SC
MASTER ENSUITE CATEGORY 2 - MAPLE - SMOKEHOUSE QT 2503 (STD)	BIANCO ANTICO GRANITE (STD)	* A" EDGE (STD)	3487-128
POWDER ROOM N/A	N/A	N/A	N/A
KITCHEN / DINETTE CATEGORY 2 - MAPLE - SMOKEHOUSE QT 2503 (STD)	BIANCO ANTICO GRANITE (STD)	* A" EDGE (STD)	53529-G10 UPD
LAUNDRY ROOM N/A	N/A	N/A	N/A

APPLIANCE PACKAGE

Standard Package

Std 3" In Opening

PLUMBING FIXTURES

KITCHEN
Sink Model UPD Blanco Quattris R15 #401519
Sink Faucet STANDARD

TOILETS

Master Ensuite STANDARD
Main Bathroom STANDARD
Powder Room N/A

VANITY FAUCETS

Master Ensuite STANDARD
Main Bathroom STANDARD
Powder Room N/A

VANITY SINKS

Master Ensuite STANDARD
Main Bathroom STANDARD
Powder Room N/A

SHOWER STALL / TUBS

Master Ensuite Shower Stall STANDARD
Master Ensuite Tub N/A
Main Bathroom Tub STANDARD

Trim	Baseboard & Casing	Levers
Interior Doors	STANDARD - CARRARA, SMOOTH	Door Height

Cornice Moulding / Medallion

Foyer STANDARD - #CTR-611
Living Room STANDARD - #CTR-611
Dining Room STANDARD - #CTR-611
Den N/A
Master Bedroom NONE
Bedroom 2 NONE
Bedroom 3 N/A

Fireplace

Fireplace N/A
Location Flooring N/A
Style N/A
Finish N/A
Marble N/A
Hearth N/A

MISC. INSTALLATIONS

Ceramic Accessories
(Installed by Vendor)
☒ Yes ☐ No

Bathroom Mirrors
(Installed by Vendor)
☒ Yes ☐ No

Wire Shelving - Closet
(Installed by Vendor)
☒ Yes ☐ No

Paint Throughout

Walls STANDARD - BIRCH WHITE	Trim STANDARD - WHITE
---------------------------------	--------------------------

Page 2 of 3

Decor Consultant: Purchaser:


Melissa Di Marino

AARON DAVID JAMES

Vendor:

Suite 517 Hampton



- STD APPLIANCE PACKAGE
- X5 = PUCK LIGHTS
- (P) = PLUG PENINSULA
- MAIN + ENSUITE RAISED VANITIES 36 1/4" + 3" splash.

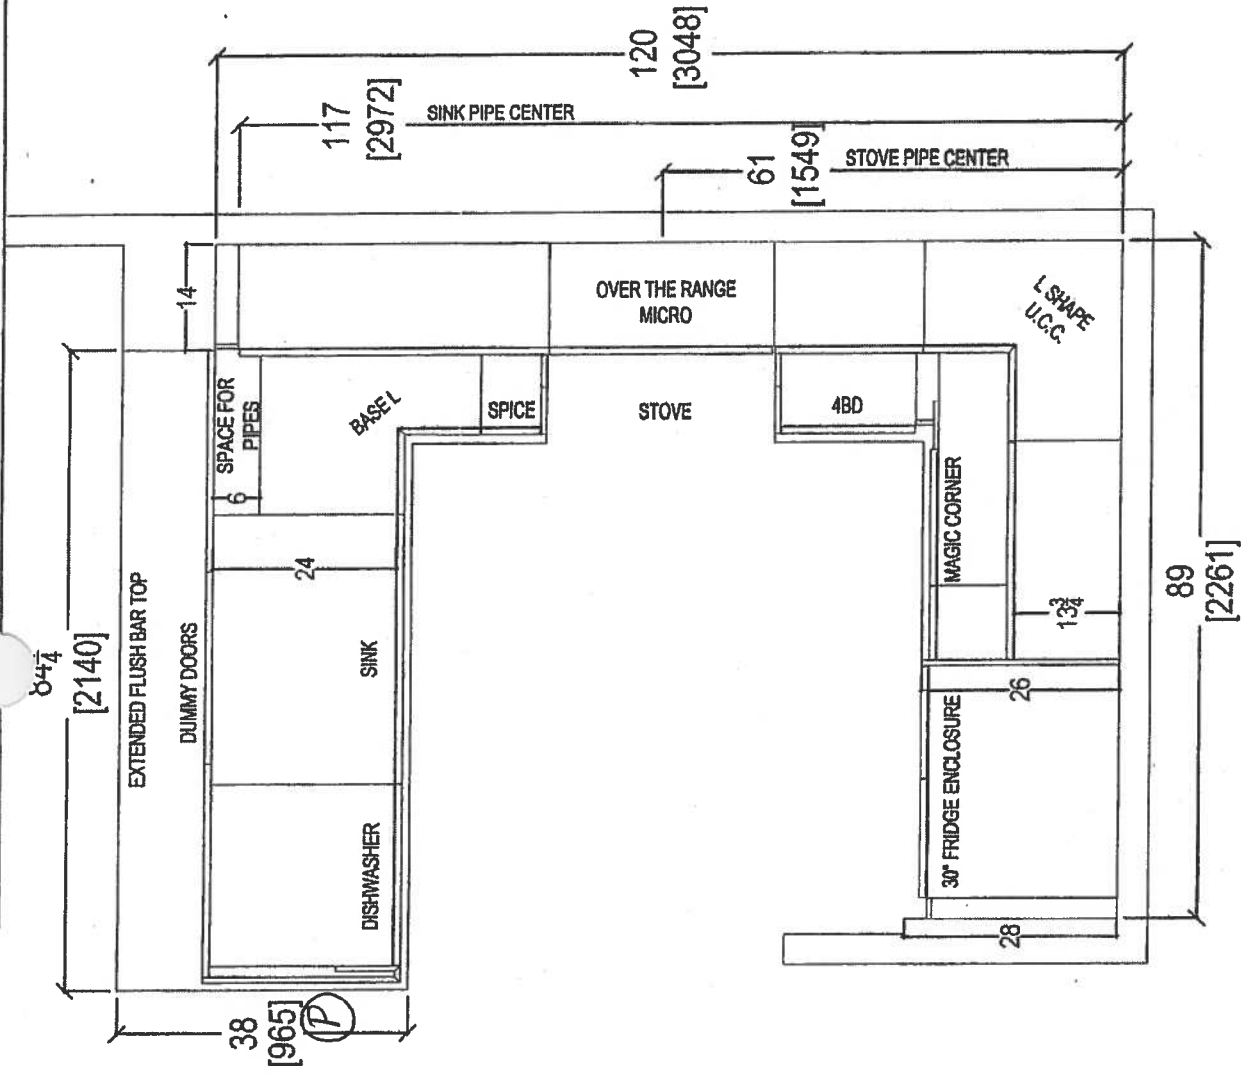


(P)

 <i>your kitchen, your taste.</i> 80 SANTE DRIVE, VAUGHAN, ON L4K 3C4, T: 416.746.1811 F: 905.761.5901	CLIENT: ROYAL PINE HOMES		REMBENBURG 2D-P UPGRADE PACKAGE		ROOM:	KITCHEN FLOOR PLAN	DRAWN BY: SK	COMMENTS: PLEASE NOTE ALL DIMENSIONS ARE NOT FINAL AND ARE SUBJECT TO CHANGE UPON FINAL SITE MEASURE	
	SITE:	HAMPTON PLACE	DOOR STYLE:	---	DOOR HANDLE:	---	SCALE:		1/2" = 1' - 0"
	PHONE:	---	FINISH:	---	DRW HANDLE:	---	DATE:		AUG 4, 2017
	EMAIL:	---	SPECIES:	---	TOP:	---	PAGE:		---

Suite 517 Hampton PL x Rock Light (x5)

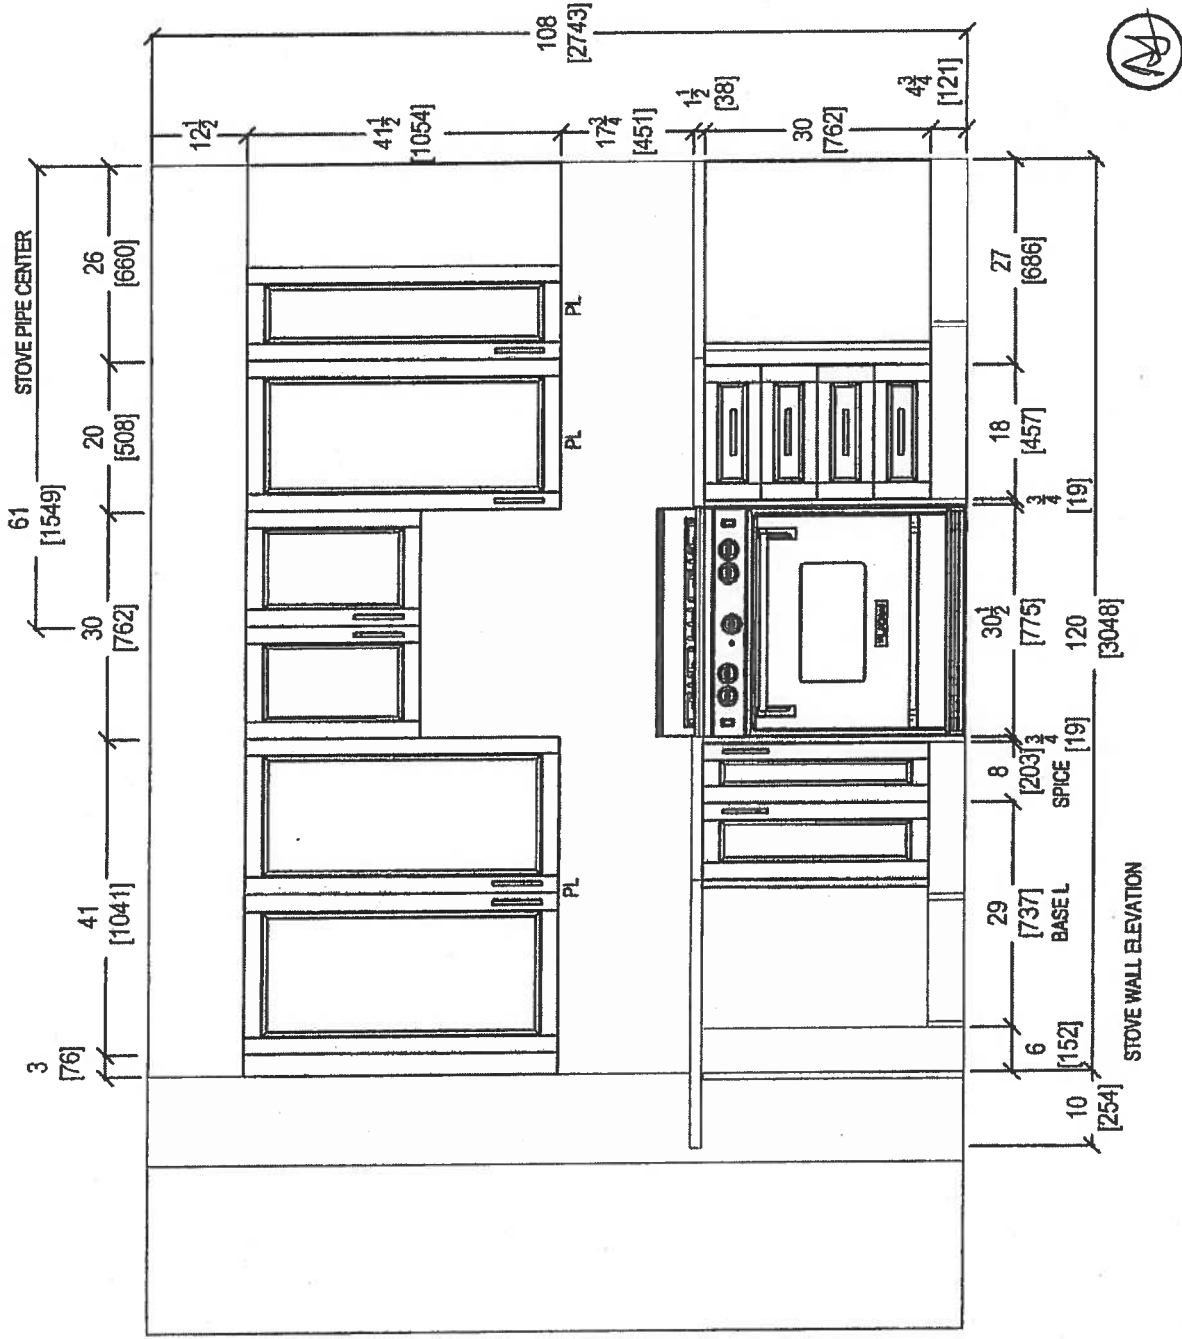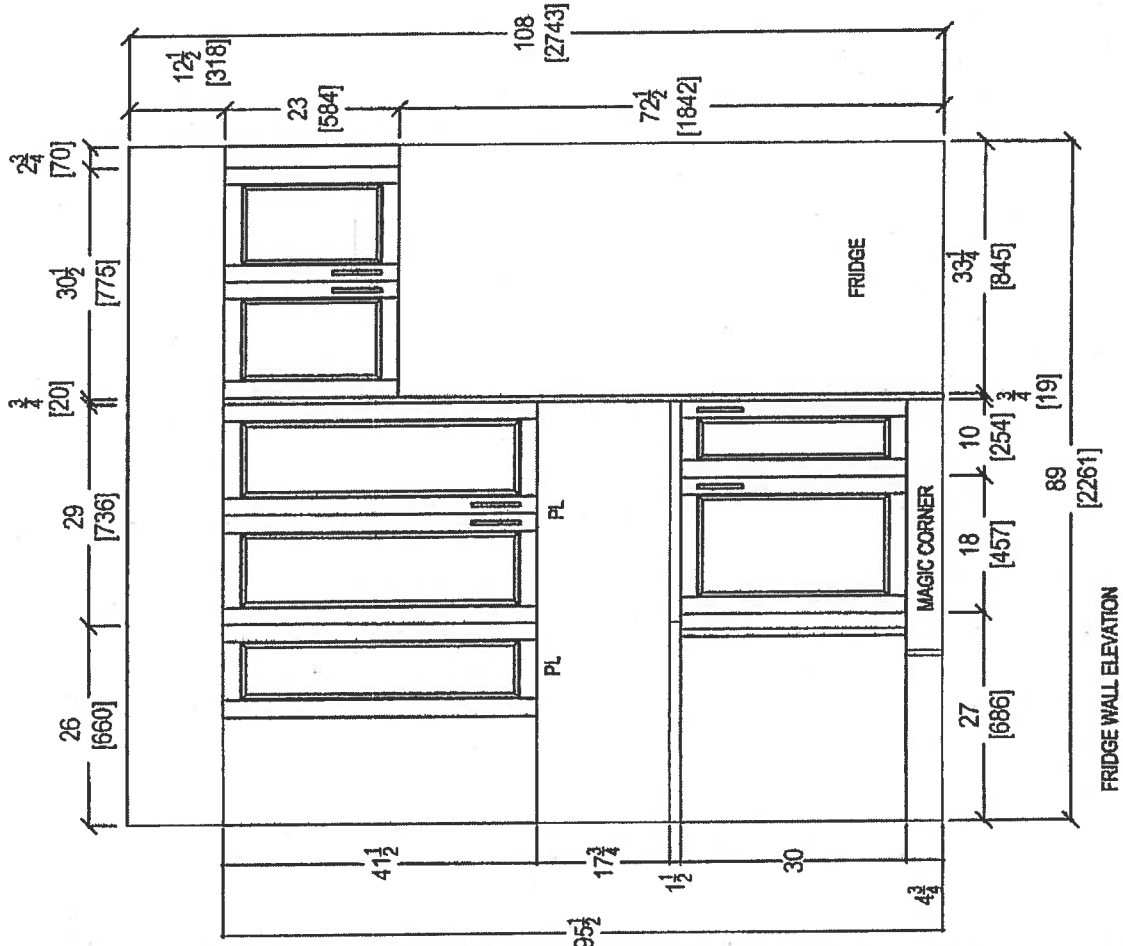


 your kitchen, your taste 80 SANTE DRIVE, VAUGHAN, ON L4K 3C4, T: 416.746.1811 F: 905.761.5901	CLIENT: ROYAL PINE HOMES		REMSENBURG 2D-P UPGRADE PACKAGE	ROOM: KITCHEN	DRAWN BY: SK	COMMENTS: PLEASE NOTE ALL DIMENSIONS ARE NOT FINAL AND ARE SUBJECT TO CHANGE UPON FINAL SITE MEASURE
	SITE: HAMPTON PLACE	DOOR STYLE: —	DOOR HANDLE: —	SCALE: 1/2" = 1' - 0"		
	PHONE: —	FINISH: —	DRW HANDLE: —	DATE: AUG 4, 2017		
	EMAIL: —	SPECIES: —	TOP: —	PAGE: —		

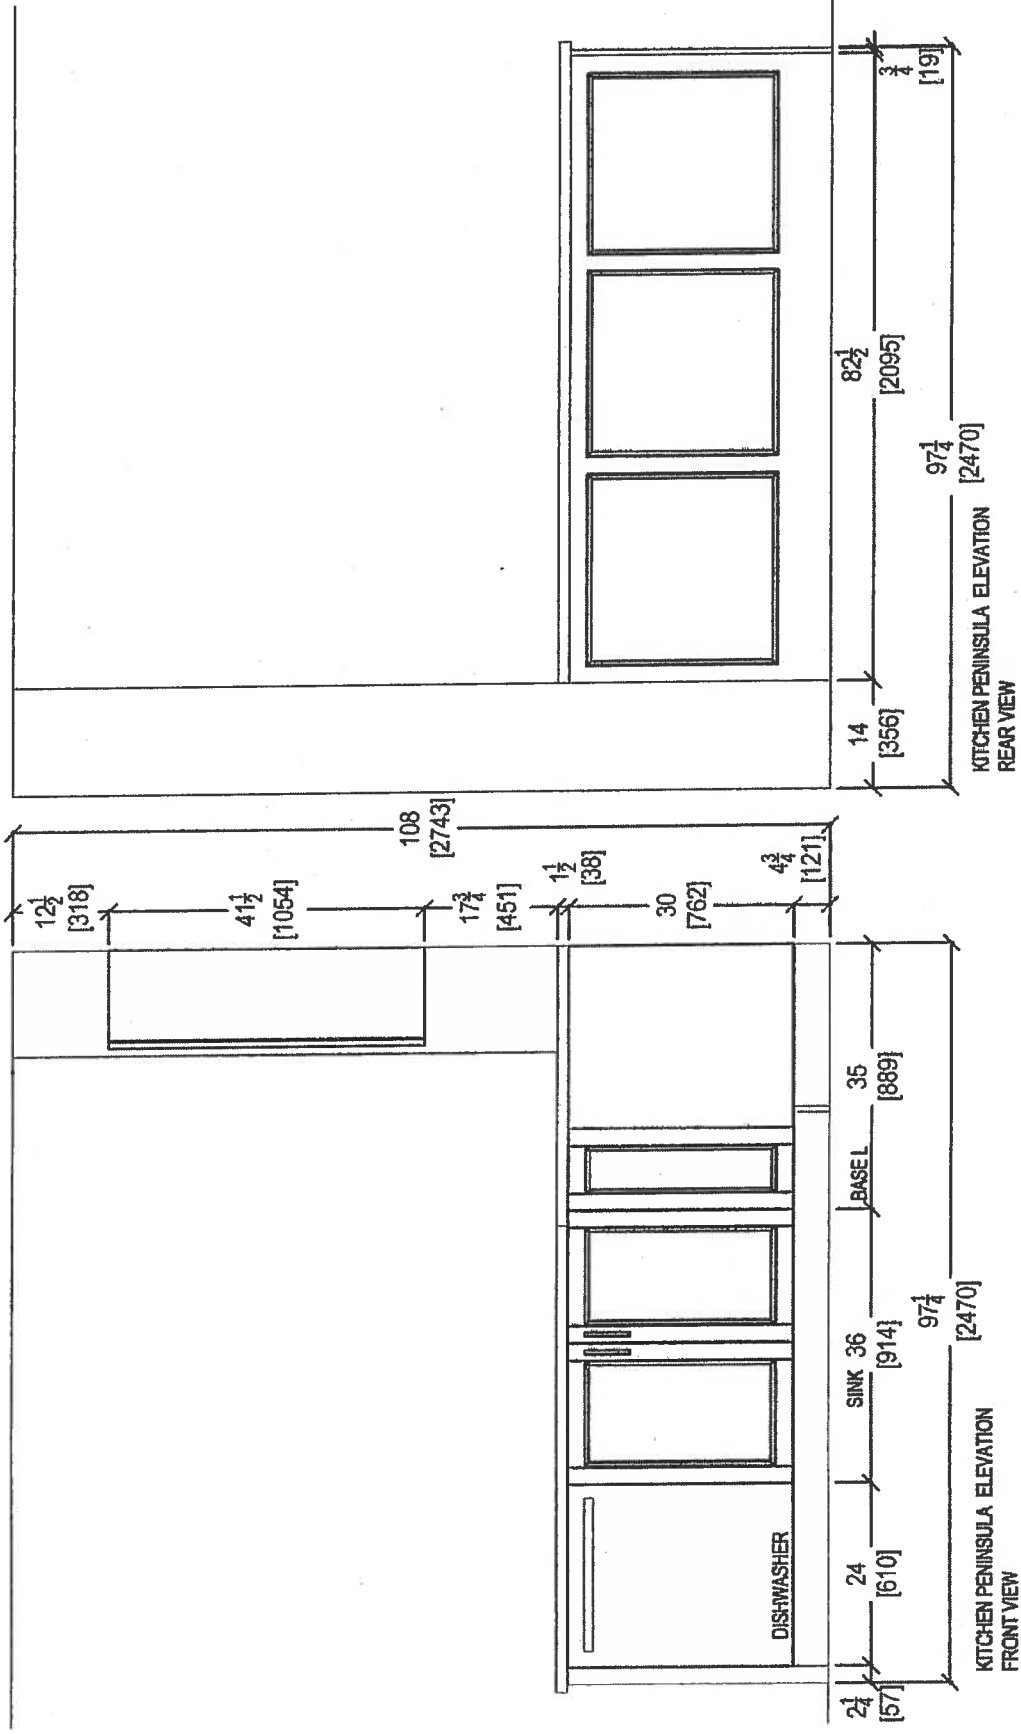

 your kitchen. your base 80 SANTE DRIVE, VAUGHAN, ON L4K 3C4, T: 416.746.1811 F: 905.761.5901	CLIENT: ROYAL PINE HOMES	JOB NAME: 2D-P	ROOM: KITCHEN	DRAWN BY: SK	COMMENTS: PLEASE NOTE ALL DIMENSIONS ARE NOT FINAL AND ARE SUBJECT TO CHANGE UPON FINAL SITE MEASURE
	SITE: HAMPTON PLACE	DOOR STYLE: —	DOOR HANDLE: —	SCALE: 1/2" = 1' - 0"	
	PHONE: —	FINISH: —	DRW HANDLE: —	DATE: AUG 4, 2017	
	EMAIL: —	SPECIES: —	TOP: —	PAGE: —	


SUITE 517 - HAMPTON

* Install 3" Splash *

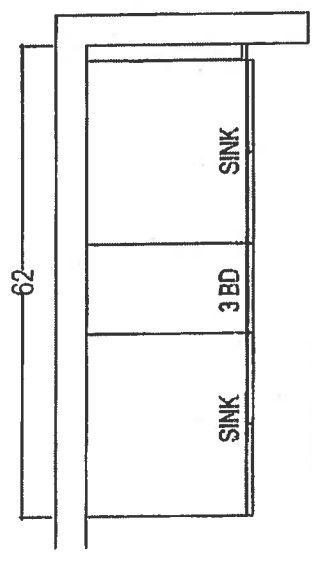



MASTER ENSUITE

* RAISED HEIGHT *

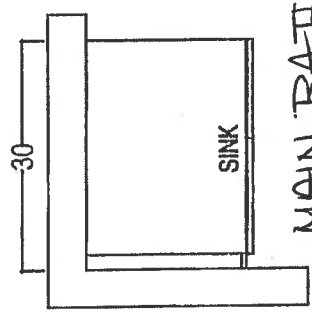

MAIN BATH

* RAISED HEIGHT *

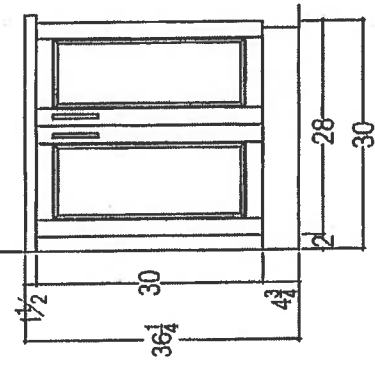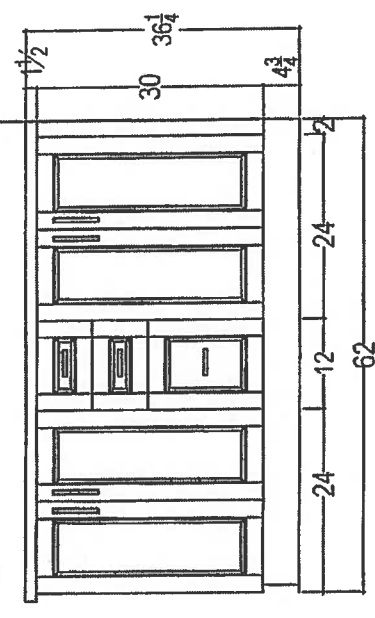

your kitchen. your taste.
80 SANTE DRIVE, VAUGHAN, ON L4K 3C4,
T: 416.746.1811 F: 905.761.5901

CLIENT: ROYAL PINE HOMES SITE: HAMPTON PLACE PHONE: --- EMAIL: ---	REMSBURG 2D-P UPGRADE PACKAGE	ROOM:	VANITIES	DRAWN BY: SK	COMMENTS: PLEASE NOTE ALL DIMENSIONS ARE NOT FINAL AND ARE SUBJECT TO CHANGE UPON FINAL SITE MEASURE
	DOOR STYLE: ---	DOOR HANDLE: ---	SCALE: 1/2" = 1'-0"	SCALE: 1/2" = 1'-0"	
	FINISH: ---	DRW HANDLE: ---	DATE: AUG 4, 2017	DATE: AUG 4, 2017	
	SPECIES: ---	TOP: ---	PAGE: ---	PAGE: ---	

Suite 517
Hampton



WRT318FZDM

Standard



<http://www.whirlpool.com>

30-inch Wide Top-Freezer Refrigerator with
Flexi-Slide™ Bin - 18.2 cu. ft.

Key Features:

- Flexi-Slide™ Bin
- Frameless Glass Shelves
- Electronic Temperature Control
- Clear, Humidity Controlled Crispers

Product Dimensions:

Height: 65 7/8

Width: 29 3/4

Depth: 33 1/2


Additional Information:

[Use And Care Guide](#)

[Dimension Guide](#)

[Energy Guide](#)

[Warranty Certificate](#)

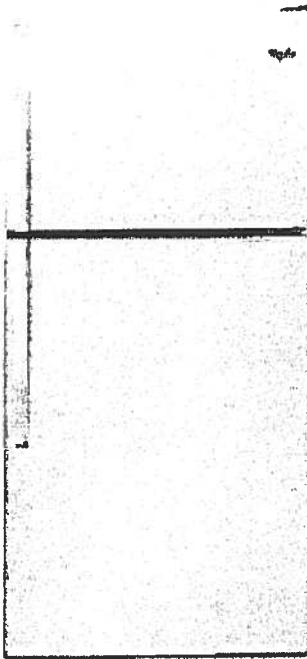

Available in:

- Black
- Monochromatic
Stainless Steel
- White



©Registered trademark/TM Trademark of Whirlpool, U.S.A. © 2013 Whirlpool Corporation. All Rights Reserved
All other trademarks are owned by their respective companies
Because Whirlpool Corporation policy includes a continuous commitment to improve our products, we reserve
the right to change materials and specifications without notice. We also reserve the right to discontinue or
transition products without notice.
Manufacturer's Suggested Retail Price (MSRP) and Minimum Advertised Price (MAP) provided for reference
purposes only. Dealer alone determines advertised and retail prices.
Created On: Monday, March 14, 2016 12:09:07

Suite 517
Hampton

Standard



WEE510S0FS

Whirlpool® 4.8 cu. ft. Guided Electric Front Control Range
With The Easy-Wipe Ceramic Glass Cooktop

MSRP: \$1,149 00

Available Colors	
☒	Black Model: WEE510S0FB MAJOR APPLIANCE
☐	Black-on-Stainless Model: WEE510S0FS MAJOR APPLIANCE
☐	White Model: WEE510S0FW MAJOR APPLIANCE

Dimensions	
Depth	28 15/16 Inches
Width	29 7/8 Inches
Gross Weight	172 LB
Dimensions shown are for planning purposes only. For complete information, see Installation Instructions packed with product.	

Specifications	
Cooktop Features	
Cooktop Element Style	Smoothtop
Cooktop Surface Color	Color Coordinated Black on Stainless
Cooktop Surface Material	Glass
Number of Cooking Element-Burners	4
Left Front Element-Burner Power	3000W
Left Front Element-Burner Size	9"6"
Left Front Element-Burner Type	Dual
Left Rear Element-Burner Power	1200W
Left Rear Element-Burner Size	6"
Left Rear Element-Burner Type	Radiant
Right Front Element-Burner Power	3000W
Right Front Element-Burner Size	9"6"
Right Front Element-Burner Type	Dual
Right Rear Element-Burner Power	1200W
Right Rear Element-Burner Size	6"
Right Rear Element-Burner Type	Radiant
Oven Features	
Number of Oven Lights	1
Hot Surface Indicator Light	Yes
Power On Indicator Light	Yes
Light Type	Incandescent
Oven Rack Type	Standard (Both)
Controls	
Drawer Type	Storage Drawer
Selections	Clock; Timer; Warm Hold; Delay Start; Cook Time Indicator; Control Lock; Automatic Door Latch; Audible Signal; Sabbath Mode; Frozen Bake
ADA Compliant	ADA Height and Operation Compliant
Dimensions	
Depth	28 15/16 Inches
Width	29 7/8 Inches
General	
ADA Compliant	ADA Height and Operation Compliant

Key Features	
Frozen Bake™ Technology	
Guided Cooktop Controls	
FlexHeat™ Dual Radiant Elements	
Adjustable Self-Cleaning	
Easy-Wipe Ceramic Glass Cooktop	
Temperature Sensor	
4.8 Cu. Ft. Capacity	
Keep Warm Option	
Closed Door Broiling	
Delay Cook	
Sabbath Mode	
Star-K Certified	
ADA Compliant	
#1 Selling Appliance Brand in the U.S.A.	

Product Literature	
Warranty(33.12 KB)	
Owners Manual(502.10 KB)	
Installation Instructions(995.40 KB)	
Dimension Guide(124.36 KB)	
You may need to install Adobe Acrobat Reader to view these documents.	

UPC Listing	
Model "WEE510S0FB" UPC: 883049391939	
Model "WEE510S0FS" UPC: 883049391946	
Model "WEE510S0FW" UPC: 883049391922	

Suite 520 Standard Hampton



WMH31017FS

Whirlpool®

<http://www.whirlpool.com>

3.0 cu. ft. Microwave Hood Combination with
Electronic Controls

Key Features:

- Microwave Presets
- Electronic Touch Controls
- Dishwasher-Safe Turntable Plate
- 2-Speed, 300 CFM Vent Fan
- Add 30 Seconds Option
- Adjustable Cooktop Lighting
- #1 Selling Appliance Brand in the U.S.A.

Product Dimensions:

Height: 17 1/4

Width: 29 15/16

Depth: 17 7/8


Additional Information:

[Use And Care Guide](#)

[Dimension Guide](#)

[Installation Guide](#)

[Warranty Certificate](#)

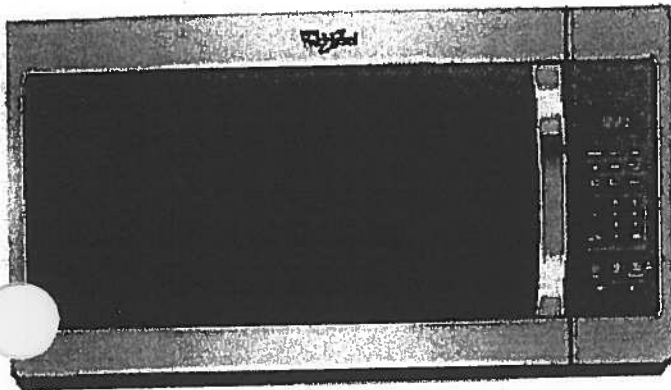

Available in:

- Black
- Silver
- Stainless Steel
- White

©Registered trademark/TM Trademark of Whirlpool, U.S.A. © 2016 Whirlpool Corporation. All Rights Reserved.
All other trademarks are owned by their respective companies.
Because Whirlpool Corporation policy includes a continuous commitment to improve our products, we reserve
the right to change materials and specifications without notice. We also reserve the right to discontinue or
transition products without notice.
Manufacturer's Suggested Retail Price (MSRP) and Minimum Advertised Price (MAP) provided for reference
purposes only. Dealer alone determines advertised and retail prices.
Created On: Tuesday, February 07, 2017 12:20:03

Suite 520 Standard
Hampton




WDF330PAHS

Whirlpool®

Heavy-Duty Dishwasher with 1-hour Wash Cycle

<http://www.whirlpool.com>

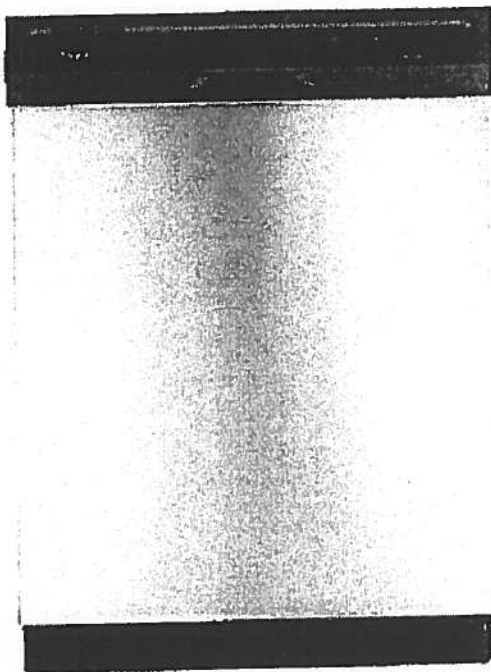

Key Features:

- 1-Hour Wash Cycle
- No One Has Fewer Repairs 20 Years in a Row
- Soil Sensor
- Normal Cycle
- Heavy Cycle
- High Temperature Wash Option
- Heated Dry Option
- Designed, Engineered and Assembled in the U.S.A. with American Pride

Product Dimensions:

Height: 34 1/2

Width: 23 7/8

Depth: 24 1/2

Additional Information:

[Use And Care Guide](#)

[Dimension Guide](#)

[Installation Guide](#)

[Energy Guide](#)

[Warranty Certificate](#)

INVESTED
IN
AMERICA



©Registered trademark/TM Trademark of Whirlpool, U.S.A. © 2016 Whirlpool Corporation. All Rights Reserved.
All other trademarks are owned by their respective companies.
Because Whirlpool Corporation policy includes a continuous commitment to improve our products, we reserve the right to change materials and specifications without notice. We also reserve the right to discontinue or transition products without notice.
Manufacturer's Suggested Retail Price (MSRP) and Minimum Advertised Price (MAP) provided for reference purposes only. Dealer alone determines advertised and retail prices.
Created On: Wednesday, April 19, 2017 10:48:05

Suite 520 Standard
Hampton


(Handwritten initials)

WET4027EW



<http://www.whirlpool.com>

Combination Washer/Electric Dryer

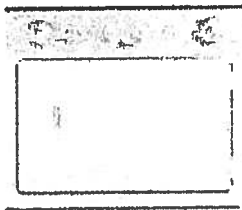

Key Features:

- HE Agitator with Fabric Softener Cap
- White Porcelain Basket
- AutoDry™ Drying System
- 3 Drying Temperatures
- 2.5 Cu. Ft. Washer Capacity
- 5.9 Cu. Ft. Dryer Capacity
- Fabric Softener Dispenser
- Bleach Dispenser

Product Dimensions:

Height: 71 3/4

Width: 27 1/2

Depth: 32

Electrical Requirements:

30.

Additional Information:

[Use And Care Guide](#)

[Dimension Guide](#)

[Installation Guide](#)

[Energy Guide](#)

[Warranty Certificate](#)

Available in:

☐ White

INVESTED
IN
AMERICA





©Registered trademark/TM Trademark of Whirlpool, U.S.A. © 2013 Whirlpool Corporation. All Rights Reserved.
All other trademarks are owned by their respective companies.
Because Whirlpool Corporation policy includes a continuous commitment to improve our products, we reserve the right to change materials and specifications without notice. We also reserve the right to discontinue or transition products without notice.
Manufacturer's Suggested Retail Price (MSRP) and Minimum Advertised Price (MAP) provided for reference purposes only. Dealer alone determines advertised and retail prices.
Created On: Friday, March 11 2016 12:26:17




Suite 520
Hampton

UPGRADE OPTION 2
PACKAGE

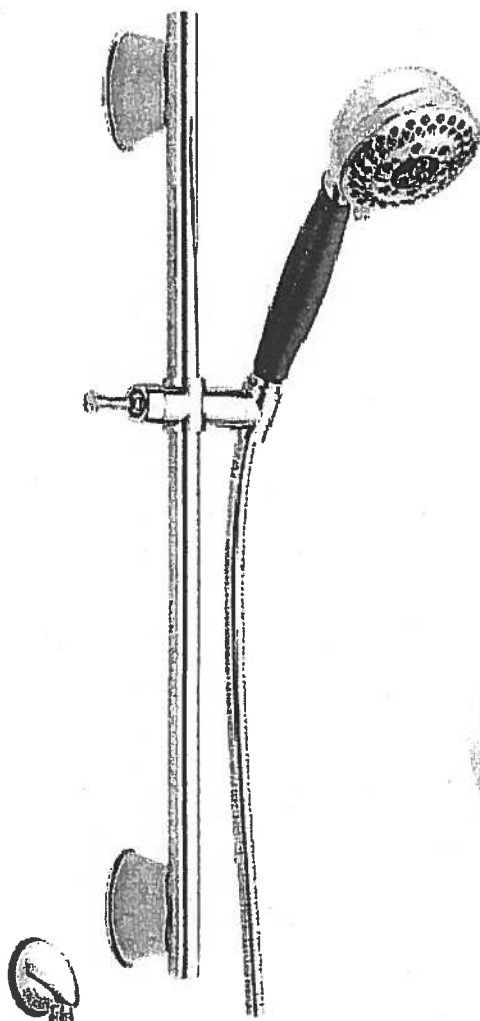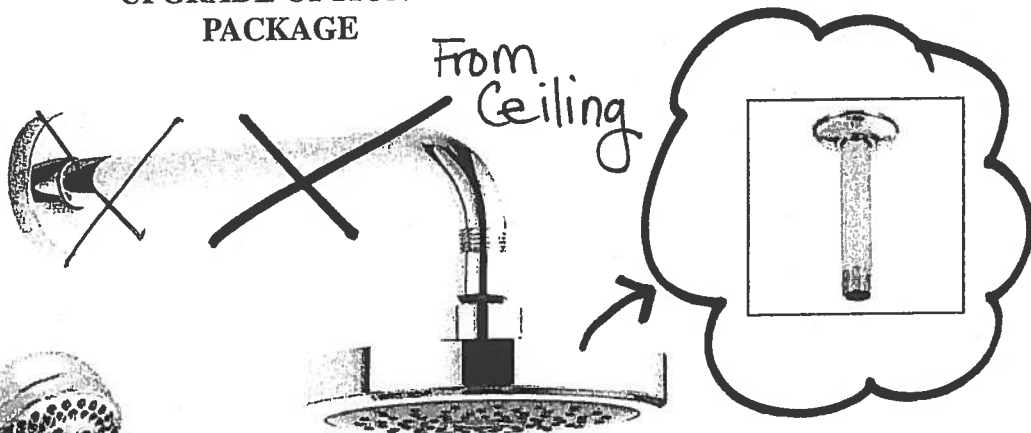

Master Ensuite
Shower Stall

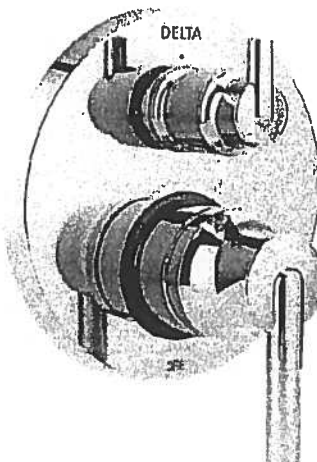

**Delta Contemporary Round 14 Series Pressure Balance Kit
Integrated Diverter Valve**

Includes both ceiling mount & wall mount shower arm

Model DF-KIT18

Centon Sales Corp. 400 Matheeson Blvd. Unit # 30, Mississauga, Ont. L4Z 1N8 Tel: 905-629-7072 Fax: 905-629-2131


Upgrade Kitchen Sinks




BLANCO

Suite 520
Hampton

Kitchen

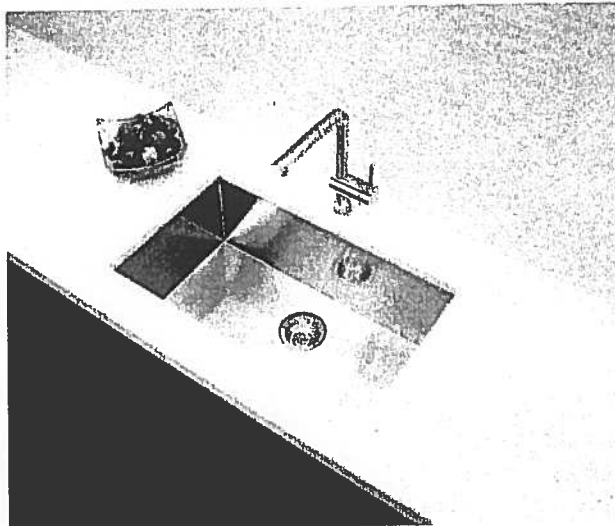

**Blanco Quatrus U Super Single
Undermount Sink
#401248**

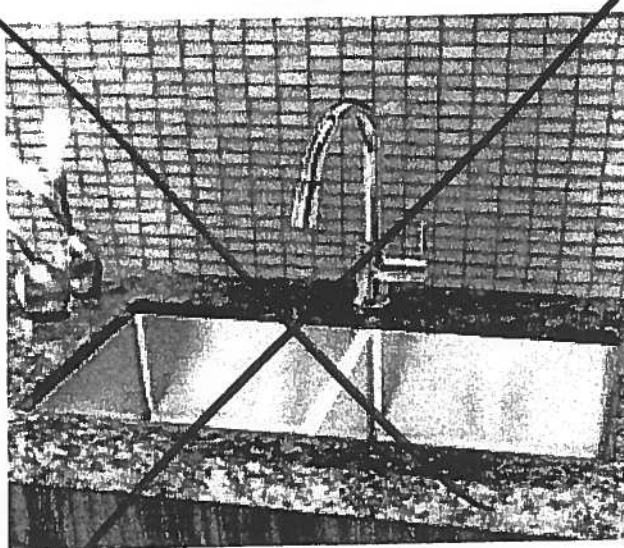

**Blanco Quatrus R15 Two Bowl
Undermount Sink
#401519**

Centon Sales Corp. 400 Matheson Blvd. Unit # 30, Mississauga, Ont L4Z 1N8 Tel: 905-629-7072 Fax: 905-629-2131

✓

Suite 520 Hampton

Main Bath Master Ensuite

CALI®

4.8Lpf / 1.28Gpf 1PC 16⁷/₈" HIGH ELONGATED

- ☐ 4710BOV Lined Tank
☐ 4710BOVU Unlined Tank

Product Specs:

- High efficiency toilet
- 4.8Lpf/1.28Gpf
- Elongated bowl with concealed skirted trapway
- Vitreous china
- 16⁷/₈" Plus Height bowl
- Soft white tank lever
- 12" (305mm) Rough-in
- 2" Fully glazed ball pass trapway
- 3" Flapper
- Siphon jet flush action
- Water surface (240mm x 170mm) 9¹/₂" x 6¹/₂"
- Decorative chrome and soft white side caps included
- Smooth close toilet seat included

Overall Dimensions:

392mm (W) x 725mm (D) x 760mm (H)
15¹/₂" (W) x 28¹/₂" (D) x 29³/₄" (H)


Compliance Certifications:

Meets or exceeds the following:

- IAPMO cUPC
- US EPA WaterSense
- ASME A 12.19.2 / CSA B45.1-2013
- ADA Guidelines & ANSI A117.1
- MaP Tested 1000g
- LEED Compliant


Shipping:

Cube 9.39
GW 92.50lbs

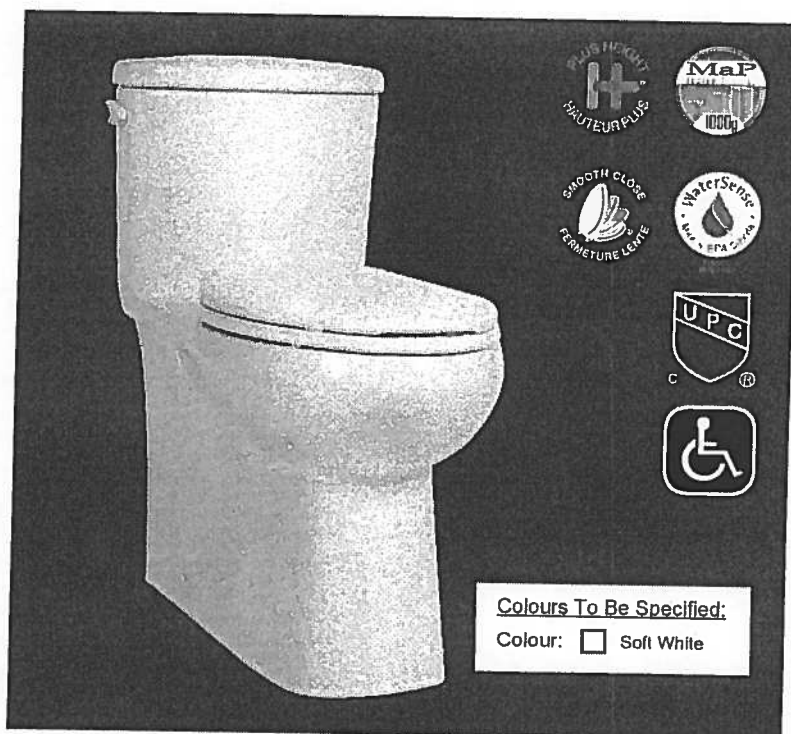

Notes:

This toilet is designed to rough-in at a minimum dimension of 305mm (12") from finished wall to C/L of outlet. Supply line not included with fixture and must be ordered separately.
Important: Dimensions of fixtures are nominal and may vary within the range of tolerances established by ASME standard A112.19.2. These measurements are subject to change or cancellation. No responsibility is assumed for use of superseded or voided pages.
Products are designed to comply ADA/ANSI A117.1 Standard. It shall be the responsibility of the installer to comply with the local disability codes and standards prior to installing the product.

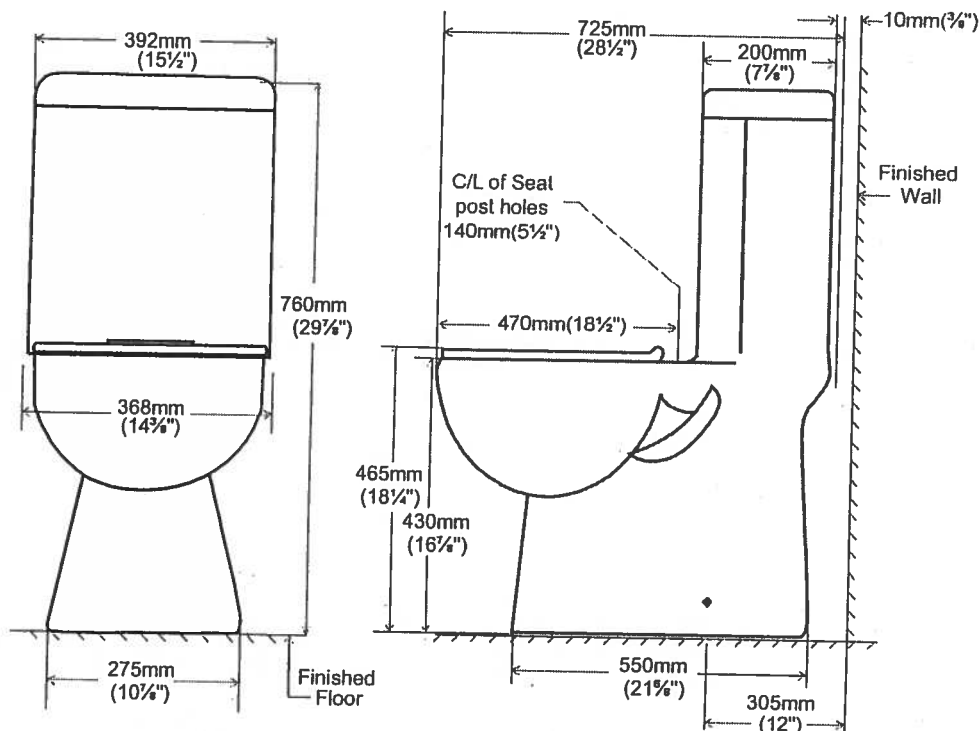

contrac®

5970 Chedworth Way, Unit A, Mississauga, ON, Canada L5R 3V5
www.contrac.ca


Revised: January 2016




UPGRADE OPTION 2
PACKAGE

Suite 520
Hampton

Master Ensuite
(x2)

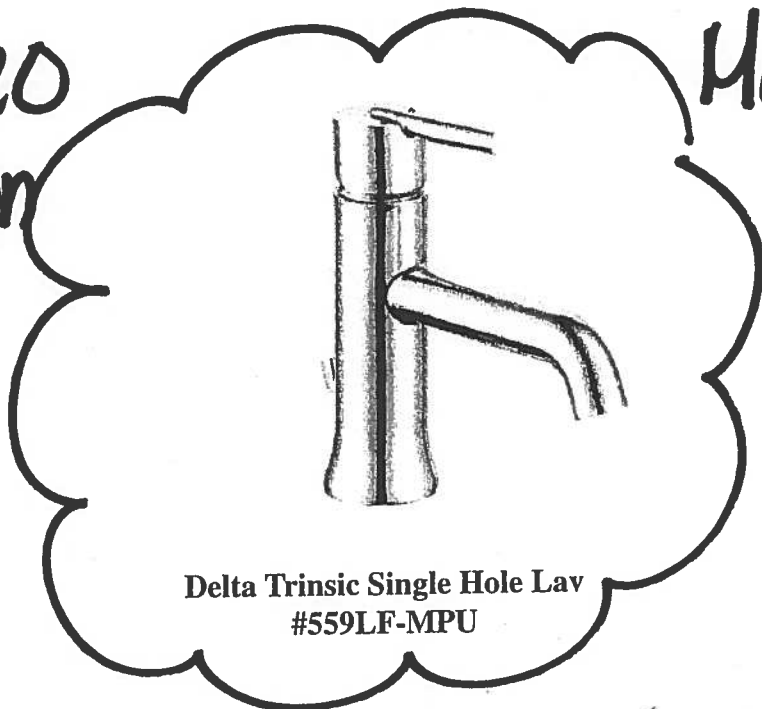


Delta Trinsic Single Hole Lav
#559LF-MPU

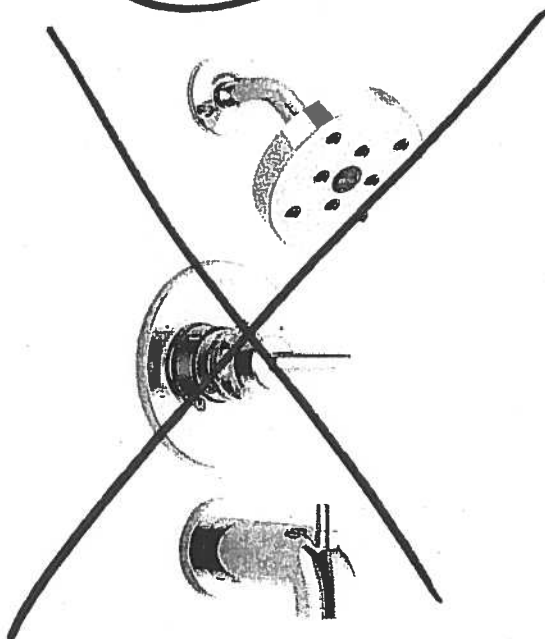

Delta Trinsic PB Tub and Shower
#R10000/T14459


Countertop Edges
Suite 520
Hampton

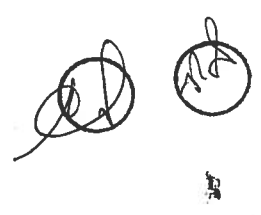


CONNOLLY Marble & Granite Ltd.

EDGE
DETAILS


004

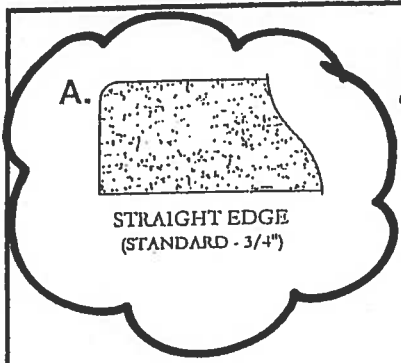

Standard
Kitchen
Main Bath
Master Ensuite

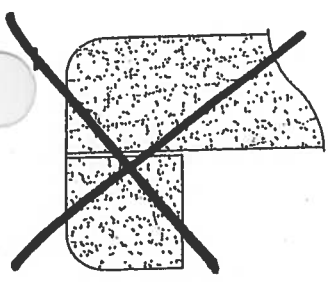

DOUBLE TOP "D" EDGE
(STANDARD - 1 1/2")

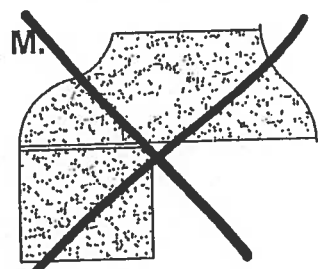

OGEE - SQUARE EDGE
(MED./HIGH - 1 1/2")

EDGING UP-GRADE OPTIONS