

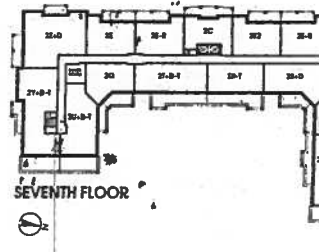


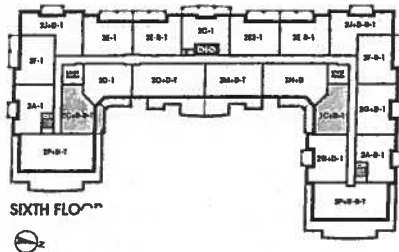

Sag Harbor

878 SQ FT *plus 119 sq. ft. of balcony area*

SUITE 518
INVENTORY SUITE
ORIGINAL SUITE
LAYOUT

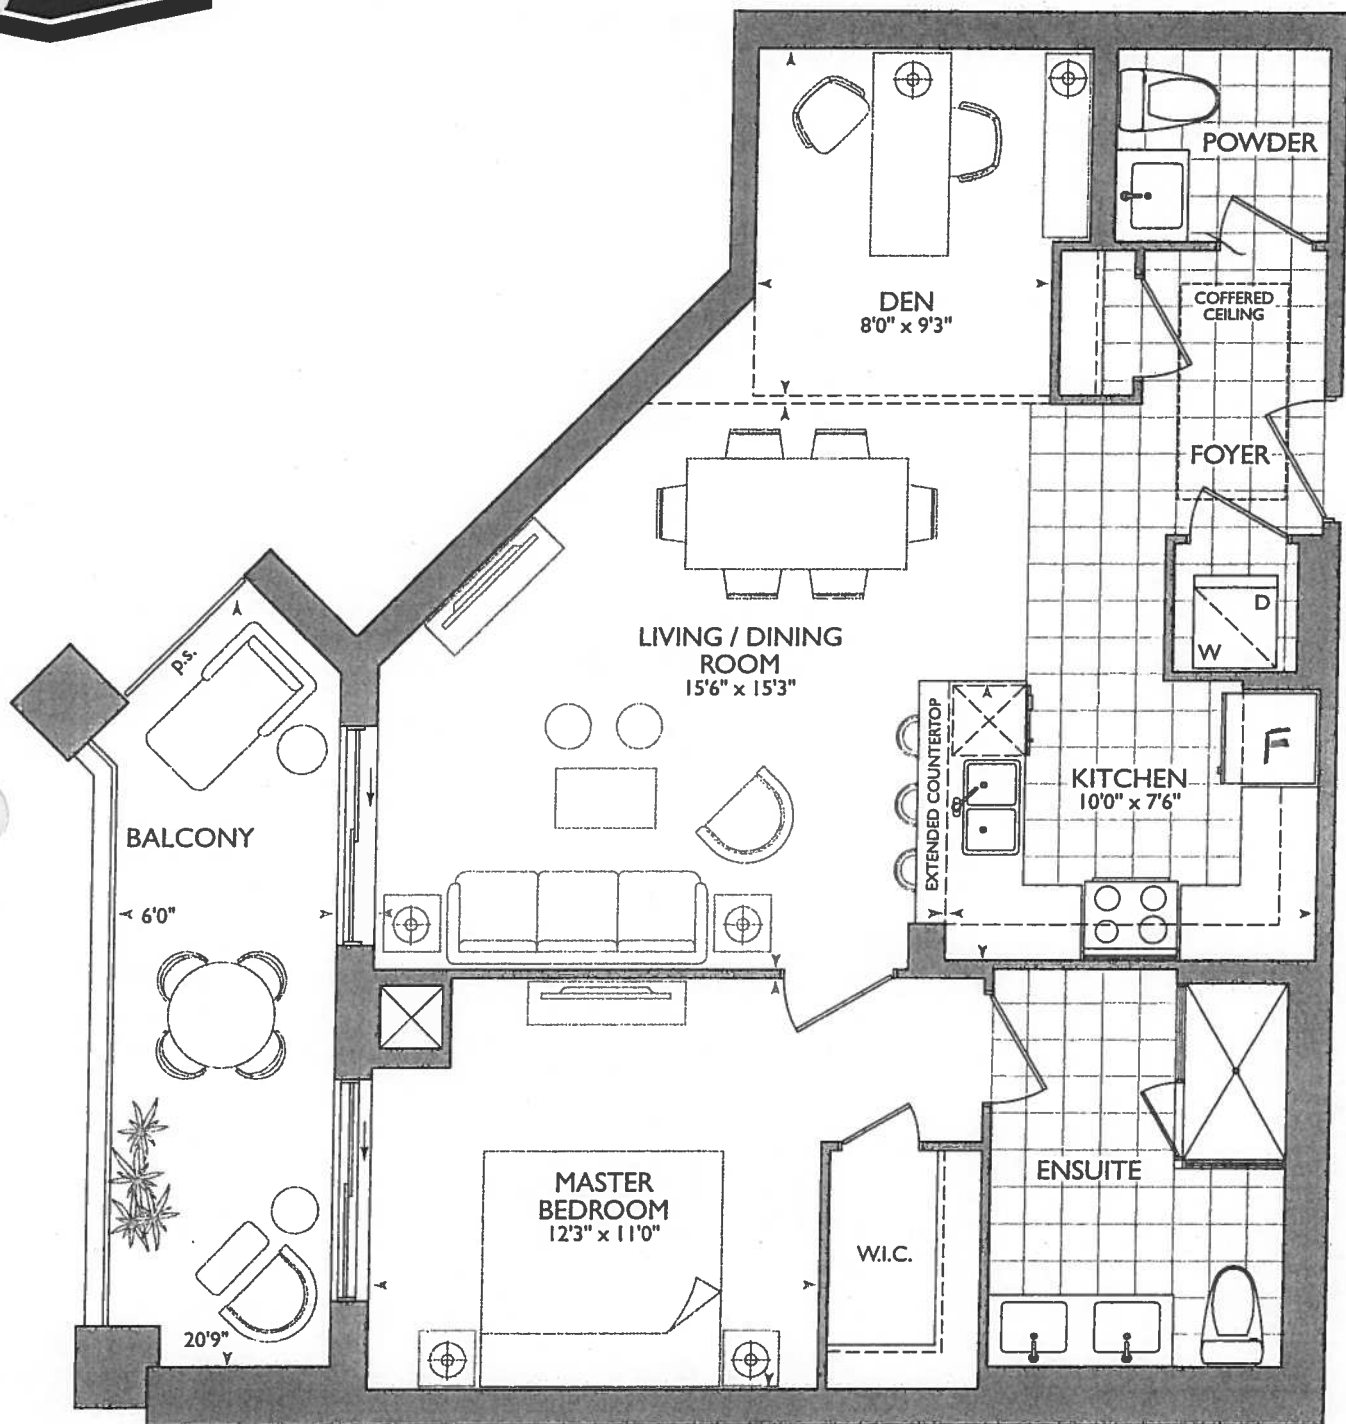

SUITE 518 - INVENT SUITE

* SHIFT FRONT ENTRY DOOR
TOWARDS POWDER ROOM DUE
TO 6" WALL BEHIND WASH/DRYER


KITCHEN

- STD KITCHEN W/ STD APPLIANCE PKG.
- (x1) = PLUG PENINSULA
- (x2) = CAPPED PENDANT LIGHTS
OVER PENINSULA
- (x3) = PUCK LIGHTS.
- 66" STOVE PIPE CENTER
- 117" SINK PIPE CENTER


OR

OPTIONAL

- 1ST UPGRADE KITCHEN LAYOUT
- 1ST UPGRADE APPLIANCE PKG
- SEE UPGRADE KITCHEN
LAYOUT FOR ALL EXTRAS

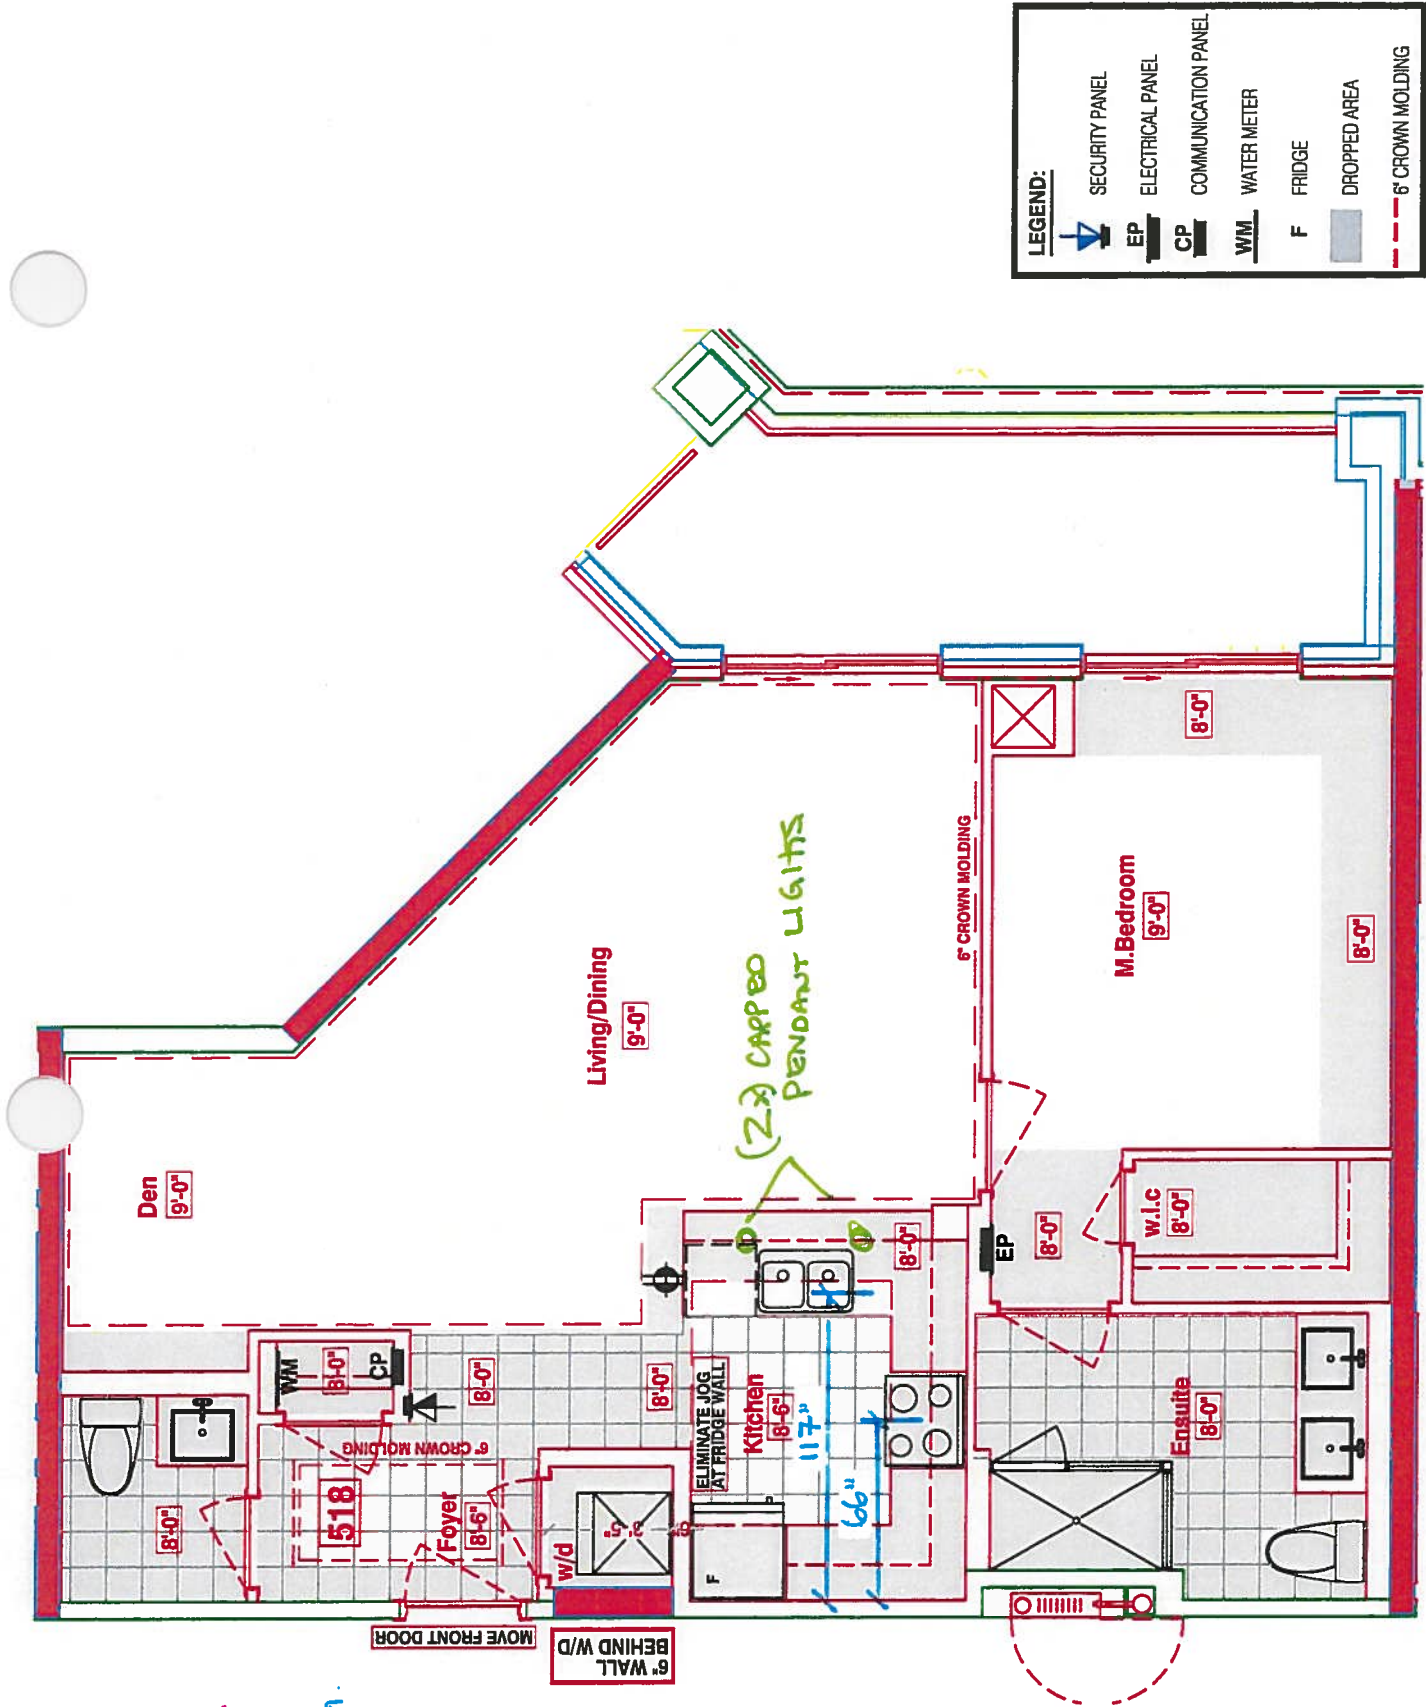


- 518- INVENTORY SUMME
- STD KITCHEN LAYOUT
 - STD APPLIANCE PKGS.
 - (x1) - PLUG PENINSULA
 - (x2) - CARPES PENDANT LIGHTS
 - (x3) - RUCK LIGHTS

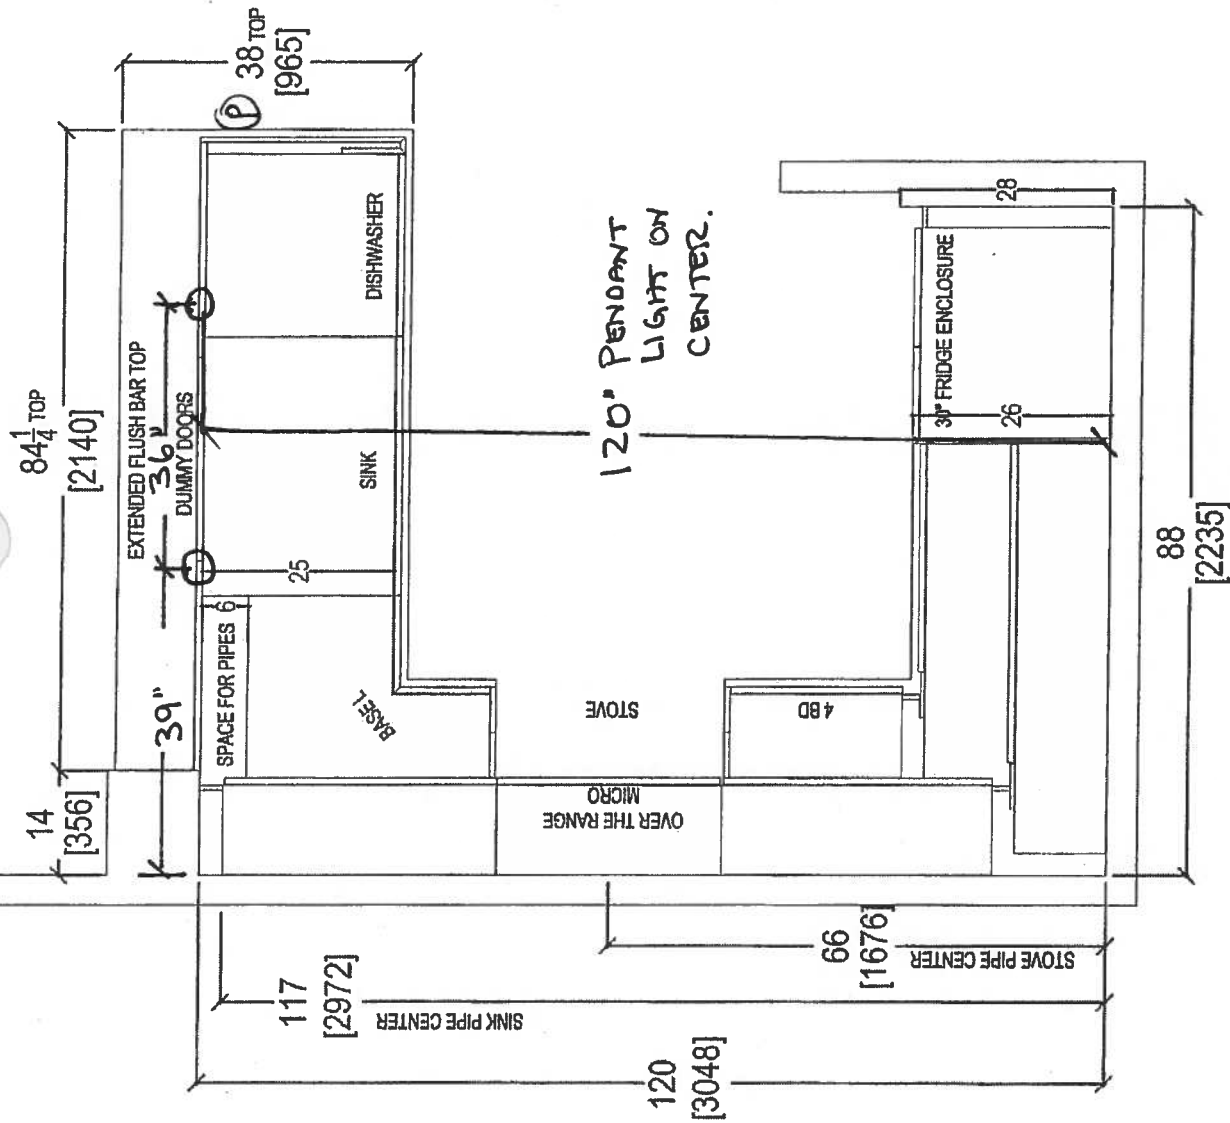




RECEIVED
NOV 6 17

 your kitchen. your life. 80 SANTE DRIVE, VAUGHAN, ON L4K 3C4. T: 416.746.1811 F: 905.761.5901	CLIENT: ROYAL PINE HOMES		1C+D SAG HARBOR		ROOM: KITCHEN FLOOR PLAN		DRAWN BY: SK		COMMENTS: PLEASE NOTE ALL DIMENSIONS ARE NOT FINAL AND ARE SUBJECT TO CHANGE UPON FINAL SITE MEASURE
	SITE: HAMPTON PLACE		DOOR STYLE: —		DOOR HANDLE: —		SCALE: 1/2" = 1' - 0"		
	PHONE: —		FINISH: —		DRW HANDLE: —		DATE: AUG 4, 2017		
	EMAIL: —		SPECIES: —		TOP: —		PAGE: —		

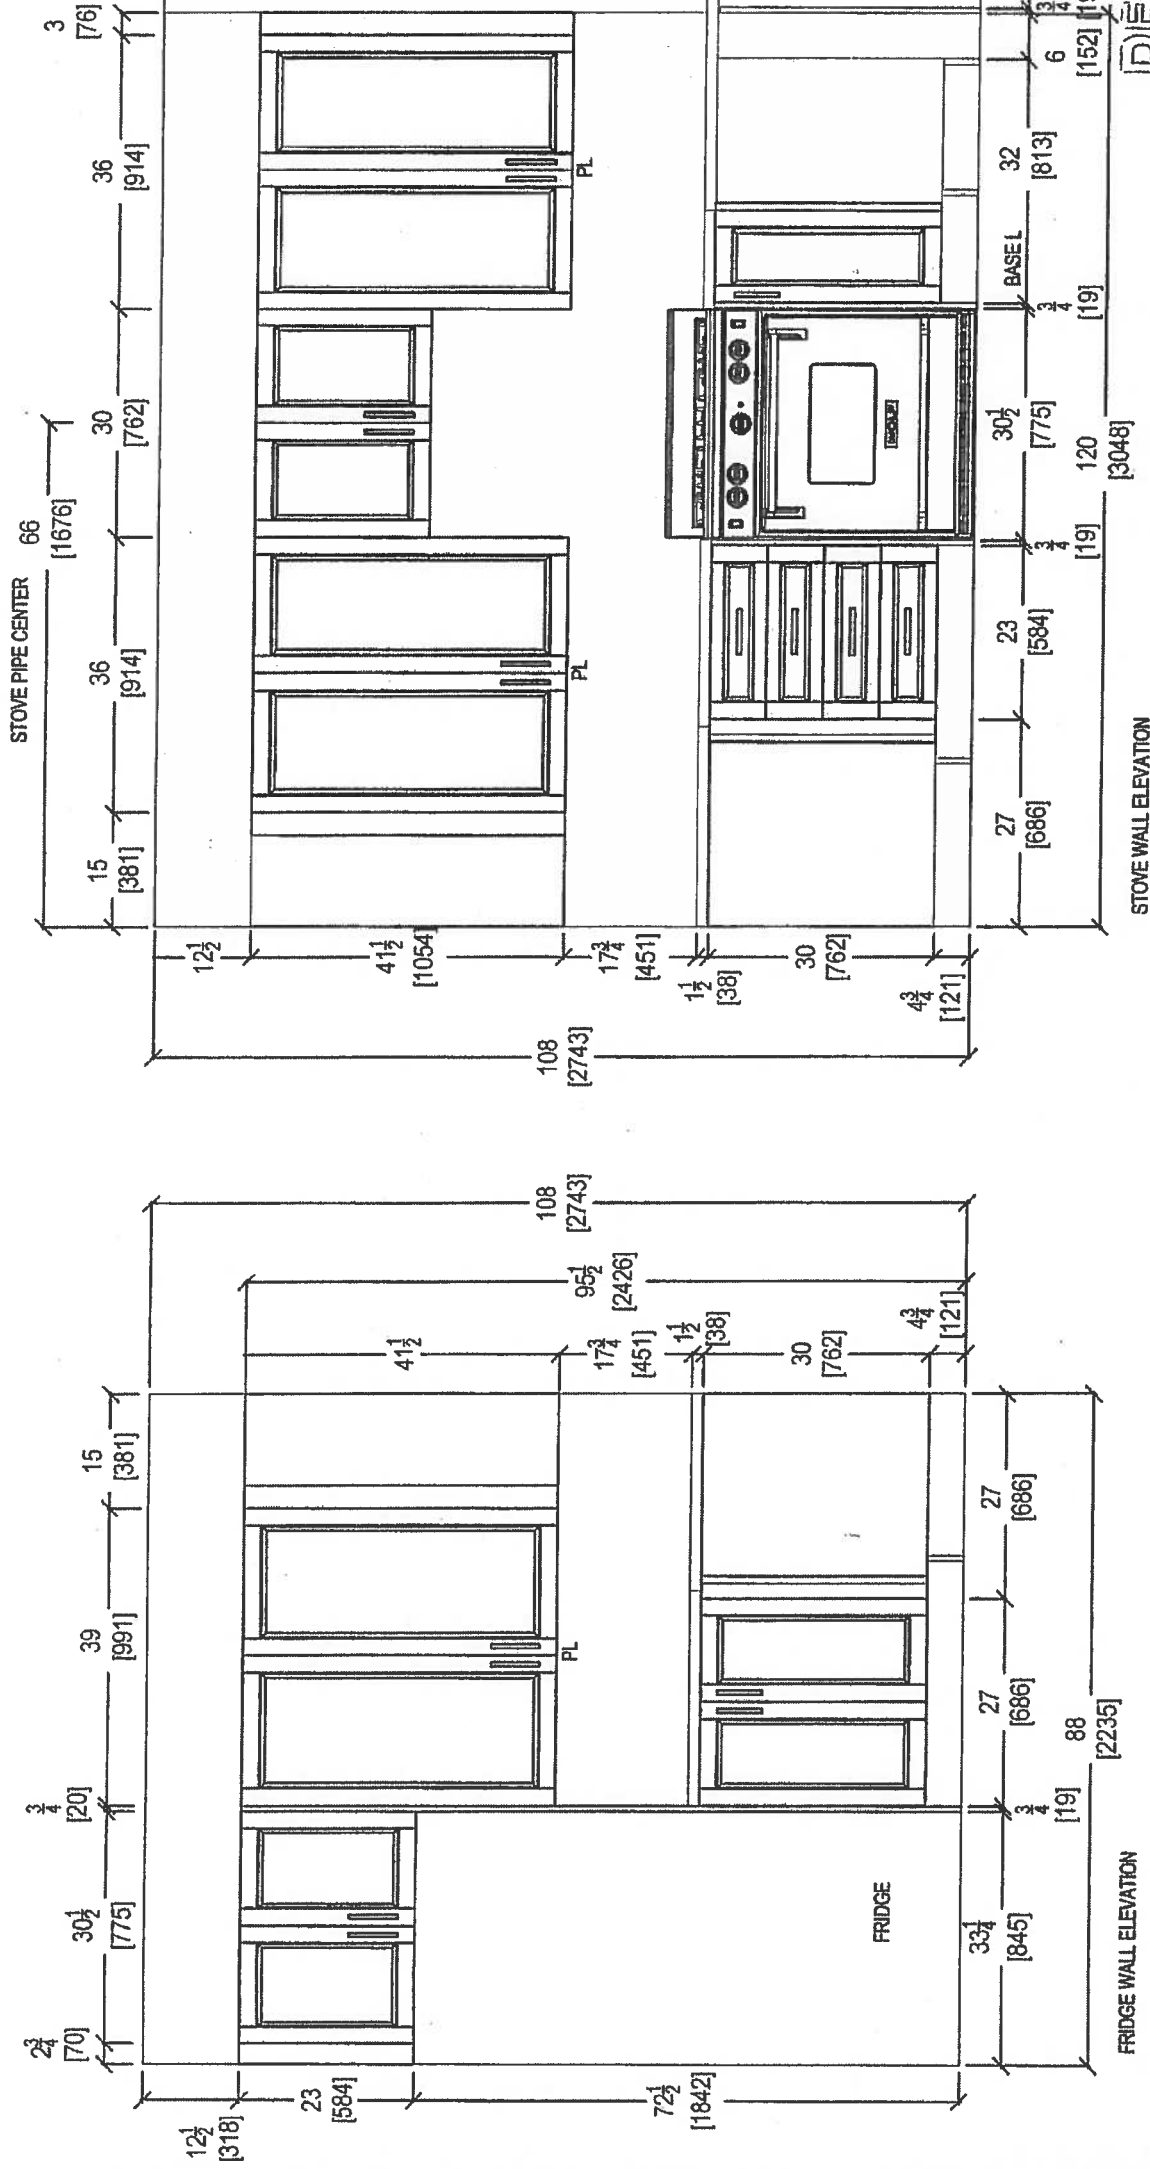

RECEIVED
2017

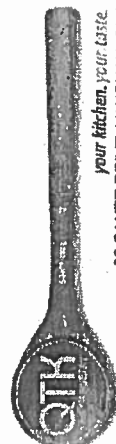 your kitchen, your life. 80 SANTE DRIVE, VAUGHAN, ON L4K 3C4, T. 416.746.1811 F.905.761.5901	CLIENT: ROYAL PINE HOMES		1C+D SAG HARBOR		ROOM: KITCHEN	DRAWN BY: SK		COMMENTS: PLEASE NOTE ALL DIMENSIONS ARE NOT FINAL AND ARE SUBJECT TO CHANGE UPON FINAL SITE MEASURE
	SITE: HAMPTON PLACE		DOOR STYLE: —		DOOR HANDLE: —		SCALE: 1/2" = 1' - 0"	
	PHONE: —		FINISH: —		DRW HANDLE: —		DATE: AUG 4, 2017	
	EMAIL: —		SPECIES: —		TOP: —		PAGE: —	

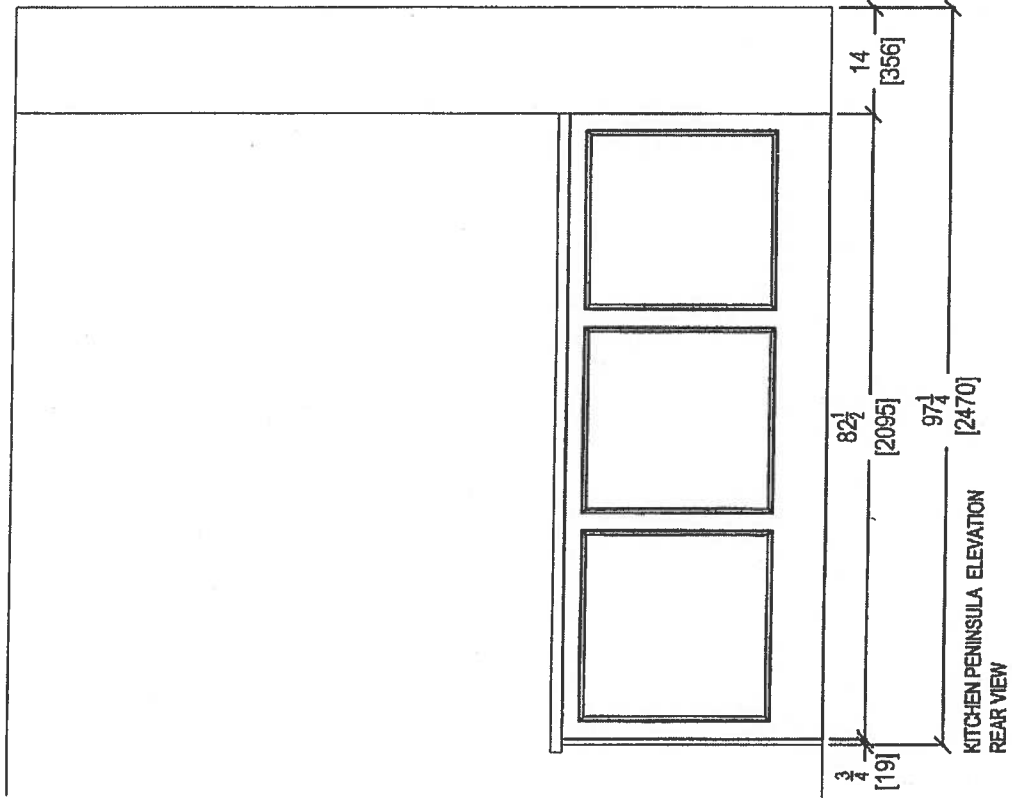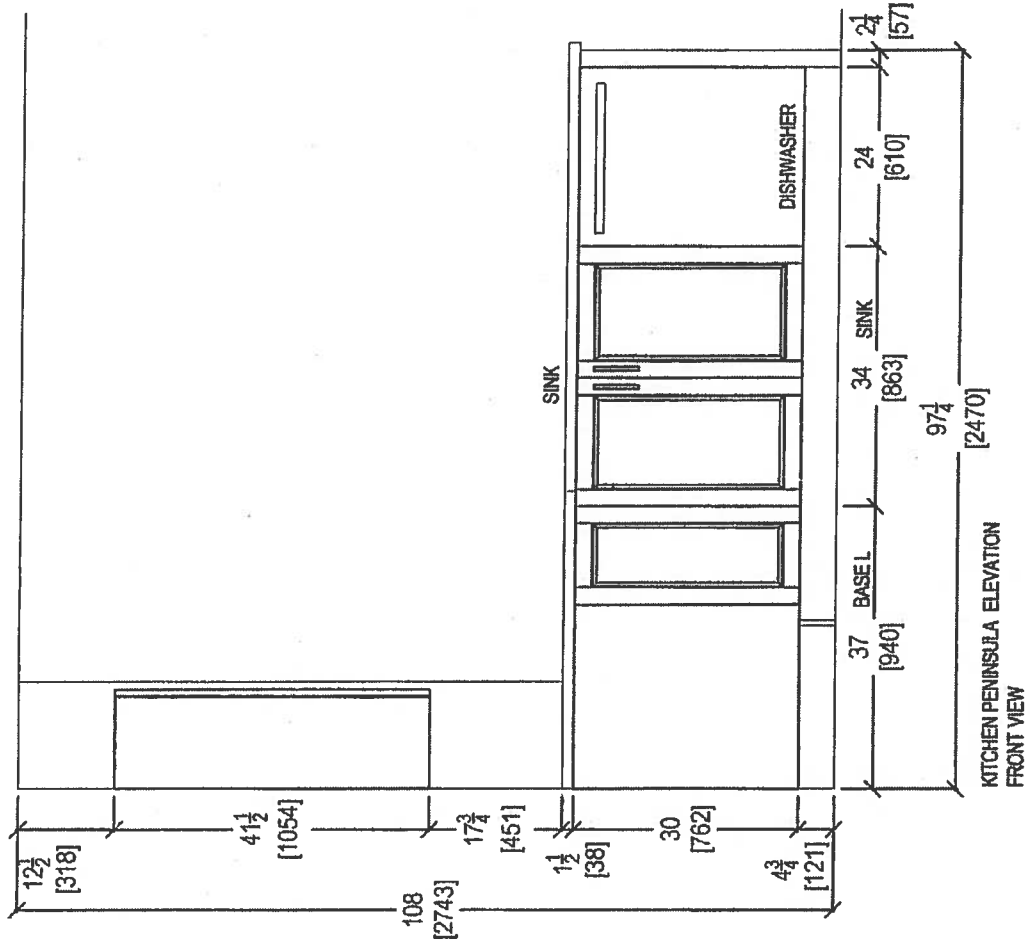

80 SANTE DRIVE, VAUGHAN, ON L4K 3C4.
T: 416.746.1811 F: 905.761.5901





CLIENT: ROYAL PINE HOMES	1C+D SAG HARBOR
SITE: HAMPTON PLACE	DOOR STYLE: —
PHONE: —	FINISH: —
EMAIL: —	SPECIES: —

ROOM: KITCHEN	DRAWN BY: SK
DOOR HANDLE: —	SCALE: 1/2" = 1' - 0"
DRY HANDLE: —	DATE: AUG 4, 2017
TOP: —	PAGE: —

COMMENTS:


RECEIVED

NOV 6 17

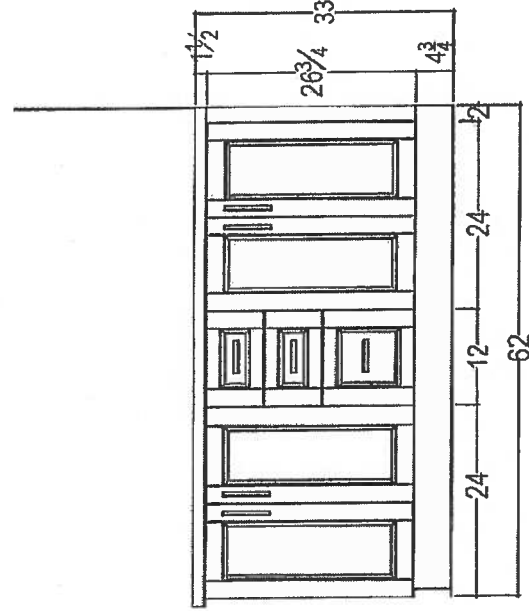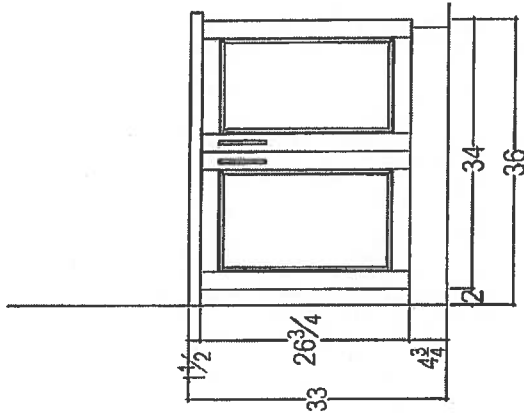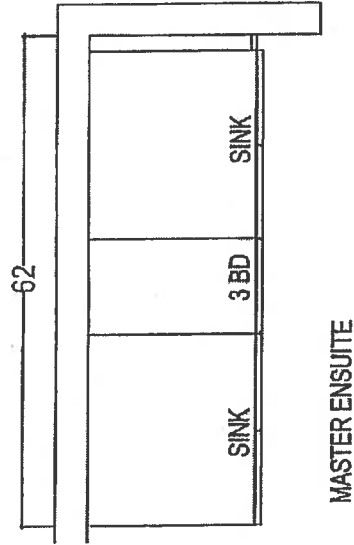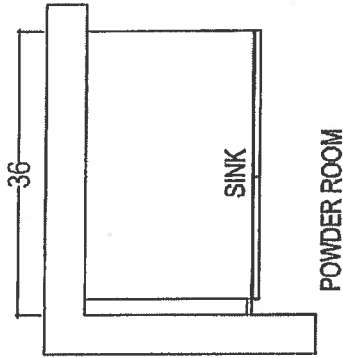


RECEIVED
12-28-18


 your kitchen. your life. 80 SANTE DRIVE, VAUGHAN, ON L4K 3C4, T: 416.746.1811 F: 905.761.5901	CLIENT: ROYAL PINE HOMES		1C+D SAG HARBOR		ROOM:	DRAWN BY: SK		COMMENTS: PLEASE NOTE ALL DIMENSIONS ARE NOT FINAL AND ARE SUBJECT TO CHANGE UPON FINAL SITE MEASURE
	SITE:	HAMPTON PLACE	DOOR STYLE:	—	DOOR HANDLE:	—	SCALE:	1/2" = 1' - 0"
	PHONE:	—	FINISH:	—	DRW HANDLE:	—	DATE:	AUG 4, 2017
	EMAIL:	—	SPECIES:	—	TOP:	—	PAGE:	—

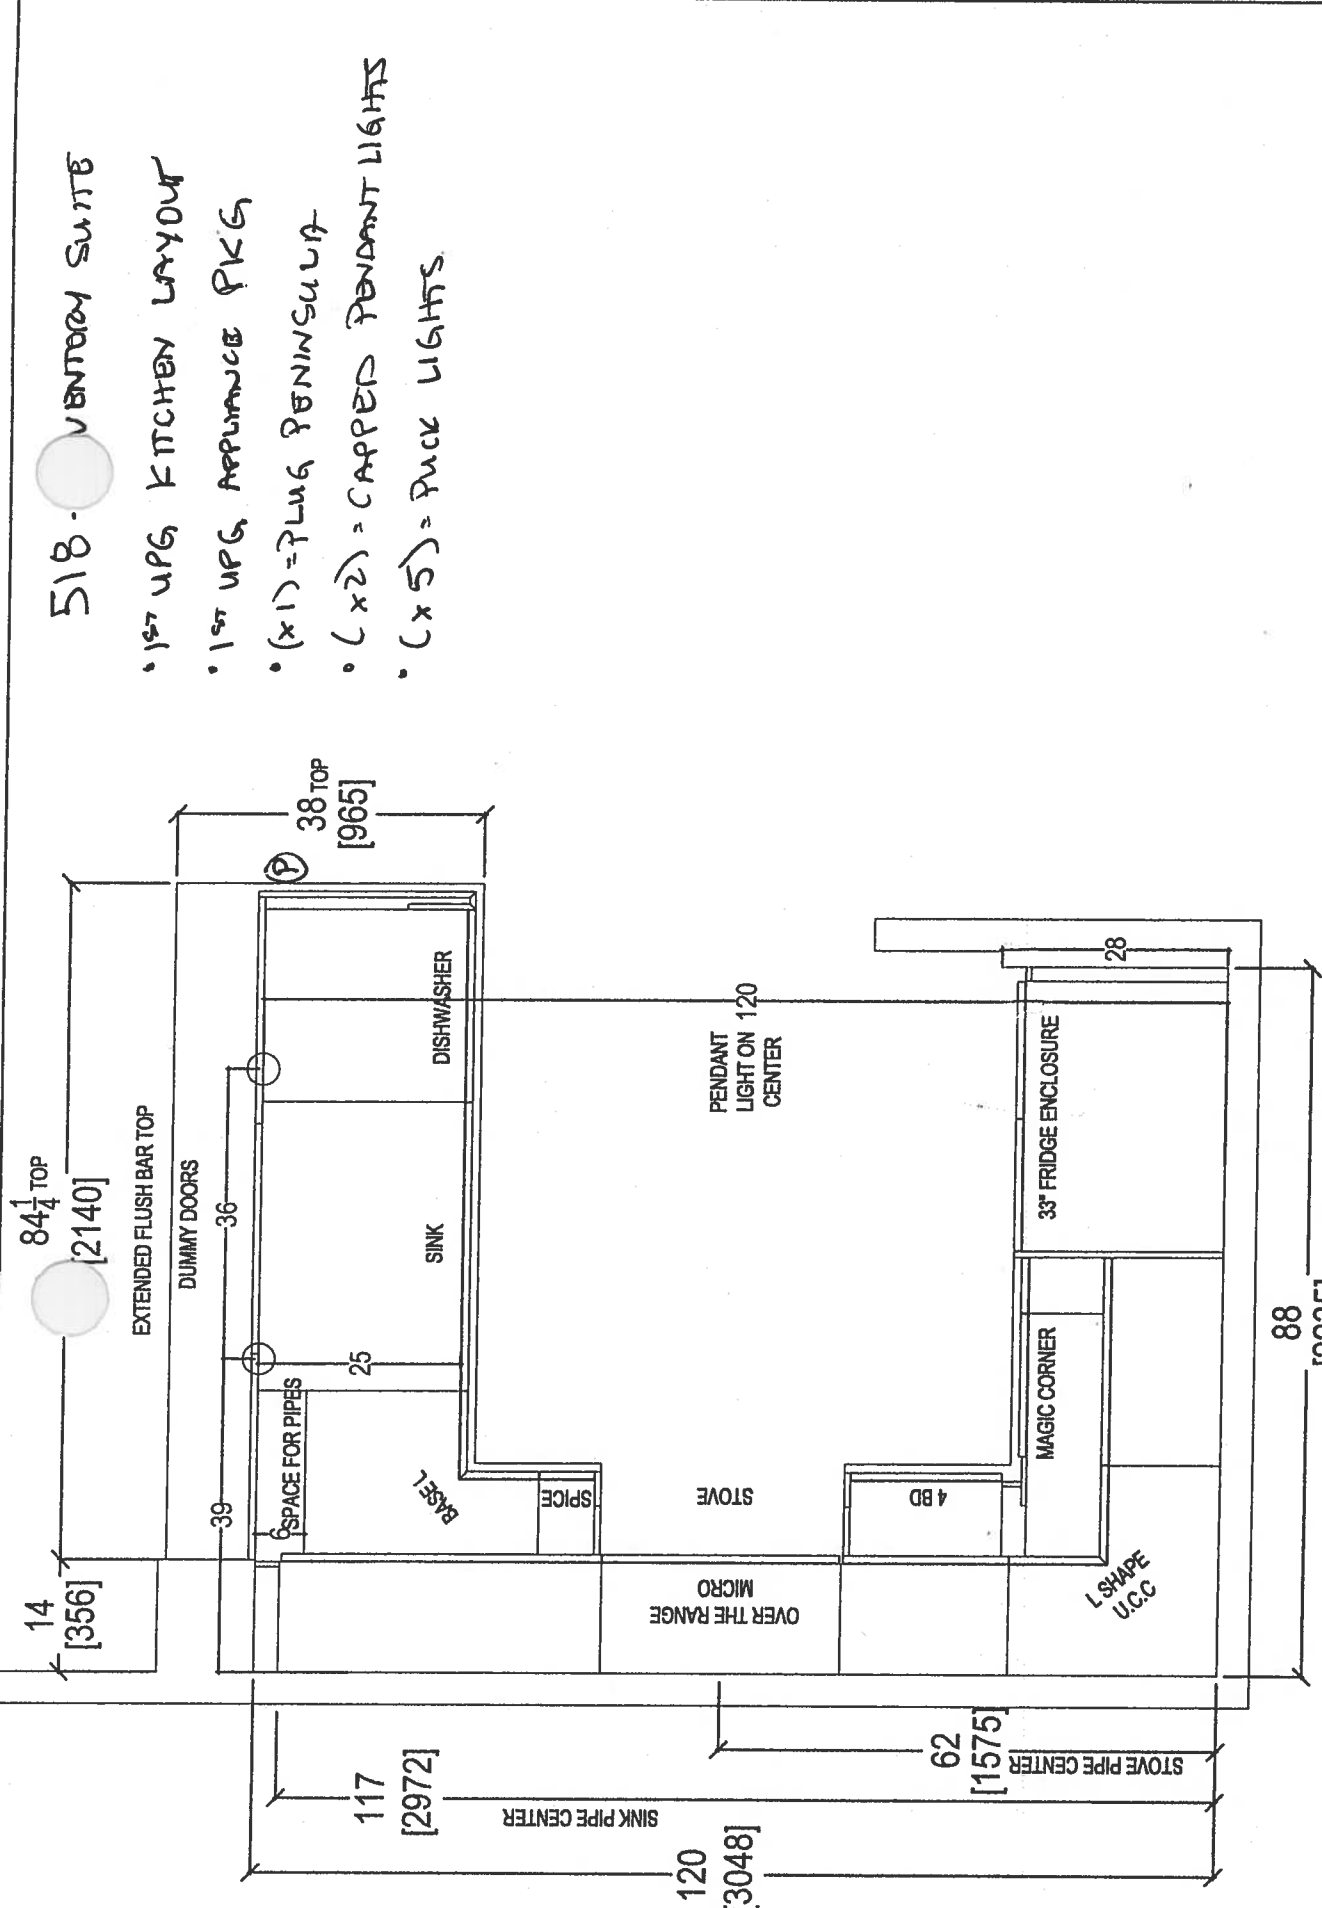


- 518 - VENTURA SUITE
- 1st UPG KITCHEN LAYOUT
 - 1st UPG APPLIANCE PKGS
 - (x1) = PLUG PENINSULA
 - (x2) = CAPPED PENDANT LIGHTS
 - (x5) = RUCK LIGHTS

 your kitchen. your taste. 80 SANTE DRIVE, VAUGHAN, ON L4K 3C4, T: 416.746.1811 F: 905.761.5901	CLIENT: ROYAL PINE HOMES		UNIT 518 HMP	ROOM: KITCHEN FLOOR PLAN	DRAWN BY: SK	COMMENTS:	
	SITE: HAMPTON PLACE	DOOR STYLE: —	DOOR HANDLE: —	SCALE: 1/2" = 1'-0"		PLEASE NOTE ALL DIMENSIONS ARE NOT FINAL AND ARE SUBJECT TO CHANGE UPON FINAL SITE MEASURE	
	PHONE: —	FINISH: —	DRW HANDLE: —	DATE: MARCH 7, 2018			
	EMAIL: —	SPECIES: —	TOP: —	PAGE: —			




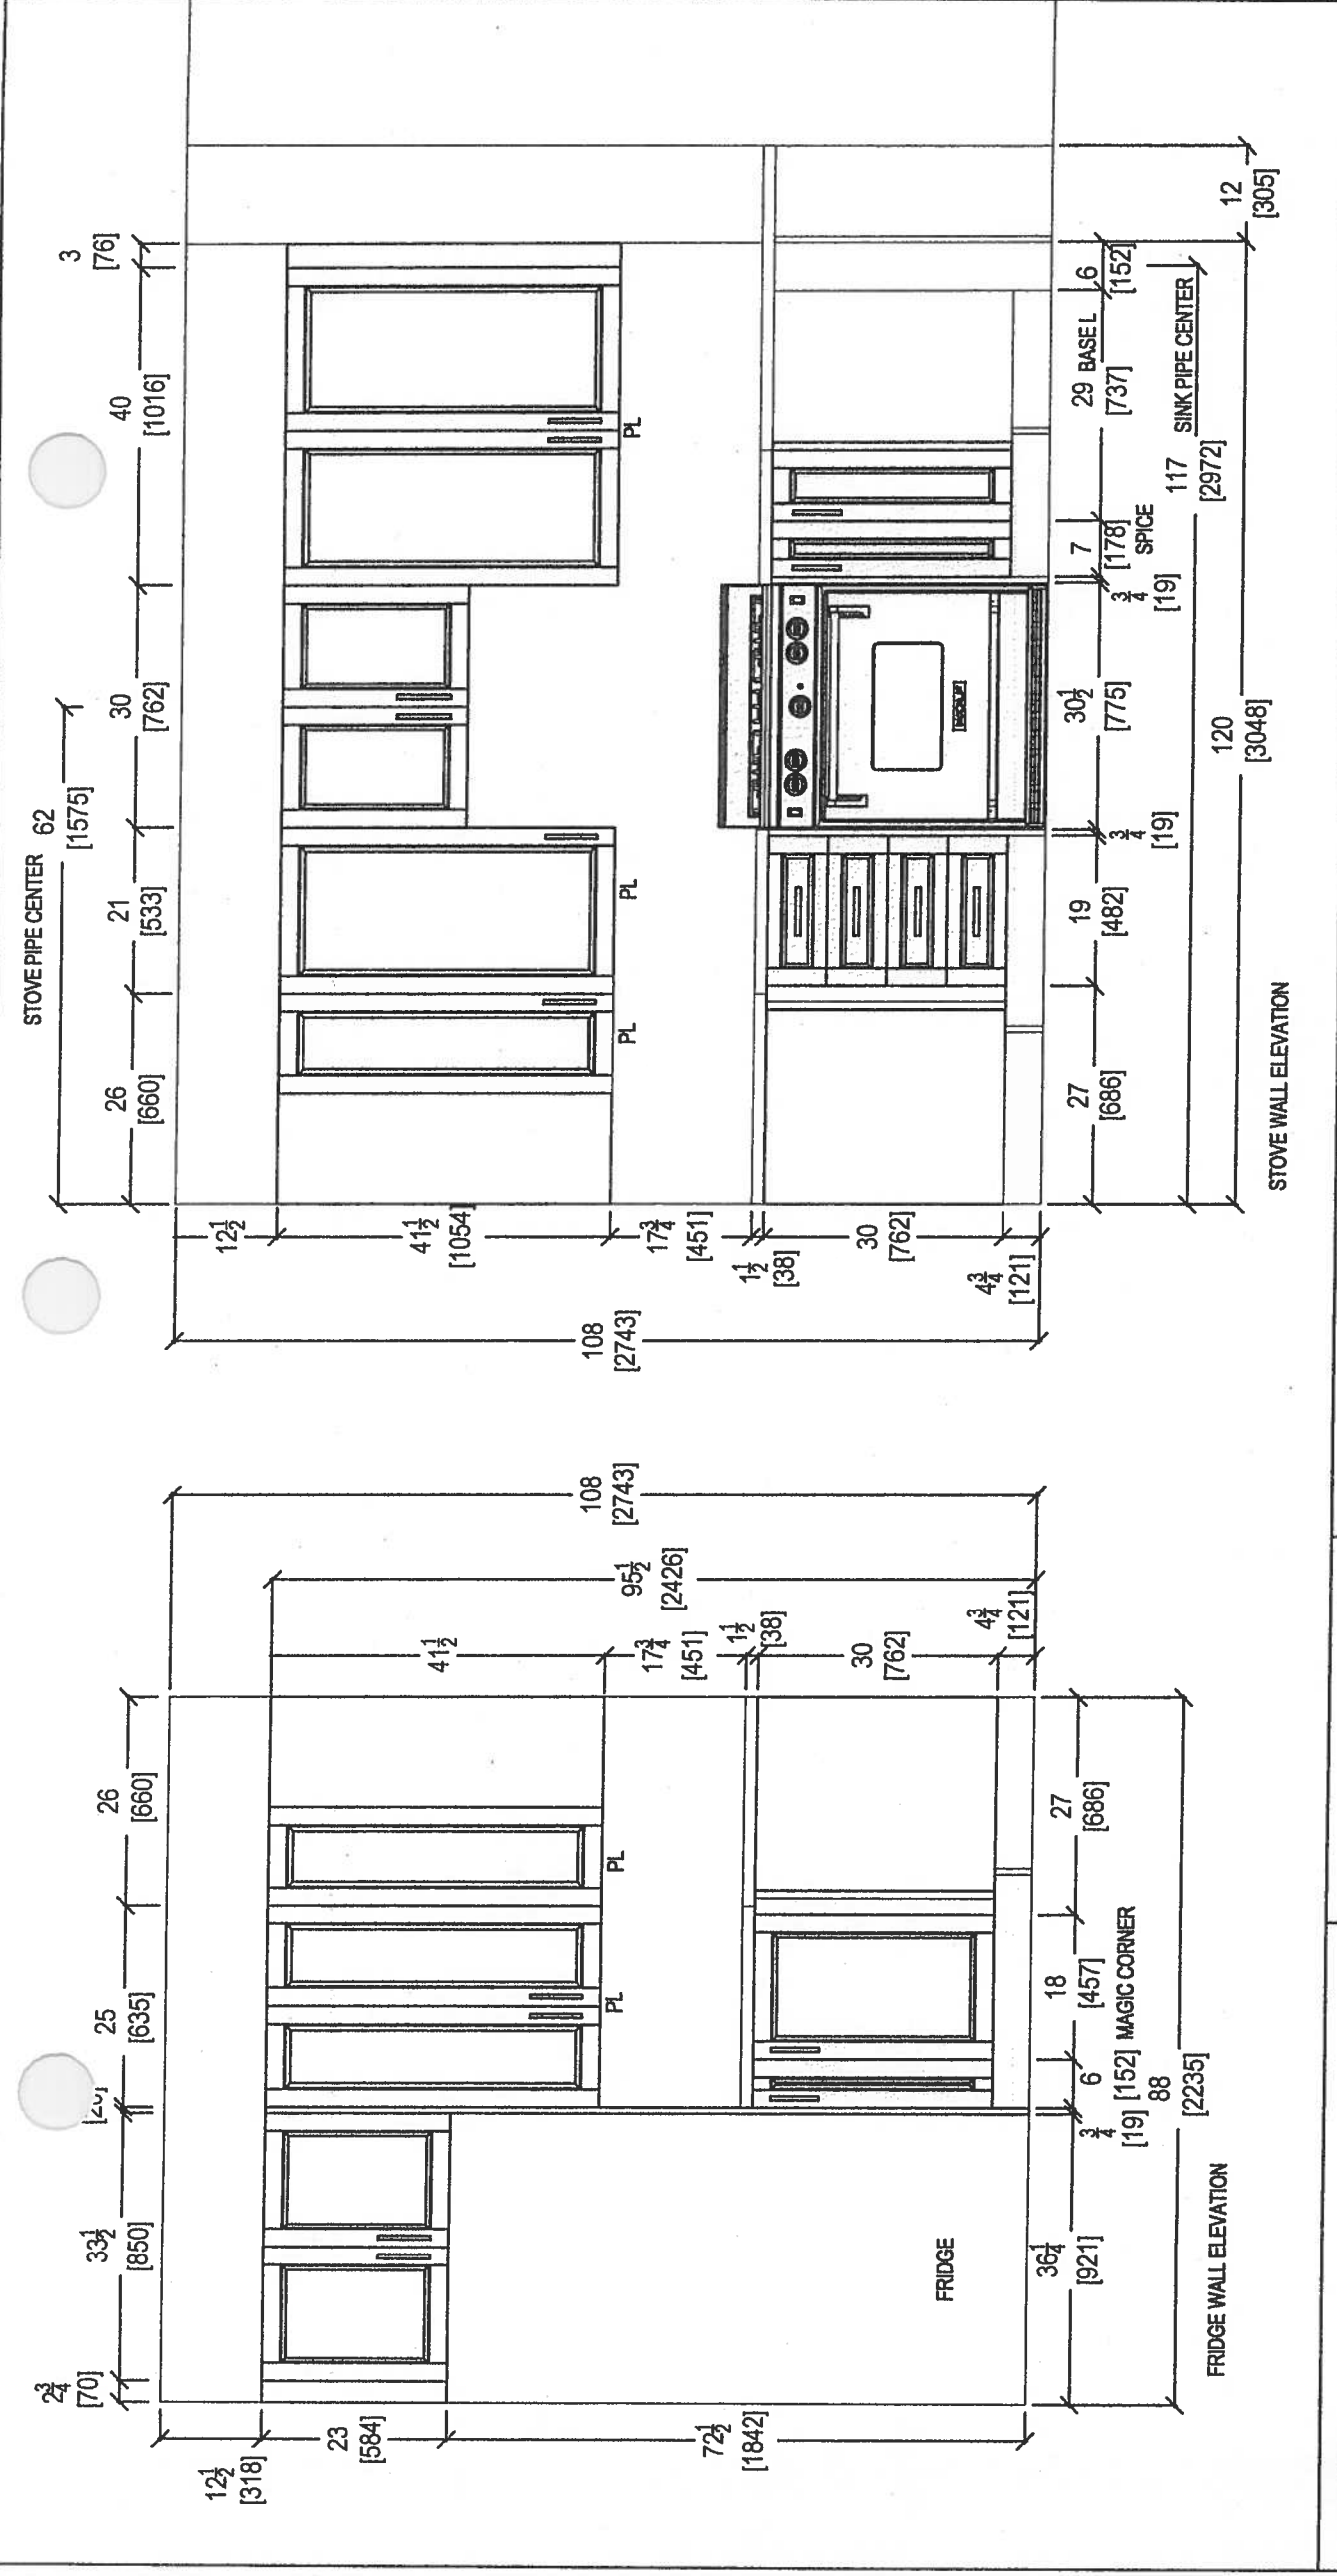


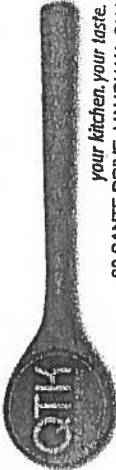 <i>your kitchen, your taste.</i> 80 SANTE DRIVE, VAUGHAN, ON L4K 3C4, T: 416.746.1811 F: 905.761.5901	CLIENT: ROYAL PINE HOMES		UNIT 518 HMP		ROOM: KITCHEN	DRAWN BY: SK	COMMENTS: PLEASE NOTE ALL DIMENSIONS ARE NOT FINAL AND ARE SUBJECT TO CHANGE UPON FINAL SITE MEASURE
	SITE: HAMPTON PLACE		DOOR STYLE: —		DOOR HANDLE: —	SCALE: 1/2" = 1' - 0"	
	PHONE: —		FINISH: —		DRW HANDLE: —	DATE: MARCH 7, 2018	
	EMAIL: —		SPECIES: —		TOP: —	PAGE: —	

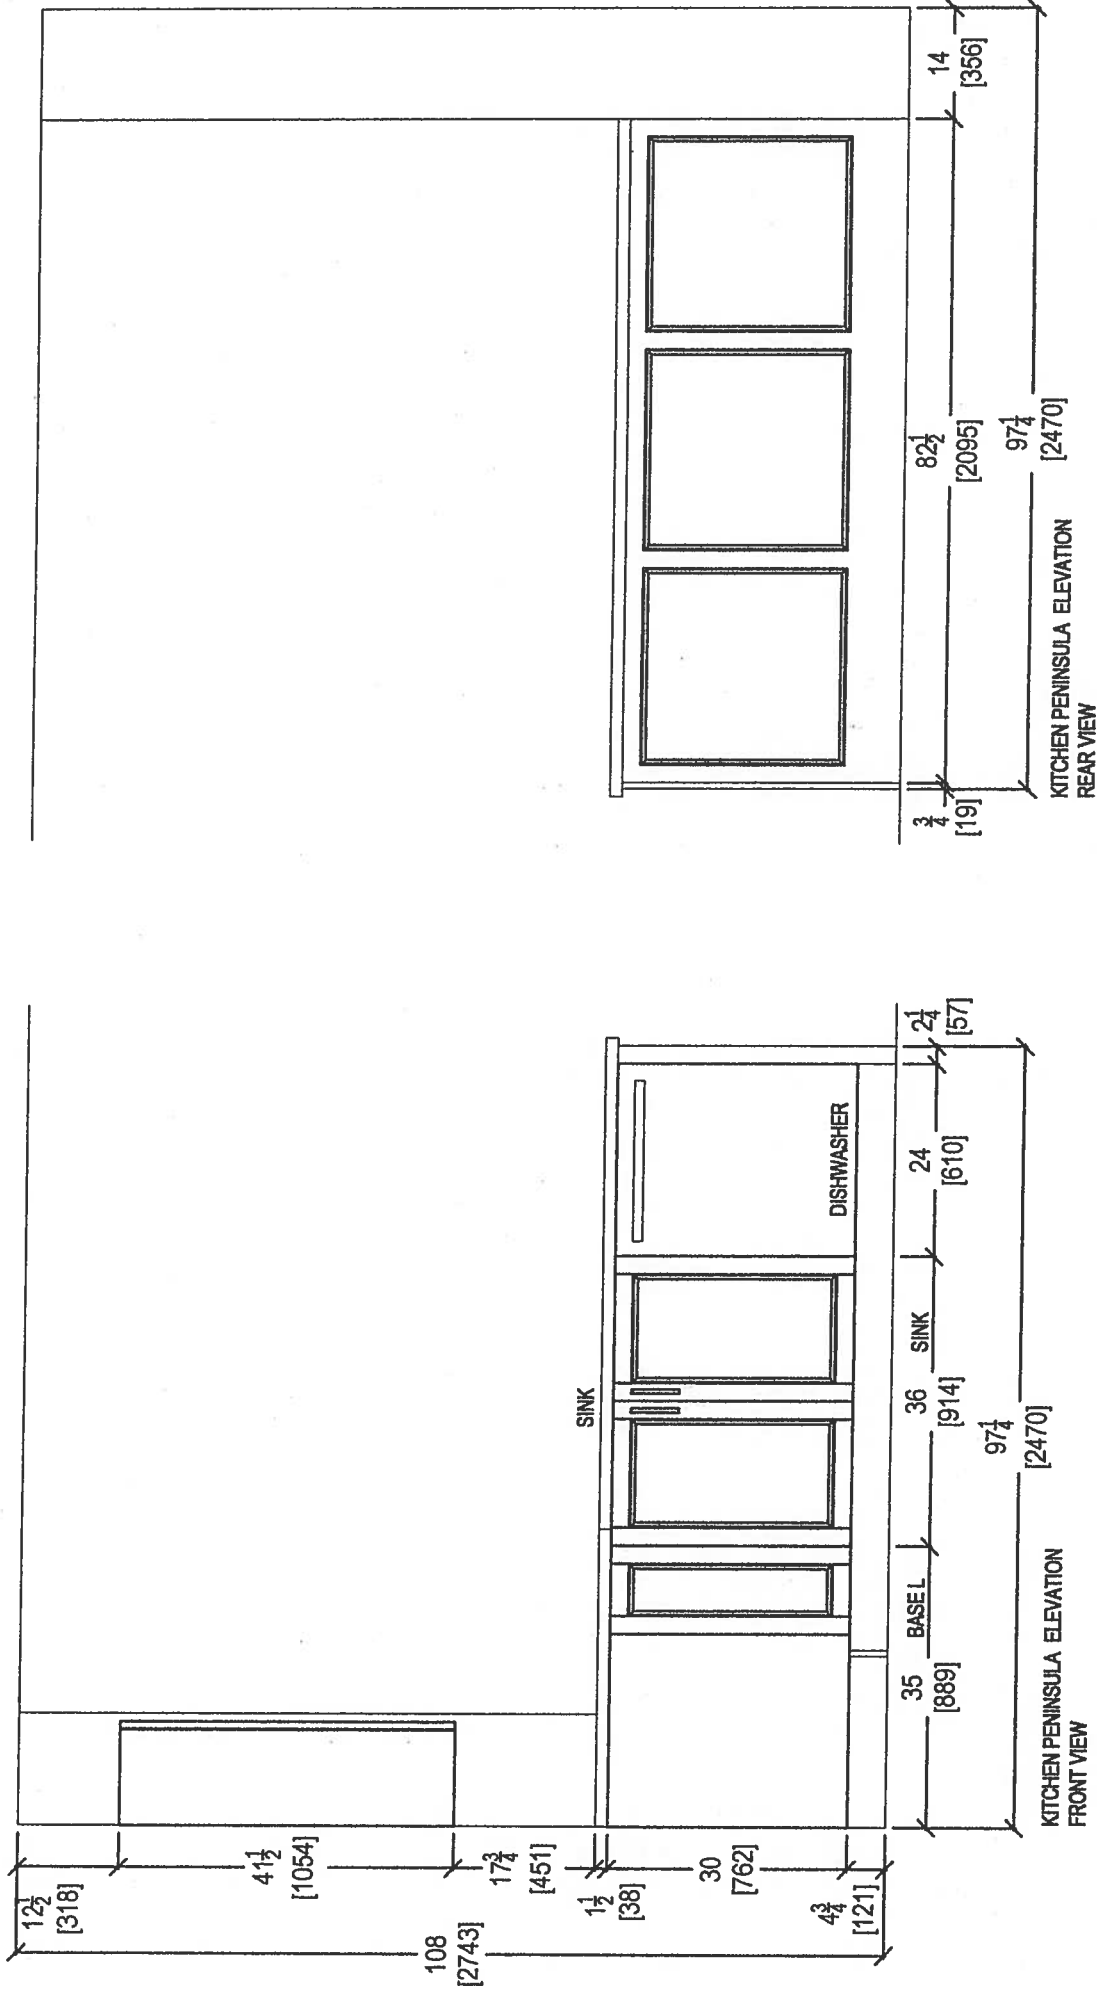

your kitchen, your taste.
80 SANTE DRIVE, VAUGHAN, ON L4K 3C4,
T: 416.746.1811 F: 905.761.5901

CLIENT: ROYAL PINE HOMES		UNIT 518 HMP		ROOM: KITCHEN	DRAWN BY: SK	COMMENTS:
SITE: HAMPTON PLACE		DOOR STYLE: --		DOOR HANDLE: --	SCALE: 1/2" = 1' - 0"	
PHONE: --		FINISH: --		DRW HANDLE: --	DATE: MARCH 7, 2018	
EMAIL: --		SPECIES: --		TOP: --	PAGE: --	

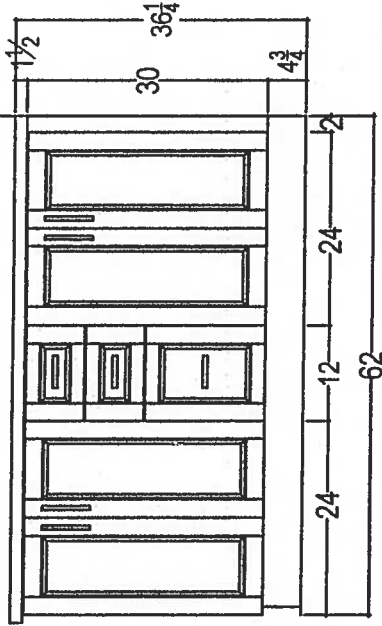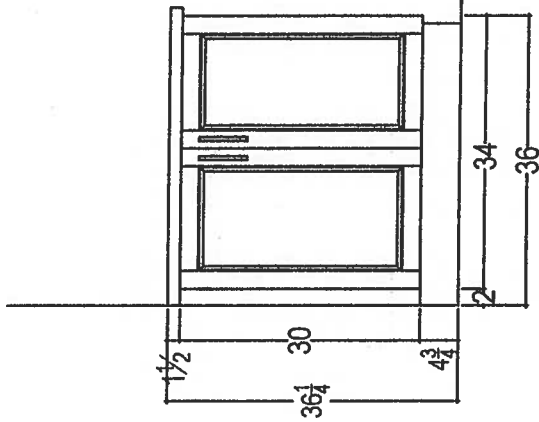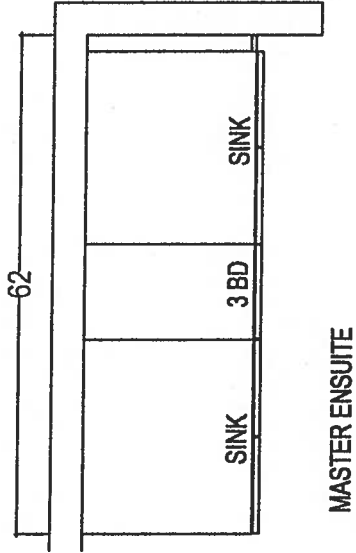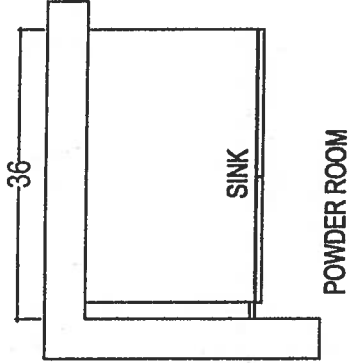

80 SANTE DRIVE, VAUGHAN, ON L4K 3C4,
T: 416.748.1811 F: 905.781.5901

CLIENT: ROYAL PINE HOMES		UNIT 518 HMP		ROOM:	VANITIES	DRAWN BY: SK		COMMENTS:	
SITE:	HAMPTON PLACE	DOOR STYLE:	—	DOOR HANDLE:	—	SCALE:	1/2" = 1' - 0"	PLEASE NOTE ALL DIMENSIONS ARE NOT FINAL AND ARE SUBJECT TO CHANGE UPON FINAL SITE MEASURE	
PHONE:	—	FINISH:	—	DRW HANDLE:	—	DATE:	MARCH 7, 2018		
EMAIL:	—	SPECIES:	—	TOP:	—	PAGE:	—		