
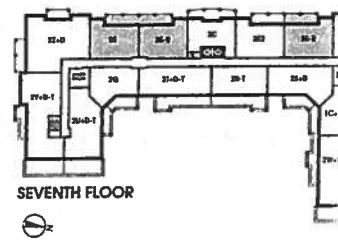
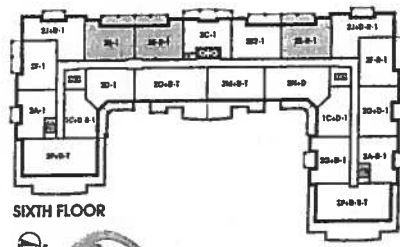
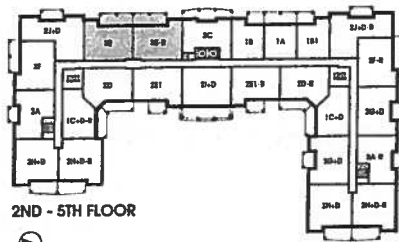
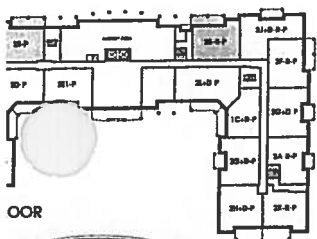


Flanders

SUITE 525
ORIGINAL LAYOUT

1,059 SQ FT *plus 180 sq. ft. of balcony area*

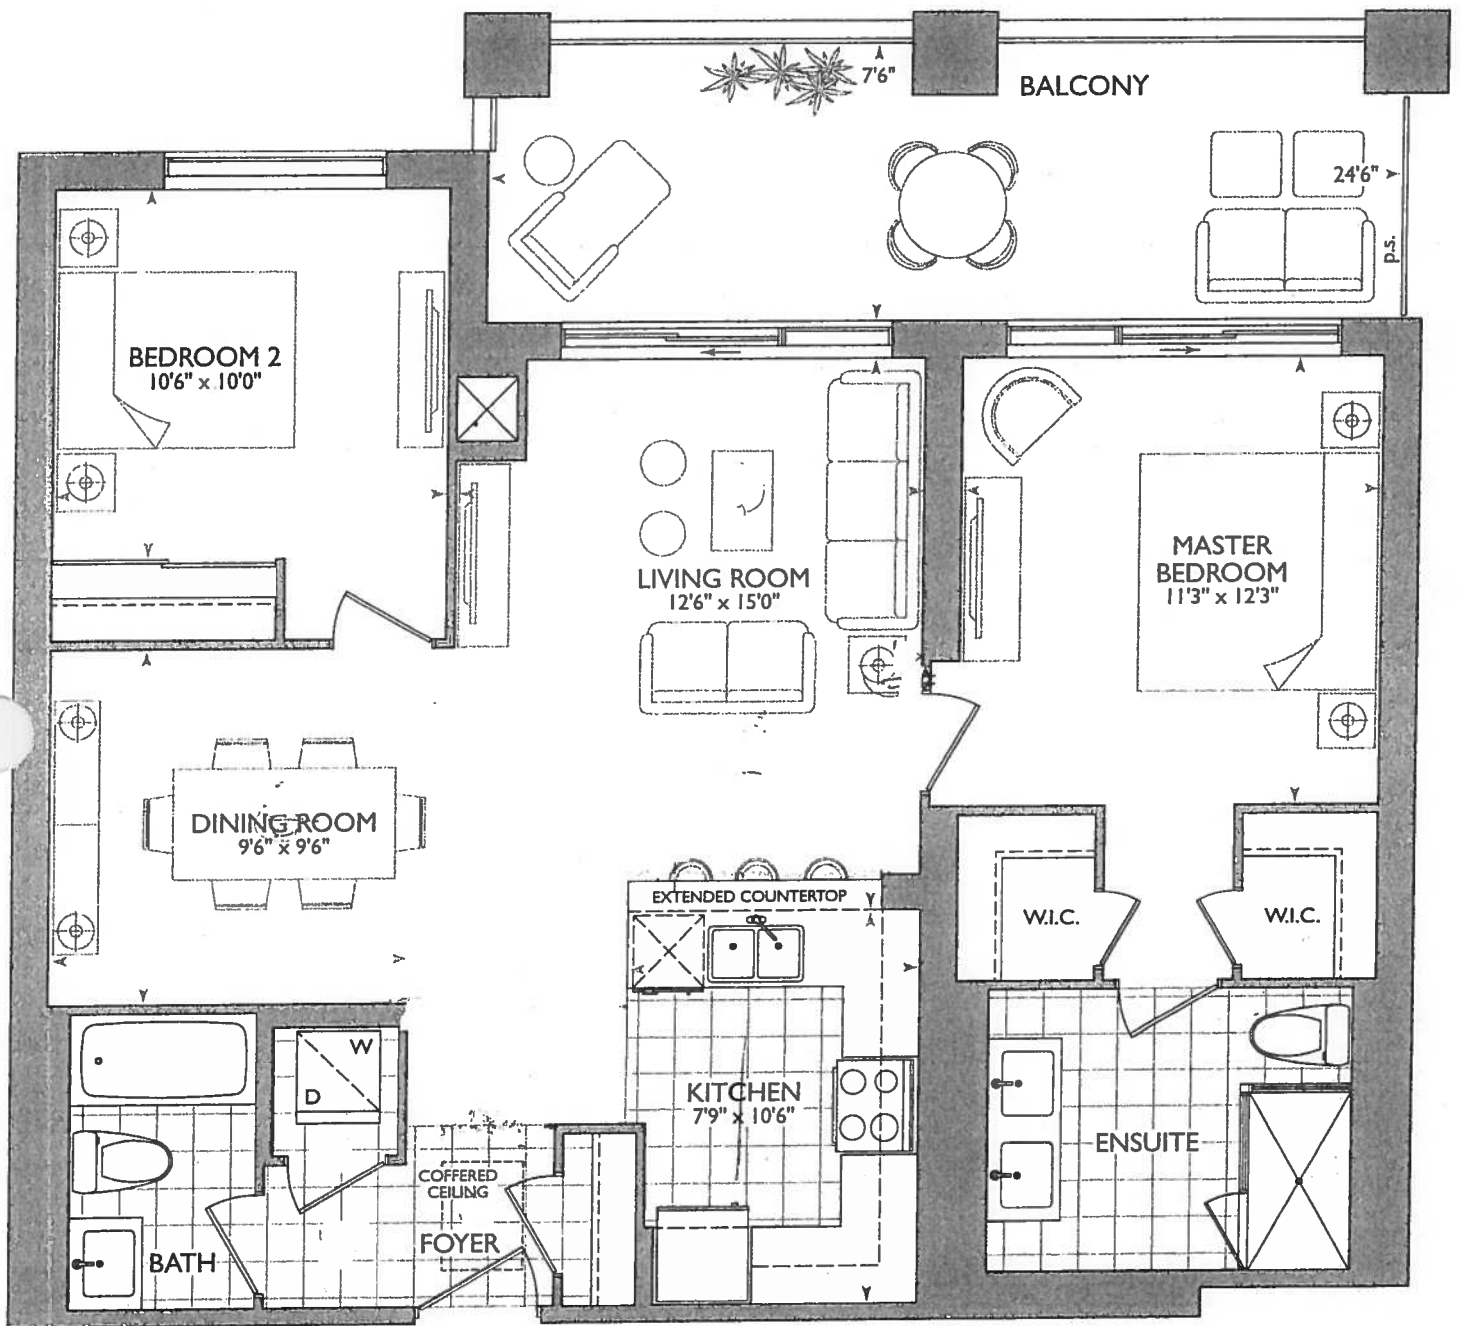


16

January 9, 2018

* Revised Foyer Covered *
AS PER THIS
Brochure - Tiles
TO REMAIN
THE SAME

* MASTER BEDRM +
W.I.C + ENSUITE
REVISED MEASUREMENTS
DUE TO 4" WET
WALL ADDED
TO ENSUITE

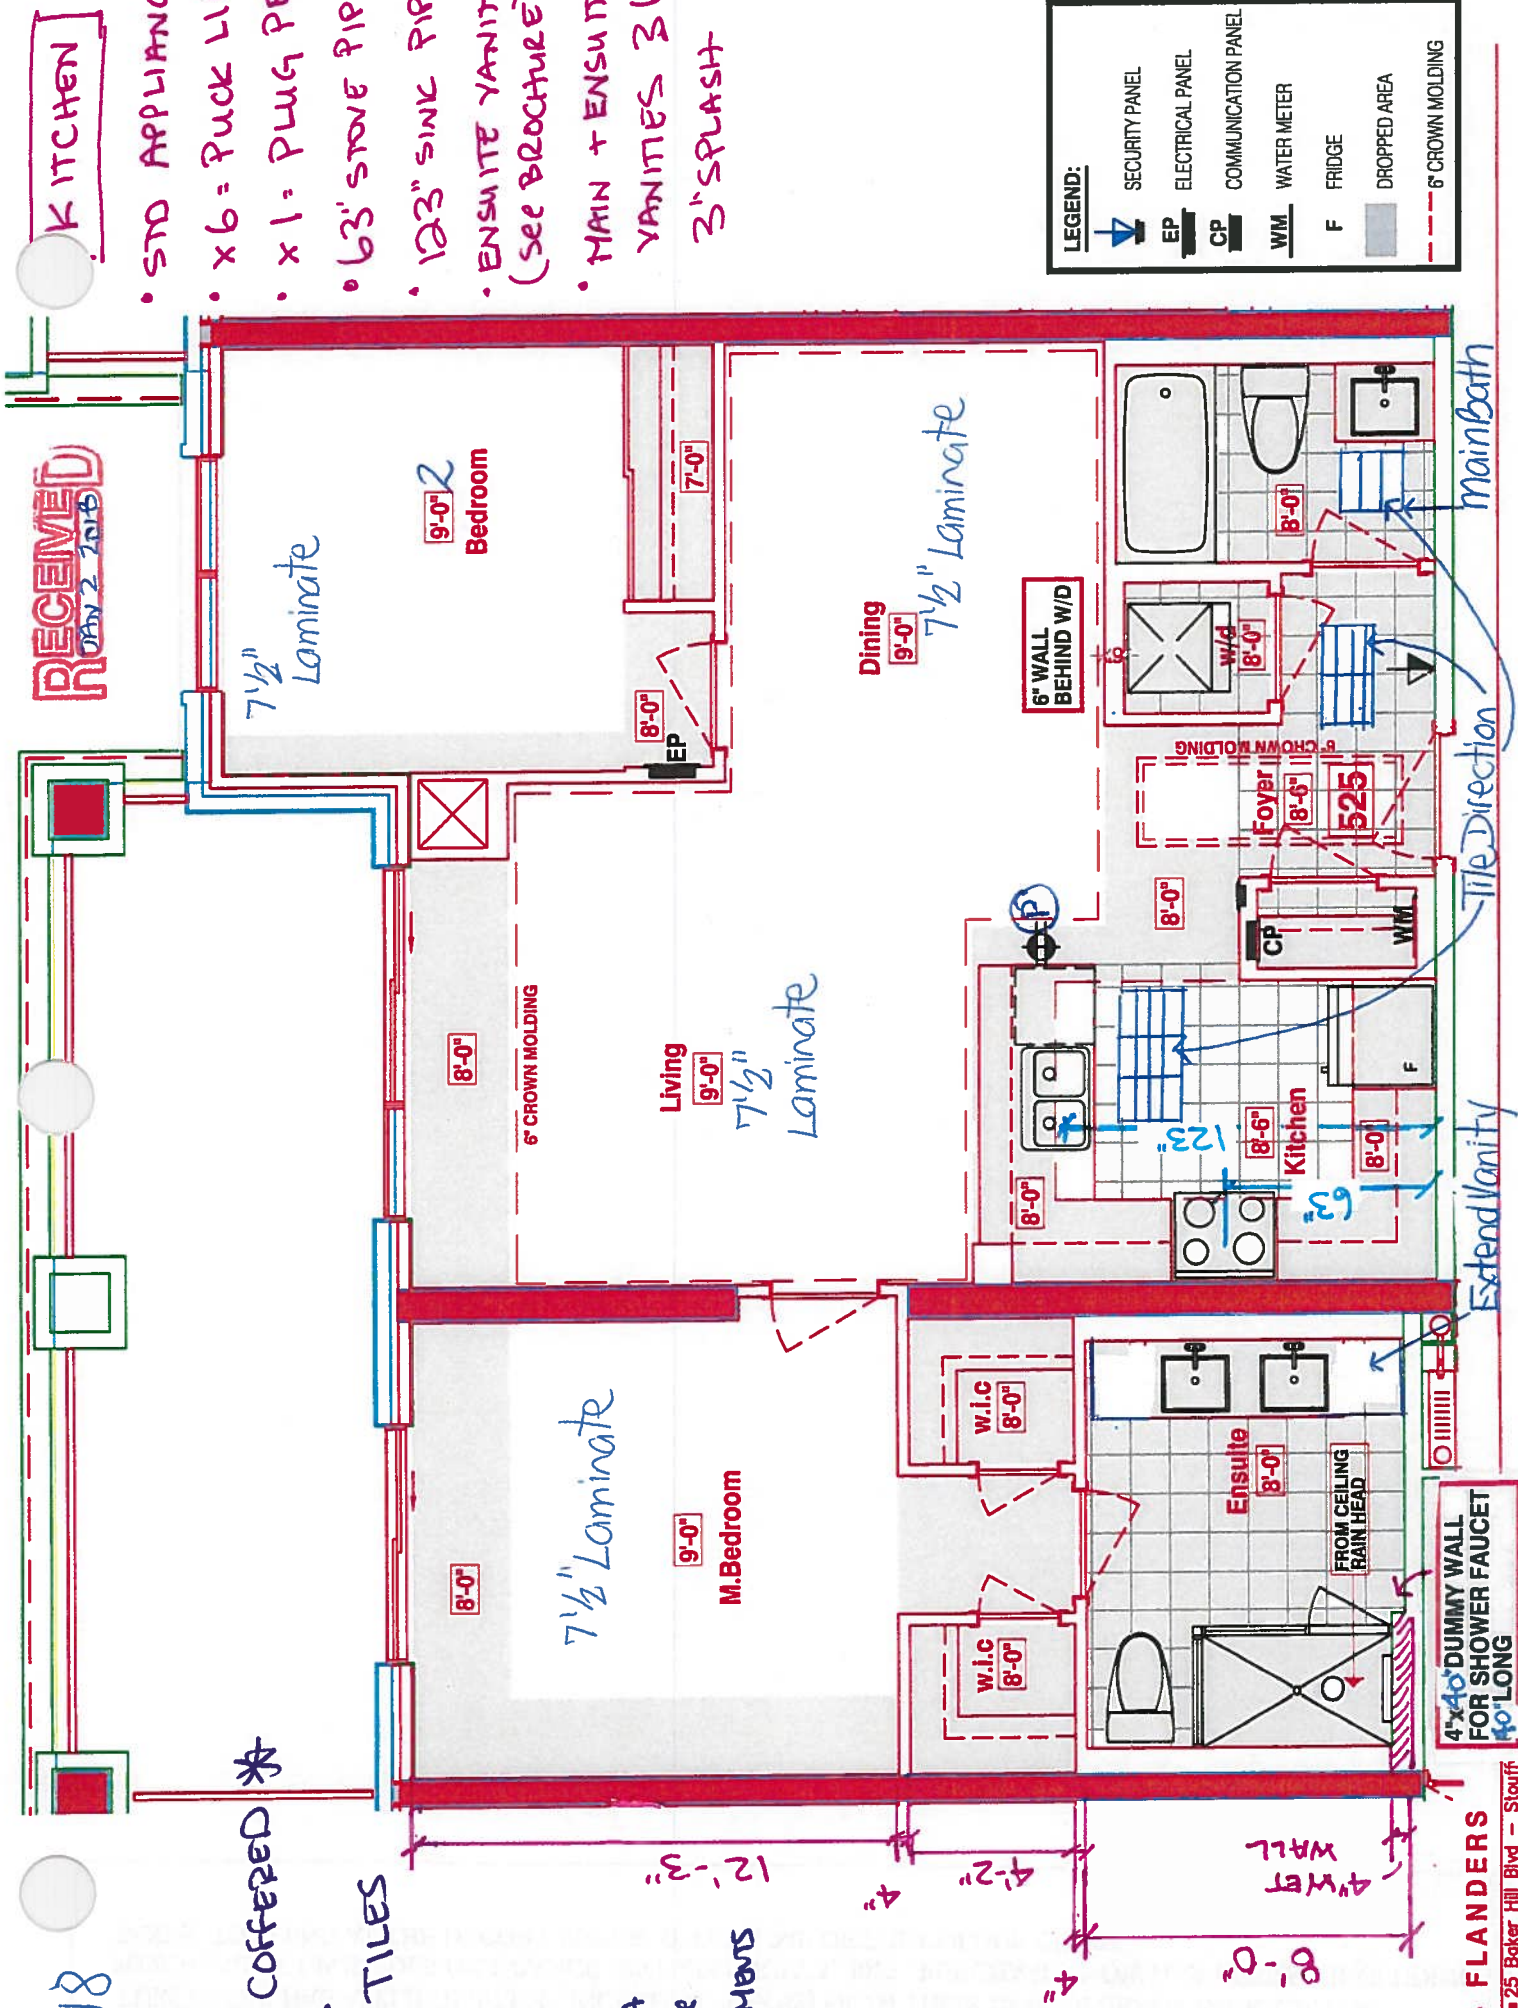

SUITE 525 - FLANDERS

Royal Pine Homes 25 Baker Hill Blvd - Stouffville



CONSTRUCTION SUMMARY

Hampton Place

PURCHASERS: HORMOZ KHOODIAN and ERIC KHOODIAN

TEL: RES.: 416-528-4482

LOT NUMBER	PHASE	HOUSE TYPE	CLOSING DATE	
525	1	FLANDERS(2E)	30-Oct-18	

Offer	PURCHASER WILL HAVE THE OPTION TO CHANGE THE AGREEMENT TO HIS SONS NAME WITHIN 6 MONTHS FROM DATE OF AGREEMENT FOR NO CHARGE AND WITHOUT USING HIS ASSIGNMENT CLAUSE.
Workshee	Note:

Offer	PURCHASER TO RECEIVE \$5,000(INCLUDES APPLICABLE TAXES) WORTH OF UPGRADES AT THE DECOR CENTER AT TIME OF COLOUR CHART.
Workshee	Note:

Offer	ADDITIONAL - SINGLE PARKING UNIT
Workshee	Note:

Offer	RAINHEAD FROM CEILING IN MASTER ENSUITE FROM VENDORS STANDARD SAMPLES
Upgrade	Note:

Offer	PURCHASER HAS APPLIED\$1073.50 (INCLUDING TAXES) FROM THEIR \$5000 UPGRADE PACKAGE FOR PURCHASE OF UPGRADES ON INVOICE 290 DATED JULY 5, 2017. PURCHASER NOW HAS \$3936.50 (INCLUDING TAXES) TO SPEND AT THE DECOR CENTER AT THE TIME OF THE COLOUR CHART
Upgrade	Note:





SITE COPY

CONSTRUCTION SUMMARY

Hampton Place

PURCHASERS: HORMOZ KHOODIAN and ERIC KHOODIAN

TEL: RES.: 416-528-4482

LOT NUMBER	PHASE	HOUSE TYPE	CLOSING DATE	
525	1	FLANDERS(2E)	30-Oct-18	

Date Added: 09-Jan-18

Invoice Number: 7079

1 - KITCHEN & BATHROOMS - SEE QUALITY TOPS & KITCHENS FOR ALL KITCHEN & BATHROOMS UPGRADES / LAYOUTS (See Attached QTK Paperwork)
2 - KITCHEN - Install TWO (2) ADDITIONAL PUCK LIGHTS (Same Switch as Standard Puck Lights) at kitchen. To be installed below kitchen cabinetry, where applicable. (See Attached QTK Layout for Locations) Note: Purchaser Paying Difference for Additional Puck Lights - Standard Kitchen to Receive Four (4) Puck Lights - Upgrade Kitchen Requires Six (6) Puck Lights
1 - KITCHEN - Install Standard Granite Countertop - BIANCO ANTICO - To be installed throughout kitchen, where applicable. (Does not include granite backsplash) (See Sketch) Note:
1 - DISCLAIMER - GRANITE COUNTERTOP; KITCHEN - Due to the many variables that can affect the pattern, colour and/or design and "pitting" of natural products, granite installed will not be identical to the samples displayed. Note: Every effort is made to provide granite countertops as close as possible but the vendor is not responsible for results which differ from the sample displayed. All countertop surfaces may have seams, and product pattern and shade can change in areas containing seams.
1 - DISCLAIMER - STONE COUNTERTOP; KITCHEN - Stone slabs vary in size & all seams are visible & the fabricator reserves the right to position the seams as necessary Note:
1 - KITCHEN - Kitchen Sink - Install Standard Undermount Sink - BLANCO Horizon Plus U2 Undermount Sink (8") - Model # 401234 Note:
1 - KITCHEN - Kitchen Faucet - Install Standard Faucet - DELTA Chrome Pull-Out Kitchen Faucet (Single Hole) - Model # 469LF - Chrome Note:
1 - APPLIANCE PACKAGE - Install STANDARD APPLIANCE PACKAGE - To be installed throughout suite, where applicable. (See Sketch) Note:
30 - MAIN BATH - 1ST UPGRADE - PORCELAIN TILES - 12x24 H-STONE LIGHT GREY - To be installed throughout main bath floor (To be Installed Straight) (See Sketch) Note: Includes Larger Size
1 - MAIN BATH - Install Standard Granite Countertop - BIANCO ANTICO - To be installed throughout main bath vanity, where applicable. (Includes 3" Splash) (See Sketch) Note:
1 - MASTER ENSUITE - Install ADDITIONAL Standard Granite Countertop - SERENATA GRANITE - To be installed throughout master ensuite vanity, where applicable. (Includes 3" Splash) (See Sketch) Note: To Accommodate Enlargerd Vanity Length included in Upgrade QTK Package.
1 - CLARIFICATION; MAIN BATH & MASTER ENSUITE - Install Standard 3" Splash throughout Main Bath and Master Ensuite Vanity Countertops, where applicable. (See Sketch)
1 - DISCLAIMER - GRANITE COUNTERTOP; MAIN BATH & MASTER ENSUITE - Due to the many variables that can affect the pattern, colour and/or design and "pitting" of natural products, granite installed will not be identical to the samples displayed. Note: Every effort is made to provide granite countertops as close as possible but the vendor is not responsible for results which differ from the sample displayed. All countertop surfaces may have seams, and product pattern and shade can change in areas containing seams.
1 - DISCLAIMER - STONE COUNTERTOP; MAIN BTAH & MASTER ENSUITE - Stone slabs vary in size & all seams are visible & the fabricator reserves the right to position the seams as necessary. Note:



SITE COPY

CONSTRUCTION SUMMARY

Hampton Place

PURCHASERS: HORMOZ KHOODIAN and ERIC KHOODIAN

TEL: RES.: 416-528-4482

LOT NUMBER	PHASE	HOUSE TYPE	CLOSING DATE	
525	1	FLANDERS(2E)	30-Oct-18	

Date Added: 09-Jan-18

Invoice Number: 7079

1 - MAIN BATH & MASTER ENSUITE - Install RAISED VANITY HEIGHTS at Main Bath and Master Ensuite vanities, where applicable (See Attached QTK Paperwork)

1 - CLARIFICATION;
MAIN BATH & MASTER ENSUITE - Install Standard Plumbing Fixtures throughout Main Bath and Master Ensuite where applicable. (See Sketch)
Note:

1 - CLARIFICATION - REFER TO APAS;
MASTER ENSUITE - Install Rain Shower Head from Ceiling at Master Ensuite Shower Stall - DELTA - Shower Trim and Hansgrohe Slide Bar with Handheld and Ceiling Mount Showerhead
Note: Model # R10000 / T13020-CDN/27454002 / 277440 / RP52382 / RP46870 / RP6025 / R11000 / T11800 - Chrome (See Sketch)

1 - CLARIFICATION;
MASTER ENSUITE - Purchaser accepts & acknowledges the standard frameless glass enclosure at master ensuite shower stall will NOT touch the ceiling and will receive a Standard Chrome Header. (See Sketch)
Note:

1 - BONUS PACKAGE - PURCHASER HAS APPLIED \$3,936.50 (Includes Taxes) WORTH OF UPGRADE PROMOTIONAL PACKAGE TOWARDS THE PURCHASE OF UPGRADES COMPLETED AT THE DECOR CENTRE.
Note:

1 - PURCHASER HAS ATTENDED A COLOR APPOINTMENT AT THE DECOR CENTRE AND HAS DECLINED ANY ADDITIONAL UPGRADES. Purchaser accepts and acknowledges that there will be no further changes/additions/deletions to be made upon signing on January 9,2018
Note:

PURCHASER AWARE AND ACCEPTS THAT ANY CHANGES MADE TO UPGRADES AFTER SIGNING THIS PURCHASERS EXTRA FORM ARE SUBJECT TO A MINIMUM ADMINISTRATION FEE OF \$1,000 PLUS A 10% HOLDBACK FEE.
Note:

This Document is Extremely Time Sensitive - Printed 7 Mar 18 at 10:07





Purchasers

HORMOZ KHOODIAN & ERIC KHOODIAN

* INTERIOR

OUR SCHEME *

Decor Consultant

Melissa Di Marino

Model Type

FLANDERS(2E)

Telephone Res. / Bus

(416) 528-4482 /

Project

Hampton Place

Closing Date

30/10/2018

Unit

525

Page 1 of 3

Flooring

Description	
✓ 13x13 HELLO SILVER (STD)	
✓ 12x24 H-STONE LIGHT GREY (STRAIGHT) (Upg)	
N/A	
✓ 12x24 H-STONE LIGHT GREY (STRAIGHT)(STD)	
✓ 12x24 H-STONE LIGHT GREY (STRAIGHT)(STD)	
✓ 8x8 BEHRAM PINK (STD)	
✓ 7 1/2" TorleysForest - NorthernCordillera9687P (STD)	
✓ 7 1/2" TorleysForest - NorthernCordillera9687P (STD)	
N/A	
✓ 7 1/2" TorleysForest - NorthernCordillera9687P (STD)	
✓ 7 1/2" TorleysForest - NorthernCordillera9687P (STD)	
N/A	

Wall Tile

Main	Accent/Insert	Pattern
8x10 GOLF GRIGIO (STD)	NONE	NONE
8x10 GOLF GRIGIO (STD)	NONE	NONE
N/A	N/A	N/A
12x12 TwilightMocha GlassMosaics (STD)	NONE	NONE
N/A	N/A	N/A
N/A	N/A	N/A

Notes

Page 1 of 3

Consultant:

Melissa Di Marino

Purchaser:

HORMOZ KHOODIAN

Purchaser:

ERIC KHOODIAN

Vendor

Hampton Place



* INTERIOR / OUR SCHEME *

Purchasers HORMOZ KHOODIAN & ERIC KHOODIAN		Decor Consultant Melissa Di Marino	Model Type FLANDERS(2E)	Telephone Res. / Bus (416) 528-4482 /	Project Hampton Place	Closing Date 30/10/2018	Unit 525
---	--	---------------------------------------	----------------------------	--	--------------------------	----------------------------	-------------

Page 2 of 3

CABINETRY, VANITIES AND COUNTERTOPS

	Style	Countertop	Counter Edge	Handle / Knob
MAIN BATHROOM	CATEGORY 1 - FIBERBOARD - WHITE QT 1203 (STD)	☒ BIANCO ANTICO GRANITE (STD)	☒ A " EDGE (STD)	B603-SC
MASTER ENSUITE	CATEGORY 1 - FIBERBOARD - IVORY QT 1203 (STD)	☒ SERENATA GRANITE (STD)	☒ A " EDGE (STD)	16338-195
POWDER ROOM	N/A	N/A	N/A	N/A
KITCHEN / DINETTE	CATEGORY 1 - FIBERBOARD - WHITE QT 1203 (STD)	☒ BIANCO ANTICO GRANITE (STD)	☒ A " EDGE (STD)	16338-195
LAUNDRY ROOM	N/A	N/A	N/A	N/A

APPLIANCE PACKAGE

Standard Package

Std 31in Opening

PLUMBING FIXTURES

KITCHEN	
Sink Model	☒ STANDARD
Sink Faucet	☒ STANDARD
TOILETS	
Master Ensuite	☒ STANDARD
Main Bathroom	☒ STANDARD
Powder Room	N/A
VANITY FAUCETS	
Master Ensuite	☒ STANDARD
Main Bathroom	☒ STANDARD
Powder Room	N/A
VANITY SINKS	
Master Ensuite	☒ STANDARD
Main Bathroom	☒ STANDARD
Powder Room	N/A
SHOWER STALL / TUBS	
Master Ensuite Shower Stall	☒ STANDARD
Master Ensuite Tub	N/A
Main Bathroom Tub	☒ STANDARD

Trim

Baseboard & Casing	☒ STANDARD
Interior Doors	☒ STANDARD - CARRARA SMOOTH

Levers

Door Height	☒ STANDARD
-------------	--

Cornice Moulding / Medallion

Foyer	☒ STANDARD - #CTR-611
Living Room	☒ STANDARD - #CTR-611
Dining Room	☒ STANDARD - #CTR-611
Den	N/A
Master Bedroom	NONE
Bedroom 2	NONE
Bedroom 3	N/A

Fireplace

Fireplace	N/A
Location Flooring	N/A
Style	N/A
Finish	N/A
Marble	N/A
Hearth	N/A

Paint Throughout

Walls	☒ STANDARD - BIRCH WHITE
Trim	☒ STANDARD - WHITE

Page 2 of 3

Decor Consultant:

Melissa Di Marino

Purchaser:

HORMOZ KHOODIAN

Purchaser:


ERIC KHOODIAN

Vendor:

Hampton Place




Suite 525 Hampton

- STD APPLIANCE PACKAGE
- x6 - PUCK LIGHTS
- (P) = PLUG PENINSULA
- ENSUITE VANITY EXTENDED
- MAIN + ENSUITE RAISED VANITIES 36 1/4" + 3" SPLASH

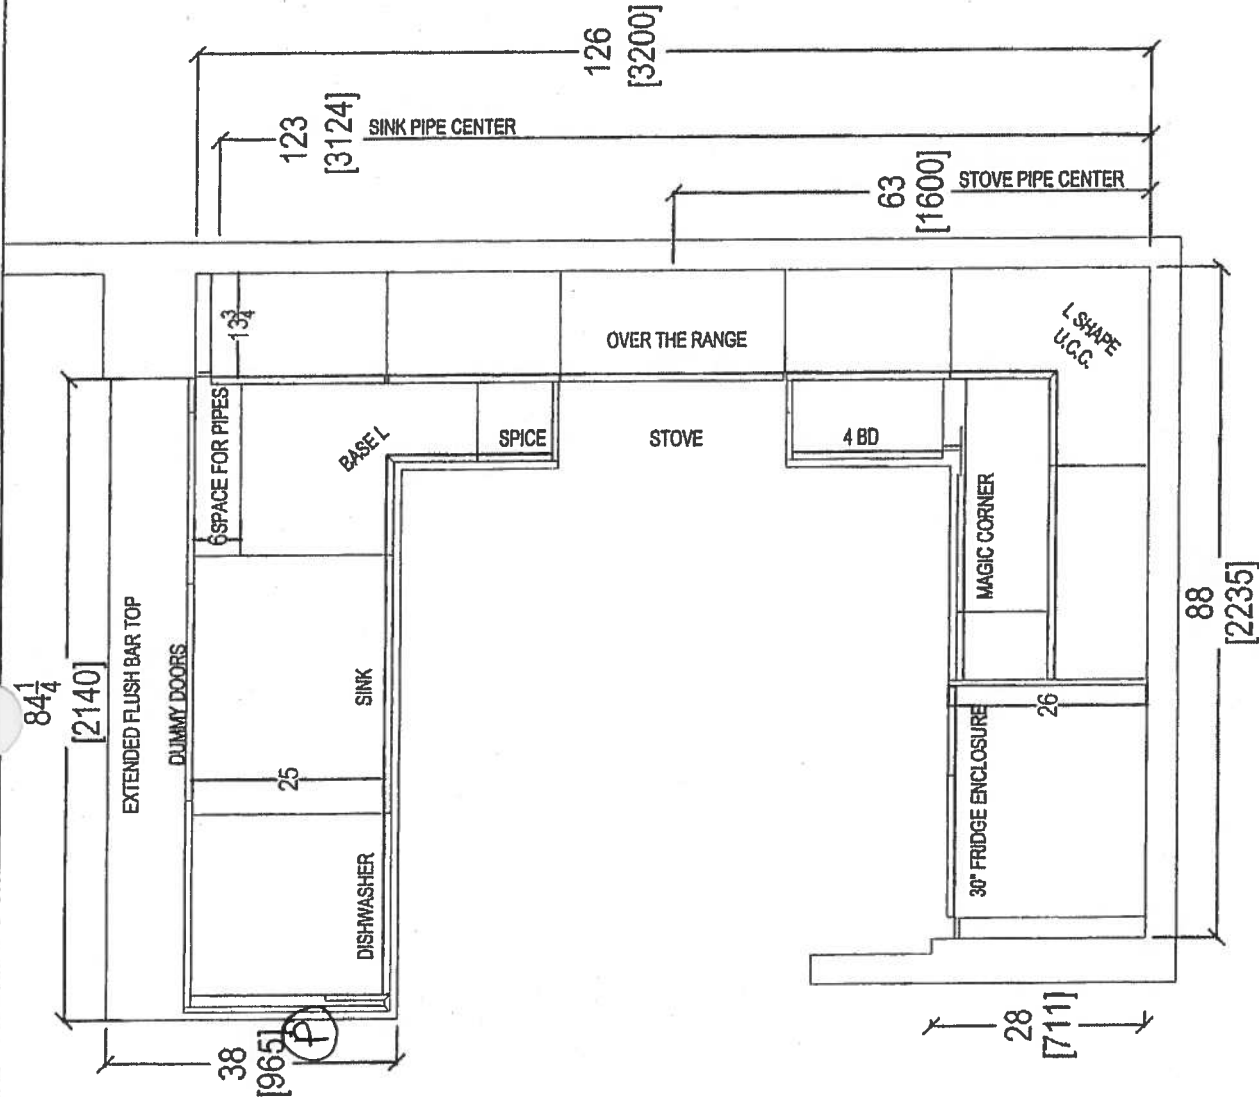

 OTK your kitchen. since 1974 80 SANTE DRIVE, VAUGHAN, ON L4K 3C4, T: 416.748.1811 F 906.761.5901	CLIENT: ROYAL PINE HOMES		JOB NAME: FLANDERS 2E UPGRADE PKG 1	ROOM:	KITCHEN FLOOR PLAN	DRAWN BY: SK	COMMENTS: PLEASE NOTE ALL DIMENSIONS ARE NOT FINAL AND ARE SUBJECT TO CHANGE UPON FINAL SITE MEASURE
	SITE: HAMPTON PLACE	LOT #:		DOOR HANDLE:	---	SCALE: 1/2" = 1'-0"	
	PHONE: ---	FINISH: ---		DRW HANDLE:	---	DATE: AUG 4, 2017	
	EMAIL: ---	SPECIES: ---		TOP:	---	PAGE: ---	

Suite 525 Hampton PL 5' Rock Light (x6)

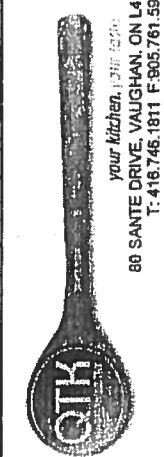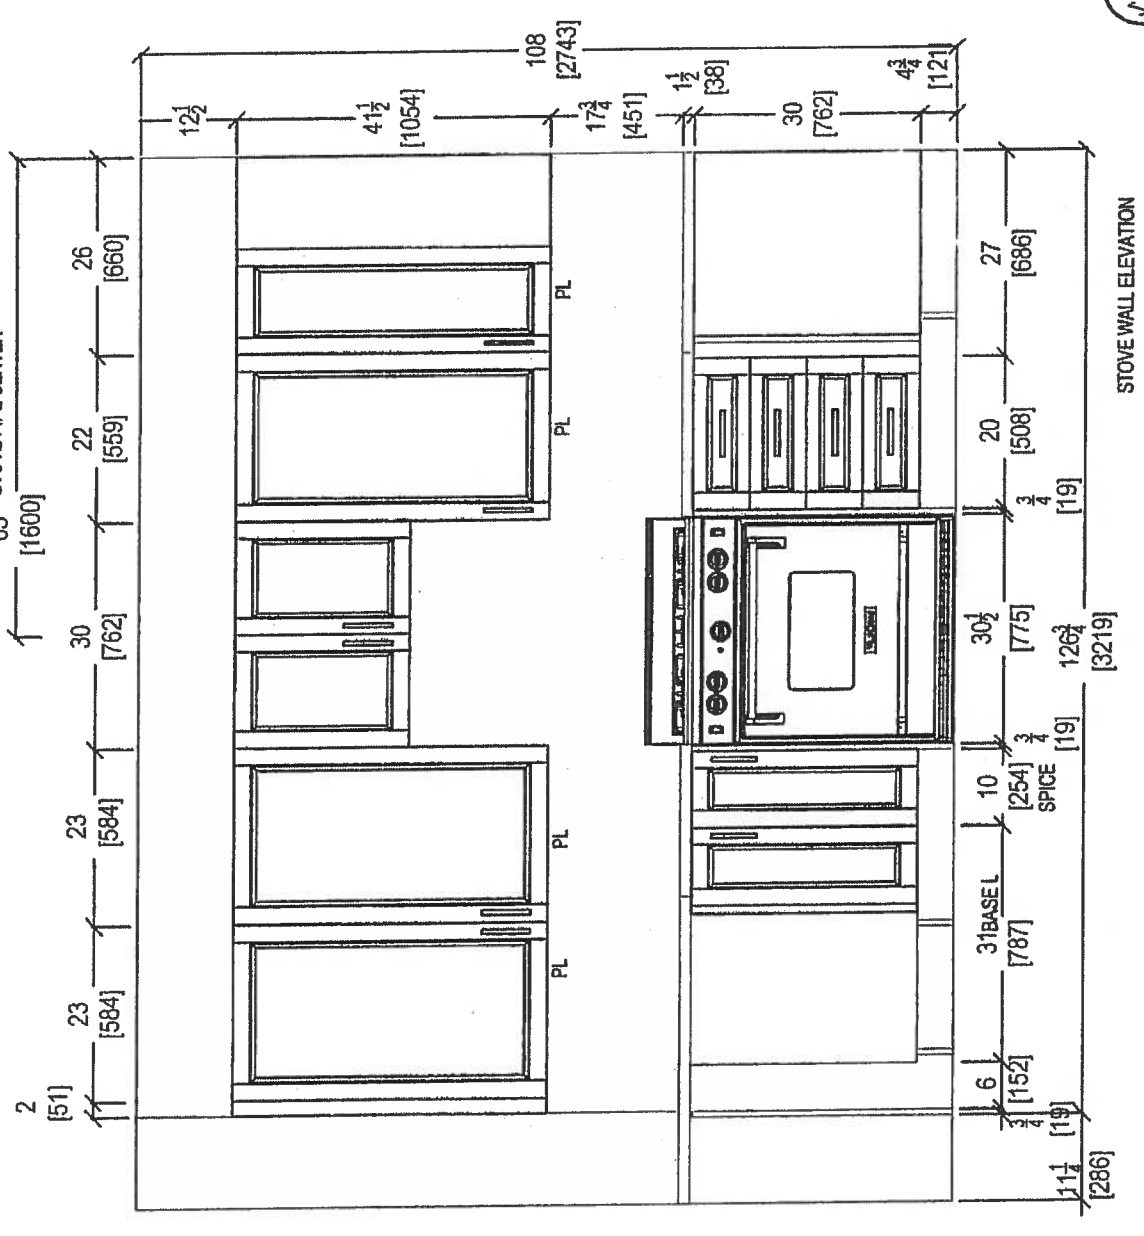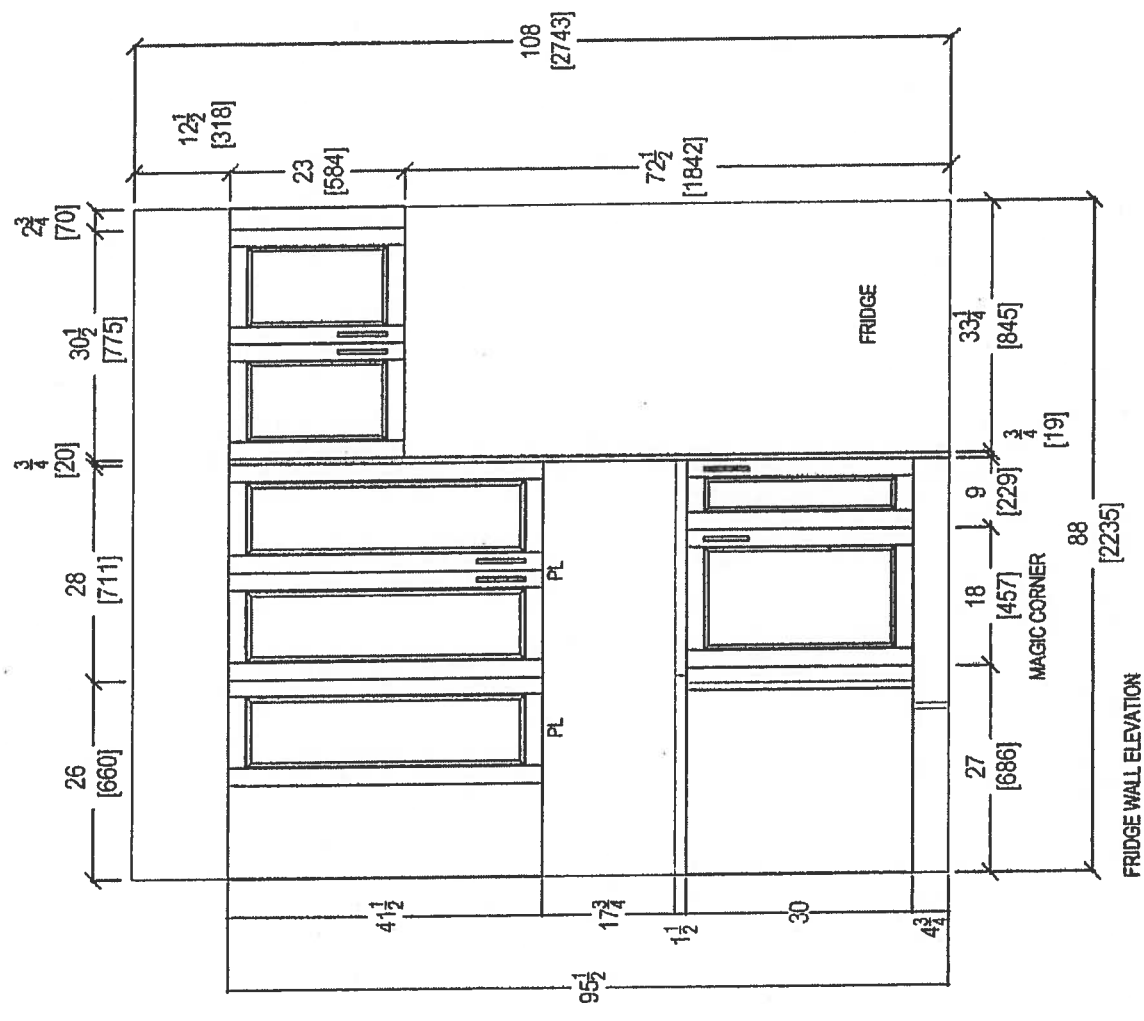


80 SANTE DRIVE, VAUGHAN, ON L4K 3C4,
T: 416.746.1811 F: 905.761.5901

CLIENT: ROYAL PINE HOMES	JOB NAME: FLANDERS 2E UPGRADE PKG 1	ROOM: KITCHEN	DRAWN BY: SK
SITE: HAMPTON PLACE	LOT #:	DOOR HANDLE: —	SCALE: 1/2" = 1' - 0"
PHONE: —	FINISH: —	DRW HANDLE: —	DATE: AUG 4, 2017
EMAIL: —	SPECIES: —	TOP: —	PAGE: —

COMMENTS:

PLEASE NOTE ALL DIMENSIONS
ARE NOT FINAL AND ARE
SUBJECT TO CHANGE UPON
FINAL SITE MEASURE

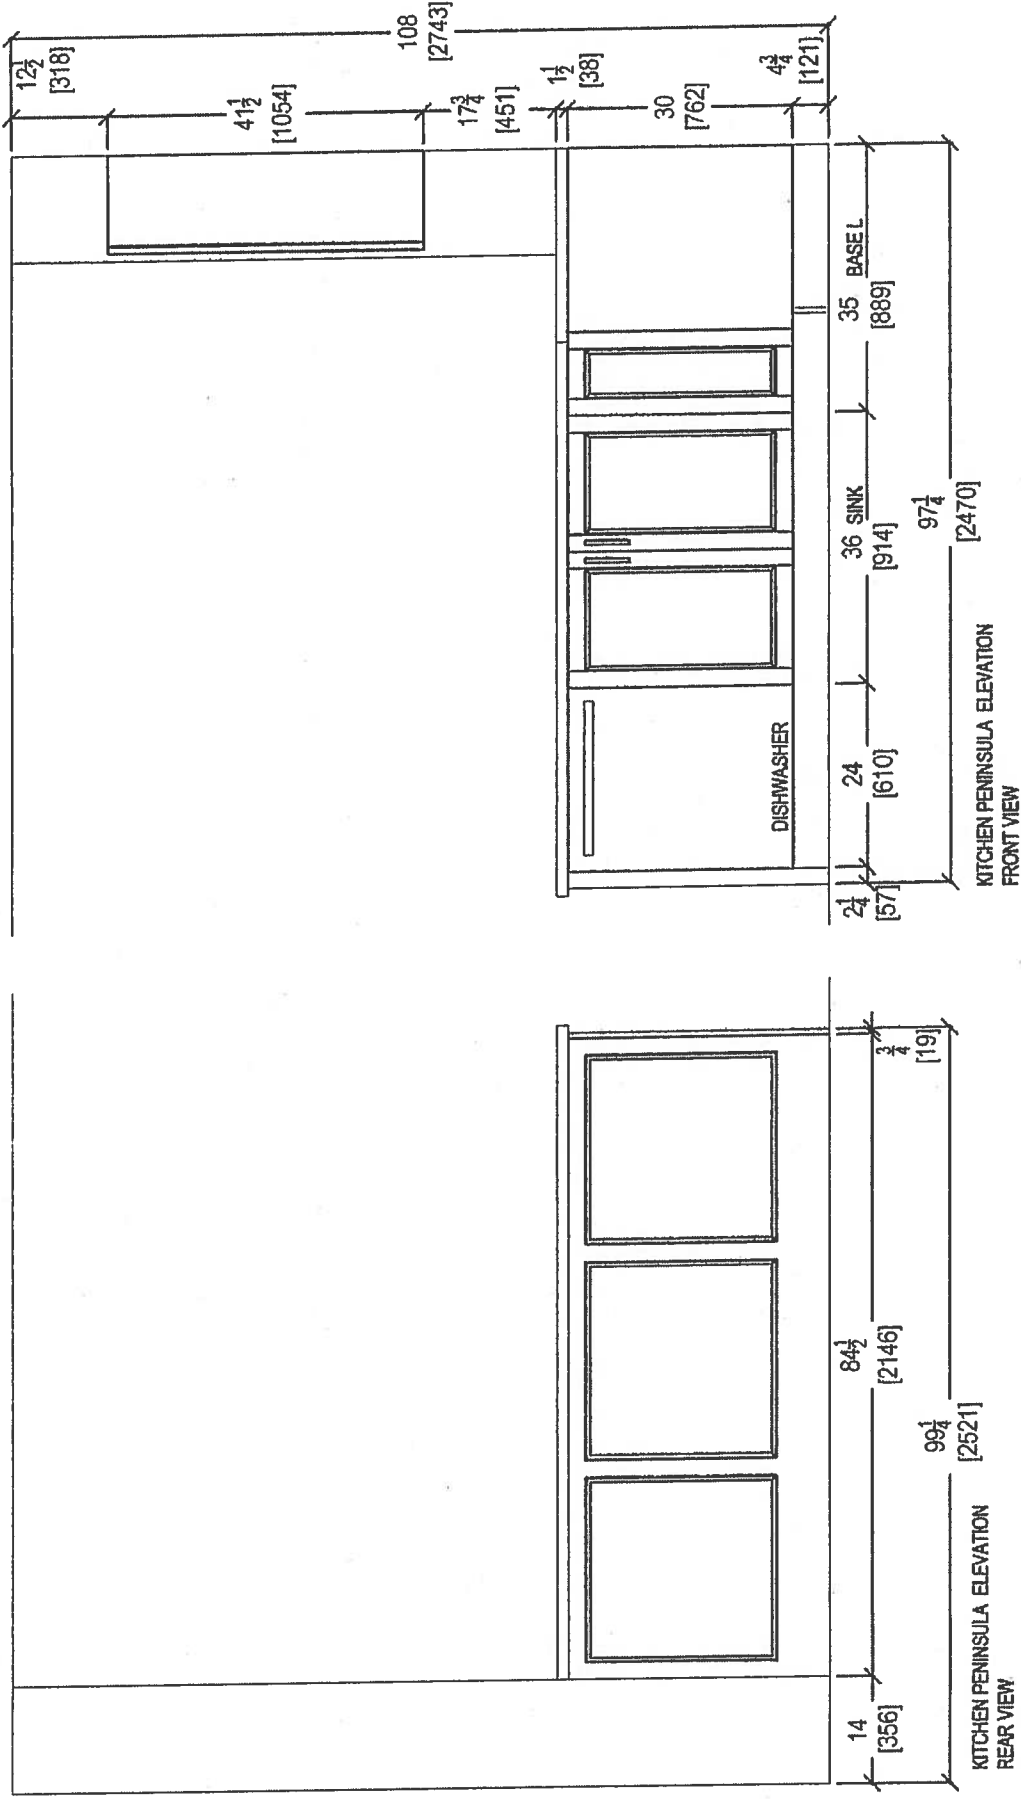


Handwritten signature/initials.

CLIENT: ROYAL PINE HOMES		JOB NAME: FLANDERS 2E UPGRADE PKG 1	ROOM: KITCHEN	DRAWN BY: SK	COMMENTS: PLEASE NOTE ALL DIMENSIONS ARE NOT FINAL AND ARE SUBJECT TO CHANGE UPON FINAL SITE MEASURE
SITE: HAMPTON PLACE	LOT #:		DOOR HANDLE: —	SCALE: 1/2" = 1' - 0"	
PHONE: —	FINISH: —		DRW HANDLE: —	DATE: AUG 4, 2017	
EMAIL: —	SPECIES: —		TOP: —	PAGE: —	





80 SANTE DRIVE, VAUGHAN, ON L4K 3C4,
T: 416.746.1811 F: 905.781.5901

* Install 3" Splash *

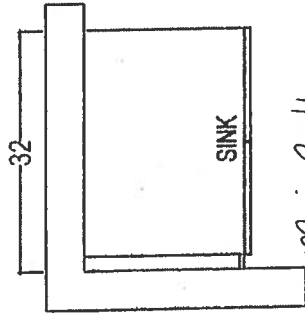

Main Bath
*Raised Height

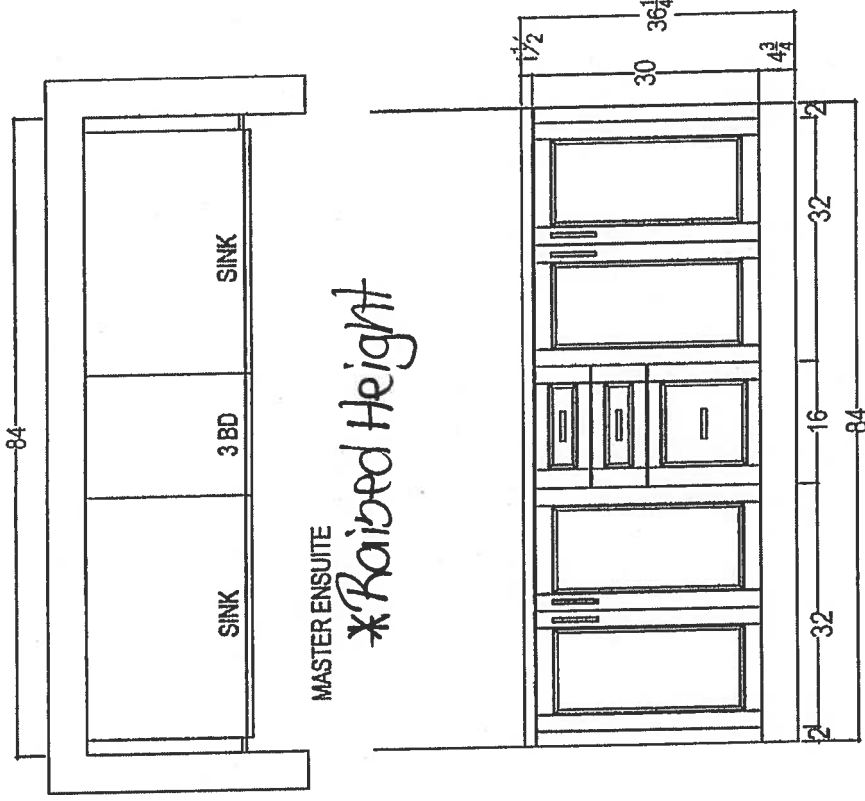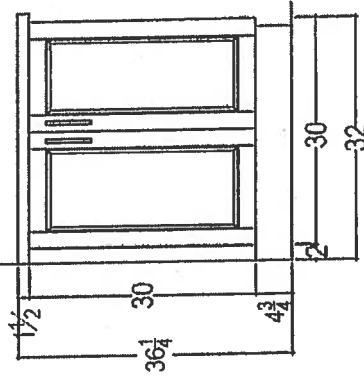

MASTER ENSUITE
*Raised Height

Handwritten signature.



80 SANTE DRIVE, VAUGHAN, ON L4K 3C4.
T: 416.746.1811 F: 905.761.5601

 your kitchen, our life. 80 SANTE DRIVE, VAUGHAN, ON L4K 3C4, T: 416.746.1811 F: 905.761.5801		CLIENT: ROYAL PINE HOMES		JOB NAME: FLANDERS 2E UPGRADE PKG 1		ROOM:		VANITIES		DRAWN BY: SK		COMMENTS: PLEASE NOTE ALL DIMENSIONS ARE NOT FINAL AND ARE SUBJECT TO CHANGE UPON FINAL SITE MEASURE
SITE: HAMPTON PLACE		LOT #:		DOOR HANDLE: —		SCALE: 1/2" = 1' - 0"						
PHONE: —		FINISH: —		DRW HANDLE: —		DATE: AUG 4, 2017						
EMAIL: —		SPECIES: —		TOP: —		PAGE: —						

Suite 525 Hampton

DL

WRT318FZDM

Standard



<http://www.whirlpool.com>

30-inch Wide Top-Freezer Refrigerator with
Flexi-Slide™ Bin - 18.2 cu. ft.

Key Features:

- Flexi-Slide™ Bin
- Frameless Glass Shelves
- Electronic Temperature Control
- Clear, Humidity Controlled Crispers

Product Dimensions:

Height: 65 7/8

Width: 29 3/4

Depth: 33 1/2


Additional Information:

[Use And Care Guide](#)

[Dimension Guide](#)

[Energy Guide](#)

[Warranty Certificate](#)

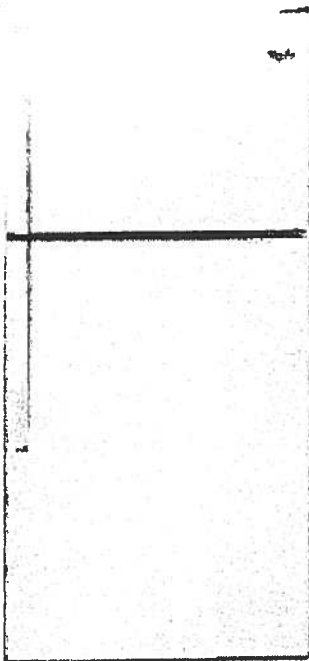

Available in:

- Black
- Monochromatic
- Stainless Steel
- White




©Registered trademark/TM Trademark of Whirlpool, U.S.A. © 2013 Whirlpool Corporation. All Rights Reserved
All other trademarks are owned by their respective companies
Because Whirlpool Corporation policy includes a continuous commitment to improve our products, we reserve
the right to change materials and specifications without notice. We also reserve the right to discontinue or
transition products without notice.
Manufacturer's Suggested Retail Price (MSRP) and Minimum Advertised Price (MAP) provided for reference
purposes only. Dealer alone determines advertised and retail prices.
Created On: Monday, March 14, 2016 12:09:07

Suite 525
Hampton

Standard

Handwritten initials: HLL

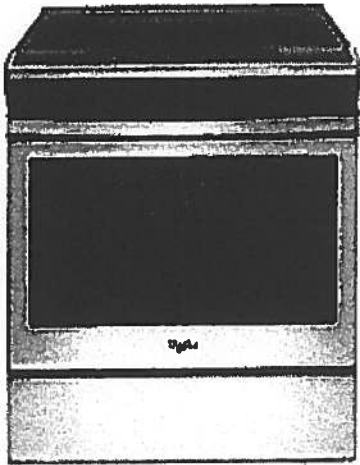

WEE510S0FS

Whirlpool® 4.8 cu. ft. Guided Electric Front Control Range
With The Easy-Wipe Ceramic Glass Cooktop

MSRP: \$1,149.00

Available Colors	
☒	Black Model: WEE510S0FB MAJOR APPLIANCE
☒	Black-on-Stainless Model: WEE510S0FS MAJOR APPLIANCE
☐	White Model: WEE510S0FW MAJOR APPLIANCE

Dimensions	
Depth	28 15/16 Inches
Width	29 7/8 Inches
Gross Weight	172 LB
Dimensions shown are for planning purposes only. For complete information, see Installation Instructions packed with product.	

Specifications	
Cooktop Features	
Cooktop Element Style	Smoothtop
Cooktop Surface Color	Color Coordinated Black on Stainless
Cooktop Surface Material	Glass
Number of Cooking Element-Burners	4
Left Front Element-Burner Power	3000W
Left Front Element-Burner Size	9"6"
Left Front Element-Burner Type	Dual
Right Front Element-Burner Power	1200W
Left Rear Element-Burner Size	6"
Left Rear Element-Burner Type	Radiant
Right Front Element-Burner Power	3000W
Right Front Element-Burner Size	9"6"
Right Front Element-Burner Type	Dual
Right Rear Element-Burner Power	1200W
Right Rear Element-Burner Size	6"
Right Rear Element-Burner Type	Radiant
Oven Features	
Number of Oven Lights	1
Hot Surface Indicator Light	Yes
Power On Indicator Light	Yes
Light Type	Incandescent
Oven Rack Type	Standard (Both)
Controls	
Drawer Type	Storage Drawer
Selections	Clock; Timer; Warm Hold; Delay Start; Cook Time Indicator; Control Lock; Automatic Door Latch; Audible Signal; Sabbath Mode; Frozen Bake
ADA Compliant	ADA Height and Operation Compliant
Dimensions	
Depth	28 15/16 Inches
Width	29 7/8 Inches
General	
ADA Compliant	ADA Height and Operation Compliant

Key Features
Frozen Bake™ Technology
Guided Cooktop Controls
FlexHeat™ Dual Radiant Elements
Adjustable Self-Cleaning
Easy-Wipe Ceramic Glass Cooktop
Temperature Sensor
4.8 Cu. Ft. Capacity
Keep Warm Option
Closed Door Broiling
Delay Cook
Sabbath Mode
Star-K Certified
ADA Compliant
#1 Selling Appliance Brand in the U.S.A.

Product Literature
Warranty(33.12 KB)
Owners Manual(502.10 KB)
Installation Instructions(995.40 KB)
Dimension Guide(124.36 KB)
You may need to install Adobe Acrobat Reader to view these documents.

UPC Listing
Model "WEE510S0FB" UPC: 883049391939
Model "WEE510S0FS" UPC: 883049391946
Model "WEE510S0FW" UPC: 883049391922

Suite 525 Standard Hampton

OK

WMH31017FS

Whirlpool®

1.7 cu. ft. Microwave Hood Combination with
Electronic Controls

<http://www.whirlpool.com>

Key Features:

- Microwave Presets
- Electronic Touch Controls
- Dishwasher-Safe Turntable Plate
- 2-Speed, 300 CFM Vent Fan
- Add 30 Seconds Option
- Adjustable Cooktop Lighting
- #1 Selling Appliance Brand in the U.S.A.

Product Dimensions:

Height: 17 1/4

Width: 29 15/16

Depth: 17 7/8


Additional Information:

[Use And Care Guide](#)

[Dimension Guide](#)

[Installation Guide](#)

[Warranty Certificate](#)

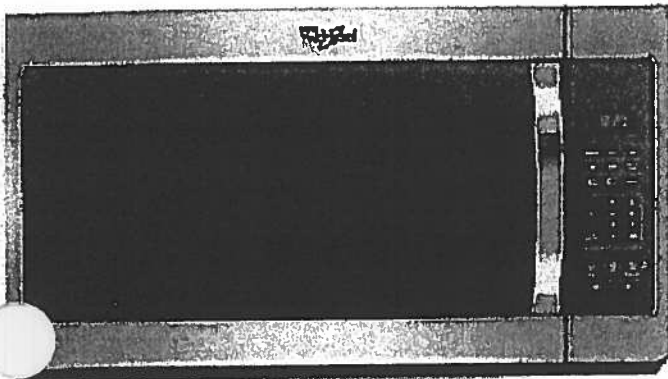

Available in:

- ☒ Black
- ☐ Silver
- ☐ Stainless Steel
- ☐ White

©Registered trademark/TM Trademark of Whirlpool, U.S.A. © 2016 Whirlpool Corporation. All Rights Reserved.
All other trademarks are owned by their respective companies.
Because Whirlpool Corporation policy includes a continuous commitment to improve our products, we reserve the right to change materials and specifications without notice. We also reserve the right to discontinue or transition products without notice.
Manufacturer's Suggested Retail Price (MSRP) and Minimum Advertised Price (MAP) provided for reference purposes only. Dealer alone determines advertised and retail prices.
Created On: Tuesday, February 07, 2017 12:20:03

Suite 525
Hampton

Standard

Handwritten signature

WDF330PAHS

Whirlpool®

<http://www.whirlpool.com>

Heavy-Duty Dishwasher with 1-hour Wash Cycle

Key Features:

- 1-Hour Wash Cycle
- No One Has Fewer Repairs 20 Years in a Row
- Soil Sensor
- Normal Cycle
- Heavy Cycle
- High Temperature Wash Option
- Heated Dry Option
- Designed, Engineered and Assembled in the U.S.A. with American Pride

Product Dimensions:

Height: 34 1/2

Width: 23 7/8

Depth: 24 1/2

Additional Information:


[Use And Care Guide](#)

[Dimension Guide](#)

[Installation Guide](#)

[Energy Guide](#)

[Warranty Certificate](#)

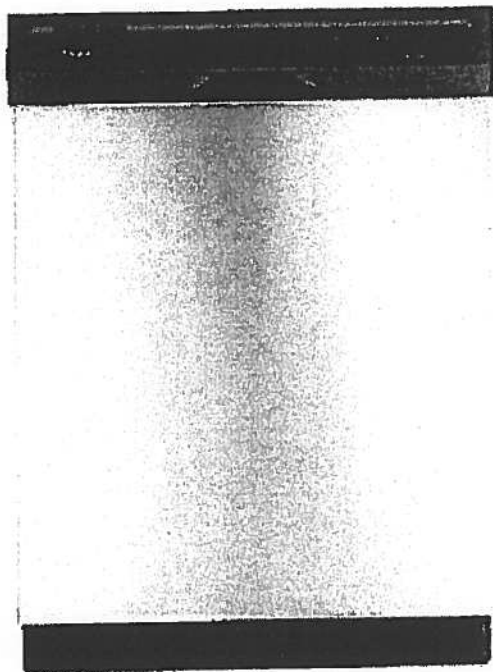

INVESTED
IN
AMERICA



©Registered trademark/TM Trademark of Whirlpool, U.S.A. © 2016 Whirlpool Corporation. All Rights Reserved.
All other trademarks are owned by their respective companies.
Because Whirlpool Corporation policy includes a continuous commitment to improve our products, we reserve the right to change materials and specifications without notice. We also reserve the right to discontinue or transition products without notice.
Manufacturer's Suggested Retail Price (MSRP) and Minimum Advertised Price (MAP) provided for reference purposes only. Dealer alone determines advertised and retail prices.
Created On: Wednesday, April 19, 2017 10:48:05

Suite 525 Standard Hampton

OK

WET4027EW



<http://www.whirlpool.com>

Combination Washer/Electric Dryer

Key Features:

- HE Agitator with Fabric Softener Cap
- White Porcelain Basket
- AutoDry™ Drying System
- 3 Drying Temperatures
- 2.5 Cu. Ft. Washer Capacity
- 5.9 Cu. Ft. Dryer Capacity
- Fabric Softener Dispenser
- Bleach Dispenser

Product Dimensions:

Height: 71 3/4

Width: 27 1/2

Depth: 32

Electrical Requirements:

30.

Additional Information:

[Use And Care Guide](#)

[Dimension Guide](#)

[Installation Guide](#)

[Energy Guide](#)

[Warranty Certificate](#)

Available in:

☐ White

INVESTED
IN
AMERICA



®Registered trademark/™ Trademark of Whirlpool, U.S.A. © 2013 Whirlpool Corporation. All Rights Reserved
All other trademarks are owned by their respective companies.

Because Whirlpool Corporation policy includes a continuous commitment to improve our products, we reserve the right to change materials and specifications without notice. We also reserve the right to discontinue or transition products without notice.


Manufacturer's Suggested Retail Price (MSRP) and Minimum Advertised Price (MAP) provided for reference purposes only. Dealer alone determines advertised and retail prices.

Created On: Friday, March 11 2016 12:26:17

Standard




Suite 525
Hampton

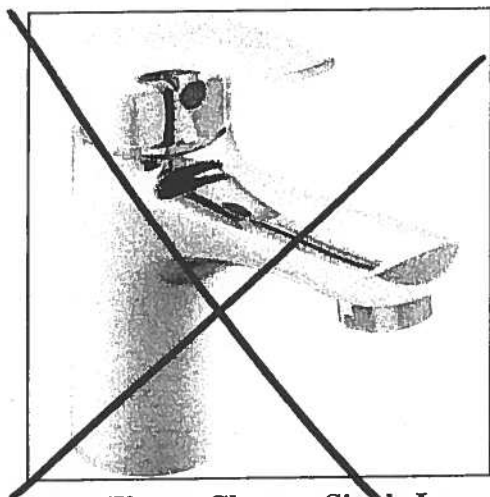


Delta Wynne Chrome Single Lever
Lavatory Faucet With Pop Up
#534LF

* MASTER ENSUITE *

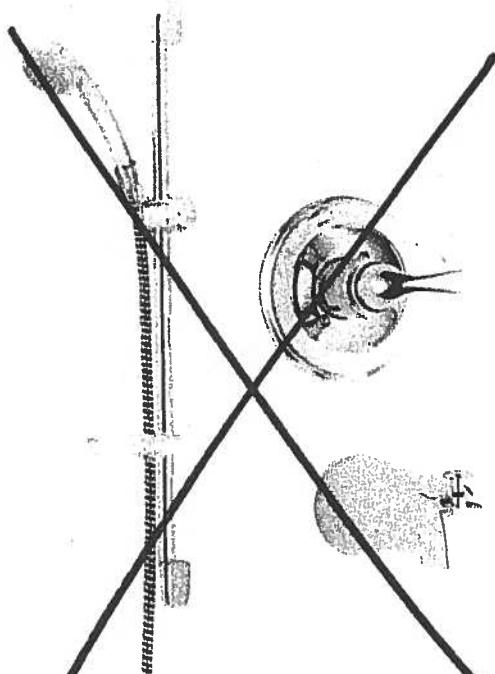

Delta Shower Trim with Tub Spout and
Hansgrohe Slide Bar with Handheld
#R10000/T13020-CDN/2001-TP/27454002/
27744000

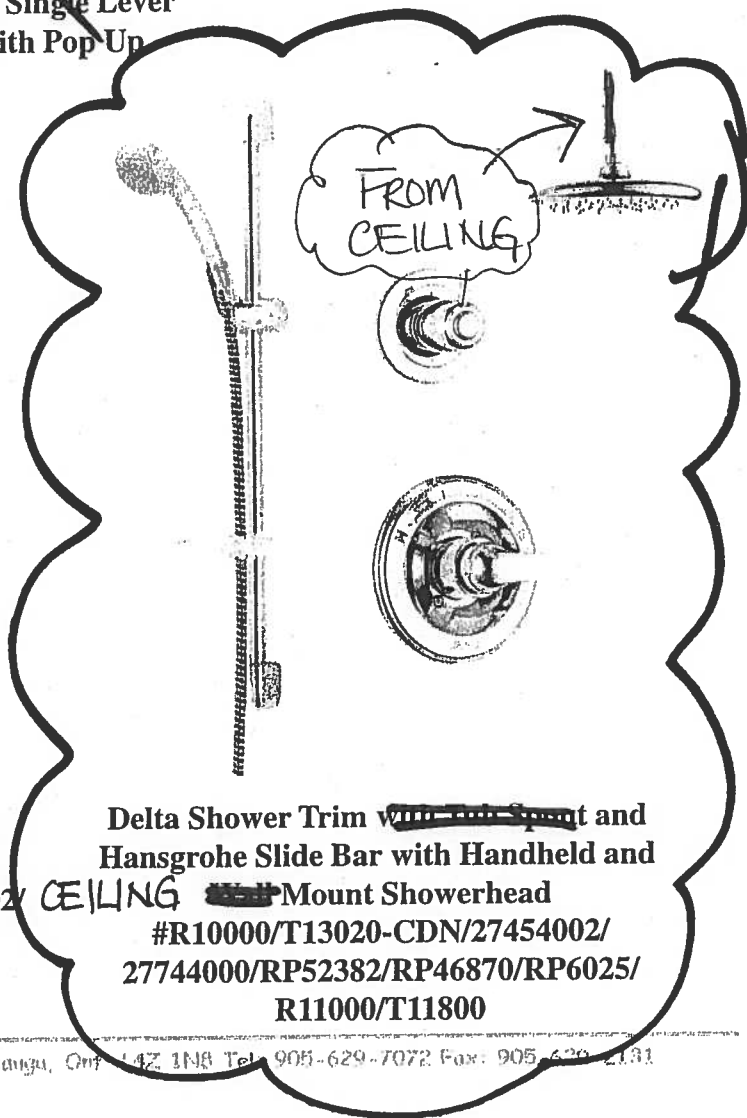


Delta Shower Trim with ~~Tub Spout~~ and
Hansgrohe Slide Bar with Handheld and
CEILING ~~Mount~~ Showerhead
#R10000/T13020-CDN/27454002/
27744000/RP52382/RP46870/RP6025/
R11000/T11800


Countertop Edges
Suite 525
Hampton

PHL


CONNOLLY Marble & Granite Ltd.	EDGE DETAILS 004
---------------------------------------	------------------------------------

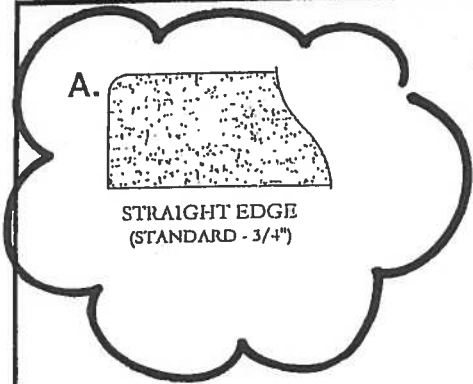

Standard:
Kitchen
Main Bath
Master Ensuite

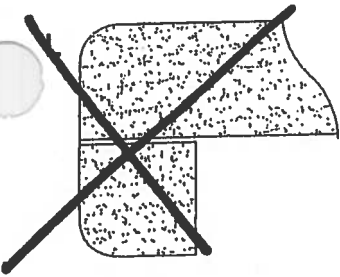

DOUBLE TOP "D" EDGE
(STANDARD - 1 1/2")

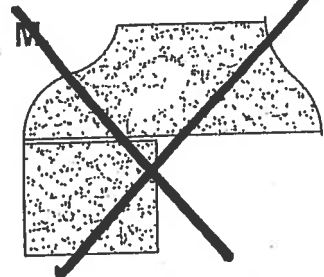

OGEE - SQUARE EDGE
(MED./HIGH - 1 1/2")

EDGING UP-GRADE OPTIONS