
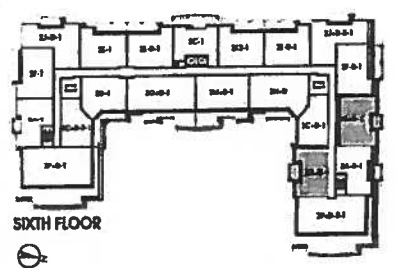
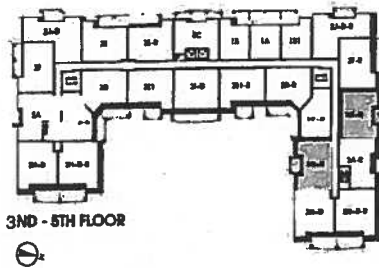
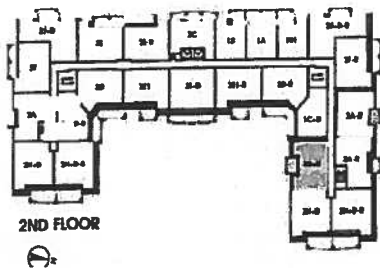


Noyac Bay

1,121 SQ FT *plus* 76 sq. ft. of balcony area

SUITE 311
ORIGINAL LAYOUT
INVENTORY SUITE

NEW.

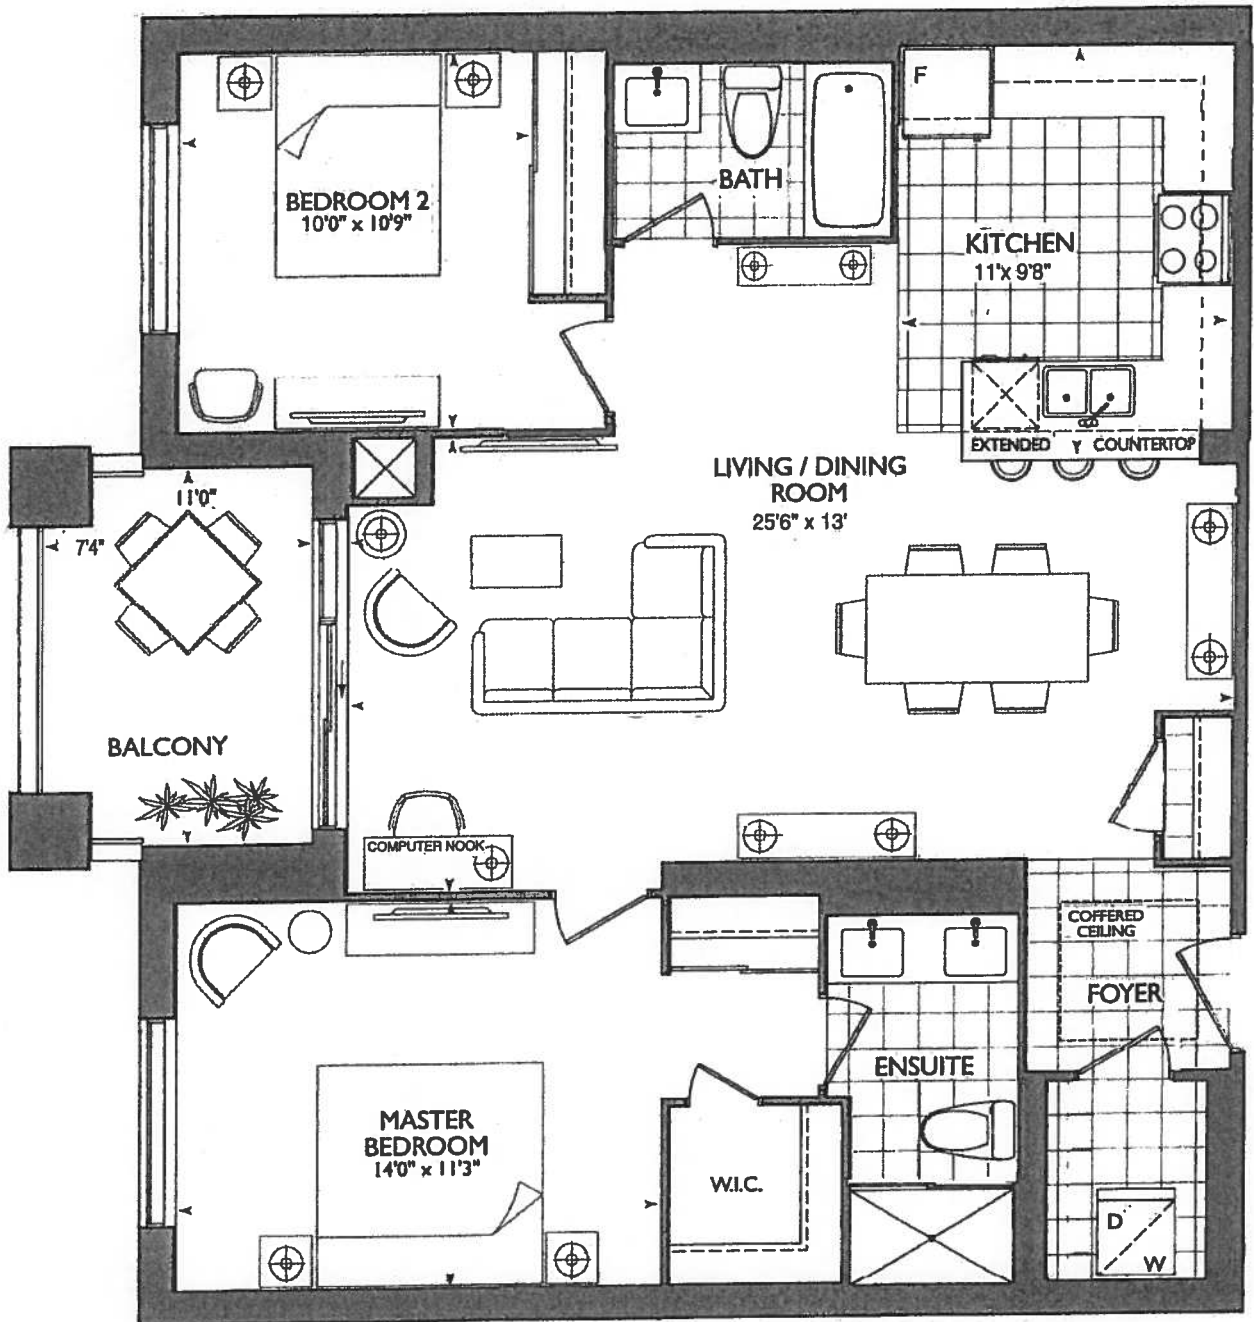

Plans and specifications are subject to change without notice. Actual usable floor space may vary from the stated floor area. All renderings are artist's concept E. & O. E.



* KITCHEN *

CHOICE OF STD. KITCHEN LAYOUT WITH
STD. APPLIANCE PACKAGE

OR

CAN UPGRADE AT DECOR CENTER

- (x2) CAPPED PENDANT
- (x1) PLUG PENINSULA
- (x) PUCK LIGHTS


*SEE ATTACHED UPG.

#1- KITCHEN LAYOUT WITH 1ST UPG.
APPLIANCE PACKAGE

* SUITE 311 * (INVENTORY SUITE)


- NEW PLAN
- REMOVED DEN
- REVISED KITCHEN

*REVISED LAUNDRY DOOR SWING &
ENSUITE WALL AS PER THIS BROCHURE

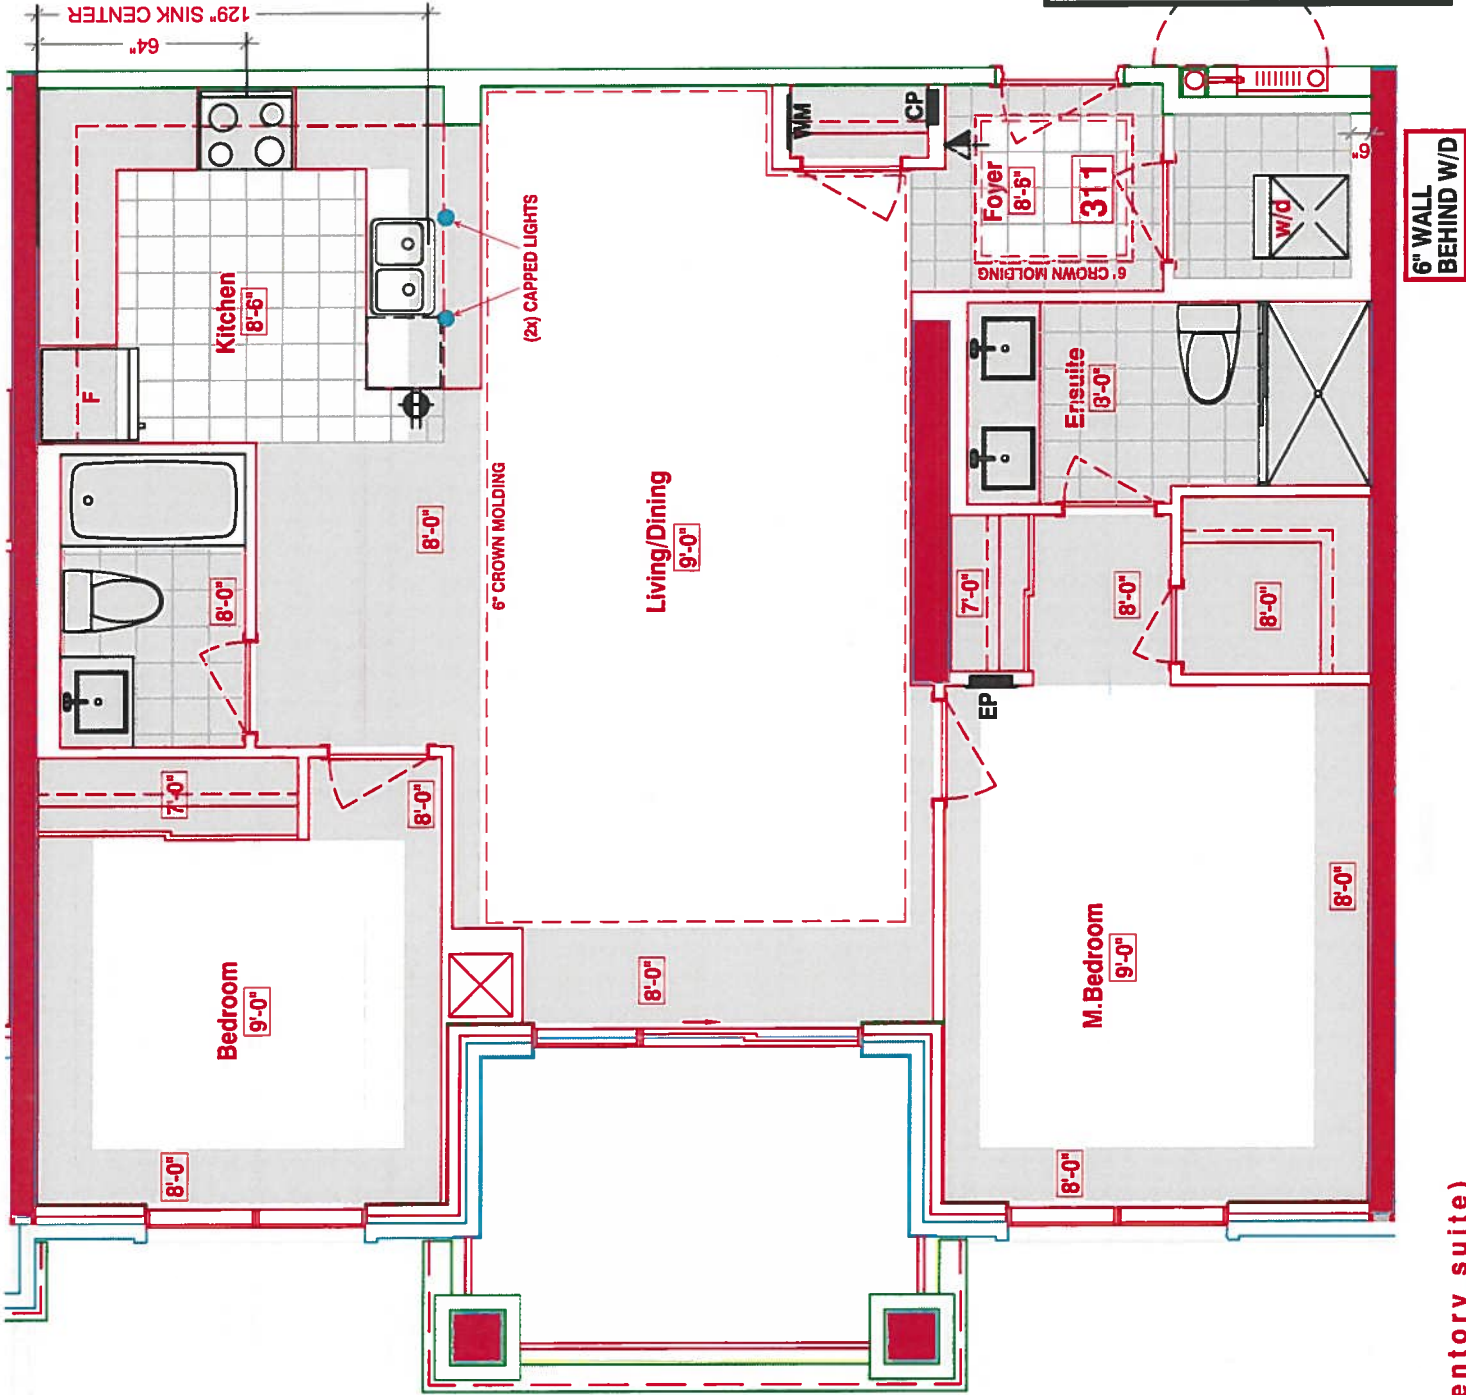

311


- STD KITCHEN LAYOUT
- STD APPLIANCE PKQ.
- (x1) = PLUG PENINSULA
- (x5) = PUCK LIGHTS
- (x2) = CAPPED PENDANT LIGHTS OVER PENINSULA

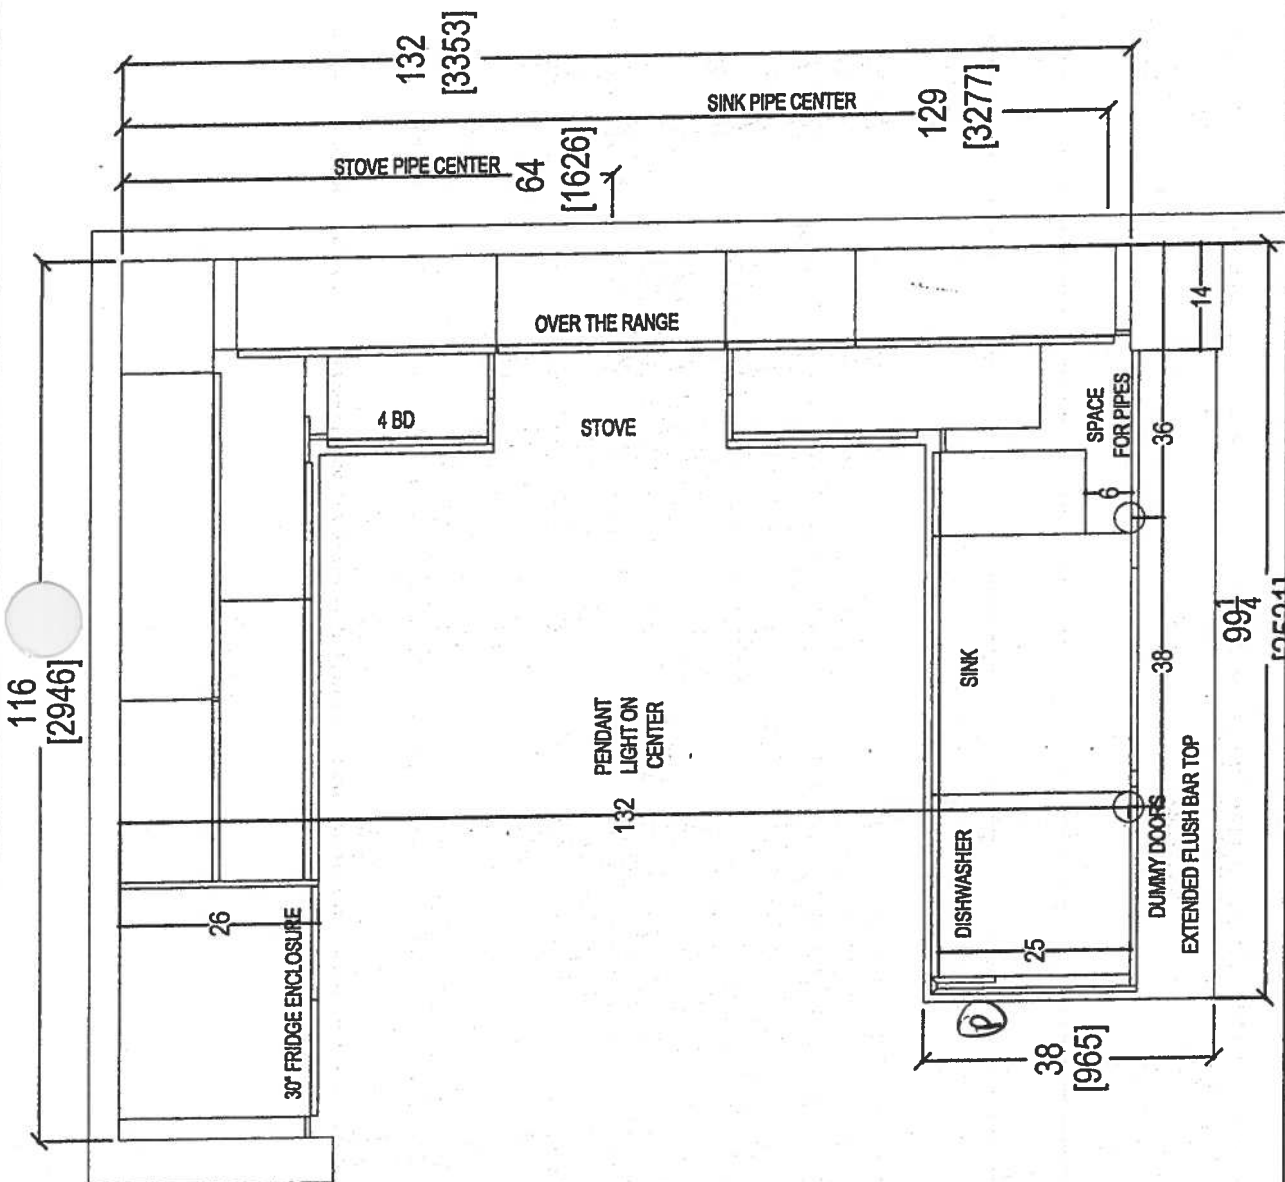

 <i>your kitchen, your taste.</i> 80 SANTE DRIVE, VAUGHAN, ON L4K 3C4, T: 416.748.1811 F: 905.761.5901				CLIENT: ROYAL PINE HOMES		NOYAC BAY (2G)		ROOM: KITCHEN FLOOR PLAN		DRAWN BY: SK		COMMENTS: PLEASE NOTE ALL DIMENSIONS ARE NOT FINAL AND ARE SUBJECT TO CHANGE UPON FINAL SITE MEASURE	
SITE: HAMPTON PLACE		DOOR STYLE: —		DOOR HANDLE: —		SCALE: 1/2" = 1'-0"							
PHONE: —		FINISH: —		DRW HANDLE: —		DATE: MARCH 8, 2018							
EMAIL: —		SPECIES: —		TOP: —		PAGE: —							




80 SANTE DRIVE, VAUGHAN, ON L4K 3C4,
T: 416.748.1811 F: 905.781.5901

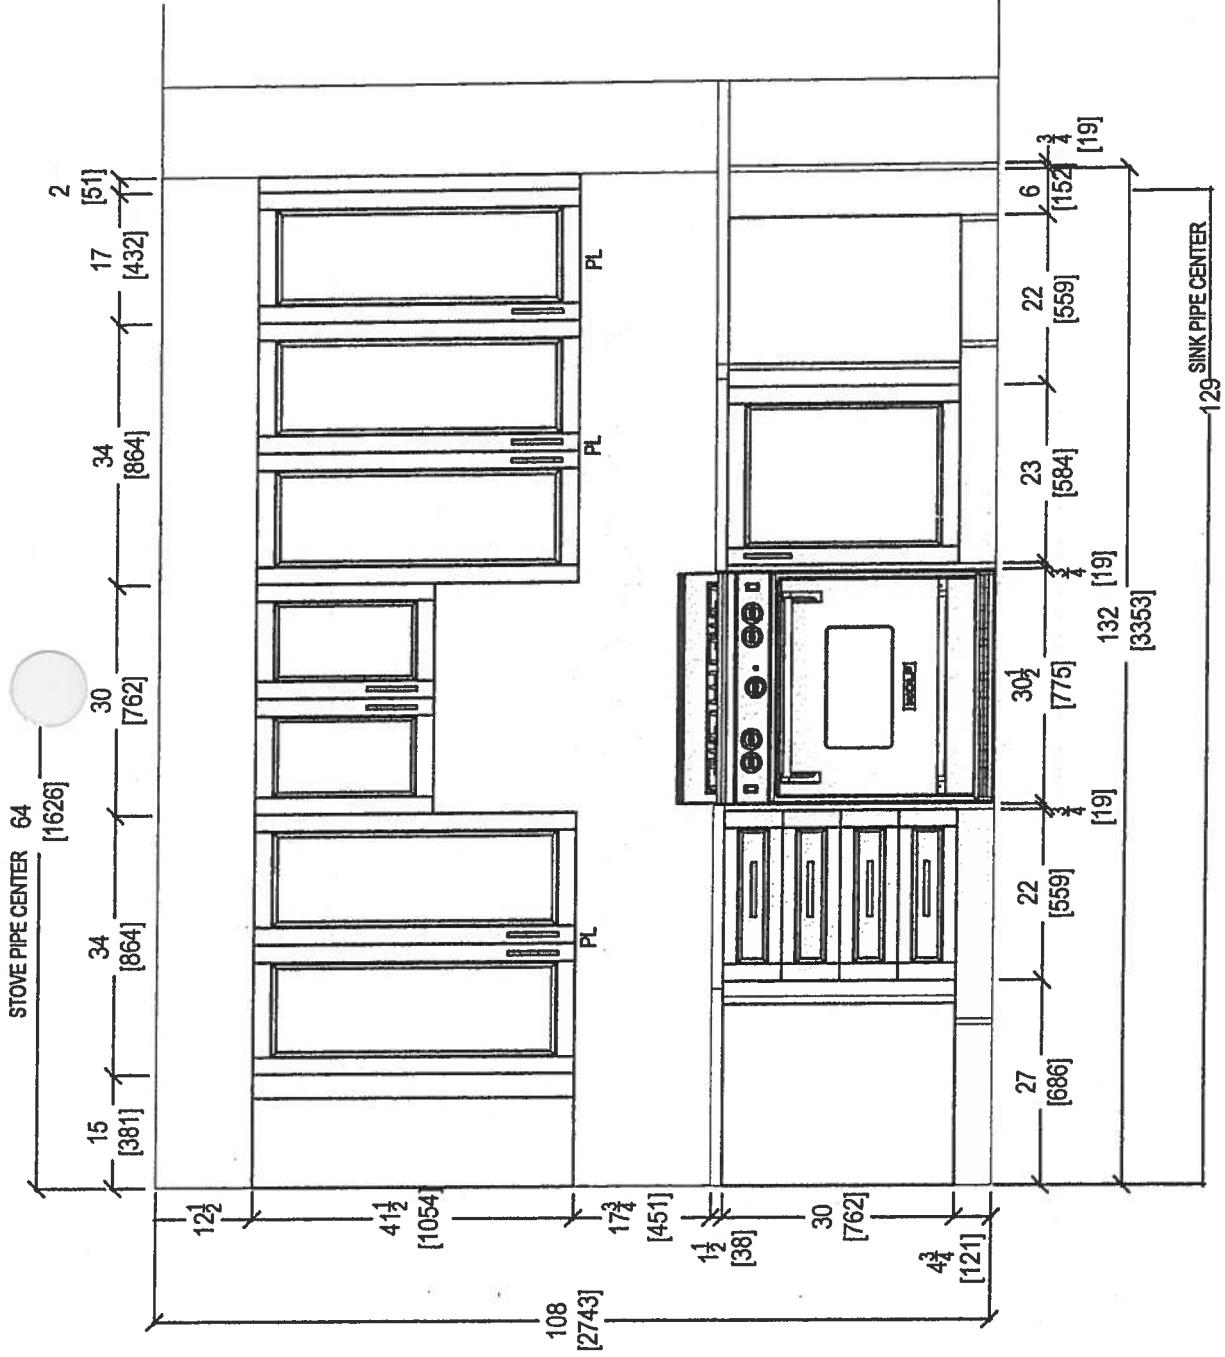



STOVE WALL ELEVATION

 your kitchen, your taste. 80 SANTE DRIVE, VAUGHAN, ON L4K 3C4, T: 416.746.1811 F: 905.761.5801	CLIENT: ROYAL PINE HOMES	NOYAC BAY (2G)	ROOM: KITCHEN	DRAWN BY: SK	COMMENTS: PLEASE NOTE ALL DIMENSIONS ARE NOT FINAL AND ARE SUBJECT TO CHANGE UPON FINAL SITE MEASURE
	SITE: HAMPTON PLACE	DOOR STYLE: —	DOOR HANDLE: —	SCALE: 1/2" = 1' - 0"	
	PHONE: —	FINISH: —	DRW HANDLE: —	DATE: MARCH 8, 2018	
	EMAIL: —	SPECIES: —	TOP: —	PAGE: —	

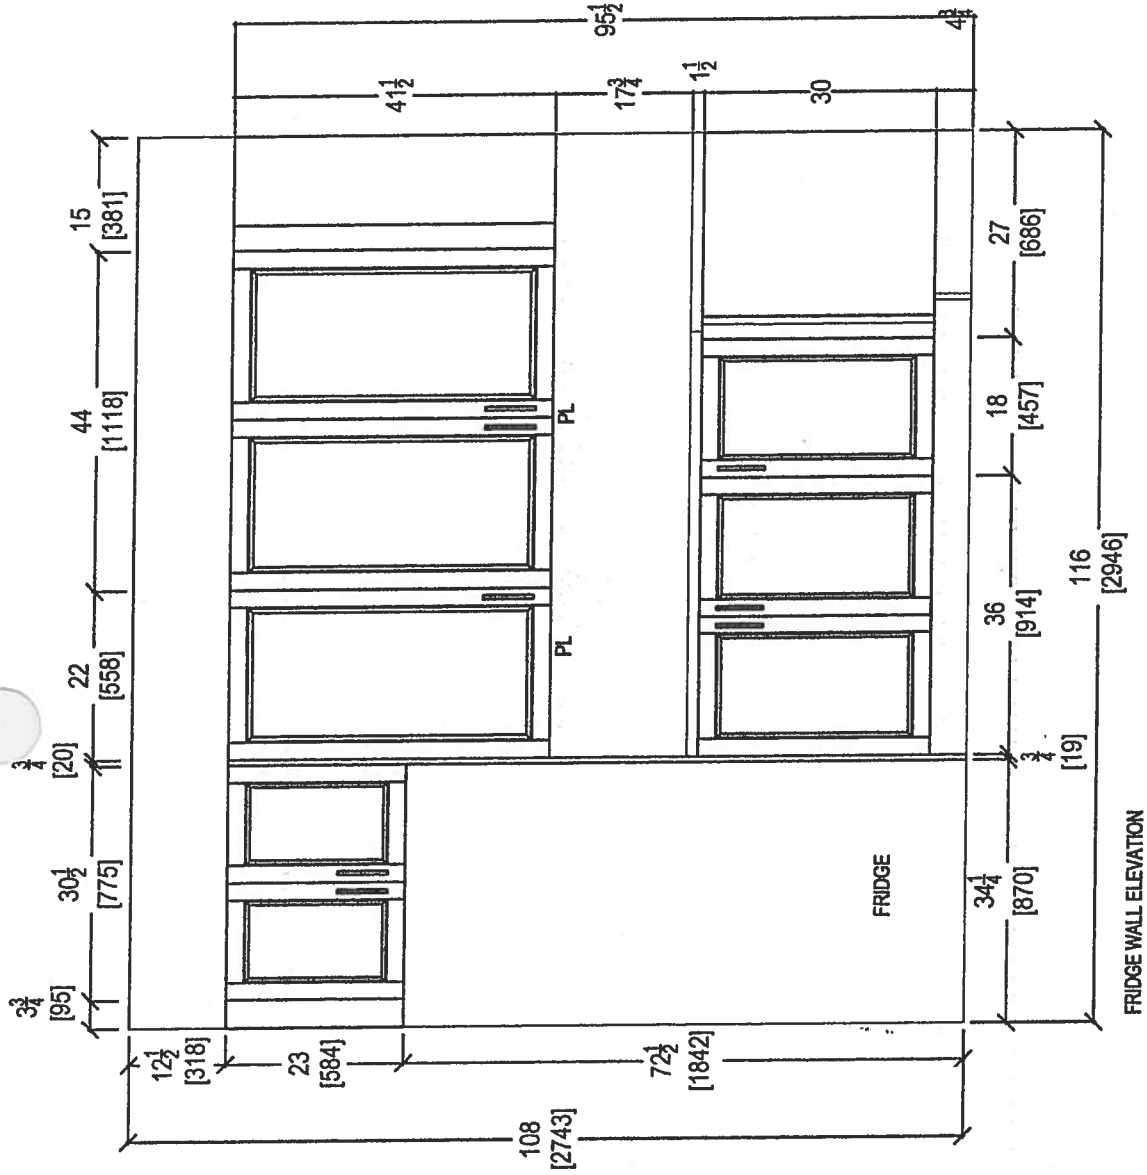

your kitchen, your taste
80 SANTE DRIVE, VAUGHAN, ON L4K 3C4,
T: 416.746.1811 F: 905.761.5801

CLIENT: ROYAL PINE HOMES	NOYAC BAY (2G)	ROOM: KITCHEN	DRAWN BY: SK		COMMENTS: PLEASE NOTE ALL DIMENSIONS ARE NOT FINAL AND ARE SUBJECT TO CHANGE UPON FINAL SITE MEASURE
SITE: HAMPTON PLACE	DOOR STYLE: ---	DOOR HANDLE: ---	SCALE: 1/2" = 1'-0"		
PHONE: ---	FINISH: ---	DRW HANDLE: ---	DATE: MARCH 8, 2018		
EMAIL: ---	SPECIES: ---	TOP: ---	PAGE: ---		

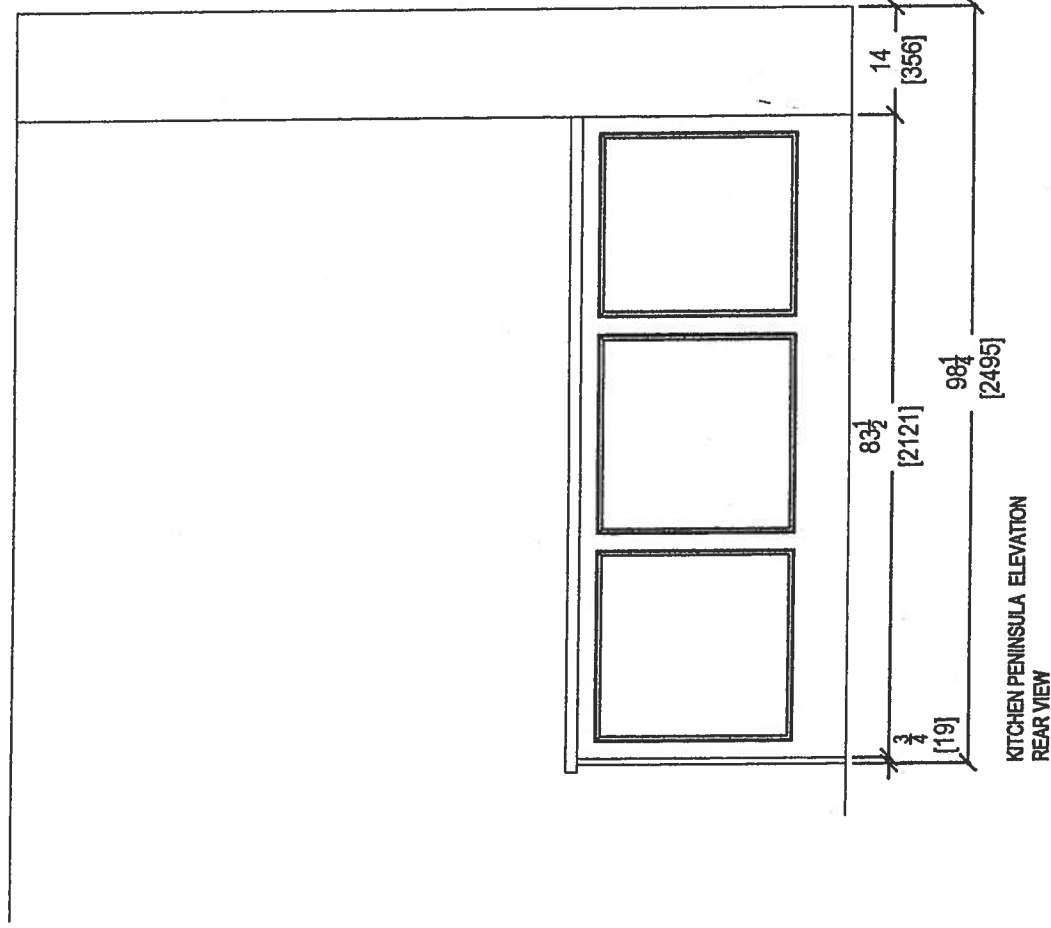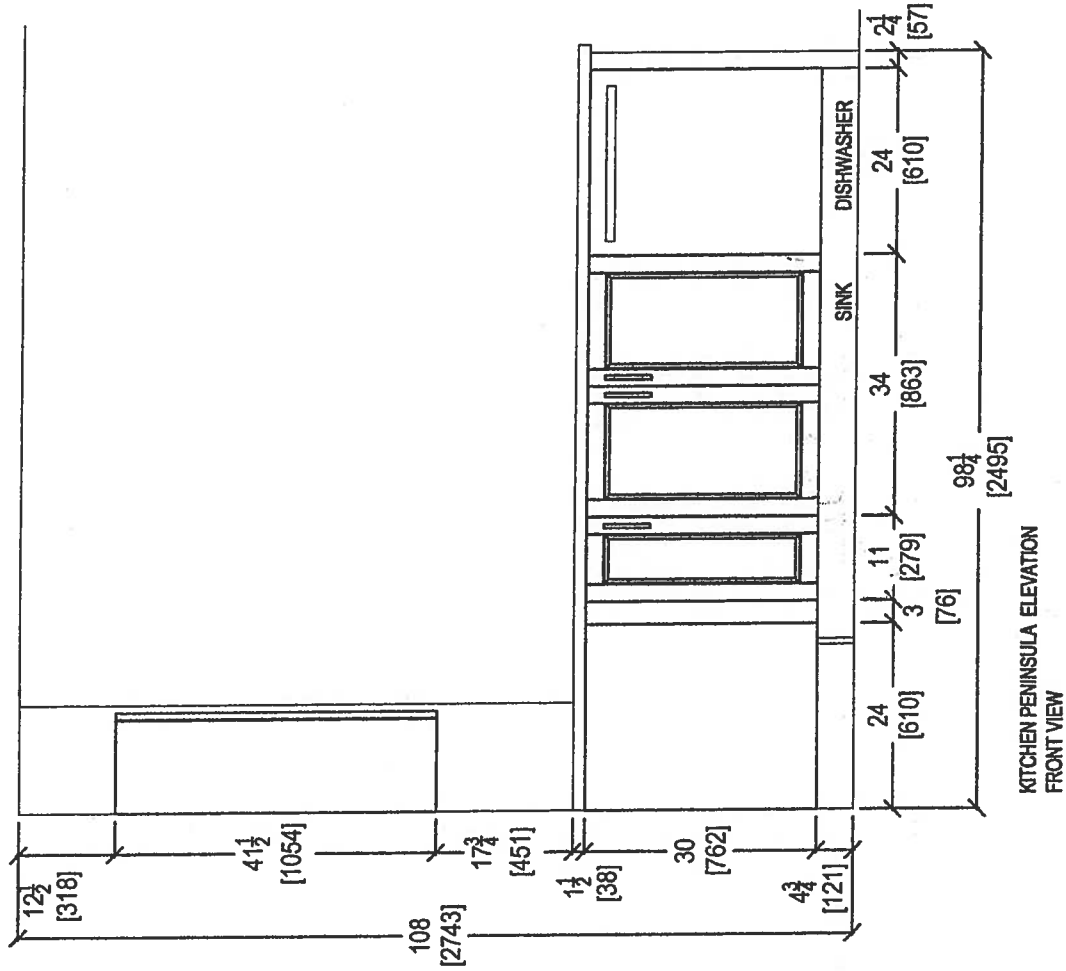

80 SANTE DRIVE VAUGHAN, ON L4K 3C4,
T: 416.746.1811 F: 905.761.5601

CLIENT: ROYAL PINE HOMES

SITE: HAMPTON PLACE

PHONE: —

EMAIL: —

NOYAC BAY (2G)

DOOR STYLE: —

FINISH: —

SPECIES: —

ROOM: KITCHEN

DOOR HANDLE: —

DRW HANDLE: —

TOP: —

DRAWN BY: SK


SCALE: 1/2" = 1' - 0"

DATE: MARCH 8, 2018


PAGE: —

COMMENTS:

PLEASE NOTE ALL DIMENSIONS
ARE NOT FINAL AND ARE
SUBJECT TO CHANGE UPON
FINAL SITE MEASURE

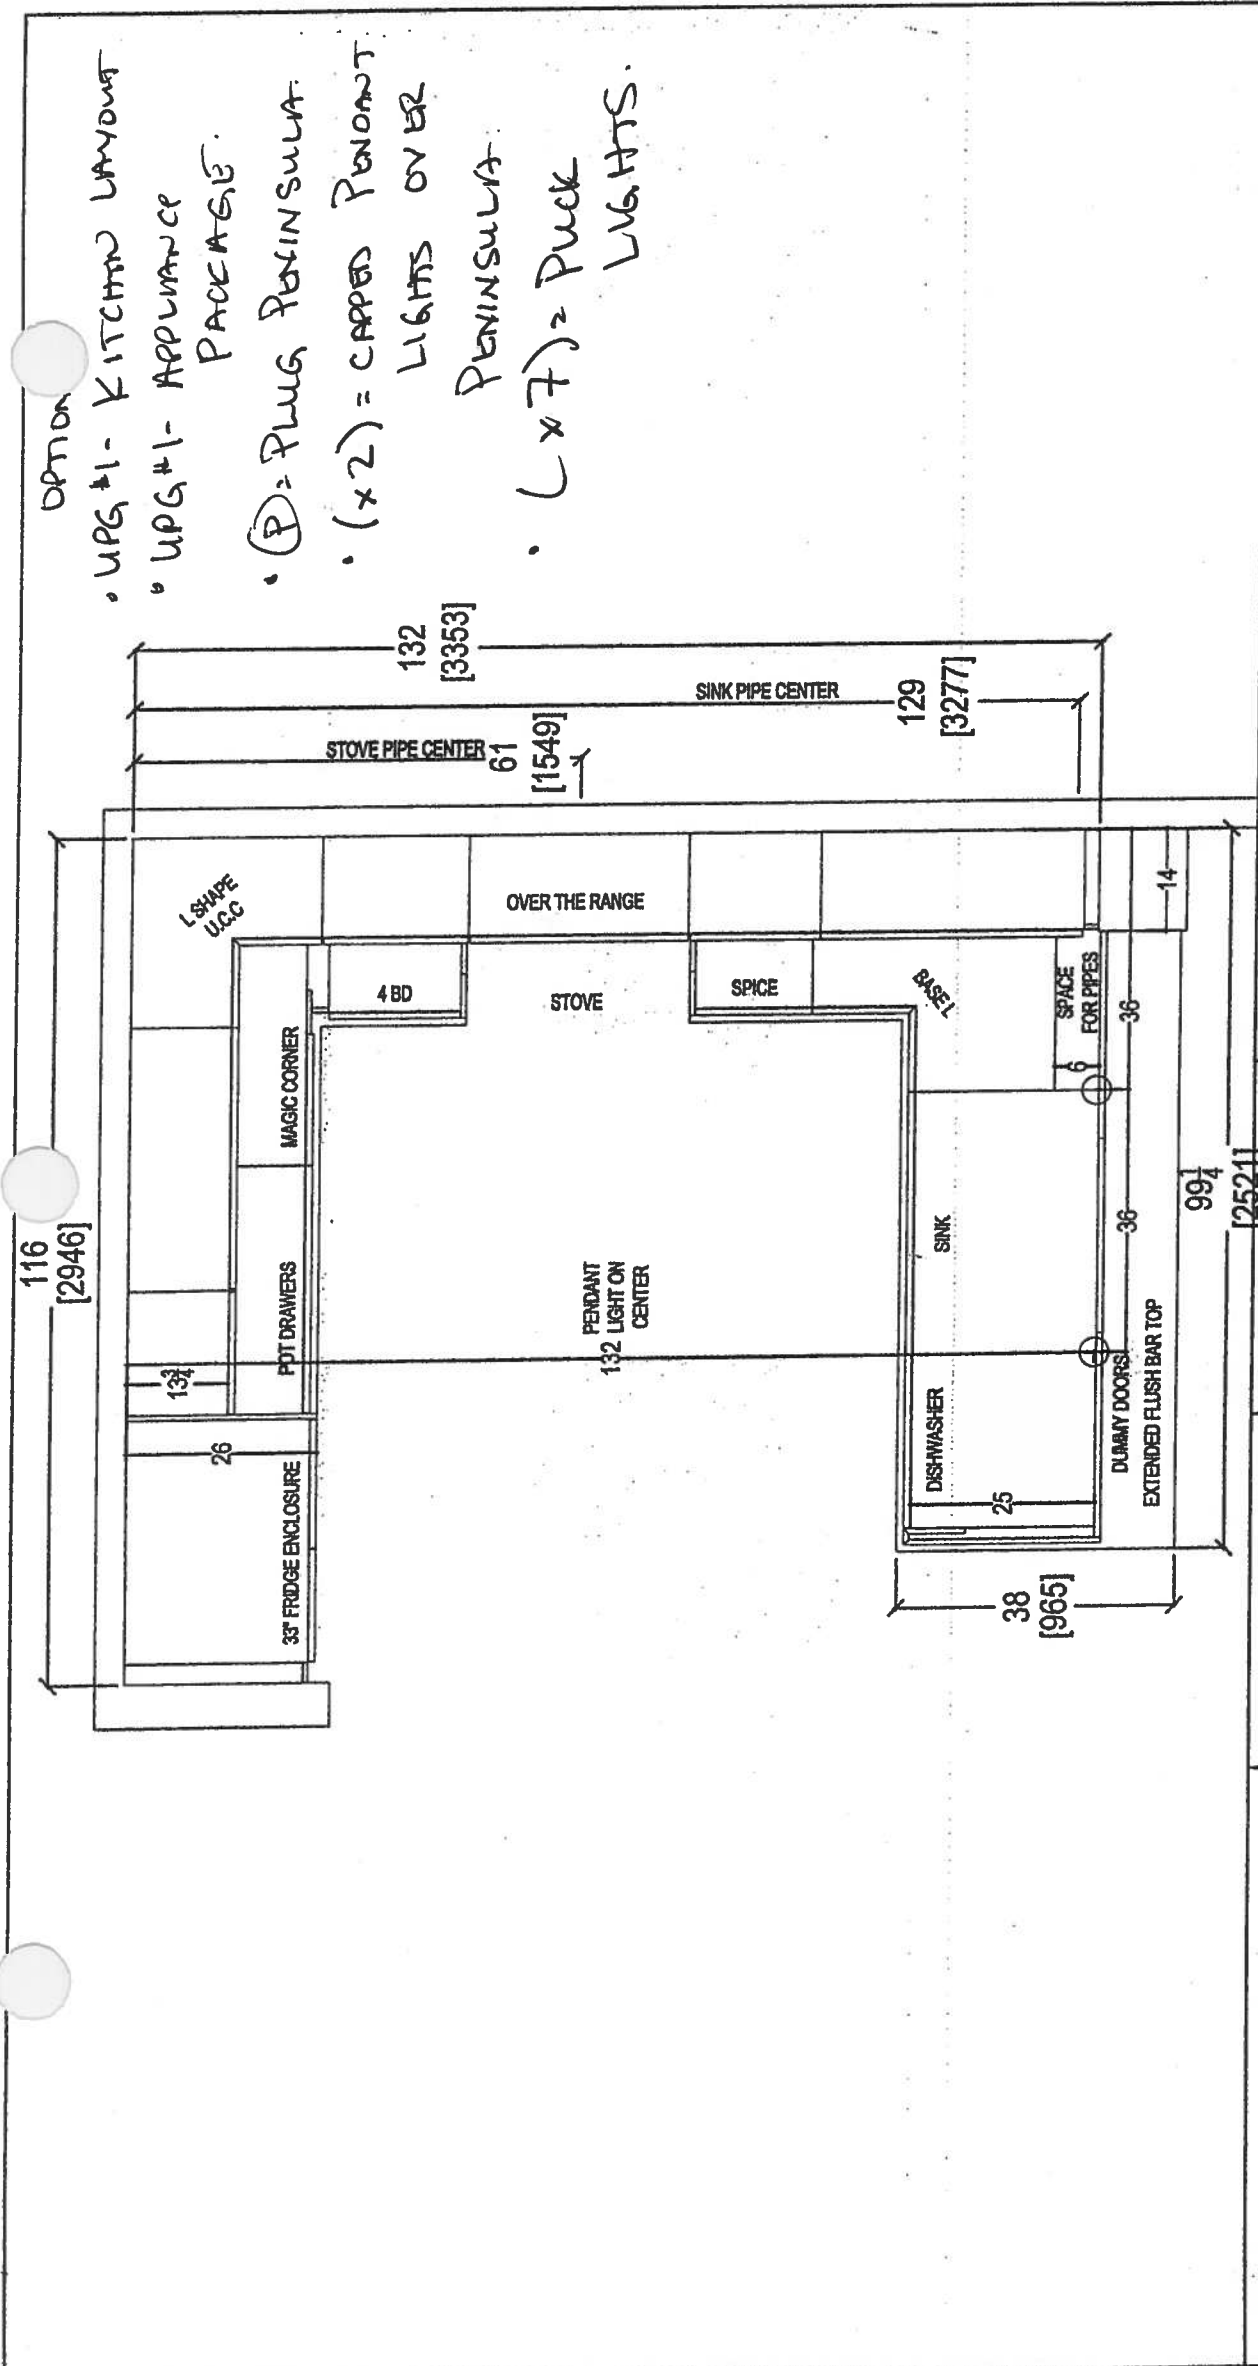


 <i>Your kitchen, your taste.</i> 80 SANTE DRIVE, VAUGHAN, ON L4K 3C4, T: 416.748.1811 F: 905.761.5801		CLIENT: ROYAL PINE HOMES		NOYAC BAY (2G) UPGRADE PACKAGE		ROOM: KITCHEN FLOOR PLAN		DRAWN BY: SK		COMMENTS: PLEASE NOTE ALL DIMENSIONS ARE NOT FINAL AND ARE SUBJECT TO CHANGE UPON FINAL SITE MEASURE	
SITE: HAMPTON PLACE		DOOR STYLE: —		DOOR HANDLE: —		SCALE: 1/2" = 1'-0"					
PHONE: —		FINISH: —		DRW HANDLE: —		DATE: MARCH 8, 2018					
EMAIL: —		SPECIES: —		TOP: —		PAGE: —					

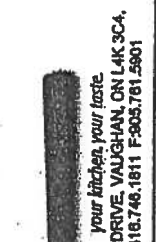

your kitchen, your taste.



80 SANTE DRIVE, VAUGHAN, ON L4K 3C4,
T: 416.748.1811 F: 905.761.5801

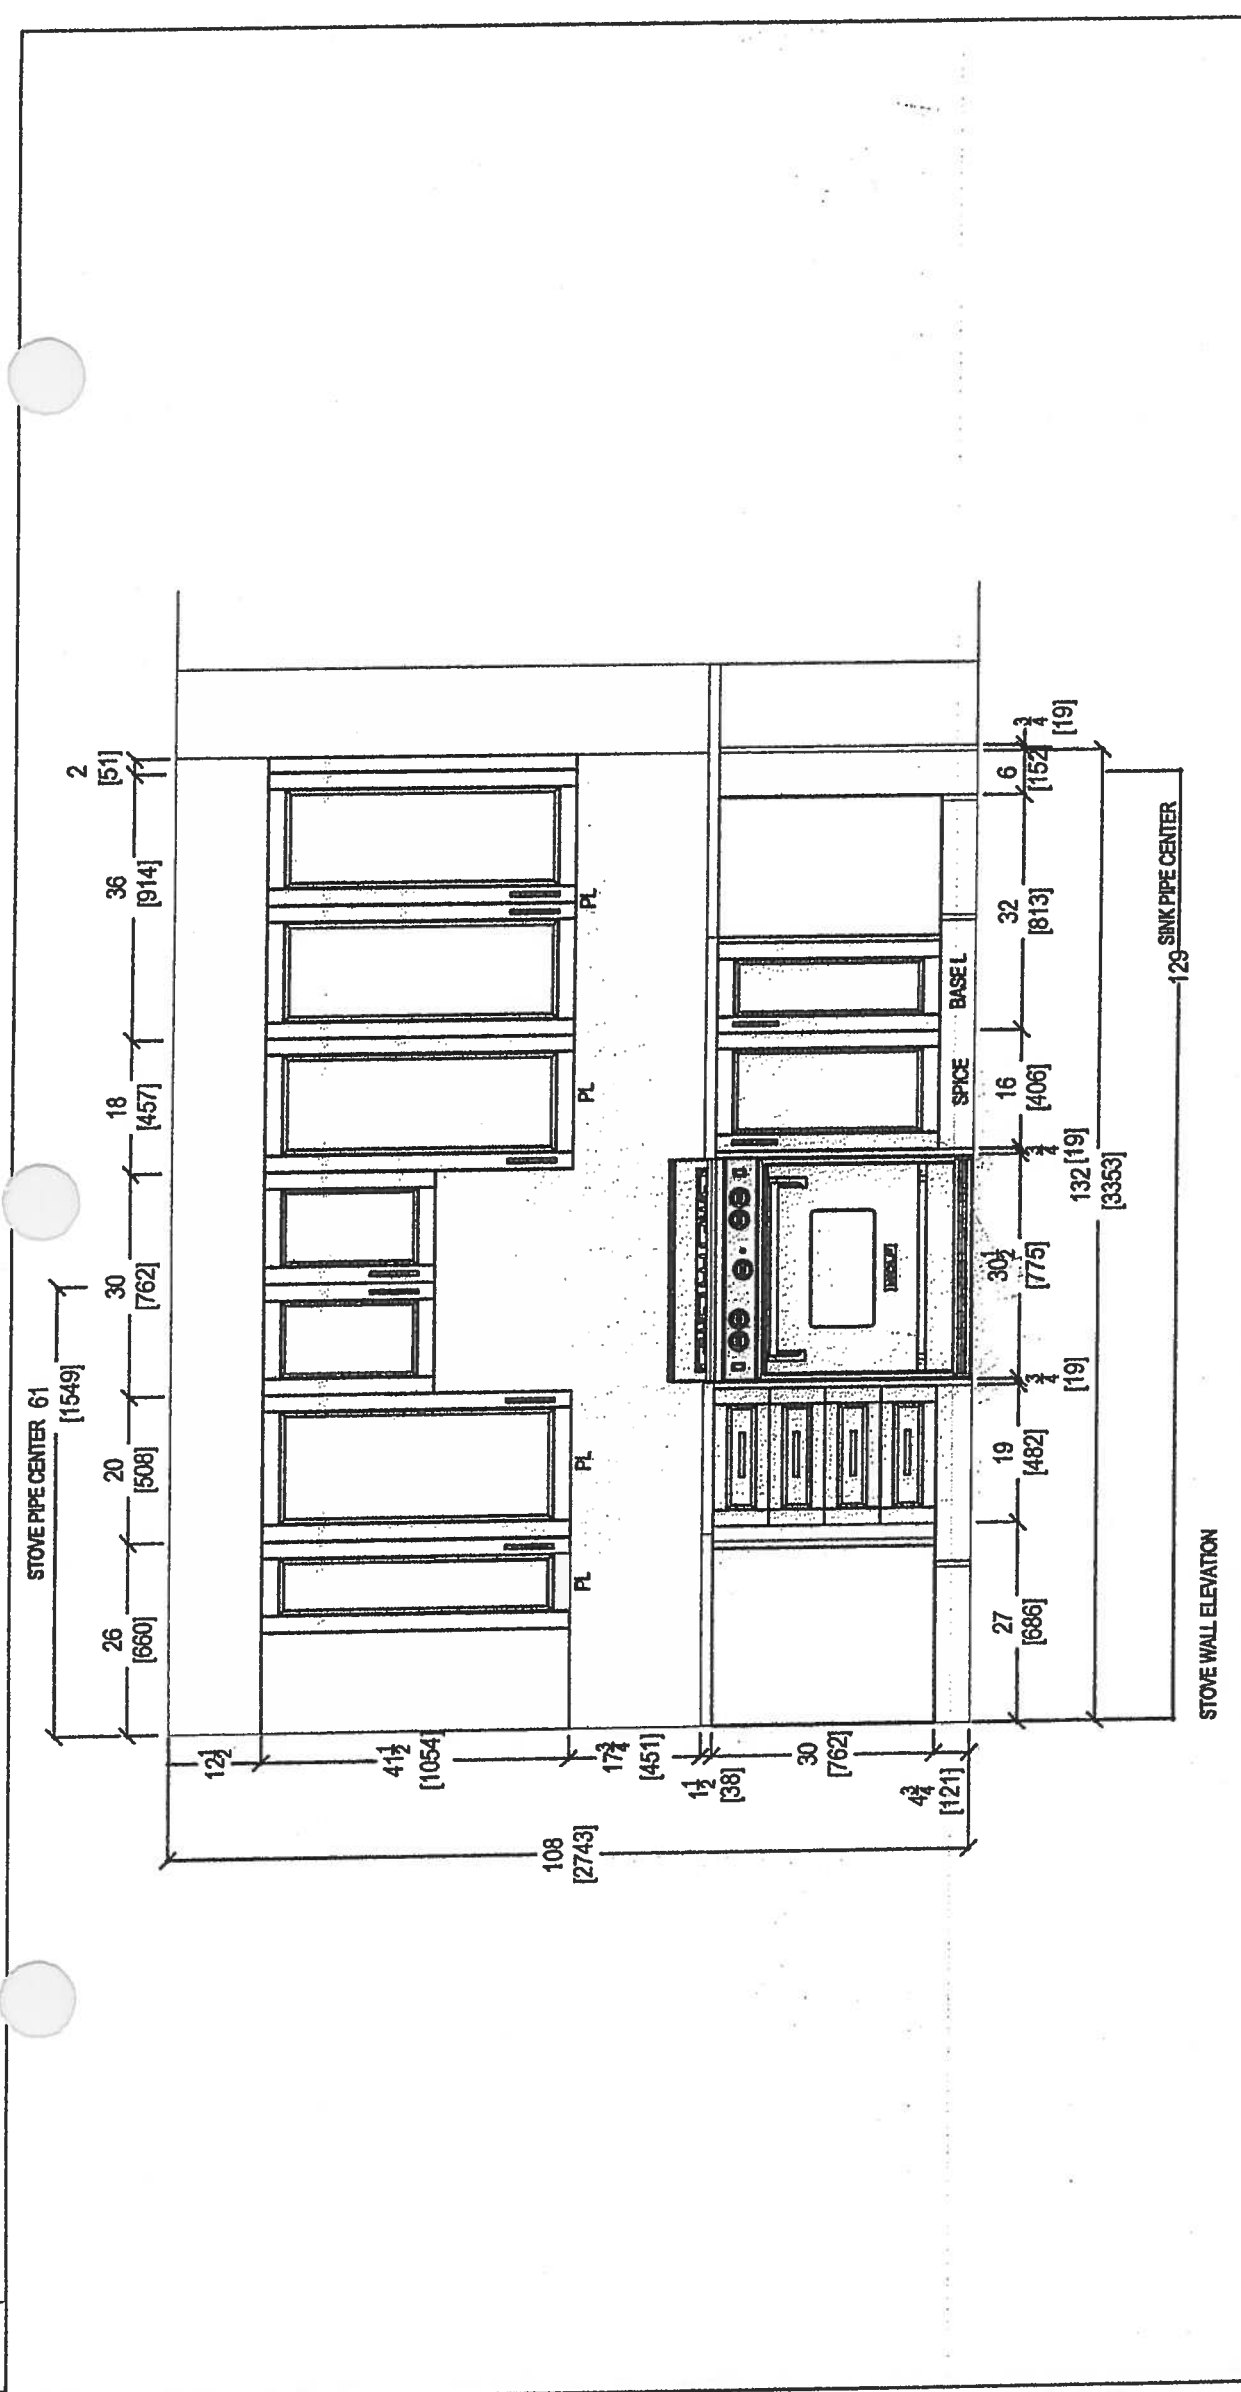





CLIENT: ROYAL PINE HOMES		NOYAC BAY (2G) UPGRADE PACKAGE	ROOM: KITCHEN	DRAWN BY: SK	COMMENTS: PLEASE NOTE ALL DIMENSIONS ARE NOT FINAL AND ARE SUBJECT TO CHANGE UPON FINAL SITE MEASURE
SITE: HAMPTON PLACE	DOOR STYLE: —	DOOR HANDLE: —	SCALE: 1/2" = 1'-0"		
PHONE: —	FINISH: —	DRW HANDLE: —	DATE: MARCH 8, 2018		
EMAIL: —	SPECIES: —	TOP: —	PAGE: —		



 <i>your kitchen, your taste.</i> 80 SANTE DRIVE, VAUGHAN, ON L4K 3C4, T: 416.746.1811 F: 905.761.5901	CLIENT: ROYAL PINE HOMES		NOYAC BAY (2G) UPGRADE PACKAGE	ROOM: . KITCHEN	DRAWN BY: SK	COMMENTS: PLEASE NOTE ALL DIMENSIONS ARE NOT FINAL AND ARE SUBJECT TO CHANGE UPON FINAL SITE MEASURE
	SITE: HAMPTON PLACE		DOOR STYLE: —	DOOR HANDLE: —	SCALE: 1/2" = 1' - 0"	
	PHONE: —		FINISH: —	DRW HANDLE: —	DATE: MARCH 8, 2018	
	EMAIL: —		SPECIES: —	TOP: —	PAGE: —	

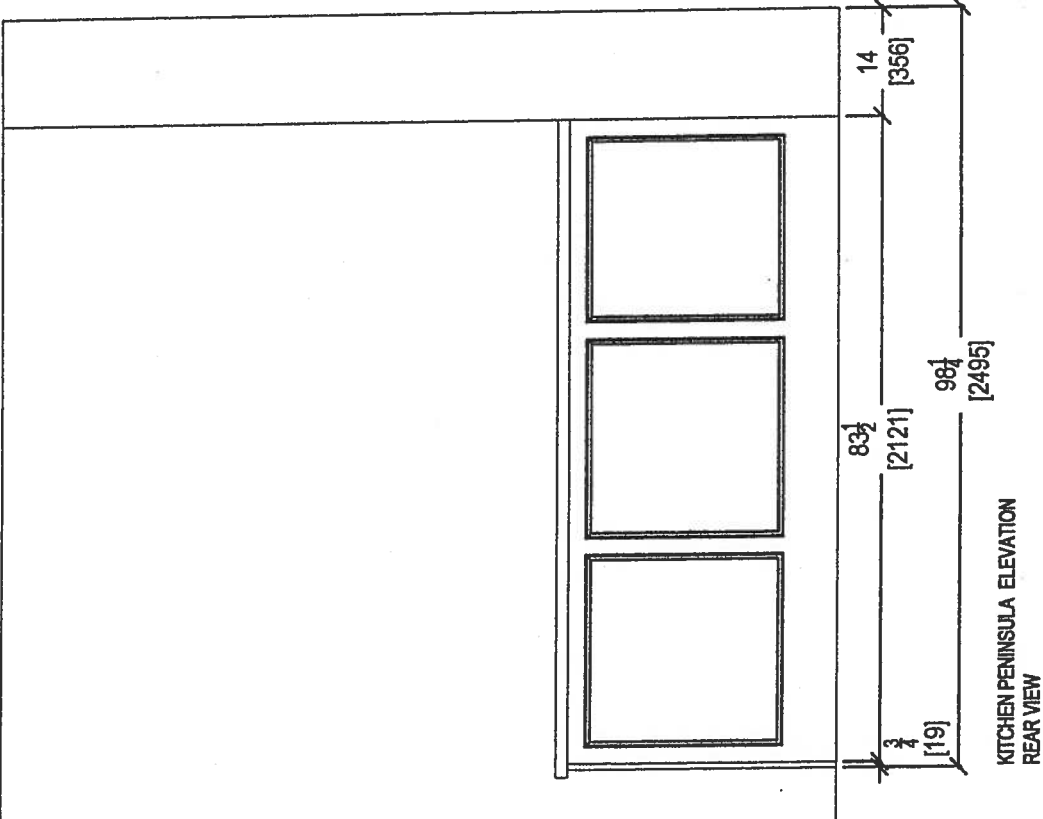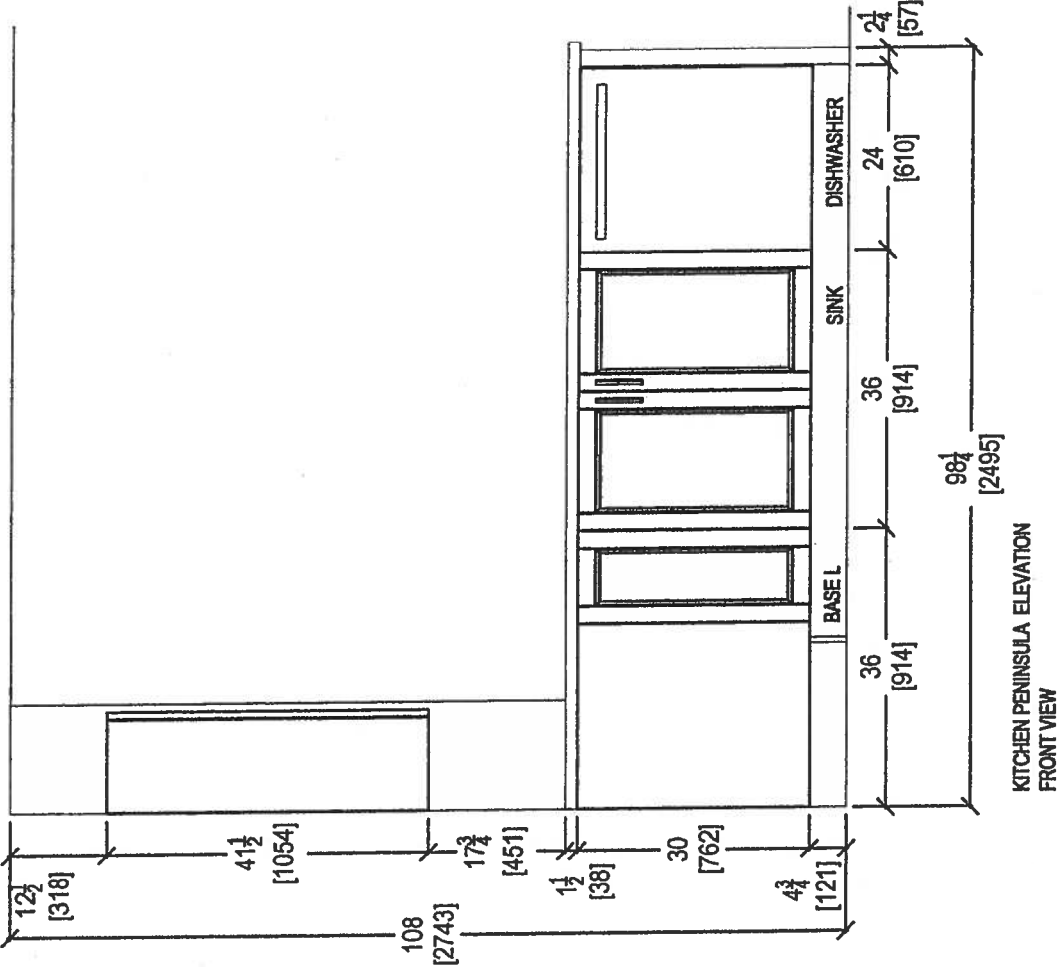

 your kitchen, your taste. 80 SANTE DRIVE, VAUGHAN, ON L4K 3C4, T: 416.748.1811 F: 905.761.5901	CLIENT: ROYAL PINE HOMES		NOYAC BAY (2G) UPGRADE PACKAGE	ROOM:	KITCHEN	DRAWN BY: SK	COMMENTS: PLEASE NOTE ALL DIMENSIONS ARE NOT FINAL AND ARE SUBJECT TO CHANGE UPON FINAL SITE MEASURE
	SITE:	HAMPTON PLACE	DOOR STYLE: —	DOOR HANDLE: —		SCALE: 1/2" = 1' - 0"	
	PHONE:	---	FINISH: —	DRW HANDLE: —		DATE: MARCH 8, 2018	
	EMAIL:	---	SPECIES: —	TOP: —		PAGE: —	

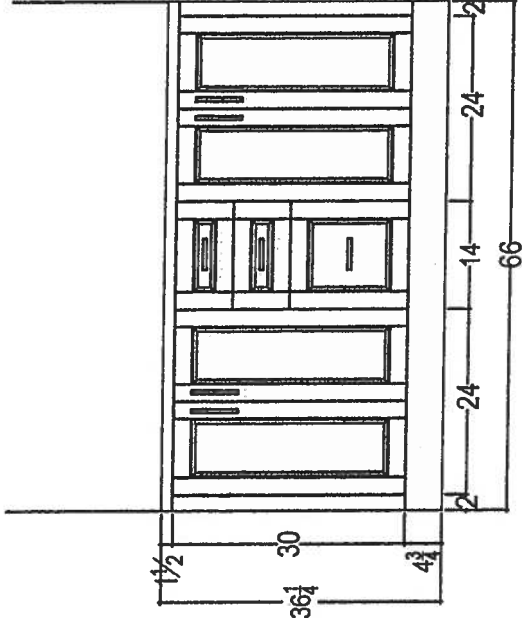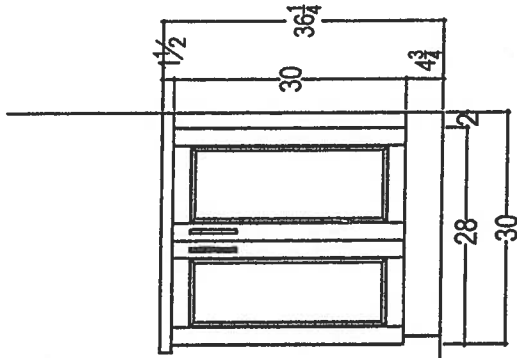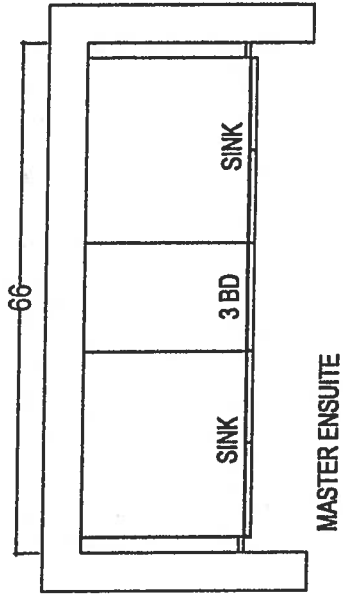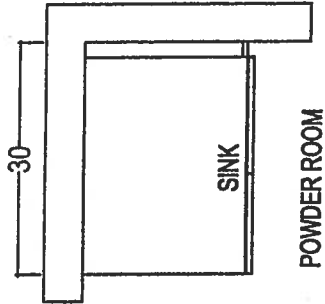

Your kitchen, your taste.
 80 SANTE DRIVE, VAUGHAN, ON L4K 3C4,
 T: 416.748.1811 F: 905.781.5901

CLIENT: ROYAL PINE HOMES SITE: HAMPTON PLACE PHONE: — EMAIL: —	NOYAC BAY (2G) UPGRADE PACKAGE		ROOM:	DRAWN BY: SK	
	DOOR STYLE:	—	DOOR HANDLE:	—	SCALE: 1/2" = 1' - 0"
	FINISH:	—	DRW HANDLE:	—	DATE: MARCH 8, 2018
	SPECIES:	—	TOP:	—	PAGE: —
COMMENTS: PLEASE NOTE ALL DIMENSIONS ARE NOT FINAL AND ARE SUBJECT TO CHANGE UPON FINAL SITE MEASURE					