

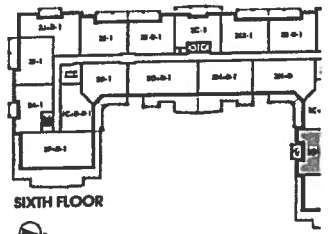
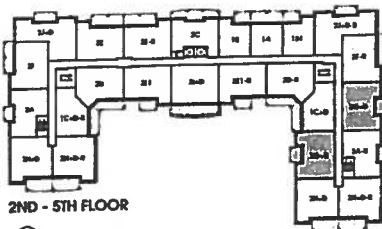


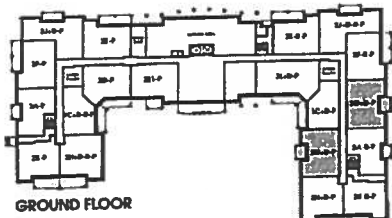

Noyac Bay

1,121 SQ FT *plus 81 sq. ft. of balcony area*

Suite 407.
ORIGINAL LAYOUT
INVENTORY SUITE
(OLD)

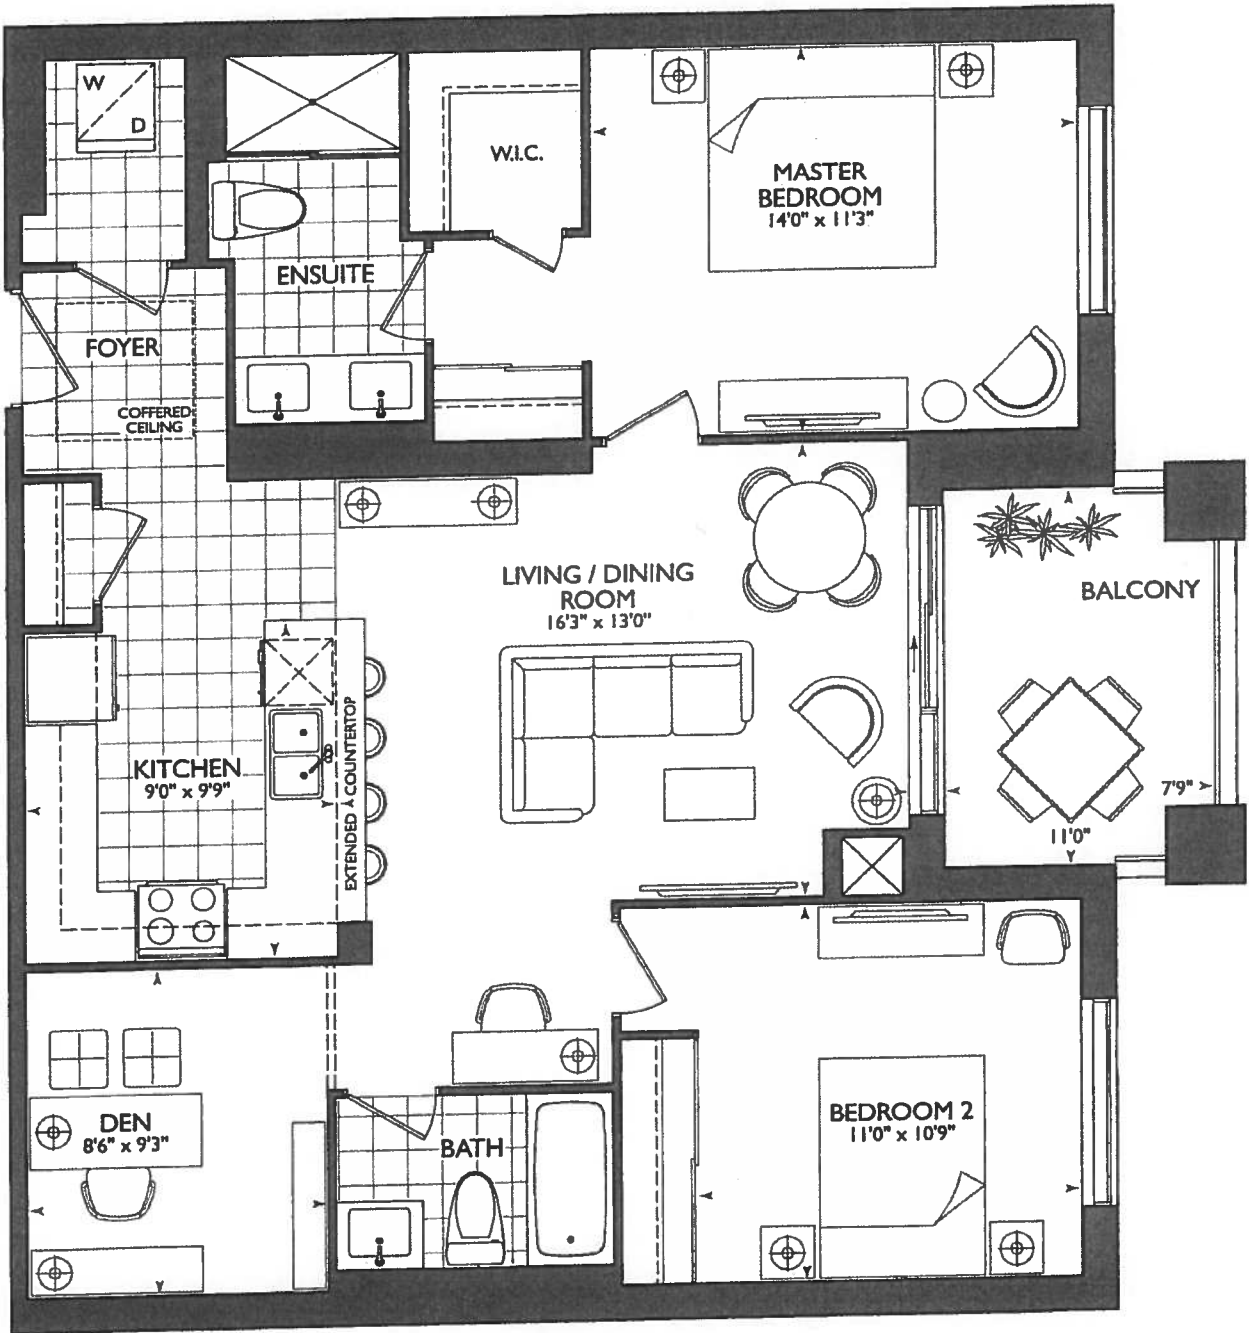






Noyac Bay

1,121 SQ FT *plus* 76sq. ft. of balcony area

SUITE 407
ORIGINAL LAYOUT
INVENTORY SUITE

(NEW)

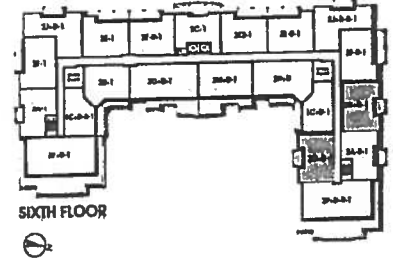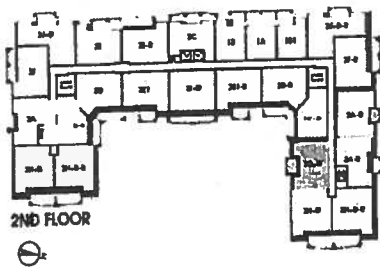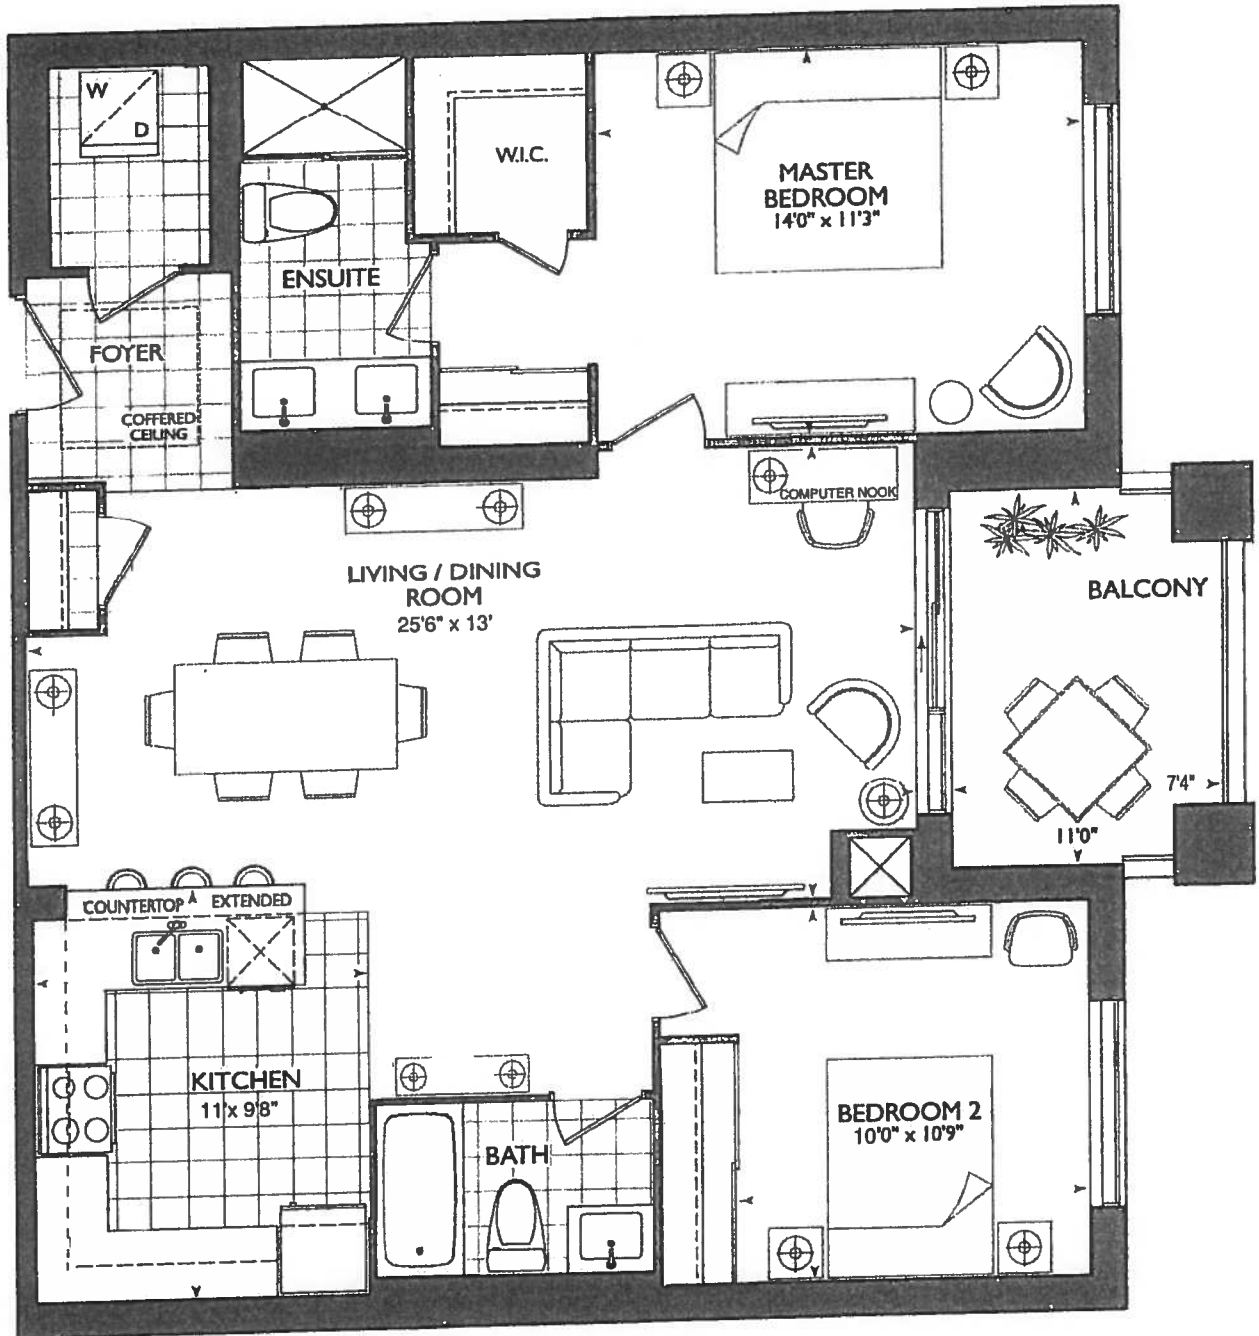

Plans and specifications are subject to change without notice. Actual usable floor space may vary from the stated floor area. All renderings are artist's concept. E. & O. E.

*** KITCHEN ***

CHOICE OF STD. KITCHEN LAYOUT WITH
STD. APPLIANCE PACKAGE

OR

CAN UPGRADE AT DECOR CENTER

- (x2) CAPPED PENDANT
- (x1) PLUG PENINSULA
- (x) PUCK LIGHTS


***SEE ATTACHED UPG.**

**#1- KITCHEN LAYOUT WITH 1ST UPG.
APPLIANCE PACKAGE**

*** SUITE * (INVENTORY SUITE)**

- NEW PLAN
- REMOVED DEN
- REVISED KITCHEN


***REVISED LAUNDRY DOOR SWING &
ENSUITE WALL AS PER THIS BROCHURE**

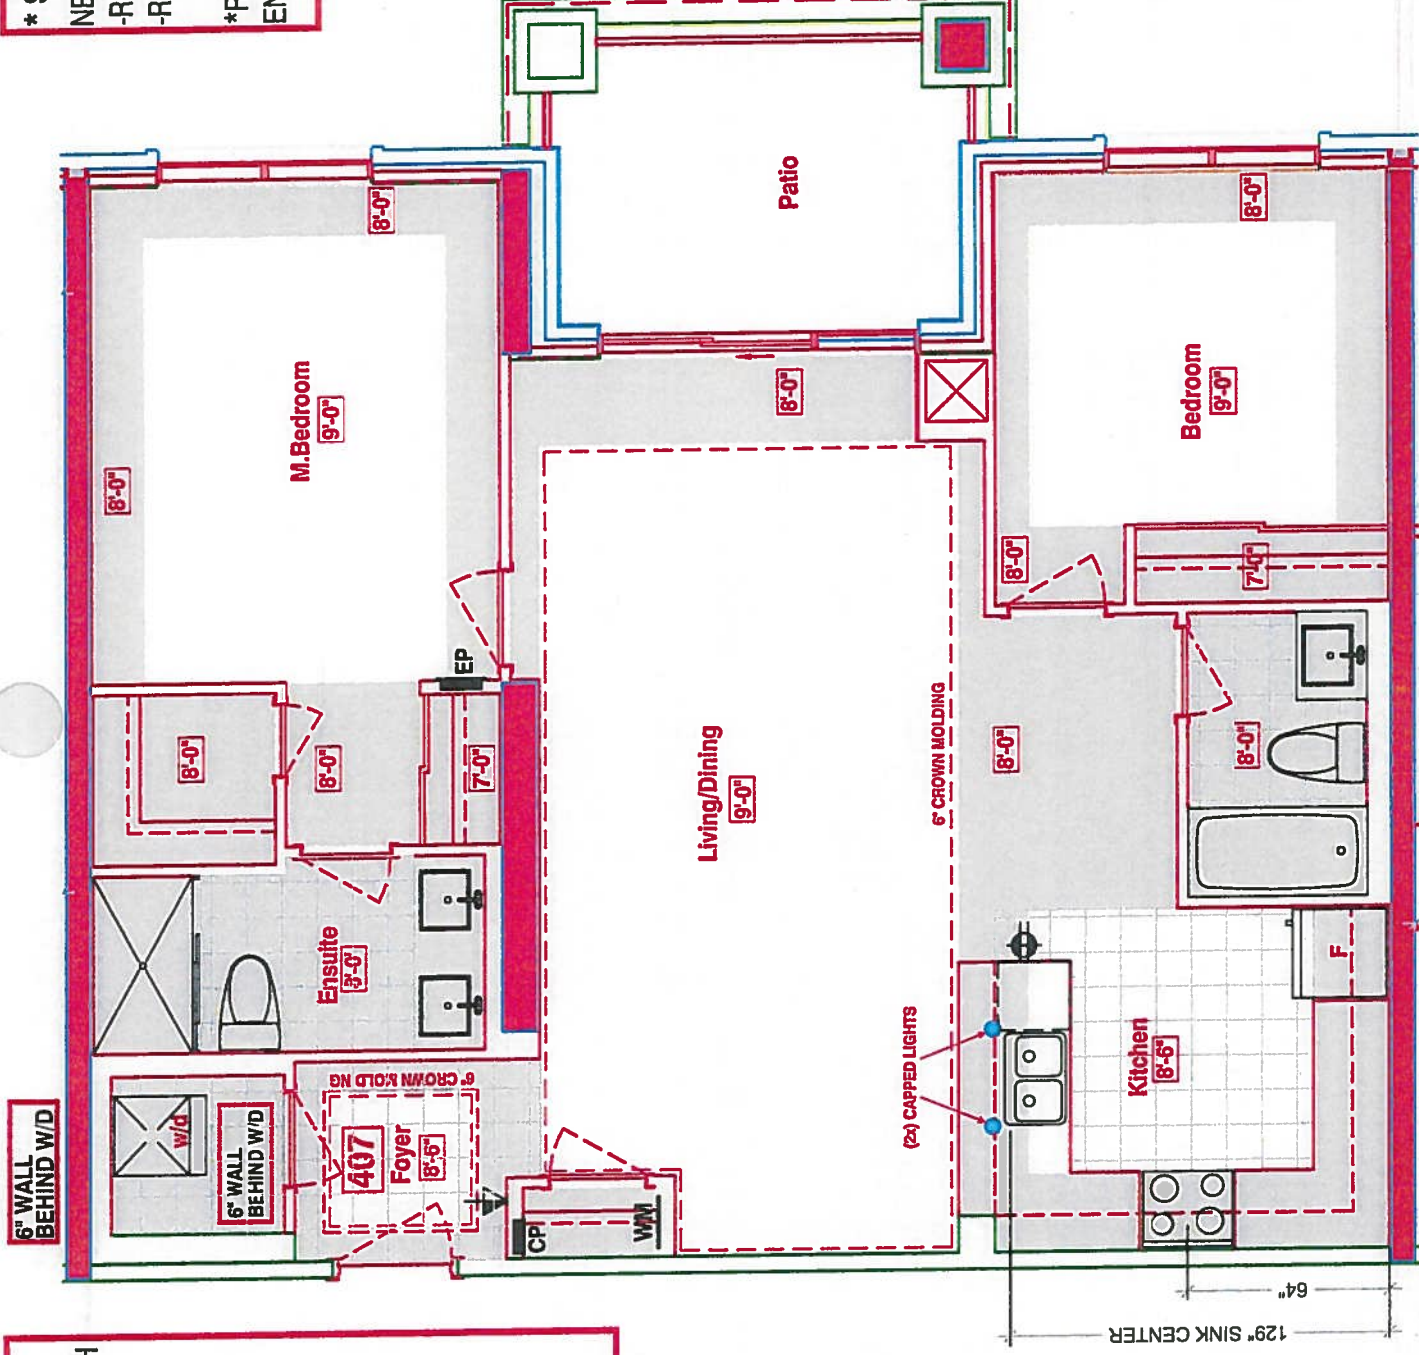

SUITES 407 - NOYAC BAY (Inventory suite)

Royal Pine Homes 25 Baker Hill Blvd - Stouffville, ON Apr 04, 2018

STANDARD

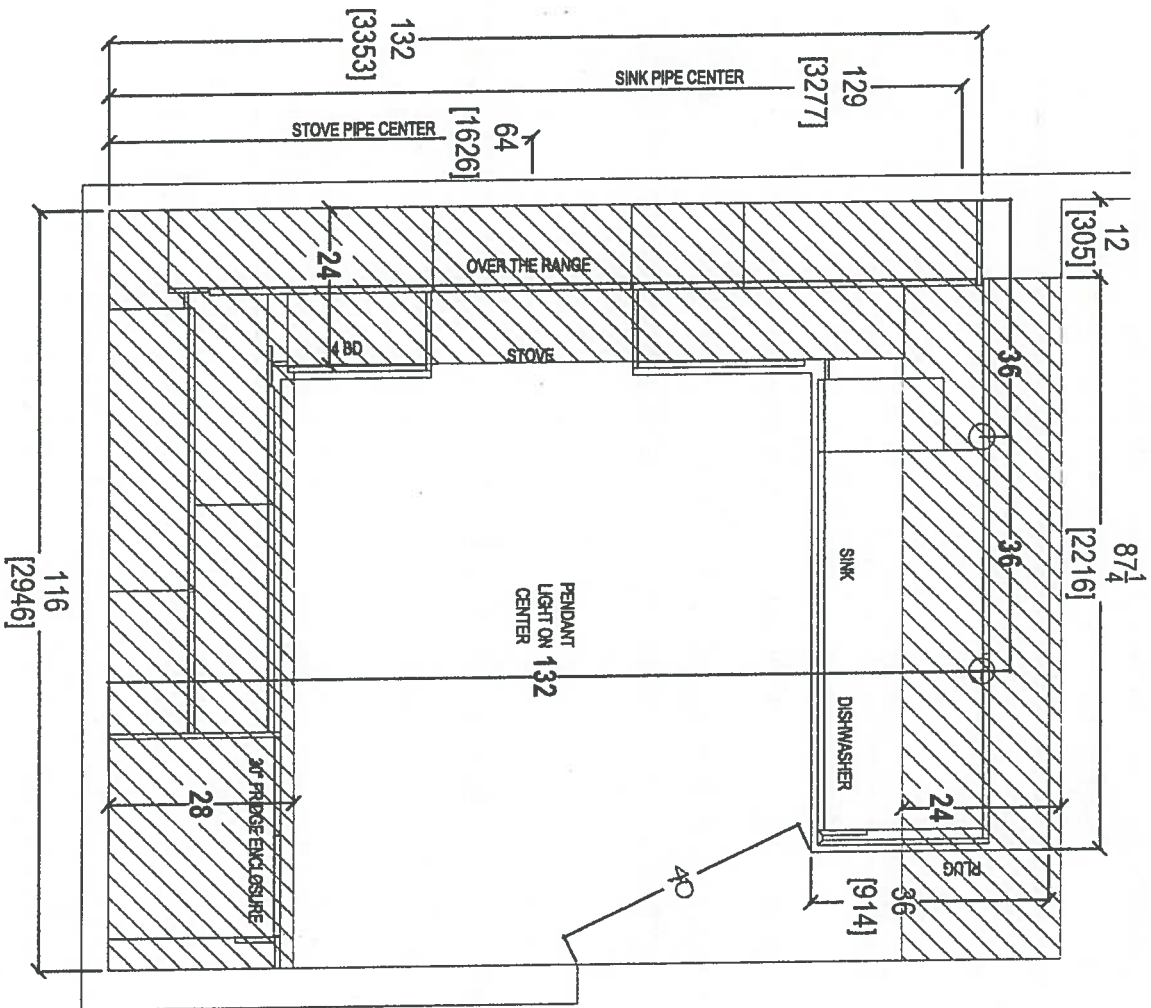

QTK

your kitchen, your taste.
80 SANTE DRIVE, VAUGHAN, ON L4K 3C4,
T: 416.746.1811 F: 905.761.5901

CLIENT: ROYAL PINE HOMES

JOB NAME: UNIT 407 HMP ~~STANDARD~~

ROOM: KITCHEN FLOOR PLAN

DRAWN BY: SK

COMMENTS:

SITE: HAMPTON PLACE

DOOR STYLE: —

DOOR HANDLE: —

SCALE: 1/2" = 1'-0"

PLEASE NOTE ALL DIMENSIONS
ARE NOT FINAL AND ARE
SUBJECT TO CHANGE UPON
FINAL SITE MEASURE

PHONE: —

FINISH: —

DRW HANDLE: —


DATE: MAY 8, 2018

EMAIL: —


SPECIES: —

TOP: —

PAGE: —

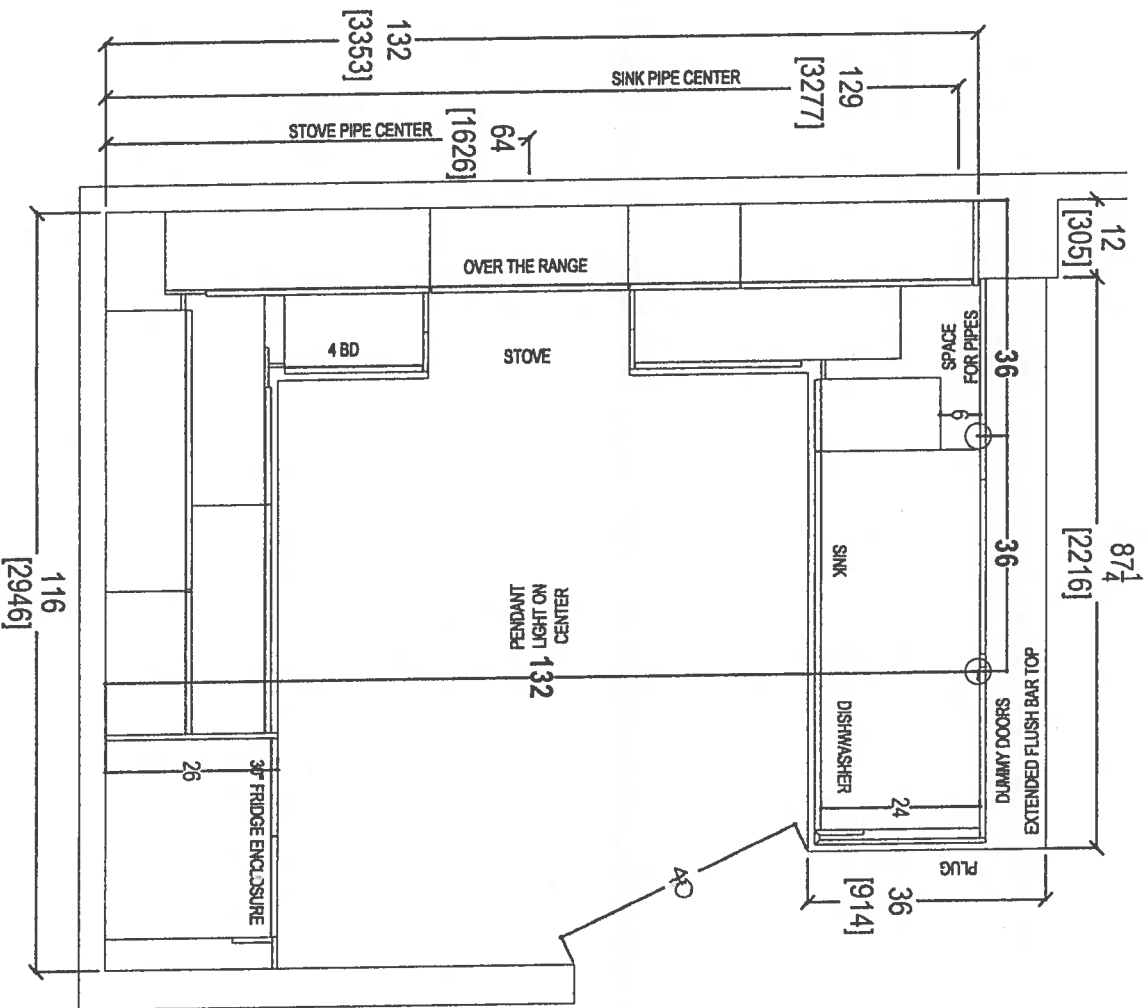

CLIENT: ROYAL PINE HOMES	JOB NAME: UNIT 407 HMP STRIP DRY	ROOM: KITCHEN FLOOR PLAN	DRAWN BY: SK	COMMENTS:
SITE: HAMPTON PLACE	DOOR STYLE: —	DOOR HANDLE: —	SCALE: 1/2" = 1' - 0"	PLEASE NOTE ALL DIMENSIONS ARE NOT FINAL AND ARE SUBJECT TO CHANGE UPON FINAL SITE MEASURE
PHONE: —	FINISH: —	DRW HANDLE: —	DATE: MAY 8, 2018	
EMAIL: —	SPECIES: —	TOP: —	PAGE: —	

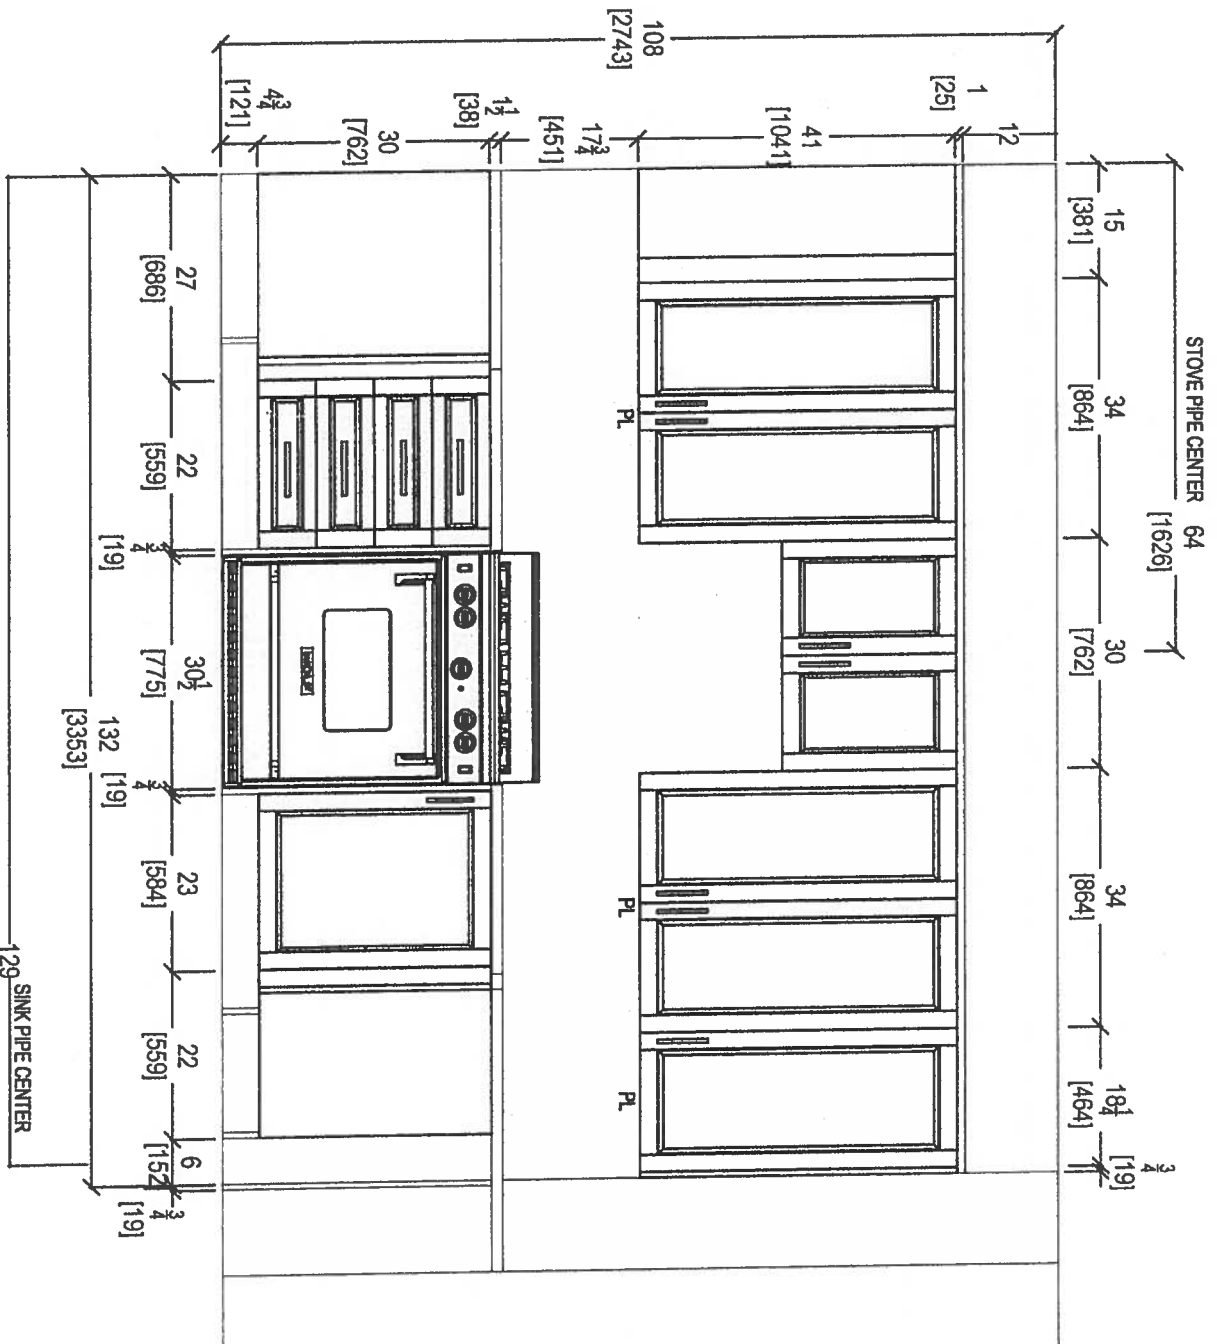


STOVE WALL ELEVATION

CLIENT: ROYAL PINE HOMES	JOB NAME: UNIT 407 HMP <i>Standard</i>	ROOM: KITCHEN	DRAWN BY: SK	COMMENTS: PLEASE NOTE ALL DIMENSIONS ARE NOT FINAL AND ARE SUBJECT TO CHANGE UPON FINAL SITE MEASURE
SITE: HAMPTON PLACE	DOOR STYLE: —	DOOR HANDLE: —	SCALE: 1/2" = 1' - 0"	
PHONE: —	FINISH: —	DRW HANDLE: —	DATE: MAY 8, 2018	
EMAIL: —	SPECIES: —	TOP: —	PAGE: —	



80 SANTE DRIVE, VAUGHAN, ON L4K 3C4,
T: 416.746.1811 F: 905.761.5801

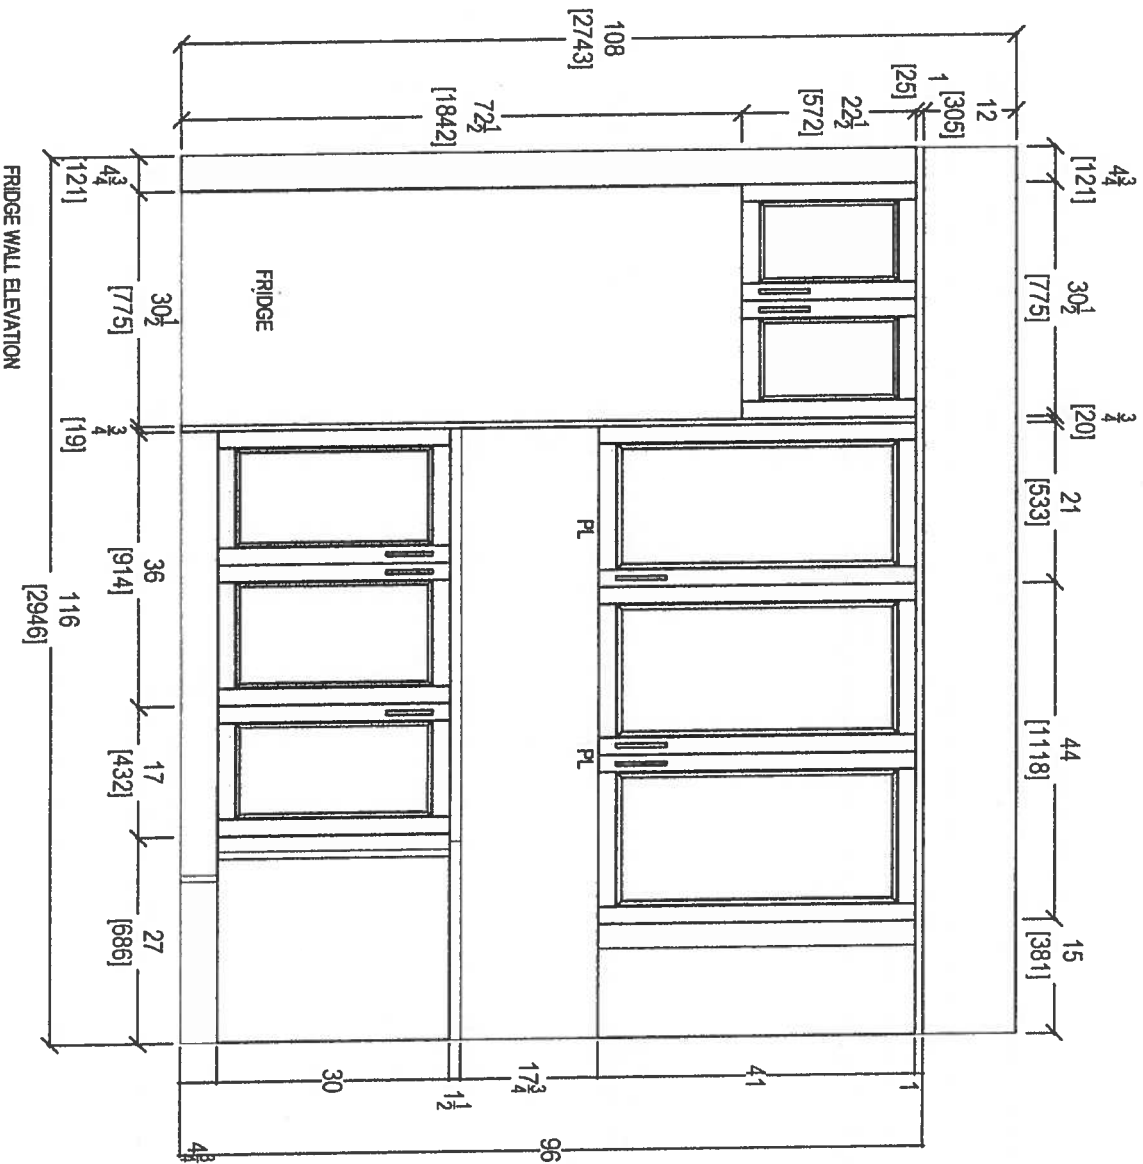



CLIENT: ROYAL PINE HOMES	JOB NAME: UNIT 407 HMP <i>STANDARD</i>	ROOM: KITCHEN	DRAWN BY: SK
SITE: HAMPTON PLACE	DOOR STYLE: —	DOOR HANDLE: —	SCALE: 1/2" = 1' - 0"
PHONE: —	FINISH: —	DRW HANDLE: —	DATE: MAY 8, 2018
EMAIL: —	SPECIES: —	TOP: —	PAGE: —

COMMENTS:

PLEASE NOTE ALL DIMENSIONS
ARE NOT FINAL AND ARE
SUBJECT TO CHANGE UPON
FINAL SITE MEASURE



80 SANTE DRIVE, VAUGHAN, ON L4K 3C4,
T: 416.748.1811 F: 905.761.5901

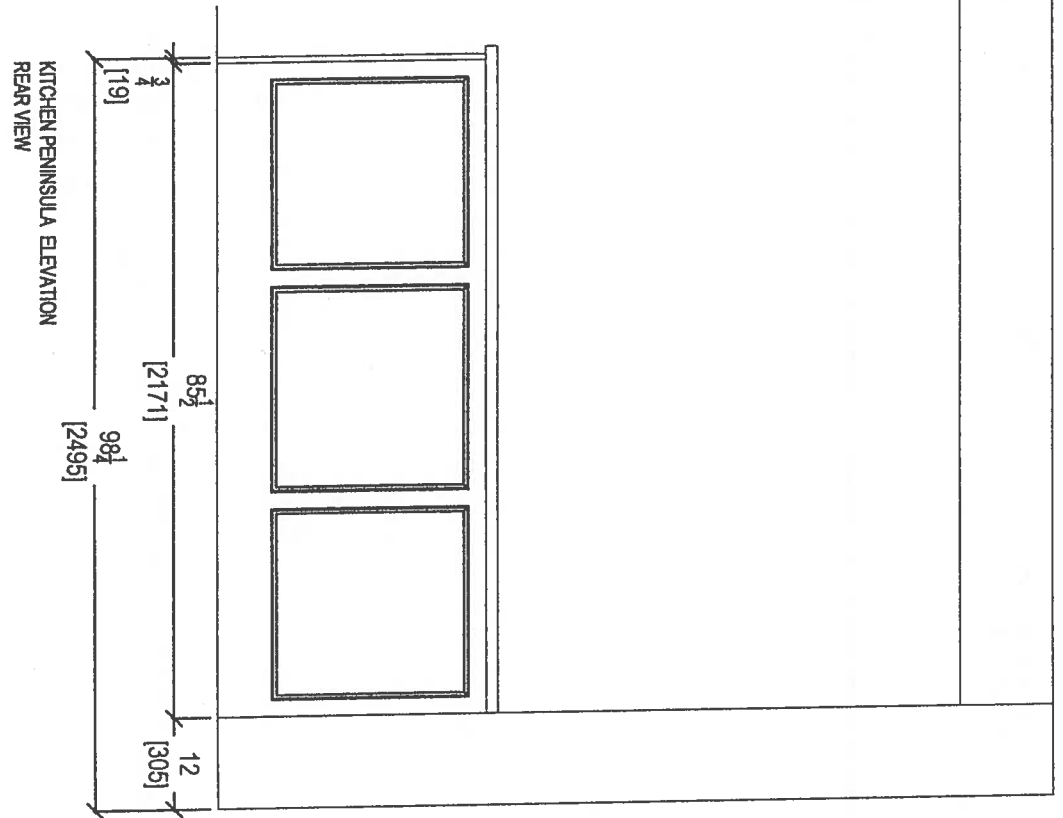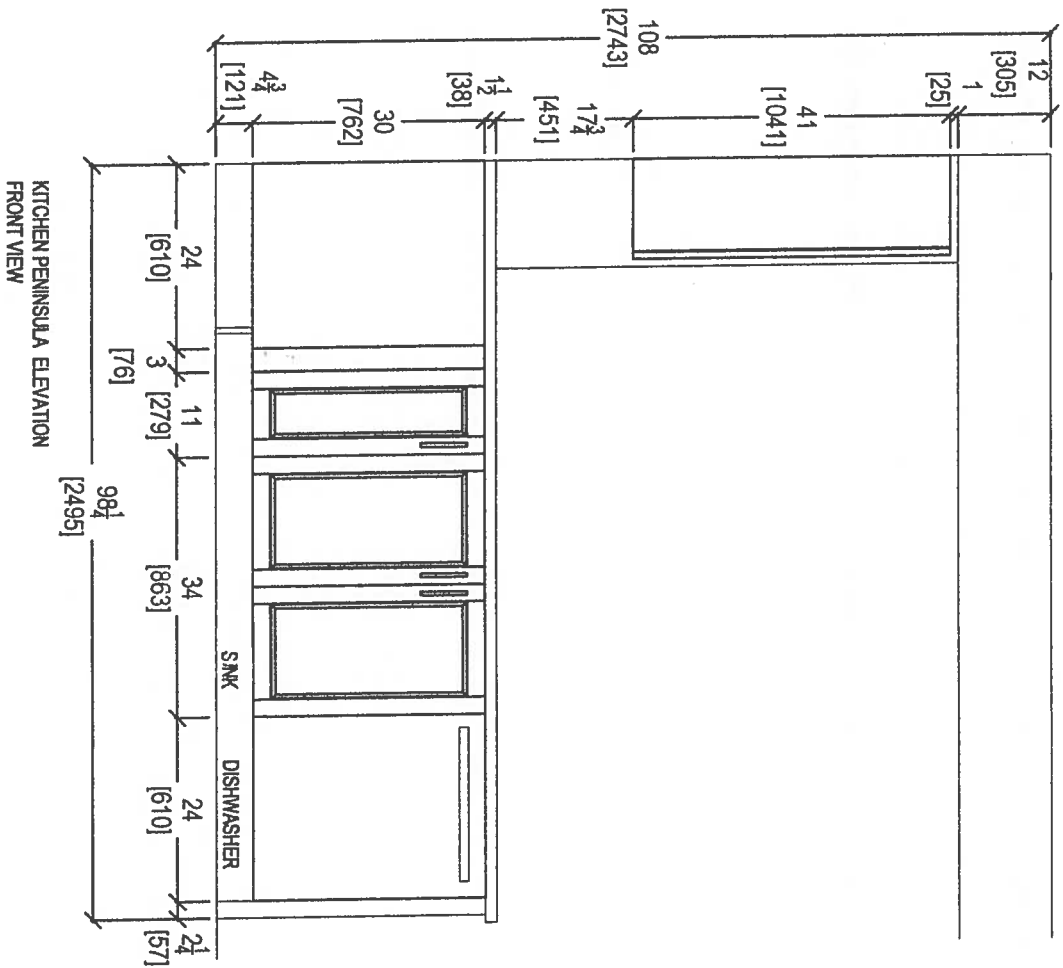

KITCHEN PENINSULA ELEVATION
FRONT VIEW


KITCHEN PENINSULA ELEVATION
REAR VIEW

CLIENT: ROYAL PINE HOMES	JOB NAME: UNIT 407 HMP <i>Standard</i>	ROOM: KITCHEN	DRAWN BY: SK
SITE: HAMPTON PLACE	DOOR STYLE: —	DOOR HANDLE: —	SCALE: 1/2" = 1' - 0"
PHONE: —	FINISH: —	DRW HANDLE: —	DATE: MAY 8, 2018
EMAIL: —	SPECIES: —	TOP: —	PAGE: —




your kitchen, your taste
80 SANTE DRIVE, VAUGHAN, ON L4K 3C4,
T: 416.746.1811 F: 905.761.5901



COMMENTS:
PLEASE NOTE ALL DIMENSIONS
ARE NOT FINAL AND ARE
SUBJECT TO CHANGE UPON
FINAL SITE MEASURE

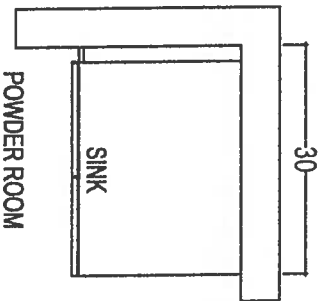

POWDER ROOM

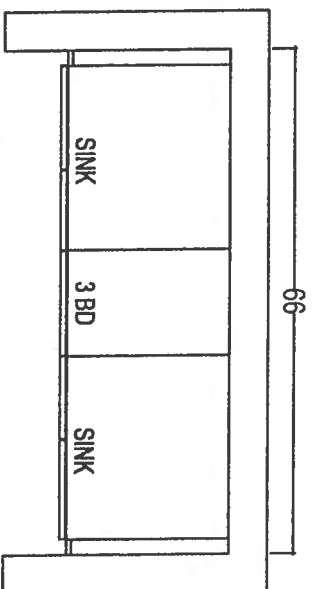

MASTER ENSUITE

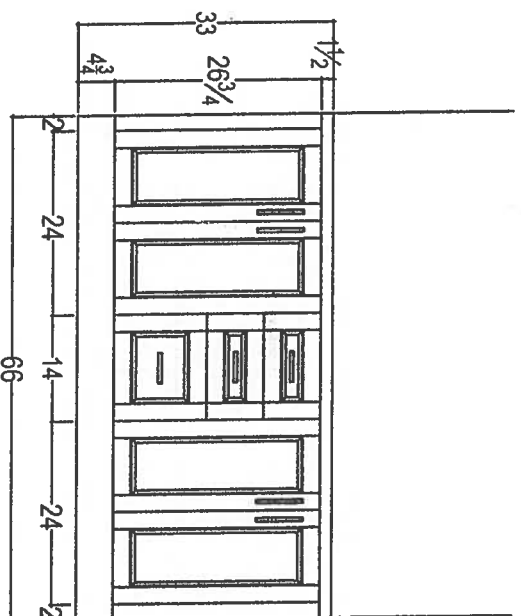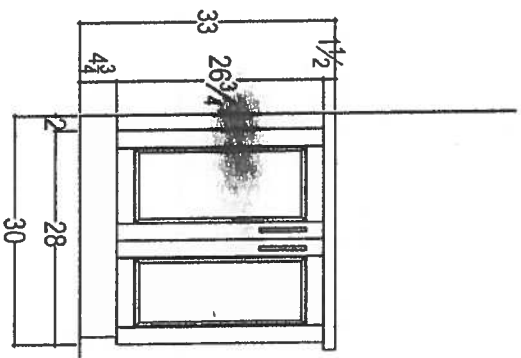

80 SANTE DRIVE, VAUGHAN, ON L4K 3C4,
T: 416.746.1811 F: 905.761.5801


CLIENT: ROYAL PINE HOMES	JOB NAME: UNIT 407 HMP	STANDARD	ROOM: VANITIES	DRAWN BY: SK
SITE: HAMPTON PLACE	DOOR STYLE: —		DOOR HANDLE: —	SCALE: 1/2" = 1'-0"
PHONE: —	FINISH: —		DRW HANDLE: —	DATE: MAY 8, 2018
EMAIL: —	SPECIES: —		TOP: —	PAGE: —

COMMENTS:
PLEASE NOTE ALL DIMENSIONS
ARE NOT FINAL AND ARE
SUBJECT TO CHANGE UPON
FINAL SITE MEASURE


* UPGRADE *



your kitchen. your taste.
80 SANTE DRIVE, VAUGHAN, ON L4K 3C4,
T: 416.746.1811 F: 416.746.5901

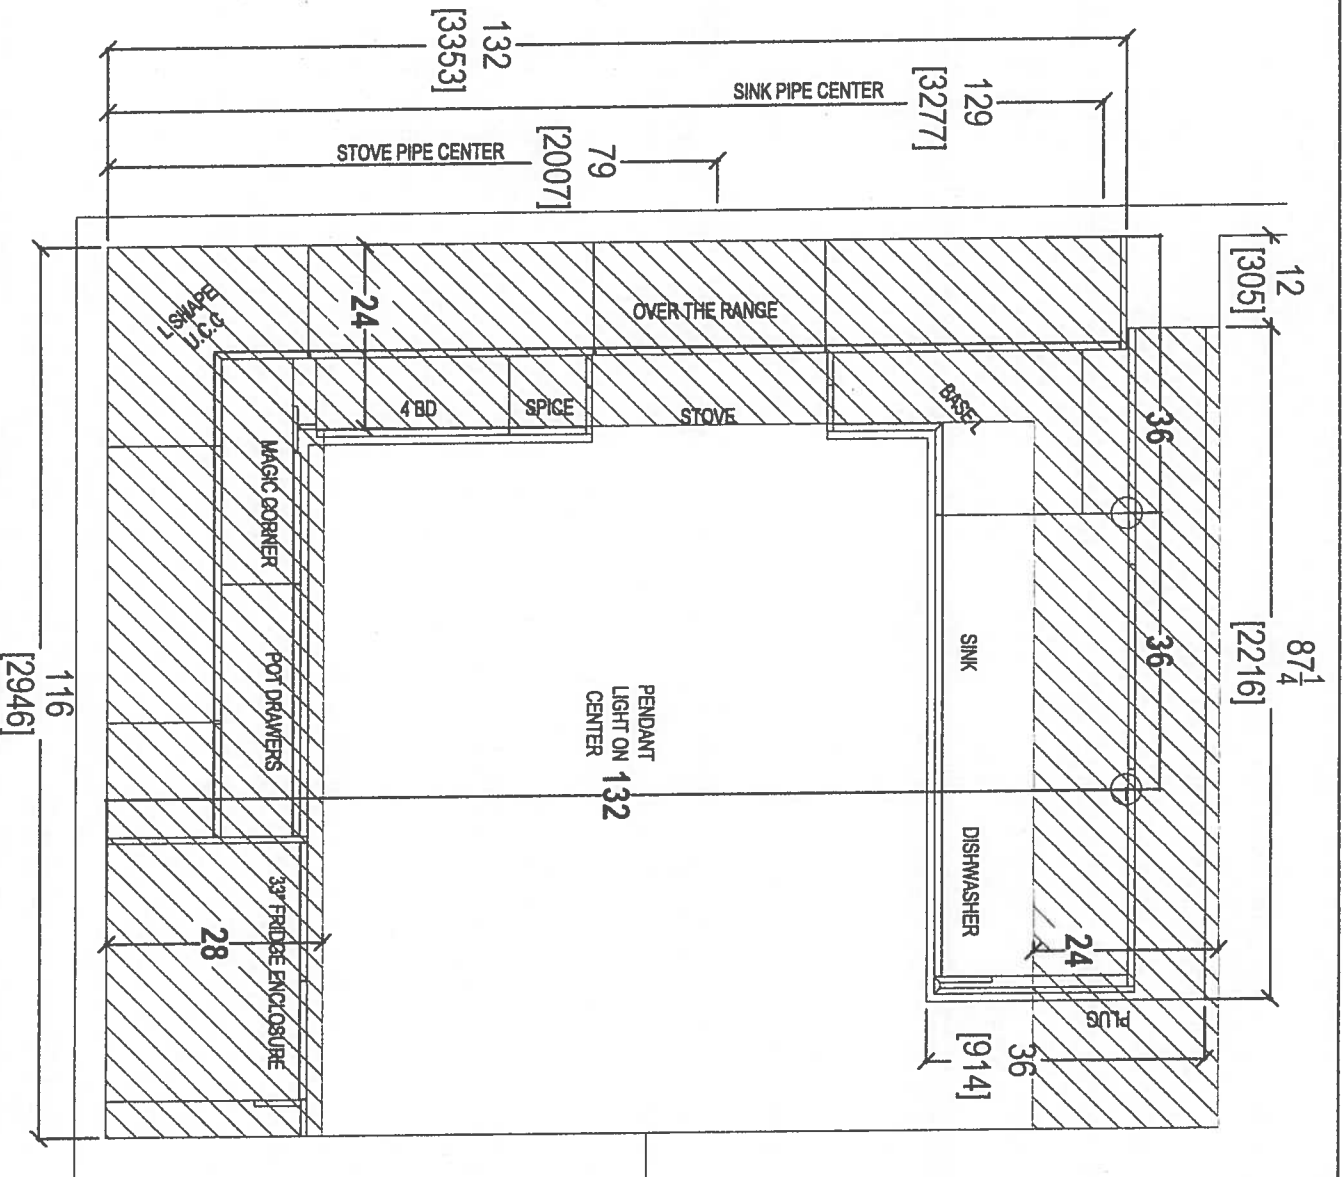

CLIENT: ROYAL PINE HOMES	JOB NAME: UNIT 407 HMP	ROOM: KITCHEN FLOOR PLAN	DRAWN BY: SK	COMMENTS: PLEASE NOTE ALL DIMENSIONS ARE NOT FINAL AND ARE SUBJECT TO CHANGE UPON FINAL SITE MEASURE
SITE: HAMPTON PLACE	DOOR STYLE: —	DOOR HANDLE: —	SCALE: 1/2" = 1' - 0"	
PHONE: —	FINISH: —	DRW HANDLE: —	DATE: APRIL 27, 2018	
EMAIL: —	SPECIES: —	TOP: —	PAGE: —	
				

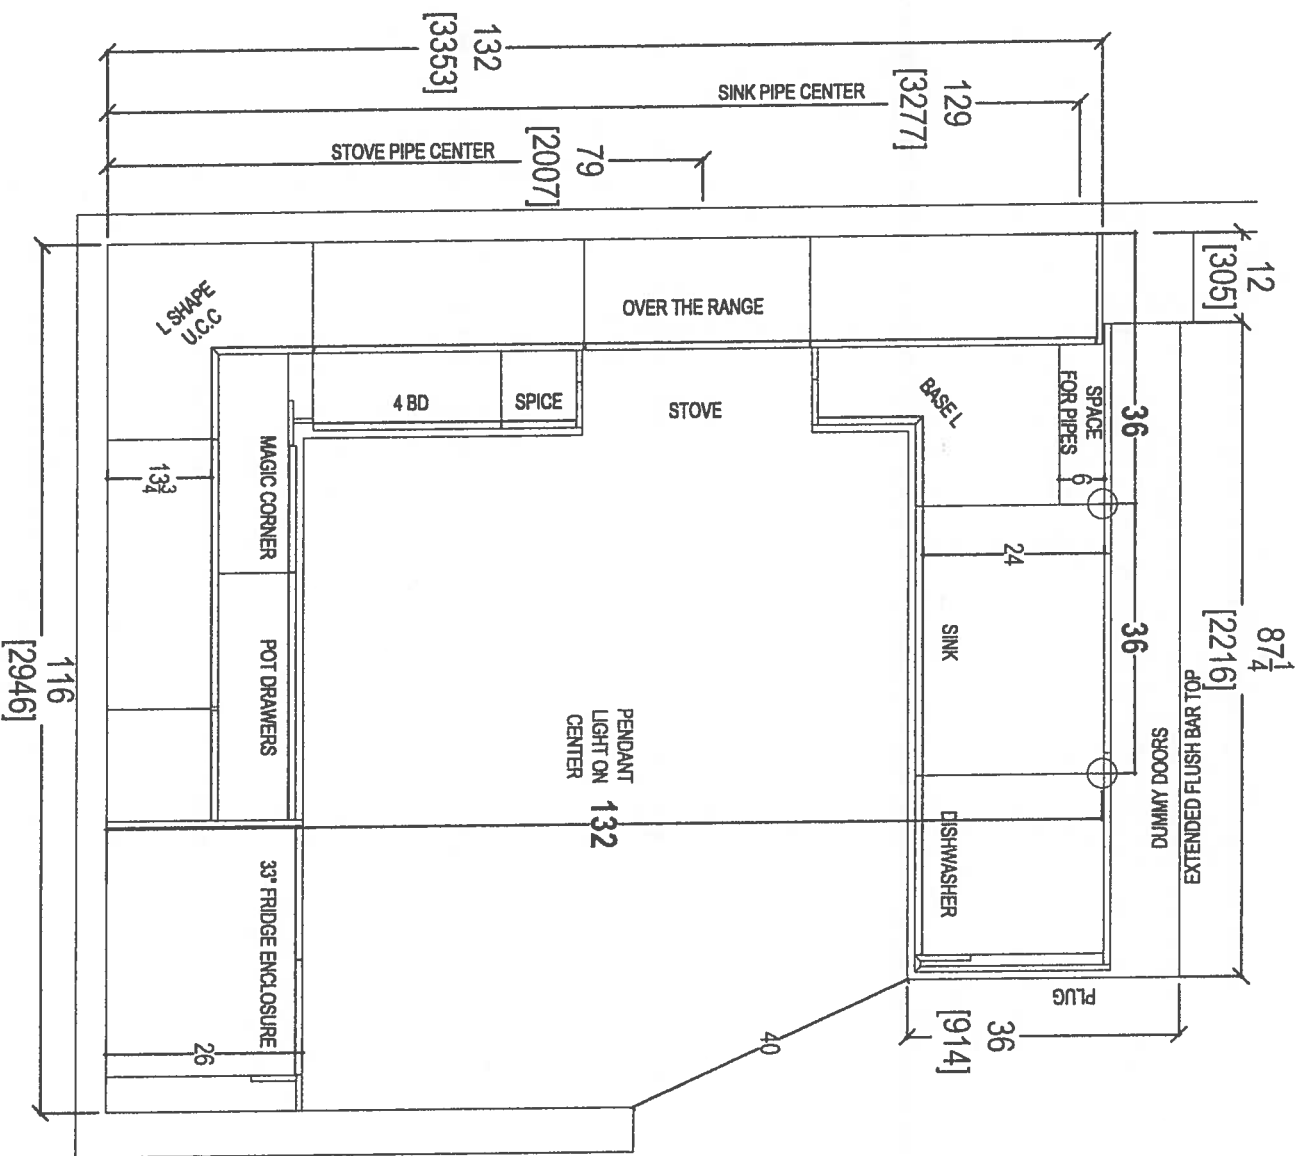


CLIENT: ROYAL PINE HOMES	JOB NAME: UNIT 407 HMP	ROOM: KITCHEN FLOOR PLAN	DRAWN BY: SK
SITE: HAMPTON PLACE	DOOR STYLE: —	DOOR HANDLE: —	SCALE: 1/2" = 1' - 0"
PHONE: —	FINISH: —	DRW HANDLE: —	DATE: APRIL 27, 2018
EMAIL: —	SPECIES: —	TOP: —	PAGE: —



your kitchen, your taste
80 SANTE DRIVE, VAUGHAN, ON L4K 3C4,
T: 416.746.1811 F: 416.746.15901

COMMENTS:
PLEASE NOTE ALL DIMENSIONS
ARE NOT FINAL AND ARE
SUBJECT TO CHANGE UPON
FINAL SITE MEASURE

6

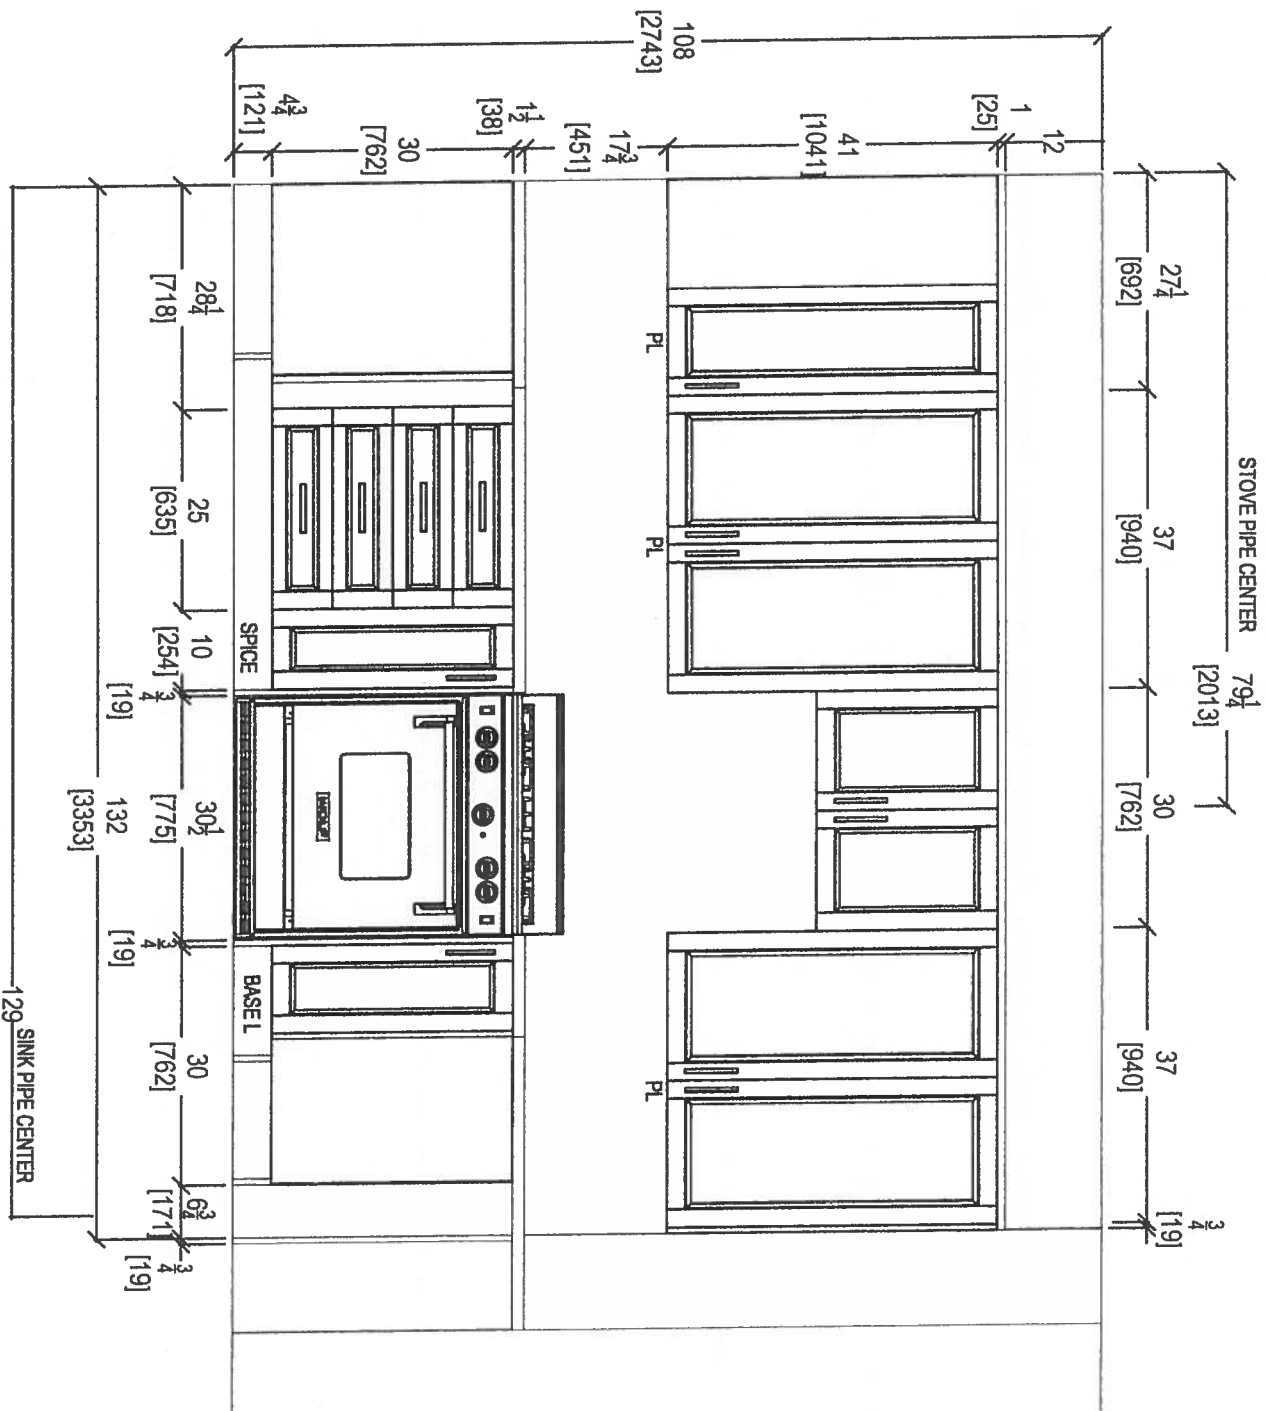


STOVE WALL ELEVATION

CLIENT: ROYAL PINE HOMES	JOB NAME: UNIT 407 HMP	ROOM: KITCHEN	DRAWN BY: SK	COMMENTS:
SITE: HAMPTON PLACE	DOOR STYLE: —	DOOR HANDLE: —	SCALE: 1/2" = 1'-0"	PLEASE NOTE ALL DIMENSIONS ARE NOT FINAL AND ARE SUBJECT TO CHANGE UPON FINAL SITE MEASURE
PHONE: —	FINISH: —	DRW HANDLE: —	DATE: APRIL 27, 2018	
EMAIL: —	SPECIES: —	TOP: —	PAGE: —	



your kitchen, your taste
80 SANTE DRIVE, VAUGHAN, ON L4K 3C4,
T: 416.748.1811 F: 416.748.1801

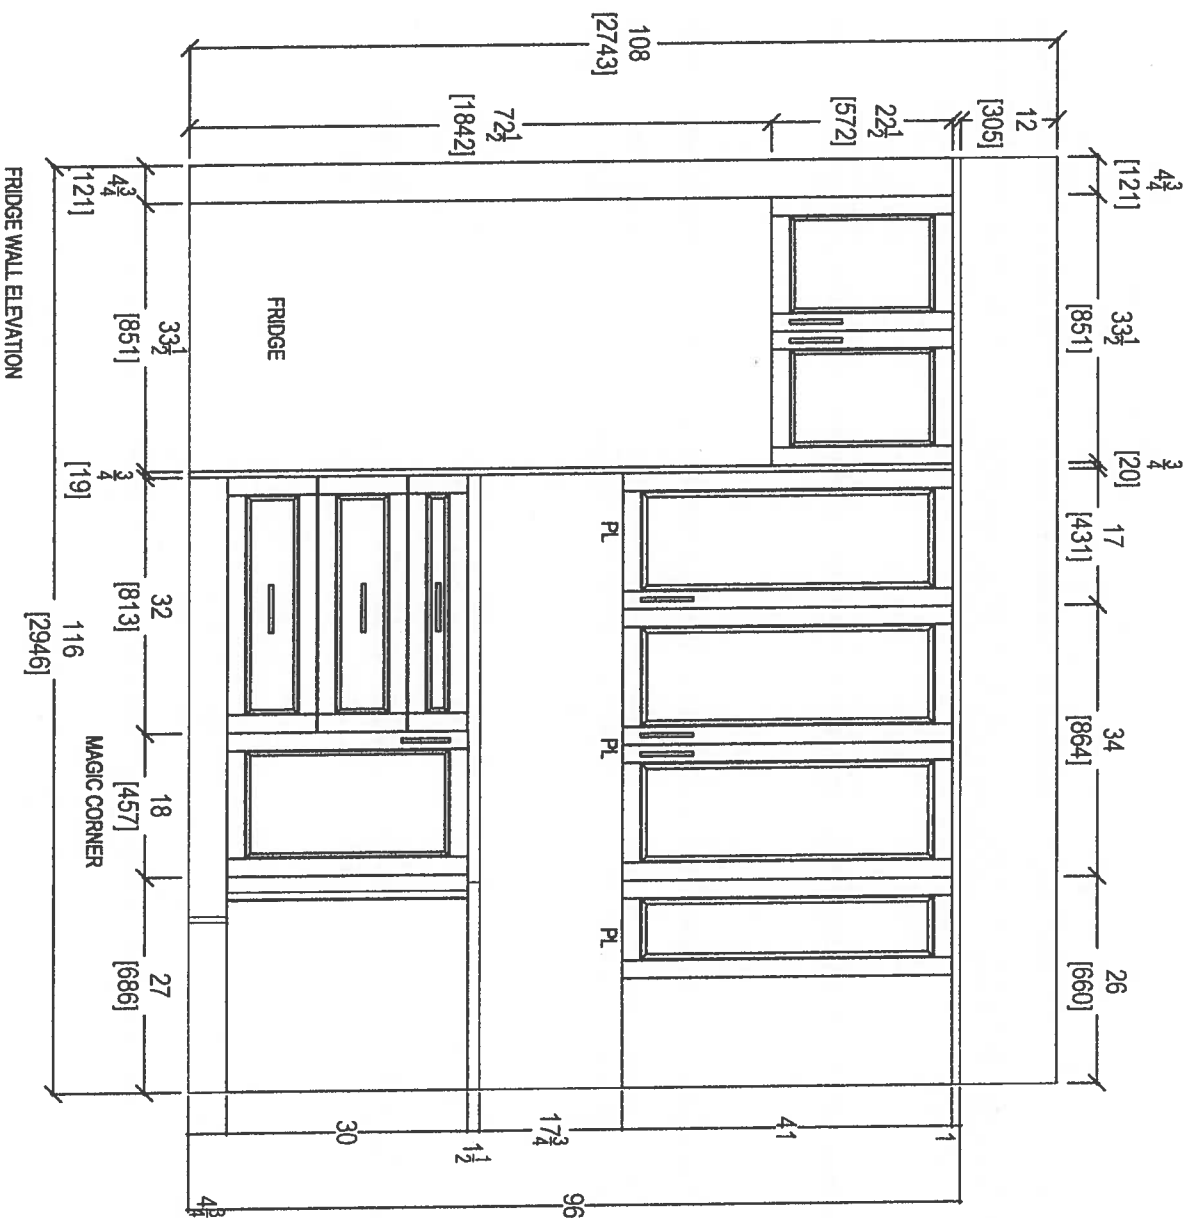


CLIENT: ROYAL PINE HOMES	JOB NAME: UNIT 407 HMP	ROOM: KITCHEN	DRAWN BY: SK
SITE: HAMPTON PLACE	DOOR STYLE: —	DOOR HANDLE: —	SCALE: 1/2" = 1' - 0"
PHONE: —	FINISH: —	DRW HANDLE: —	DATE: APRIL 27, 2018
EMAIL: —	SPECIES: —	TOP: —	PAGE: —

COMMENTS:


PLEASE NOTE ALL DIMENSIONS
ARE NOT FINAL AND ARE
SUBJECT TO CHANGE UPON
FINAL SITE MEASURE



80 SANTE DRIVE, VAUGHAN, ON L4K 3C4,
T: 416.746.1811 F: 416.746.1801

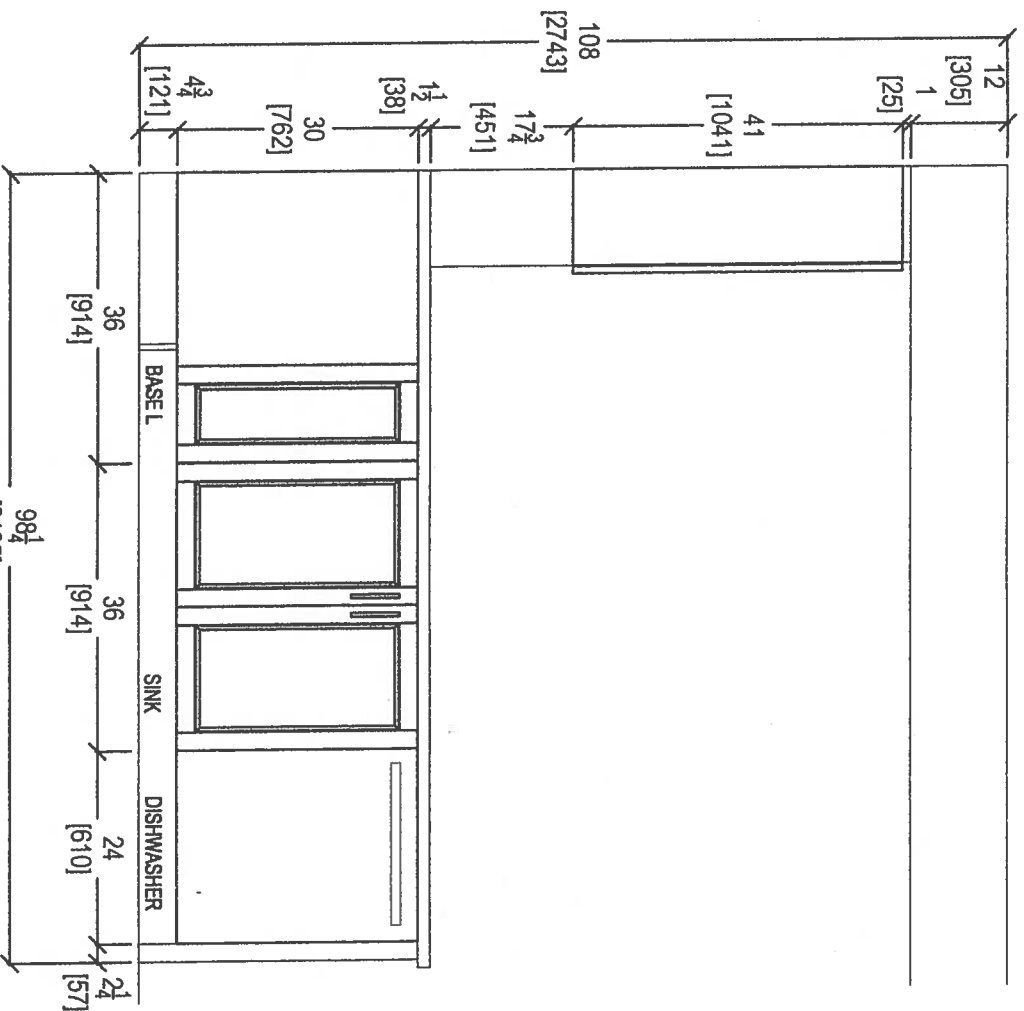


KITCHEN PENINSULA ELEVATION
FRONT VIEW

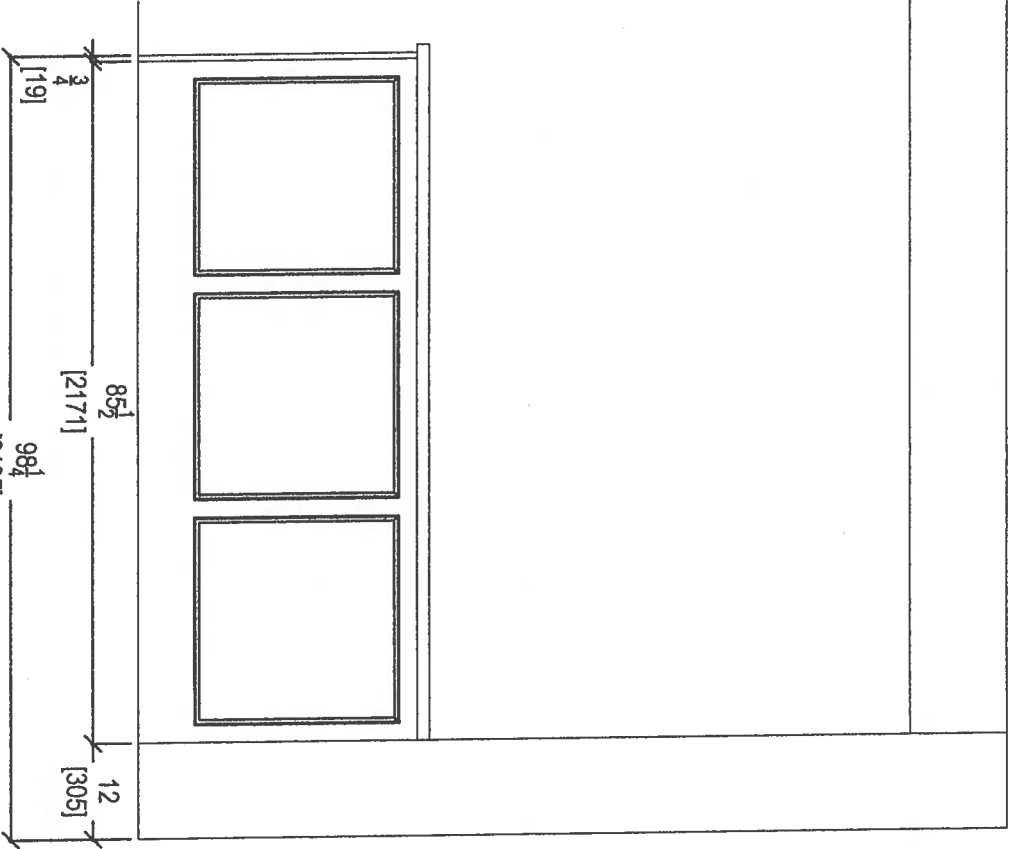


KITCHEN PENINSULA ELEVATION
REAR VIEW



 your kitchen, your taste. 80 SANTE DRIVE, VAUGHAN, ON L4K 3C4, T: 416.746.1811 F: 416.746.15901		CLIENT: ROYAL PINE HOMES	JOB NAME: UNIT 407 HMP	ROOM: KITCHEN	DRAWN BY: SK	COMMENTS: PLEASE NOTE ALL DIMENSIONS ARE NOT FINAL AND ARE SUBJECT TO CHANGE UPON FINAL SITE MEASURE
SITE: HAMPTON PLACE		DOOR STYLE: —	DOOR HANDLE: —	SCALE: 1/2" = 1'-0"		
PHONE: —		FINISH: —	DRW HANDLE: —	DATE: APRIL 27, 2018		
EMAIL: —		SPECIES: —	TOP: —	PAGE: —		

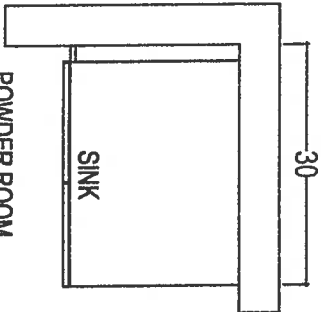

POWDER ROOM

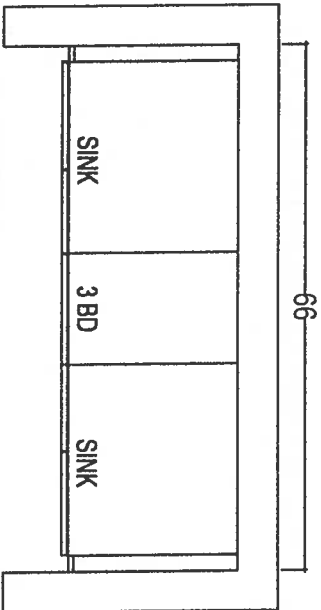

MASTER ENSUITE

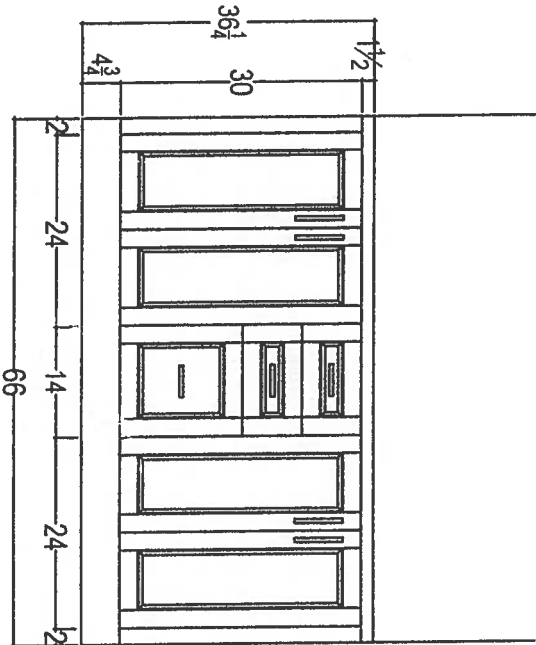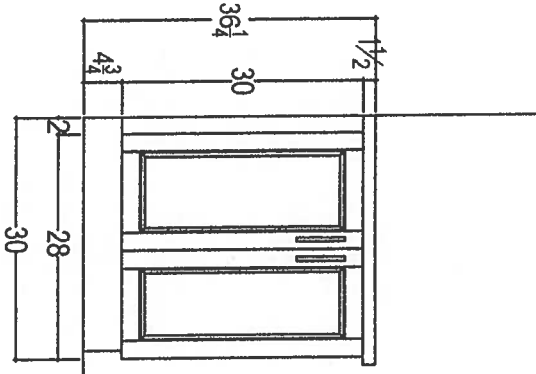

80 SANTE DRIVE, VAUGHAN, ON L4K 3C4,
T: 416.746.1811 F: 416.746.1590

CLIENT: ROYAL PINE HOMES	JOB NAME: UNIT 407 HMP	ROOM: VANITIES	DRAWN BY: SK
SITE: HAMPTON PLACE	DOOR STYLE: —	DOOR HANDLE: —	SCALE: 1/2" = 1'-0"
PHONE: —	FINISH: —	DRW HANDLE: —	DATE: APRIL 27, 2018
EMAIL: —	SPECIES: —	TOP: —	PAGE: —

COMMENTS:
PLEASE NOTE ALL DIMENSIONS
ARE NOT FINAL AND ARE
SUBJECT TO CHANGE UPON
FINAL SITE MEASURE