







Sag Harbor

878 SQ FT *plus 119 sq. ft. of balcony area*


ORIGINAL Suite

Suite #418

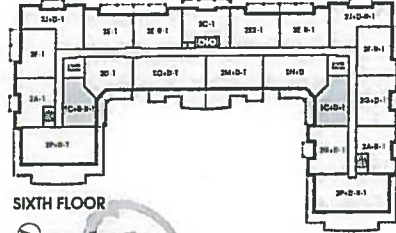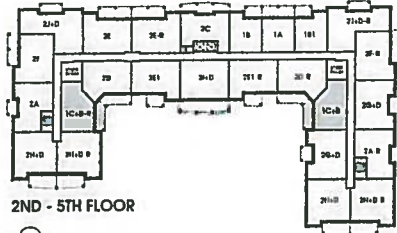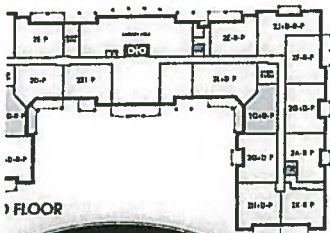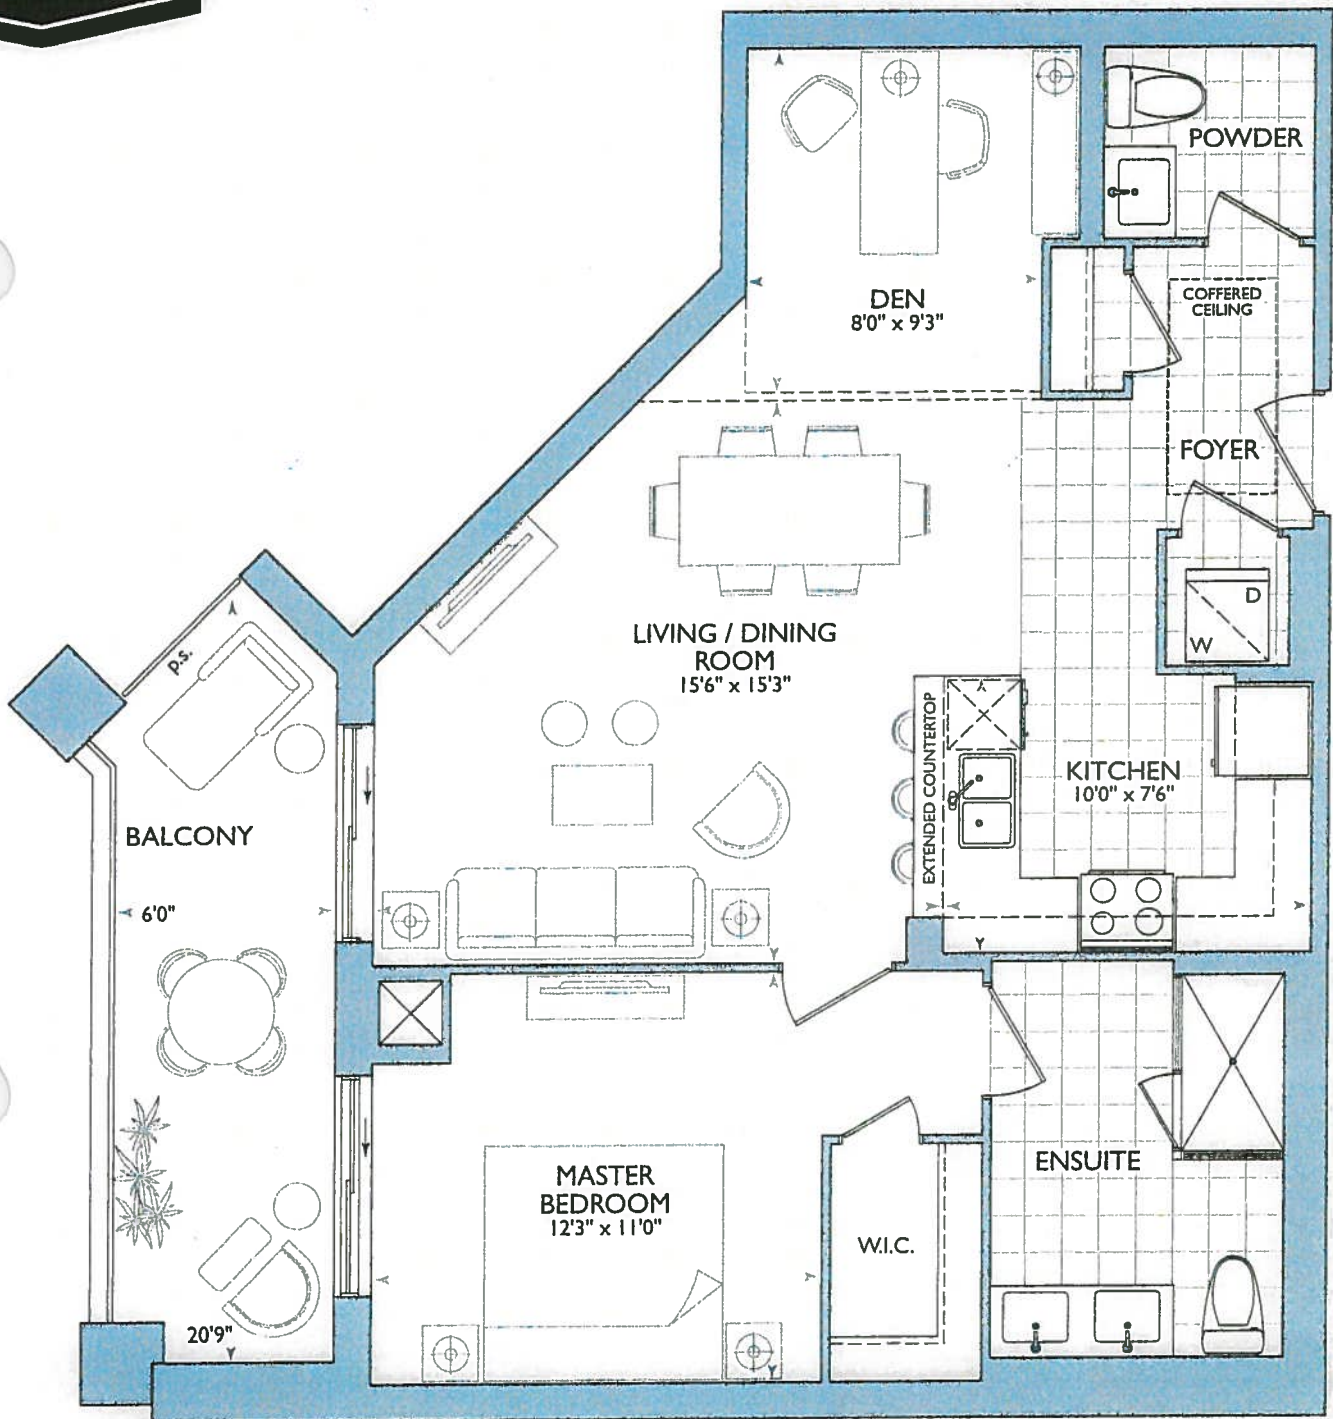


INVENTORY SUITE

* MOVE FRONT DOOR
DUE TO 6" WALL
BEHIND WASHT/ DRYER

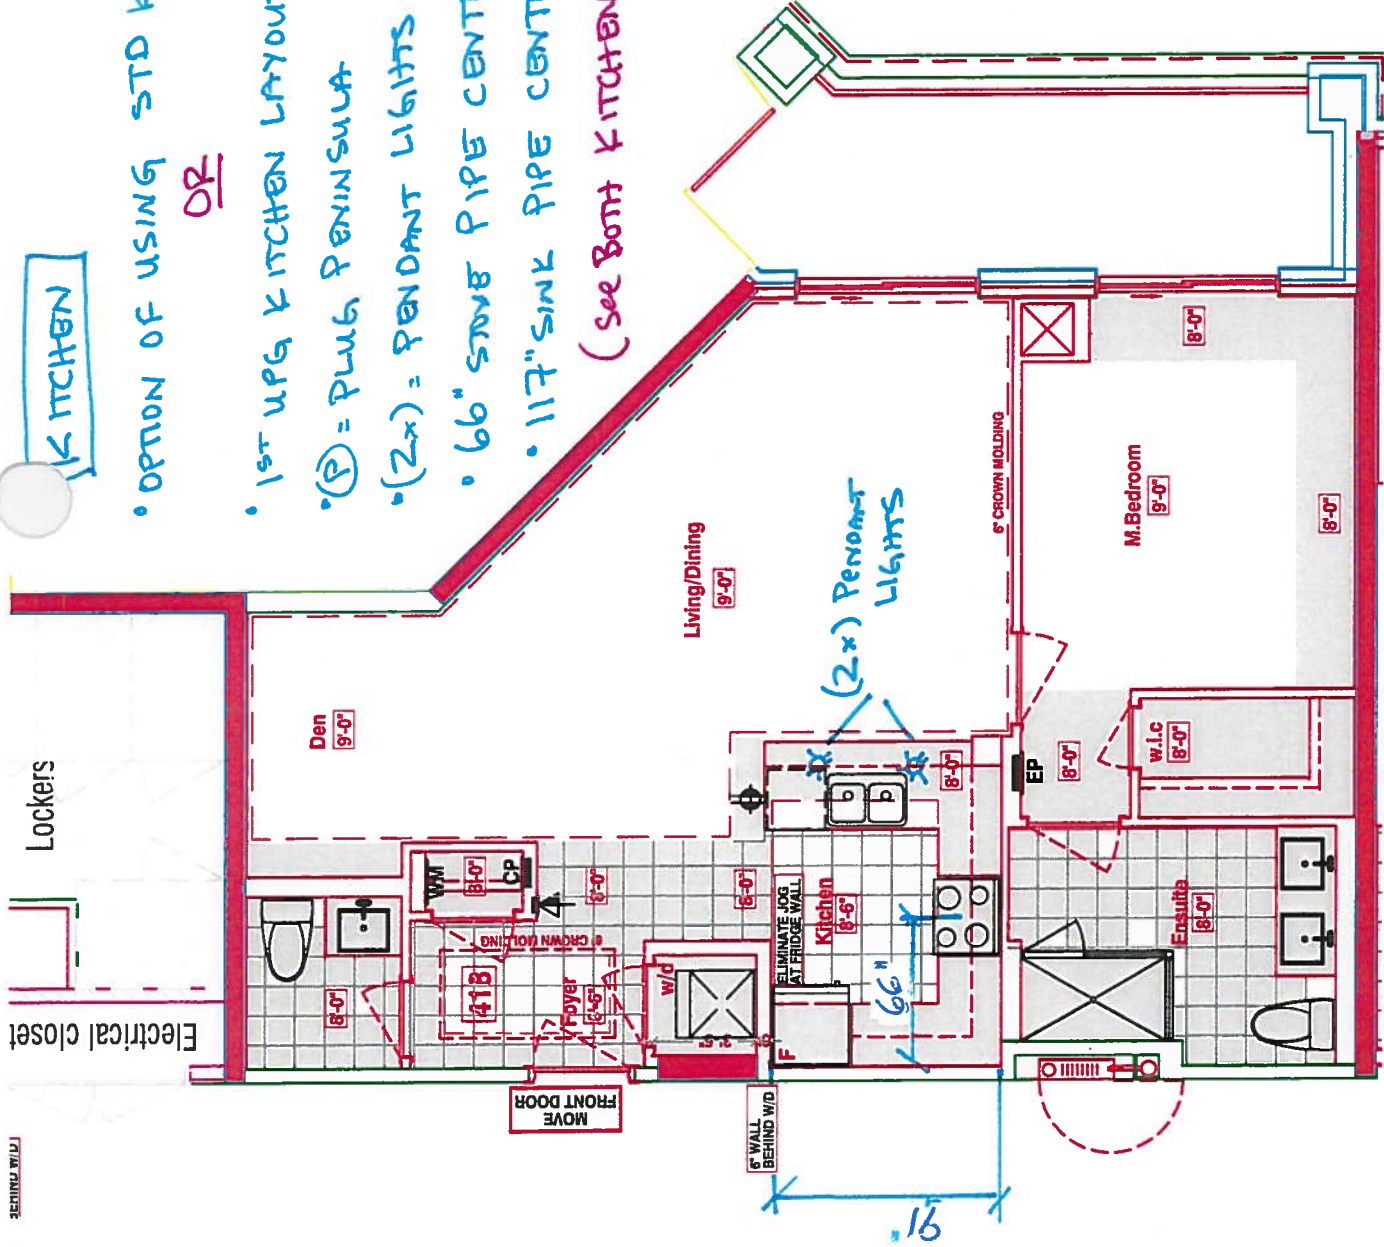


- OPTION OF USING STD KITCHEN LAYOUT w/ STD APPLIANCE PACKAGE
 - 1ST UPG KITCHEN LAYOUT w/ 1ST UPG APPLIANCE PACKAGE
 - (P) = PLUG PENINSULA
 - (2x) = PENDANT LIGHTS OVER PENINSULA
 - 66" STOVE PIPE CENTER
 - 117" SINK PIPE CENTER
- (SEE BOTH KITCHEN LAYOUT OPTIONS)

STANDARD


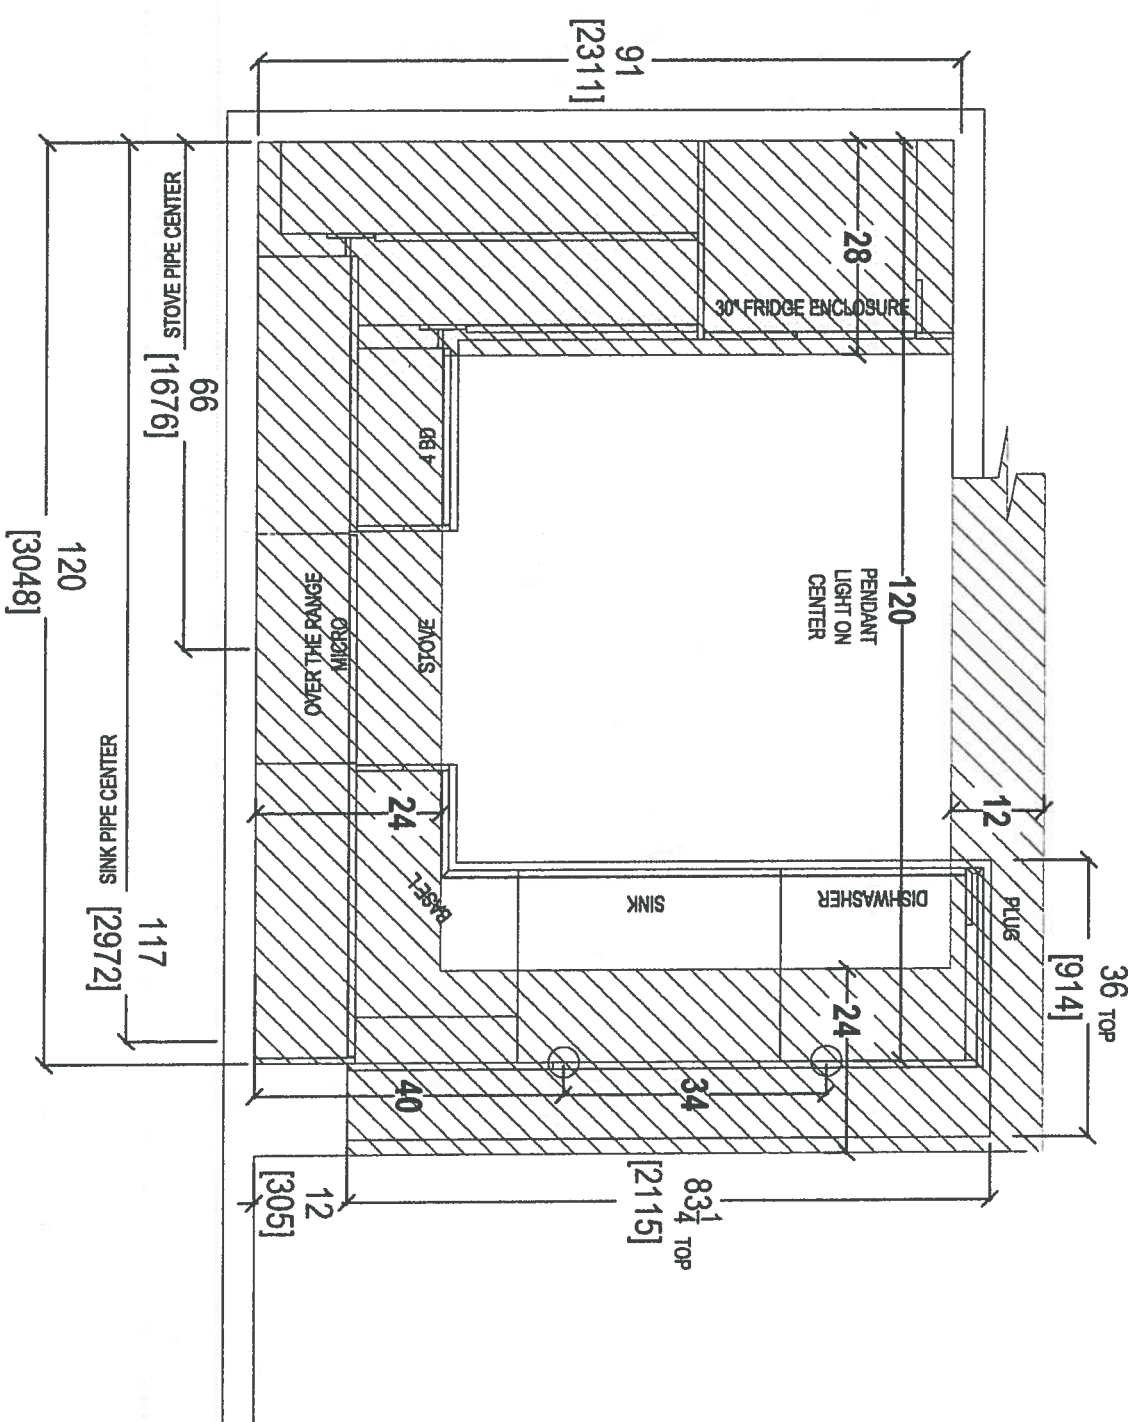


your kitchen. your taste.
80 SANTE DRIVE, VAUGHAN, ON L4K 3C4
T: 416.746.1811 F: 905.761.5801

CLIENT: ROYAL PINE HOMES	JOB NAME: UNIT 418 HMP	ROOM: <u>STANDARD</u>	KITCHEN BULKHEAD PLAN	DRAWN BY: SK	COMMENTS: PLEASE NOTE ALL DIMENSIONS ARE NOT FINAL AND ARE SUBJECT TO CHANGE UPON FINAL SITE MEASURE
SITE: HAMPTON PLACE	DOOR STYLE: —	DOOR HANDLE: —	SCALE: 1/2" = 1' - 0"		
PHONE: —	FINISH: —	DRW HANDLE: —	DATE: MAY 8, 2018		
EMAIL: —	SPECIES: —	TOP: —	PAGE: —		

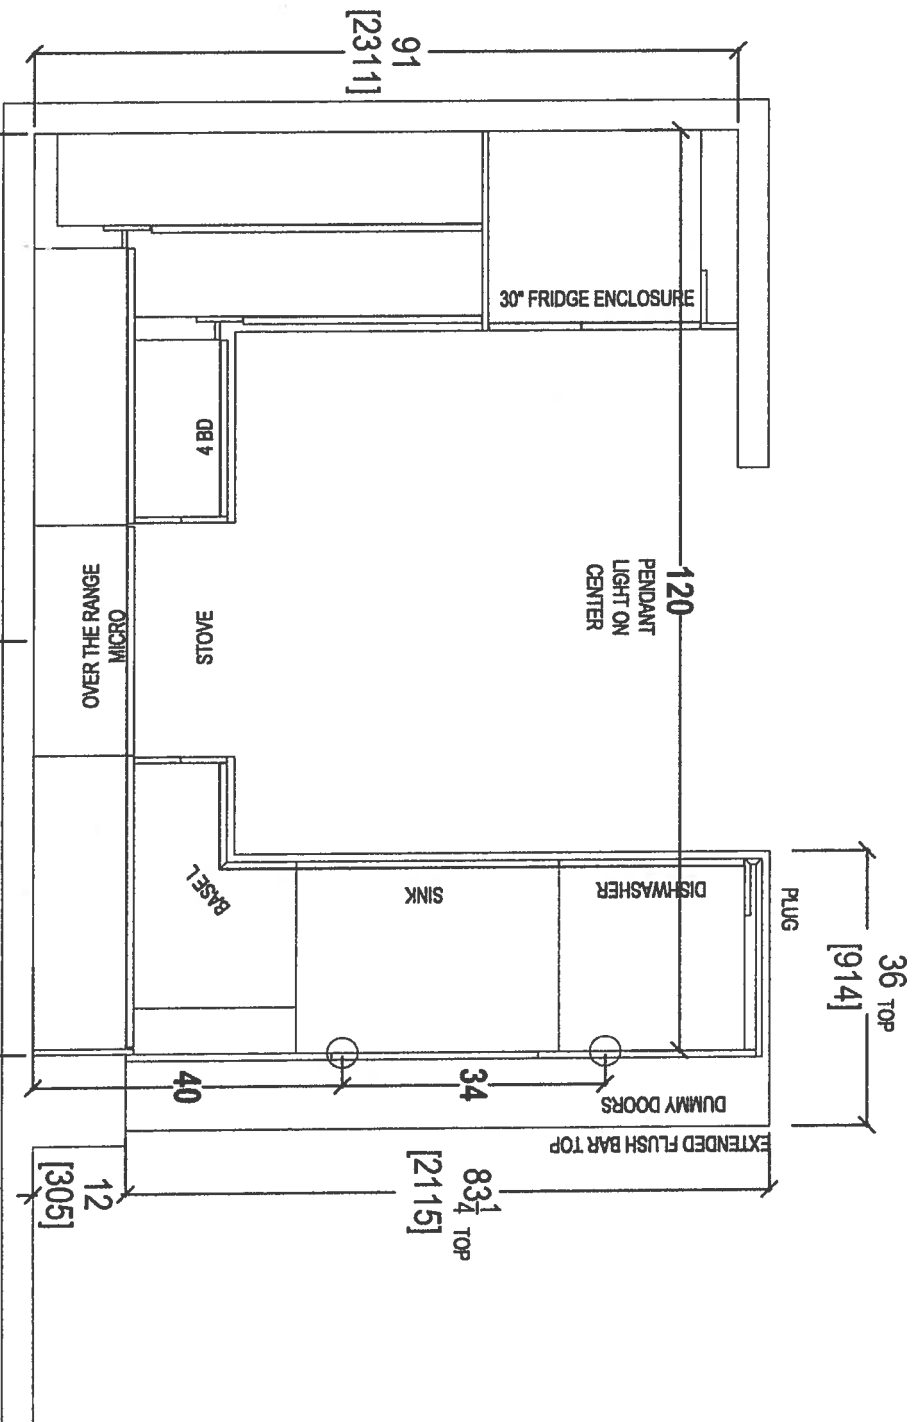

 your kitchen your taste 80 SANTE DRIVE, VAUGHAN, ON L4K 3C4, T: 416.746.1811 F: 905.761.5901		CLIENT: ROYAL PINE HOMES		JOB NAME: UNIT 418 HMP STAND-ALONE		ROOM: KITCHEN BULKHEAD PLAN		DRAWN BY: SK		COMMENTS: PLEASE NOTE ALL DIMENSIONS ARE NOT FINAL AND ARE SUBJECT TO CHANGE UPON FINAL SITE MEASURE
SITE: HAMPTON PLACE		DOOR STYLE: —		DOOR HANDLE: —		SCALE: 1/2" = 1'-0"				
PHONE: —		FINISH: —		DRW HANDLE: —		DATE: MAY 8, 2018				
EMAIL: —		SPECIES: —		TOP: —		PAGE: —				

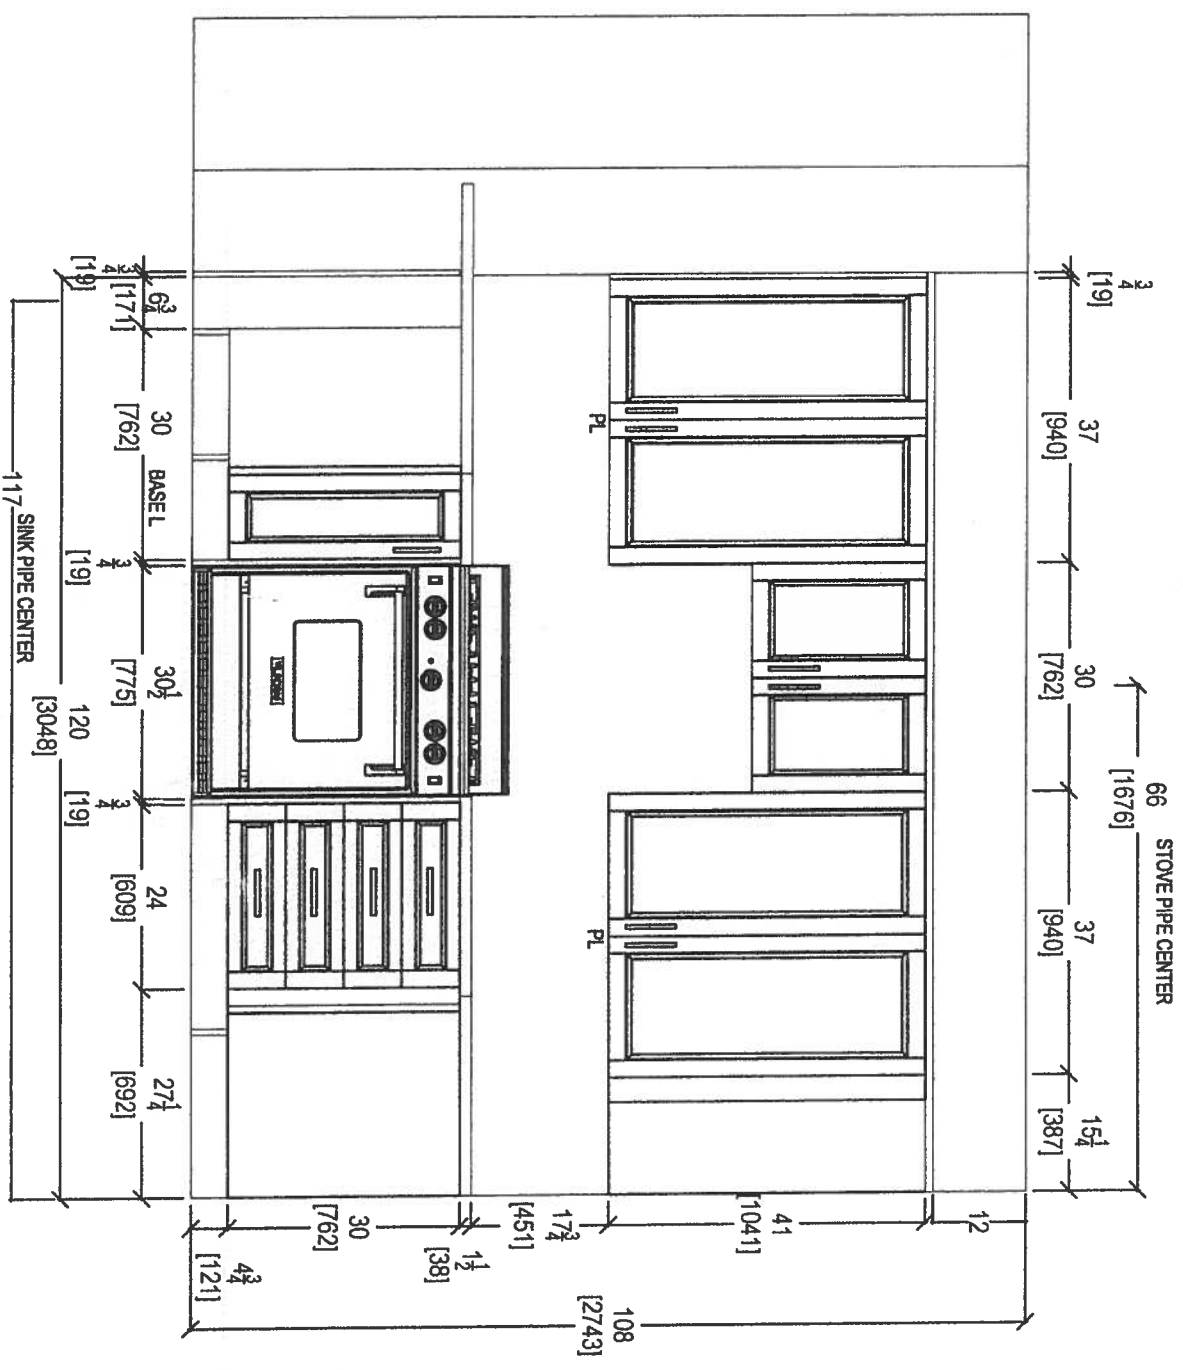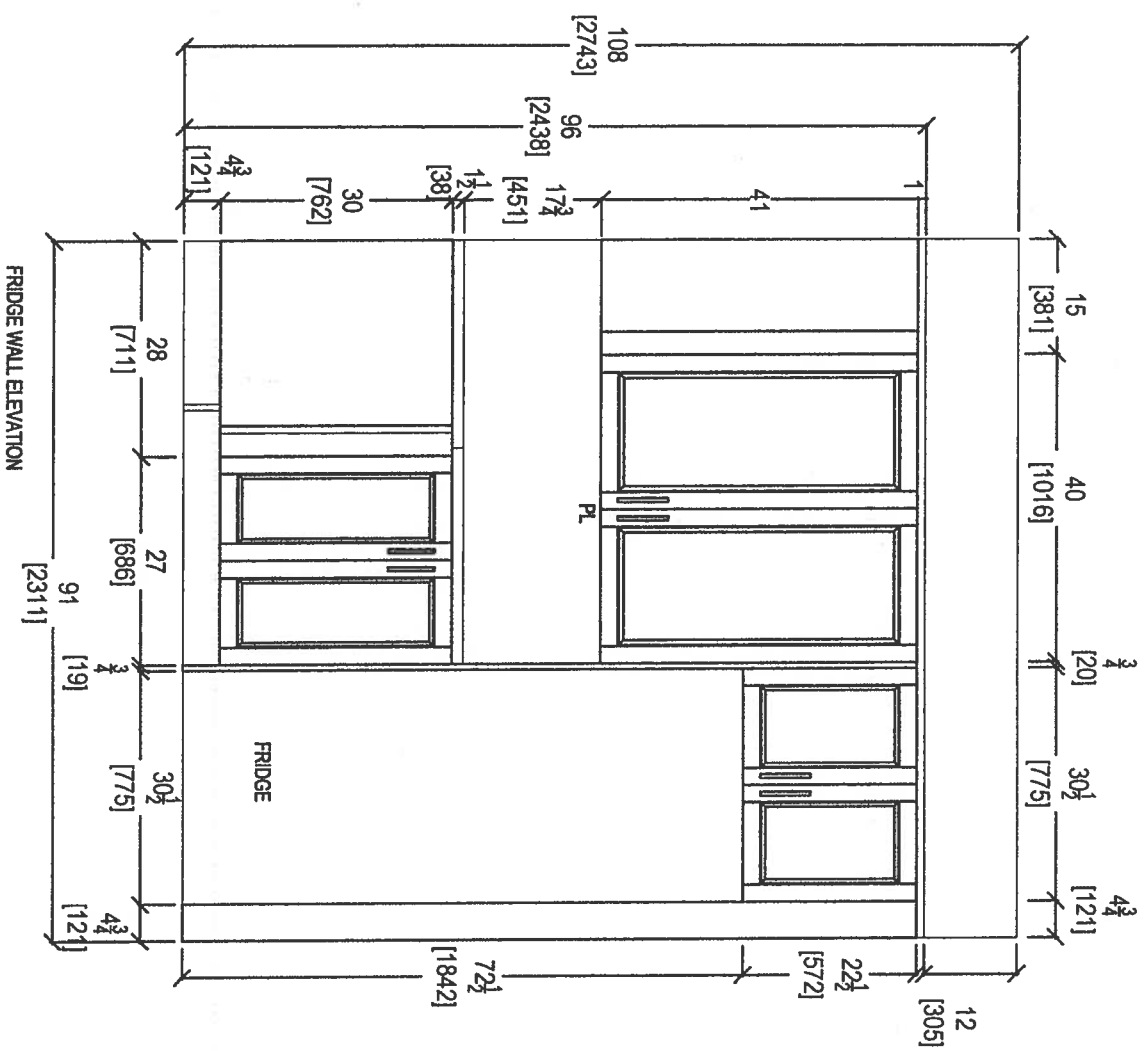

CLIENT: ROYAL PINE HOMES

JOB NAME: UNIT 418 HMP STANDARD

ROOM: KITCHEN

DRAWN BY: SK

COMMENTS:

SITE: HAMPTON PLACE

DOOR STYLE: —

DOOR HANDLE: —

SCALE: 1/2" = 1'-0"

1

[illegible][illegible]

EMAIL: _____

SPECIES


TOP: _____

PAGE: _____


**PLEASE NOTE ALL DIMENSIONS
ARE NOT FINAL AND ARE
SUBJECT TO CHANGE UPON
FINAL SITE MEASURE**




your kitchen, your taste.
80 SANTE DRIVE, VAUGHAN, ON L4K 3C4,
T: 416.748.1811 F: 905.761.5901

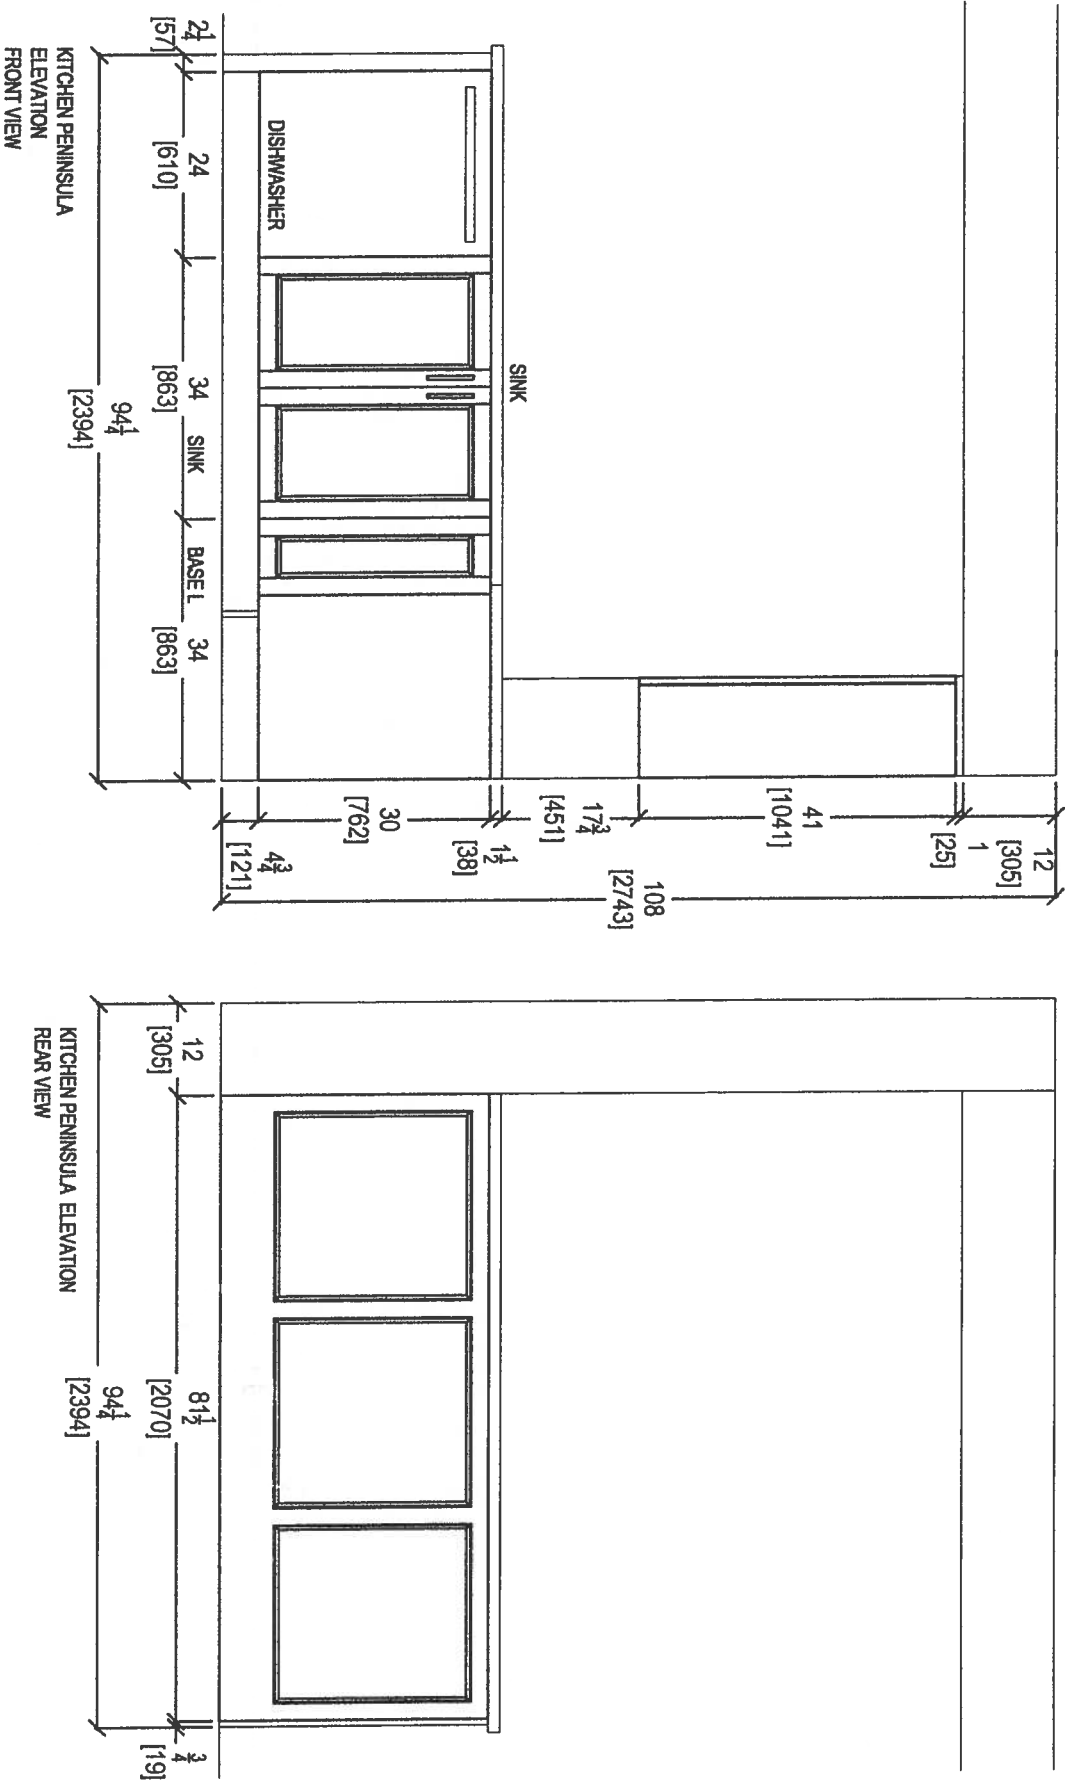



 your kitchen, your taste 80 SANTE DRIVE, VAUGHAN, ON L4K 3C4, T: 416.746.1811 F: 905.761.5901		CLIENT: ROYAL PINE HOMES		JOB NAME: UNIT 418 HMP <i>STANLEY</i>		ROOM: KITCHEN		DRAWN BY: SK		COMMENTS:
SITE: HAMPTON PLACE		DOOR STYLE: —		DOOR HANDLE: —		SCALE: 1/2" = 1' - 0"				
PHONE: —		FINISH: —		DRW HANDLE: —		DATE: MAY 8, 2018				
EMAIL: —		SPECIES: —		TOP: —		PAGE: —				

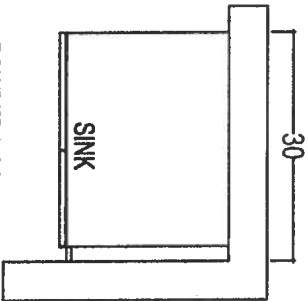

POWDER ROOM

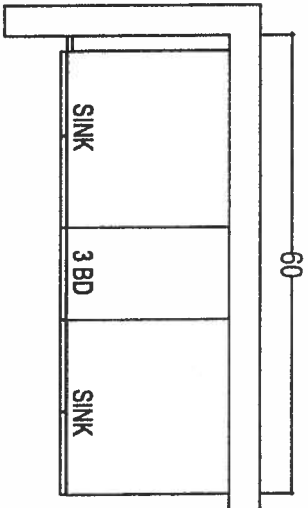

MASTER ENSUITE

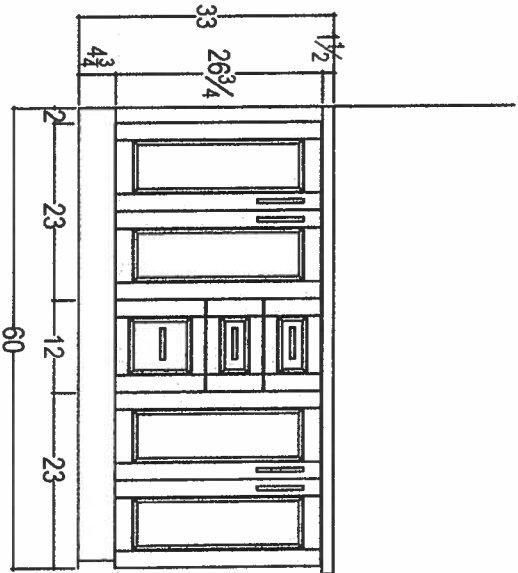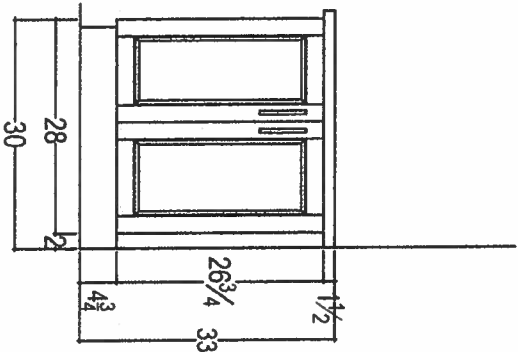

your kitchen, your taste.
80 SANTE DRIVE, VAUGHAN, ON L4K 3C4,
T: 416.748.1811 F: 905.761.5901

CLIENT: ROYAL PINE HOMES	JOB NAME: UNIT 418 HMP ST AND AVE	ROOM: VANITIES	DRAWN BY: SK
SITE: HAMPTON PLACE	DOOR STYLE: —	DOOR HANDLE: —	SCALE: 1/2" = 1' - 0"
PHONE: —	FINISH: —	DRW HANDLE: —	DATE: MAY 8, 2018
EMAIL: —	SPECIES: —	TOP: —	PAGE: —


COMMENTS:
PLEASE NOTE ALL DIMENSIONS
ARE NOT FINAL AND ARE
SUBJECT TO CHANGE UPON
FINAL SITE MEASURE

* UPGRADE *




your kitchen. your taste.
80 SANTE DRIVE, VAUGHAN, ON L4K 3C4,
T: 416.746.1811 F: 905.741.5801

CLIENT: ROYAL PINE HOMES	JOB NAME: UNIT 418 HMP	ROOM: KITCHEN BULKHEAD PLAN	DRAWN BY: SK	COMMENTS: PLEASE NOTE ALL DIMENSIONS ARE NOT FINAL AND ARE SUBJECT TO CHANGE UPON FINAL SITE MEASURE
SITE: HAMPTON PLACE	DOOR STYLE: —	DOOR HANDLE: —	SCALE: 1/2" = 1' - 0"	
PHONE: —	FINISH: —	DRW HANDLE: —	DATE: FEB 16, 2018	
EMAIL: —	SPECIES: —	TOP: —	PAGE: —	


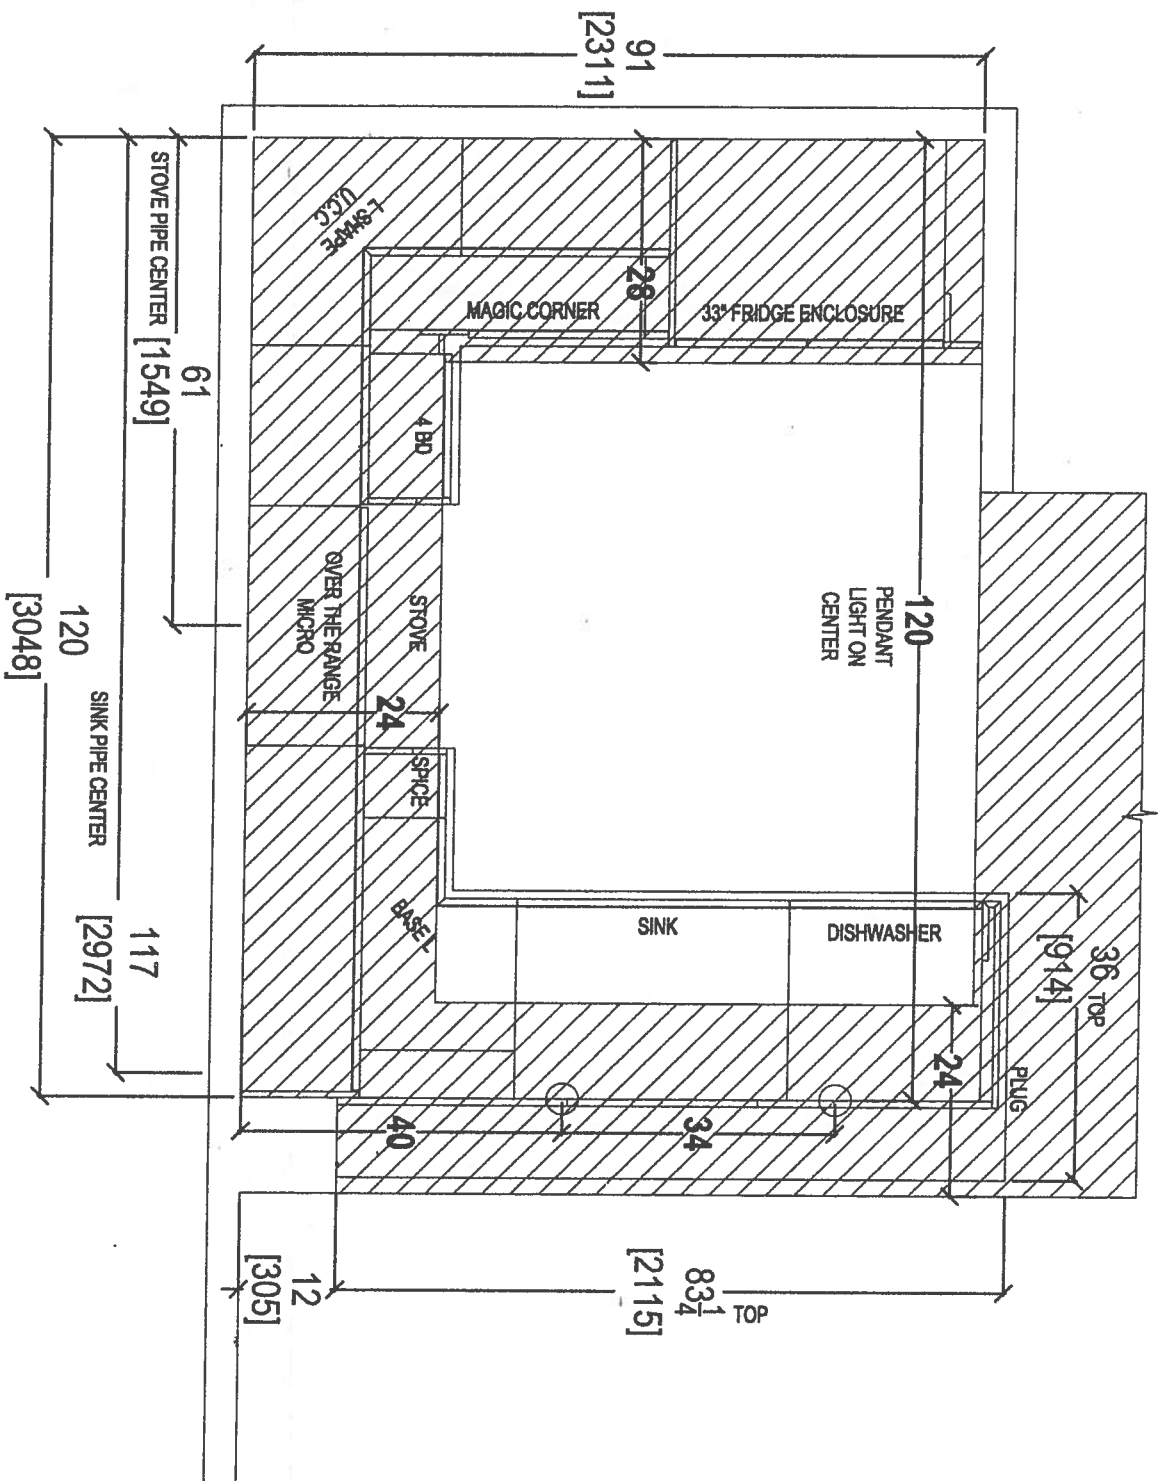


5

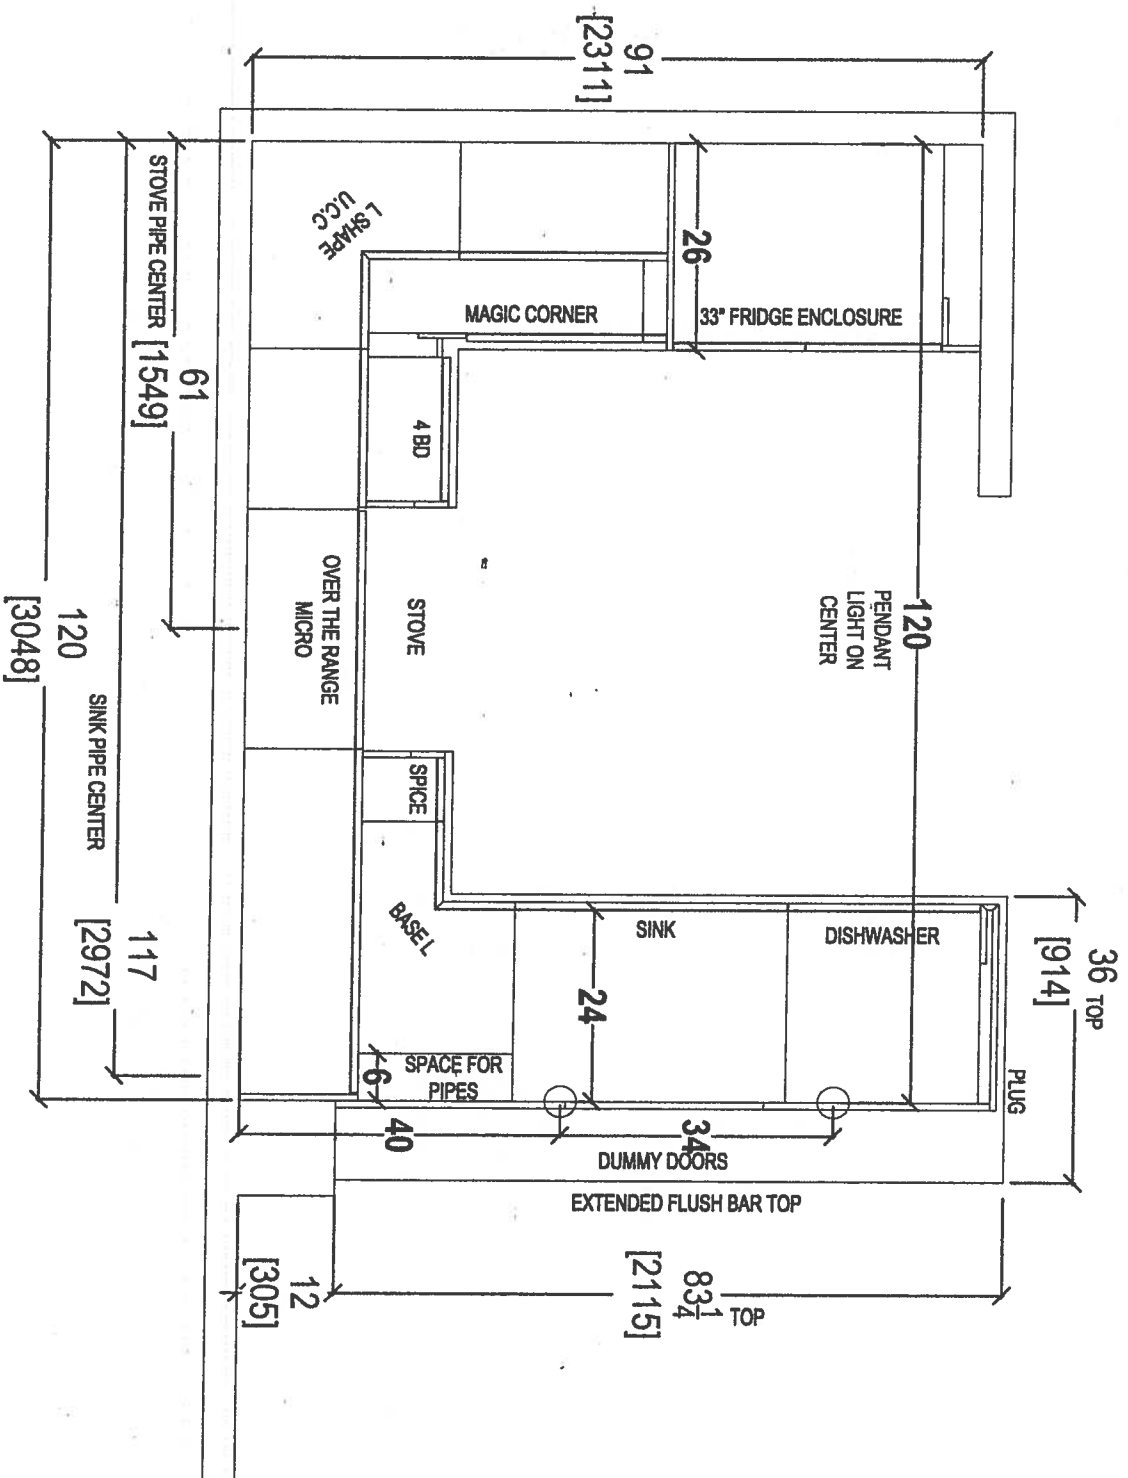

your kitchen, your taste.
80 SANTE DRIVE, VAUGHAN, ON L4K 3C4,
T: 416.746.1811 F: 905.741.5901


CLIENT: ROYAL PINE HOMES		JOB NAME: UNIT 418 HMP		ROOM: KITCHEN BULKHEAD PLAN		DRAWN BY: SK		COMMENTS: PLEASE NOTE ALL DIMENSIONS ARE NOT FINAL AND ARE SUBJECT TO CHANGE UPON FINAL SITE MEASURE
SITE: HAMPTON PLACE		DOOR STYLE: —		DOOR HANDLE: —		SCALE: 1/2" = 1'-0"		
PHONE: —		FINISH: —		DRW HANDLE: —		DATE: FEB 16, 2018		
EMAIL: —		SPECIES: —		TOP: —		PAGE: —		

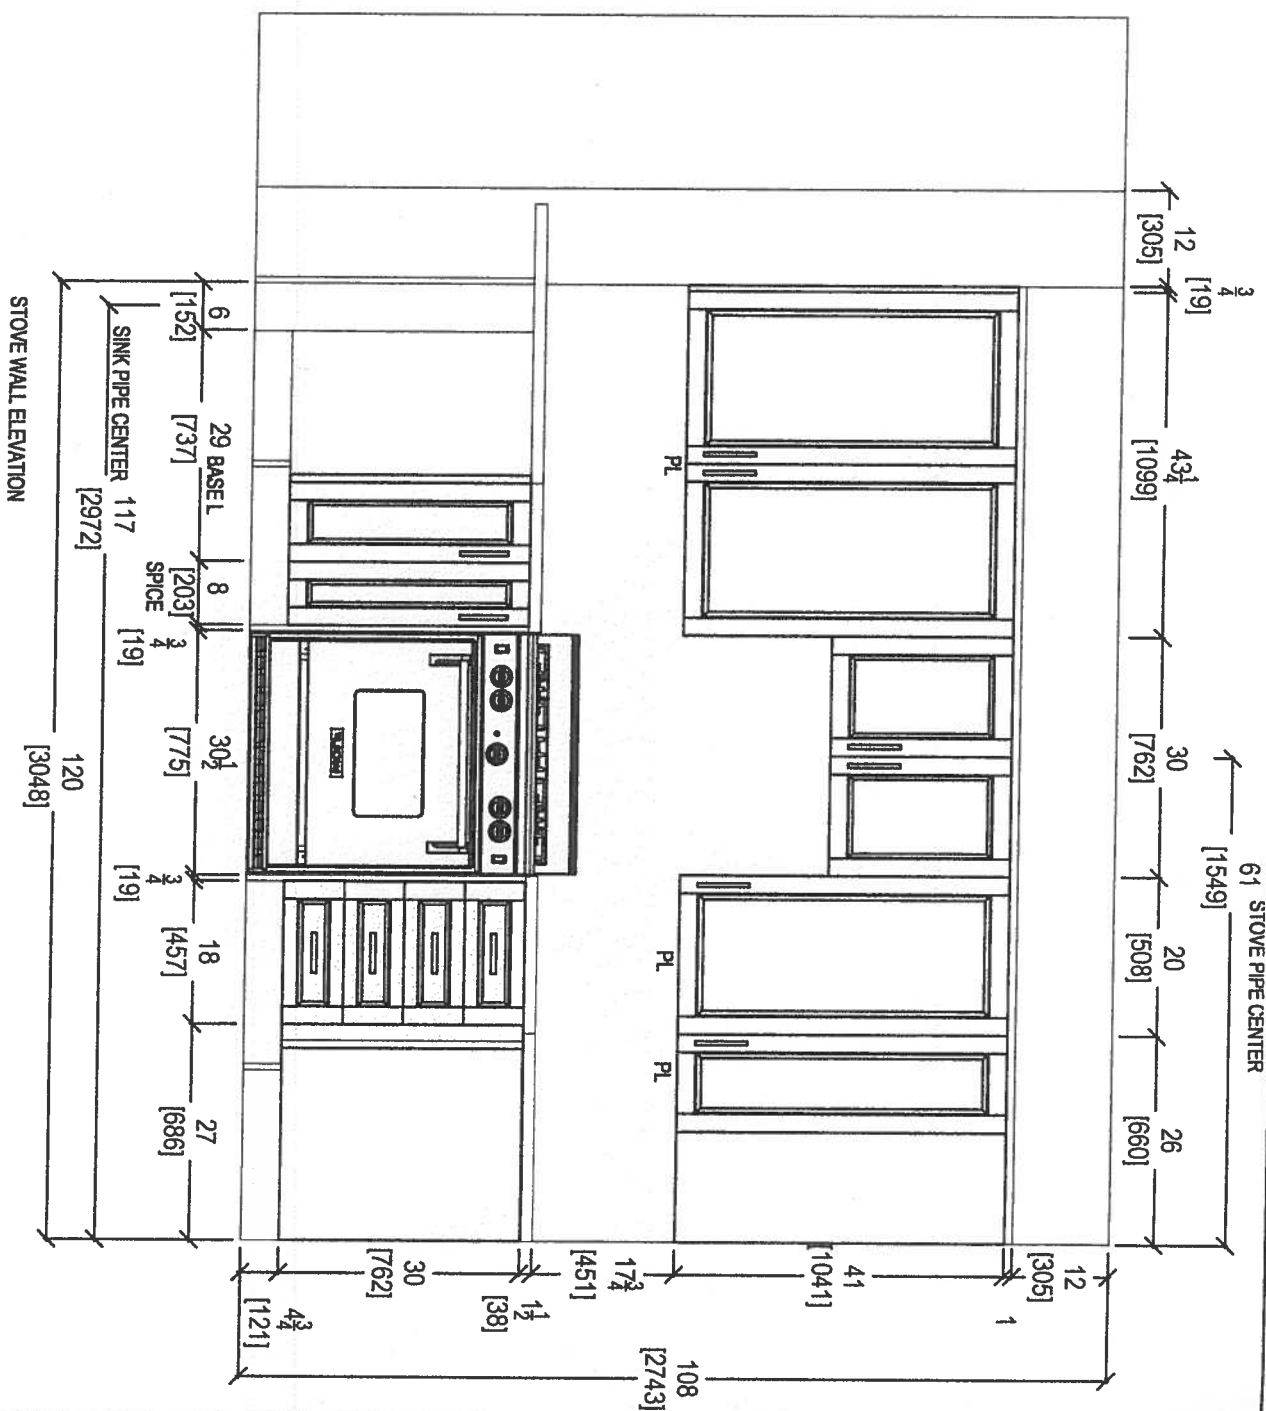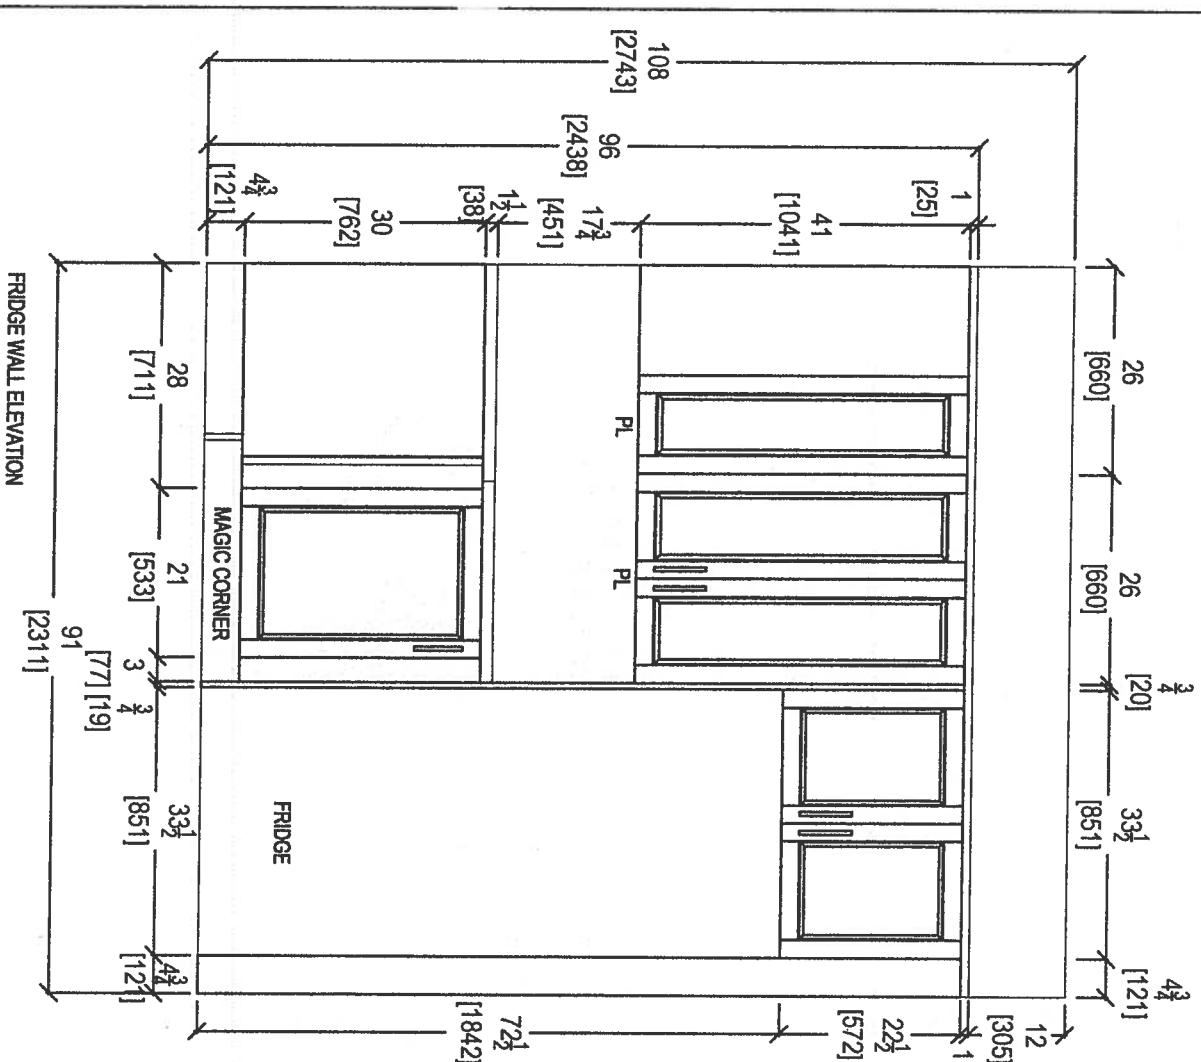

80 SANTE DRIVE, VAUGHAN, ON L4K 3C4,
T: 416.746.1811 F: 905.741.5801

CLIENT: ROYAL PINE HOMES	JOB NAME: UNIT 418 HMP	ROOM: KITCHEN	DRAWN BY: SK	COMMENTS:
SITE: HAMPTON PLACE	DOOR STYLE: —	DOOR HANDLE: —	SCALE: 1/2" = 1'-0"	PLEASE NOTE ALL DIMENSIONS ARE NOT FINAL AND ARE SUBJECT TO CHANGE UPON FINAL SITE MEASURE
PHONE: —	FINISH: —	DRW HANDLE: —	DATE: FEB 16, 2018	
EMAIL: —	SPECIES: —	TOP: —	PAGE: —	

6

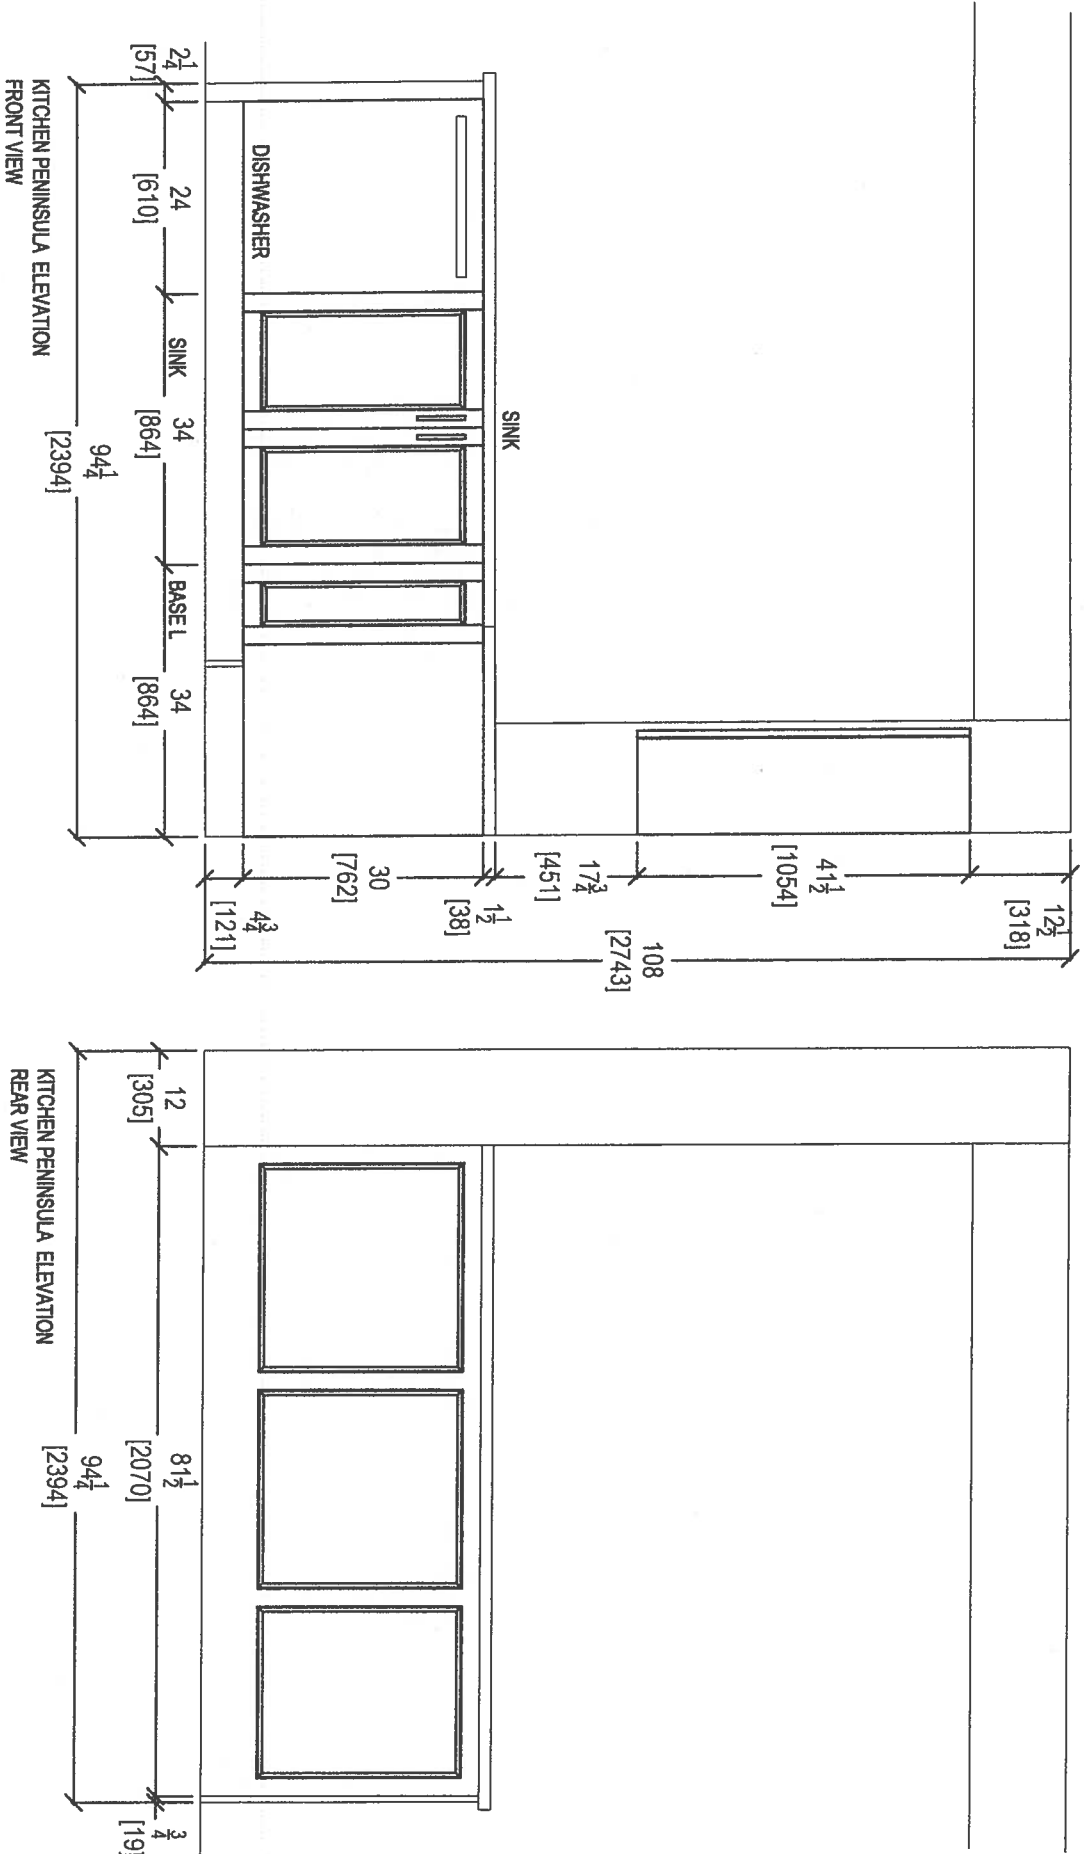


80 SANTE DRIVE, VAUGHAN, ON L4K 3C4,
T: 416.746.1811


CLIENT: ROYAL PINE HOMES	JOB NAME: UNIT 418 HMP	ROOM: KITCHEN	DRAWN BY: SK
SITE: HAMPTON PLACE	DOOR STYLE: —	DOOR HANDLE: —	SCALE: 1/2" = 1'-0"
PHONE: —	FINISH: —	DRW HANDLE: —	DATE: FEB 16, 2018
EMAIL: —	SPECIES: —	TOP: —	PAGE: —

COMMENTS:



6

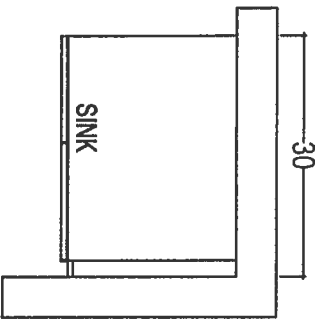

POWDER ROOM

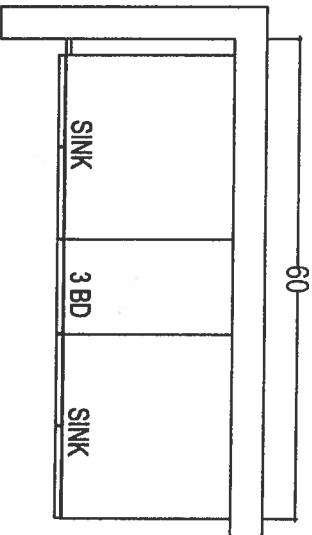

MASTER ENSUITE

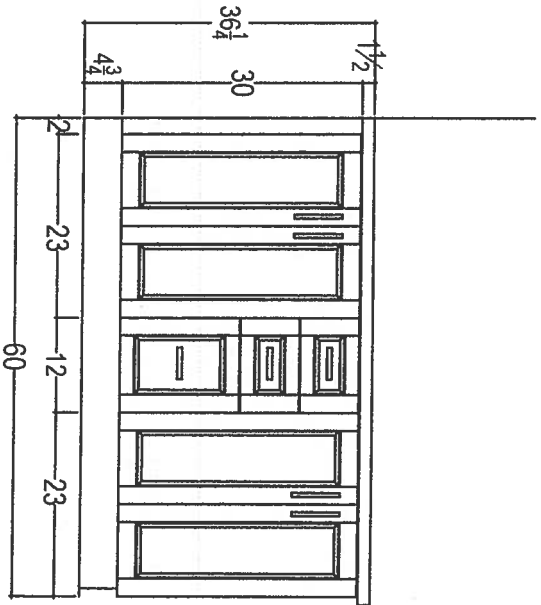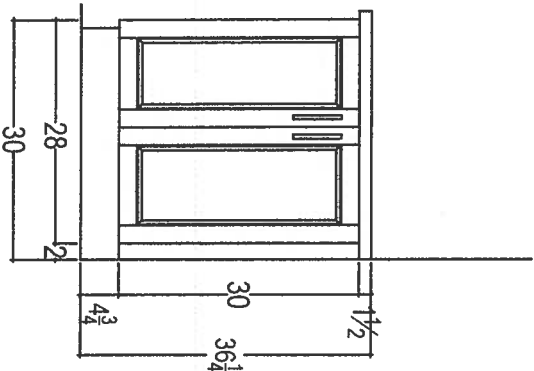

80 SANTE DRIVE, VAUGHAN, ON L4K 3C4,
T. 416.746.1811

CLIENT: ROYAL PINE HOMES	JOB NAME: UNIT 418 HMP	ROOM: VANITIES	DRAWN BY: SK
SITE: HAMPTON PLACE	DOOR STYLE: —	DOOR HANDLE: —	SCALE: 1/2" = 1'-0"
PHONE: —	FINISH: —	DRW HANDLE: —	DATE: FEB 16, 2018
EMAIL: —	SPECIES: —	TOP: —	PAGE: —

COMMENTS:
PLEASE NOTE ALL DIMENSIONS
ARE NOT FINAL AND ARE
SUBJECT TO CHANGE UPON
FINAL SITE MEASURE