








Noyac Bay

Suite 507.

1,121 SQ FT *plus 81 sq. ft. of balcony area*

INVENTORY SUITE
ORIGINAL LAYOUT
(OLD).

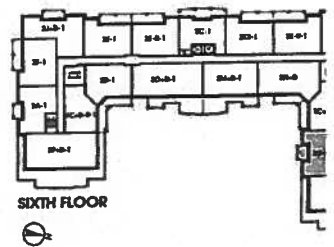
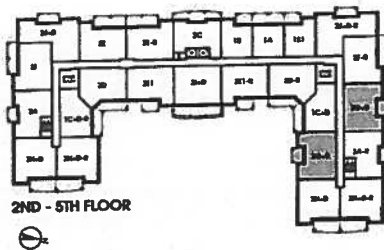
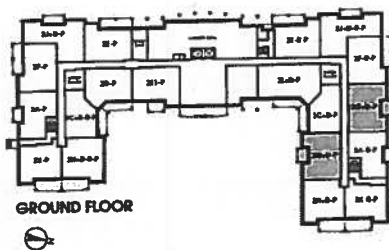
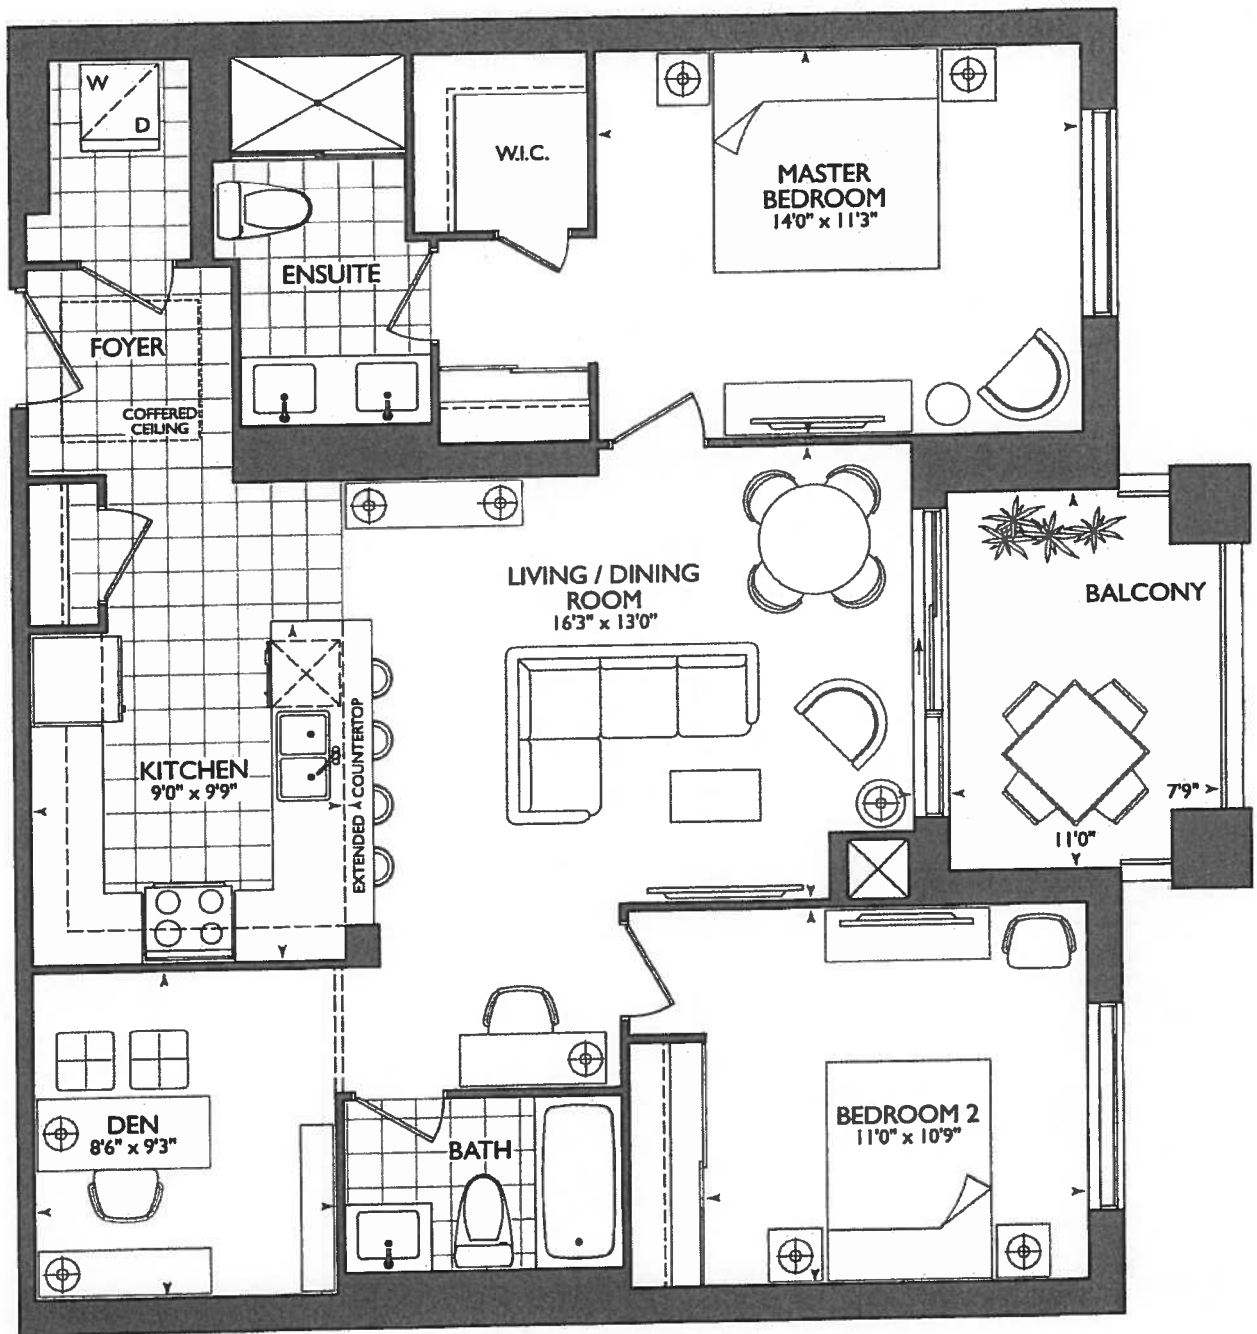


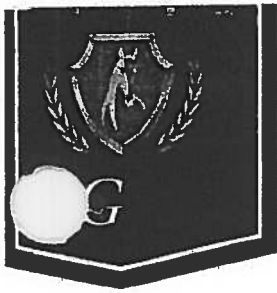

Noyac Bay

1,121 SQ FT *plus* 76sq. ft. of balcony area

SUITE 507
ORIGINAL LAYOUT
INVENTORY SUITE
(new)

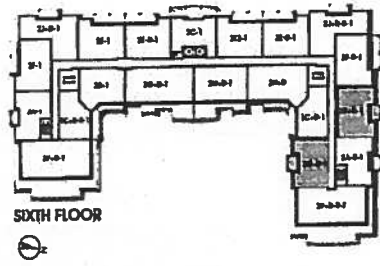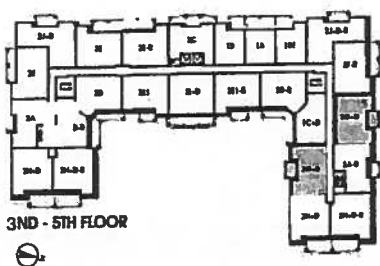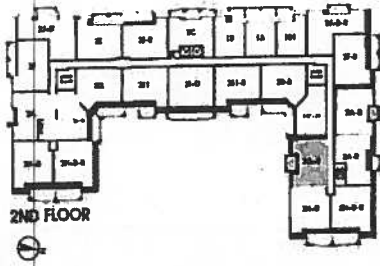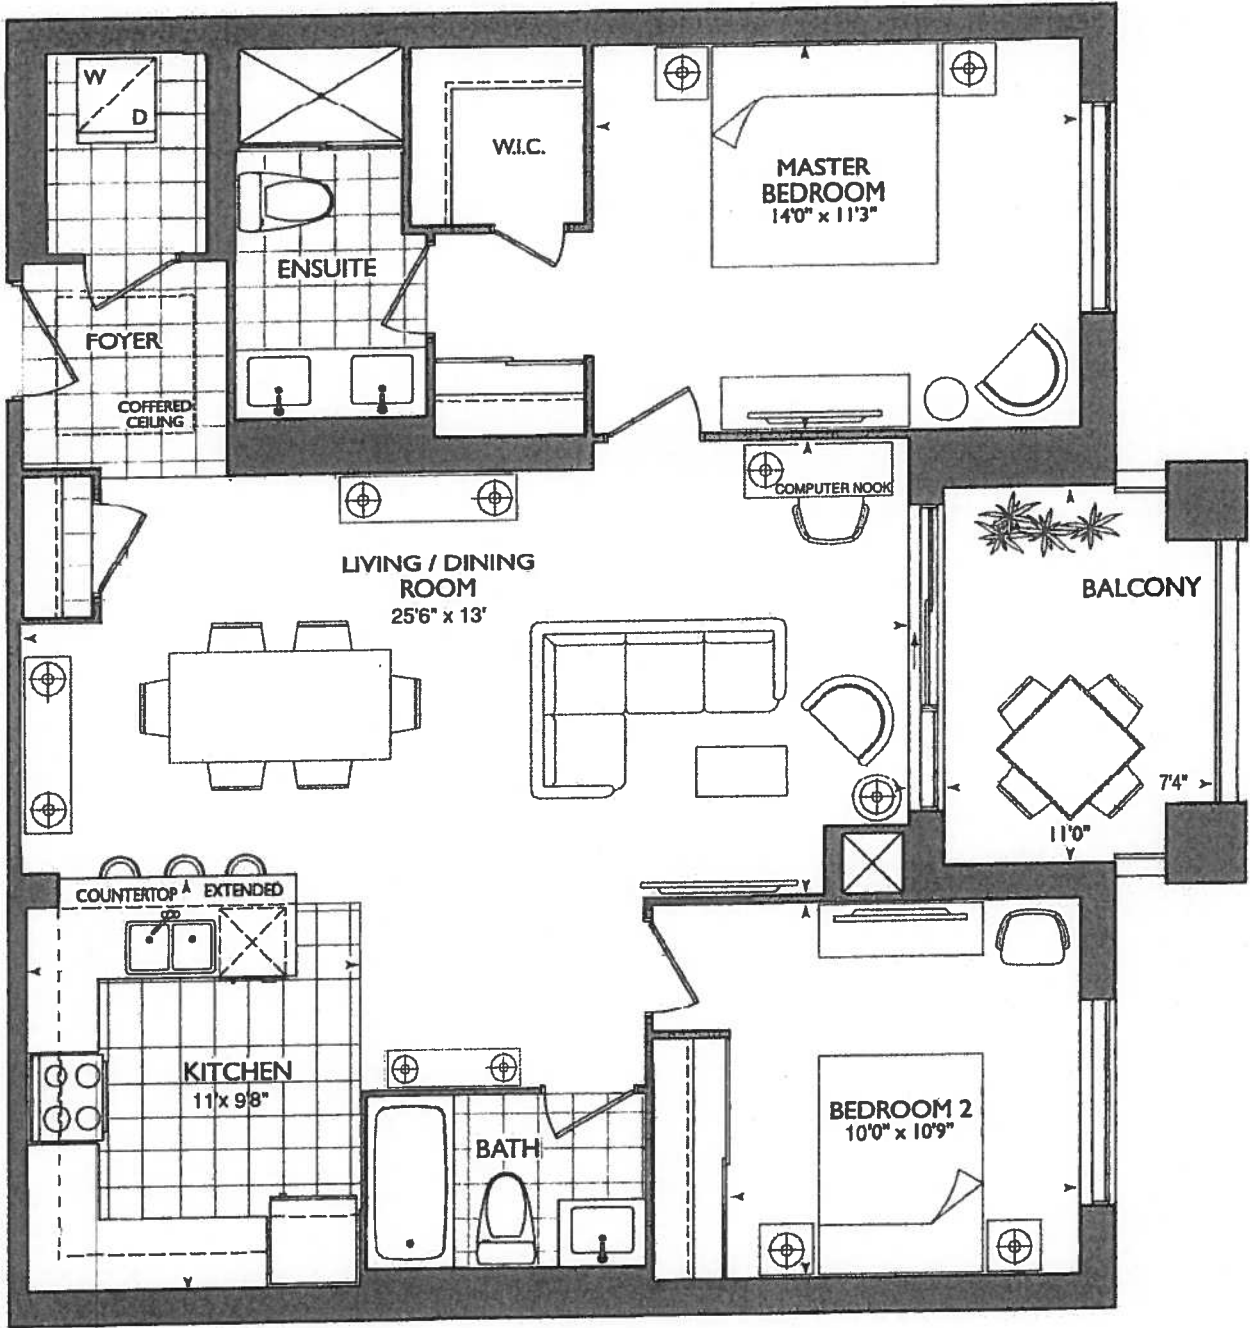

Plans and specifications are subject to change without notice. Actual usable floor space may vary from the stated floor area. All renderings are artist's concept. E. & O. E.

*** KITCHEN ***

CHOICE OF STD. KITCHEN LAYOUT WITH
STD. APPLIANCE PACKAGE

OR

CAN UPGRADE AT DECOR CENTER

- (x2) CAPPED PENDANT
- (x1) PLUG PENINSULA
- (x) PUCK LIGHTS


***SEE ATTACHED UPG.**

**#1- KITCHEN LAYOUT WITH 1ST UPG.
APPLIANCE PACKAGE**


*** SUITE * (INVENTORY SUITE)**

- NEW PLAN
- REMOVED DEN
- REVISED KITCHEN

***REVISED LAUNDRY DOOR SWING &
ENSUITE WALL AS PER THIS BROCHURE**

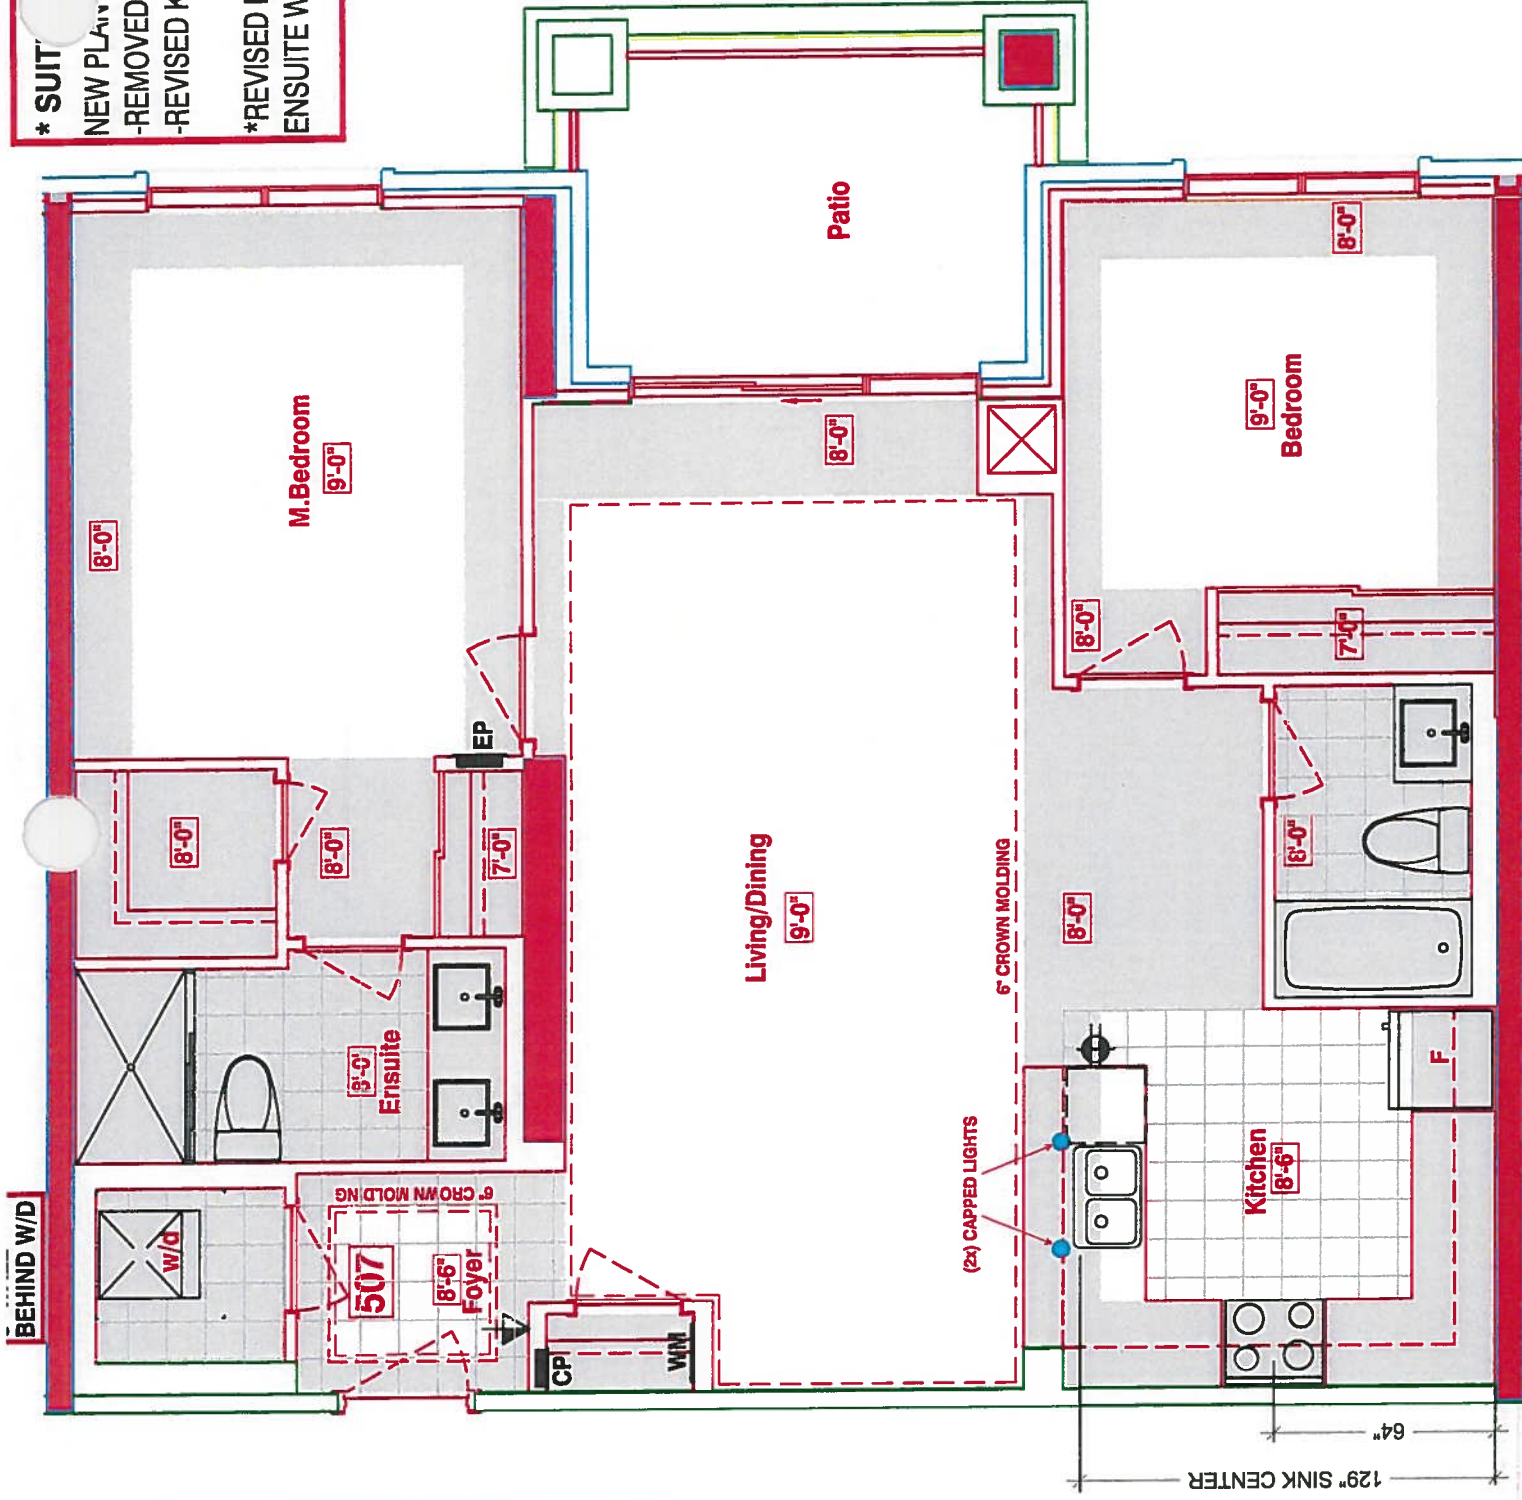

STANDARD

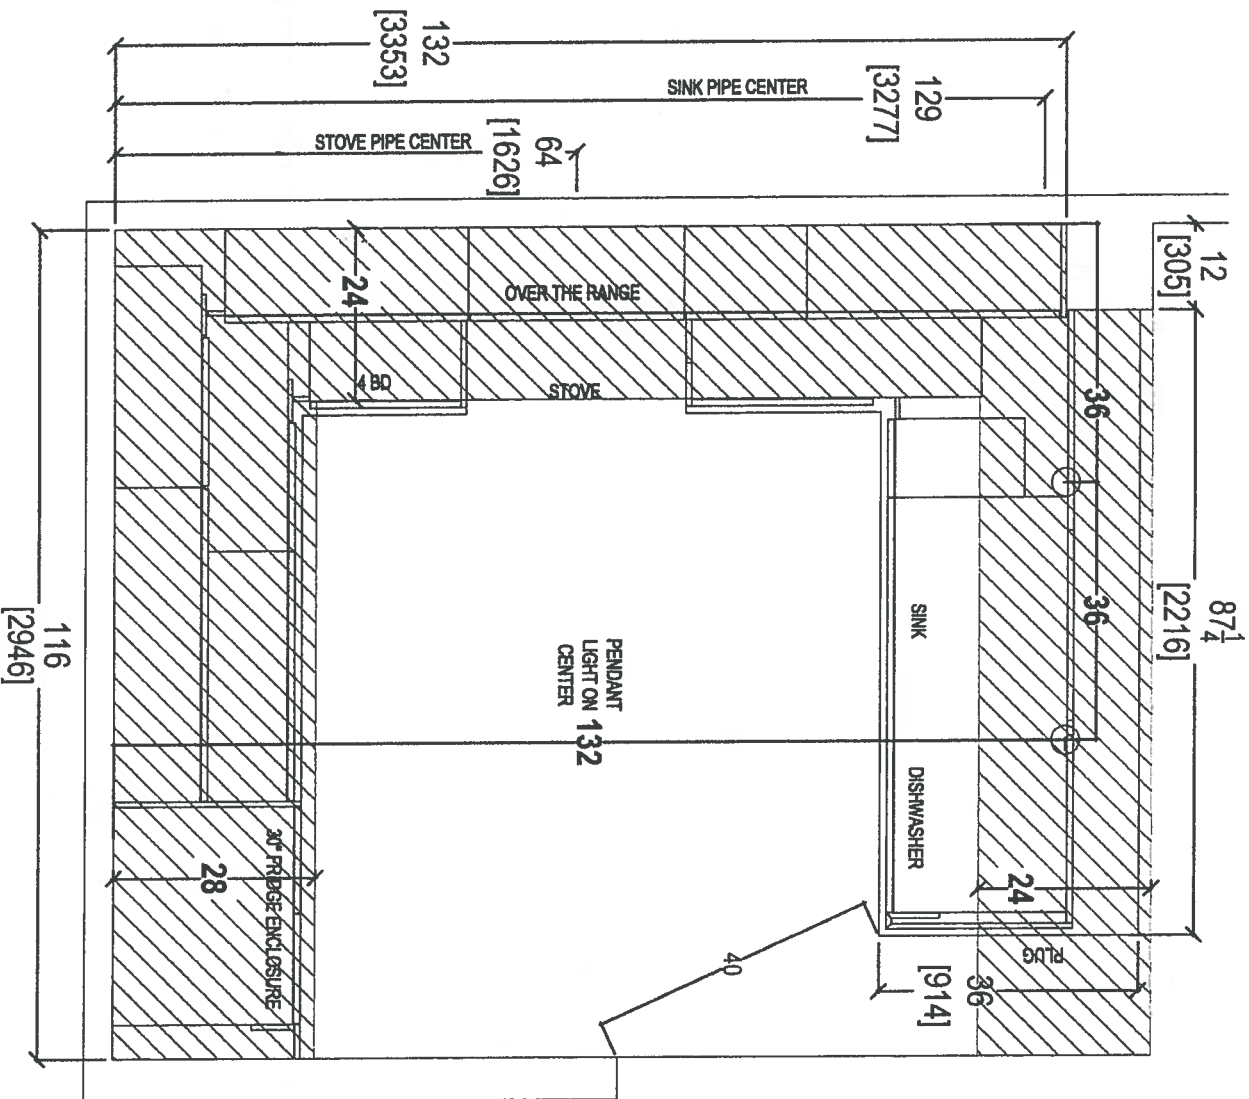

CLIENT: ROYAL PINE HOMES

JOB NAME: UNIT 507 HMP

ROOM: KITCHEN BULKHEAD PLAN

DRAWN BY: SK

COMMENTS:

SITE: HAMPTON PLACE

DOOR STYLE: ---

DOOR HANDLE: ---

SCALE: 1/2" = 1' - 0"

PLEASE NOTE ALL DIMENSIONS ARE NOT FINAL AND ARE SUBJECT TO CHANGE UPON FINAL SITE MEASURE

PHONE: ---

FINISH: ---

DRW HANDLE: ---

DATE: MAY 8, 2018

FINAL SITE MEASURE

EMAIL: ---


SPECIES: ---

TOP: ---

PAGE:



80 SANTE DRIVE, VAUGHAN, ON L4K 3C4,
T: 416.746.1811 F: 905.761.5801

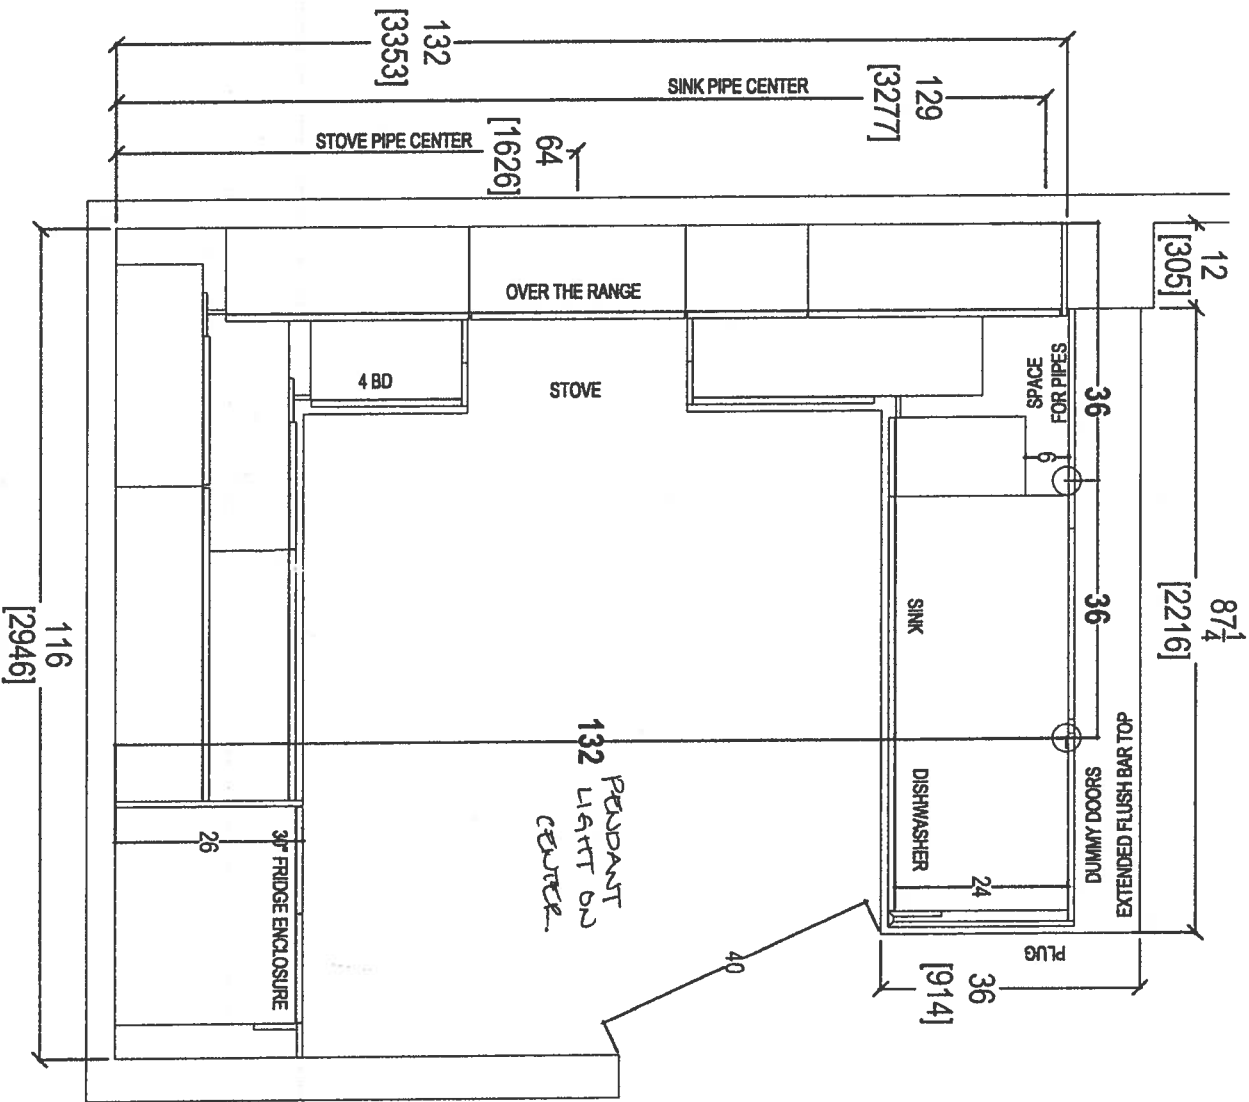


CLIENT: ROYAL PINE HOMES	JOB NAME: UNIT 507 HAMP	UNIT 507 HAMP	ROOM: KITCHEN BULKHEAD PLAN	DRAWN BY: SK	COMMENTS:
SITE: HAMPTON PLACE	DOOR STYLE: —	DOOR HANDLE: —	SCALE: 1/2" = 1'-0"		PLEASE NOTE ALL DIMENSIONS ARE NOT FINAL AND ARE SUBJECT TO CHANGE UPON FINAL SITE MEASURE
PHONE: —	FINISH: —	DRW HANDLE: —	DATE: MAY 8, 2018		
EMAIL: —	SPECIES: —	TOP: —	PAGE:		




your kitchen your taste

80 SANTE DRIVE, VAUGHAN, ON L4K 3C4,
T: 416.746.1811 F: 905.761.5901

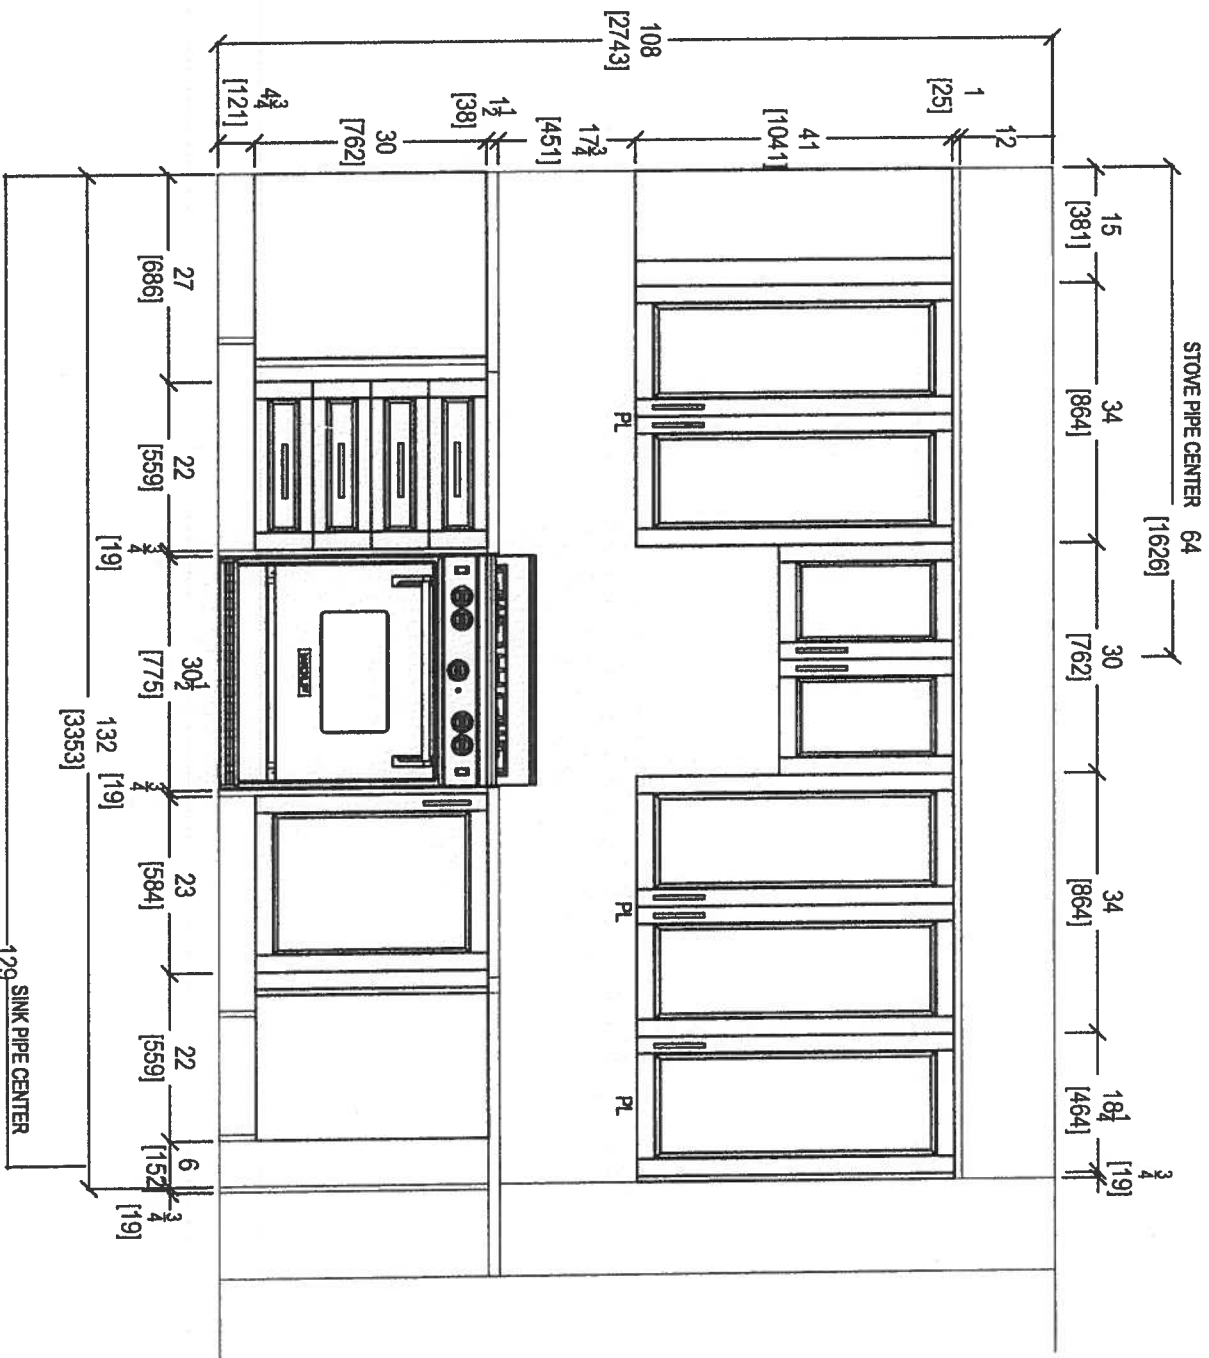

QTH your kitchen your taste 80 SANTE DRIVE, VAUGHAN, ON L4K 3C4, T: 416.746.1811 F: 905.761.5901		CLIENT: ROYAL PINE HOMES		JOB NAME: UNIT 507 HAMP ST. AND DUNDAS		ROOM: KITCHEN		DRAWN BY: SK		COMMENTS: PLEASE NOTE ALL DIMENSIONS ARE NOT FINAL AND ARE SUBJECT TO CHANGE UPON FINAL SITE MEASURE
SITE: HAMPTON PLACE		DOOR STYLE: —		DOOR HANDLE: —		SCALE: 1/2" = 1' - 0"				
PHONE: —		FINISH: —		DRW HANDLE: —		DATE: MAY 8, 2018				
EMAIL: —		SPECIES: —		TOP: —		PAGE:				

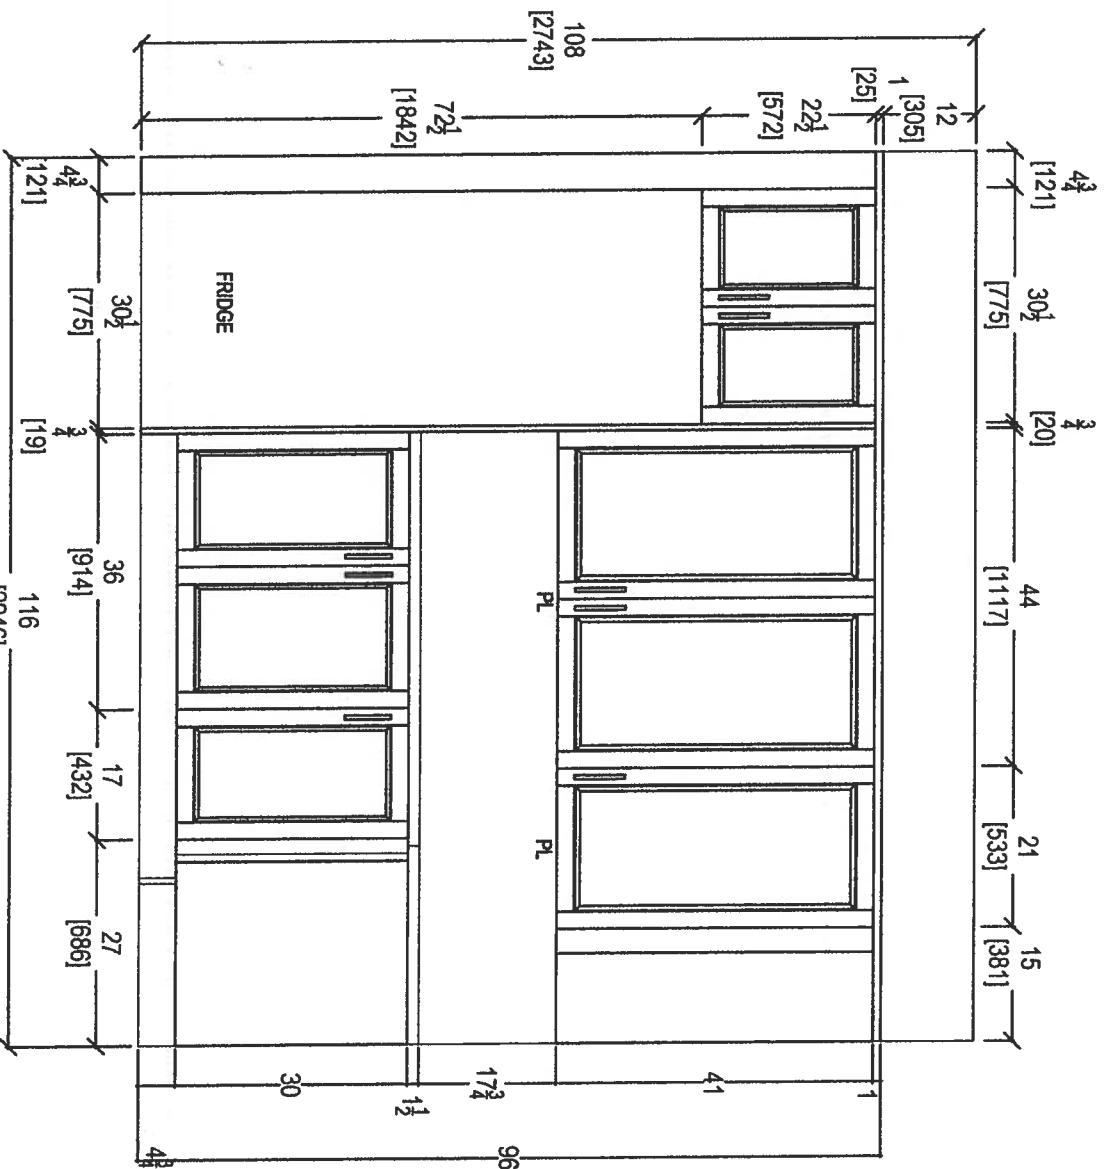

CLIENT: ROYAL PINE HOMES	JOB NAME: UNIT 507 HMP SPAN DAKOTA	ROOM: KITCHEN	DRAWN BY: SK
SITE: HAMPTON PLACE	DOOR STYLE: —	DOOR HANDLE: —	SCALE: 1/2" = 1' - 0"
PHONE: —	FINISH: —	DRW HANDLE: —	DATE: MAY 8, 2018
EMAIL: —	SPECIES: —	TOP: —	PAGE: —




your kitchen, your taste


80 SANTE DRIVE, VAUGHAN, ON L4K 3C4,
T: 416.746.1811 F:905.761.5801

COMMENTS:

PLEASE NOTE ALL DIMENSIONS
ARE NOT FINAL AND ARE
SUBJECT TO CHANGE UPON
FINAL SITE MEASURE

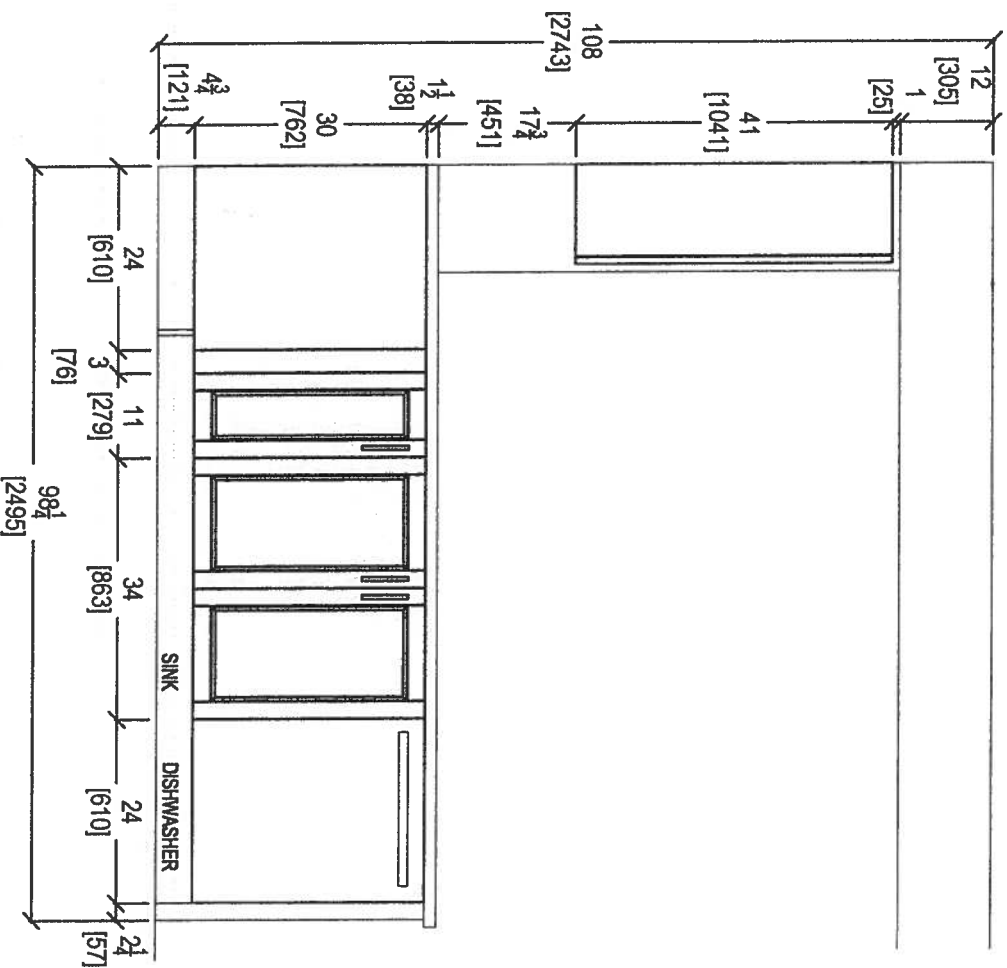

KITCHEN PENINSULA ELEVATION
FRONT VIEW

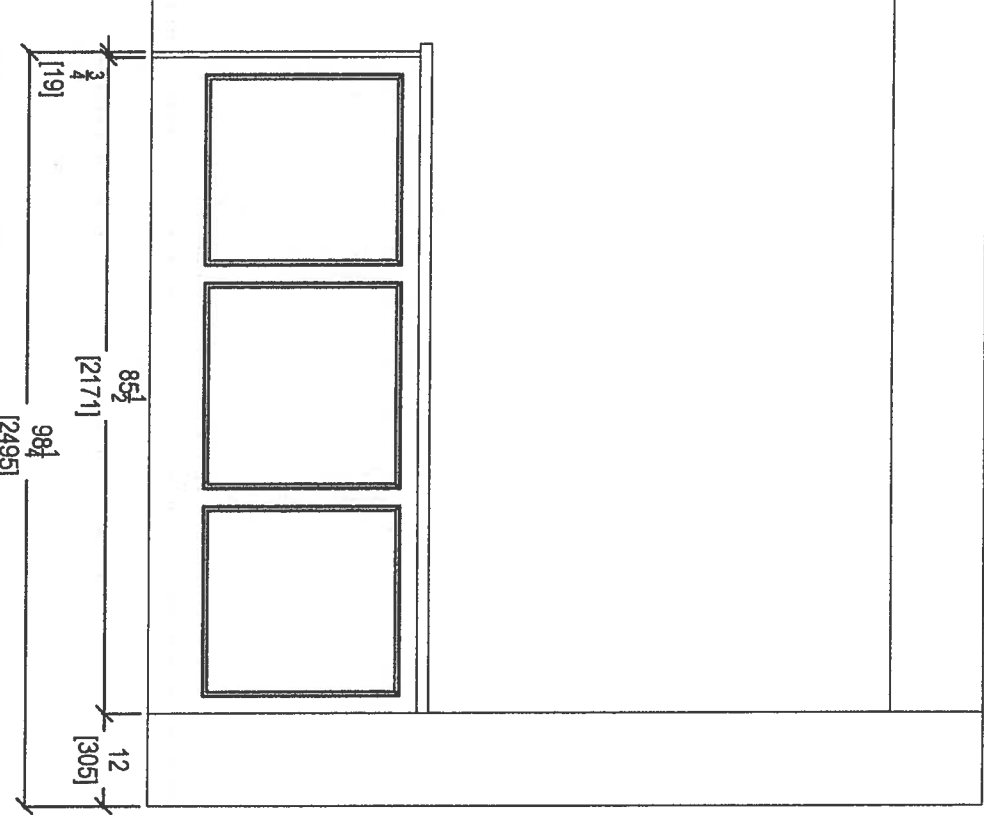


KITCHEN PENINSULA ELEVATION
REAR VIEW




your kitchen, your life
80 SANTE DRIVE, VAUGHAN, ON L4K 3C4,
T: 416.746.1811 F: 905.761.5901

CLIENT: ROYAL PINE HOMES	JOB NAME: UNIT 507 HMP STANDARD	ROOM: KITCHEN	DRAWN BY: SK
SITE: HAMPTON PLACE	DOOR STYLE: --	DOOR HANDLE: --	SCALE: 1/2" = 1' - 0"
PHONE: --	FINISH: --	DRW HANDLE: --	DATE: MAY 8, 2018
EMAIL: --	SPECIES: --	TOP: --	PAGE:



COMMENTS:
PLEASE NOTE ALL DIMENSIONS
ARE NOT FINAL AND ARE
SUBJECT TO CHANGE UPON
FINAL SITE MEASURE

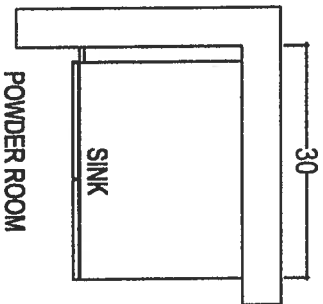

POWDER ROOM

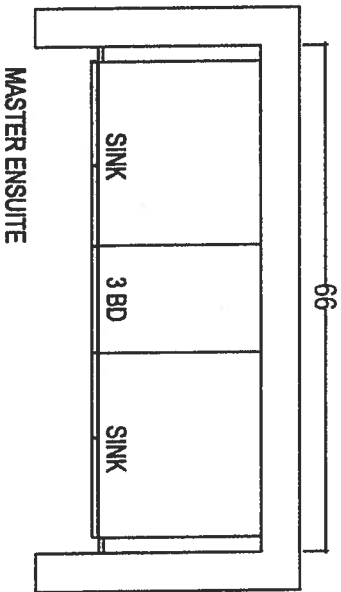


MASTER ENSUITE

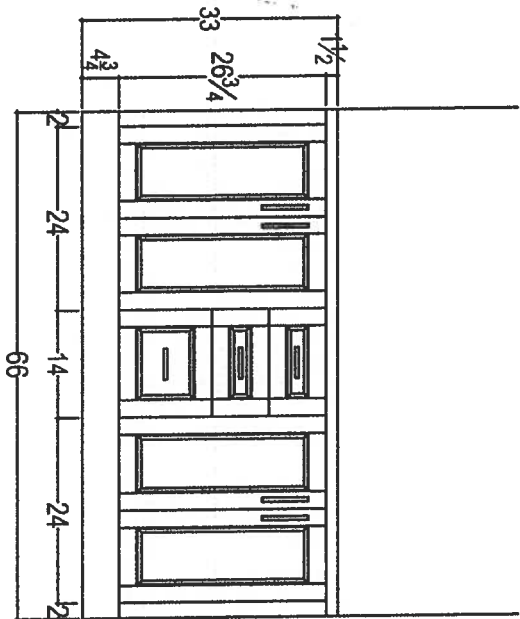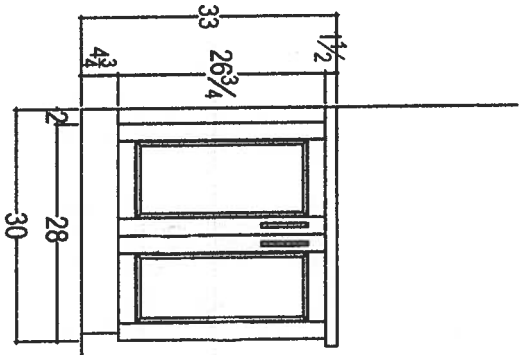

CLIENT: ROYAL PINE HOMES	JOB NAME: UNIT 507 HMP STRANDS ROOM:	VANITIES	DRAWN BY: SK
SITE: HAMPTON PLACE	DOOR STYLE: —	DOOR HANDLE: —	SCALE: 1/2" = 1'-0"
PHONE: —	FINISH: —	DRW HANDLE: —	DATE: MAY 1, 2018
EMAIL: —	SPECIES: —	TOP: —	PAGE:

COMMENTS:
PLEASE NOTE ALL DIMENSIONS
ARE NOT FINAL AND ARE
SUBJECT TO CHANGE UPON
FINAL SITE MEASURE

* UPGRADE *
OPTIONAL

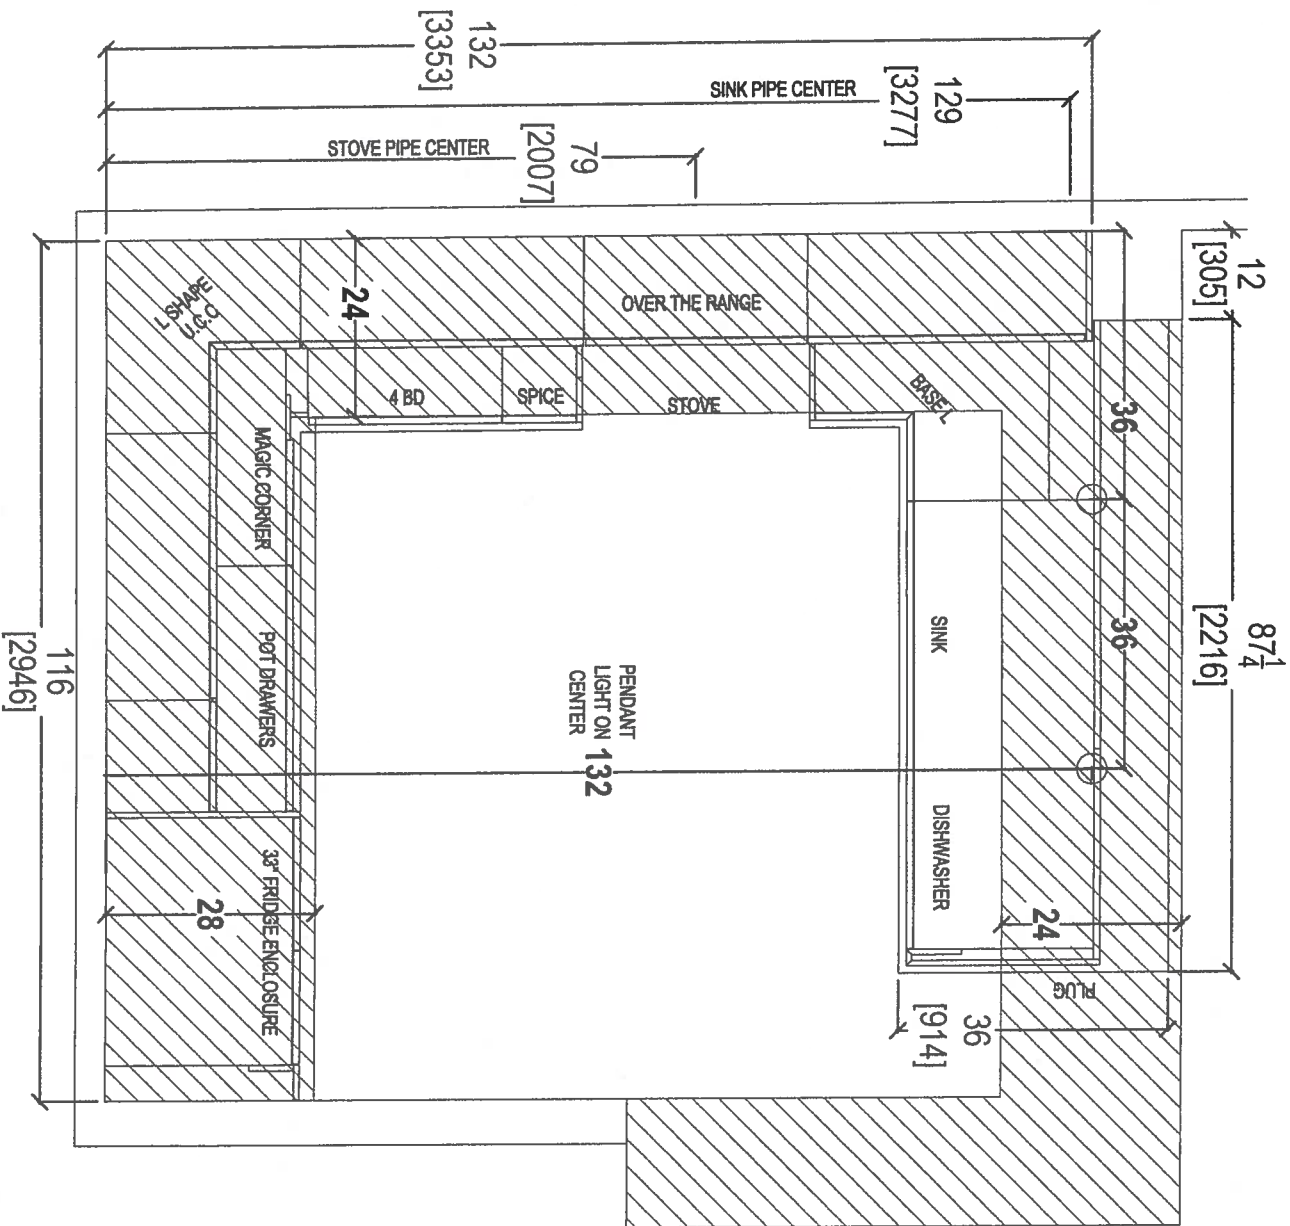

CLIENT: ROYAL PINE HOMES	JOB NAME: UNIT 507 HMP	ROOM: KITCHEN BULKHEAD PLAN	DRAWN BY: SK
SITE: HAMPTON PLACE	DOOR STYLE: —	DOOR HANDLE: —	SCALE: 1/2" = 1'-0"
PHONE: —	FINISH: —	DRW HANDLE: —	DATE: MAY 1, 2018
EMAIL: —	SPECIES: —	TOP: —	PAGE:

COMMENTS:
PLEASE NOTE ALL DIMENSIONS
ARE NOT FINAL AND ARE
SUBJECT TO CHANGE UPON
FINAL SITE MEASURE




QTH

your kitchen, your taste

80 SANTE DRIVE, VAUGHAN, ONT. L4K 3C4,
T: 416.746.1811 F: 905.746.1811

SA

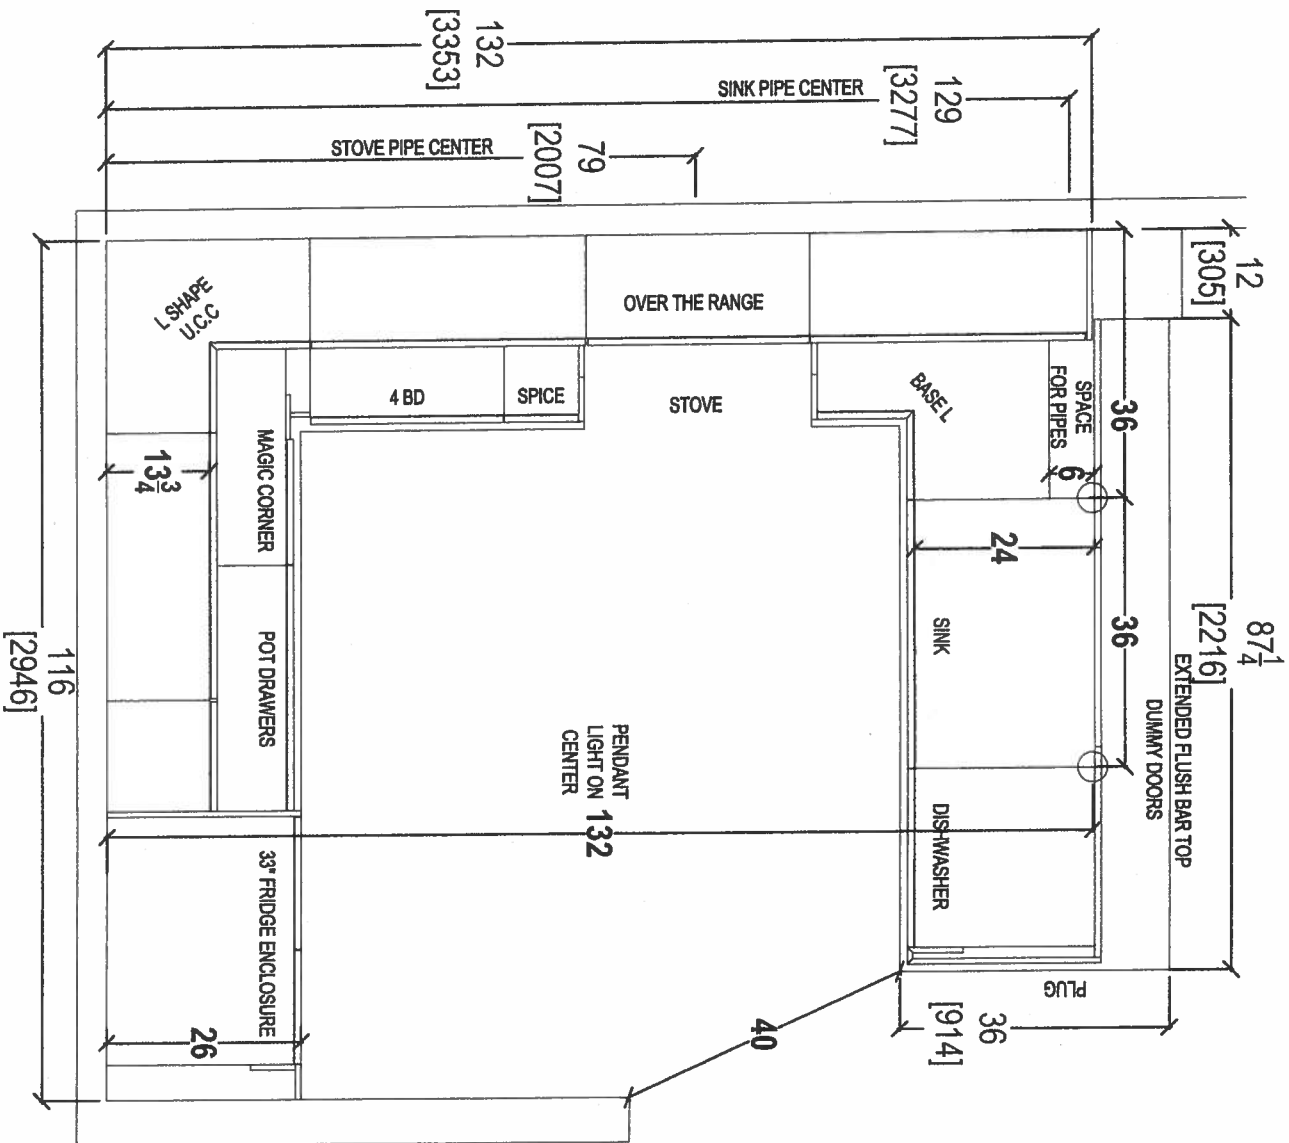


CLIENT: ROYAL PINE HOMES	JOB NAME: UNIT 507 HMP	ROOM: KITCHEN FLOOR PLAN	DRAWN BY: SK
SITE: HAMPTON PLACE	DOOR STYLE: —	DOOR HANDLE: —	SCALE: 1/2" = 1'-0"
PHONE: —	FINISH: —	DRW HANDLE: —	DATE: MAY 1, 2018
EMAIL: —	SPECIES: —	TOP: —	PAGE:

COMMENTS:
PLEASE NOTE ALL DIMENSIONS
ARE NOT FINAL, AND ARE
SUBJECT TO CHANGE UPON
FINAL SITE MEASURE




80 SANTE DRIVE, VAUGHAN, ONTARIO L4K 3C4,
T: 416.746.1811 F: 416.746.1812

69

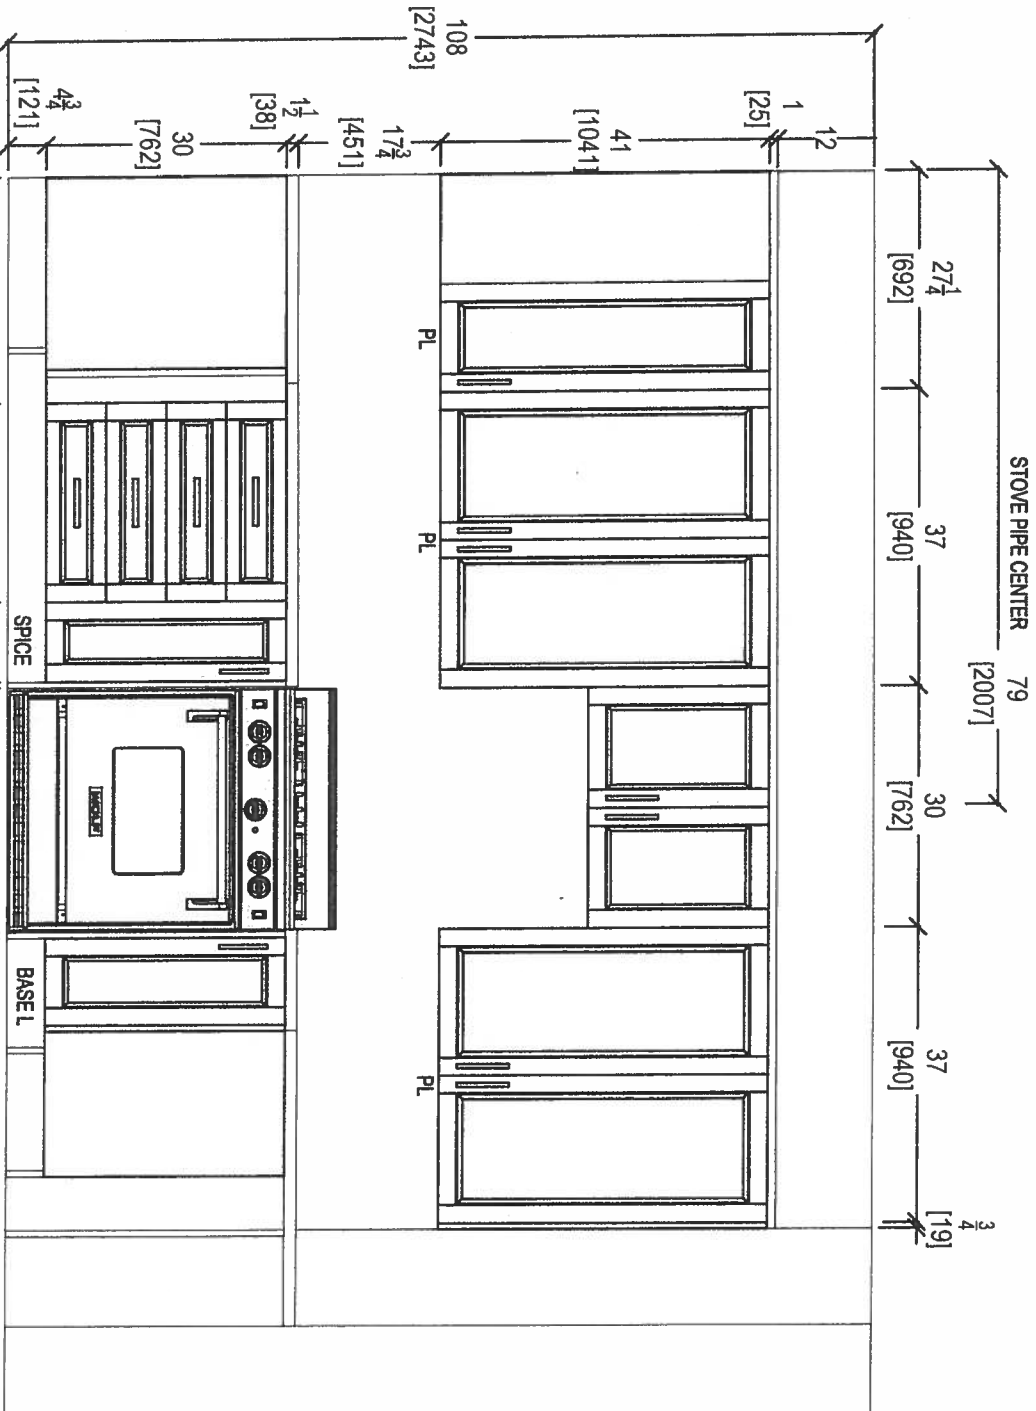

STOVE WALL ELEVATION

 your kitchen your taste		CLIENT: ROYAL PINE HOMES		JOB NAME: UNIT 507 HMP		ROOM: KITCHEN		DRAWN BY: SK		COMMENTS:	
80 SANTE DRIVE, VAUGHAN, ONT. L4K 3C4, T: 416.746.1811 F: 905.746.1811		SITE: HAMPTON PLACE		DOOR STYLE: —		DOOR HANDLE: —		SCALE: 1/2" = 1'-0"		PLEASE NOTE ALL DIMENSIONS ARE NOT FINAL AND ARE SUBJECT TO CHANGE UPON FINAL SITE MEASURE	
PHONE: —		FINISH: —		DRAW HANDLE: —		DATE: MAY 1, 2018		DATE: —			
EMAIL: —		SPECIES: —		TOP: —		PAGE: —		PAGE: —			

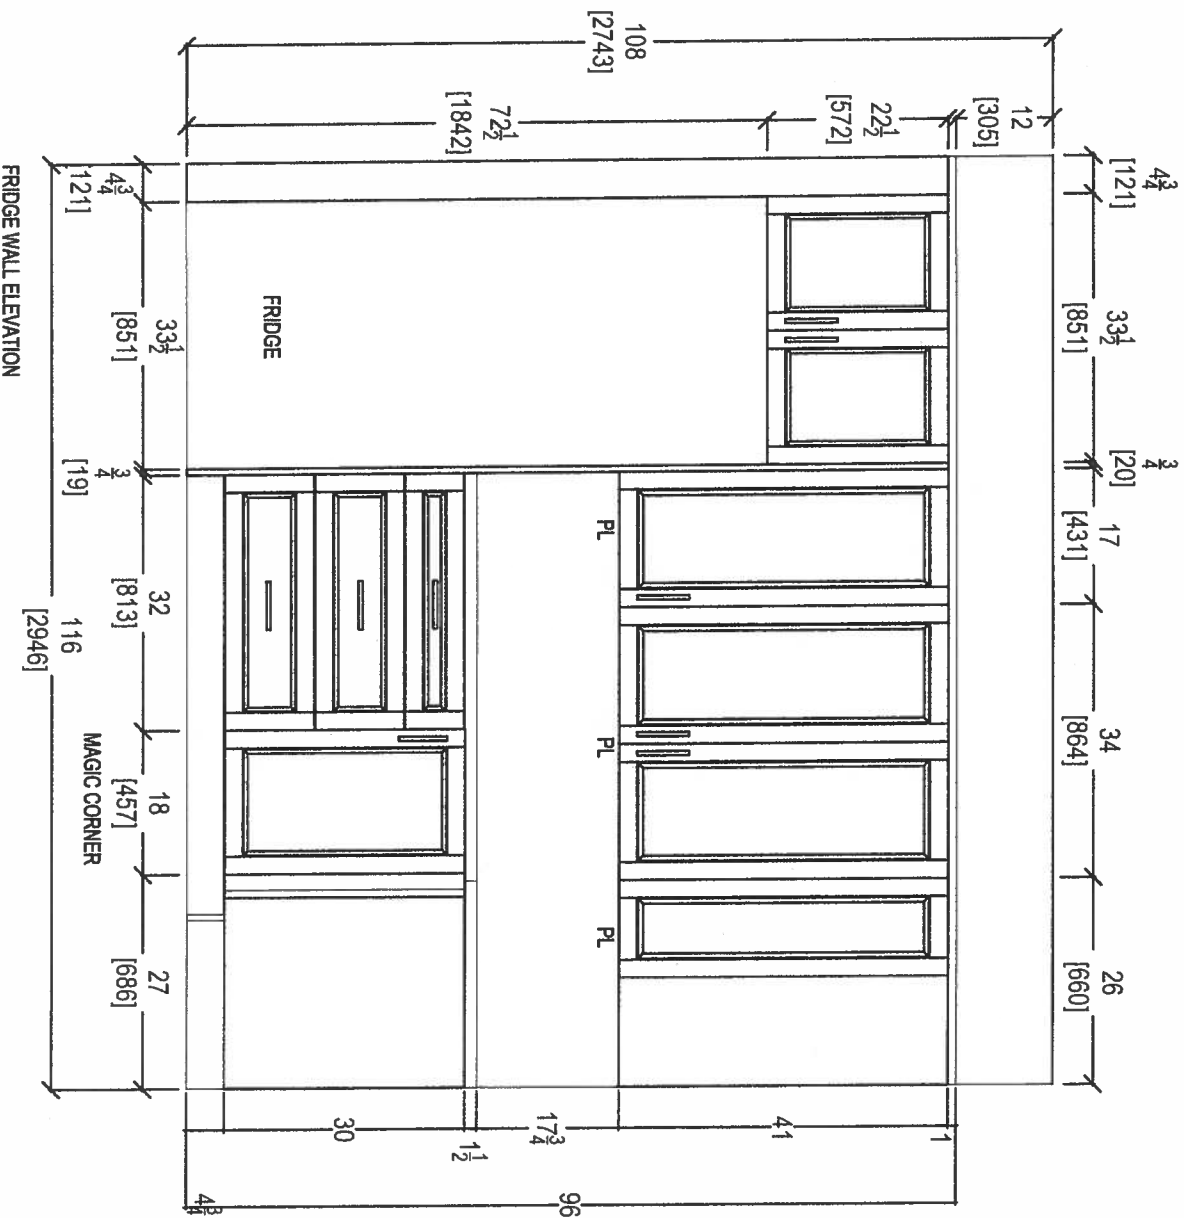

FRIDGE WALL ELEVATION

CLIENT: ROYAL PINE HOMES	JOB NAME: UNIT 507 HMP	ROOM: KITCHEN
SITE: HAMPTON PLACE	DOOR STYLE: —	DOOR HANDLE: —
PHONE: —	FINISH: —	DRW HANDLE: —
EMAIL: —	SPECIES: —	TOP: —

DRAWN BY: SK

SCALE: 1/2" = 1' - 0"


DATE: MAY 1, 2018

PAGE:


PLEASE NOTE ALL DIMENSIONS
ARE NOT FINAL AND ARE
SUBJECT TO CHANGE UPON
FINAL SITE MEASURE



80 SANTE DRIVE, VAUGHAN, ONT. L4K 3C4,
T: 416.746.1811 F: 905.746.1801

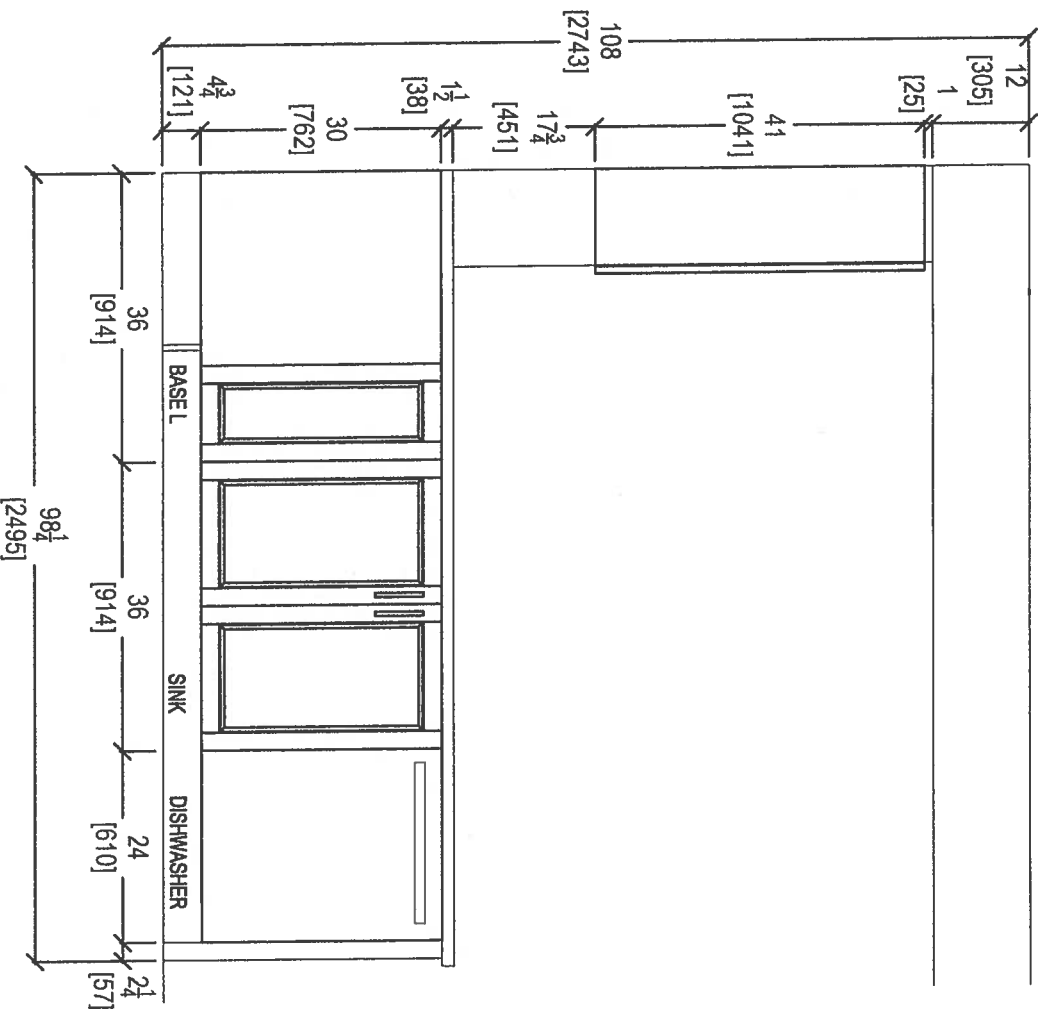

KITCHEN PENINSULA ELEVATION
FRONT VIEW

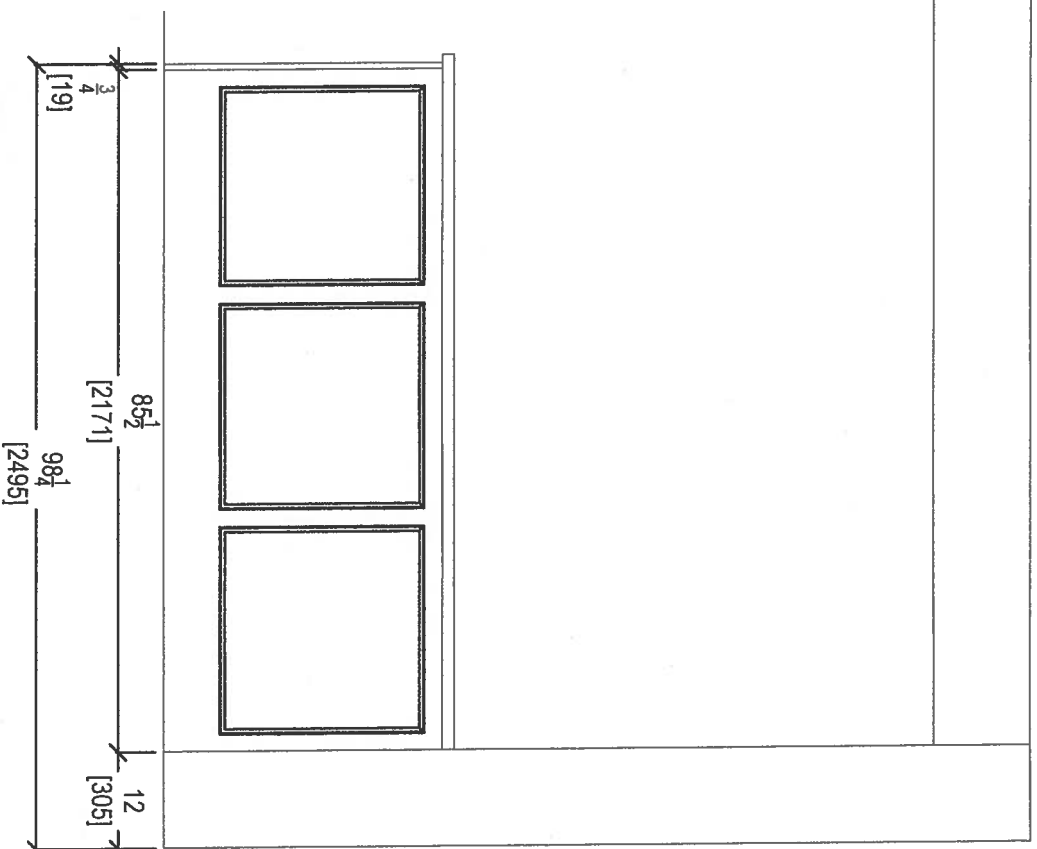

KITCHEN PENINSULA ELEVATION
REAR VIEW

CLIENT: ROYAL PINE HOMES	JOB NAME: UNIT 507 HMP	ROOM: KITCHEN	DRAWN BY: SK
SITE: HAMPTON PLACE	DOOR STYLE: —	DOOR HANDLE: —	SCALE: 1/2" = 1'-0"
PHONE: —	FINISH: —	DRW HANDLE: —	DATE: MAY 1, 2018
EMAIL: —	SPECIES: —	TOP: —	PAGE:


COMMENTS:

PLEASE NOTE ALL DIMENSIONS
ARE NOT FINAL AND ARE
SUBJECT TO CHANGE UPON
FINAL SITE MEASURE




80 SANTE DRIVE, VAUGHAN, ONTARIO L4K 3C4,
T. 416.746.1811 F. 905.746.1811



9

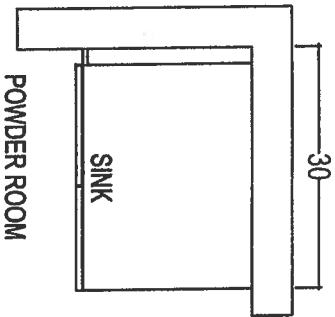

POWDER ROOM

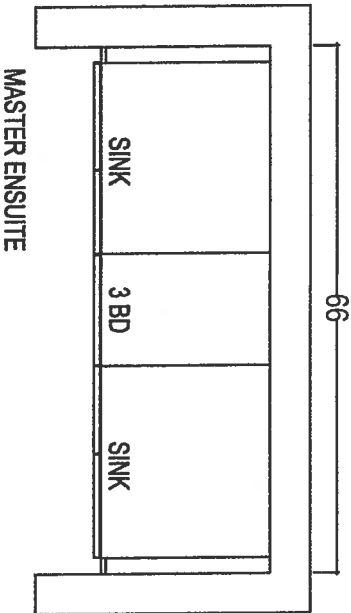

MASTER ENSUITE

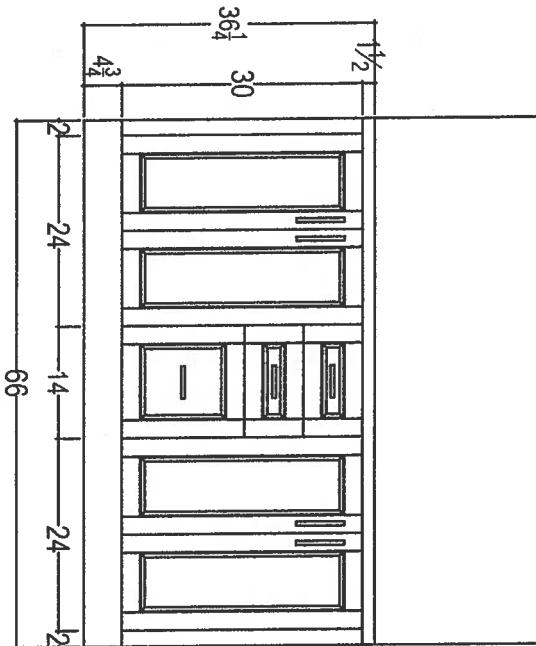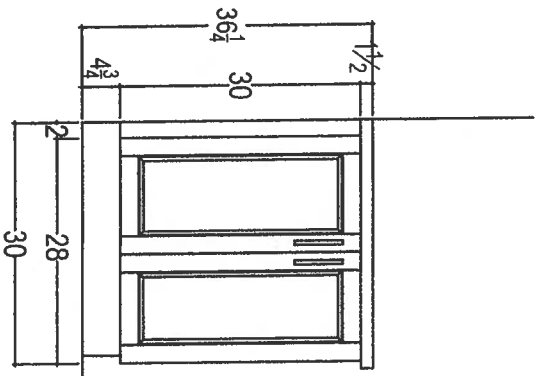

QTH
your kitchen, your taste
80 SANTE DRIVE, VAUGHAN, ONT. L4K 3C4,
T: 416.746.1811 F: 905.746.1811

CULENT: ROYAL PINE HOMES	JOB NAME: UNIT 507 HMP	ROOM: VANITIES	DRAWN BY: SK
SITE: HAMPTON PLACE	DOOR STYLE: —	DOOR HANDLE: —	SCALE: 1/2" = 1' - 0"
PHONE: —	FINISH: —	DRW HANDLE: —	DATE: MAY 1, 2018
EMAIL: —	SPECIES: —	TOP: —	PAGE:

COMMENTS:
PLEASE NOTE ALL DIMENSIONS
ARE NOT FINAL AND ARE
SUBJECT TO CHANGE UPON
FINAL SITE MEASURE

Handwritten signature or mark.