
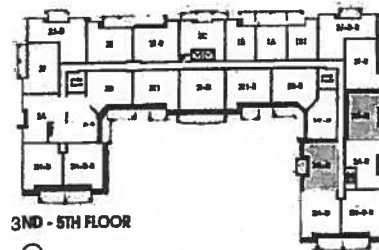
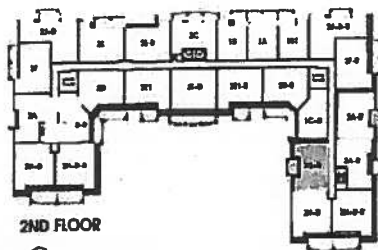


Noyac Bay

1,121 SQ FT *plus 76 sq. ft. of balcony area*

SUITE 511
ORIGINAL LAYOUT
INVENTORY SUITE
NEXT LAYOUT

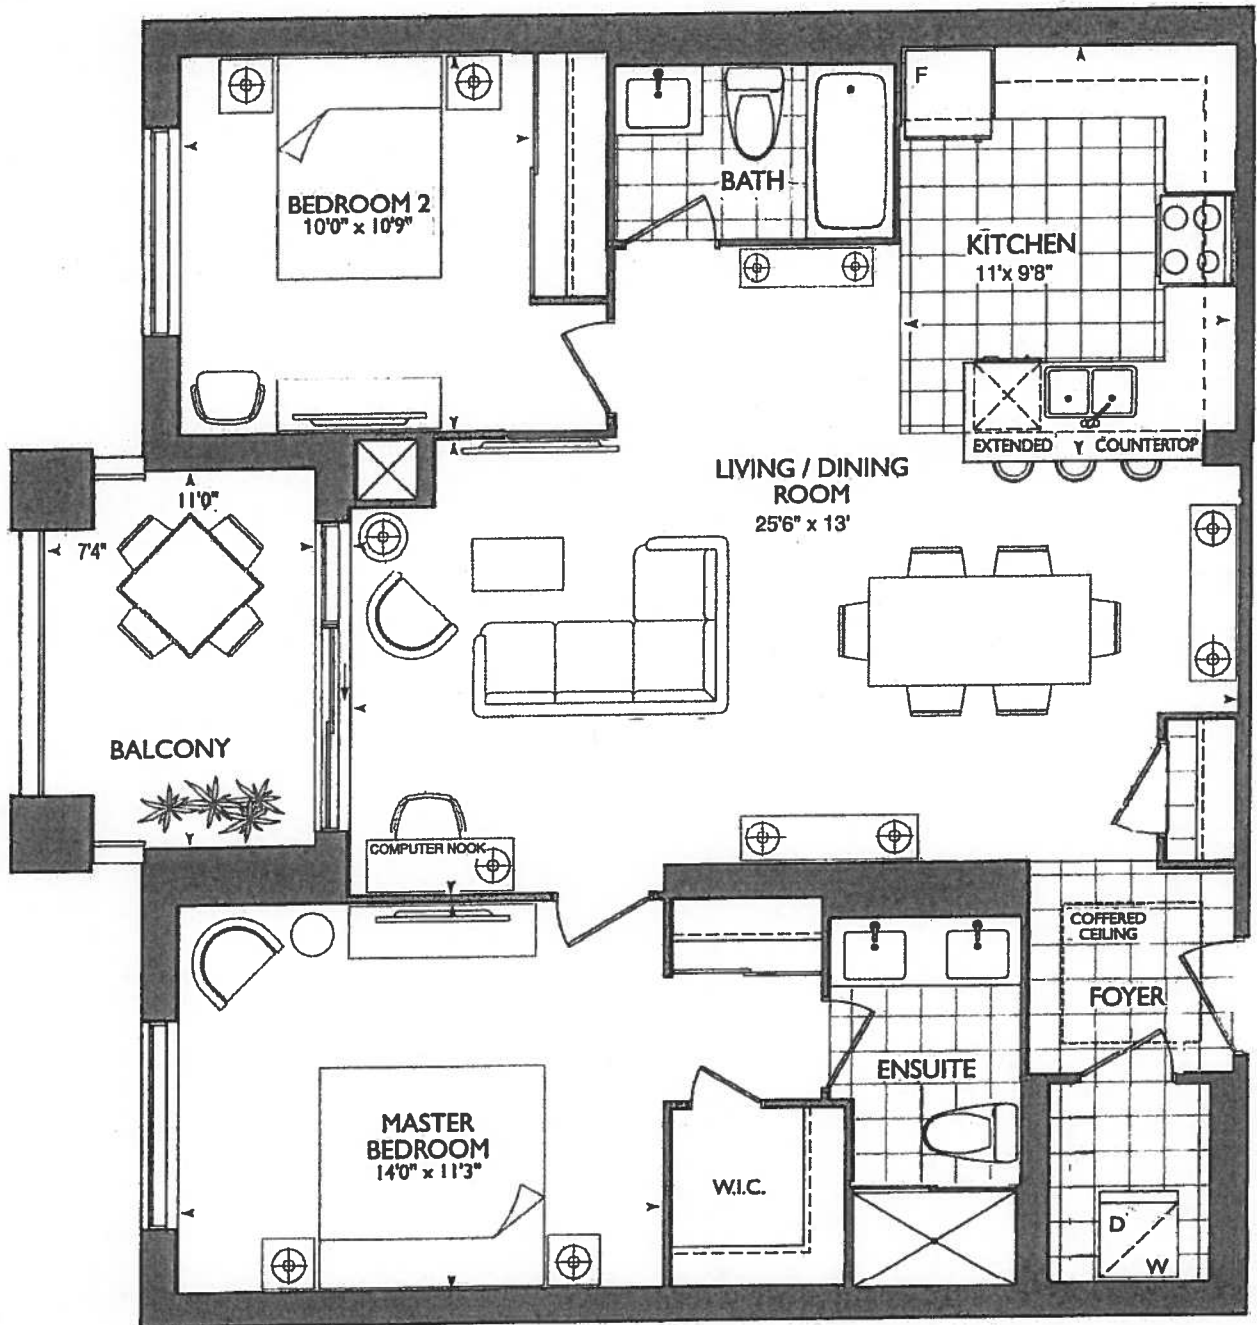


Plans and specifications are subject to change without notice. Actual usable floor space may vary from the stated floor area. All renderings are artist's concept E. & O. E.




Noyac Bay

1,121 SQ FT *plus 81 sq. ft. of balcony area*

SUITE 511 - INVENTORY
OLD ORIGINAL
SUITE LAYOUT

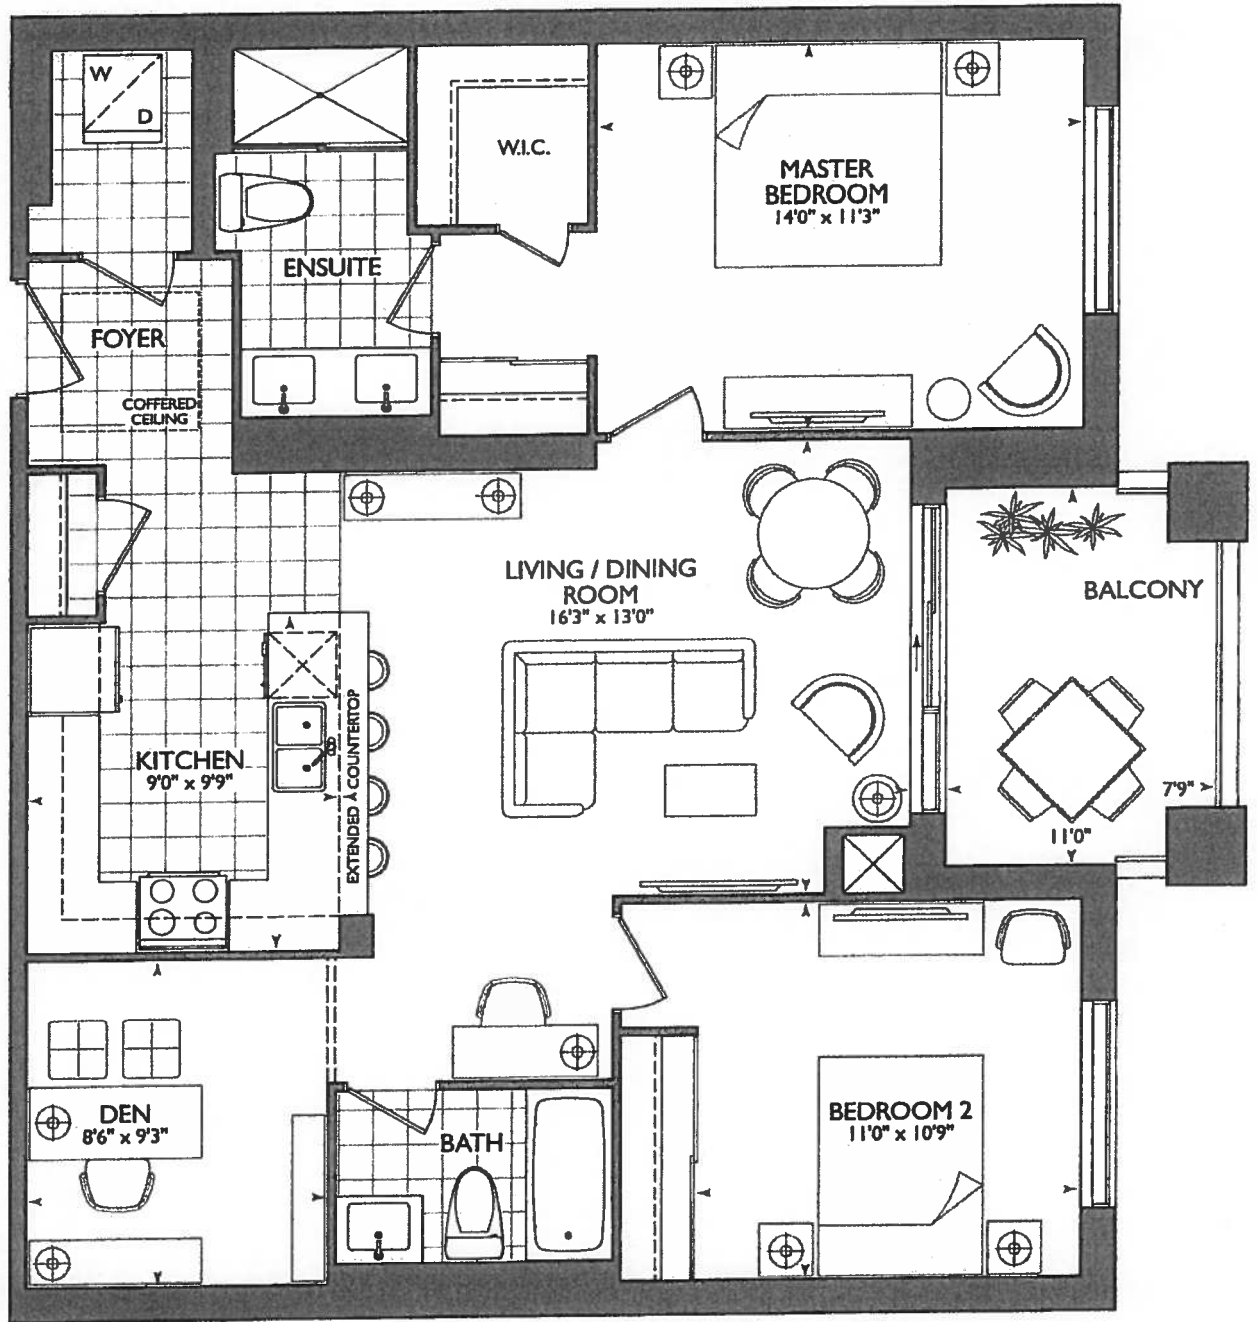

GROUND FLOOR

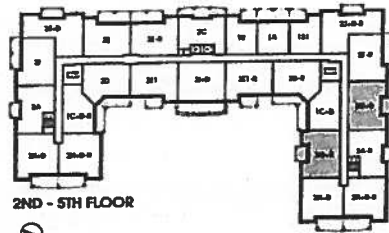

2ND - 5TH FLOOR



SIXTH FLOOR



*** KITCHEN ***

CHOICE OF STD. KITCHEN LAYOUT, WITH
STD. APPLIANCE PACKAGE

OR

CAN UPGRADE AT DECOR CENTER

- (x2) CAPPED PENDANT
- (x1) PLUG PENINSULA
- (x) PUCK LIGHTS


***SEE ATTACHED UPG.**

#1- KITCHEN LAYOUT WITH 1ST UPG.
APPLIANCE PACKAGE

*** SUITE 511 * (INVENTORY SUITE)**

- NEW KITCHEN
- REMOVED DEN
- REVISED KITCHEN

***REVISED LAUNDRY DOOR SWING &
ENSUITE WALL AS PER THIS BROCHURE**

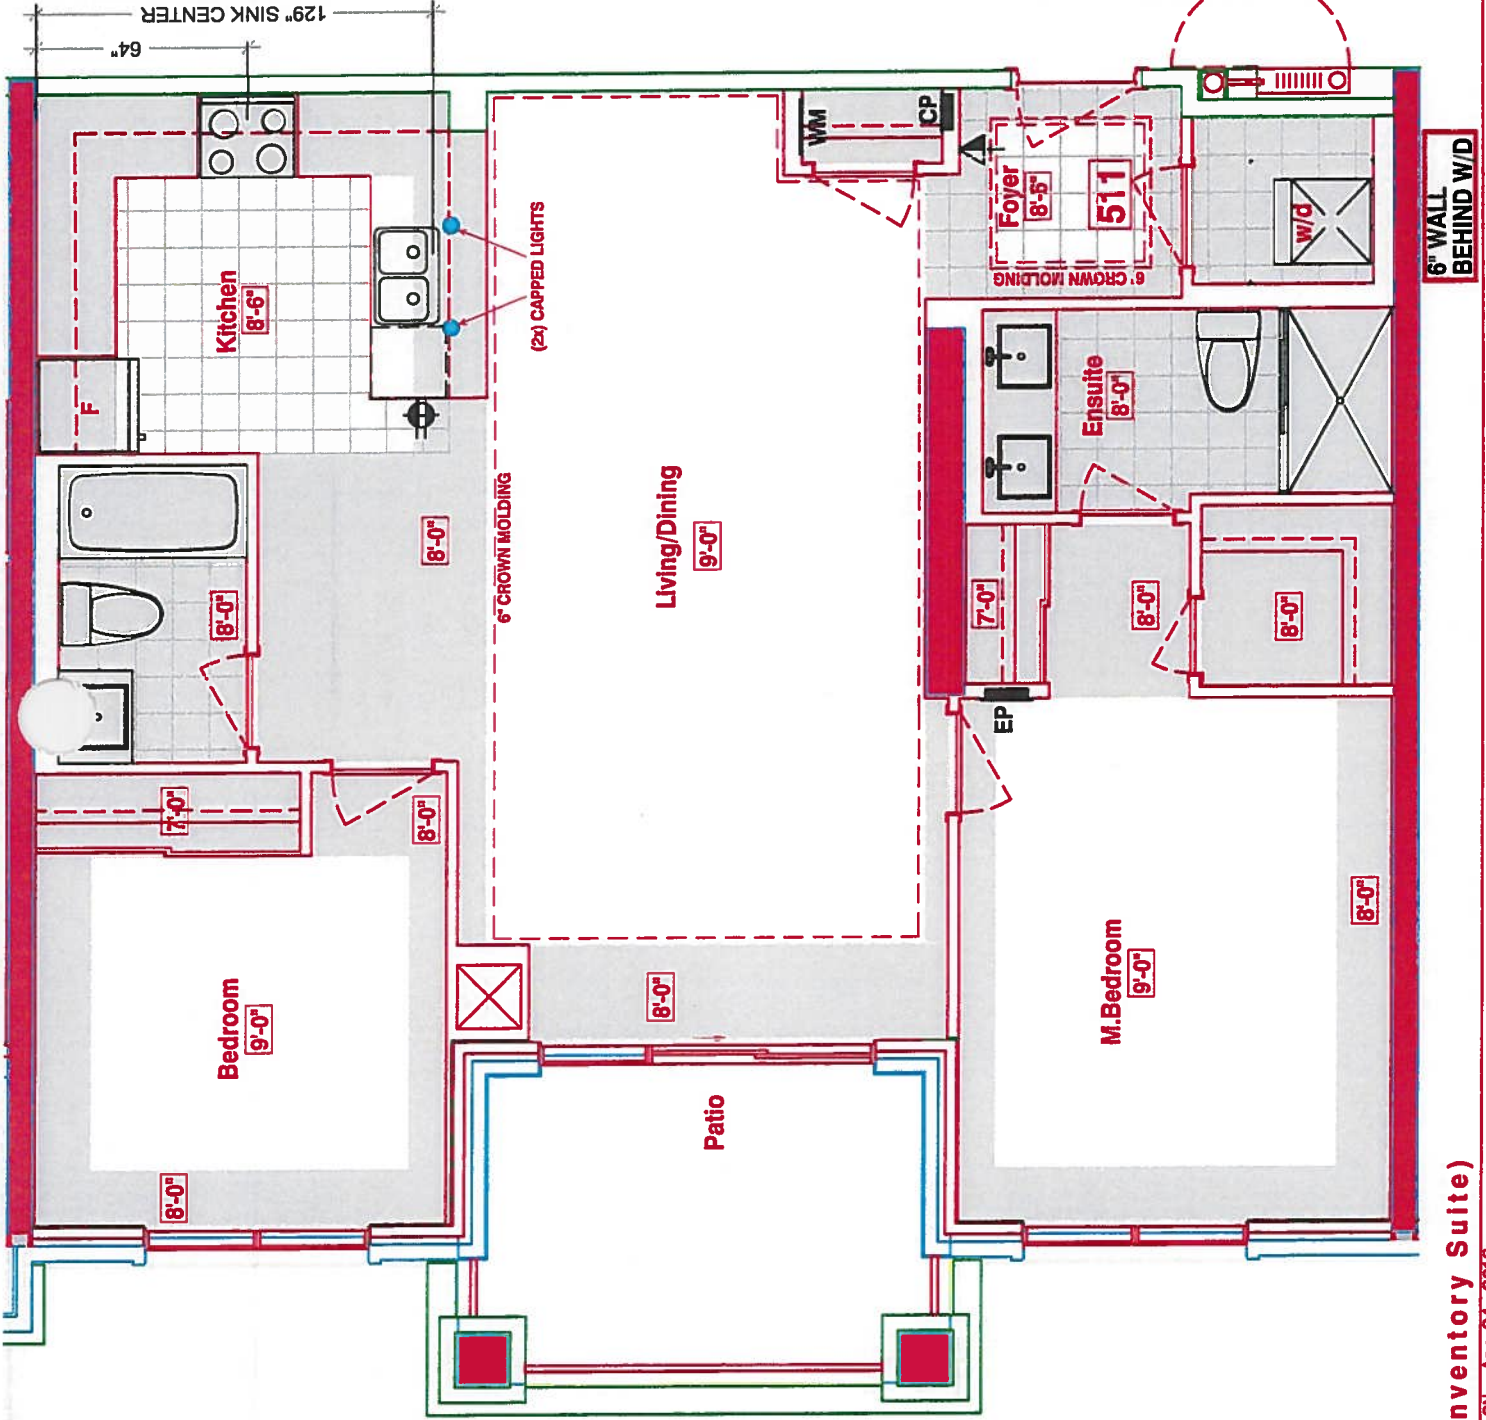

SUITES 511 - NOYAC BAY (Inventory Suite)

25 Baker Hill Blvd - Stouffville, ON Apr 04, 2018



**PLEASE NOTE ALL DIMENSIONS
ARE NOT FINAL AND ARE
SUBJECT TO CHANGE UPON
FINAL SITE MEASURE**

DRAWN BY: SK


DOOR HANDLE: —

DRW HANDLE: ---


[TOP:](#)

女人

your kitchen, your taste.
80 SANTE DRIVE, VAUGHAN, ON L4K 3C4,
T: 416.746.1811 F: 905.761.5901

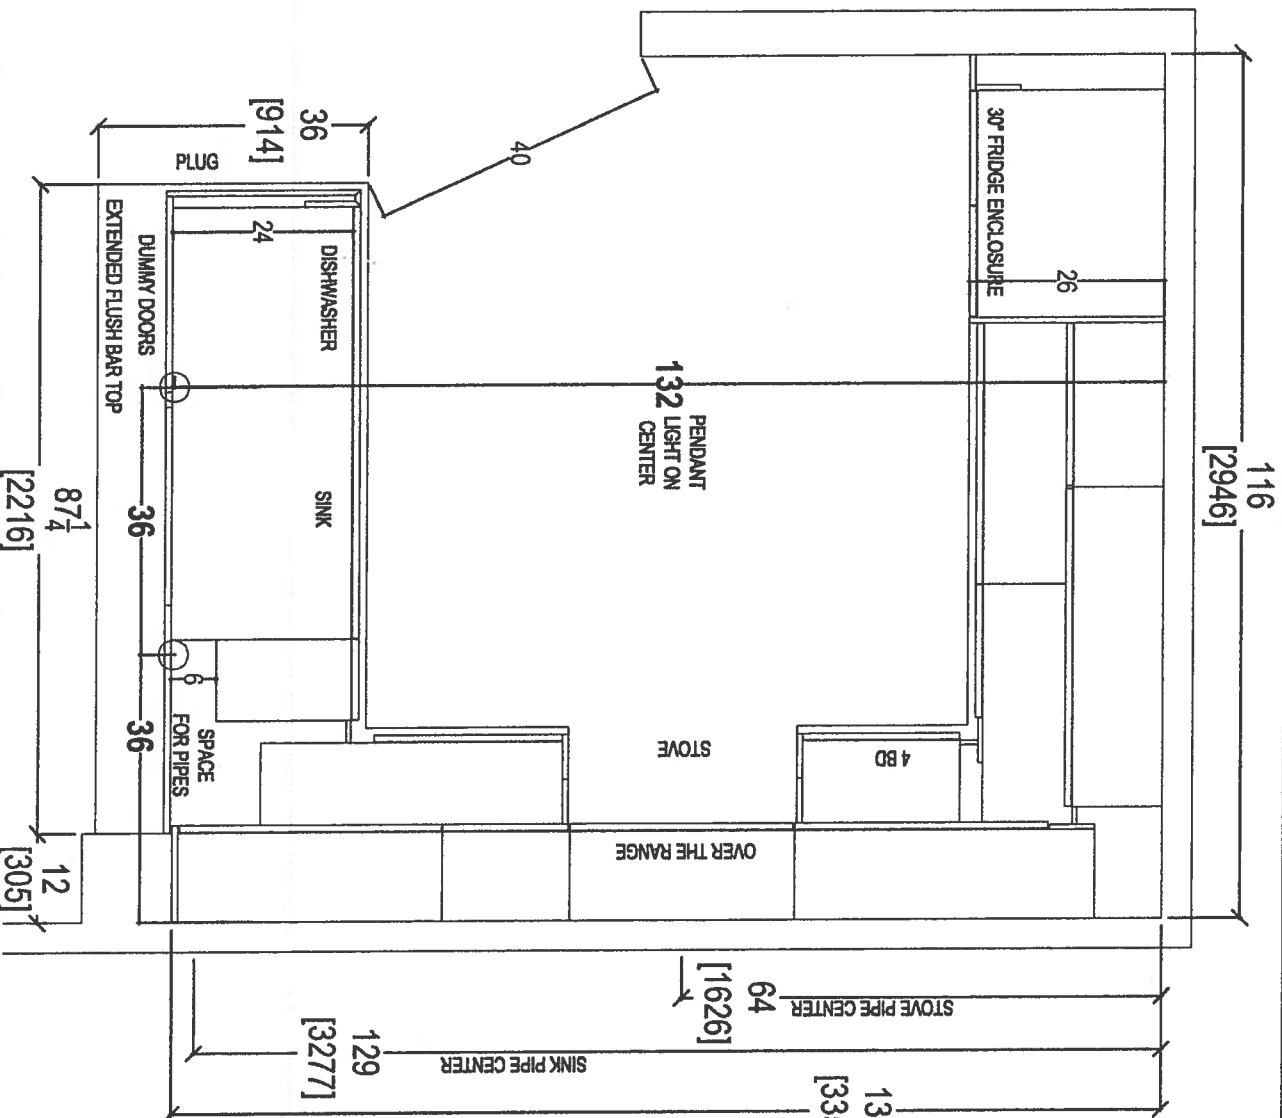

 your kitchen, your taste. 80 SANTE DRIVE, VAUGHAN, ON L4K 3C4, T: 416.746.1811 F: 905.761.5901		CLIENT: ROYAL PINE HOMES		JOB NAME: UNIT 511 HMP	ROOM: KITCHEN BULKHEAD PLAN	DRAWN BY: SK	COMMENTS: PLEASE NOTE ALL DIMENSIONS ARE NOT FINAL AND ARE SUBJECT TO CHANGE UPON FINAL SITE MEASURE
SITE: HAMPTON PLACE		DOOR STYLE: —		DOOR HANDLE: —		SCALE: 1/2" = 1' - 0"	
PHONE: —		FINISH: —		DRW HANDLE: —		DATE: MAY 8, 2018	
EMAIL: —		SPECIES: —		TOP: —		PAGE:	

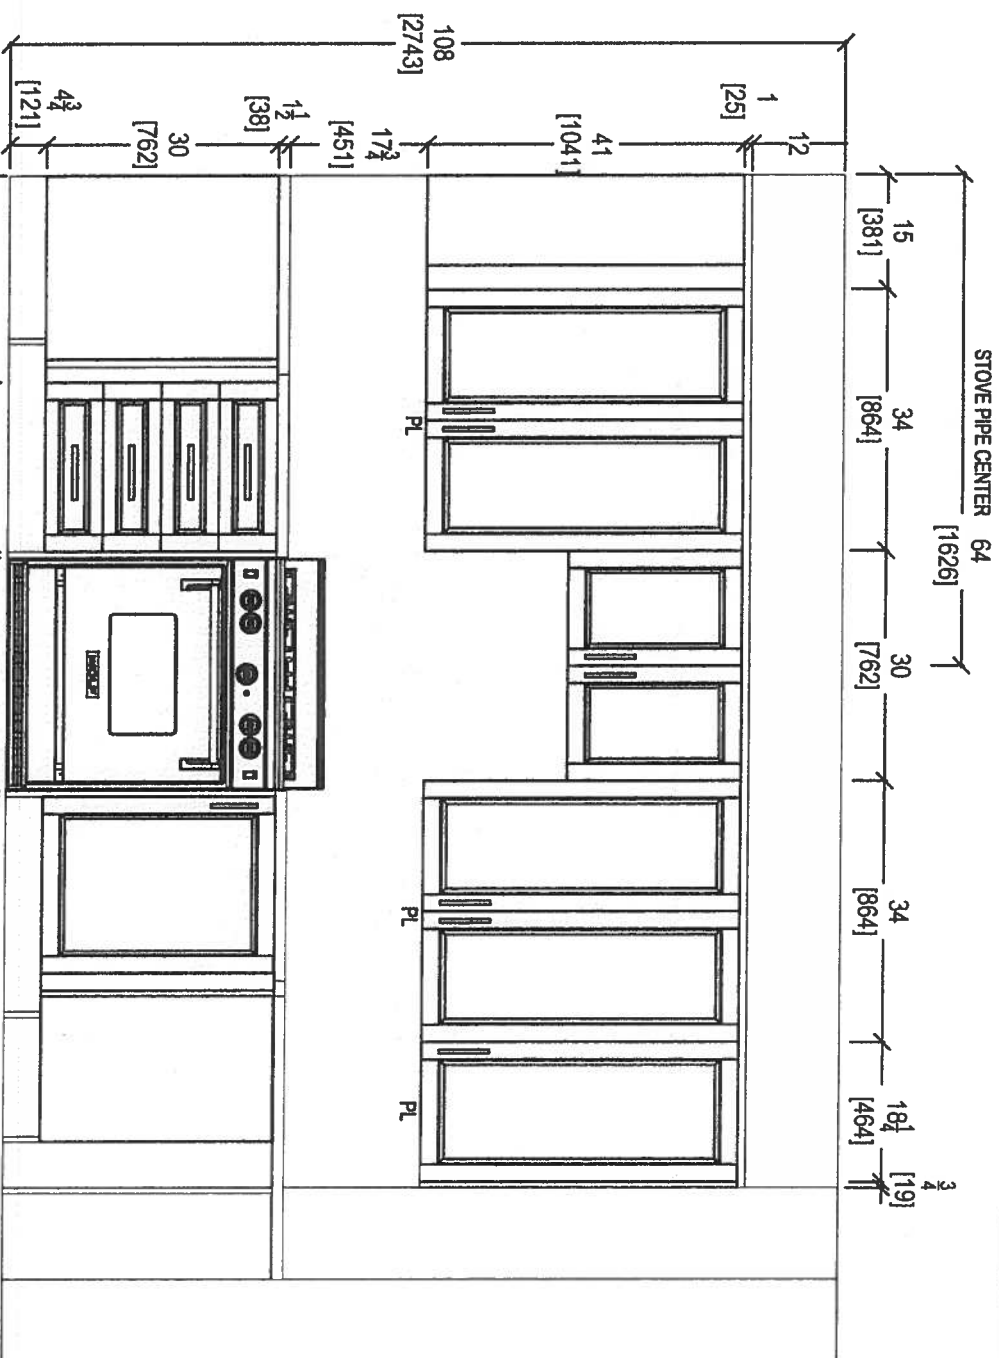


STOVE WALL ELEVATION

CLIENT: ROYAL PINE HOMES	JOB NAME: UNIT 511 HMP STRANDY	ROOM: KITCHEN	DRAWN BY: SK
SITE: HAMPTON PLACE	DOOR STYLE: —	DOOR HANDLE: —	SCALE: 1/2" = 1' - 0"
PHONE: —	FINISH: —	DRW HANDLE: —	DATE: MAY 8, 2018
EMAIL: —	SPECIES: —	TOP: —	PAGE:

COMMENTS:

PLEASE NOTE ALL DIMENSIONS
ARE NOT FINAL AND ARE
SUBJECT TO CHANGE UPON
FINAL SITE MEASURE



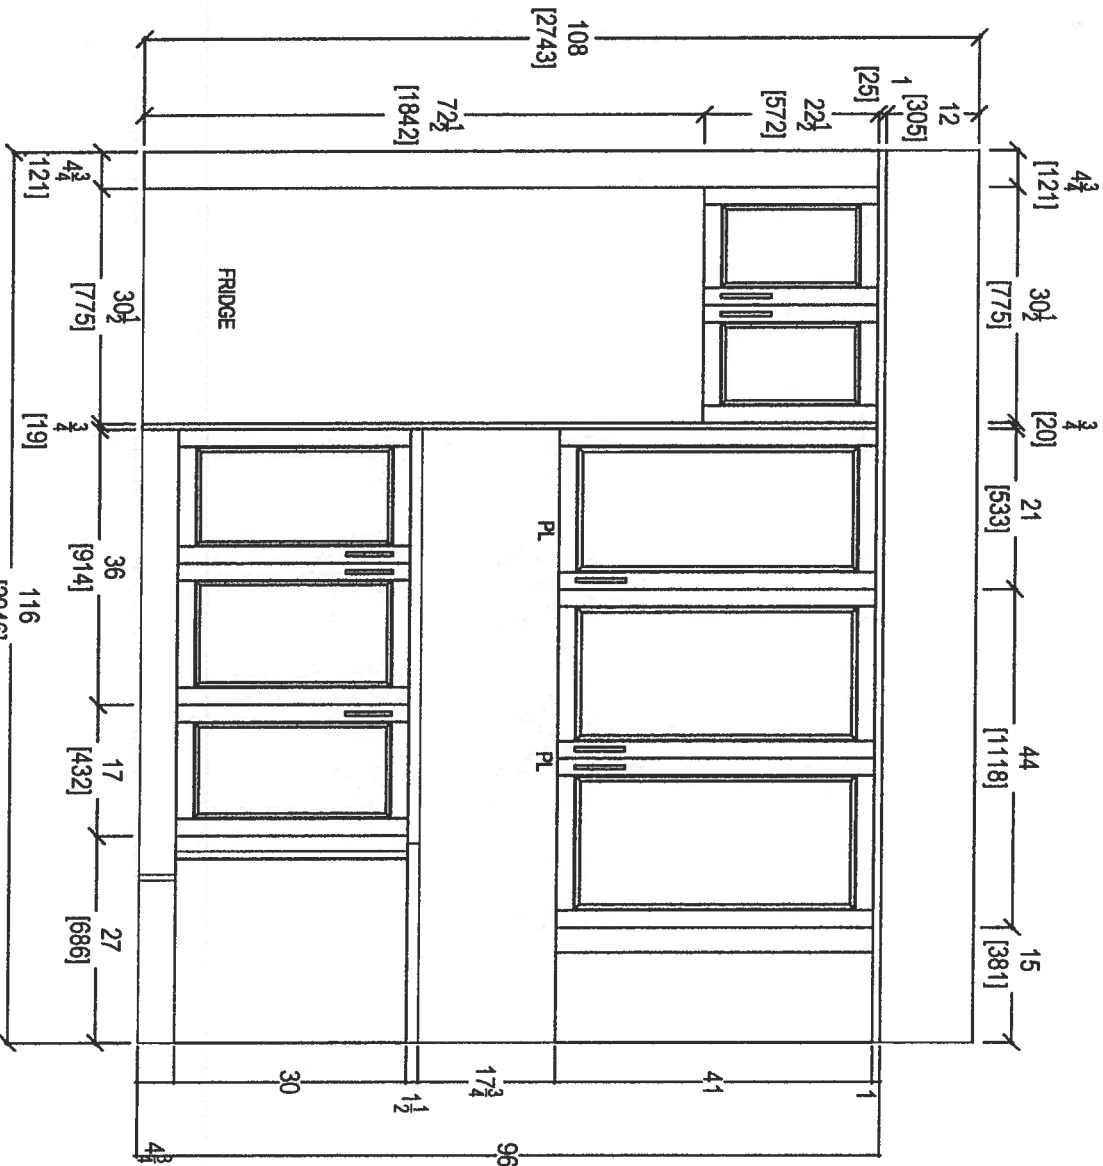

FRIDGE WALL ELEVATION


CLIENT: ROYAL PINE HOMES	JOB NAME: UNIT 511 HMP	ROOM: KITCHEN	DRAWN BY: SK
SITE: HAMPTON PLACE	DOOR STYLE: —	DOOR HANDLE: —	SCALE: 1/2" = 1' - 0"
PHONE: —	FINISH: —	DRV HANDLE: —	DATE: MAY 8, 2018
EMAIL: —	SPECIES: —	TOP: —	PAGE:

COMMENTS:


PLEASE NOTE ALL DIMENSIONS
ARE NOT FINAL AND ARE
SUBJECT TO CHANGE UPON
FINAL SITE MEASURE



80 SANTE DRIVE, VAUGHAN, ON L4K 3C4,
T: 416.746.1811 F:305.761.5901

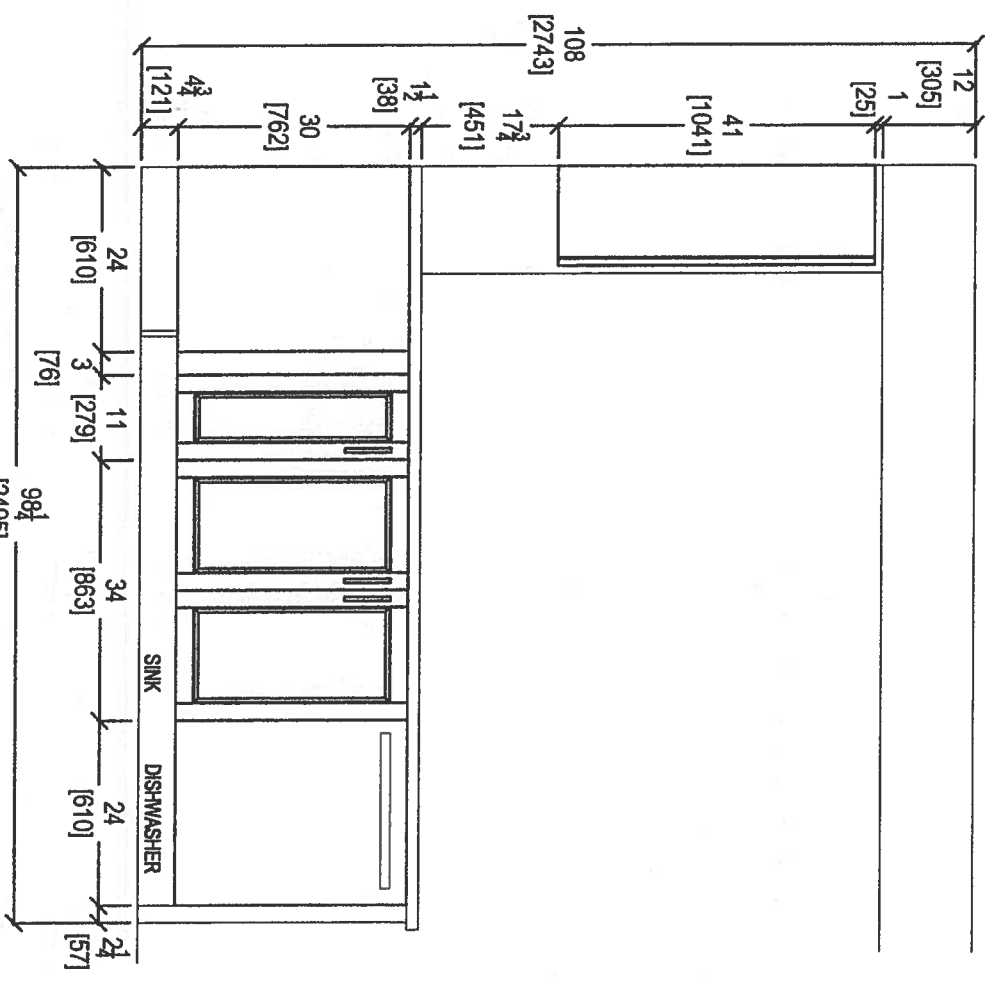

KITCHEN PENINSULA ELEVATION
FRONT VIEW

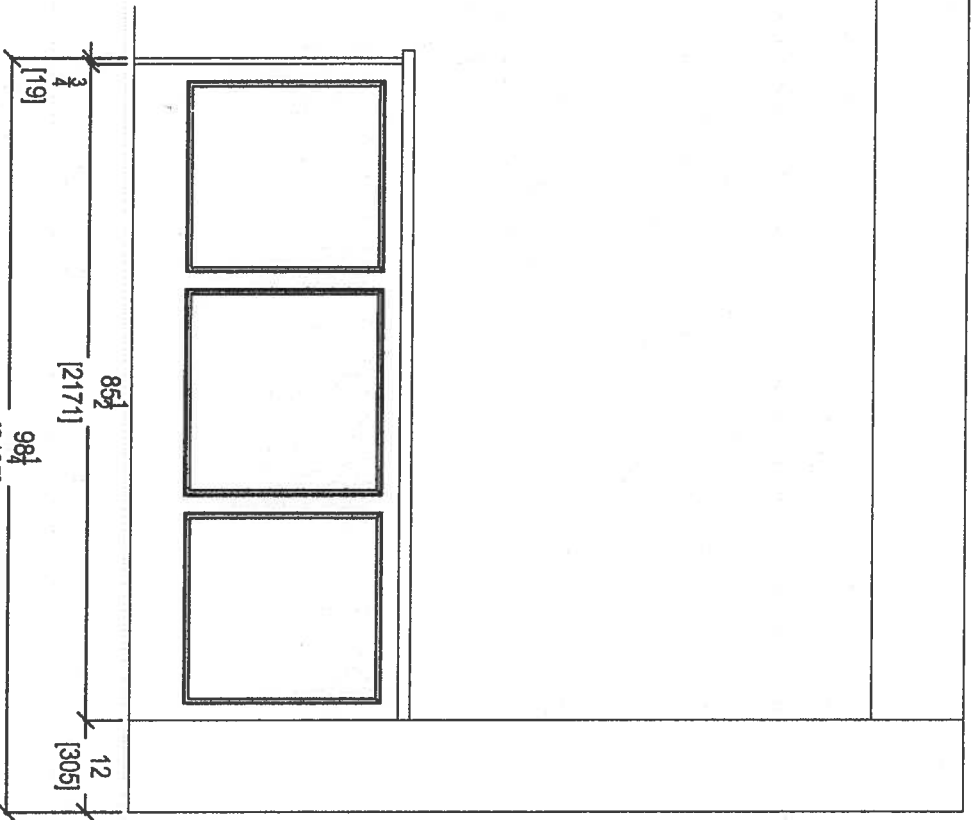


KITCHEN PENINSULA ELEVATION
REAR VIEW




80 SANTE DRIVE, VAUGHAN, ON L4K 3C4,
T: 416.746.1811 F: 905.781.5901

CLIENT: ROYAL PINE HOMES	JOB NAME: UNIT 511 HMP	STANDARD	ROOM: KITCHEN	DRAWN BY: SK
SITE: HAMPTON PLACE	DOOR STYLE: —	DOOR HANDLE: —	SCALE: 1/2" = 1' - 0"	
PHONE: —	FINISH: —	DRW HANDLE: —	DATE: MAY 8, 2018	
EMAIL: —	SPECIES: —	TOP: —	PAGE:	



COMMENTS:
PLEASE NOTE ALL DIMENSIONS
ARE NOT FINAL AND ARE
SUBJECT TO CHANGE UPON
FINAL SITE MEASURE

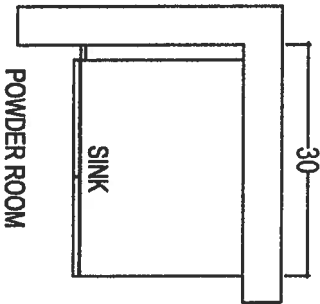

POWDER ROOM

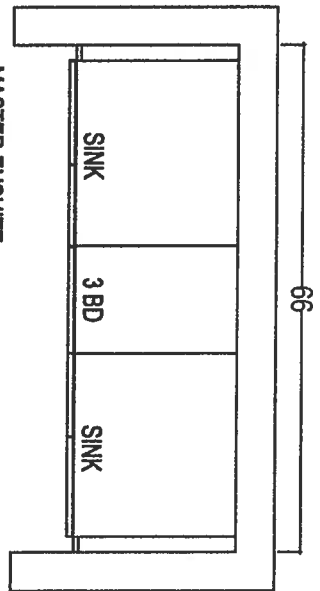


MASTER ENSUITE

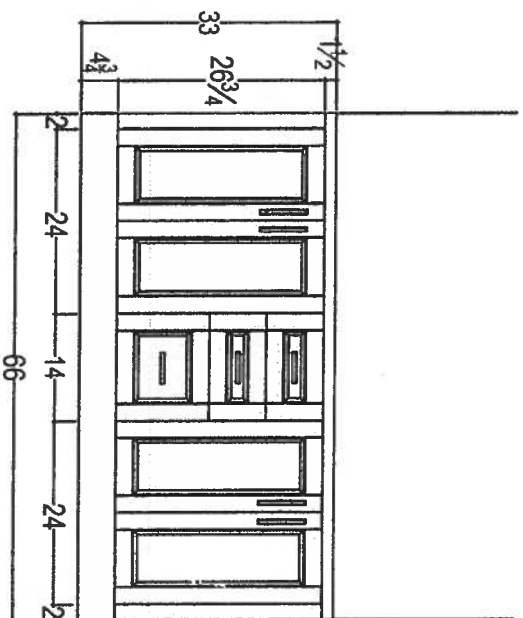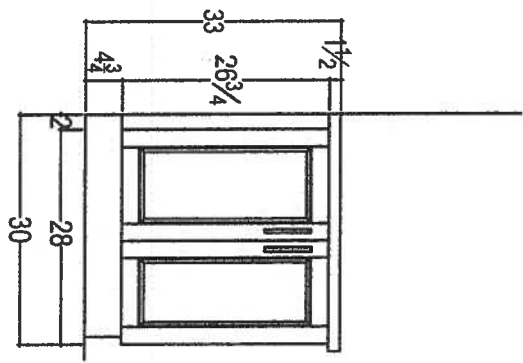

your kitchen, your taste.
80 SANTE DRIVE, VAUGHAN, ON L4K 3C4.
T: 416.746.1811 F: 905.781.5901

CLIENT: ROYAL PINE HOMES	JOB NAME: UNIT 511 HMP STANDARDS	ROOM: VANITIES	DRAWN BY: SK
SITE: HAMPTON PLACE	DOOR STYLE: --	DOOR HANDLE: --	SCALE: 1/2" = 1' - 0"
PHONE: --	FINISH: --	DRW HANDLE: --	DATE: MAY 8, 2018
EMAIL: --	SPECIES: --	TOP: --	PAGE:

COMMENTS:
PLEASE NOTE ALL DIMENSIONS
ARE NOT FINAL AND ARE
SUBJECT TO CHANGE UPON
FINAL SITE MEASURE

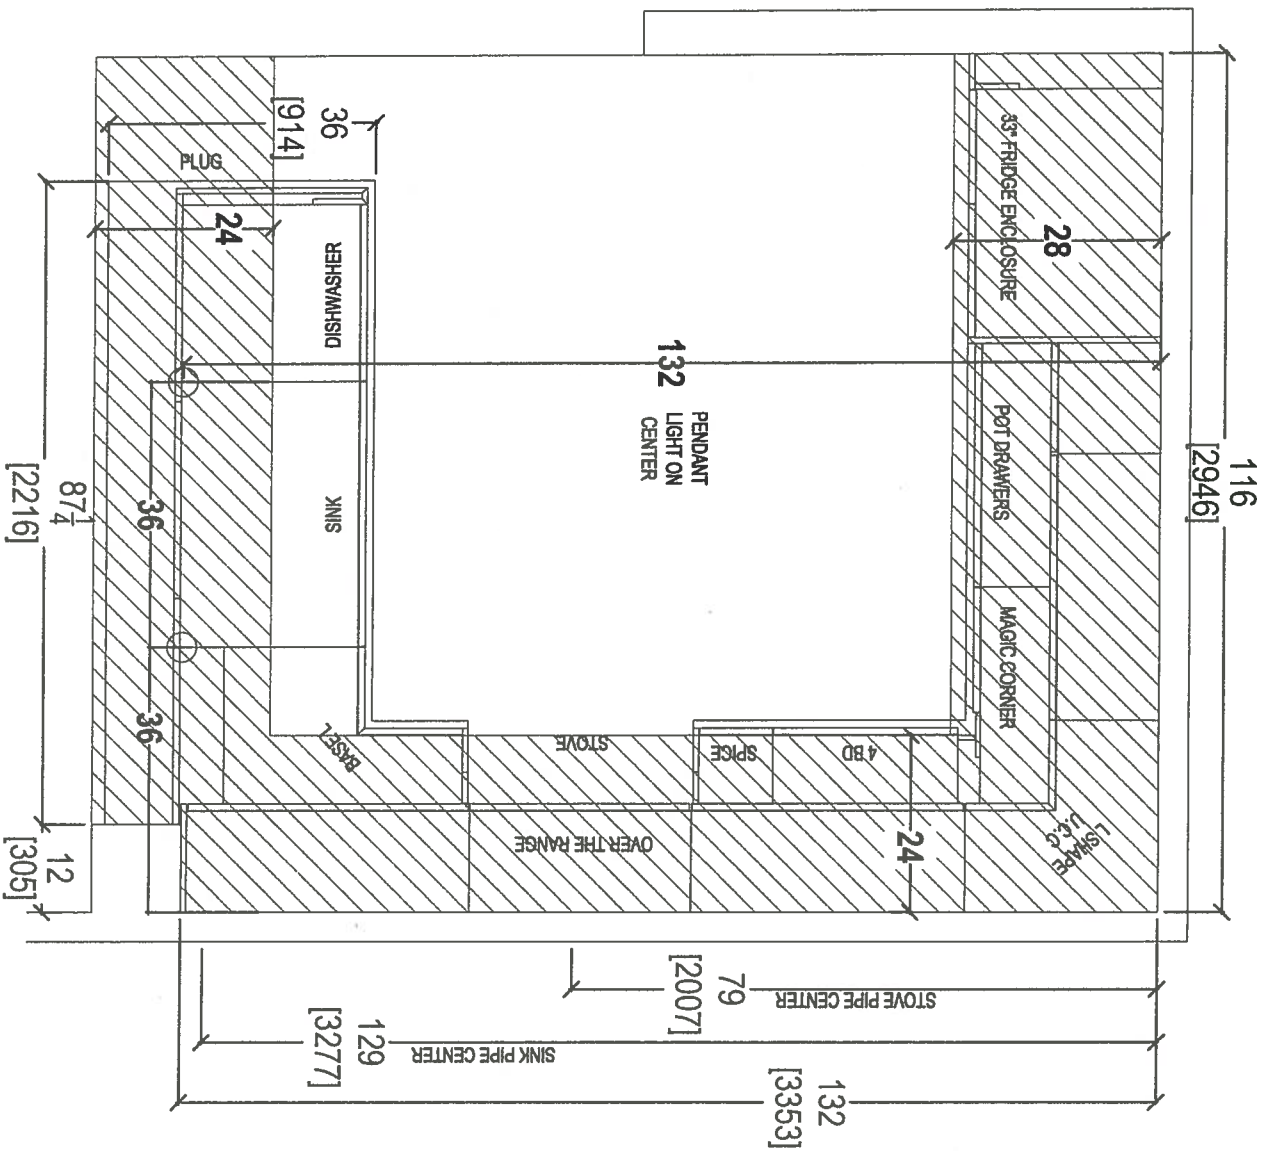

* UPGRADE *
* OPTION *

CLIENT: ROYAL PINE HOMES

JOB NAME: UNIT 511 HMP

ROOM: KITCHEN BULKHEAD PLAN

DRAWN BY: SK

COMMENTS:

SITE: HAMPTON PLACE

DOOR STYLE: —

DOOR HANDLE: —

SCALE: 1/2" = 1' - 0"

PLEASE NOTE ALL DIMENSIONS
ARE NOT FINAL AND ARE
SUBJECT TO CHANGE UPON
FINAL SITE MEASURE

PHONE: —

FINISH: —

DRW HANDLE: —

DATE: MAY 1, 2018

EMAIL: —

SPECIES: —

TOP: —

PAGE:


your kitchen, your taste
80 SANTE DRIVE, VAUGHAN
T. 416.746.1811 F. 905.746.1811






CLIENT: ROYAL PINE HOMES	JOB NAME: UNIT 511 HMP	ROOM: KITCHEN FLOOR PLAN	DRAWN BY: SK
SITE: HAMPTON PLACE	DOOR STYLE: —	DOOR HANDLE: —	SCALE: 1/2" = 1' - 0"
PHONE: —	FINISH: —	DRW HANDLE: —	DATE: MAY 1, 2018
EMAIL: —	SPECIES: —	TOP: —	PAGE: —

2

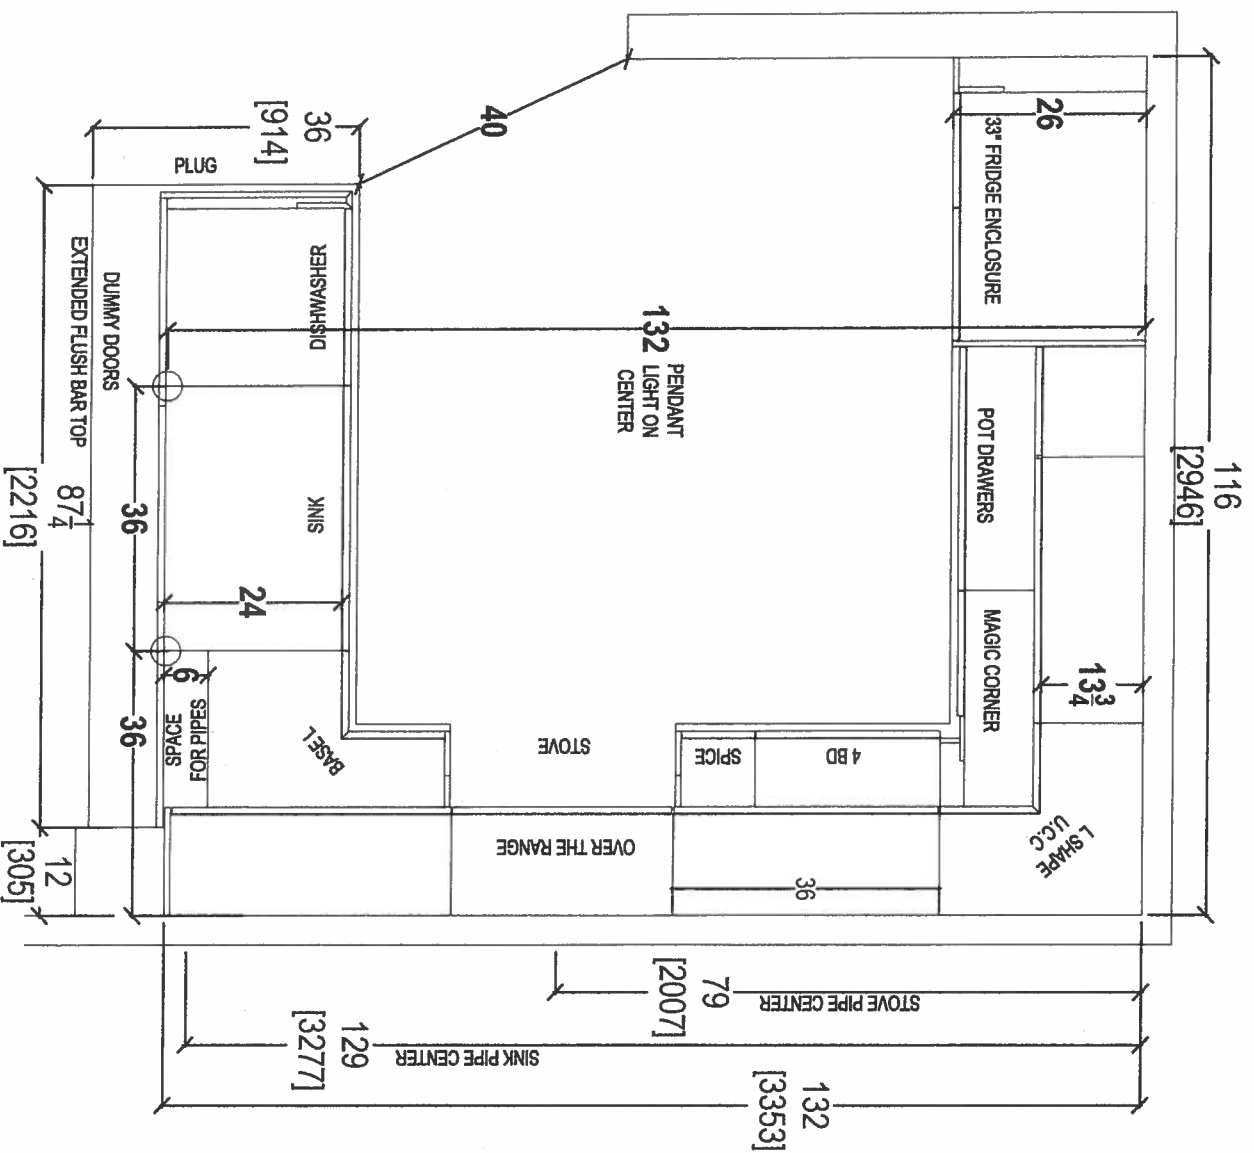

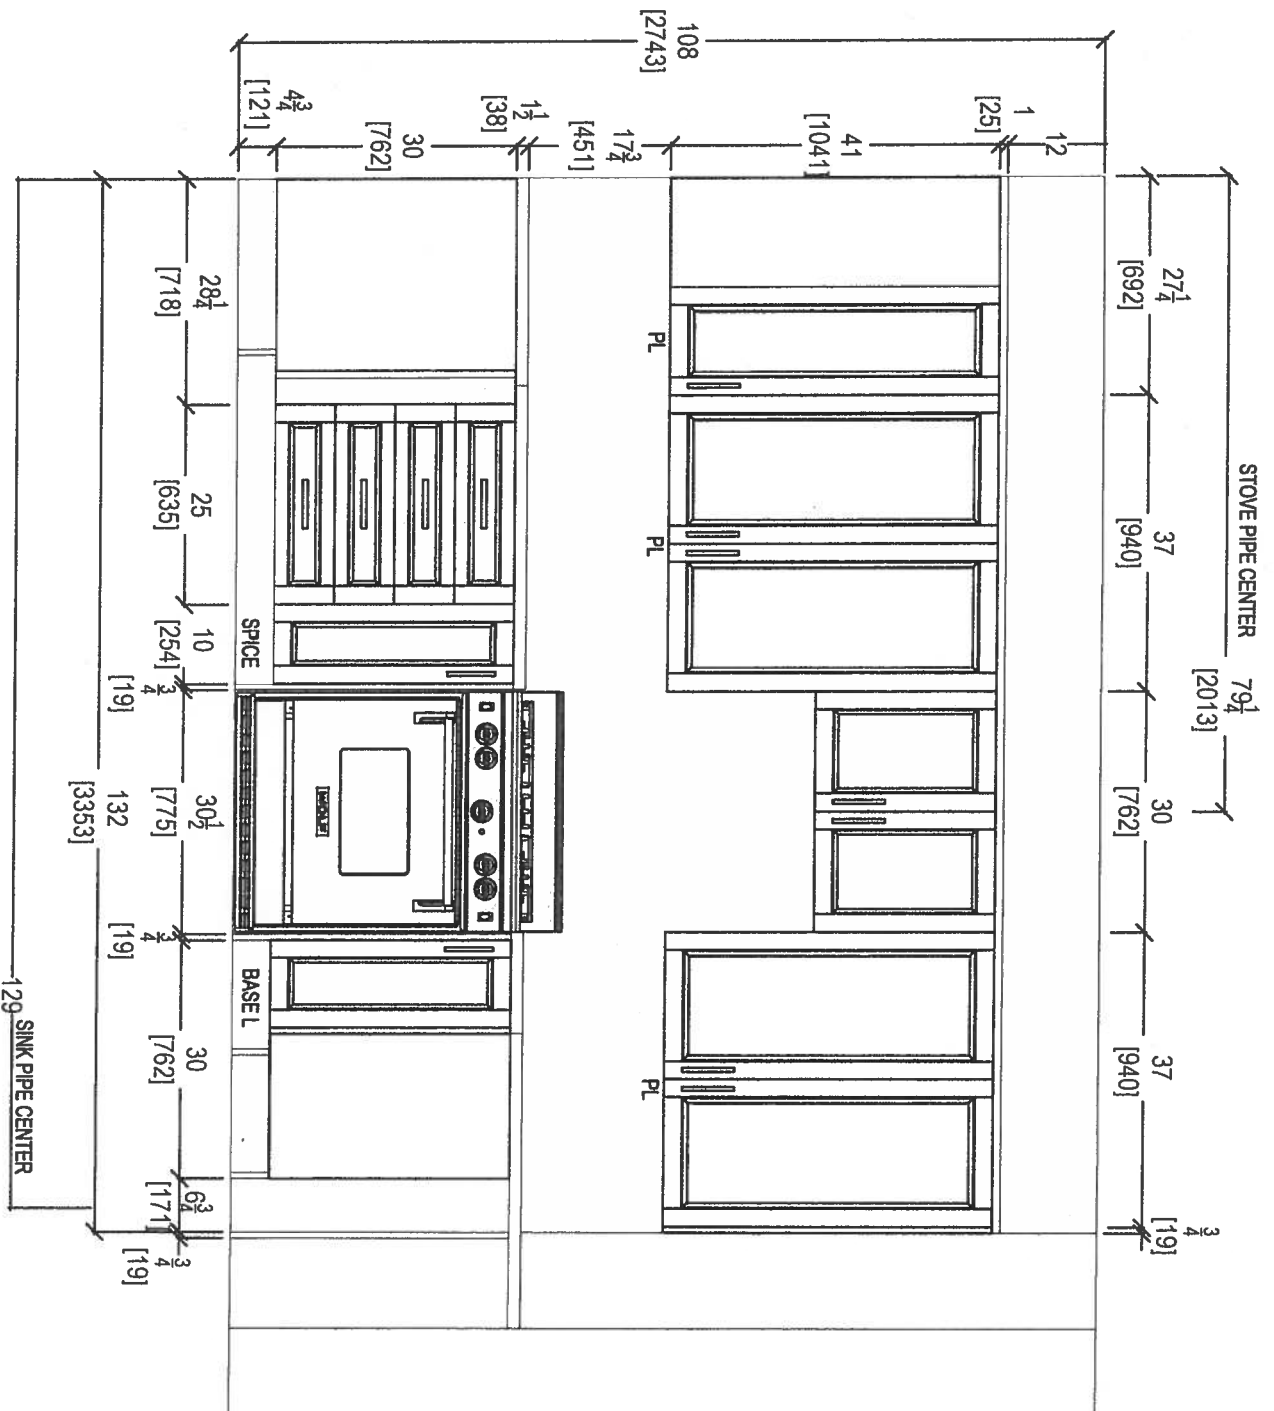

STOVE WALL ELEVATION

CLIENT: ROYAL PINE HOMES	JOB NAME: UNIT 511 HMP	ROOM: KITCHEN	DRAWN BY: SK
SITE: HAMPTON PLACE	DOOR STYLE: —	DOOR HANDLE: —	SCALE: 1/2" = 1' - 0"
PHONE: —	FINISH: —	DRW HANDLE: —	DATE: MAY 1, 2018
EMAIL: —	SPECIES: —	TOP: —	PAGE: —

COMMENTS:


PLEASE NOTE ALL DIMENSIONS
ARE NOT FINAL AND ARE
SUBJECT TO CHANGE UPON
FINAL SITE MEASURE




80 SANTE DRIVE, VAUGHAN
T: 416.746.1811 F: 905.746.1811




CLIENT: ROYAL PINE HOMES	JOB NAME: UNIT 511 HMP	ROOM: KITCHEN	DRAWN BY: SK	COMMENTS: PLEASE NOTE ALL DIMENSIONS ARE NOT FINAL AND ARE SUBJECT TO CHANGE UPON FINAL SITE MEASURE
SITE: HAMPTON PLACE	DOOR STYLE: —	DOOR HANDLE: —	SCALE: 1/2" = 1' - 0"	
PHONE: —	FINISH: —	DRW HANDLE: —	DATE: MAY 1, 2018	
EMAIL: —	SPECIES: —	TOP: —	PAGE: —	

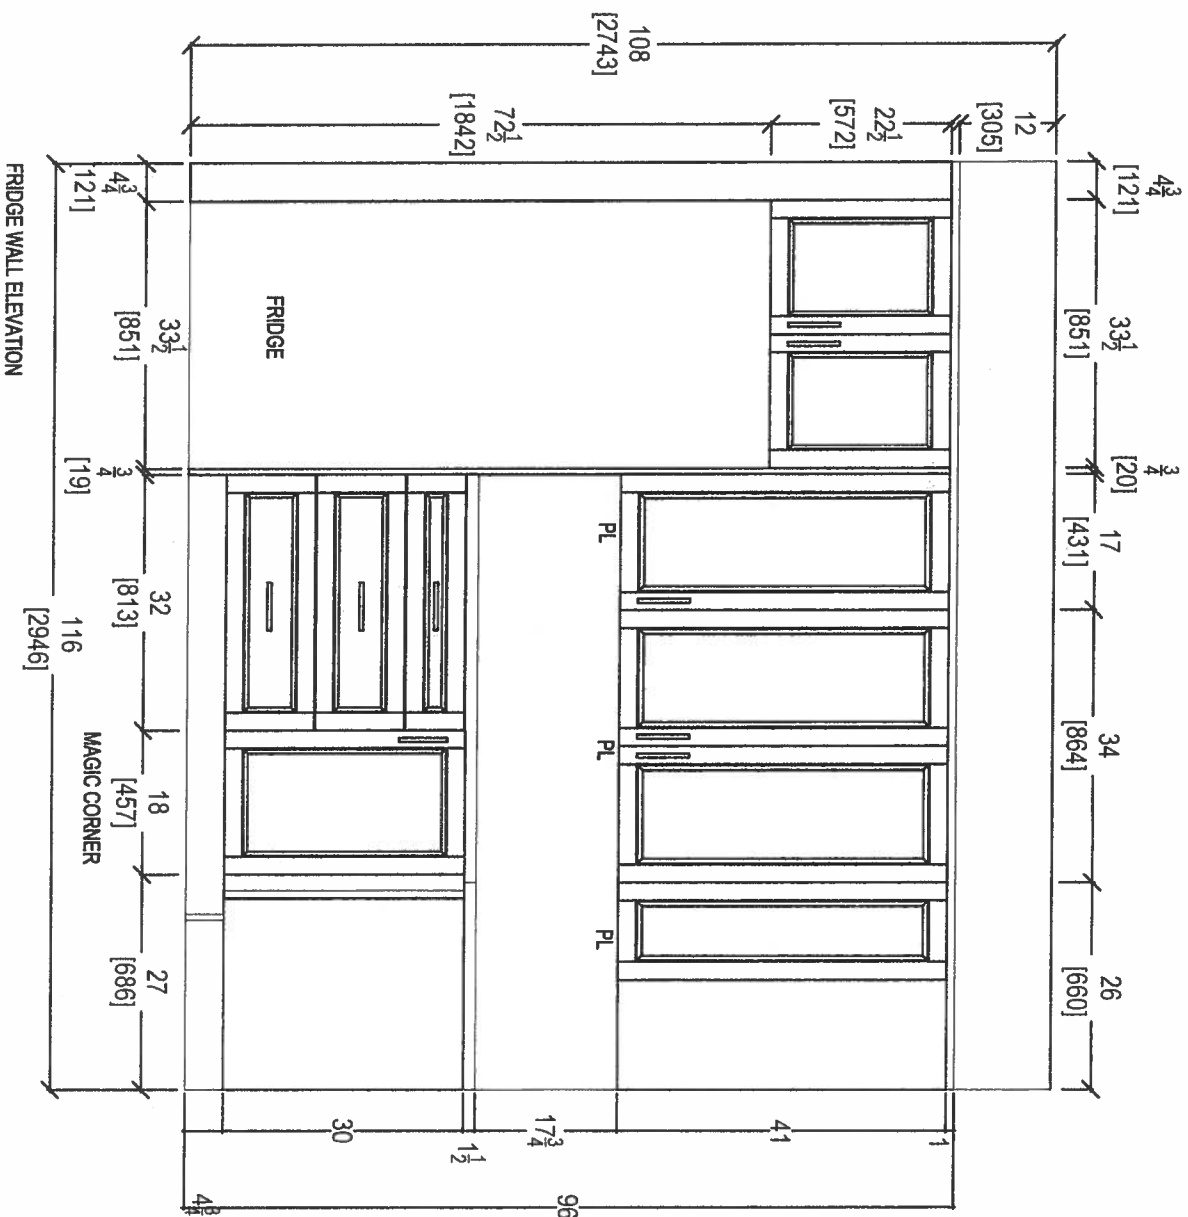

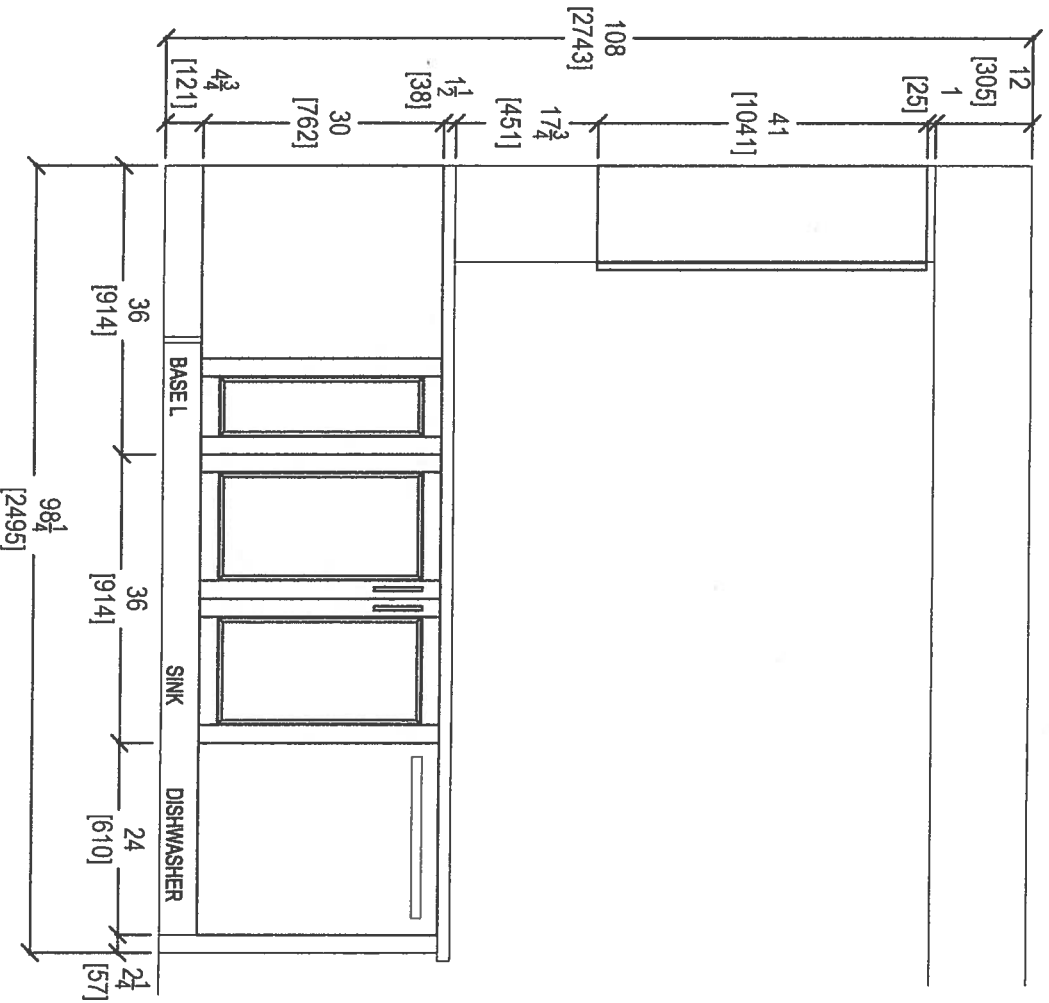

KITCHEN PENINSULA ELEVATION
FRONT VIEW

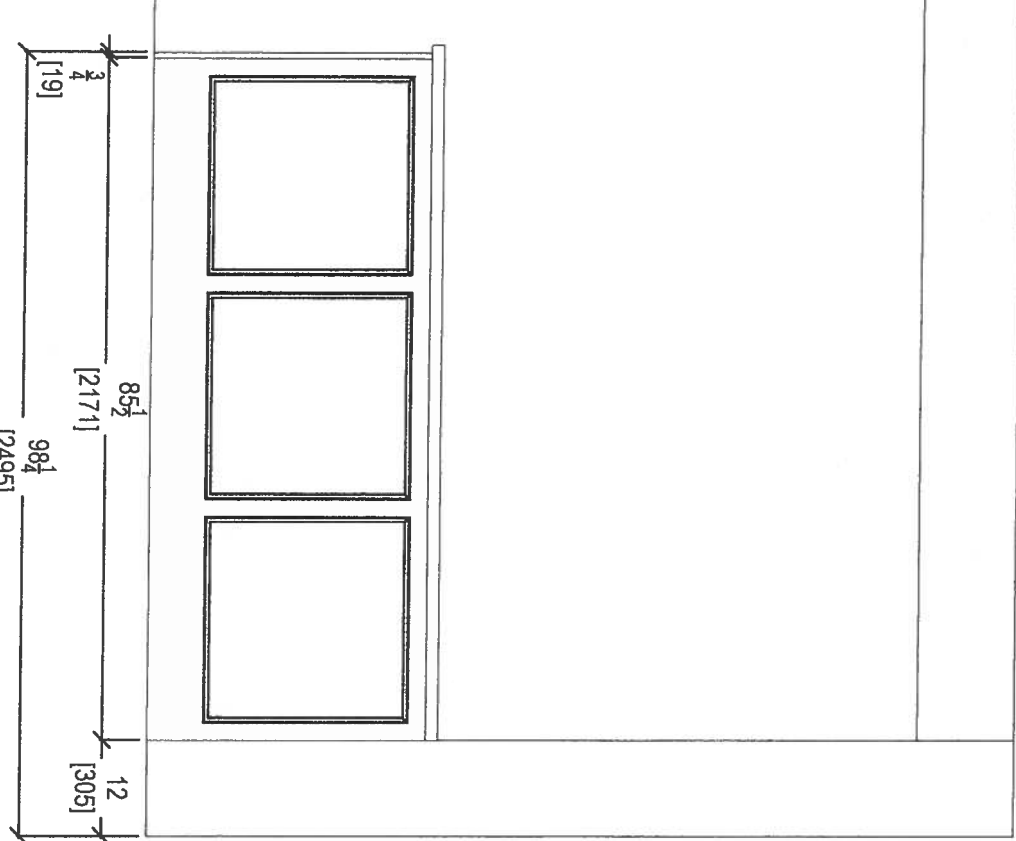

KITCHEN PENINSULA ELEVATION
REAR VIEW



QTH

your kitchen, your taste.


80 SANTE DRIVE, VAUGHAN, ONTARIO L4K 3C4,
T: 416.746.1811

CLIENT: ROYAL PINE HOMES	JOB NAME: UNIT 511 HMP	ROOM: KITCHEN	DRAWN BY: SK
SITE: HAMPTON PLACE	DOOR STYLE: —	DOOR HANDLE: —	SCALE: 1/2" = 1' - 0"
PHONE: —	FINISH: —	DRW HANDLE: —	DATE: MAY 1, 2018
EMAIL: —	SPECIES: —	TOP: —	PAGE:


COMMENTS:

PLEASE NOTE ALL DIMENSIONS
ARE NOT FINAL AND ARE
SUBJECT TO CHANGE UPON
FINAL SITE MEASURE



69

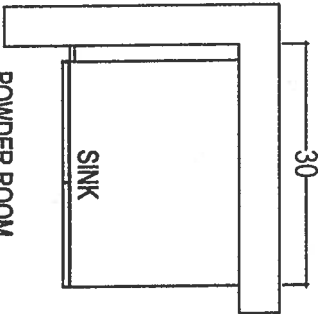

POWDER ROOM

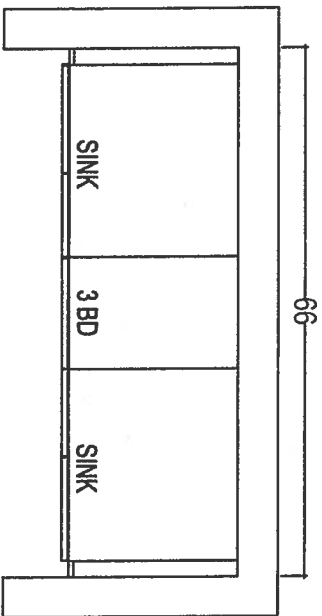

MASTER ENSUITE

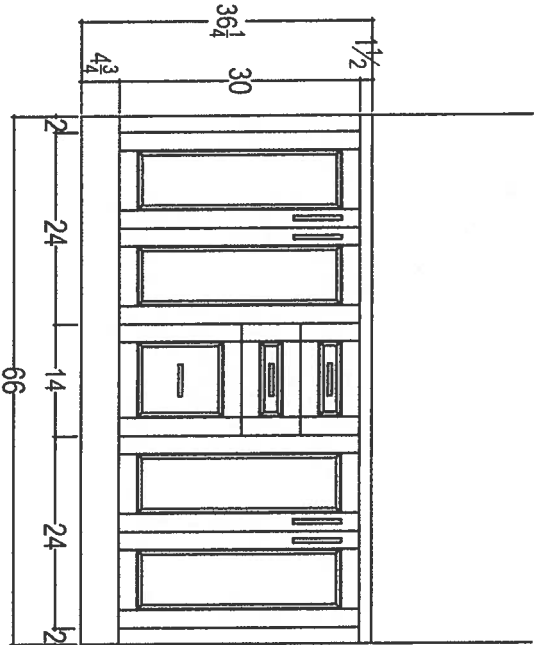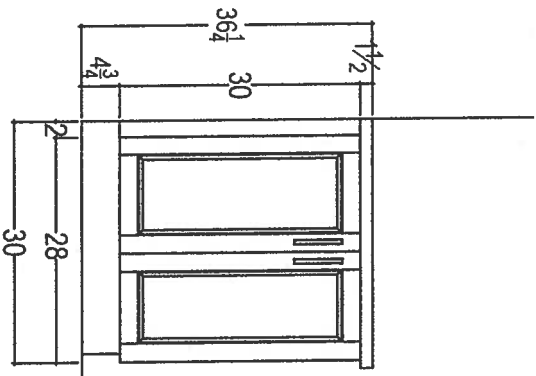

 your kitchen, your taste 80 SANTE DRIVE, VAUGHAN, ONTARIO L4K 3C4 TEL: 416.746.1811 FAX: 416.746.1812	CLIENT: ROYAL PINE HOMES	JOB NAME: UNIT 511 HMP	ROOM: VANITIES	DRAWN BY: SK	COMMENTS: PLEASE NOTE ALL DIMENSIONS ARE NOT FINAL AND ARE SUBJECT TO CHANGE UPON FINAL SITE MEASURE
	SITE: HAMPTON PLACE	DOOR STYLE: —	DOOR HANDLE: —	SCALE: 1/2" = 1' - 0"	
	PHONE: —	FINISH: —	DRW HANDLE: —	DATE: MAY 1, 2018	
	EMAIL: —	SPECIES: —	TOP: —	PAGE:	

69