



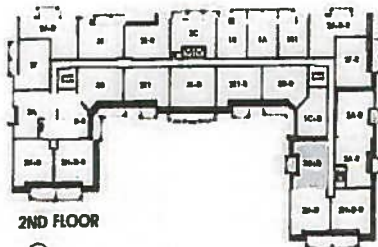


Noyac Bay

1,121 SQ FT *plus 76 sq. ft. of balcony area*


SUITE 211
ORIGINAL LAYOUT
INVENTORY SUITE

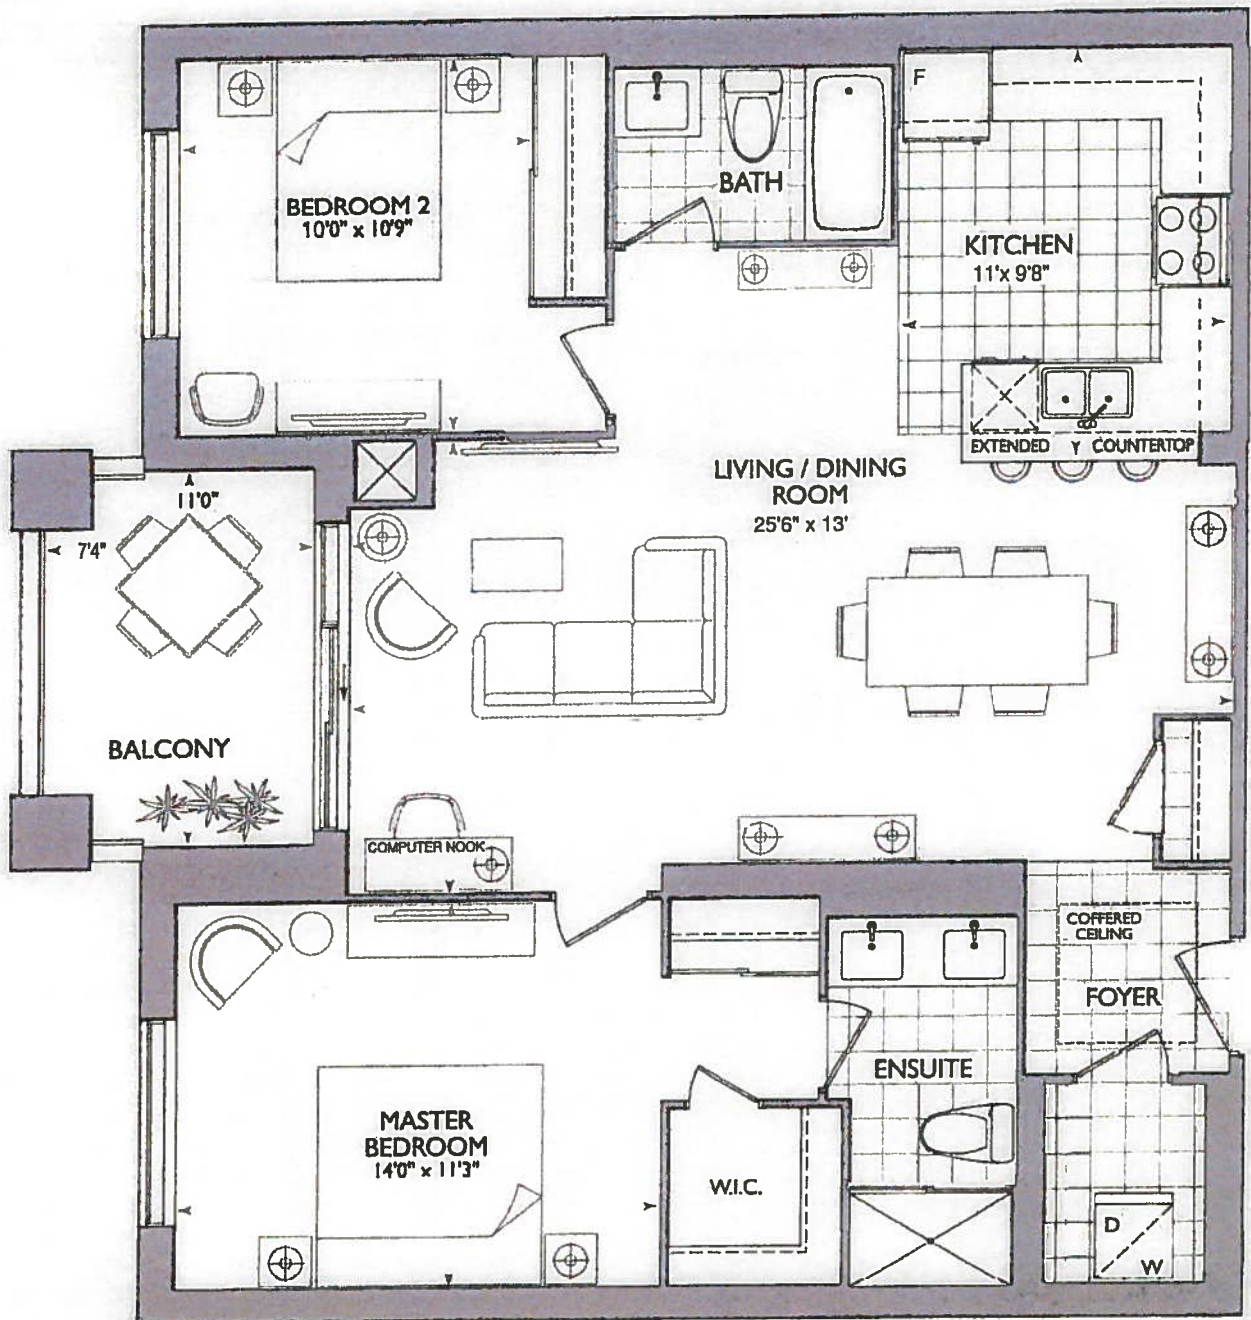

2ND FLOOR

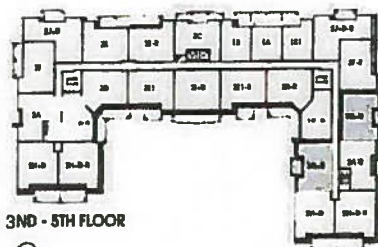

3RD - 5TH FLOOR

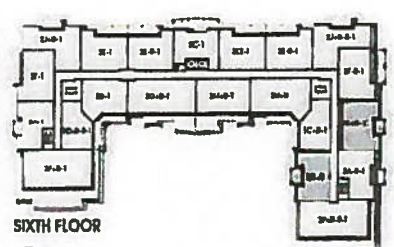


SIXTH FLOOR

Plans and specifications are subject to change without notice. Actual usable floor space may vary from the stated floor area. All renderings are artist's concept E. & O. E.




*** KITCHEN ***
CHOICE OF STD. KITCHEN LAYOUT WITH
STD. APPLIANCE PACKAGE
OR
CAN UPGRADE AT DECOR CENTER
- (x2) CAPPED PENDANT
- (x1) PLUG PENINSULA
- (x) PUCK LIGHTS
*SEE ATTACHED UPG.
#1- KITCHEN LAYOUT WITH 1ST UPG.
APPLIANCE PACKAGE

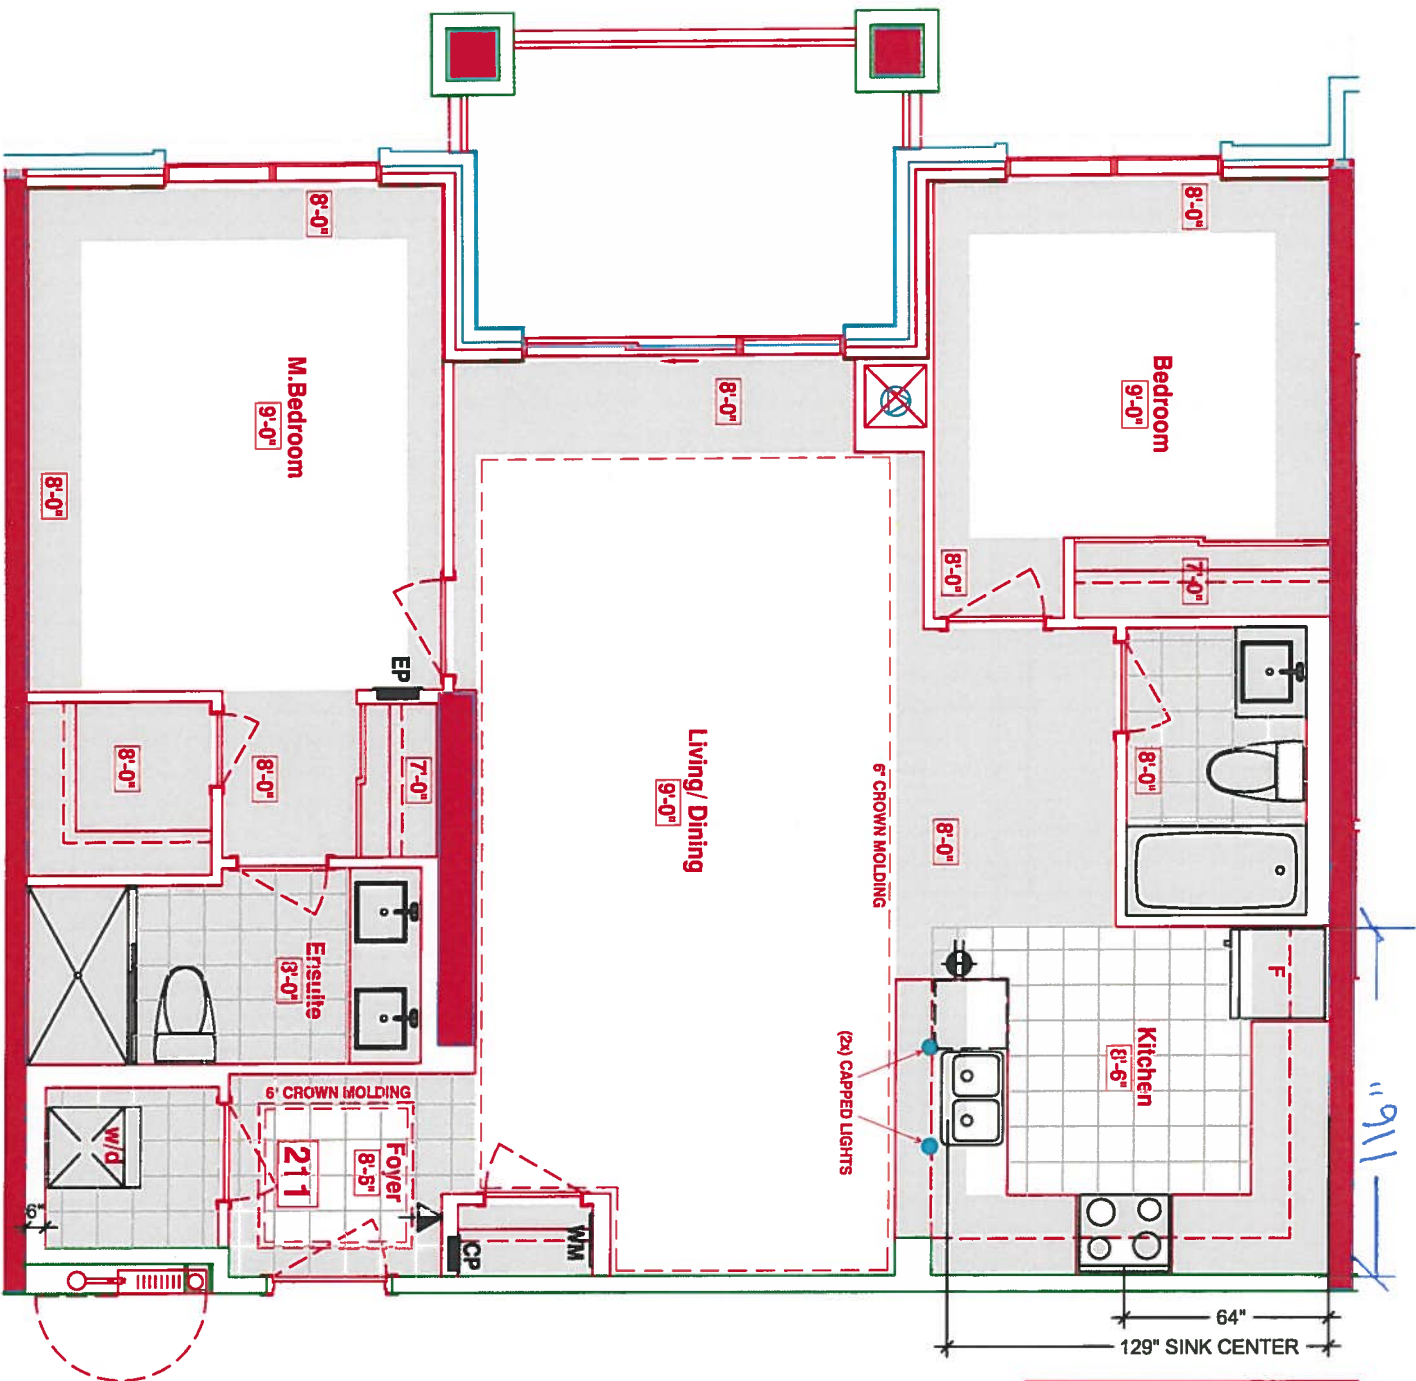

*** SUITE 211 * (INVENTORY SUITE)**
NEW PLAN
-REMOVED DEN
-REVISED KITCHEN
*REVISED LAUNDRY DOOR SWING &
ENSUITE WALL AS PER THIS BROCHURE

LEGEND:	
	SECURITY PANEL
	ELECTRICAL PANEL
	COMMUNICATION PANEL
	WATER METER
	FRIDGE
	DROPPED AREA
	6" CROWN MOLDING

* UPGRADE KITCHEN LAYOUT.

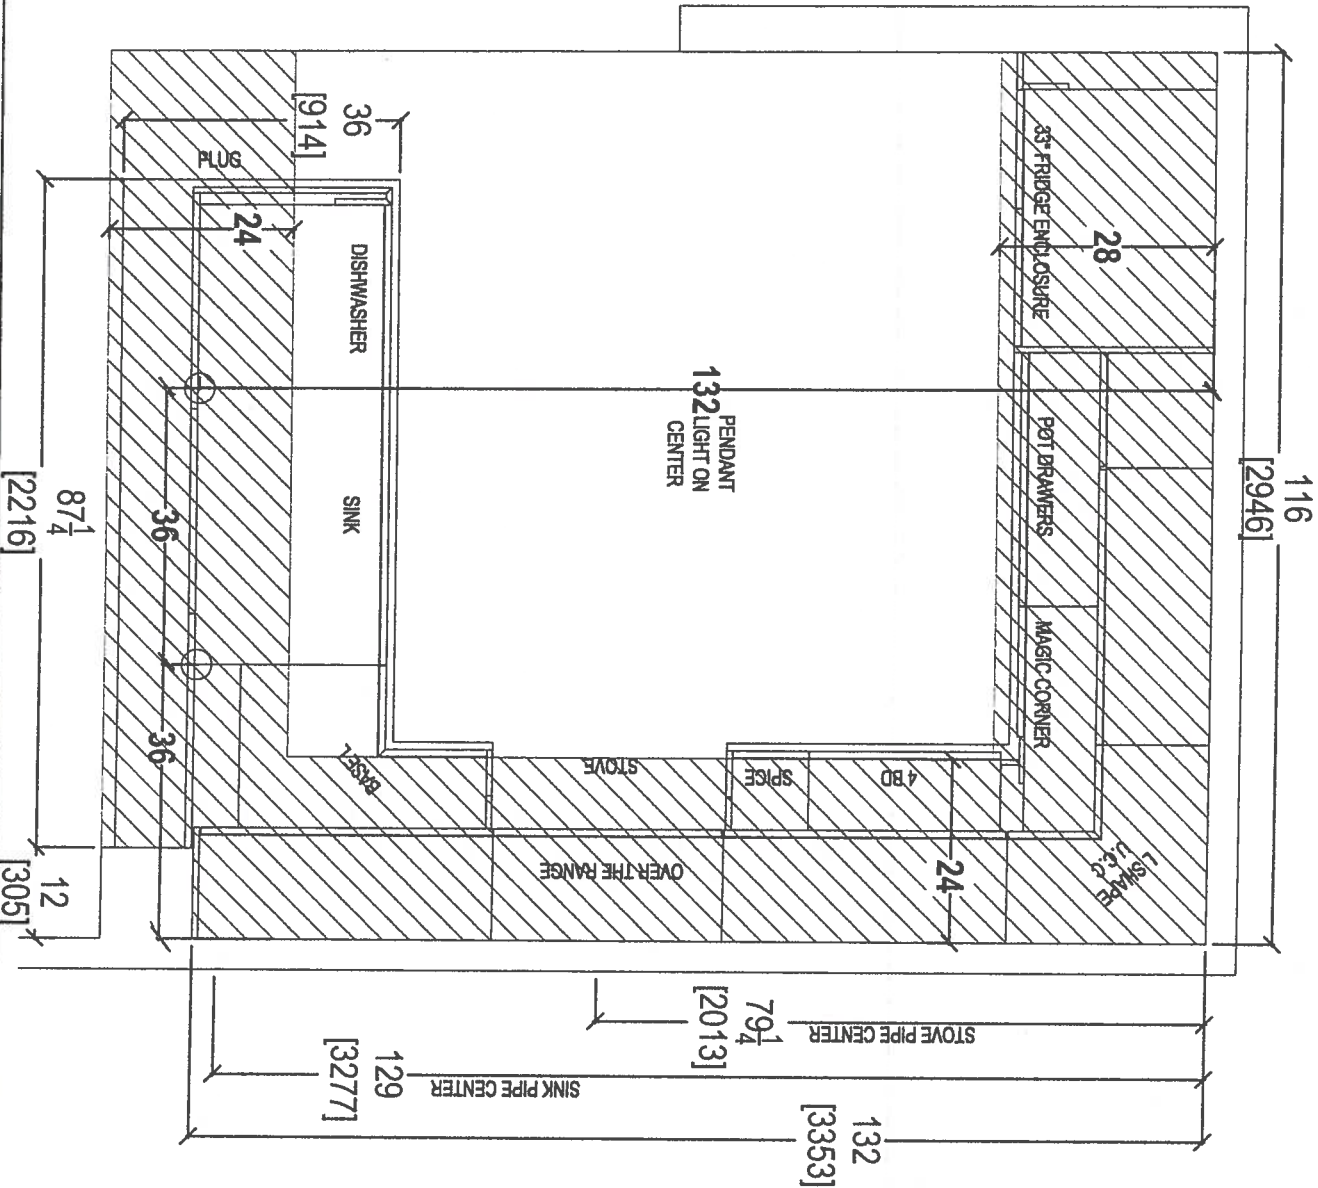

CLIENT: ROYAL PINE HOMES

UNIT 211 HMP

ROOM: KITCHEN BULKHEAD PLAN

DRAWN BY: SK

COMMENTS:

SITE: HAMPTON PLACE

DOOR STYLE: —

DOOR HANDLE: —

SCALE: 1/2" = 1'-0"

PHONE: —

FINISH: —

DRW HANDLE: —

DATE: APRIL 20, 2018

EMAIL: —

SPECIES: —

TOP: —


PAGE: —

PLEASE NOTE ALL DIMENSIONS ARE NOT FINAL AND ARE SUBJECT TO CHANGE UPON FINAL SITE MEASURE

QTH

Your kitchen, your taste.

80 SANTE DRIVE, VAUGHAN, ONT. M3A 3C4,
T: 416.746.1811 F: 905.746.1811

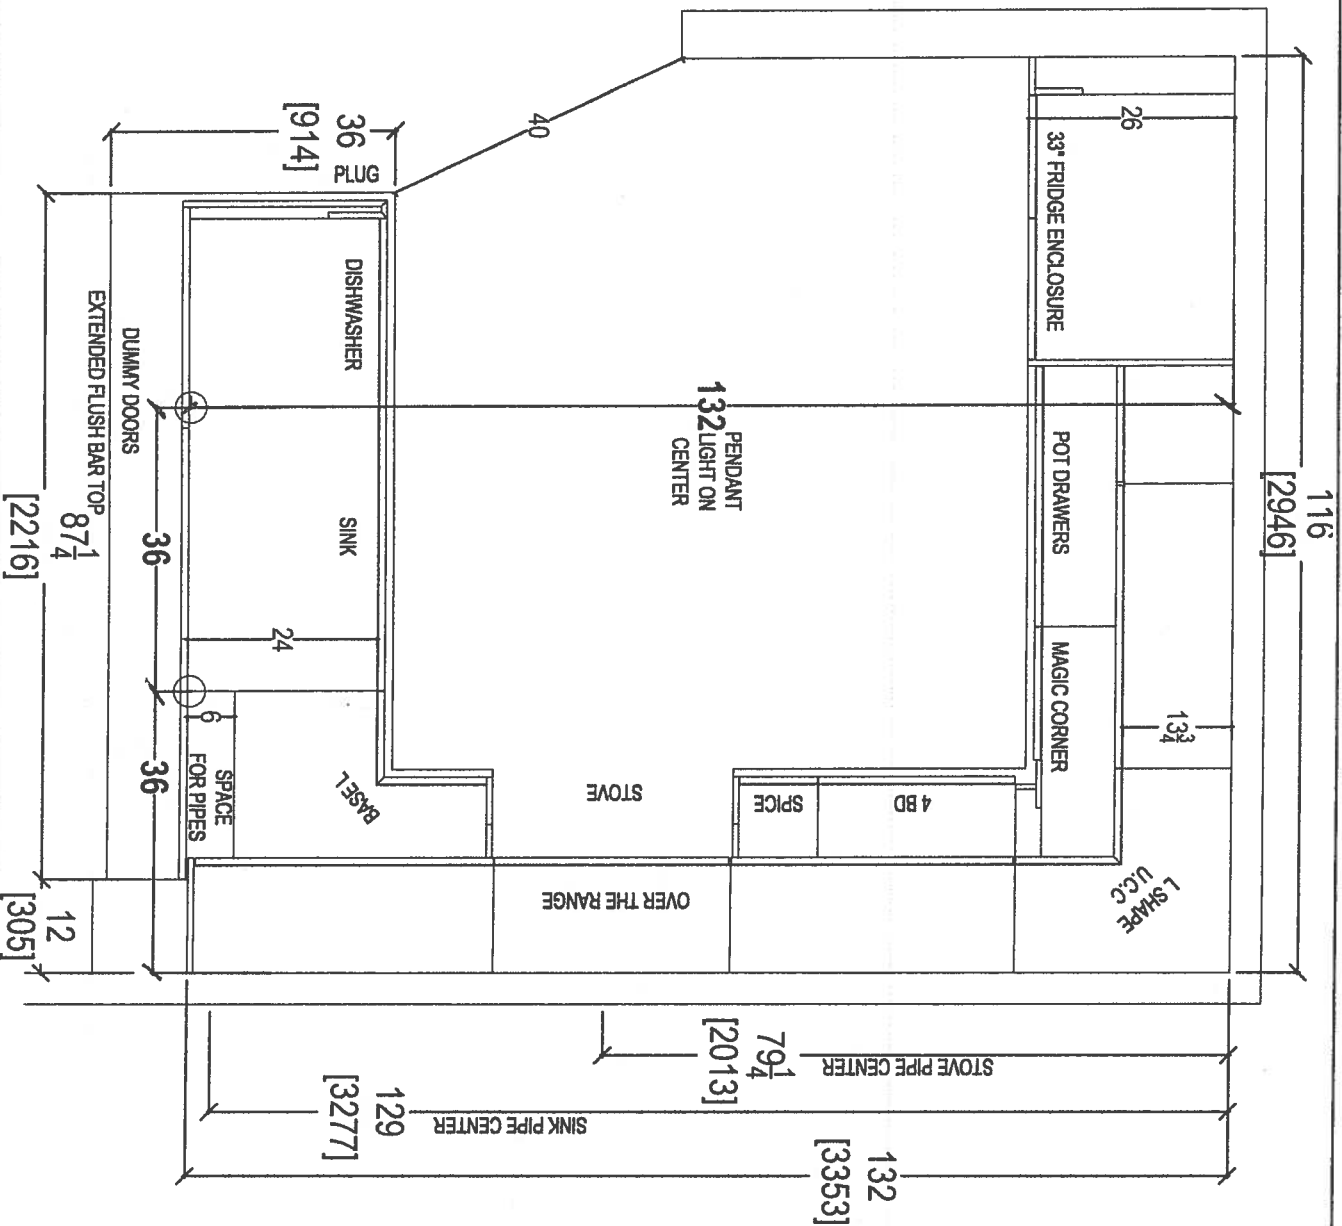


CLIENT: ROYAL PINE HOMES	UNIT 211 HMP	ROOM: KITCHEN FLOOR PLAN	DRAWN BY: SK
SITE: HAMPTON PLACE	DOOR STYLE: —	DOOR HANDLE: —	SCALE: 1/2" = 1' - 0"
PHONE: —	FINISH: —	DRW HANDLE: —	DATE: APRIL 20, 2018
EMAIL: —	SPECIES: —	TOP: —	PAGE: —



your kitchen, your taste.
80 SANTE DRIVE, VAUGHAN
T: 416.746.1811 F: 905.746.1811

COMMENTS:
PLEASE NOTE ALL DIMENSIONS
ARE NOT FINAL AND ARE
SUBJECT TO CHANGE UPON
FINAL SITE MEASURE

69

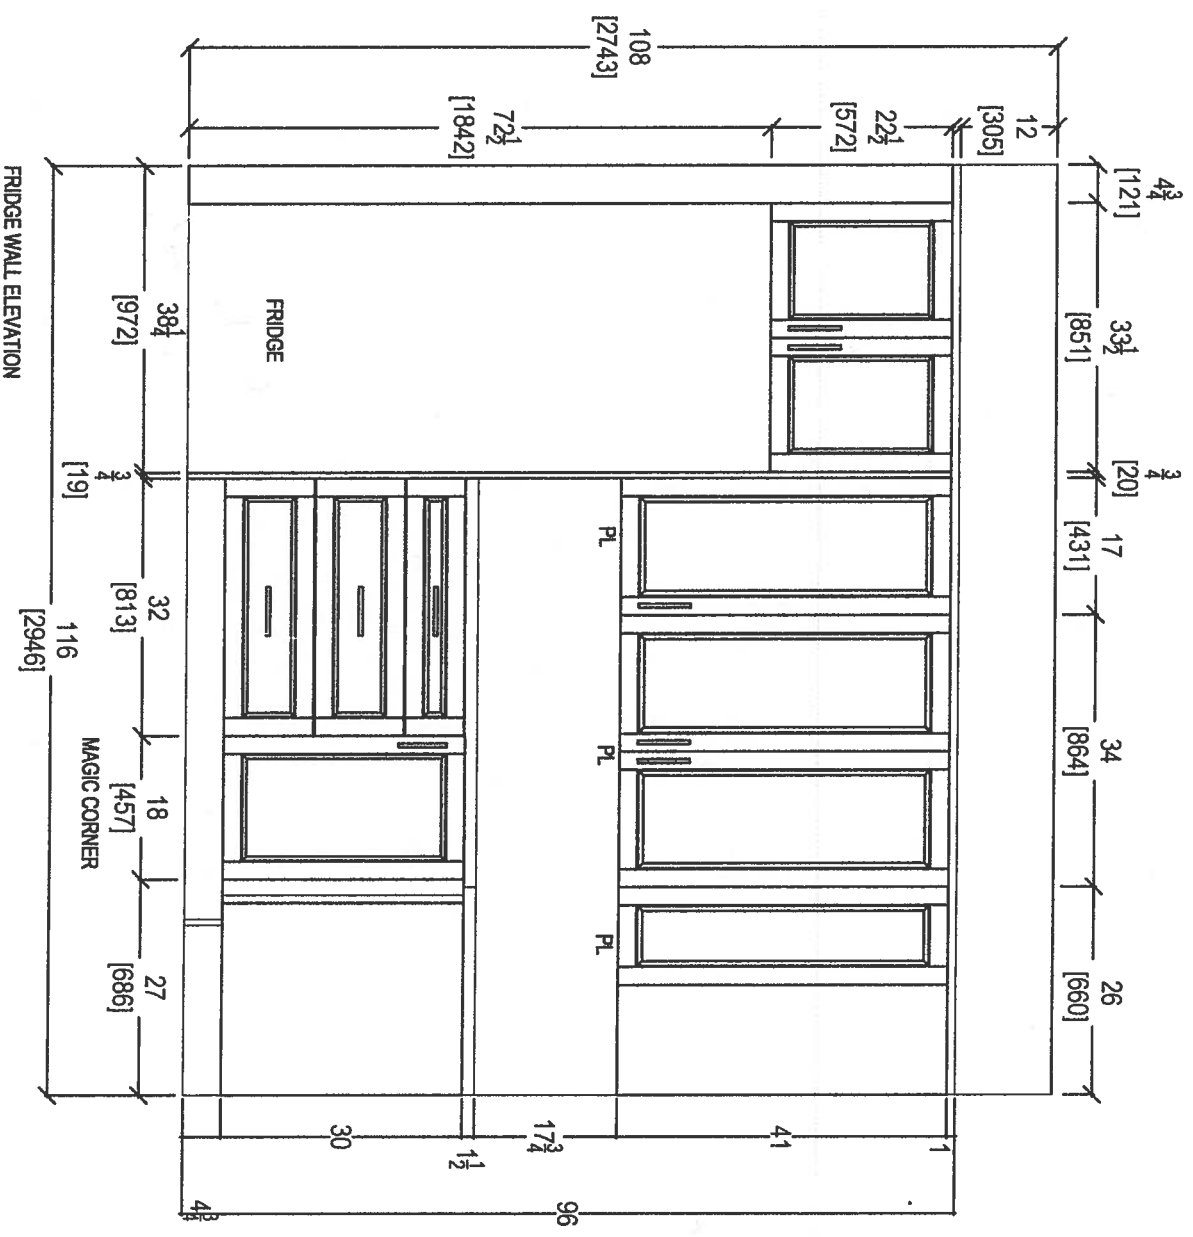

FRIDGE WALL ELEVATION


CLIENT: ROYAL PINE HOMES	UNIT 211 HMP	ROOM: KITCHEN	DRAWN BY: SK
SITE: HAMPTON PLACE	DOOR STYLE: —	DOOR HANDLE: —	SCALE: 1/2" = 1' - 0"
PHONE: —	FINISH: —	DRW HANDLE: —	DATE: APRIL 20, 2018
EMAIL: —	SPECIES: —	TOP: —	PAGE: —

COMMENTS:


PLEASE NOTE ALL DIMENSIONS
ARE NOT FINAL AND ARE
SUBJECT TO CHANGE UPON
FINAL SITE MEASURE



your kitchen, your style
80 SANTE DRIVE, VAUGHAN
T: 416.746.1811 F: 905.746.1811

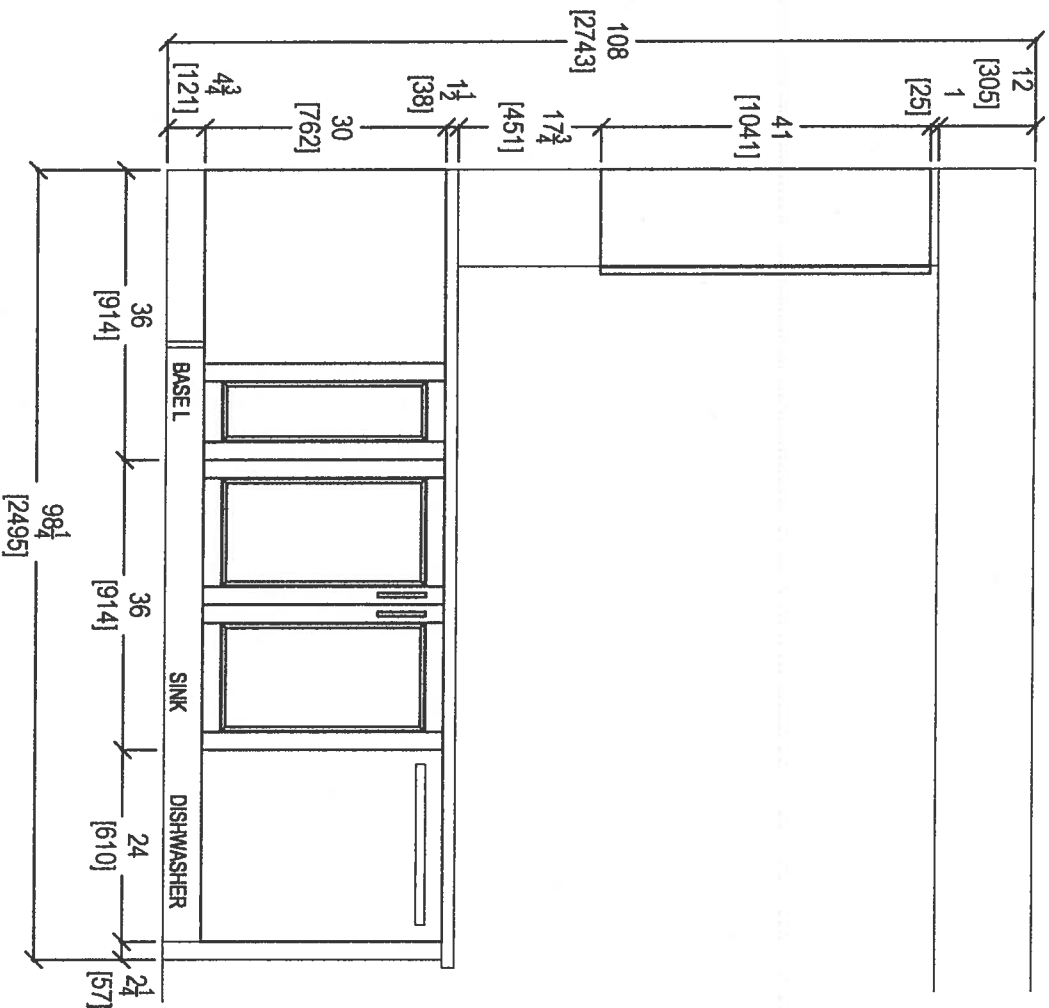

KITCHEN PENINSULA ELEVATION
FRONT VIEW

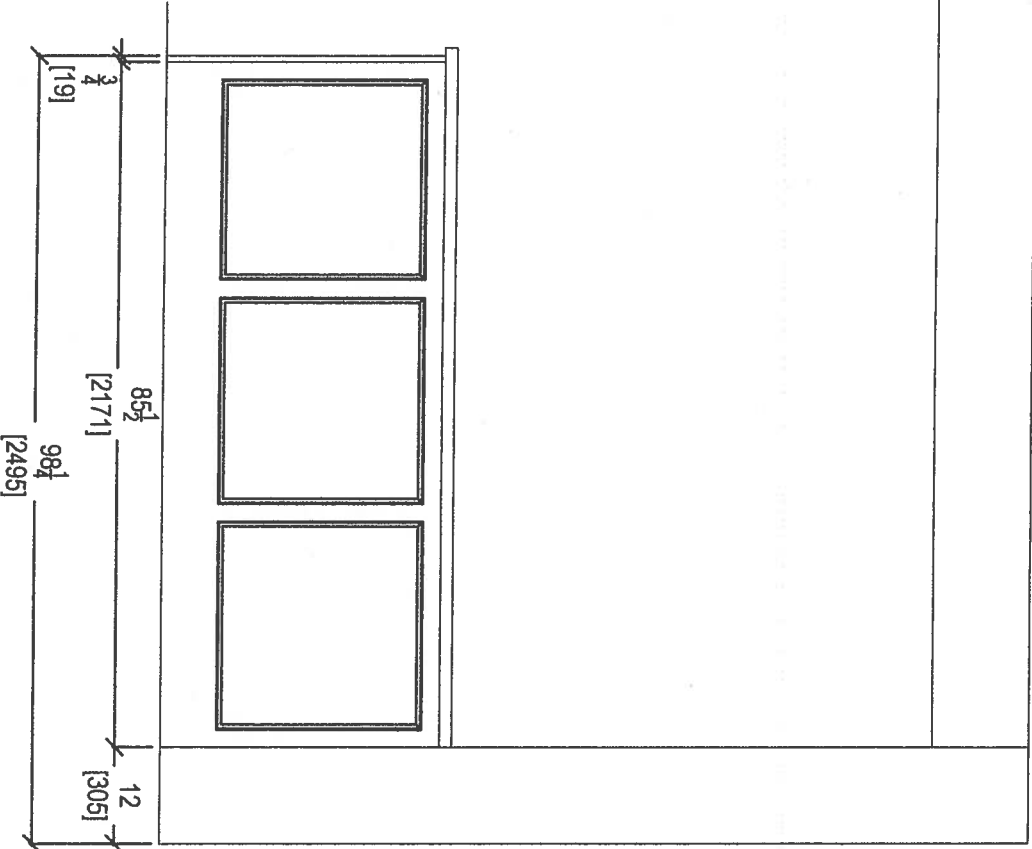

KITCHEN PENINSULA ELEVATION
REAR VIEW

CLIENT: ROYAL PINE HOMES	UNIT 211 HMP	ROOM: KITCHEN	DRAWN BY: SK
SITE: HAMPTON PLACE	DOOR STYLE: --	DOOR HANDLE: --	SCALE: 1/2" = 1' - 0"
PHONE: --	FINISH: --	DRW HANDLE: --	DATE: APRIL 20, 2018
EMAIL: --	SPECIES: --	TOP: --	PAGE: --


COMMENTS:

PLEASE NOTE ALL DIMENSIONS
ARE NOT FINAL AND ARE
SUBJECT TO CHANGE UPON
FINAL SITE MEASURE




your kitchen, your life.
80 SANTE DRIVE, VAUGHAN, ONTARIO
T: 416.746.1811 F: 905.746.1811



CA

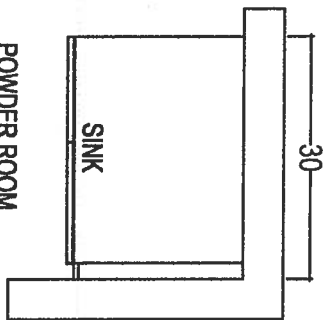

POWDER ROOM

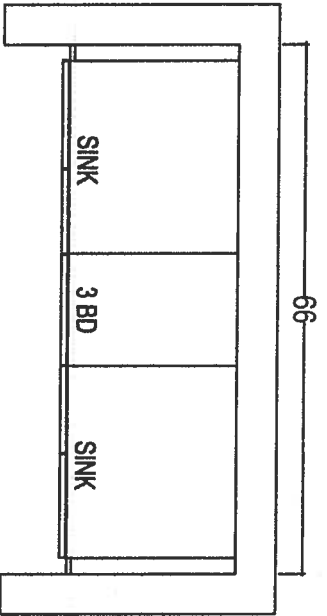

MASTER ENSUITE

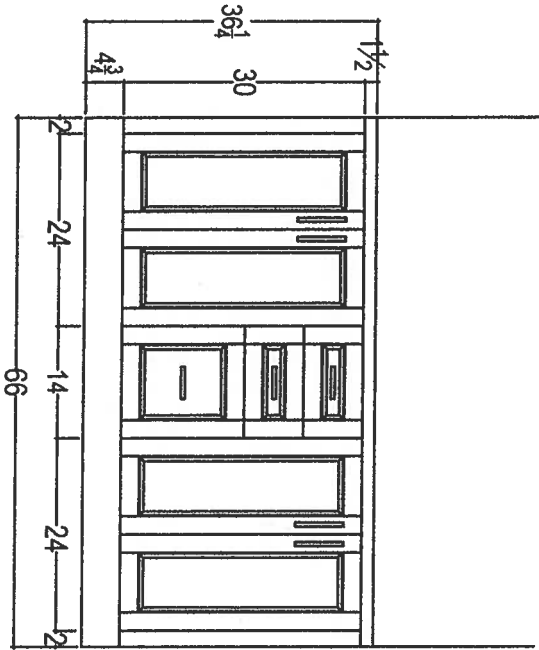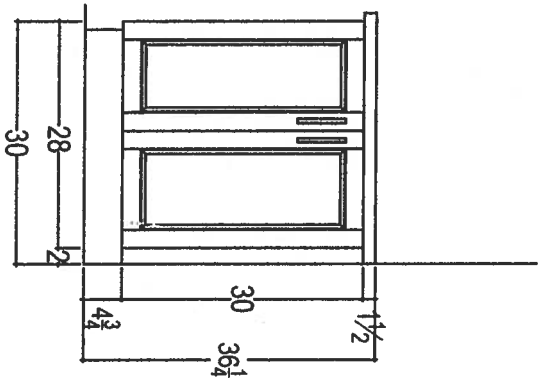

CLIENT: ROYAL PINE HOMES		UNIT 211 HMP		ROOM: VANITIES		DRAWN BY: SK	
SITE: HAMPTON PLACE		DOOR STYLE: —		DOOR HANDLE: —		SCALE: 1/2" = 1'-0"	
PHONE: —		FINISH: —		DRW HANDLE: —		DATE: APRIL 20, 2018	
EMAIL: —		SPECIES: —		TOP: —		PAGE: —	

COMMENTS:

PLEASE NOTE ALL DIMENSIONS
ARE NOT FINAL AND ARE
SUBJECT TO CHANGE UPON
FINAL SITE MEASURE



80 SANTE DRIVE, VAUGHAN,
T: 416.746.1811 F: 905.746.1811

69