




Glen Cove

ORIGINAL SUITE


218

1,162 SQ FT *plus* 168 sq. ft. of balcony area

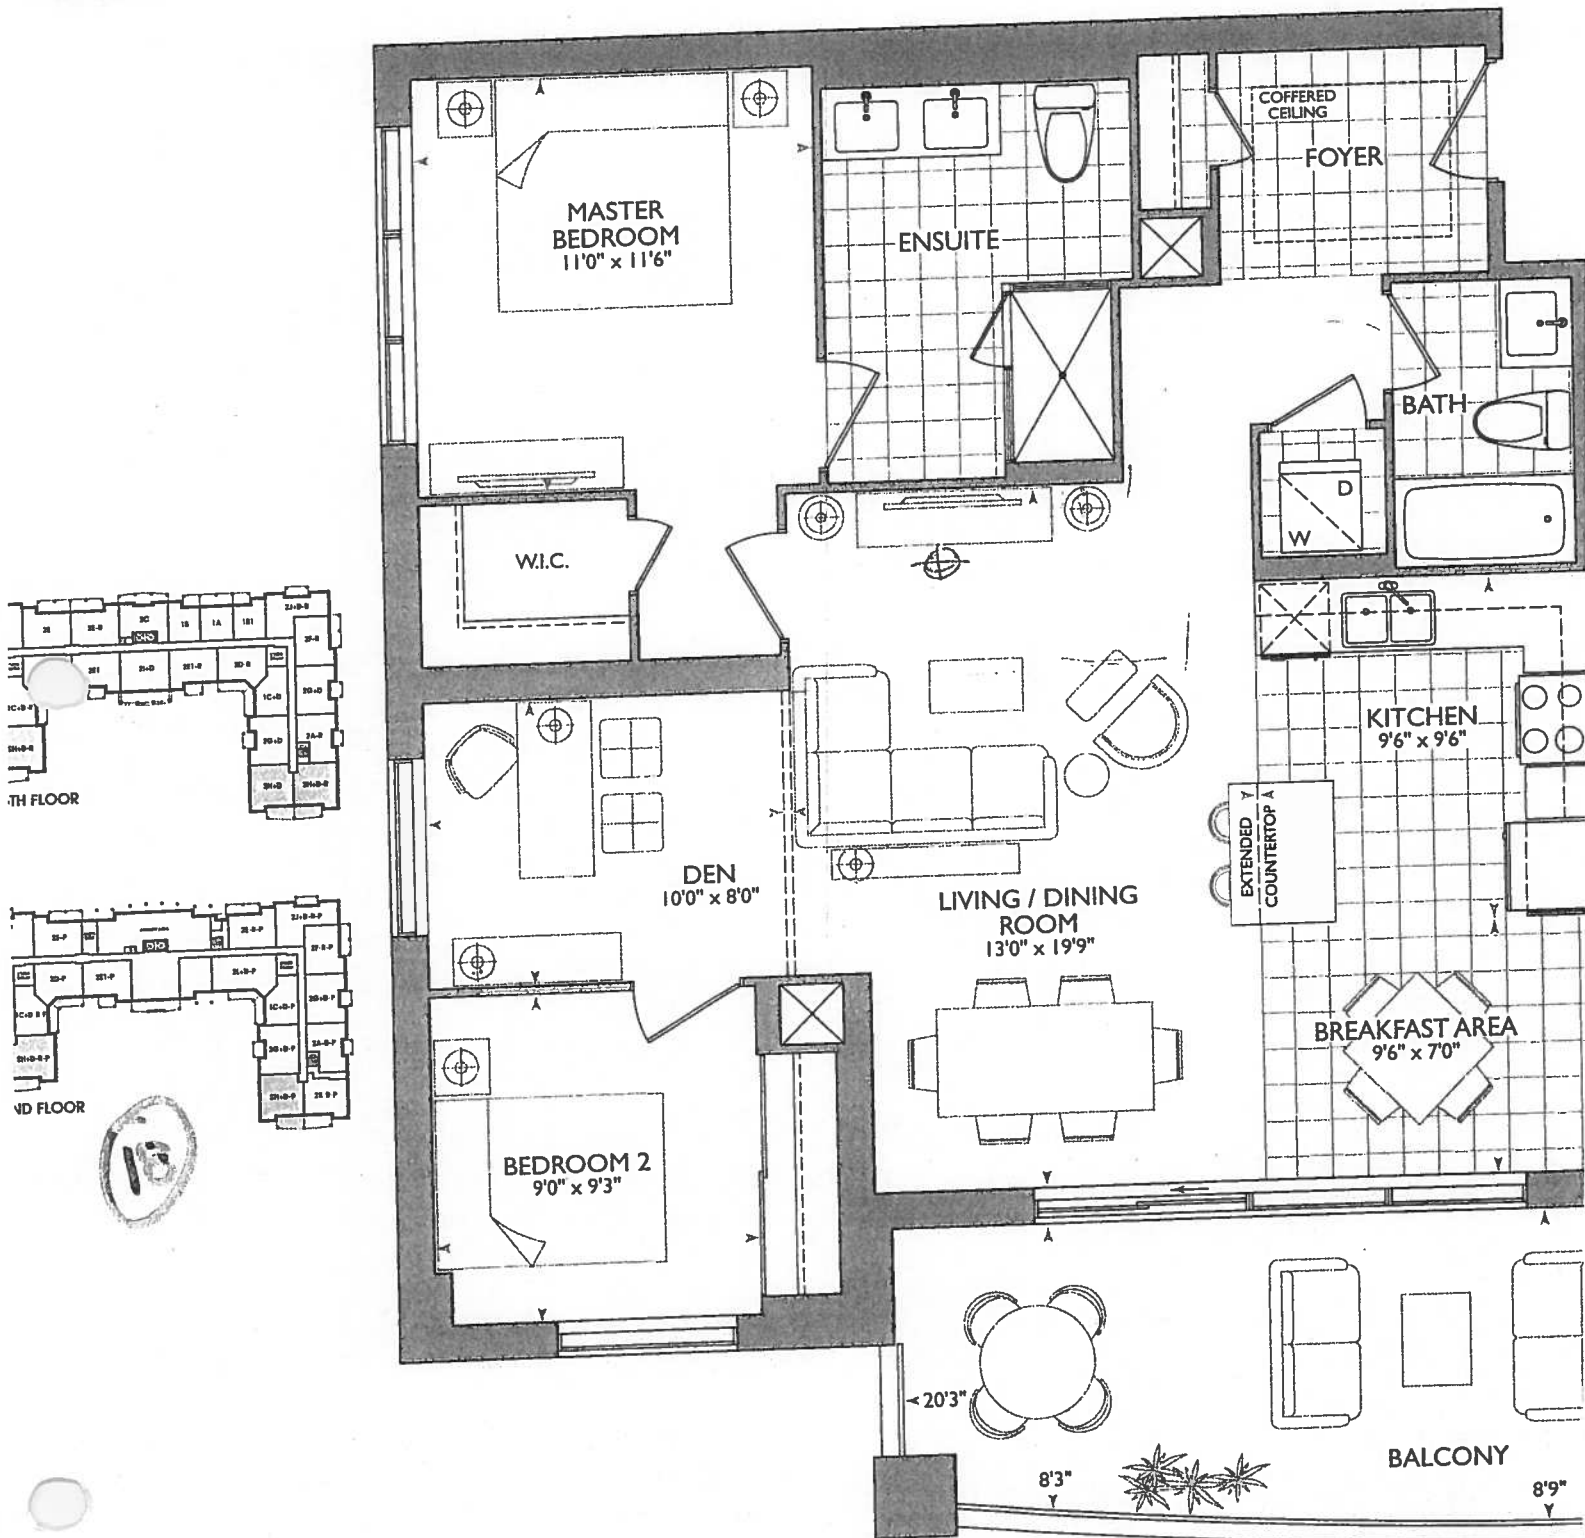

JAN 5 2018

- * BARRIER FREE SUITE
- * Delete Bathroom Mirrors + ACCESSORIES.

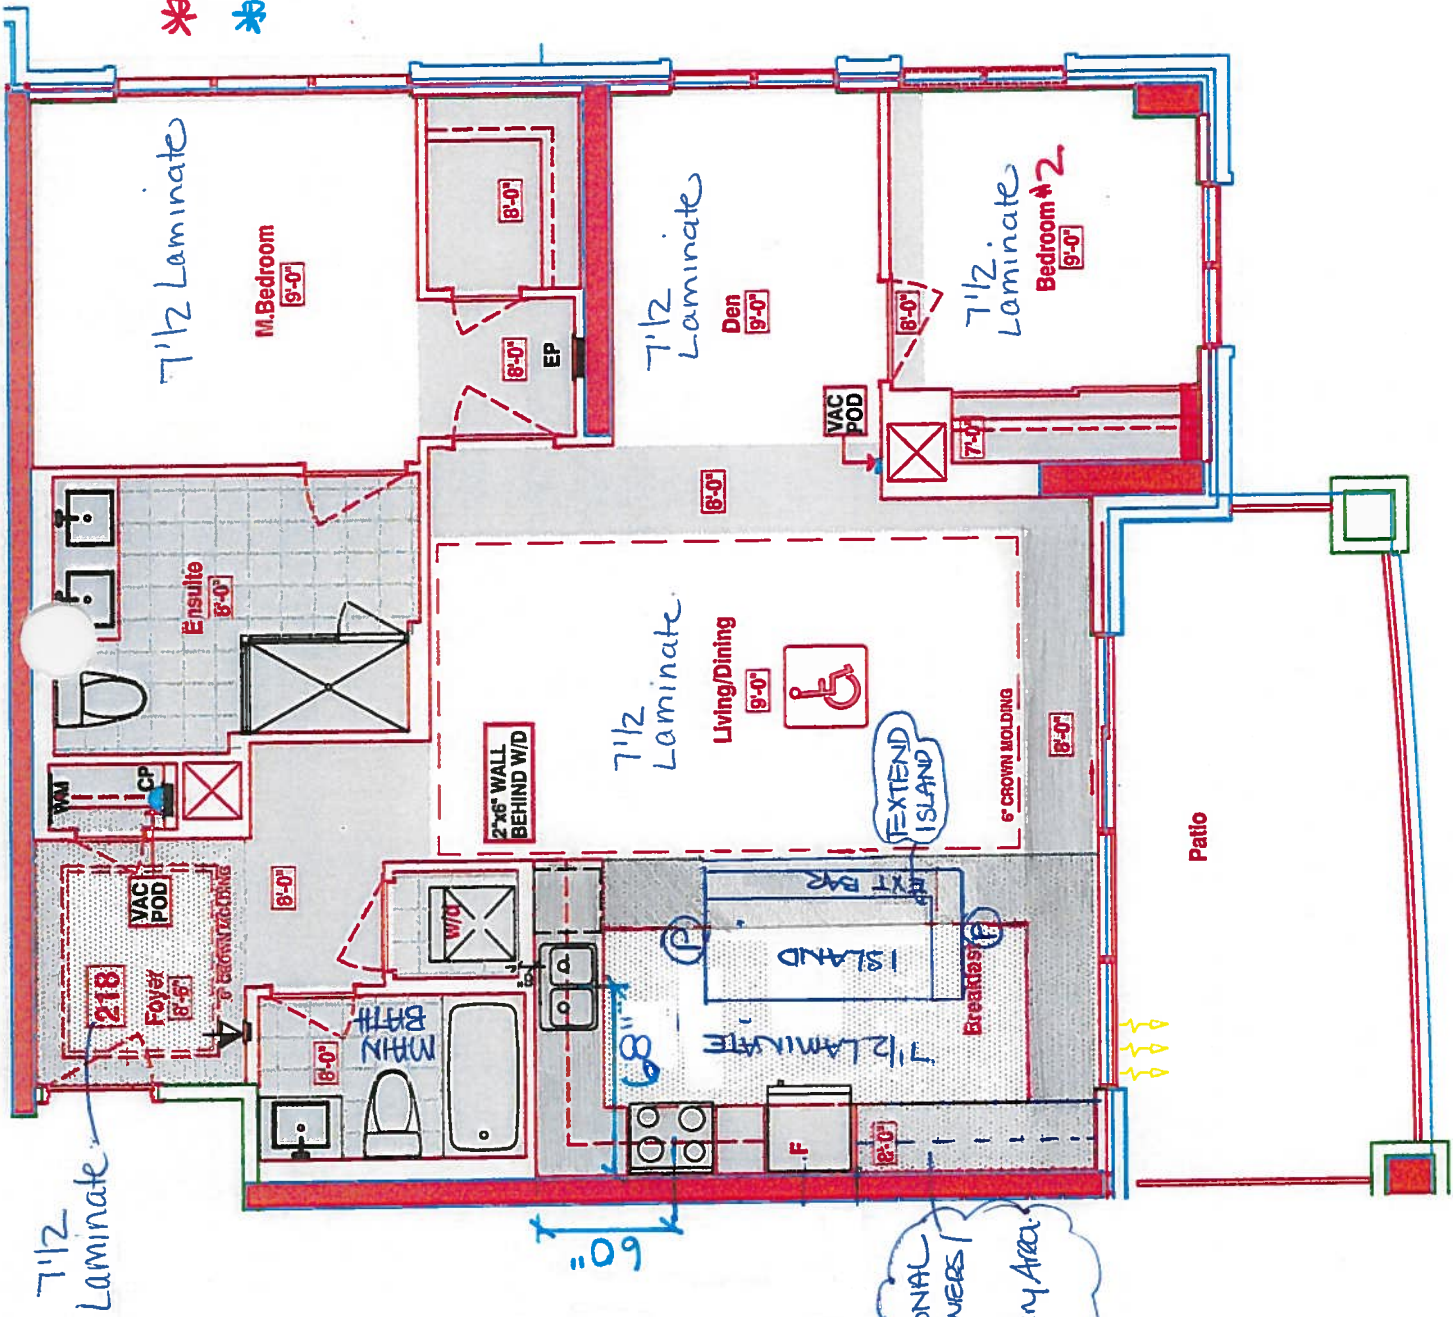

KITCHEN

- * P= Plugs IN ISLAND (x2)
- * KITCHEN ISLAND Extended & Shifted Towards Fridge wall
- * (68) FUCH LIGHTS
- * Appliance UPG #1-PACKAGE
- * STOVE PIPE Center 60"
- * SINK PIPE CENTER 68"
- * MAN & ENSUITE RAISED VANITIES 36 1/4" + 3" splash.
- * ADDITIONAL UPPER & LOWER COUNTRY NEW SERVICE AREA.

RECEIVED
JAN 5-18

SUITE 218- GLEN COVE

25 Baker Hill Blvd - Stouffville, ON Jan 04, 2018



* INTERIOR COLOUR SCHEME *

Purchaser	Decor Consultant	Model Type	Telephone Res. / Bus	Project	Closing Date	Unit
STELLA V. COSENTINO	Laura Di Pede	GLEN COVE	(905) 737-0582 /	Hampton Place	20/09/2018	218

Page 1 of 3

	Flooring		Wall Tile		Accent/Insert	Pattern
	Description		Main			
✓ MASTER ENSUITE	13X13 Rustic Grey (STD)	✓	8x10 Golf Grigio (STD)	N/A	N/A	N/A
✓ MAIN BATHROOM	13X13 Rustic Grey (STD)	✓	8x10 Golf Grigio (STD)	N/A	N/A	N/A
POWDER ROOM	N/A		N/A	N/A	N/A	N/A
✓ KITCHEN / DINETTE	7 1/2" Torlys Forest Okangan 9742-P (STD)	✓	Cloud Random Strip Glass Mosaic -UPGD	N/A	N/A	N/A
✓ FOYER	7 1/2" Torlys Forest Okangan 9742-P (STD)	✓	N/A	N/A	N/A	N/A
✓ LAUNDRY	8X8 Behram Pink (STD)	✓	N/A	N/A	N/A	N/A
LIVING ROOM	7 1/2" Torlys Forest Okangan 9742-P (STD)	✓				
✓ DINING ROOM	7 1/2" Torlys Forest Okangan 9742-P (STD)	✓				
✓ DEN	7 1/2" Torlys Forest Okangan 9742-P (STD)	✓				
✓ MASTER BEDROOM	7 1/2" Torlys Forest Okangan 9742-P (STD)	✓				
✓ BEDROOM 2	7 1/2" Torlys Forest Okangan 9742-P (STD)	✓				
✓ BEDROOM 3	N/A	✓				

Notes

SERVERY- Install upgraded backsplash in New Servery Area of Breakfast area -Cloud Random Strip Glass Mosaic -UPGD

Page 1 of 3

Consultant:  Purchaser:  Vendor: 

Hampton Place

Printed Jan 04, 2018 12:55 pm

Lot: 218 Project: Hampton Place Model: GLEN COVE



* INTERIOR COLOUR SCHEME *

Purchaser STELLA V. COSENTINO	Decor Consultant Laura Di Pede	Model Type GLEN COVE	Telephone Res. / Bus (905) 737-0582 /	Project Hampton Place	Closing Date 20/09/2018	Unit 218
---	--	--------------------------------	---	---------------------------------	-----------------------------------	--------------------

-CABINETRY, VANITIES AND COUNTERTOPS

	Style	Countertop	Counter Edge	Handle / Knob
MAIN BATHROOM	CATEGORY 2 Maple QT 2503 Pistachio - STD	☒ CaesarStone -Misty Carrara (UPG)	☒ "A" STD	B 603 SC
MASTER ENSUITE	CATEGORY 2 Maple QT 2503 Pistachio - STD	☒ CaesarStone -Misty Carrara (UPG)	☒ "A" STD	B 603 SC
POWDER ROOM	N/A	N/A	N/A	N/A
KITCHEN / DINETTE	CATEGORY 1 QT 1203 White, STD	☒ Aspen Terra White (STD)	☒ "I" UPG	3487 128
LAUNDRY ROOM	N/A	N/A	N/A	N/A

APPLIANCE PACKAGE

UPGRADE #1

Std 31in Opening

PLUMBING FIXTURES

KITCHEN	Sink Model	☒ STANDARD
	Sink Faucet	☒ STANDARD
TOILETS	Master Ensuite	☒ STANDARD
	Main Bathroom	☒ STANDARD
	Powder Room	N/A
VANITY FAUCETS	Master Ensuite	☒ STANDARD
	Main Bathroom	☒ STANDARD
	Powder Room	N/A
VANITY SINKS	Master Ensuite	☒ STANDARD
	Main Bathroom	☒ STANDARD
	Powder Room	N/A
SHOWER STALL / TUBS	Master Ensuite Shower Stall	☒ STANDARD
	Master Ensuite Tub	N/A
	Main Bathroom Tub	☒ STANDARD

Trim

Baseboard & Casing ☒ STANDARD

Interior Doors ☒ STANDARD

MISC. INSTALLATIONS

Ceramic Accessories (installed by Vendor) ☒ Yes ☒ No

Bathroom Mirrors (installed by Vendor) ☒ Yes ☒ No

Wire Shelving - Closet (installed by Vendor) ☒ Yes ☒ No

Cornice Moulding / Medallion

Foyer ☒ CTR 611 STANDARD

Living Room ☒ CTR 611 STANDARD

Dining Room ☒ CTR 611 STANDARD

Den N/A

Master Bedroom N/A

Bedroom 2 N/A

Bedroom 3 N/A

Fireplace

Fireplace N/A

Location Flooring N/A

Style N/A

Finish N/A

Marble N/A

Hearth N/A

Paint Throughout

Walls ☒ BIRCH WHITE

Trim ☒ WHITE

Decor Consultant:


Purchaser:

STELLA V. COSENTINO

Vendor:

Hampton Place

Printed Jan 04, 2018 12:55 pm

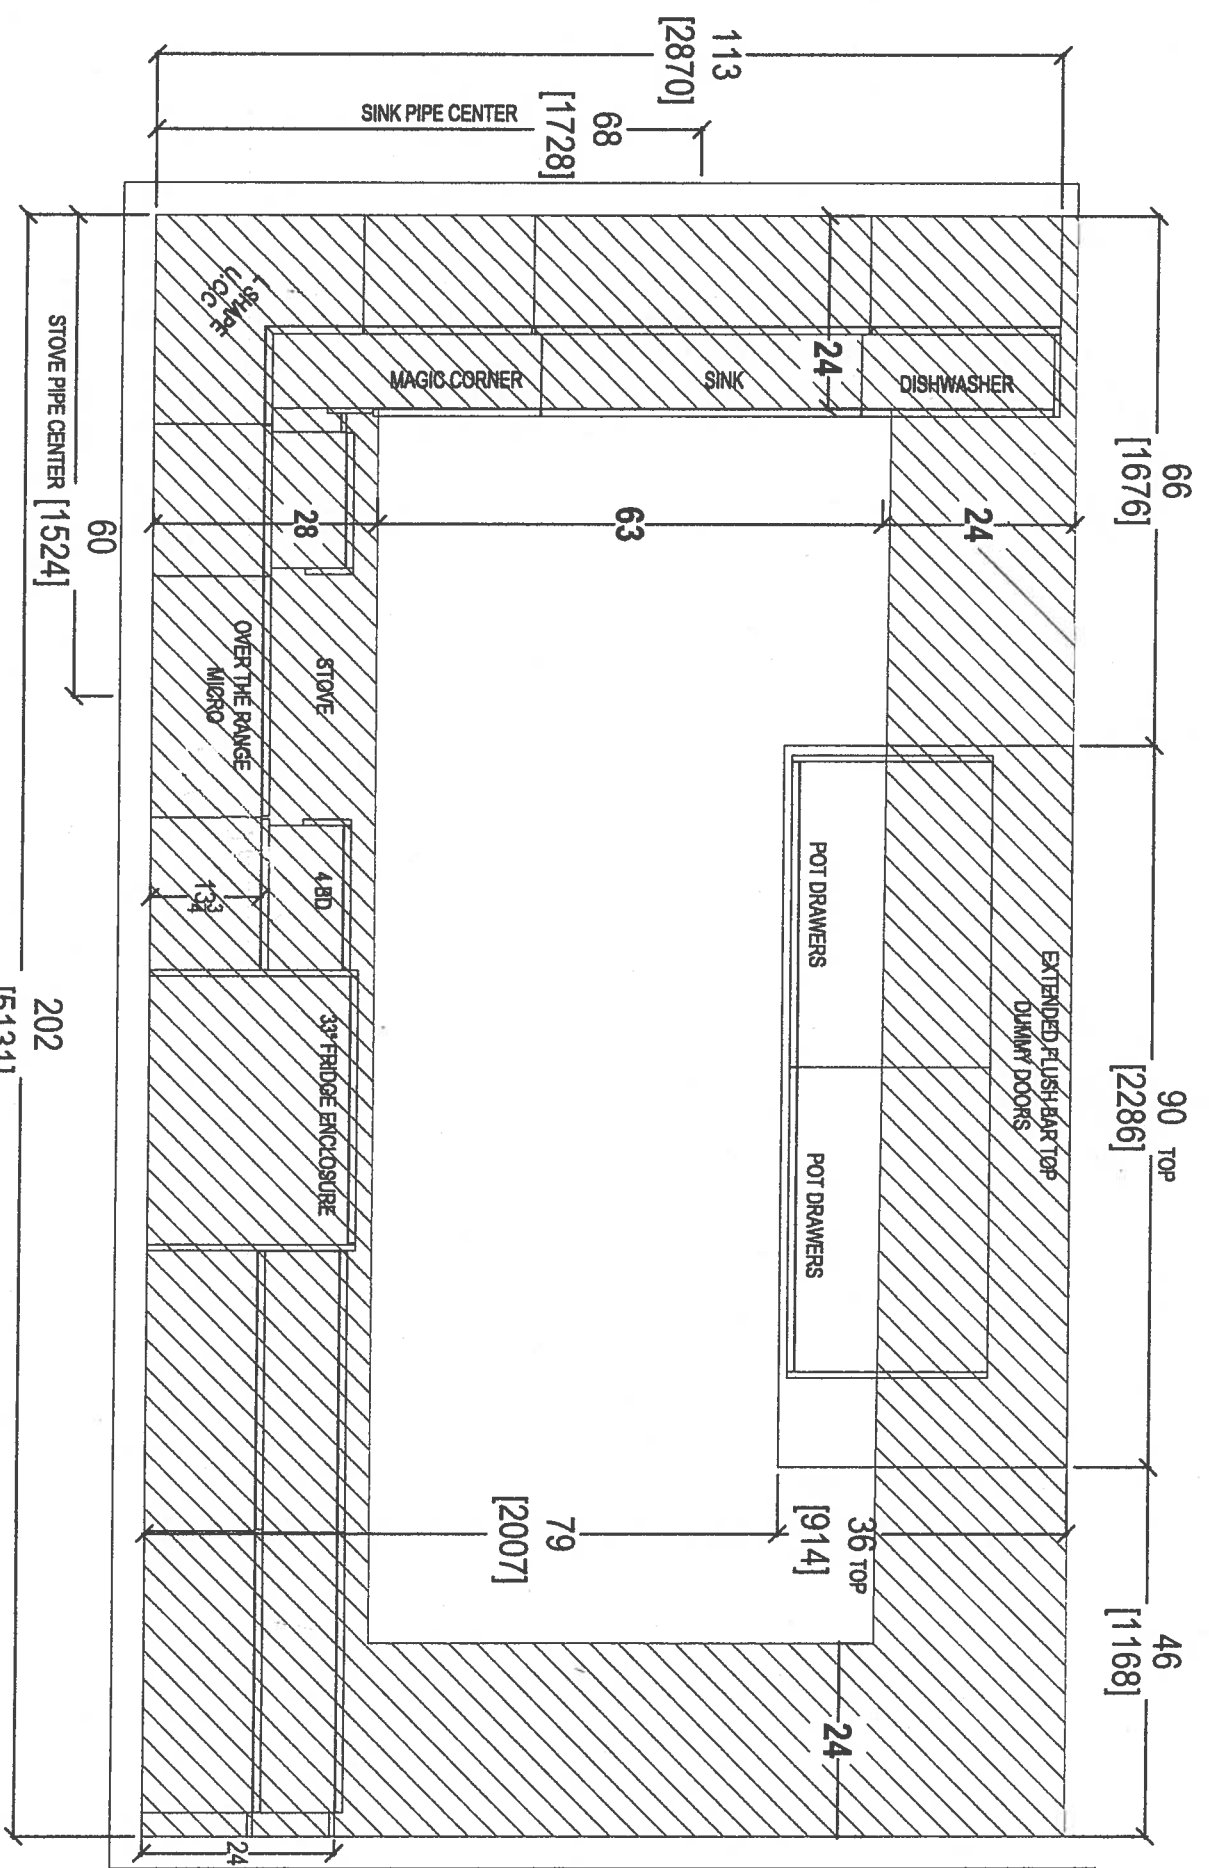

your kitchen, your taste.
80 SANTE DRIVE, VAUGHAN, ON L4K 3C4,
T: 416.746.1811 F: 905.746.5901

CLIENT: ROYAL PINE HOMES		UNIT 218 HMP (2H GLEN COVE)		ROOM: KITCHEN - BULKHEAD PLAN		DRAWN BY: SK		COMMENTS: PLEASE NOTE ALL DIMENSIONS ARE NOT FINAL AND ARE SUBJECT TO CHANGE UPON FINAL SITE MEASURE
SITE:	HAMPTON PLACE	DOOR STYLE:	—	DOOR HANDLE:	—	SCALE:	1/2" = 1' - 0"	
PHONE:	—	FINISH:	—	DRW HANDLE:	—	DATE:	APRIL 17, 2018	
EMAIL:	—	SPECIES:	—	TOP:	—	PAGE:	—	

64



COMMENTS:


10

PLEASE NOTE ALL DIMENSIONS ARE NOT FINAL AND ARE

**SUBJECT TO CHANGE
FINAL SITE MEASURE**

5901



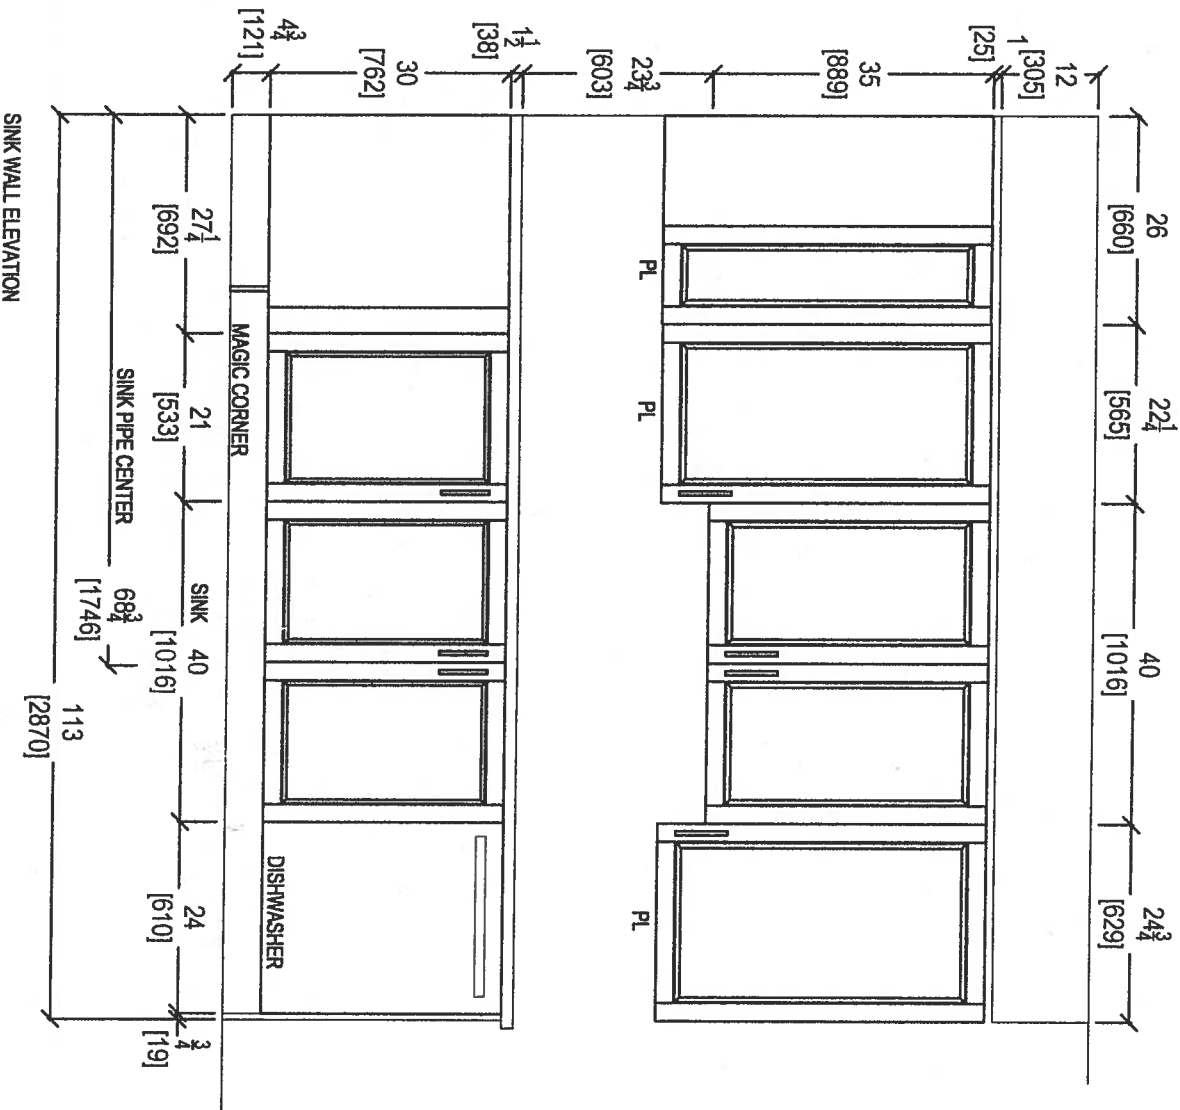

SINK WALL ELEVATION


CLIENT: ROYAL PINE HOMES	UNIT 218 HMP	ROOM: KITCHEN	DRAWN BY: SK
SITE: HAMPTON PLACE	DOOR STYLE: —	DOOR HANDLE: —	SCALE: 1/2" = 1' - 0"
PHONE: —	FINISH: —	DRW HANDLE: —	DATE: JAN 10, 2018
EMAIL: —	SPECIES: —	TOP: —	PAGE: —

COMMENTS:

PLEASE NOTE ALL DIMENSIONS
ARE NOT FINAL, AND ARE
SUBJECT TO CHANGE UPON
FINAL SITE MEASURE




your kitchen, your taste
80 SANTE DRIVE, VAUGHAN ON L4K 3C4,
T: 416.746.1811 F: 905.746.1801

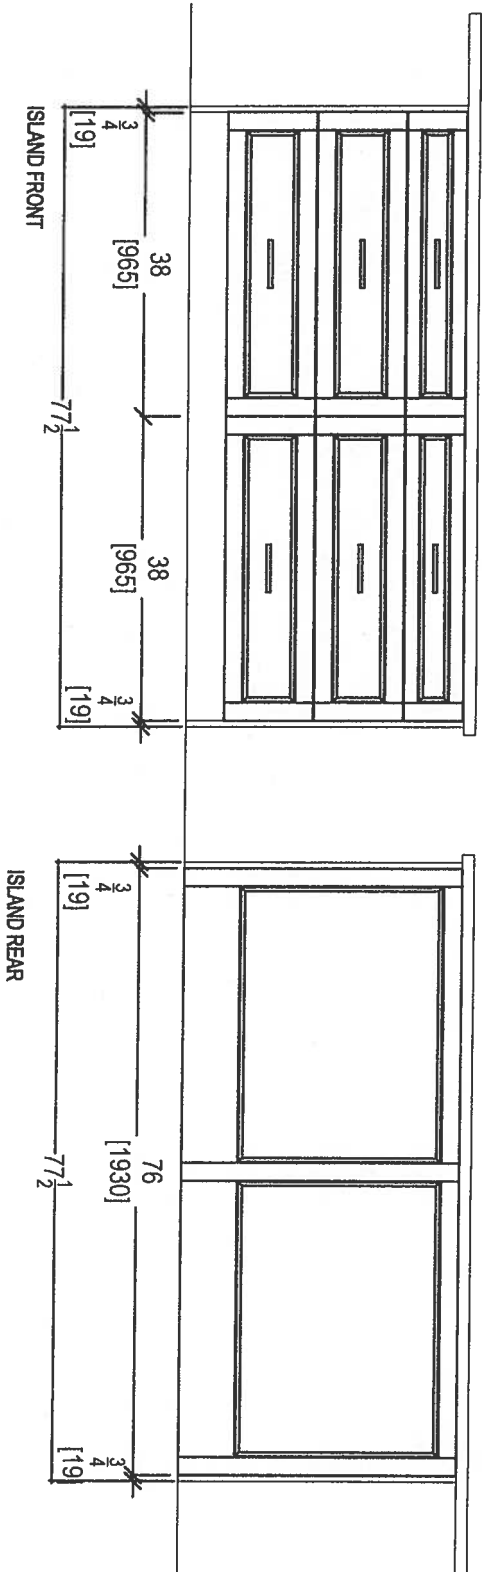


80 SANTE DRIVE, VAUGHAN, ON L4K 3C4,
T: 416.746.1811 F: 416.746.1811



CLIENT: ROYAL PINE HOMES	UNIT 218 HMP	ROOM: KITCHEN	DRAWN BY: SK	COMMENTS: PLEASE NOTE ALL DIMENSIONS ARE NOT FINAL AND ARE SUBJECT TO CHANGE UPON FINAL SITE MEASURE
SITE: HAMPTON PLACE	DOOR STYLE: —	DOOR HANDLE: —	SCALE: 1/2" = 1' - 0"	
PHONE: —	FINISH: —	DRW HANDLE: —	DATE: JAN 10, 2018	
EMAIL: —	SPECIES: —	TOP: —	PAGE: —	
Cy				

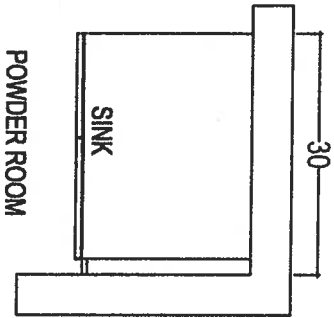

POWDER ROOM

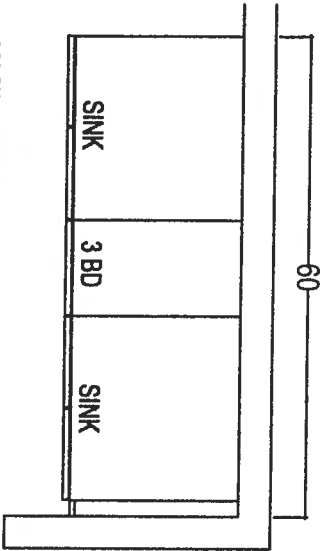

MASTER ENSUITE

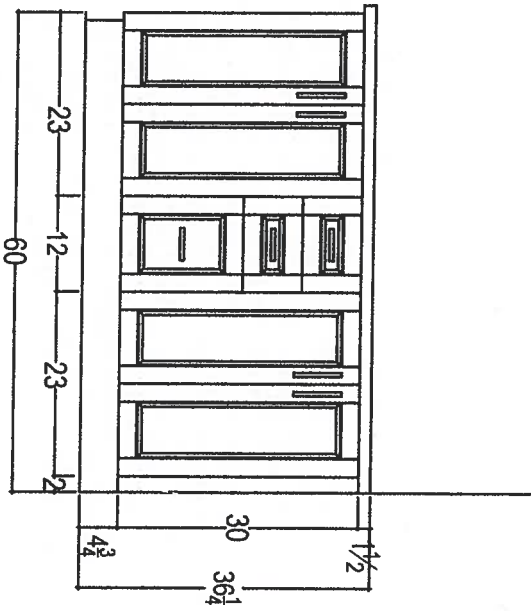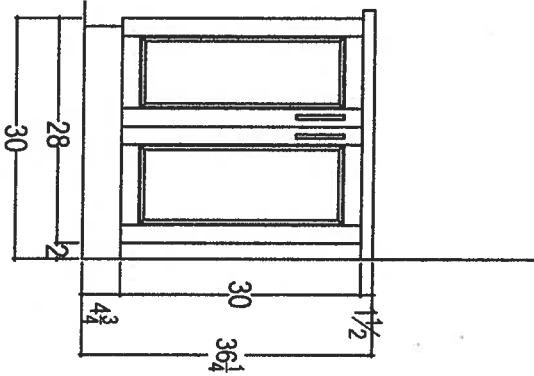

* Raised Vanities + 3" Splash *

CLIENT: ROYAL PINE HOMES

UNIT 218 HMP

ROOM: VANITIES

DRAWN BY: SK

COMMENTS:

SITE: HAMPTON PLACE

DOOR STYLE: —

DOOR HANDLE: —

SCALE: 1/2" = 1'-0"

PLEASE NOTE ALL DIMENSIONS ARE NOT FINAL AND ARE SUBJECT TO CHANGE UPON FINAL SITE MEASURE

PHONE: —

FINISH: —

DRW HANDLE: —

DATE: APRIL 20, 2018

EMAIL: —

SPECIES: —

TOP: —

PAGE: —

GTH

Your kitchen, your taste.
80 SANTE DRIVE, VAUGHAN, ON L4K 3C4,
T: 416.746.1811 F: 416.746.1801

Suite 218 HAMPTON

Upgrade Package I


A/C

WRB322DMBM

Whirlpool®

36 inches wide Bottom-Freezer Refrigerator with
SpillGuard™ Glass Shelves - 22 cu. ft

<http://www.whirlpool.com>

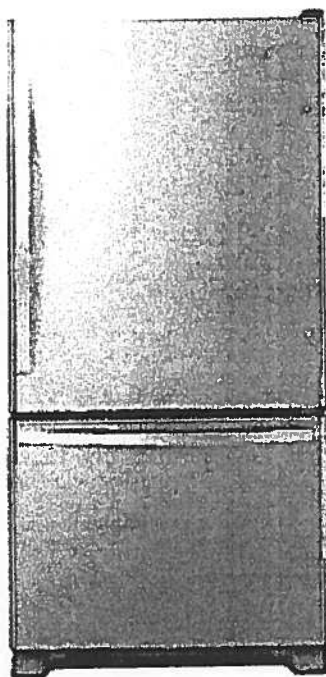

Key Features:

- SpillGuard™ Glass Shelves
- Adaptive Defrost / *Factory Installed Icemaker*
- FreshFlow™ Produce Preserver
- LED Interior Lighting
- ENERGY STAR® Qualified

Product Dimensions:

Height: 70

Width: 32 5/8

Depth: 33 3/8

Electrical Requirements:

15

Additional Information:

[Use And Care Guide](#)

[Dimension Guide](#)

[Energy Guide](#)

[Warranty Certificate](#)

INVESTED
IN
AMERICA



©Registered trademark/TM Trademark of Whirlpool, U.S.A. © 2016 Whirlpool Corporation. All Rights Reserved.
All other trademarks are owned by their respective companies.
Because Whirlpool Corporation policy includes a continuous commitment to improve our products, we reserve the right to change materials and specifications without notice. We also reserve the right to discontinue or transition products without notice.
Manufacturer's Suggested Retail Price (MSRP) and Minimum Advertised Price (MAP) provided for reference purposes only. Dealer alone determines advertised and retail prices.
Created On: Tuesday, March 14, 2017 11:30:08

WEE745H0FS


Upgrade
Package I

DE

Whirlpool®

<http://www.whirlpool.com>

6.4 Cu. Ft. Slide-In Electric Range with True
Convection

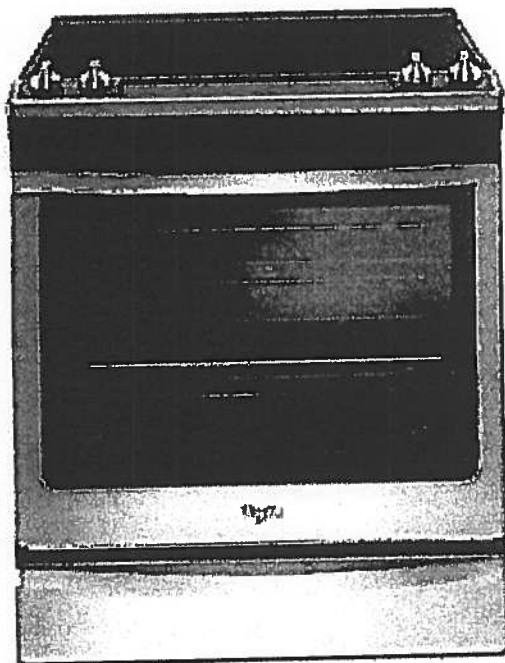

Key Features:

- Frozen Bake™ Technology
- True Convection Cooking
- FlexHeat™ Triple Radiant Element
- Convection Conversion
- AquaLift® Self-Cleaning Technology
- Temperature Sensor
- Rapid Preheat
- 6.4 Cu. Ft. Capacity
- Easy-Wipe Ceramic Glass Cooktop
- Large Oven Window
- Max Capacity Rack
- Hidden Bake Element

Product Dimensions:

Height: 36

Width: 29 7/8

Additional Information:

[Use And Care Guide](#)

[Dimension Guide](#)

[Installation Guide](#)

[Warranty Certificate](#)

INVESTED
IN
AMERICA



©Registered trademark/TM Trademark of Whirlpool, U.S.A. © 2016 Whirlpool Corporation. All Rights Reserved.
All other trademarks are owned by their respective companies.
Because Whirlpool Corporation policy includes a continuous commitment to improve our products, we reserve the right to change materials and specifications without notice. We also reserve the right to discontinue or transition products without notice.
Manufacturer's Suggested Retail Price (MSRP) and Minimum Advertised Price (MAP) provided for reference purposes only. Dealer alone determines advertised and retail prices.
Created On: Friday, January 27, 2017 10:46:47

Upgrade Package 1

Handwritten initials

YWMH76719CS



<http://www.whirlpool.com>

1.9 cu. ft. Microwave Hood Combination with
TimeSaver™ Plus True Convection

Key Features:

- TimeSaver™ Plus True Convection Cooking System
- Steam Cooking
- Sensor Cooking
- AccuPop™ Cycle
- CleanRelease® Non-Stick Interior
- SteamClean Option
- Integrated Hidden Vent and Console
- Auto Adapt Fan
- Recessed, Stoppable Glass Turntable
- Universal Microwave Steamer
- 1.9 cu. ft. Capacity
- 1,100 Watts Cooking Power

Product Dimensions:

Height: 17 1/8

Width: 29 15/16

Depth: 18 1/2

Electrical Requirements:

15 or 20. 120 V.

Additional Information:


[Use And Care Guide](#)

[Installation Guide](#)

[Warranty Certificate](#)

Available in:

● Stainless Steel

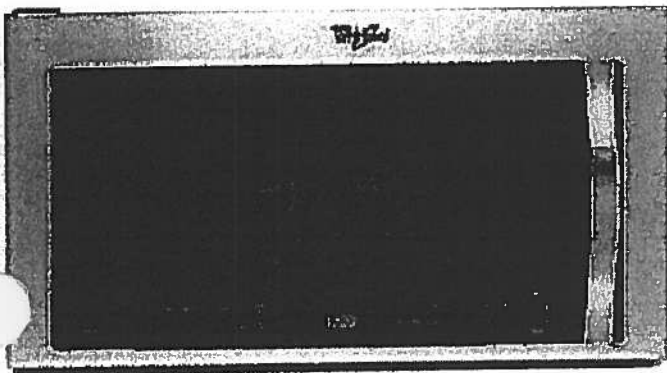

©Registered trademark/TM Trademark of Whirlpool, U S A. © 2013 Whirlpool Corporation. All Rights Reserved.
All other trademarks are owned by their respective companies.
Because Whirlpool Corporation policy includes a continuous commitment to improve our products, we reserve the right to change materials and specifications without notice. We also reserve the right to discontinue or transition products without notice.
Manufacturer's Suggested Retail Price (MSRP) and Minimum Advertised Price (MAP) provided for reference purposes only. Dealer alone determines advertised and retail prices.
Created On: Monday, March 14, 2016 13:16:48

Upgrade Package 1

WDTA50SAHZ

A.C.

Whirlpool®

<http://www.whirlpool.com>

Contemporary Design. Stainless Steel Tub
Dishwasher with TotalCoverage Spray Arm

Key Features:

- Sensor Cycle
- TotalCoverage Spray Arm
- 1-Hour Wash Cycle
- Tap Touch Controls

Product Dimensions:

Height: 34 1/2

Width: 23 7/8

Depth: 24 1/2

Additional Information:


[Use And Care](#)

[Dimension Guide](#)

[Installation Guide](#)

[Energy Guide](#)

[Warranty](#)

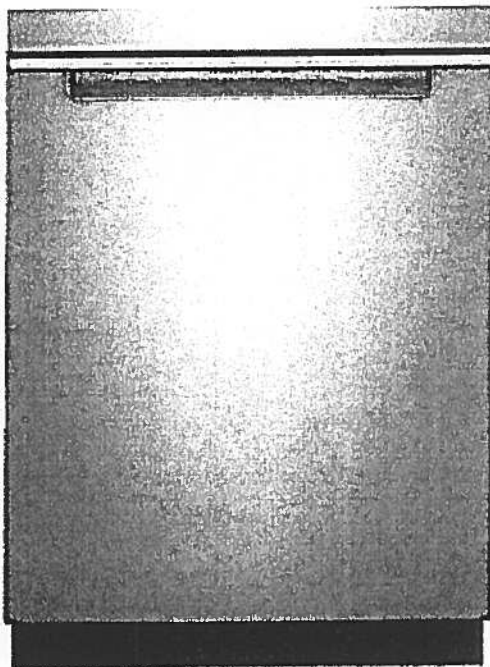

Available in:

● Black

Fingerprint Resistant Sunset Bronze

Fingerprint Resistant Black Stainless

○ White

Fingerprint Resistant Stainless Steel

INVESTED
IN
AMERICA



©Registered trademark/TM Trademark of Whirlpool, U.S.A. © 2016 Whirlpool Corporation. All Rights Reserved. All other trademarks are owned by their respective companies.

Because Whirlpool Corporation policy includes a continuous commitment to improve our products, we reserve the right to change materials and specifications without notice. We also reserve the right to discontinue or transition products without notice.

Manufacturer's Suggested Retail Price (MSRP) and Minimum Advertised Price (MAP) provided for reference purposes only. Dealer alone determines advertised and retail prices.

Upgrade Package 1




WFW75HEFW



<http://www.whirlpool.com>

4.5 cu. ft. Front Load Washer with Precision
Dispense

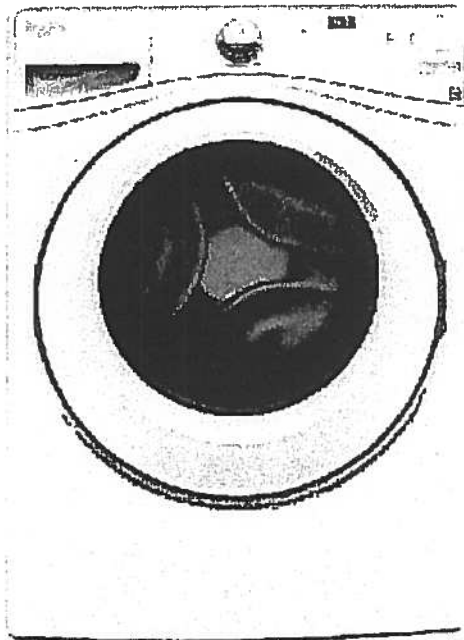

Key Features:

- Precision Dispense
- Adaptive Wash Technology
- Smooth Wave Stainless Steel Wash Basket
- 4.5 cu. ft. Capacity
- ENERGY STAR® Qualified

Product Dimensions:

Height: 39 3/4

Width: 27

Depth: 33 5/16

Electrical Requirements:

15 or 20. 120 V.

Additional Information:

[Use And Care Guide](#)

[Dimension Guide](#)

[Installation Guide](#)

[Energy Guide](#)

[Warranty Certificate](#)

INVESTED
IN
AMERICA



©Registered trademark/TM Trademark of Whirlpool, U S A. ©2013 Whirlpool Corporation All Rights Reserved.
All other trademarks are owned by their respective companies.
Because Whirlpool Corporation policy includes a continuous commitment to improve our products, we reserve the right to change materials and specifications without notice. We also reserve the right to discontinue or transition products without notice.
Manufacturer's Suggested Retail Price (MSRP) and Minimum Advertised Price (MAP) provided for reference purposes only. Dealer alone determines advertised and retail prices.
Created On: Wednesday, March 23, 2016 11:51:03

Upgrade Package 1

S.D.C.

YWED75HEFW

Whirlpool®

8.5 cu. ft. Duet® High Efficiency Front Load Electric
Washer with ENERGY STAR®

<http://www.whirlpool.com>

MSRP: \$0.00

Key Features:

- Advanced Moisture Sensing System
- Quad Baffles
- Tap Touch Controls with Memory
- EcoBoost™ Option
- Wrinkle Shield™ Plus Option
- Undercounter Installation
- 7.4 Cu. Ft. Capacity
- ENERGY STAR® Qualified

Product Dimensions:

Height: 39

Width: 27


Depth: 31

Additional Information:

[Use And Care](#)

[Installation Guide](#)

[Warranty](#)

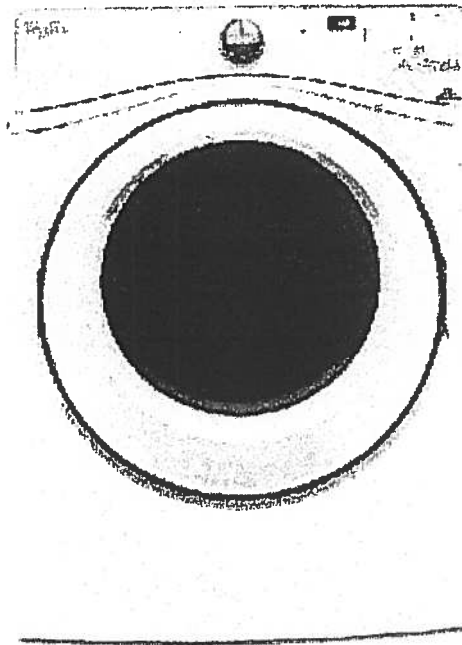

Available in:

☐ White

INVESTED
IN
AMERICA

ADA
Compliant

®Registered trademark/TM Trademark of Whirlpool, U.S.A. © 2016 Whirlpool Corporation. All Rights Reserved. All other trademarks are owned by their respective companies.

Because Whirlpool Corporation policy includes a continuous commitment to improve our products, we reserve the right to change materials and specifications without notice. We also reserve the right to discontinue or transition products without notice.

Manufacturer's Suggested Retail Price (MSRP) and Minimum Advertised Price (MAP) provided for reference purposes only. Dealer alone determines advertised and retail prices.

Countertop Edges

* SUITE 218 HAMPTON *

CONNOLLY Marble & Granite Ltd.

EDGE
DETAILS

004

A.




STRAIGHT EDGE
(STANDARD - 3/4")

* MASTER ENSUITE *

* MAIN BATH *

I.

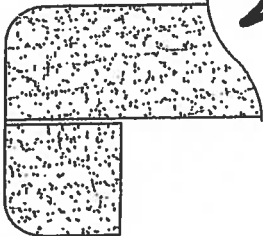


DOUBLE TOP "D" EDGE
(STANDARD - 1 1/2")

* KITCHEN *

JAN 4 2018

Dec.

M.

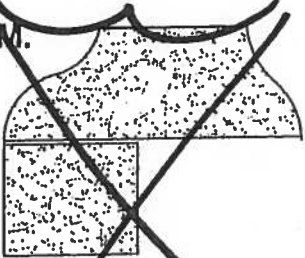

OGEE - SQUARE EDGE
(MED./HIGH - 1 1/2")

EDGING UP-GRADE OPTIONS