


Suite 301/302
ORIGINAL LAYOUT.

Inventory Suite

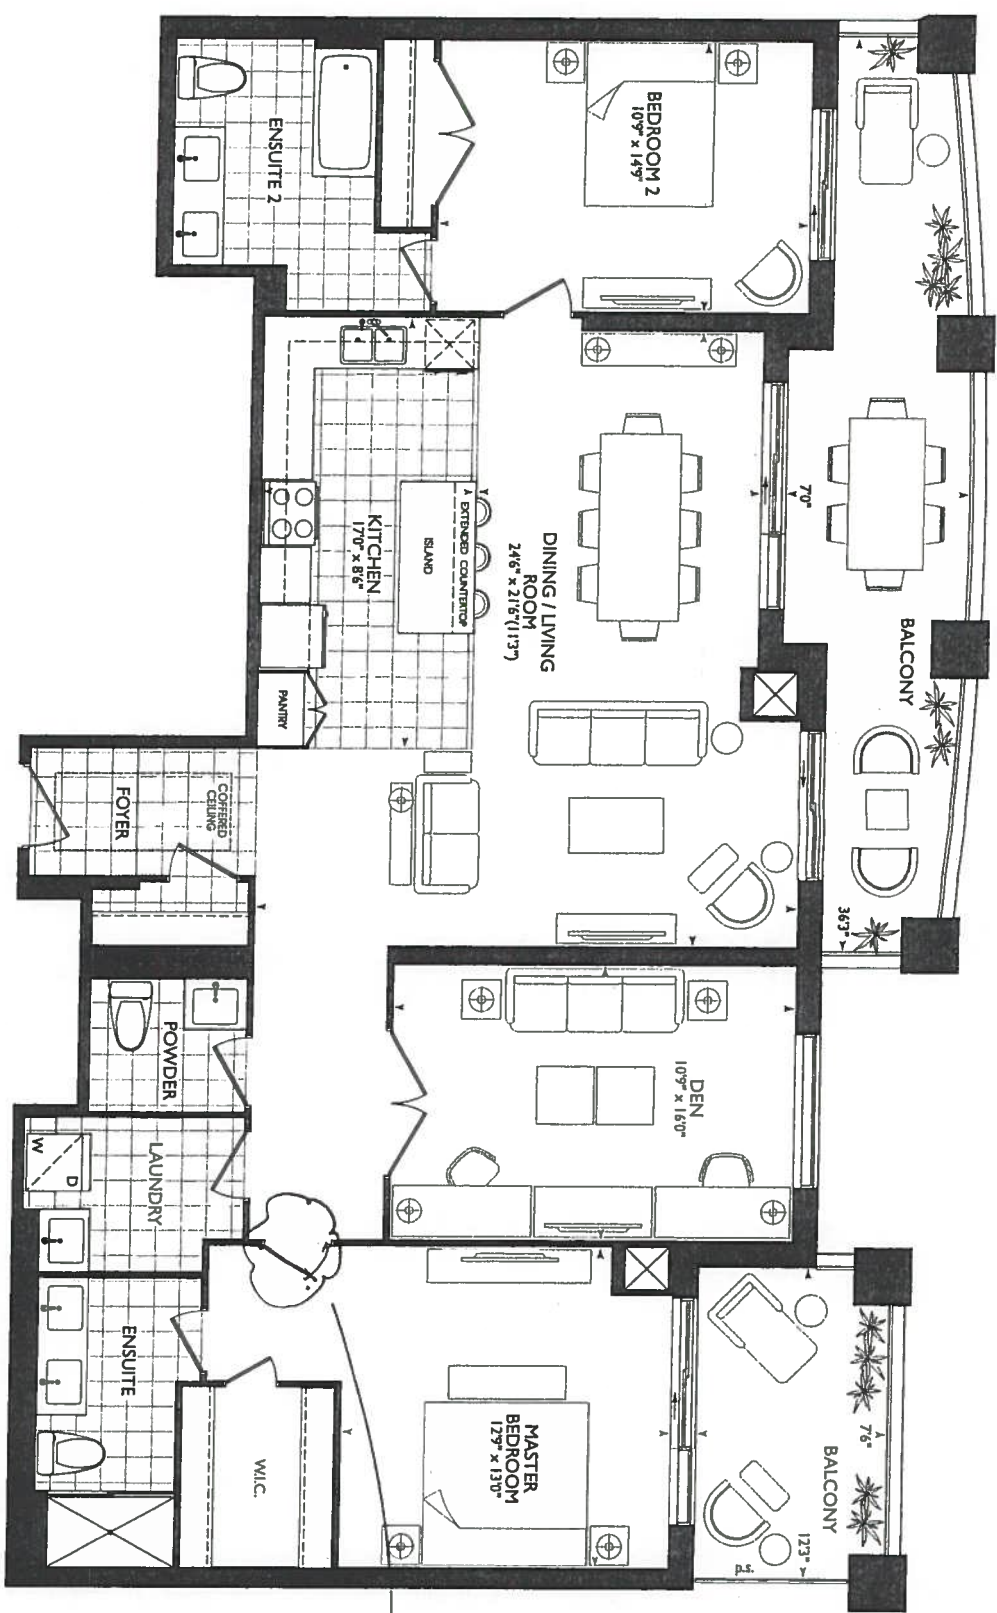


CHANGE SWING.

2B+D
1,645 SQ.FT.

LONG ISLAND
301/302

KITCHEN.

- OPT. OF STD OR 1ST UPGRADE KITCHEN CABINETS
- OPT OF STD OR 1ST UPG APPLIANCE PKG.
- (P) = 2x PLUGS ISLAND
- 5x: PUCK LIGHTS (STD)
- 6x: PUCK LIGHTS 1ST UPG.

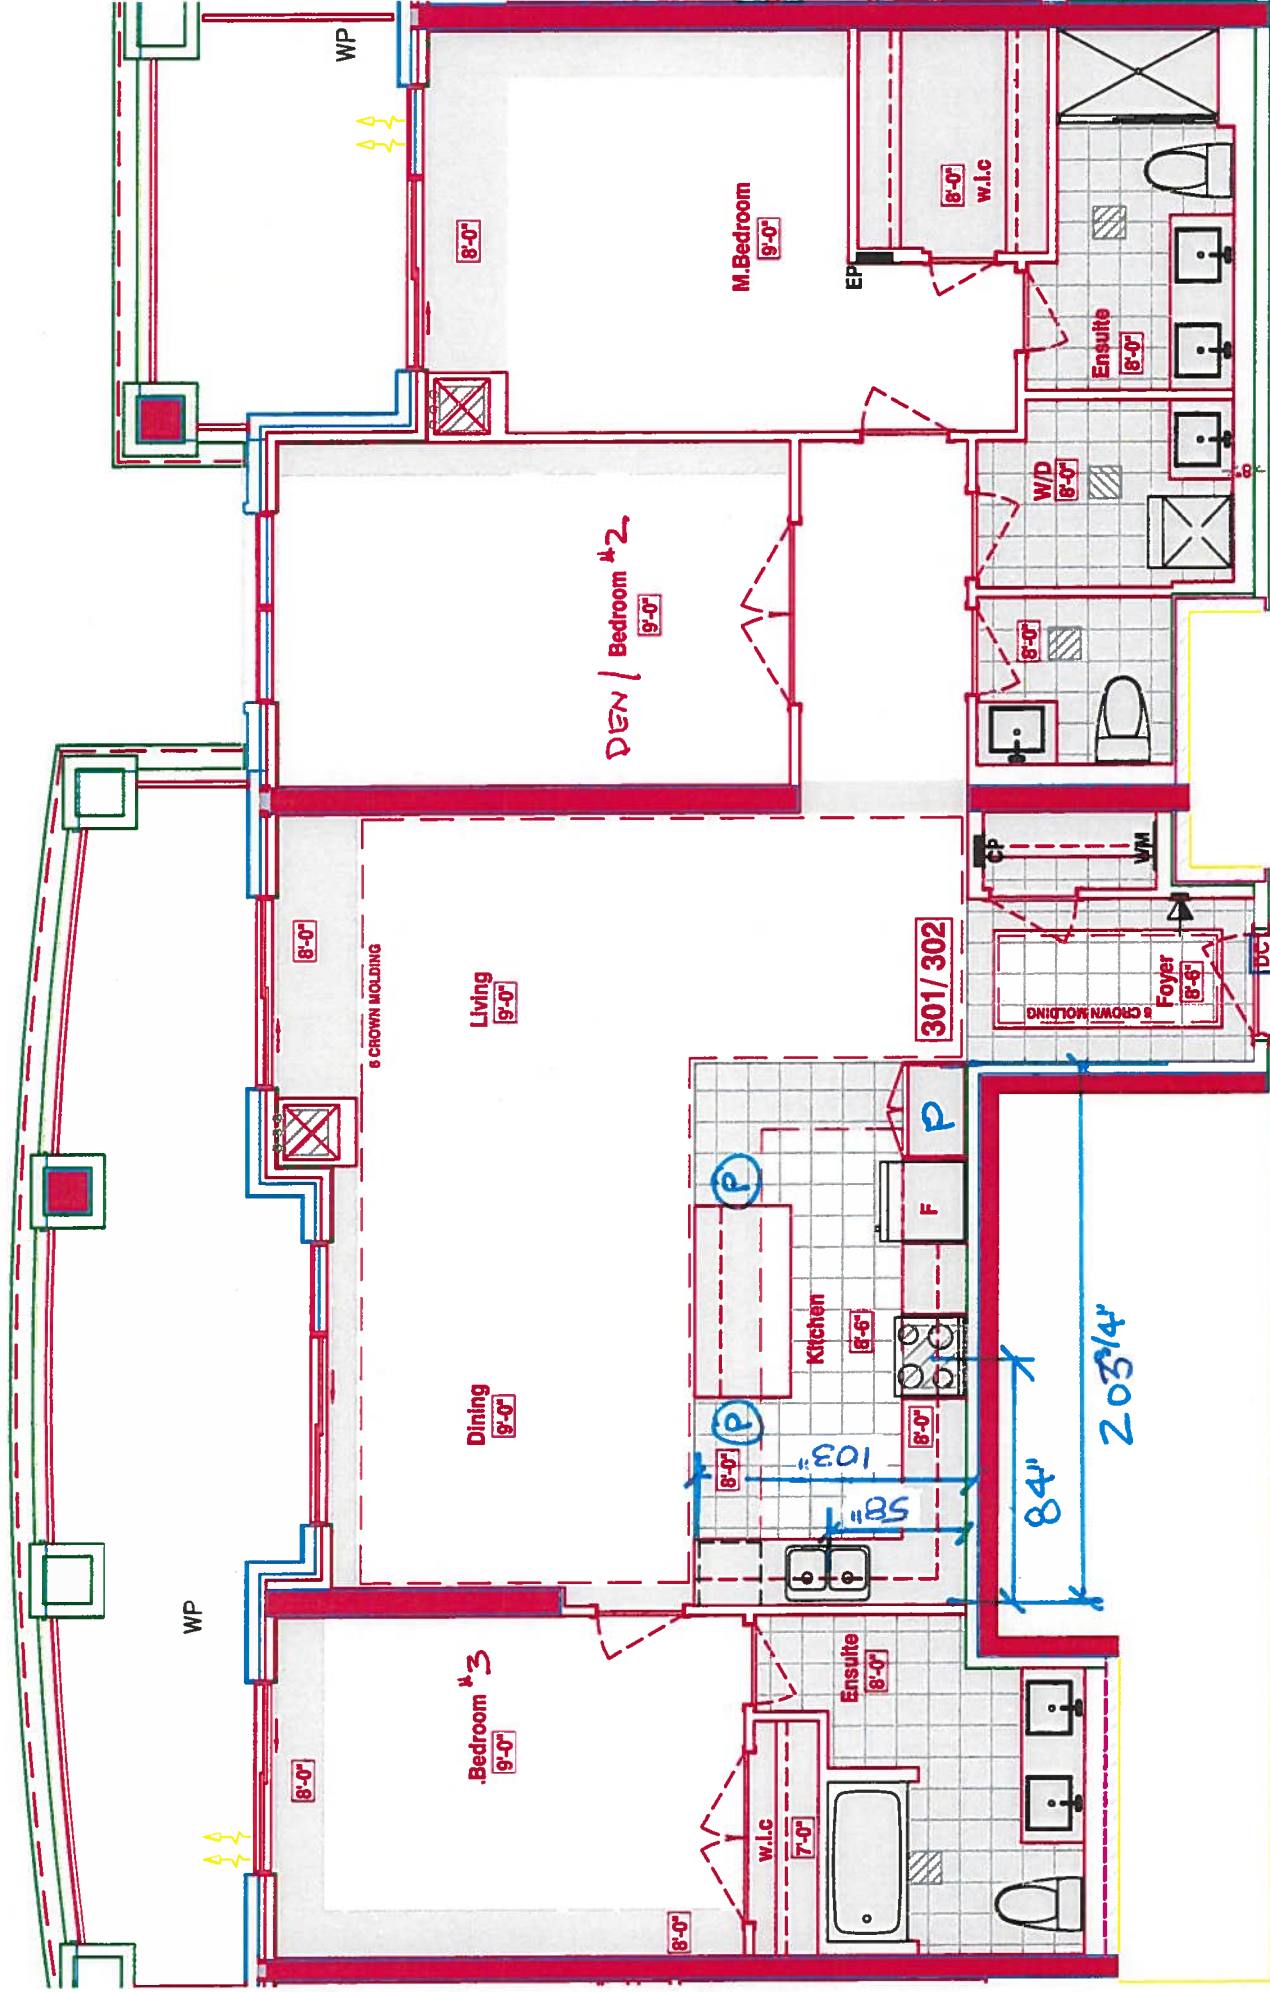


SUITES 301/ 302 - LONG ISLAND

Royal Pine Homes • 25 Boker Hill Blvd - Stouffville, ON • Feb 14, 2018


DRAWING AS PER AGREEMENT OF PURCHASE AND SALE (before decor appointment)

STANDARD
* KITCHEN
LAYOUT *

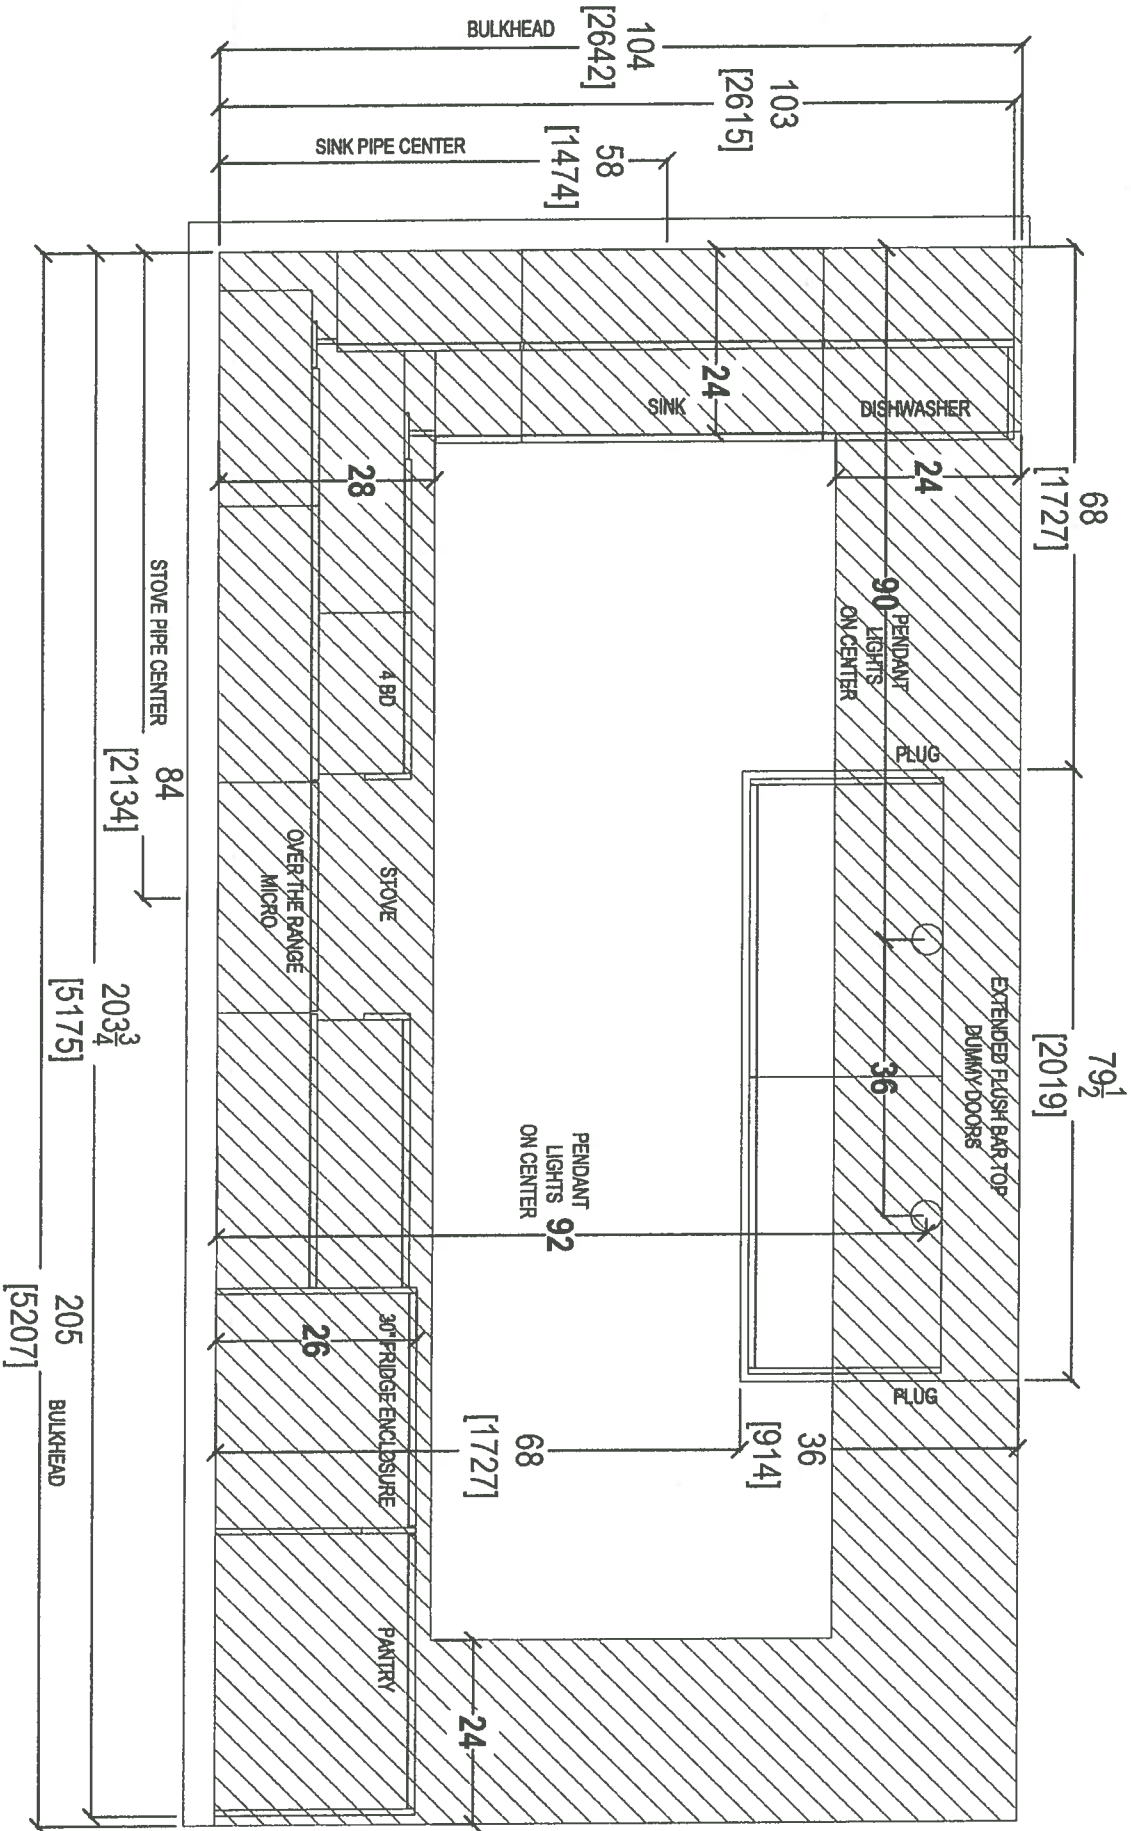


80 SANTE DRIVE, VAUGHAN, ON L4K 3C4
T: 416.746.1811 F: 416.761.5901

CLIENT: ROYAL PINE HOMES	UNIT 301-302 HMP (STANDARD)	ROOM: KITCHEN BULKHEAD PLAN	DRAWN BY: SK	COMMENTS:
SITE: HAMPTON PLACE	DOOR STYLE: —	DOOR HANDLE: —	SCALE: 1/2" = 1' - 0"	PLEASE NOTE ALL DIMENSIONS ARE NOT FINAL AND ARE SUBJECT TO CHANGE UPON FINAL SITE MEASURE
PHONE: —	FINISH: —	DRW HANDLE: —	DATE: APRIL 25, 2018	
EMAIL: —	SPECIES: —	TOP: —	PAGE: —	

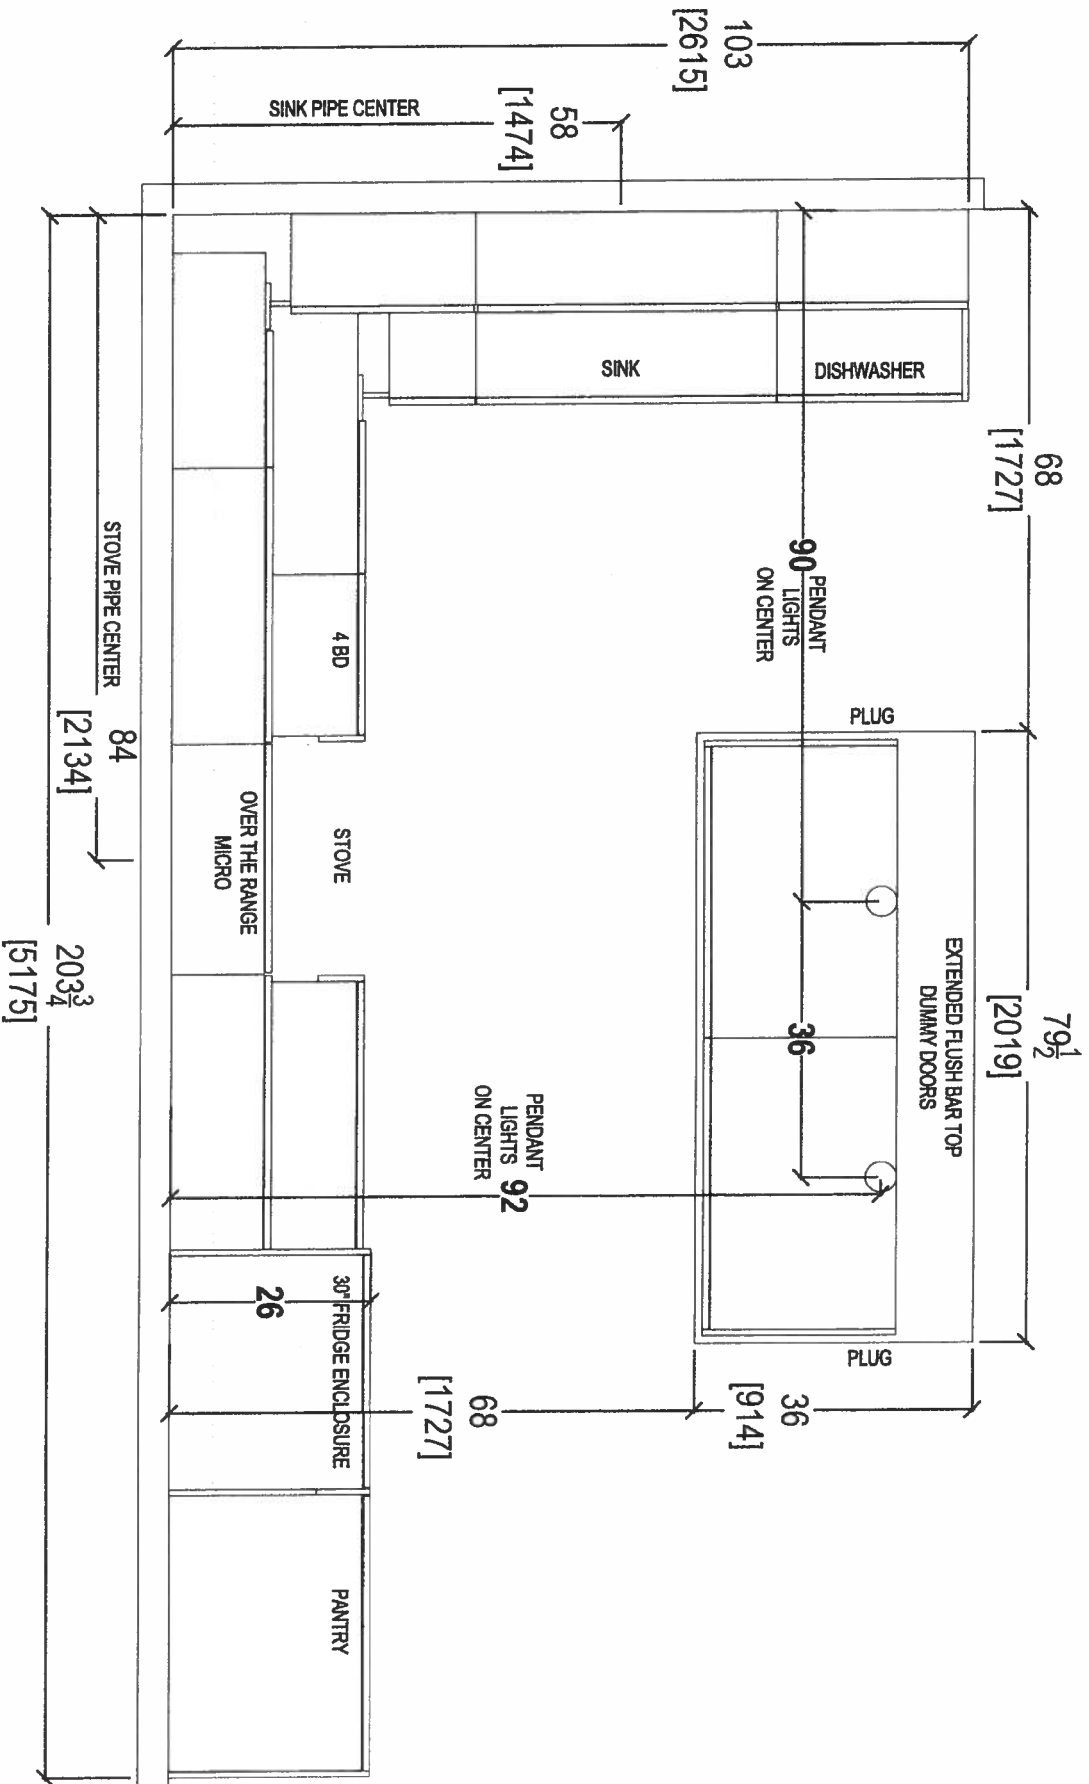

80 SANTE DRIVE, VAUGHAN ON L4K 3C4
T: 416.746.1811 F: 416.761.5801


CLIENT: ROYAL PINE HOMES	UNIT 301-302 HMP (STANDARD)	ROOM: KITCHEN FLOOR PLAN	DRAWN BY: SK	COMMENTS:
SITE: HAMPTON PLACE	DOOR STYLE: —	DOOR HANDLE: —	SCALE: 1/2" = 1' - 0"	PLEASE NOTE ALL DIMENSIONS ARE NOT FINAL AND ARE SUBJECT TO CHANGE UPON FINAL SITE MEASURE
PHONE: —	FINISH: —	DRW HANDLE: —	DATE: APRIL 25, 2018	
EMAIL: —	SPECIES: —	TOP: —	PAGE: —	

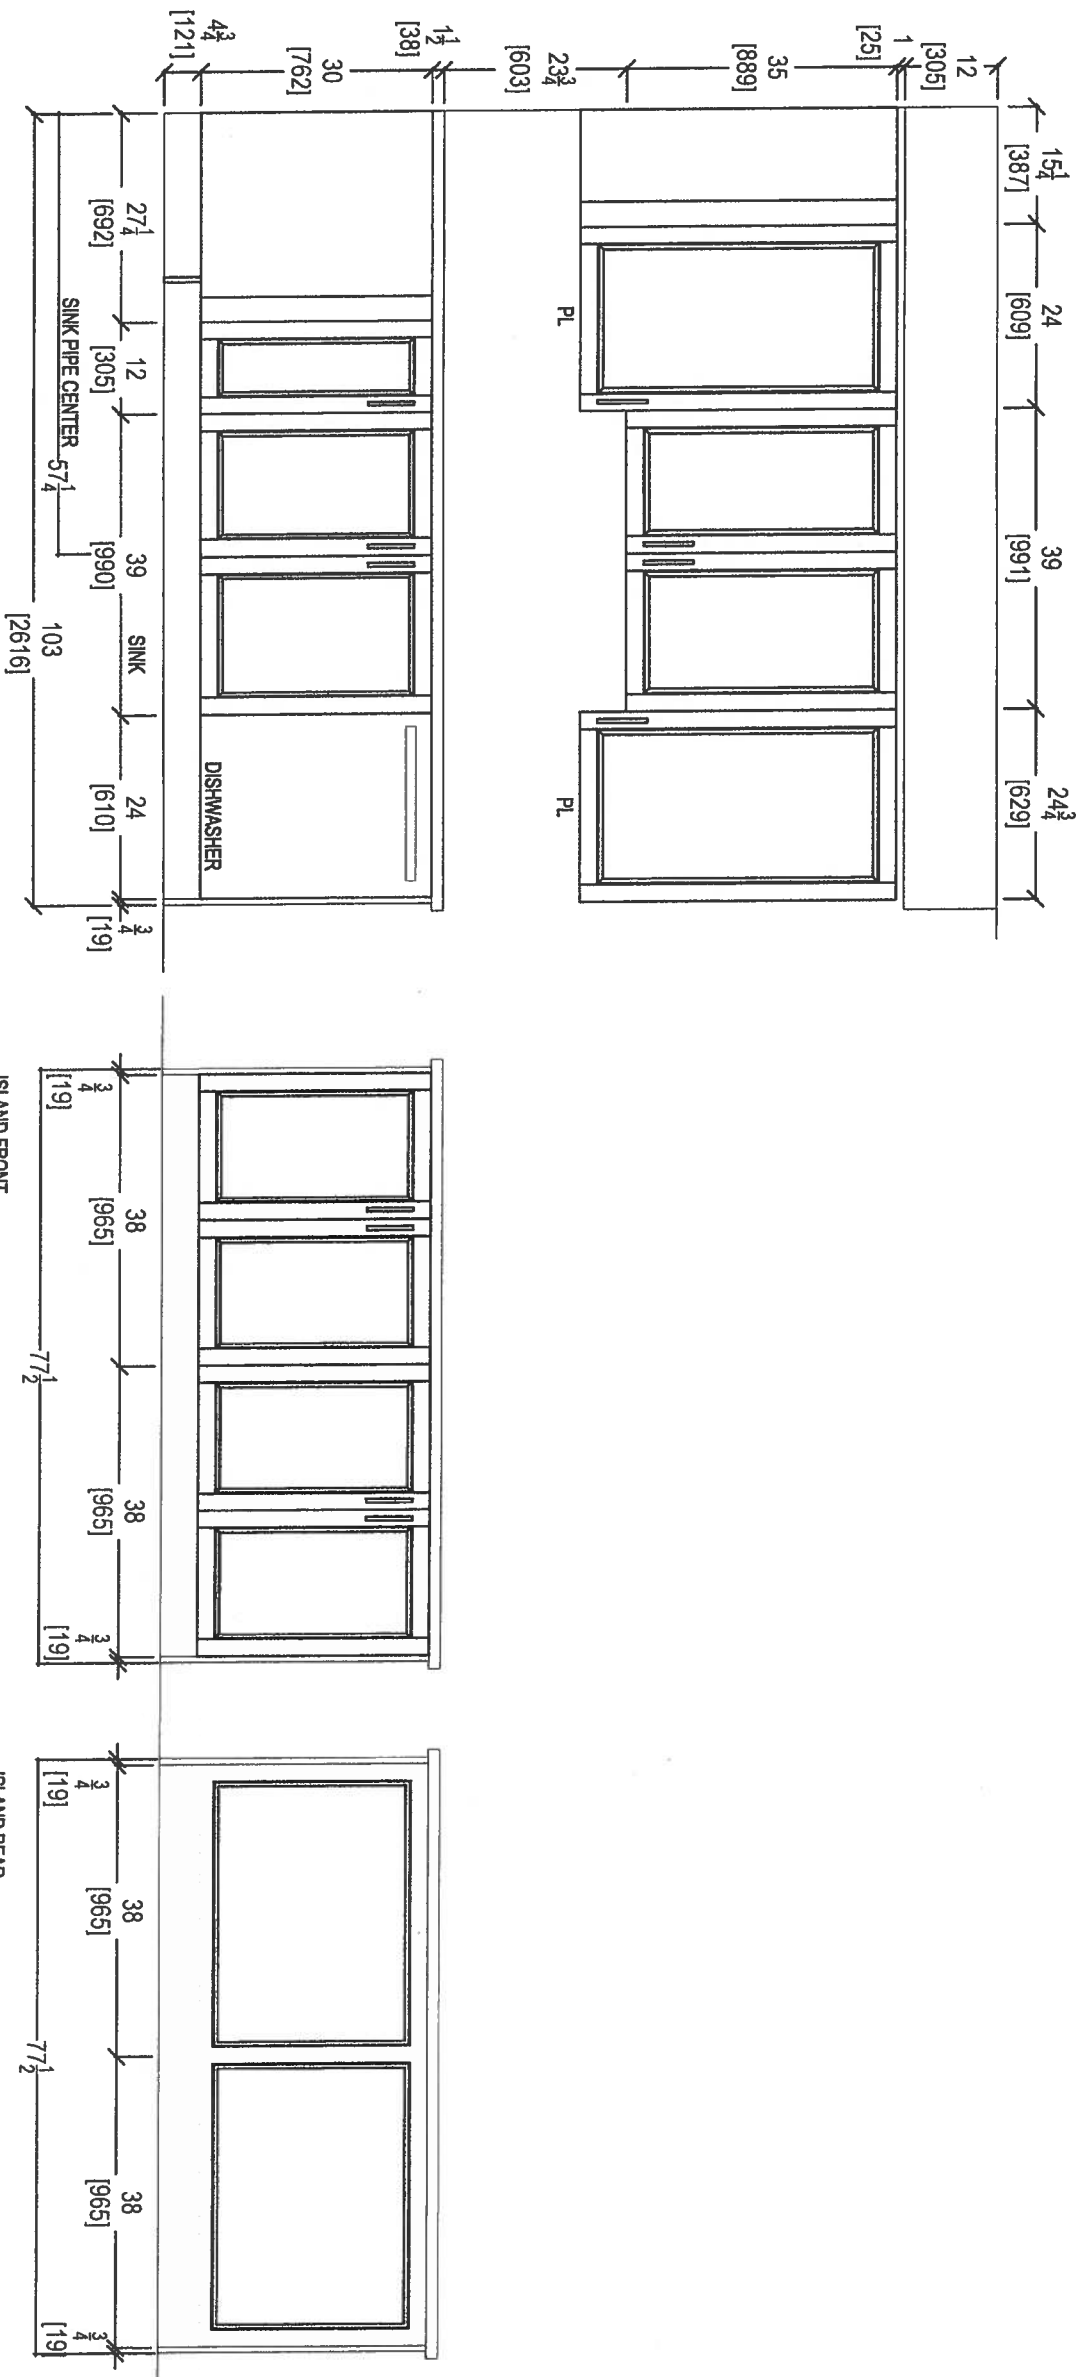

80 SANTE DRIVE, VAUGHAN, ON L4K 3C4,
T: 416.746.4441 F: 905.761.5901

CLIENT: ROYAL PINE HOMES	UNIT 301-302 HMP (STANDARD)	ROOM: KITCHEN	DRAWN BY: SK	COMMENTS:
SITE: HAMPTON PLACE	DOOR STYLE: —	DOOR HANDLE: —	SCALE: 1/2" = 1' - 0"	PLEASE NOTE ALL DIMENSIONS ARE NOT FINAL AND ARE SUBJECT TO CHANGE UPON FINAL SITE MEASURE
PHONE: —	FINISH: —	DRW HANDLE: —	DATE: APRIL 25, 2018	
EMAIL: —	SPECIES: —	TOP: —	PAGE: —	

84 STOVE PIPE CENTER
← [2134]
30 36 36 18 15
← [762] ← [914] ← [457] ← [381]
30 1/2 3/4 20 1/2
← [775] ← [914] ← [914]

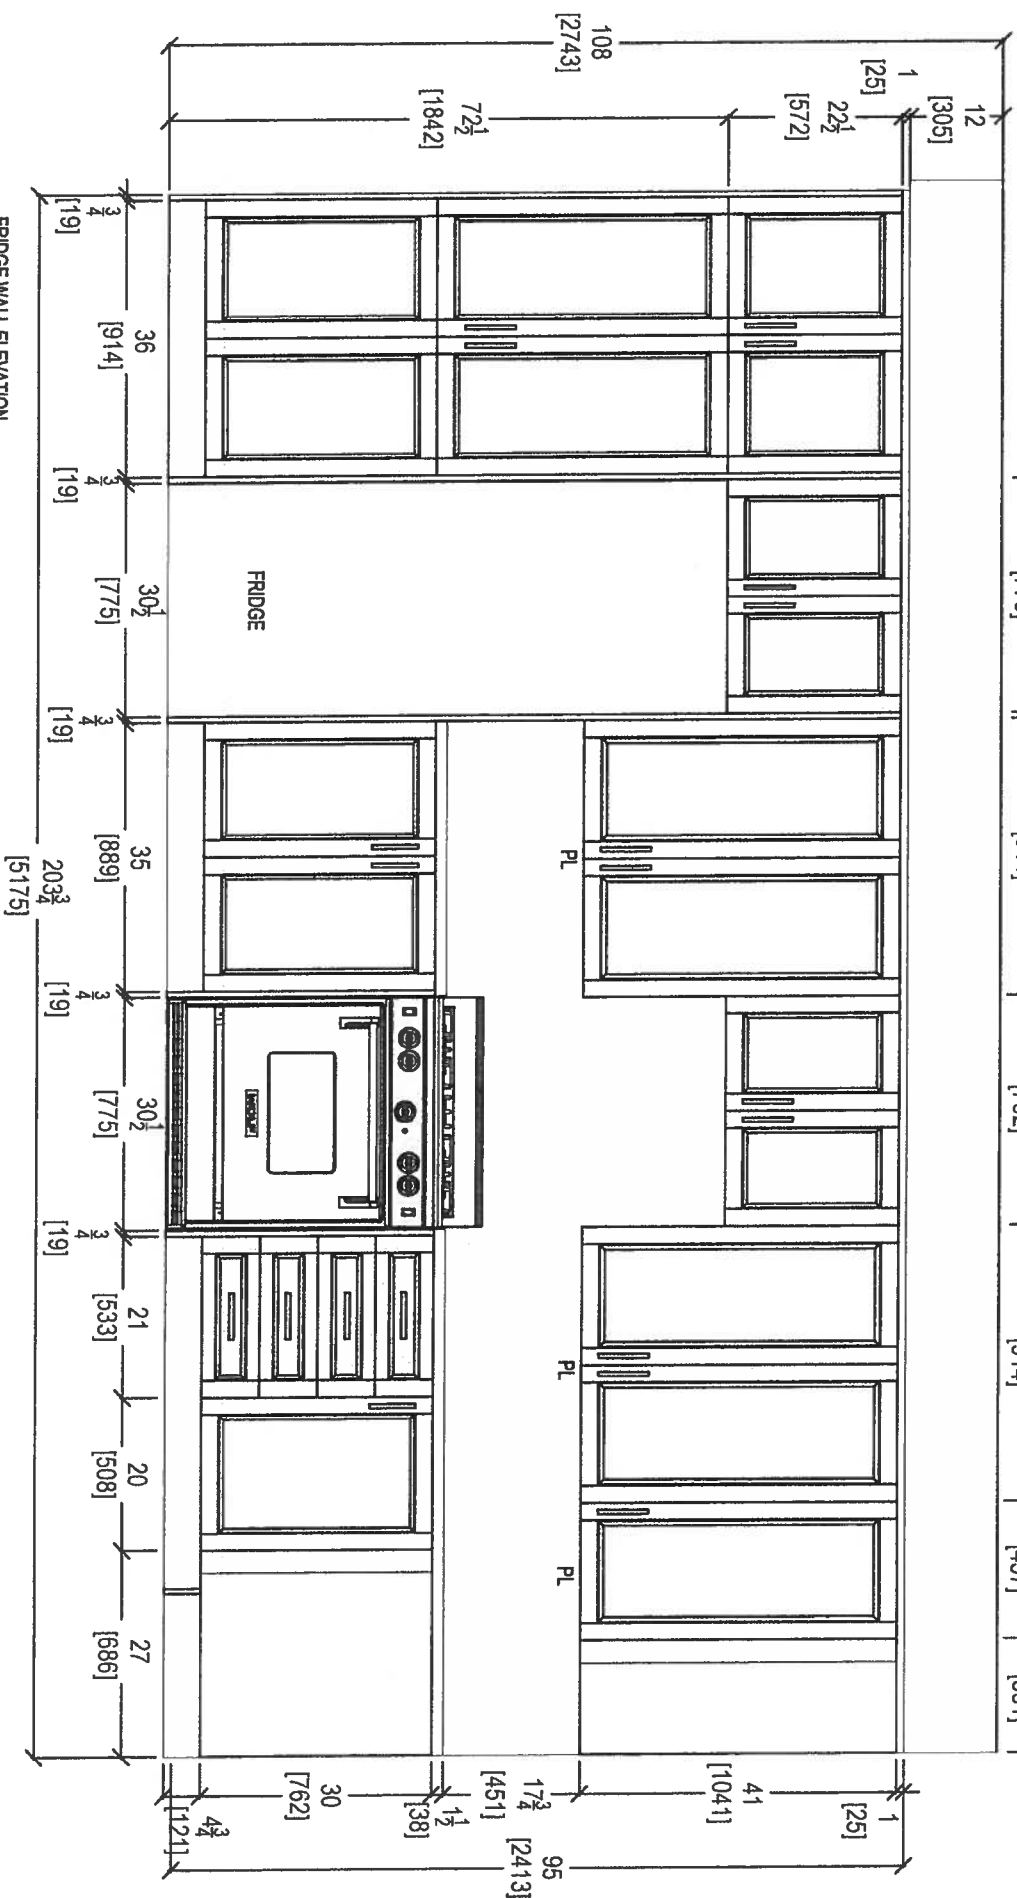

QTK

your kitchen, your taste.
80 SANTE DRIVE, VAUGHAN, ON L4K 3C4,
T: 416.746.4444 F: 905.761.5901

CLIENT: ROYAL PINE HOMES

SITE: HAMPTON PLACE

PHONE: —

EMAIL: —

UNIT 301-302 HMP (STANDARD)

DOOR STYLE: —

FINISH: —

SPECIES: —

ROOM: KITCHEN

DOOR HANDLE: —

DRW HANDLE: —

TOP: —

DRAWN BY: SK


SCALE: 1/2" = 1'-0"

DATE: APRIL 25, 2018


PAGE: —

COMMENTS:


PLEASE NOTE ALL DIMENSIONS
ARE NOT FINAL AND ARE
SUBJECT TO CHANGE UPON
FINAL SITE MEASURE

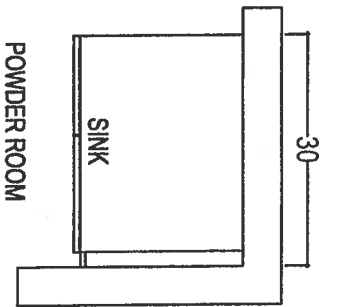


POWDER ROOM

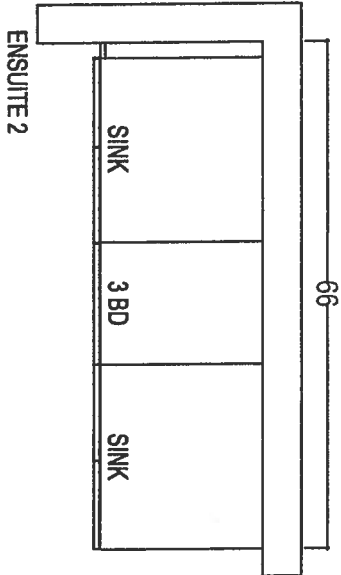





ENSUITE 2

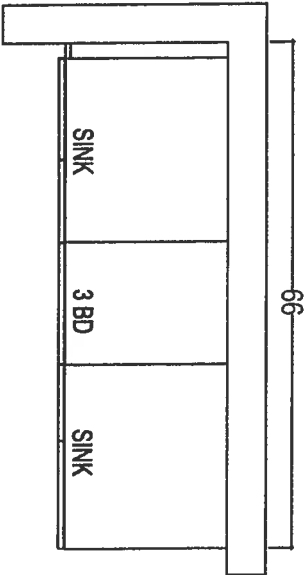

MASTER ENSUITE

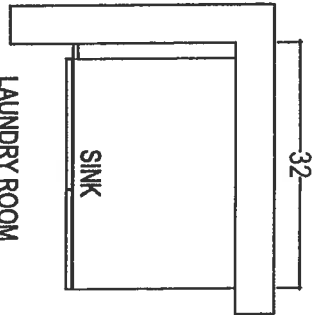


LAUNDRY ROOM

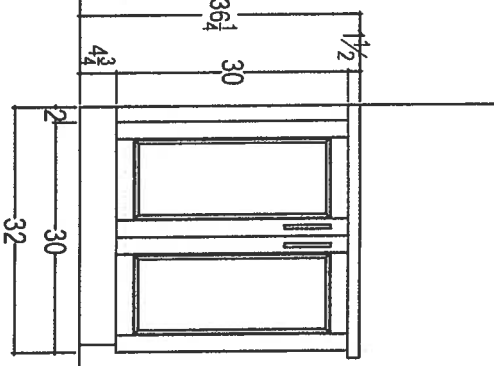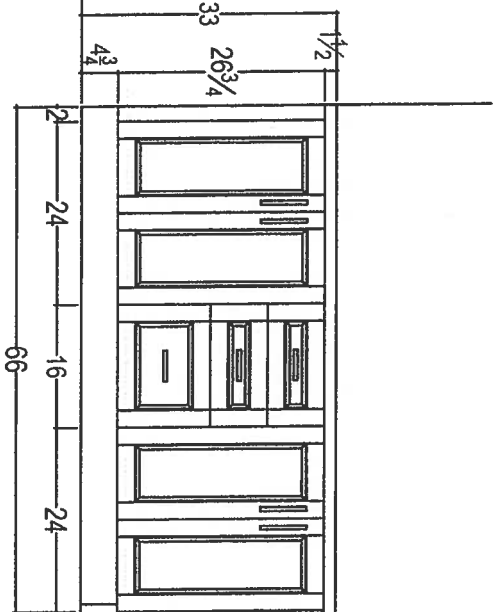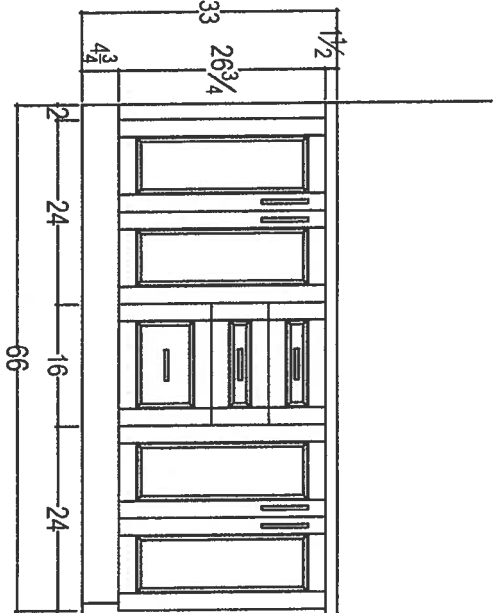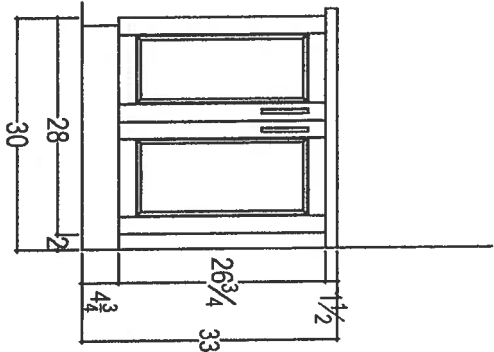

QTH your kitchen, your taste 80 SANTE DRIVE, VAUGHAN, ON L4K 3C4, T: 416.746.1811 ~ 905.761.5901					CLIENT: ROYAL PINE HOMES	UNIT 301-302 HMP (STANDARD)	ROOM: VANITIES	DRAWN BY: SK	COMMENTS: PLEASE NOTE ALL DIMENSIONS ARE NOT FINAL AND ARE SUBJECT TO CHANGE UPON FINAL SITE MEASURE
SITE: HAMPTON PLACE		DOOR STYLE: —	DOOR HANDLE: —	SCALE: 1/2" = 1'-0"					
PHONE: —		FINISH: —	DRW HANDLE: —	DATE: APRIL 25, 2018					
EMAIL: —		SPECIES: —	TOP: —	PAGE: —					

UPGRADE
* KITCHEN *
LAYOUT

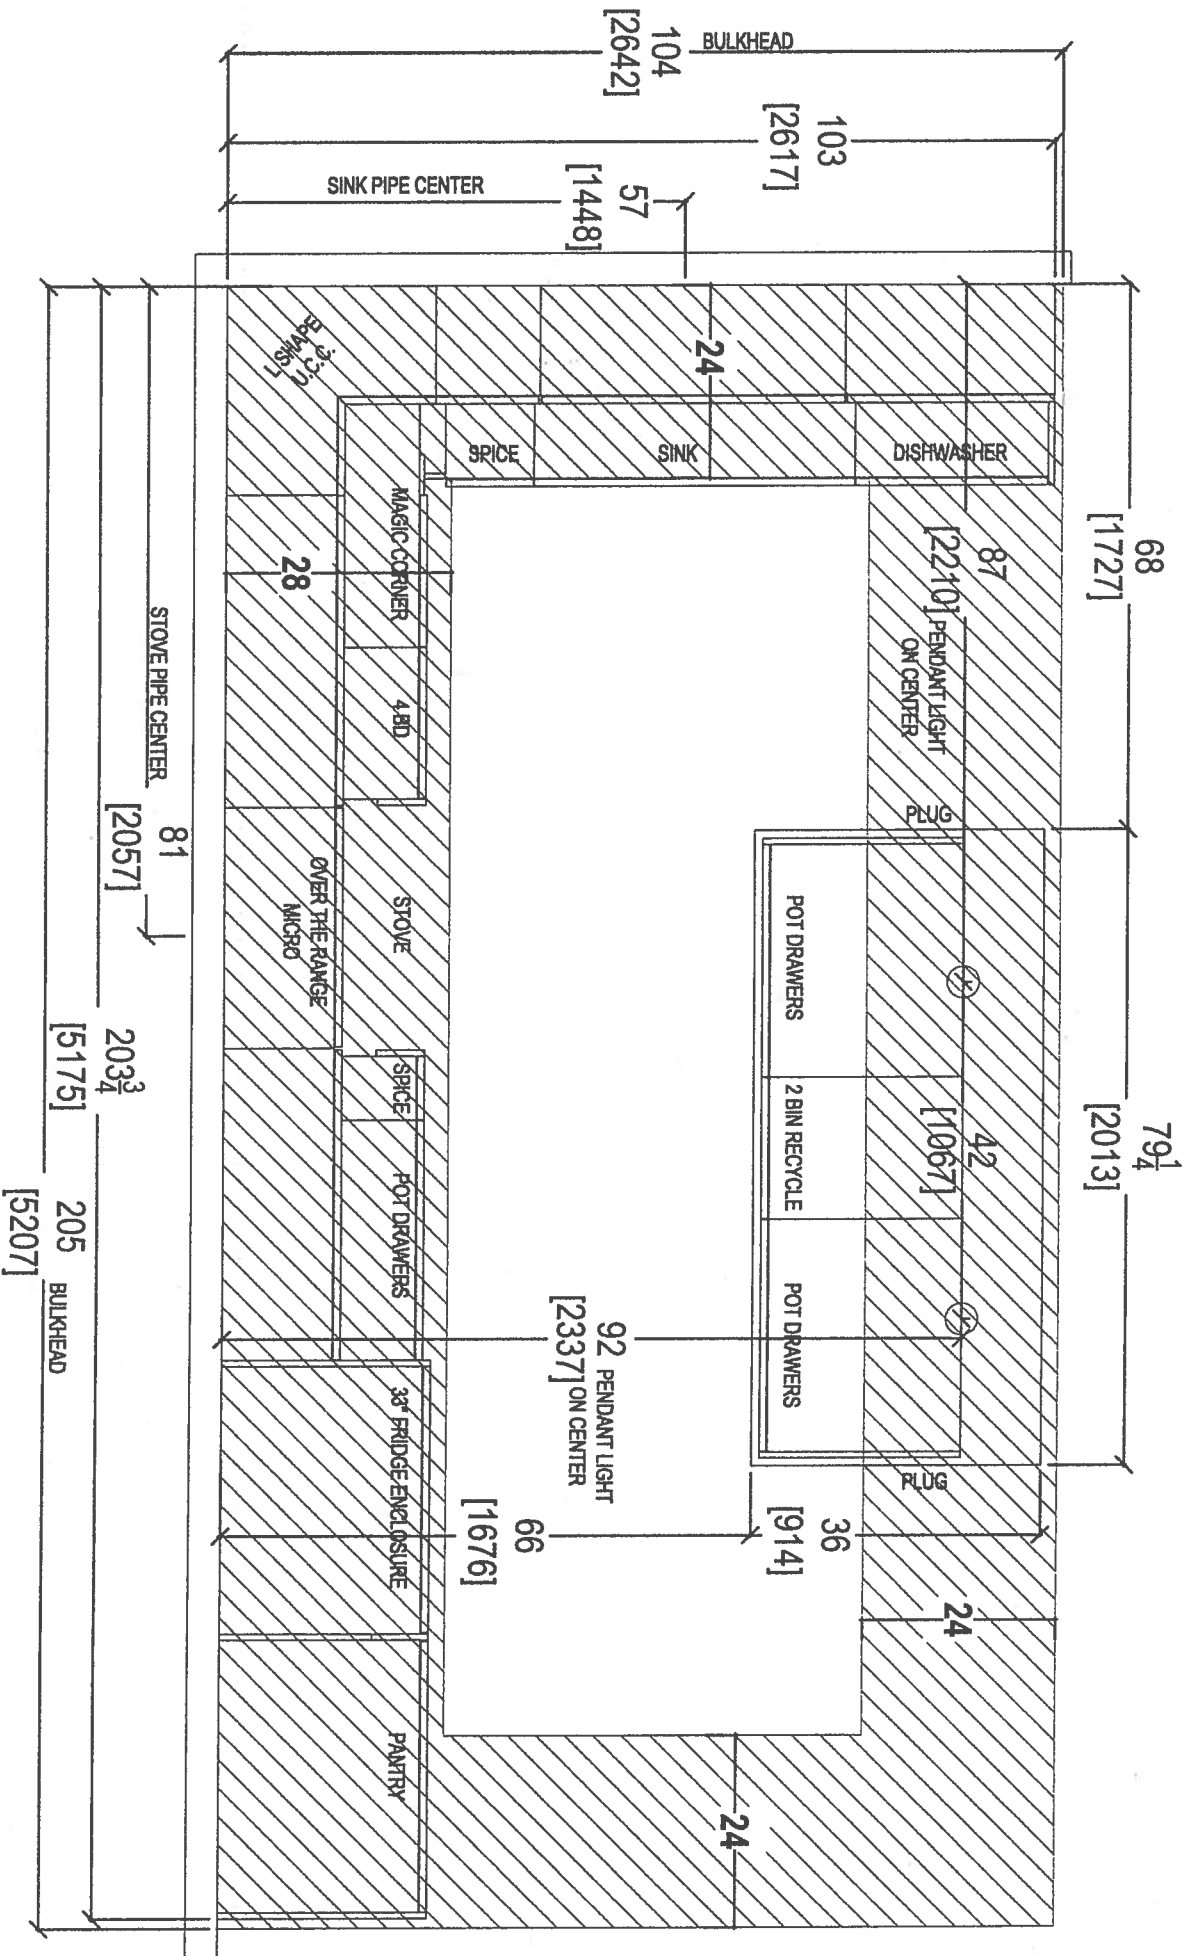

CLIENT: ROYAL PINE HOMES

UNIT 301-302 HMP

ROOM: KITCHEN FLOOR PLAN

DRAWN BY: SK

COMMENTS:

SITE: HAMPTON PLACE

DOOR STYLE: —

—

SCALE: 1/2" = 1' - 0"

PLEASE NOTE ALL DIMENSIONS
ARE NOT FINAL AND ARE
SUBJECT TO CHANGE UPON
FINAL SITE MEASURE

PHONE: —

FINISH: —

DRW HANDLE: —

DATE: APRIL 25, 2018

EMAIL: —


SPECIES: —

TOP: —

PAGE: —

QTK

your kitchen, your taste.
80 SANTE DRIVE, VAUGHAN ON L4K 3C4,
T: 416.746.1811 F: 416.746.1801

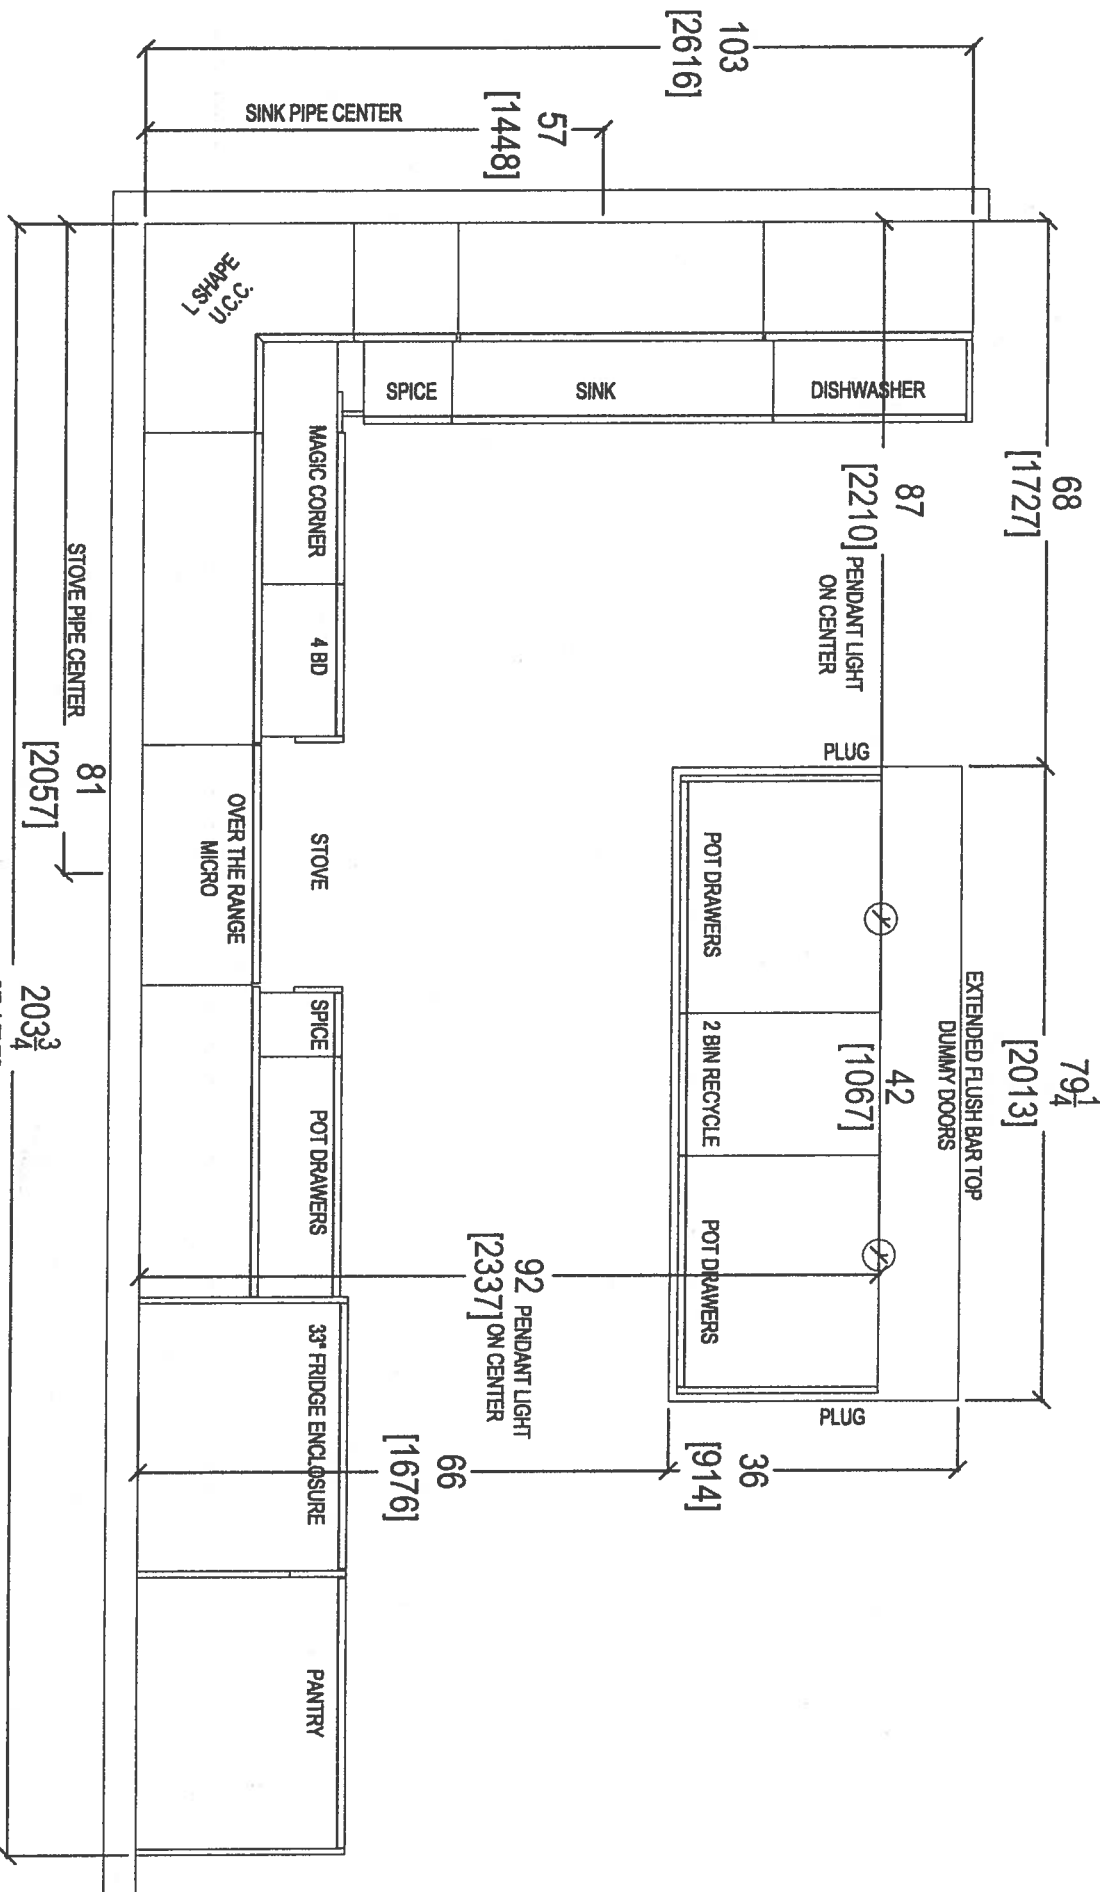


CLIENT: ROYAL PINE HOMES	UNIT 301-302 HMP	ROOM: KITCHEN FLOOR PLAN	DRAWN BY: SK
SITE: HAMPTON PLACE	DOOR STYLE: —	DOOR HANDLE: —	SCALE: 1/2" = 1' - 0"
PHONE: —	FINISH: —	DRW HANDLE: —	DATE: APRIL 25, 2018
EMAIL: —	SPECIES: —	TOP: —	PAGE: —

COMMENTS:
PLEASE NOTE ALL DIMENSIONS
ARE NOT FINAL AND ARE
SUBJECT TO CHANGE UPON
FINAL SITE MEASURE



80 SANTE DRIVE, VAUGHAN, ON L4K 3C4,
T: 416.746.1811 F: 5901

6

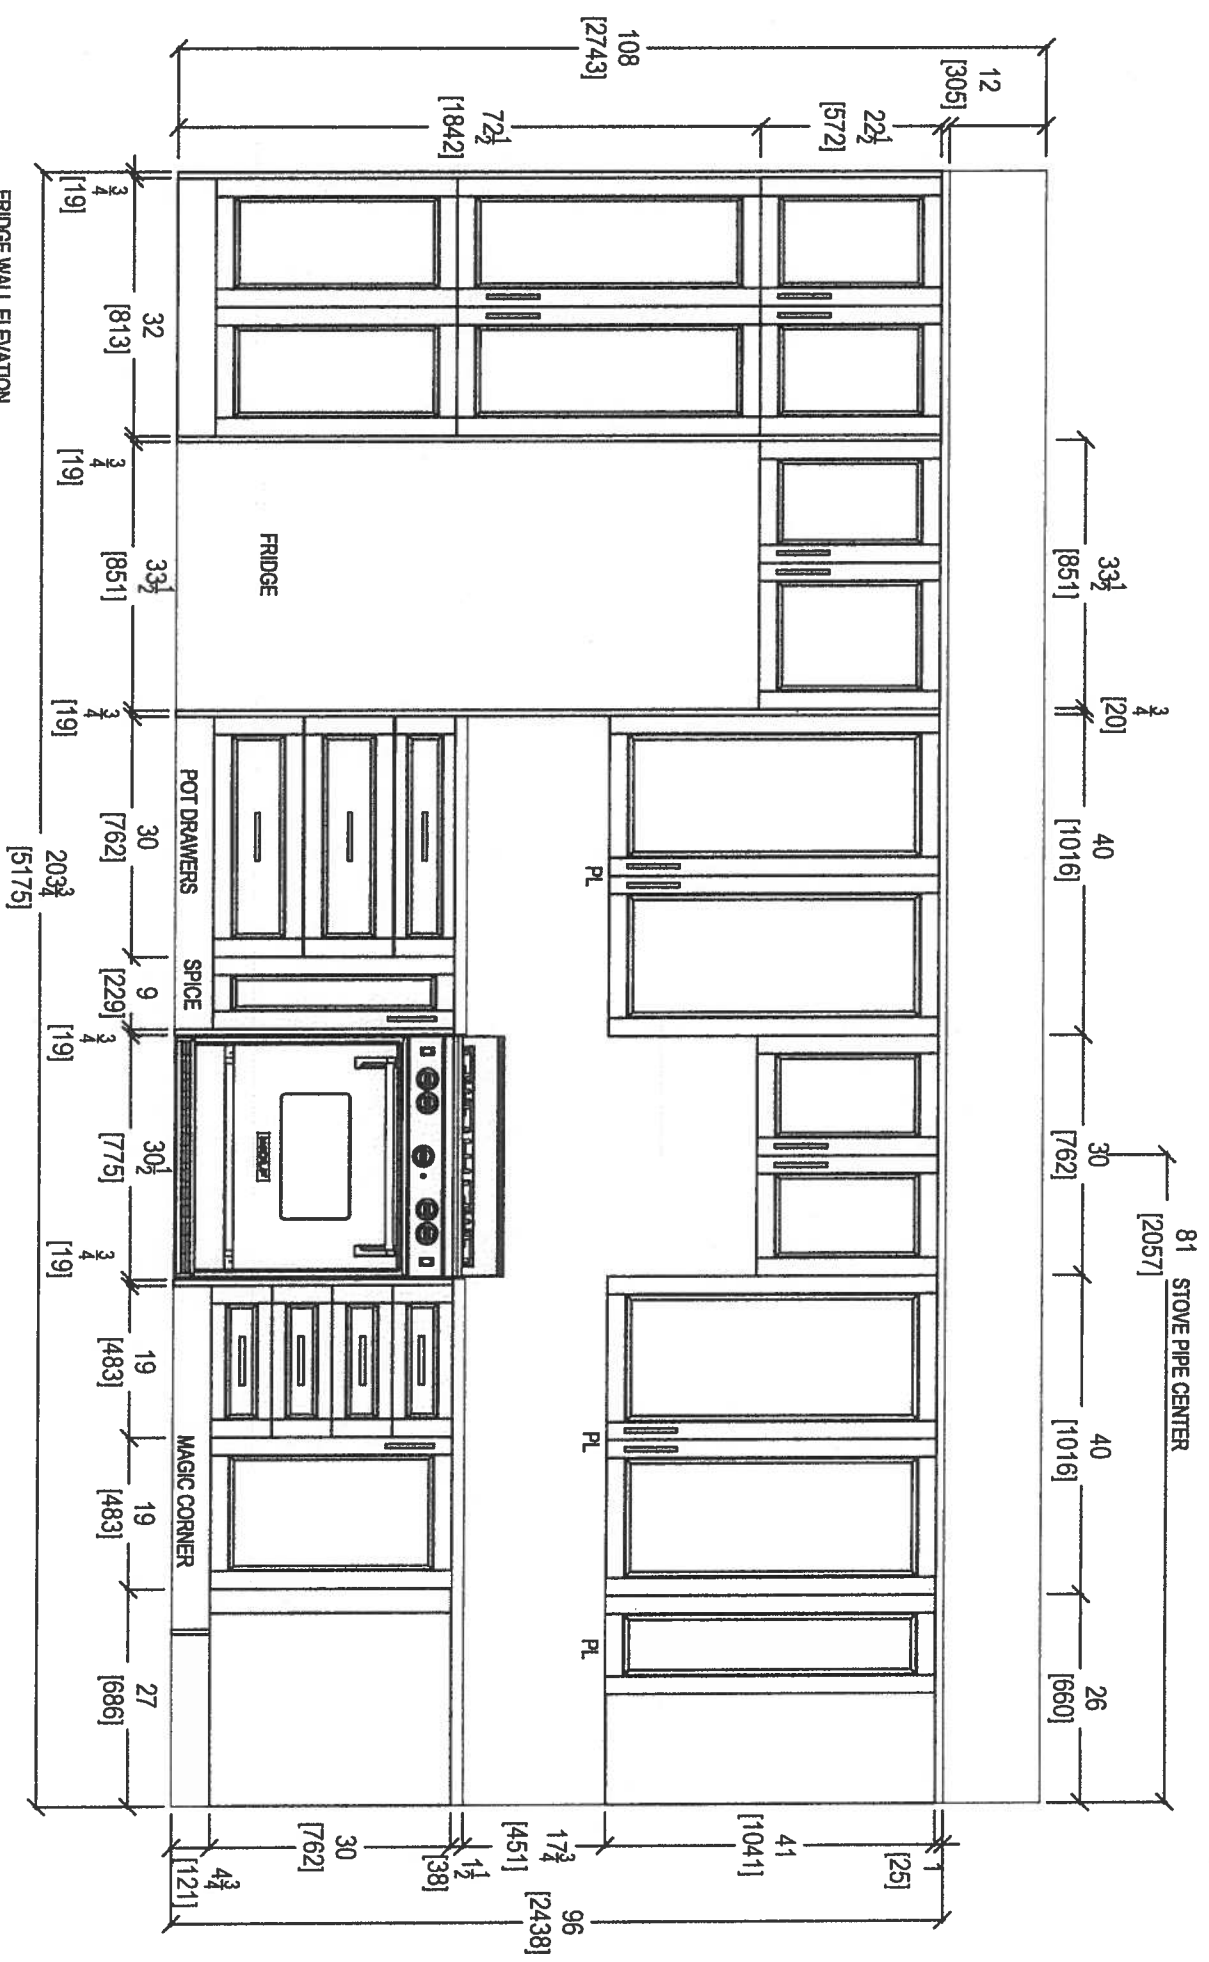

FRIDGE WALL ELEVATION

CLIENT: ROYAL PINE HOMES	UNIT 301-302 HMP	ROOM: KITCHEN	DRAWN BY: SK
SITE: HAMPTON PLACE	DOOR STYLE: —	DOOR HANDLE: —	SCALE: 1/2" = 1' - 0"
PHONE: —	FINISH: —	DRW HANDLE: —	DATE: APRIL 25, 2018
EMAIL: —	SPECIES: —	TOP: —	PAGE: —





COMMENTS:

PLEASE NOTE ALL DIMENSIONS
ARE NOT FINAL AND ARE
SUBJECT TO CHANGE UPON
FINAL SITE MEASURE




80 SANTE DRIVE, VAUGHAN, ON L4K 3C4,
T: 416.746.1811 F: 416.746.1801


19

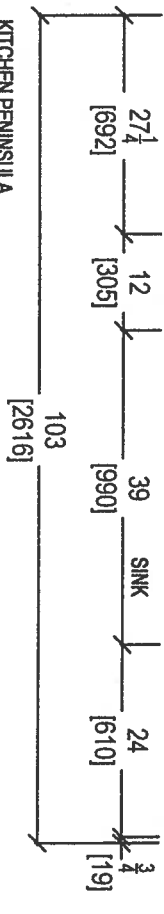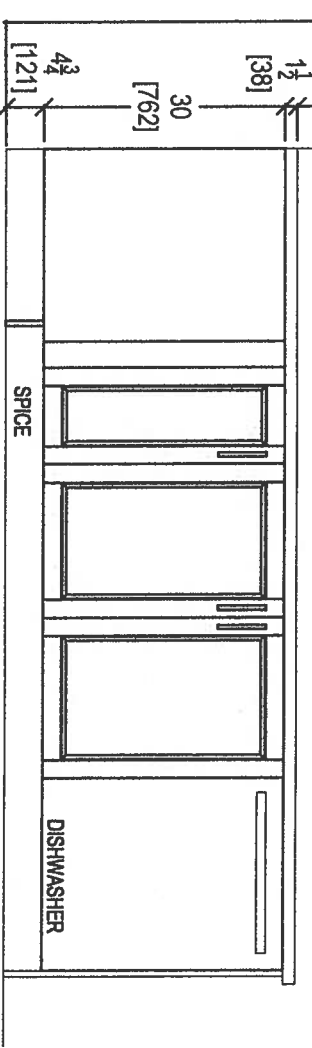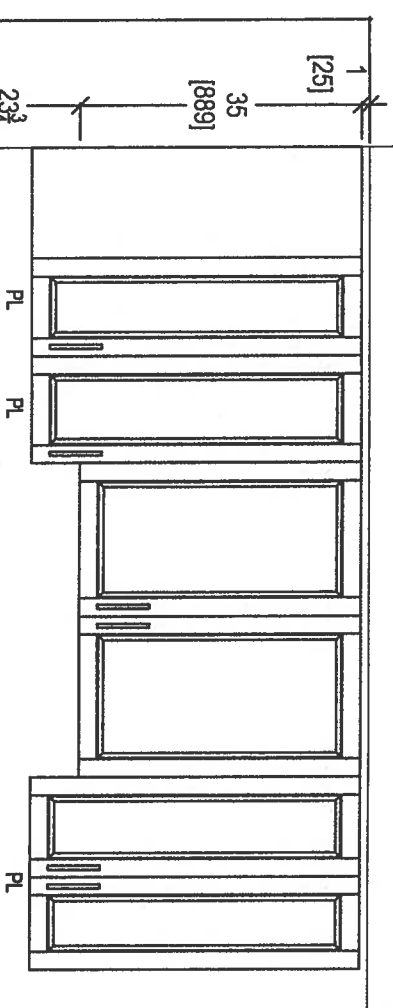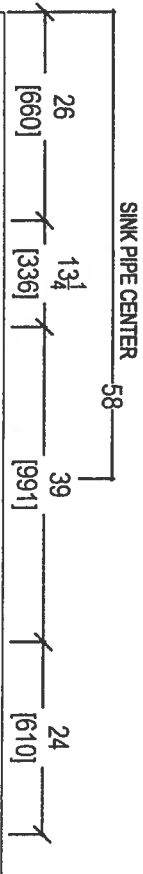

KITCHEN PENINSULA
ELEVATION
FRONT VIEW

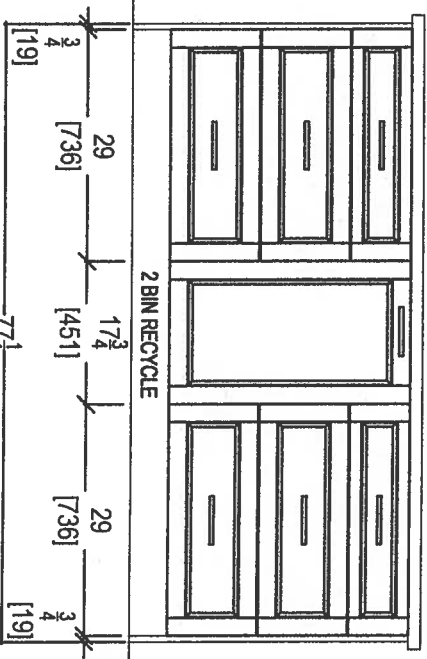

ISLAND FRONT

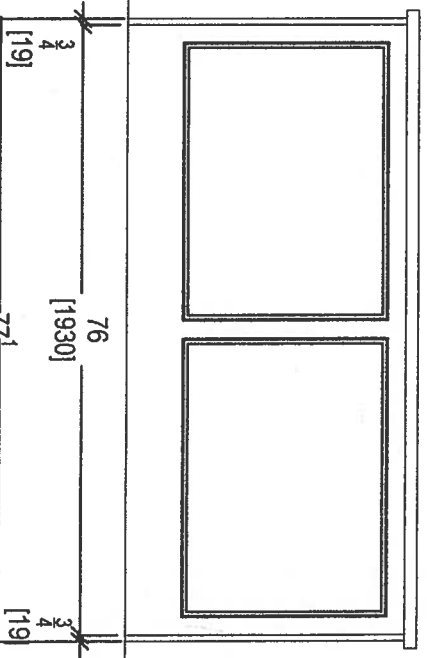


ISLAND REAR

CLIENT: ROYAL PINE HOMES	UNIT 301-302 HMP	ROOM: KITCHEN	DRAWN BY: SK	COMMENTS:
SITE: HAMPTON PLACE	DOOR STYLE: —	DOOR HANDLE: —	SCALE: 1/2" = 1' - 0"	PLEASE NOTE ALL DIMENSIONS ARE NOT FINAL AND ARE SUBJECT TO CHANGE UPON FINAL SITE MEASURE
PHONE: —	FINISH: —	DRW HANDLE: —	DATE: APRIL 26, 2018	
EMAIL: —	SPECIES: —	TOP: —	PAGE: —	




80 SANTE DRIVE, VALENTIA, ON L4K 3C4,
T: 416.746.18


67

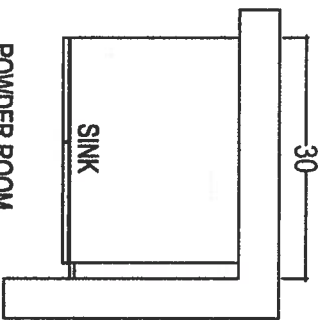


POWDER ROOM

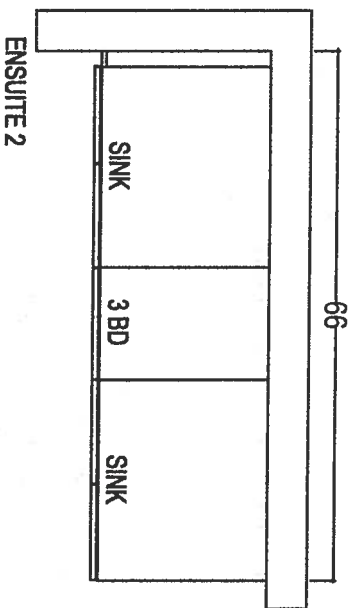





ENSUITE 2

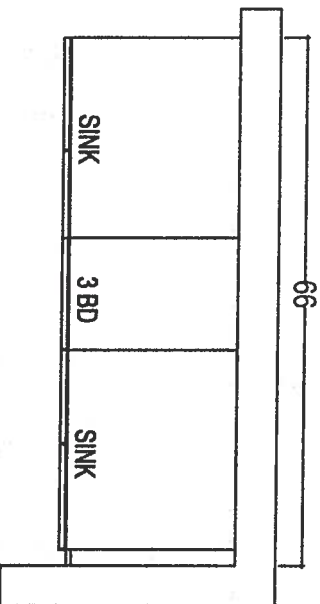

MASTER ENSUITE

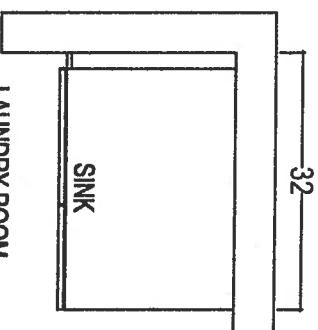

LAUNDRY ROOM

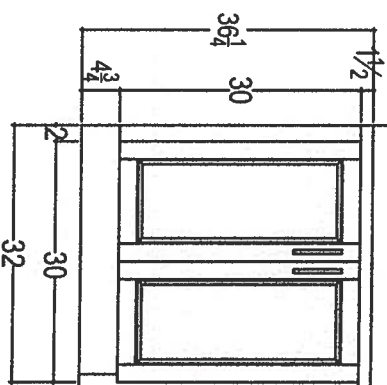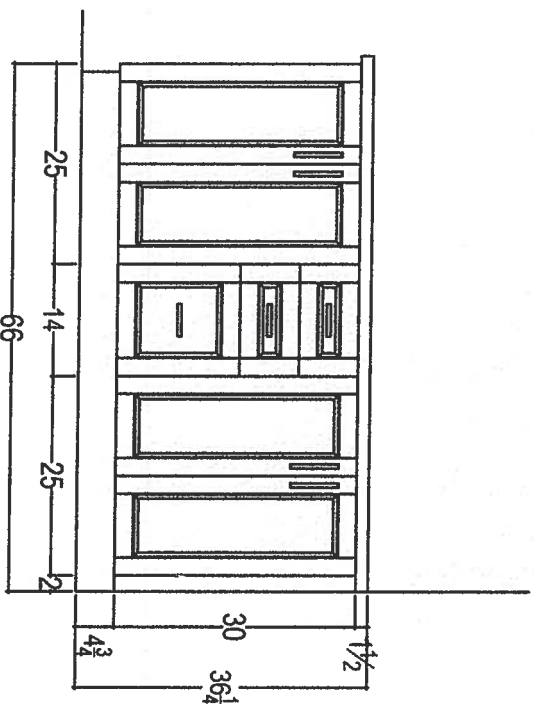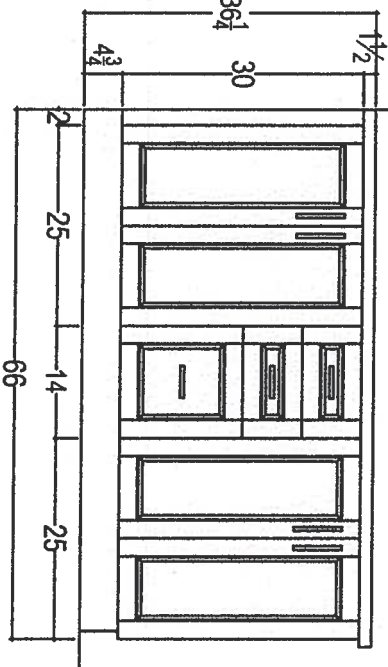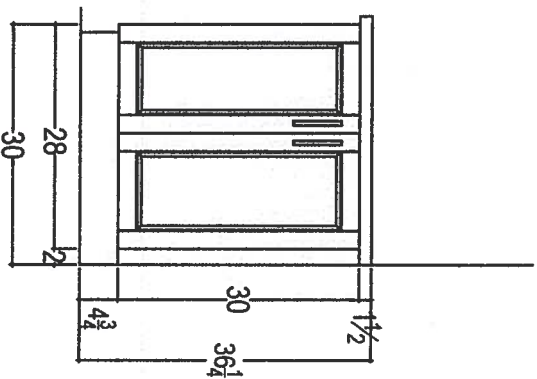

* Raised Height *

* Raised Height *

CLIENT: ROYAL PINE HOMES

UNIT 301-302 HMP

ROOM: VANITIES

DRAWN BY: SK

COMMENTS:

SITE: HAMPTON PLACE

DOOR STYLE: --

DOOR HANDLE: --

SCALE: 1/2" = 1'-0"

PLEASE NOTE ALL DIMENSIONS ARE NOT FINAL AND ARE SUBJECT TO CHANGE UPON FINAL SITE MEASURE

PHONE: --

FINISH: --

DRW HANDLE: --

DATE: APRIL 25, 2018

EMAIL: --

SPECIES: --

TOP: --

PAGE: --



your kitchen, your taste.
80 SANTE DRIVE, VAUGHAN, ON L4K 3C4,
T: 416.748.1811 F: 416.748.1801