


Noyac Bay


1,121 SQ FT *plus* 76 sq. ft. of balcony area

SUITE 311
ORIGINAL LAYOUT
INVENTORY SUITE

NEW.

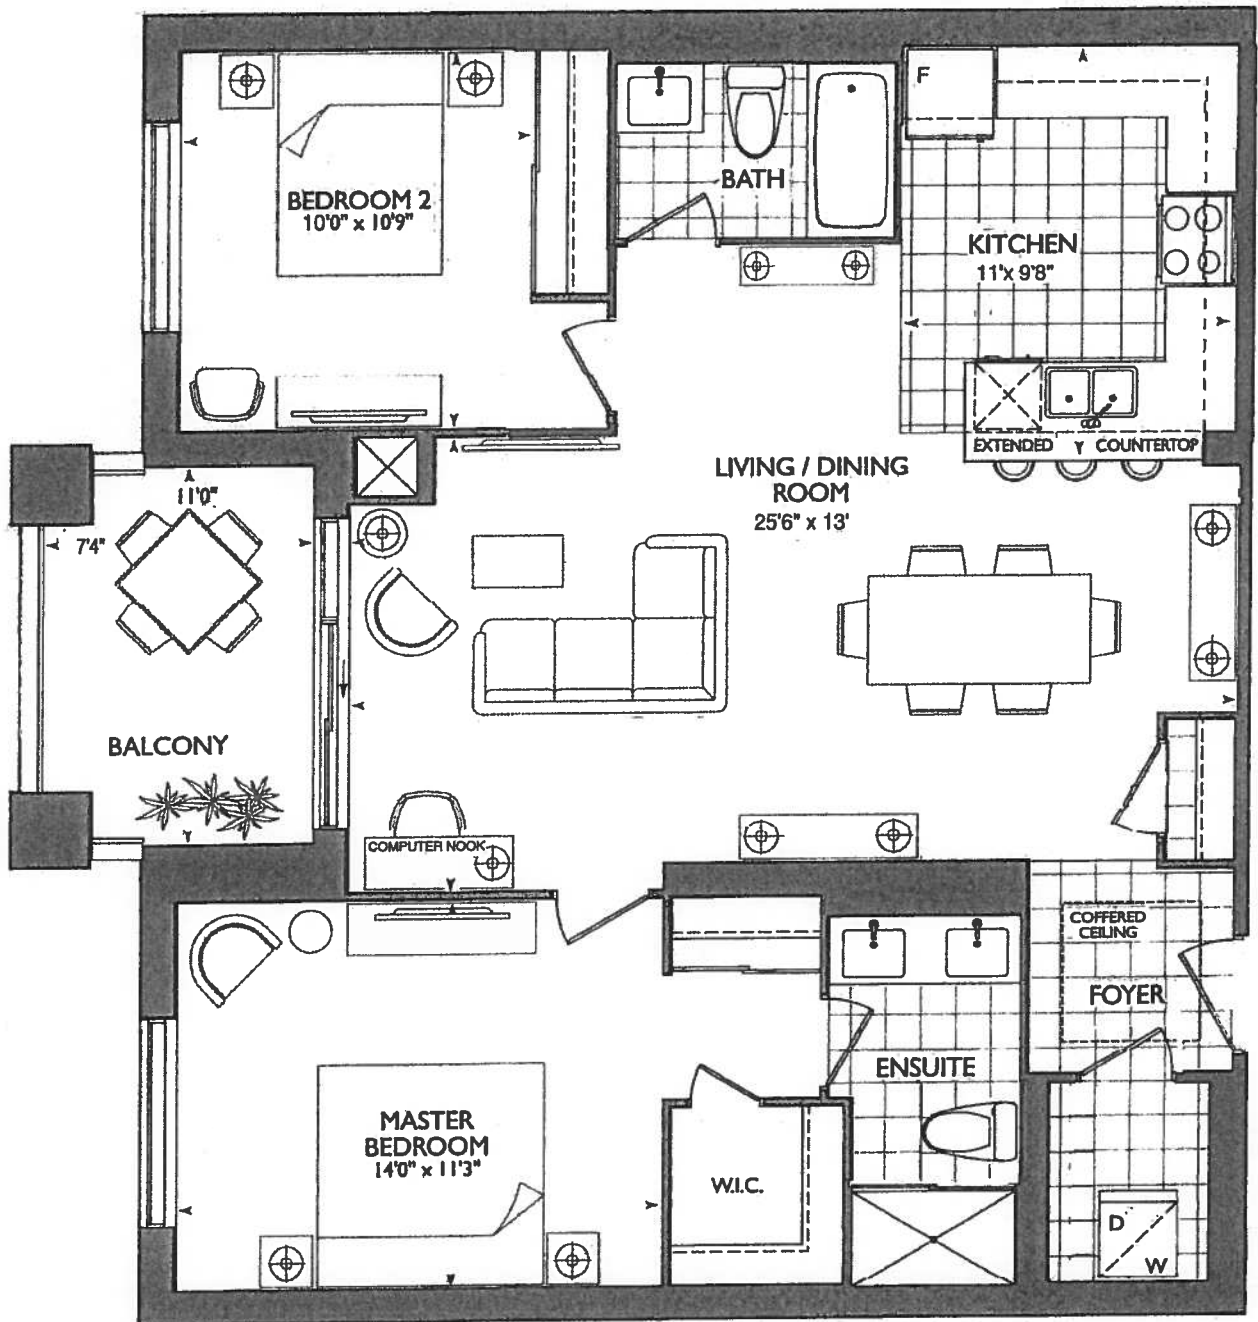

2ND FLOOR

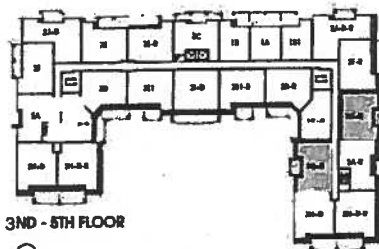

3ND - 5TH FLOOR



6TH FLOOR



Plans and specifications are subject to change without notice. Actual usable floor space may vary from the stated floor area. All renderings are artist's concept E. & O. E.

*** KITCHEN ***
CHOICE OF STD. KITCHEN LAYOUT WITH
STD. APPLIANCE PACKAGE

OR

CAN UPGRADE AT DECOR CENTER


- (x2) CAPPED PENDANT
- (x1) PLUG PENINSULA
- (x) PUCK LIGHTS

*SEE ATTACHED UPG.
#1- KITCHEN LAYOUT WITH 1ST UPG.
APPLIANCE PACKAGE

CAN UPGRADE AT DECOR CENTER

***SEE ATTACHED UPG.**

#1- KITCHEN LAYOUT WITH 1ST UPG. APPLIANCE PACKAGE

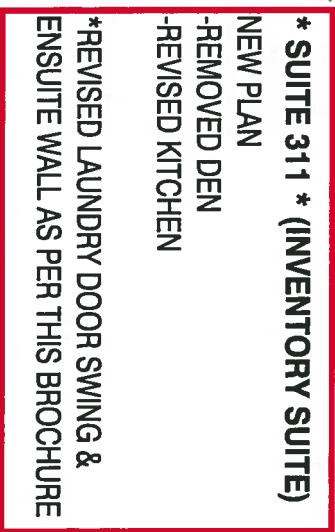

NEW PLAN

-REMOVED DEN


-REVISED KITCHEN

***REVISED LAUNDRY DOOR SWING & ENSUITE WALL AS PER THIS BROCHURE**




■ **Royal Pine Homes** ■ **25 Baker Hill Blvd** ■ **Yountville, ON** ■ **Apr 04, 2018**

* STANDARD KITCHEN LAYOUT *

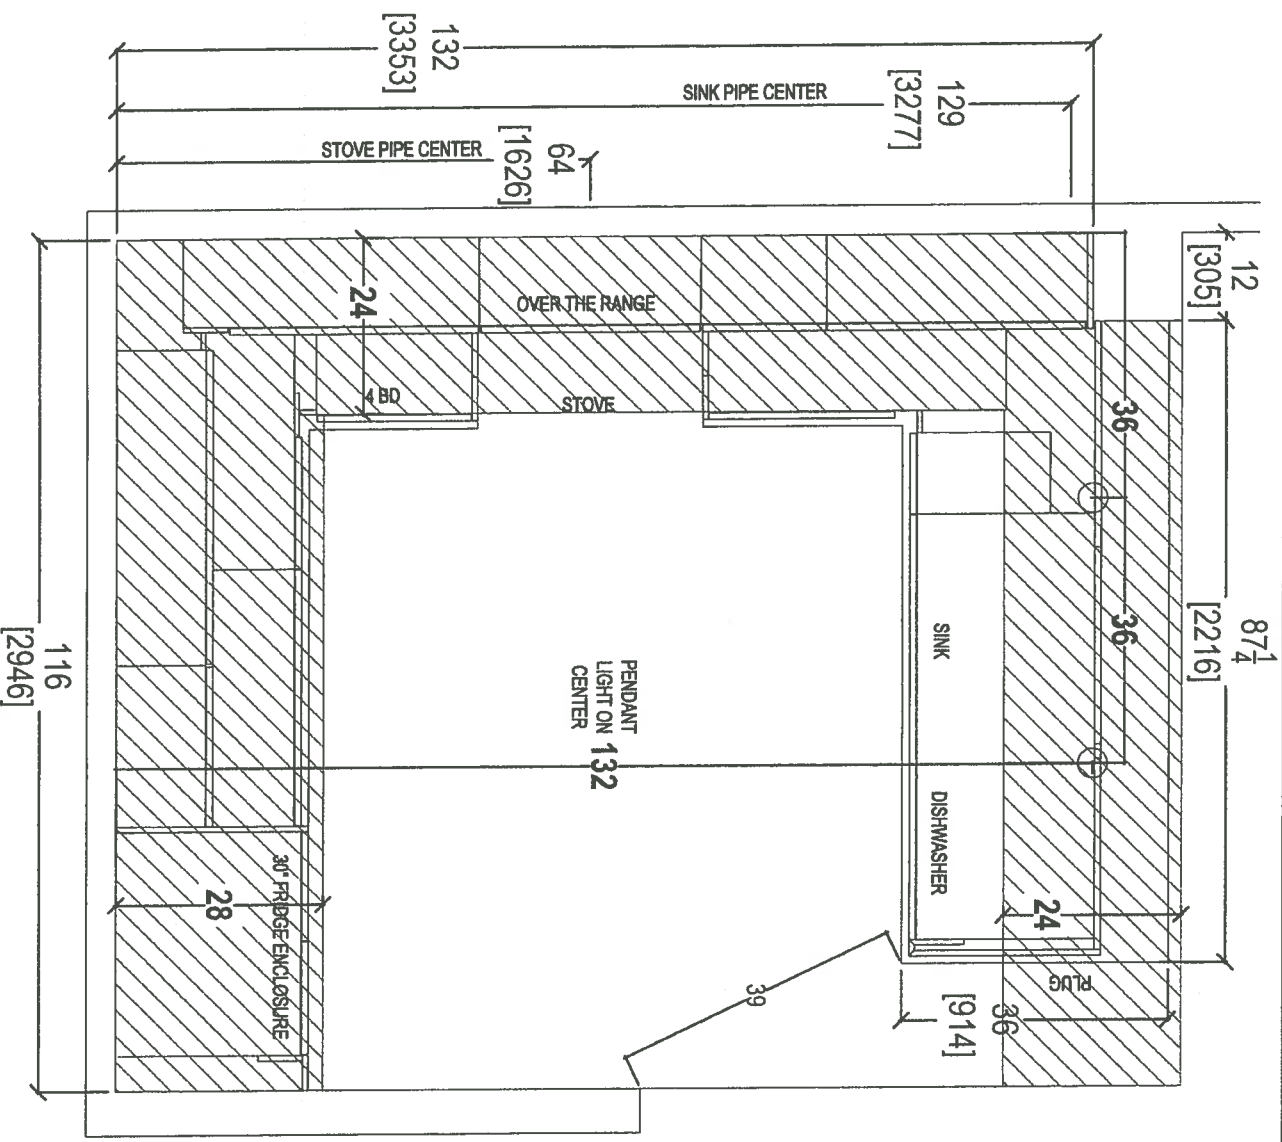

 your kitchen, your taste 80 SANTE DRIVE, VAUGHAN, ON L4K 3C4 T: 416.746.1811 F: 905.761.5901		CLIENT: ROYAL PINE HOMES		UNIT 307 HMP (STANDARD)		ROOM: KITCHEN FLOOR PLAN		DRAWN BY: SK		COMMENTS: PLEASE NOTE ALL DIMENSIONS ARE NOT FINAL AND ARE SUBJECT TO CHANGE UPON FINAL SITE MEASURE	
SITE: HAMPTON PLACE		DOOR STYLE: —		DOOR HANDLE: —		SCALE: 1/2" = 1' - 0"					
PHONE: —		FINISH: —		DRW HANDLE: —		DATE: MAY 9, 2018					
EMAIL: —		SPECIES: —		TOP: —		PAGE: —					

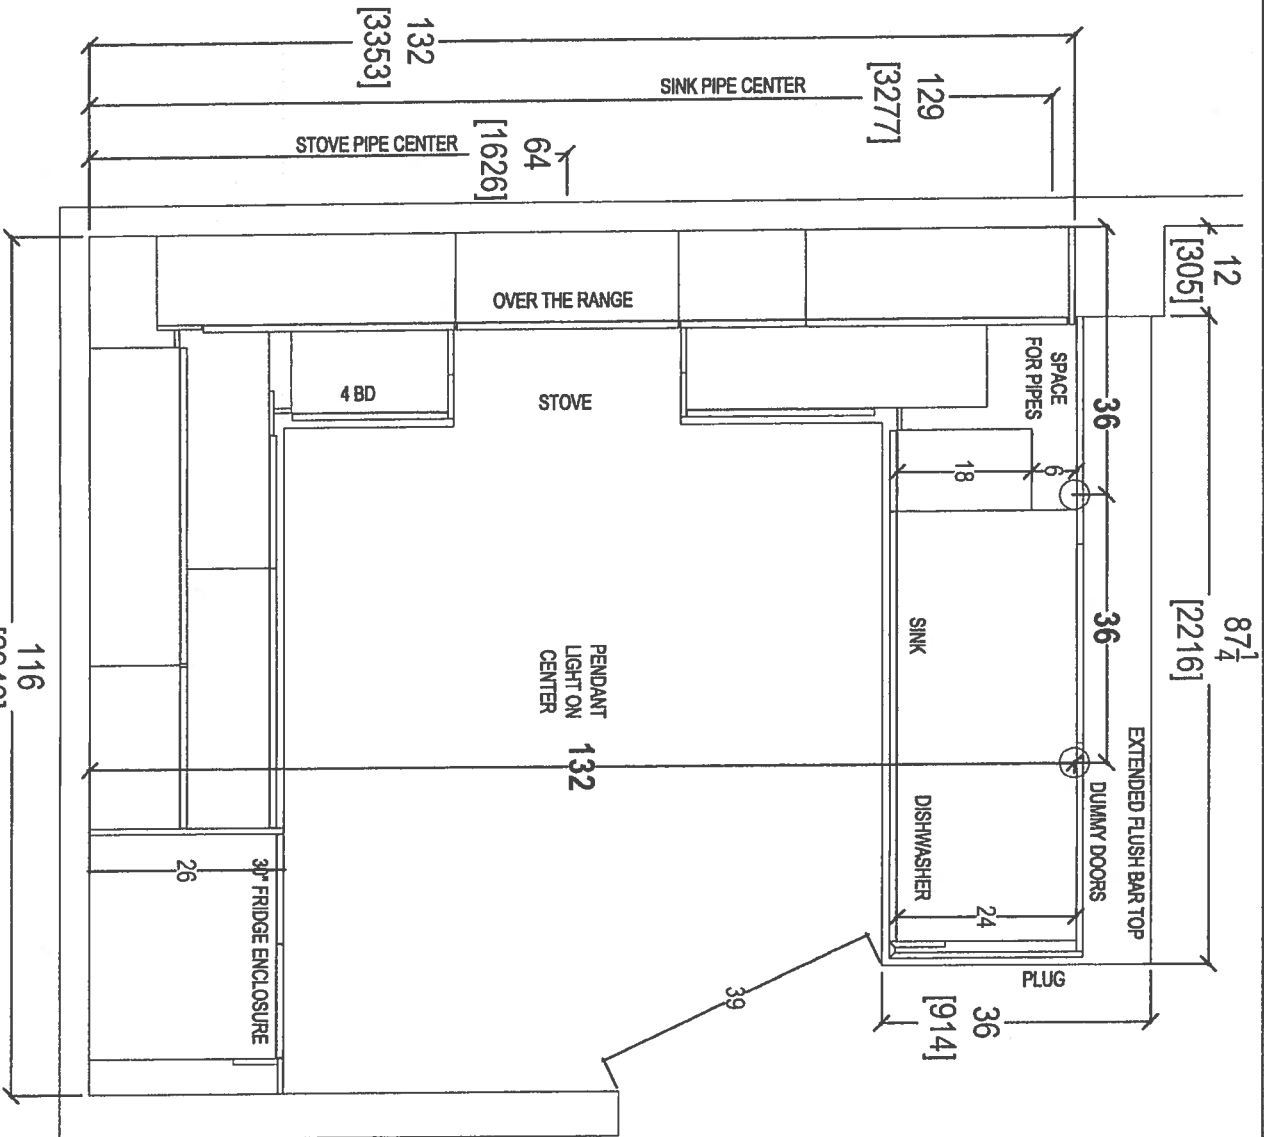


116
[2946]

CLIENT: ROYAL PINE HOMES	UNIT 307 HMP (STANDARD)	ROOM: KITCHEN FLOOR PLAN	DRAWN BY: SK
SITE: HAMPTON PLACE	DOOR STYLE: —	DOOR HANDLE: —	SCALE: 1/2" = 1' - 0"
PHONE: —	FINISH: —	DRW HANDLE: —	DATE: MAY 9, 2018
EMAIL: —	SPECIES: —	TOP: —	PAGE: —

COMMENTS:
PLEASE NOTE ALL DIMENSIONS
ARE NOT FINAL AND ARE
SUBJECT TO CHANGE UPON
FINAL SITE MEASURE




your kitchen your life
80 SANTE DRIVE, VAUGHAN, ON L4K 3C4,
T: 416.746.1811 F: 905.761.5901

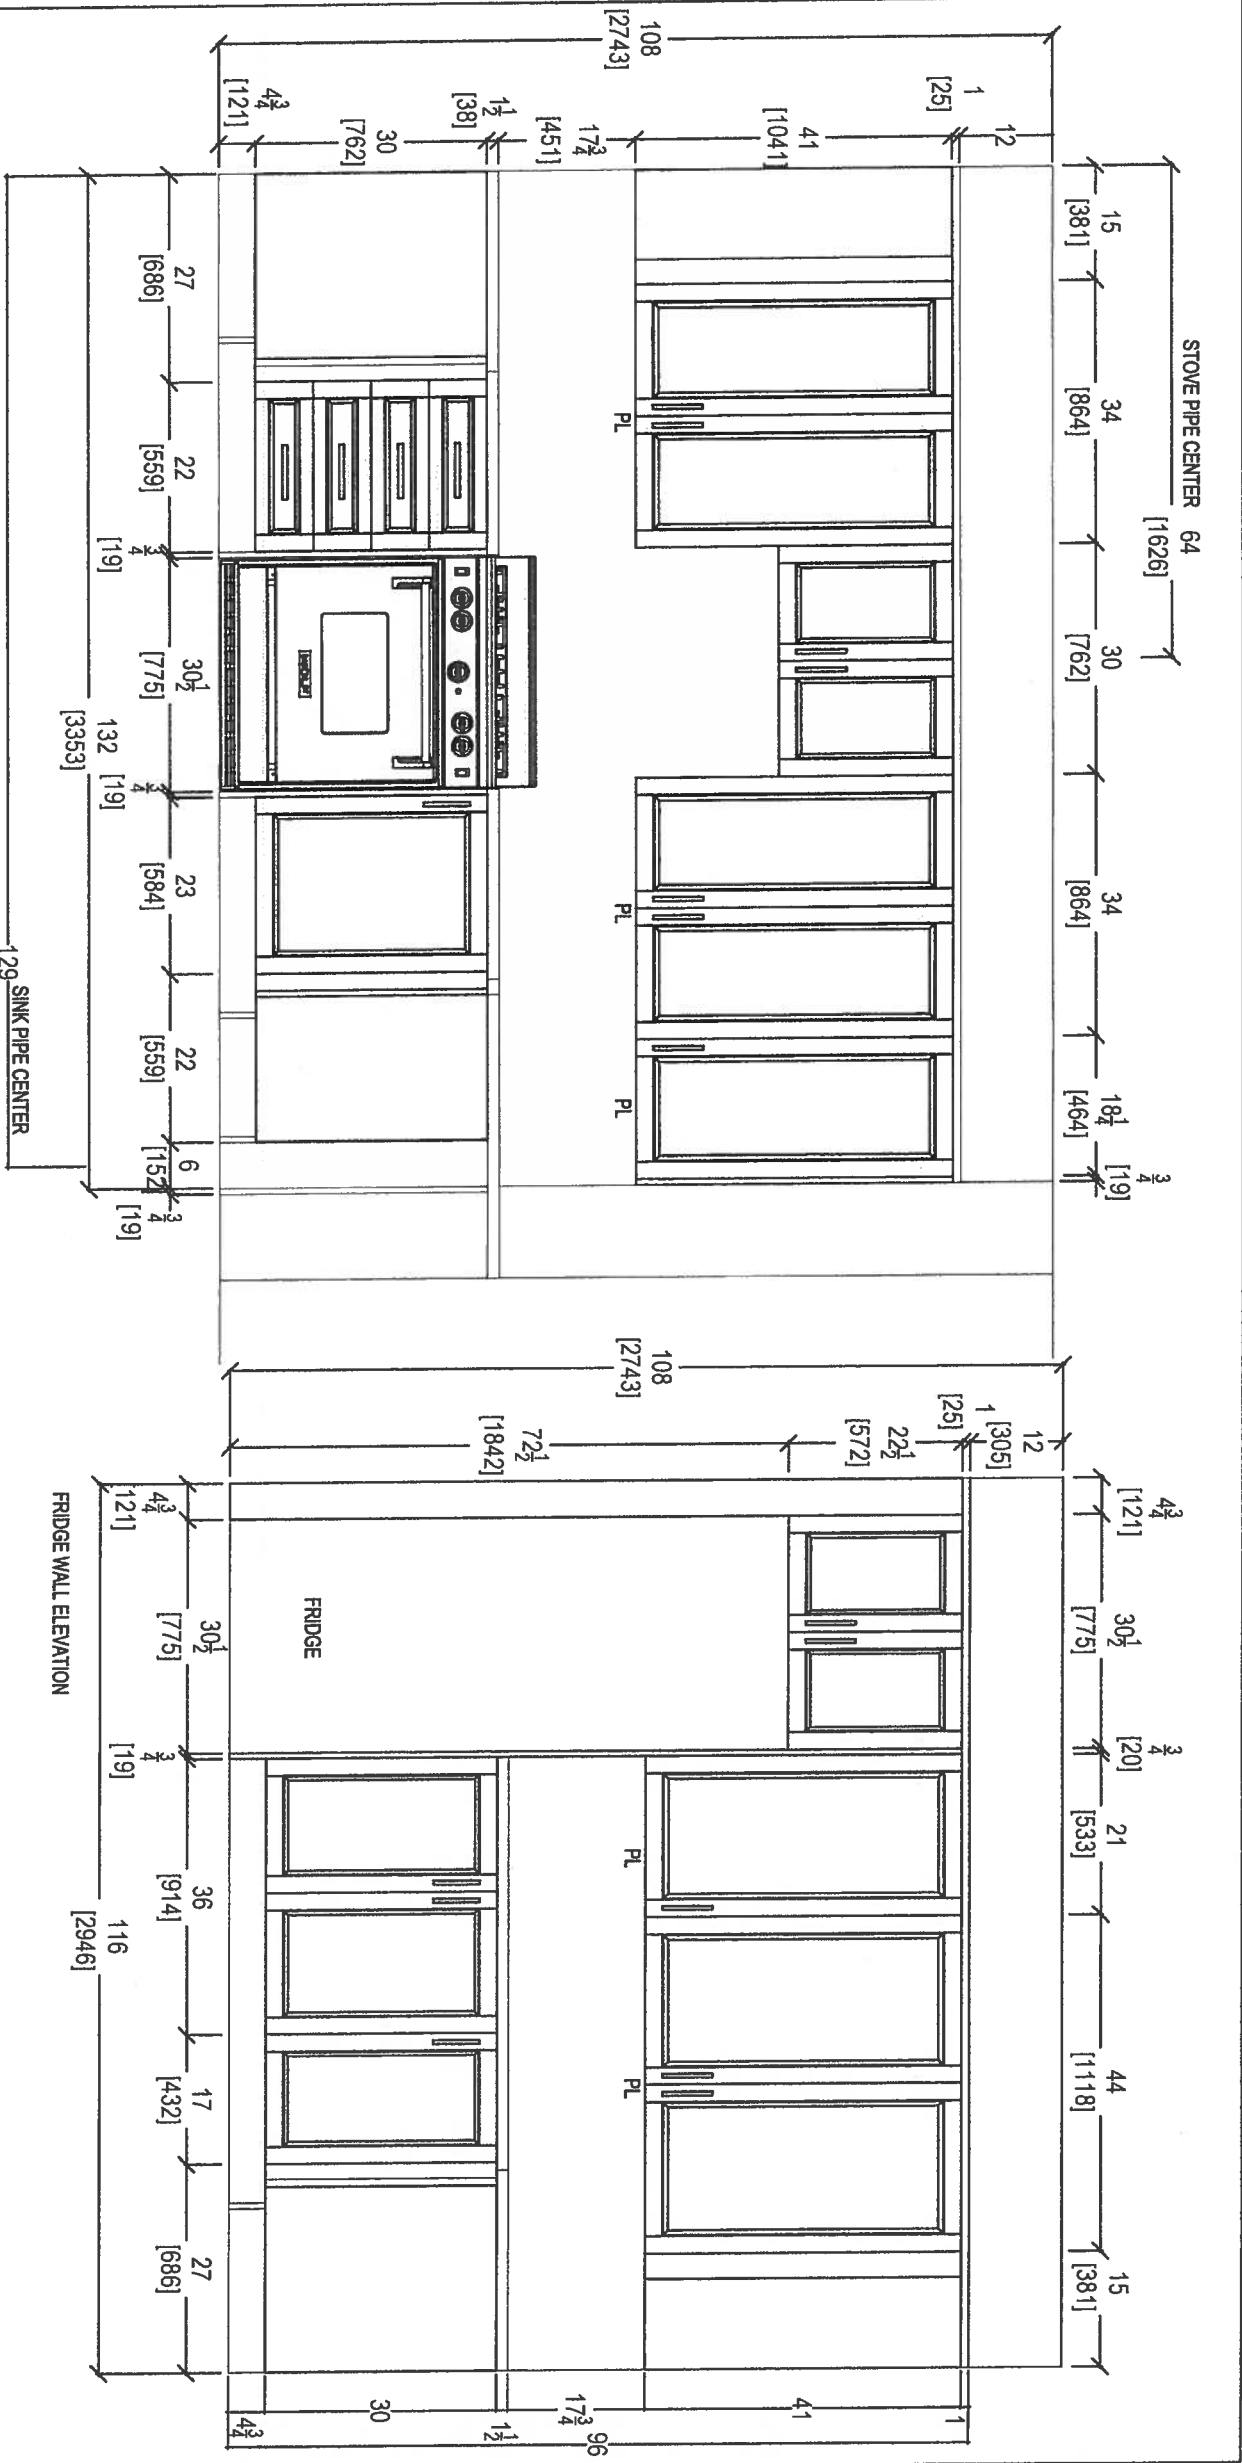


STOVE WALL ELEVATION

FRIDGE WALL ELEVATION

 your kitchen. your taste 80 SANTE DRIVE, VAUGHAN, ON L4K 3C4, T: 416.746.1811 F: 905.761.5901		CLIENT: ROYAL PINE HOMES SITE: HAMPTON PLACE PHONE: — EMAIL: —		JOB NAME: UNIT 307 HMP (STANDARD) DOOR STYLE: — FINISH: — SPECIES: —		ROOM: KITCHEN DOOR HANDLE: — DRW HANDLE: — TOP: —		DRAWN BY: SK SCALE: 1/2" = 1' - 0" DATE: MAY 9, 2018 PAGE: —		COMMENTS: PLEASE NOTE ALL DIMENSIONS ARE NOT FINAL AND ARE SUBJECT TO CHANGE UPON FINAL SITE MEASURE	
---	--	--	--	--	--	---	--	--	--	--	--

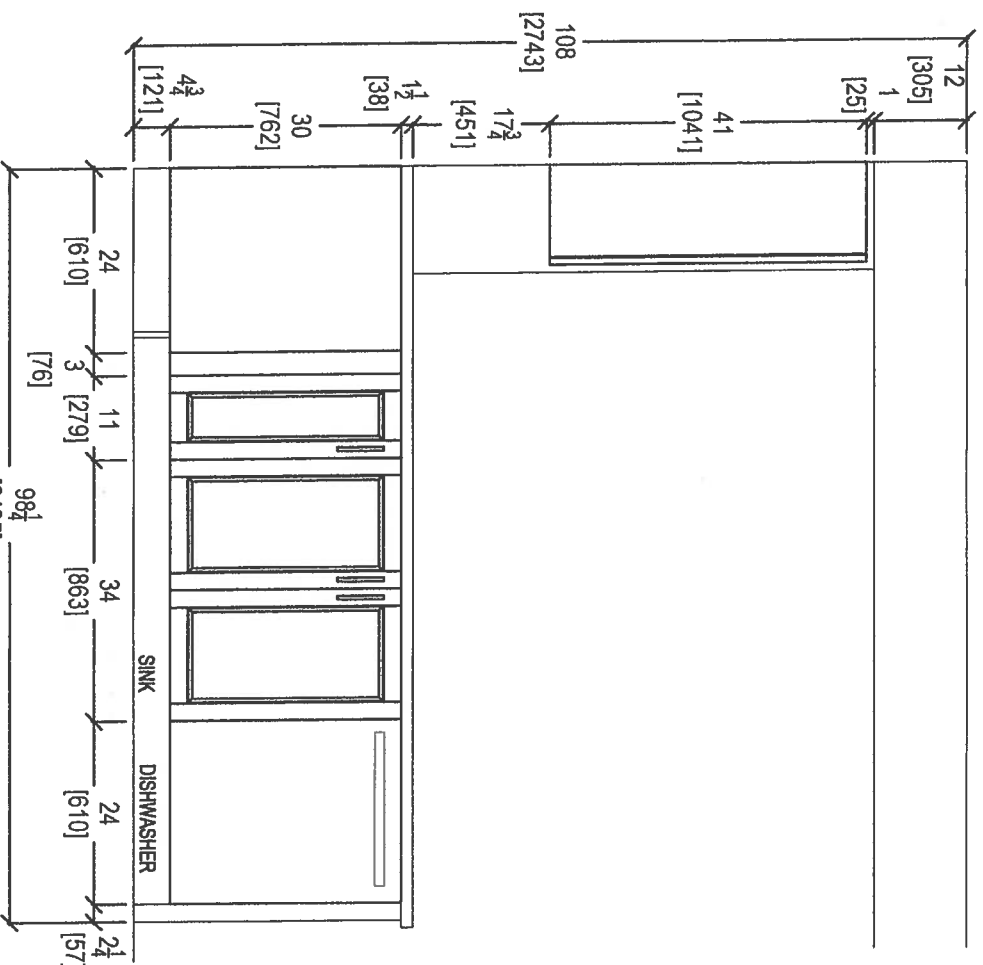

KITCHEN PENINSULA ELEVATION
FRONT VIEW




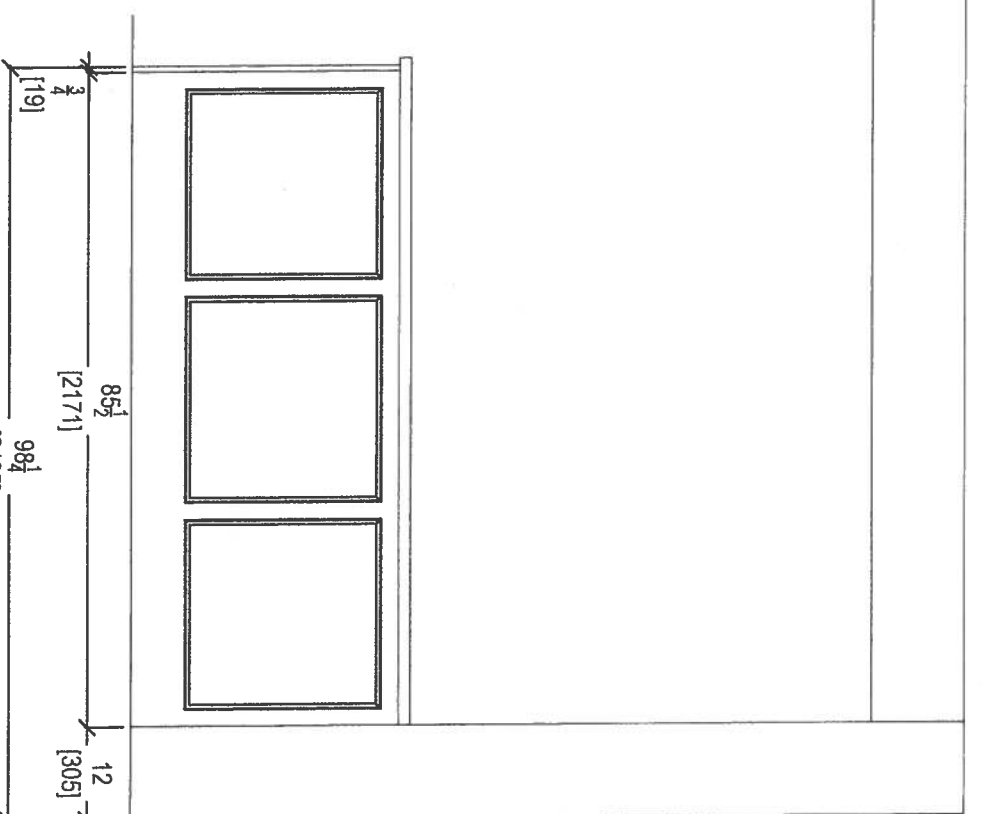


KITCHEN PENINSULA ELEVATION
REAR VIEW



80 SANTE DRIVE, VAUGHAN, ON L4K 3C4,
T: 416.746.1811 F: 905.781.5901

CLIENT: ROYAL PINE HOMES	JOB NAME: UNIT 307 HMP (STANDARD)	ROOM: KITCHEN	DRAWN BY: SK	COMMENTS:
SITE: HAMPTON PLACE	DOOR STYLE: —	DOOR HANDLE: —	SCALE: 1/2" = 1'-0"	PLEASE NOTE ALL DIMENSIONS ARE NOT FINAL AND ARE SUBJECT TO CHANGE UPON FINAL SITE MEASURE
PHONE: —	FINISH: —	DRW HANDLE: —	DATE: MAY 9, 2018	
EMAIL: —	SPECIES: —	TOP: —	PAGE: —	

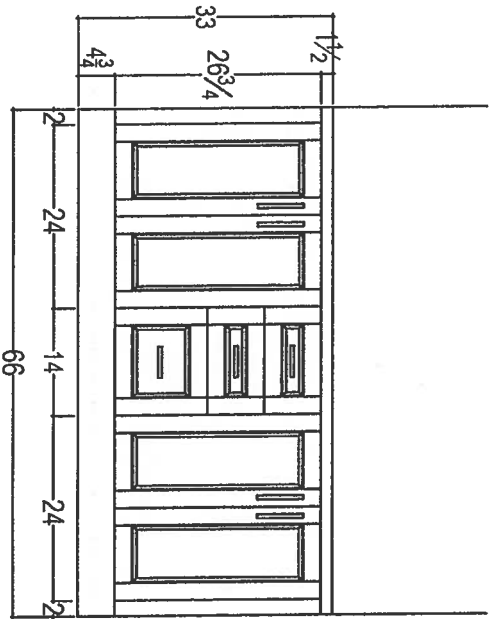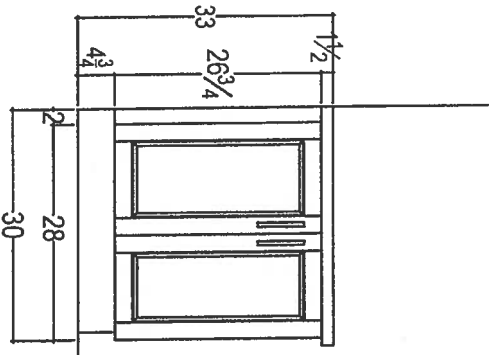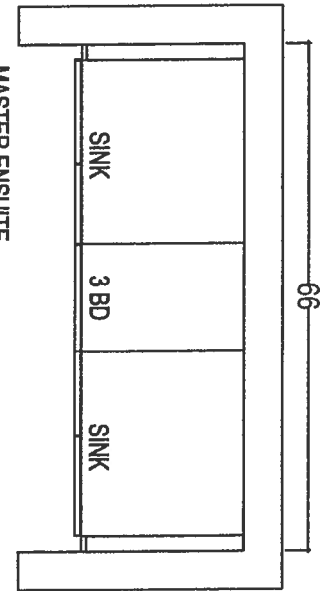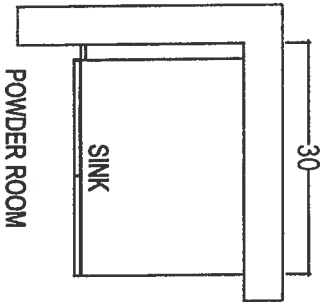


80 SANTE DRIVE, VAUGHAN, ON L4K 3C4,
T: 416.746.1811, F: 905.761.5901

CLIENT: ROYAL PINE HOMES	UNIT 307 HMP (STANDARD)	ROOM: VANITIES	DRAWN BY: SK
SITE: HAMPTON PLACE	DOOR STYLE: —	DOOR HANDLE: —	SCALE: 1/2" = 1' - 0"
PHONE: —	FINISH: —	DRAW HANDLE: —	DATE: MAY 9, 2018
EMAIL: —	SPECIES: —	TOP: —	PAGE: —

COMMENTS:

PLEASE NOTE ALL DIMENSIONS
ARE NOT FINAL AND ARE
SUBJECT TO CHANGE UPON
FINAL SITE MEASURE

* UPGRADE KITCHEN *
* OPTION *

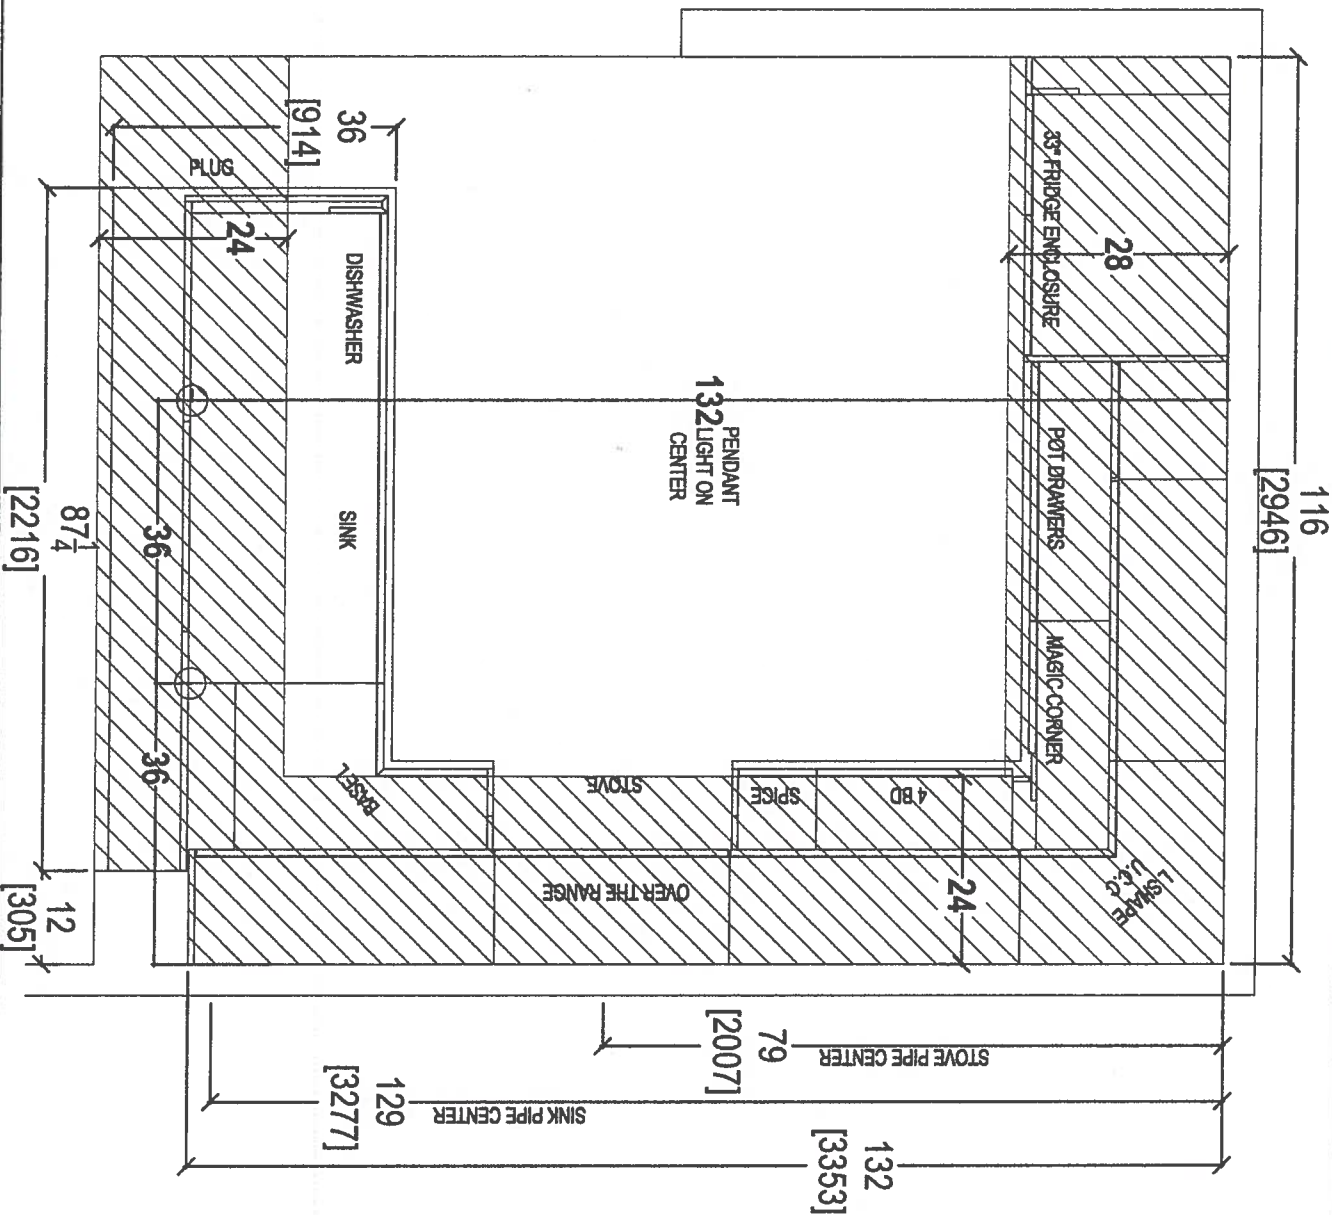

CLIENT: ROYAL PINE HOMES

UNIT 311 HMP

ROOM: KITCHEN FLOOR PLAN

DRAWN BY: SK

SITE: HAMPTON PLACE

DOOR STYLE: —

DOOR HANDLE: —

SCALE: 1/2" = 1'-0"

PHONE: —

FINISH: —

DRW HANDLE: —

DATE: APRIL 25, 2018

EMAIL: —

SPECIES: —

TOP: —

PAGE: —


COMMENTS:

PLEASE NOTE ALL DIMENSIONS
ARE NOT FINAL AND ARE
SUBJECT TO CHANGE UPON
FINAL SITE MEASURE

QTH

Your kitchen, your taste

80 SANTE DRIVE, VAUGHAN, ONT L4K 3C4,
T: 416.746.1811 F: 416.746.1812

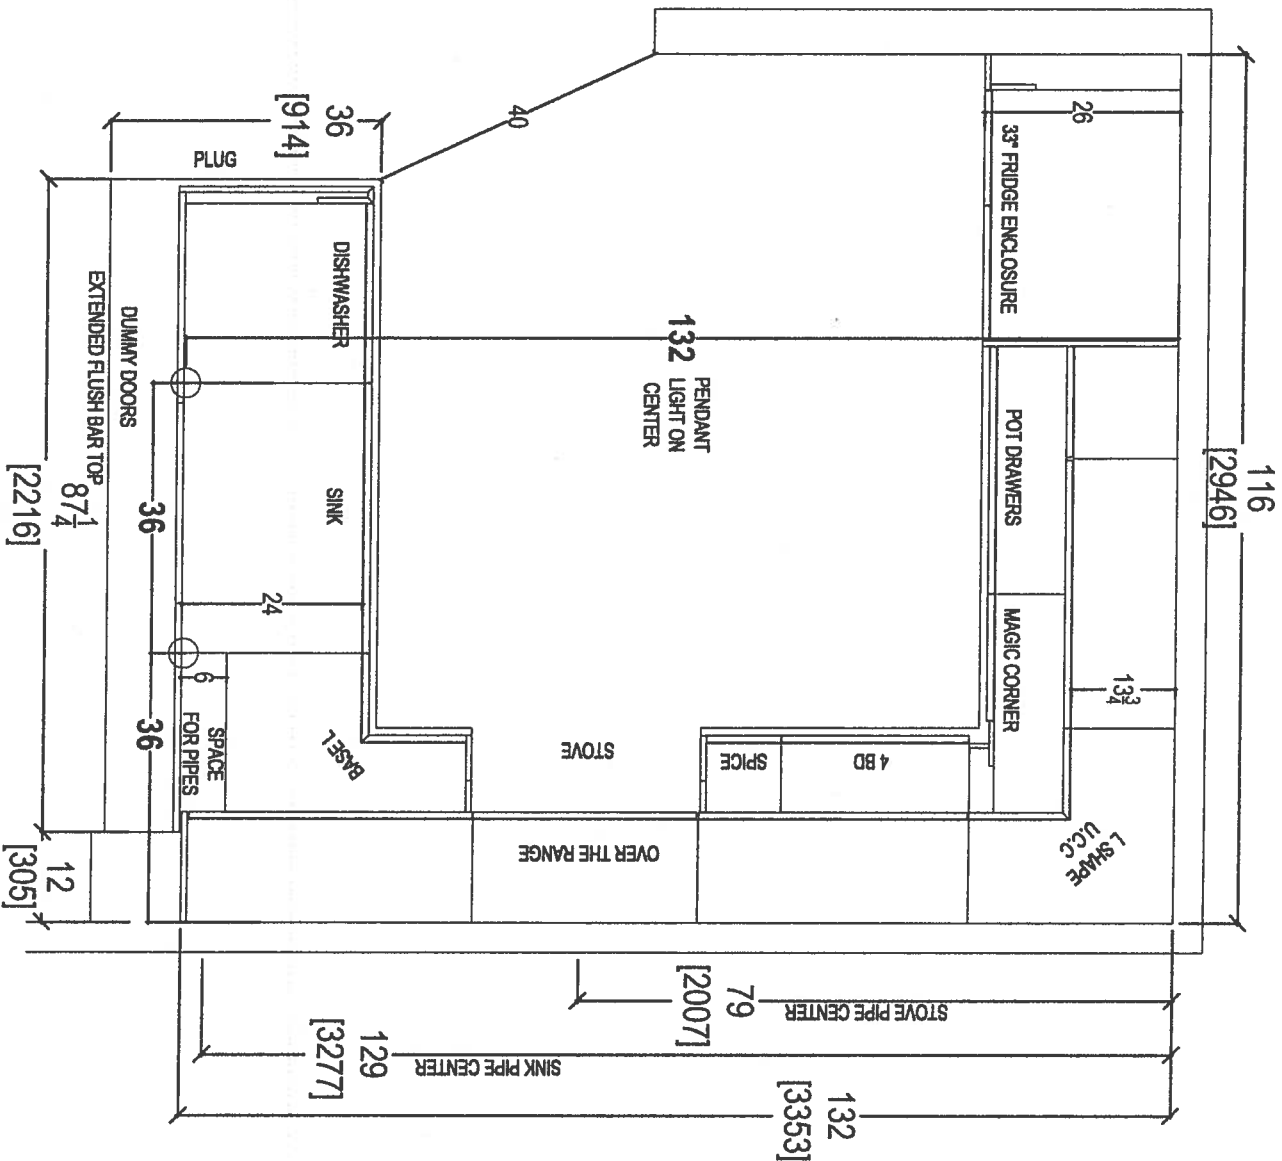

CLIENT: ROYAL PINE HOMES	JOB NAME: UNIT 311 HMP	ROOM: KITCHEN	DRAWN BY: SK
--------------------------	------------------------	---------------	--------------

SITE: HAMPTON PLACE	DOOR STYLE: —	DOOR HANDLE: —	SCALE: 1/2" = 1'-0"
---------------------	---------------	----------------	---------------------


PHONE: —	FINISH: —	DRW HANDLE: —	DATE: APRIL 24, 2018
----------	-----------	---------------	----------------------

EMAIL: —	SPECIES: —	TOP: —	PAGE: —
----------	------------	--------	---------

COMMENTS:
PLEASE NOTE ALL DIMENSIONS
ARE NOT FINAL AND ARE
SUBJECT TO CHANGE UPON
FINAL SITE MEASURE



80 SANTE DRIVE, VAUGHAN, ONTARIO L4K 3C4,
T: 416.746.1811 F: 416.746.1801

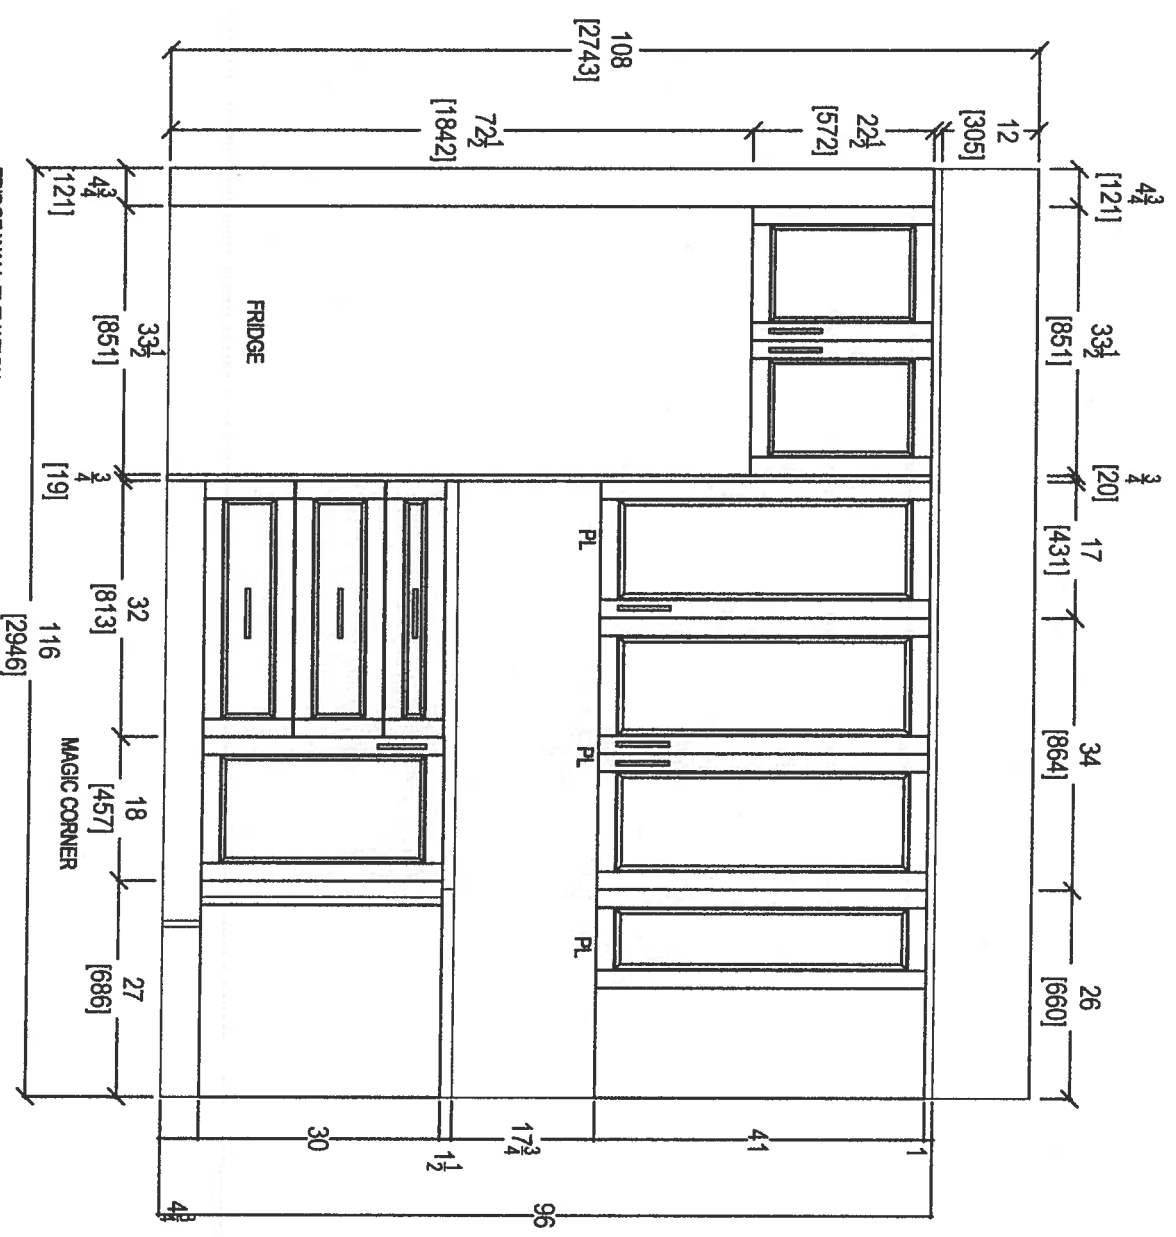

FRIDGE WALL ELEVATION

CLIENT: ROYAL PINE HOMES	JOB NAME: UNIT 311 HMP	ROOM: KITCHEN	DRAWN BY: SK
SITE: HAMPTON PLACE	DOOR STYLE: --	DOOR HANDLE: --	SCALE: 1/2" = 1'-0"
PHONE: --	FINISH: --	DRW HANDLE: --	DATE: APRIL 25, 2018
EMAIL: --	SPECIES: --	TOP: --	PAGE: --


COMMENTS:

PLEASE NOTE ALL DIMENSIONS ARE NOT FINAL AND ARE SUBJECT TO CHANGE UPON FINAL SITE MEASURE



80 SANTE DRIVE, VAUGHAN, ON L4K 3C4
T: 416.746.1811

19

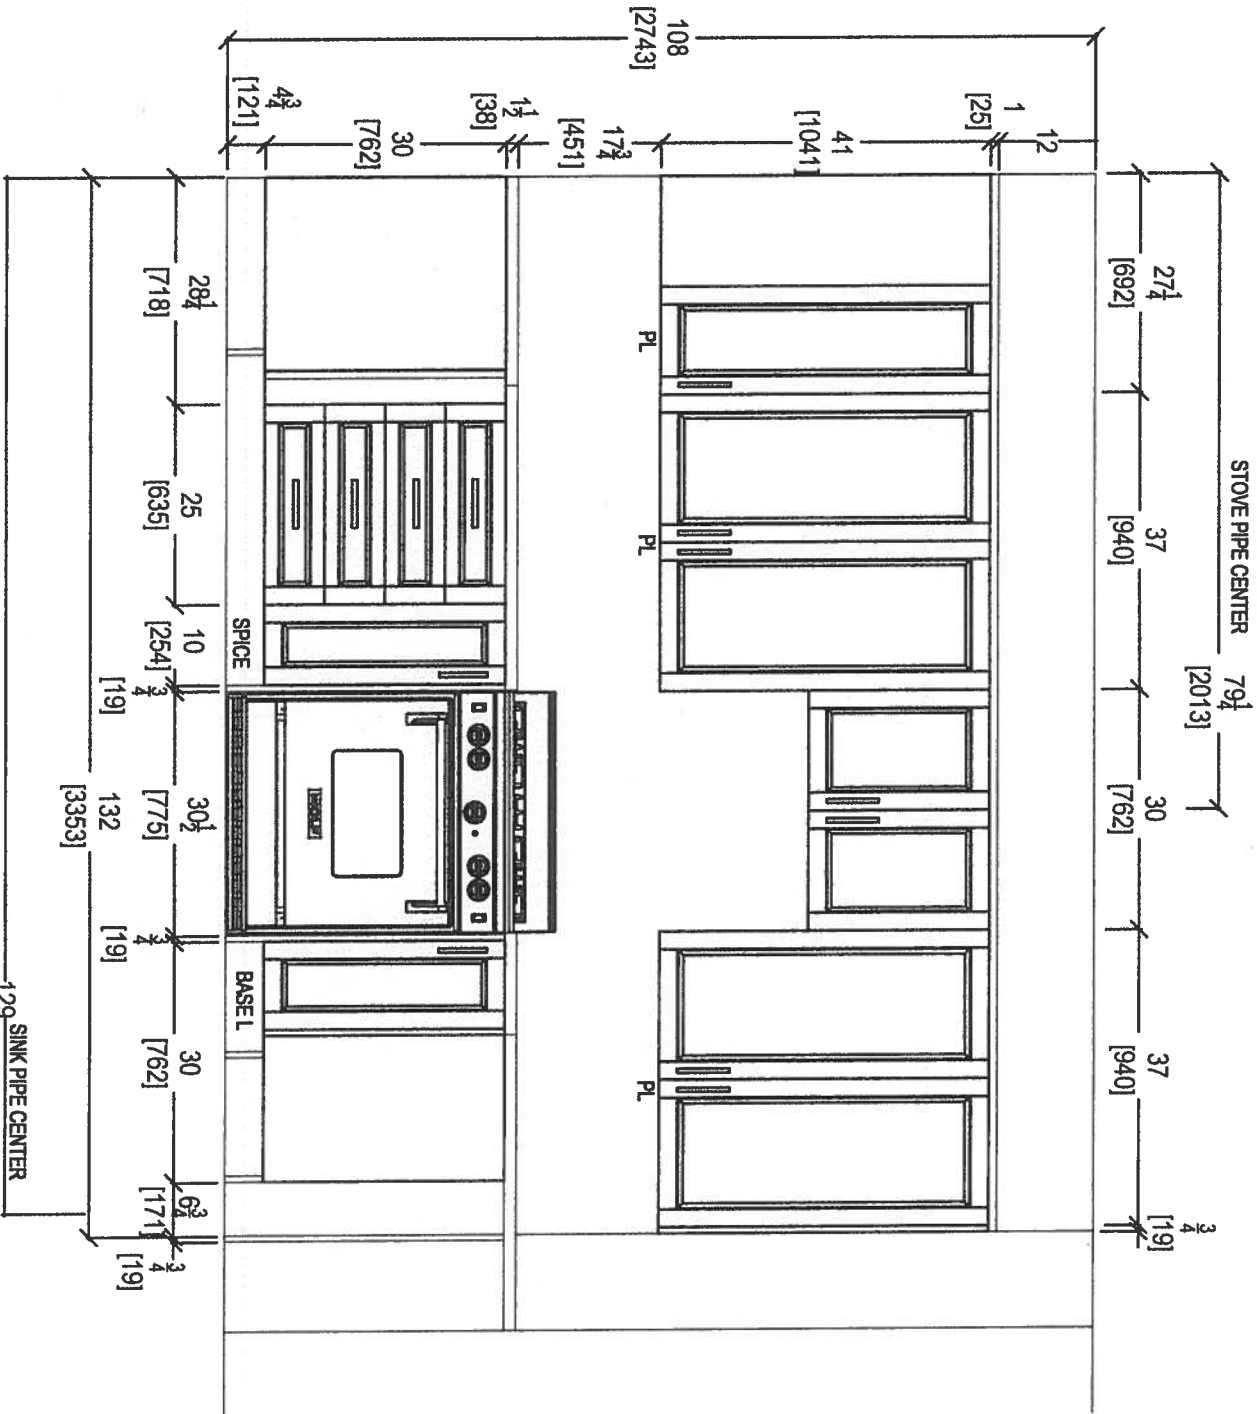


STOVE WALL ELEVATION


CLIENT: ROYAL PINE HOMES		JOB NAME: UNIT 311 HMP		ROOM: KITCHEN		DRAWN BY: SK		COMMENTS:	
SITE: HAMPTON PLACE		DOOR STYLE: —		DOOR HANDLE: —		SCALE: 1/2" = 1'-0"		PLEASE NOTE ALL DIMENSIONS ARE NOT FINAL AND ARE SUBJECT TO CHANGE UPON FINAL SITE MEASURE	
PHONE: —		FINISH: —		DRW HANDLE: —		DATE: APRIL 25, 2018			
EMAIL: —		SPECIES: —		TOP: —		PAGE: —			



80 SANTE DRIVE, VAUGHAN, ONTARIO L4K 3C4,
T: 416.746.1811 F: 416.746.1801

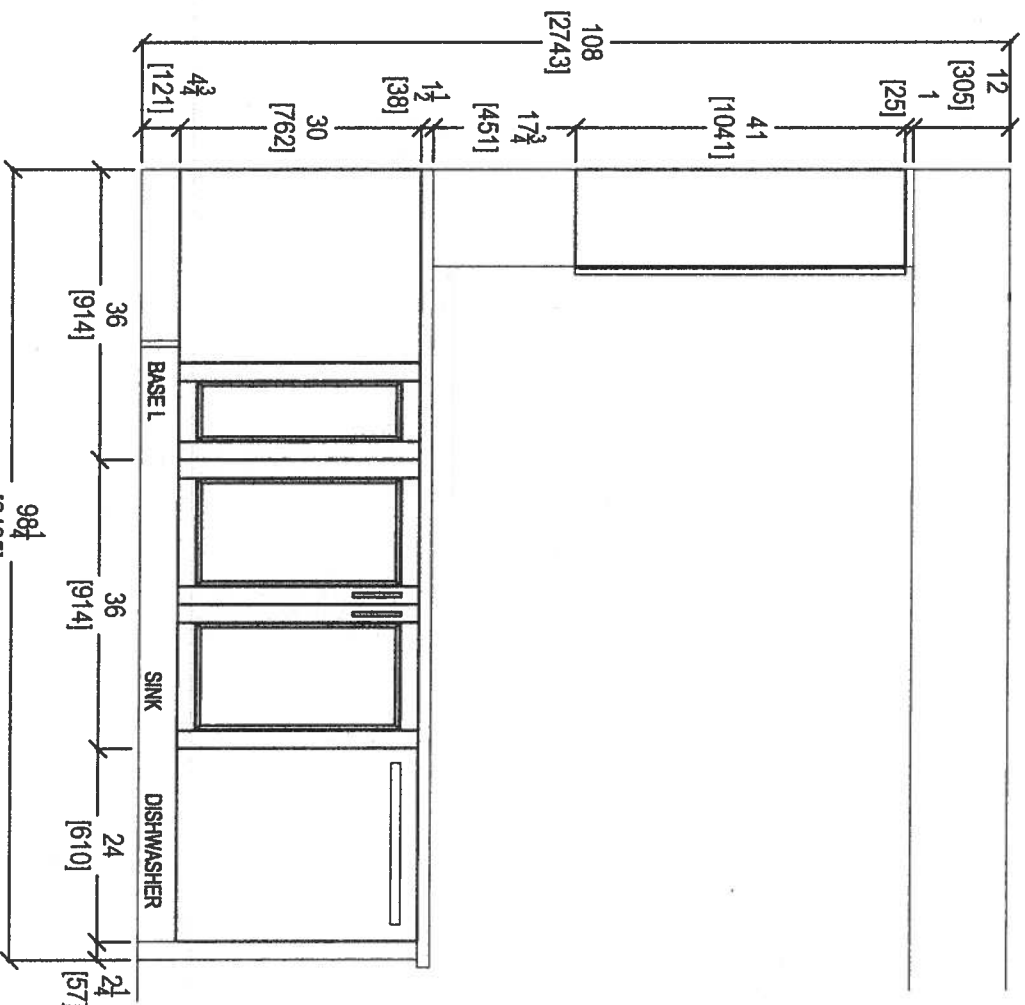





KITCHEN PENINSULA ELEVATION
FRONT VIEW

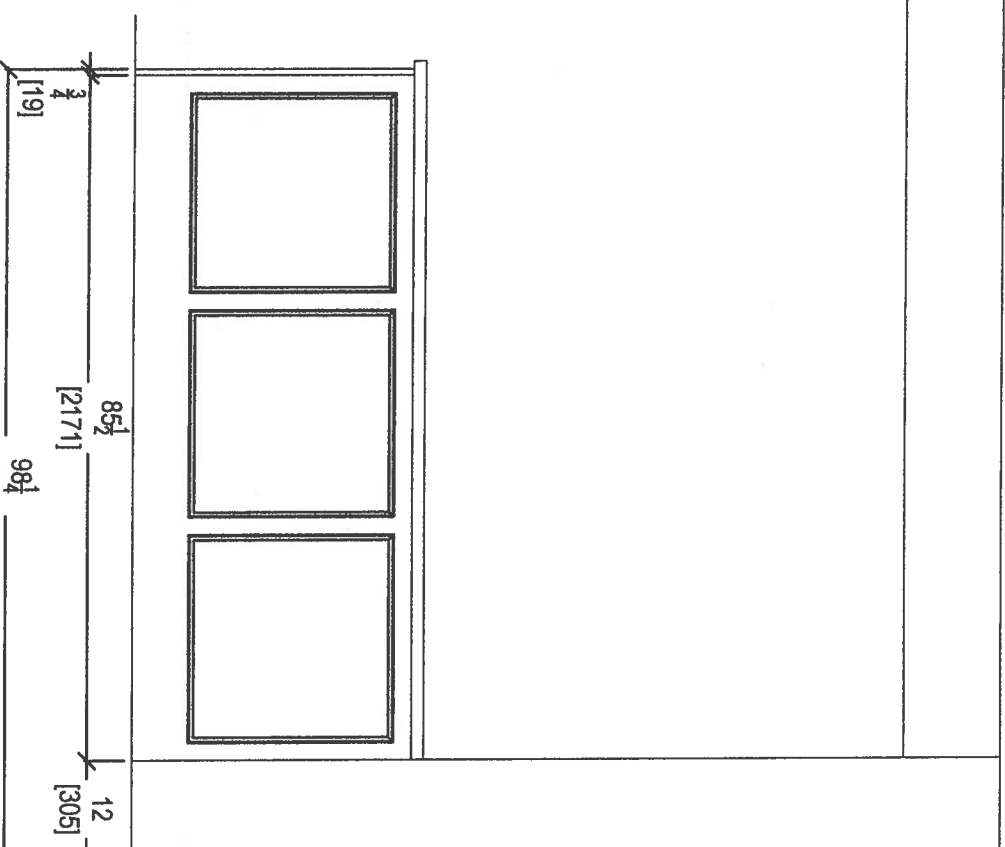

KITCHEN PENINSULA ELEVATION
REAR VIEW

 your kitchen, your taste 80 SANTE DRIVE, VAUGHAN, ON L4K 3C4, T: 416.746.1811 F: 416.746.1801		CLIENT: ROYAL PINE HOMES SITE: HAMPTON PLACE PHONE: — EMAIL: —	JOB NAME: UNIT 311 HMP DOOR STYLE: — FINISH: — SPECIES: —	ROOM: KITCHEN DOOR HANDLE: — DRW HANDLE: — TOP: —	DRAWN BY: SK SCALE: 1/2" = 1' - 0" DATE: APRIL 25, 2018 PAGE: —	COMMENTS: PLEASE NOTE ALL DIMENSIONS ARE NOT FINAL AND ARE SUBJECT TO CHANGE UPON FINAL SITE MEASURE
--	--	--	---	---	---	--

69

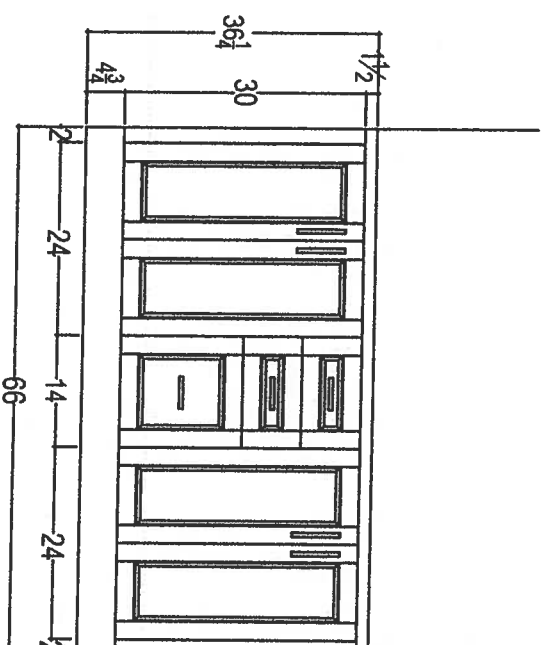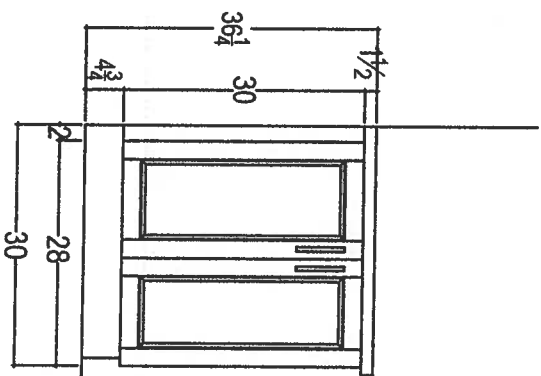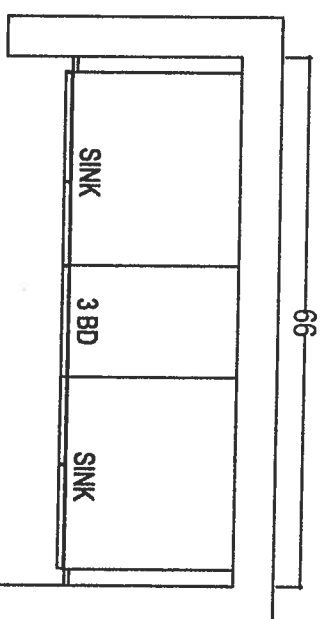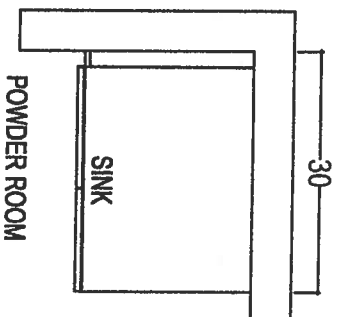

your kitchen, your taste.
80 SANTE DRIVE, VAUGHAN, ON L4K 3C4,
T: 416.746.1817

CLIENT: ROYAL PINE HOMES
SITE: HAMPTON PLACE
PHONE: —
EMAIL: —

UNIT 311 HMP
DOOR STYLE: —
FINISH: —
SPECIES: —

ROOM: VANITIES
DOOR HANDLE: —
DRW HANDLE: —
TOP: —

DRAWN BY: SK
SCALE: 1/2" = 1' - 0"
DATE: APRIL 25, 2018
PAGE: —

COMMENTS:
PLEASE NOTE ALL DIMENSIONS
ARE NOT FINAL AND ARE
SUBJECT TO CHANGE UPON
FINAL SITE MEASURE

69