




# Calverton

SUITE 315  
ORIGINAL BROCHURE

1,169 SQ FT *plus* 260 sq. ft. of balcony area

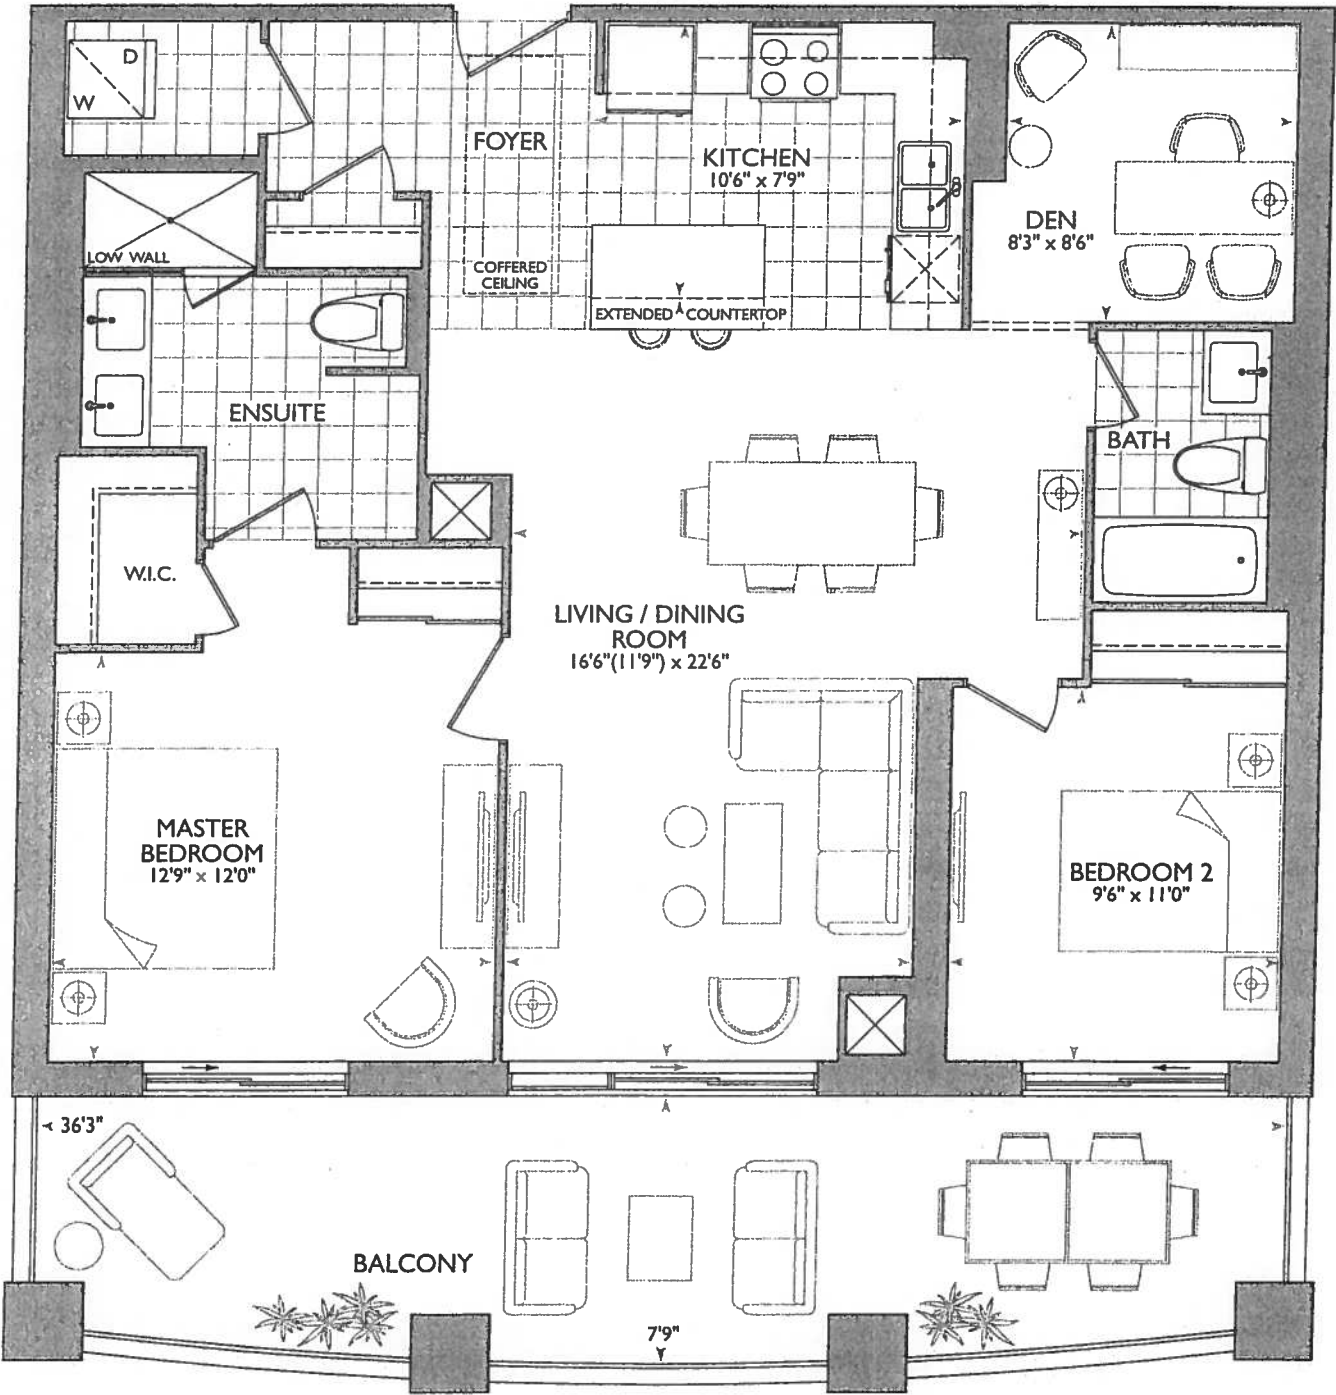

• ADD 2x6 WALL FOR XY/D

\* BARRIER \*  
FREE  
SUITE


- ENSUITE WASHROOM  
Delete LOW  
WALL Keep VANITY  
6" AWAY FROM SHOWER
- ENSUITE SHOWER HEAD  
FROM CEILING.

KITCHEN

- UPG #2 - APPLIANCE PACKAGE
- (2x) = PLUGS ISLAND
- (5x) = PUCK LIGHTS
- 50" = STOVE PIPE CENTER
- 63" = SINK PIPE CENTER

\* Main Bath & Master Ensuite:  
Delete Ceramic Accessories

## FLAT NAIL

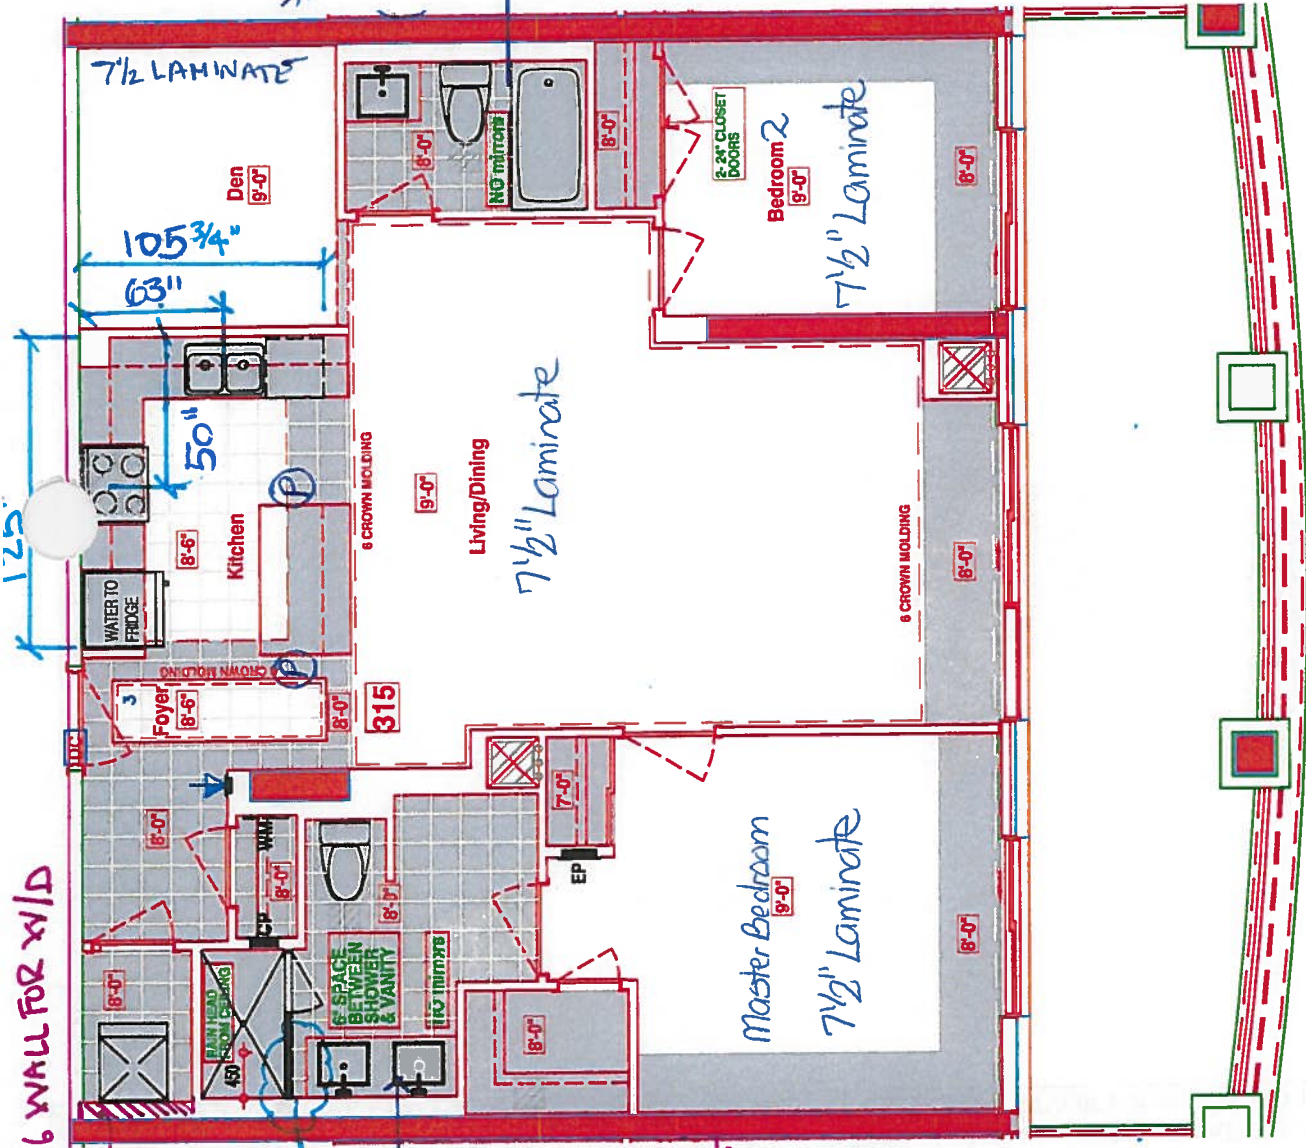

- NOTES:**

1. WATER LINE TO FRIDGE
2. RAIN HEAD FROM CEILING IN ENSUITE
3. 2 DOORS 24" CLOSET DOORS
4. NO MIRRORS IN WASHROOMS

**LEGEND:**

- SECURITY PANEL  
ELECTRICAL PANEL  
COMMUNICATION PANEL  
WATER METER  
FRIDGE  
DROPPED AREA  
6" CROWN MOLDING  
BARRIER FREE SUITE



CONSTRUCTION SUMMARY  
Hampton Place

PURCHASERS: LUIGI CIARDULLO and SANTINA M. CIARDULLO

TEL: RES.: 416-499-0218

| LOT NUMBER | PHASE | HOUSE TYPE | CLOSING DATE |
|------------|-------|------------|--------------|
| 315        | 1     | CALVERTON  | 28-Sep-18    |

|                   |                                                                                                                                 |
|-------------------|---------------------------------------------------------------------------------------------------------------------------------|
| Offer<br>Workshee | PURCHASER TO RECEIVE \$5,000(INCLUDES APPLICABLE TAXES) WORTH OF UPGRADES AT THE DECOR CENTER AT TIME OF COLOUR CHART.<br>Note: |
|-------------------|---------------------------------------------------------------------------------------------------------------------------------|

|                   |                                                               |
|-------------------|---------------------------------------------------------------|
| Offer<br>Workshee | TANDEM PARKING SPACE IN LIEU OF SINGLE PARKING SPACE<br>Note: |
|-------------------|---------------------------------------------------------------|

|                  |                               |
|------------------|-------------------------------|
| Offer<br>Upgrade | WATER LINE TO FRIDGE<br>Note: |
|------------------|-------------------------------|

|                  |                                                                                         |
|------------------|-----------------------------------------------------------------------------------------|
| Offer<br>Upgrade | RAINHEAD FROM CEILING IN MASTER ENSUITE SHOWER , FROM VENDORS STANDARD SAMPLES<br>Note: |
|------------------|-----------------------------------------------------------------------------------------|

|                  |                                                                         |
|------------------|-------------------------------------------------------------------------|
| Offer<br>Upgrade | BUILDER NOT TO INSTALL MIRRORS IN MAIN BATH AND MASTER ENSUITE<br>Note: |
|------------------|-------------------------------------------------------------------------|

|                  |                                                                                                           |
|------------------|-----------------------------------------------------------------------------------------------------------|
| Offer<br>Upgrade | REPLACE GLASS SLIDERS IN BEDROOM 2 WITH STANDARD SWING DOORS AS PER VENDORS SAMPLES (SET OF TWO)<br>Note: |
|------------------|-----------------------------------------------------------------------------------------------------------|





SITE COPY

CONSTRUCTION SUMMARY

Hampton Place

PURCHASERS: LUIGI CIARDULLO and SANTINA M. CIARDULLO

TEL: RES.: 416-499-0218

|            |       |            |              |
|------------|-------|------------|--------------|
| LOT NUMBER | PHASE | HOUSE TYPE | CLOSING DATE |
| 315        | 1     | CALVERTON  | 28-Sep-18    |

Date Added: 13-Feb-18      Invoice Number: 7108

1 - KITCHEN - Install ONE (1) ADDITIONAL PUCK LIGHTS (Same Switch as Standard Puck Lights) at kitchen. To be installed below kitchen cabinetry, where applicable. (See Attached QTK Layout for Locations)  
Purchaser Paying Difference for Additional Puck Lights - Standard Kitchen to Receive Four (4) Puck Lights - Revised Standard Kitchen Requires Five (5) Puck Lights

1 - PURCHASER AWARE AND ACCEPTS THAT ANY CHANGES MADE TO UPGRADES AFTER SIGNING THIS PURCHASERS EXTRA FORM ARE SUBJECT TO A MINIMUM ADMINISTRATION FEE OF \$1,000 PLUS A 10% HOLDBACK FEE.  
Note:

Date Added: 06-Dec-17      Invoice Number: 7039

1 - KITCHEN & BATHROOMS - Purchaser has DECLINED All Upgrades offered during decor appointment at the decor centre for kitchen & bathroom cabinetry. Standard Kitchen Layout & Standard Bathroom Vanities to be installed as per standard plan. (See Sketch)  
Note:

1 - KITCHEN - CABINETRY - Install UPGRADE PACKAGE #1 - Category 3 Fiberboard Stormy Monday QT 4401 - To be installed throughout kitchen, where applicable. (See Sketch)  
Note:

1 - KITCHEN - Install 1ST UPGRADE CAESARSTONE COUNTERTOP - 4141 MISTY CARRARA - To be installed throughout kitchen, where applicable. (does not include backsplash) (See Sketch)  
Note:

1 - KITCHEN - Countertop Edging - Install UPGRADE " M " EDGING - Throughout kitchen countertop, where applicable. (See Sketch)  
Note:

1 - DISCLAIMER - STONE COUNTERTOP;  
KITCHEN - Stone slabs vary in size & all seams are visible & the fabricator reserves the right to position the seams as necessary.  
Note:

1 - KITCHEN - Kitchen Backsplash - Install 1ST UPGRADE BACKSPLASH - 12x12 CLOUD RANDOM STRIP GLASS MOSAICS - To be installed throughout kitchen, where applicable. (Does not include behind the fridge or stove) (See Sketch)  
Note:

1 - KITCHEN - Kitchen Sink - Install Standard Undermount Sink - BLANCO Horizon Plus U2 Undermount Sink - Model # 401234  
Note:

1 - KITCHEN - Kitchen Faucet - Install Standard Faucet - DELTA Chrome Pull-Out Kitchen Faucet (Single Hole) - Model # 469LF-Chrome  
Note:

1 - APPLIANCE PACKAGE - Install Upgrade Appliance Package - UPGRADE PACKAGE # 2 - To be installed throughout suite, where applicable. (See Sketch)  
Note:

1 - MASTER ENSUITE - Install Standard Granite Countertop - BIANCO ANTICO - To be installed throughout master ensuite vanity countertop, where applicable. (Includes 3" Splash)  
Note:

1 - DISCLAIMER - GRANITE COUNTERTOP;  
MASTER ENSUITE - Due to the many variables that can affect the pattern, colour and/or design and "pitting" of natural products, granite installed will not be identical to the samples displayed.  
Note: Every effort is made to provide granite countertops as close as possible but the vendor is not responsible for results which differ from the sample displayed. All countertop surfaces may have seams, and product pattern and shade can change in areas containing seams.

1 - CLARIFICATION;  
MAIN BATH & MASTER ENSUITE - Install Standard 3" Splash throughout Main Bath and Master Ensuite Vanity Countertops, where applicable. (See Sketch)  
Note:



SITE COPY

CONSTRUCTION SUMMARY

Hampton Place

PURCHASERS: LUIGI CIARDULLO and SANTINA M. CIARDULLO

TEL: RES.: 416-499-0218

|            |       |            |              |
|------------|-------|------------|--------------|
| LOT NUMBER | PHASE | HOUSE TYPE | CLOSING DATE |
| 315        | 1     | CALVERTON  | 28-Sep-18    |

Date Added: 06-Dec-17

Invoice Number: 7039

1 - DISCLAIMER - STONE COUNTERTOP;  
MAIN BATH & MASTER ENSUITE - Stone slabs vary in size & all seams are visible & the fabricator reserves the right to position the seams as necessary.

1 - CLARIFICATION;  
MASTER ENSUITE - Master Ensuite Vanity to be approx. 6" away from shower stall at master ensuite. (See Sketch)  
Note: As per Fonzie C.

1 - MAIN BATH & MASTER ENSUITE - DELETE Do Not Install / Supply / Credit Purchaser for builders standard ceramic bathroom accessories (toilet paper, towel bar & soap dish) throughout all bathrooms where applicable.  
Note: To Include; Main Bath & Master Ensuite (See Sketch)

1 - CLARIFICATION - REFER TO APAS;  
MASTER ENSUITE - Install Rain Shower Head from Ceiling at Master Ensuite Shower Stall - DELTA - Shower Trim and Hansgrohe Slide Bar with Handheld and Ceiling Mount Showerhead  
Note: Model # R10000 / T13020-CDN/27454002 / 277440 / RP52382 / RP46870 / RP6025 / R11000 / T11800 - Chrome (See Sketch)

1 - CLARIFICATION;  
MAIN BATH & MASTER ENSUITE - Install Standard Plumbing Fixtures throughout Main Bath and Master Ensuite, where applicable. (See Sketch)  
Note:

1 - CLARIFICATION;  
MASTER ENSUITE - Purchaser accepts & acknowledges the standard frameless glass enclosure at master ensuite shower stall will NOT touch the ceiling and will receive a Standard Chrome Header. (See Sketch)  
Note:

1 - BONUS PACKAGE - PURCHASER HAS APPLIED \$536.50 (Includes Taxes) WORTH OF UPGRADE PROMOTIONAL PACKAGE TOWARDS THE PURCHASE OF UPGRADES COMPLETED AT THE DECOR CENTRE.  
Note:

1 - PURCHASER HAS ATTENDED A COLOR APPOINTMENT AT THE DECOR CENTRE AND HAS DECLINED ANY ADDITIONAL UPGRADES. Purchaser accepts and acknowledges that there will be no further changes/additions/deletions to be made upon signing on December 6,2017  
Note:

1 - PURCHASER AWARE AND ACCEPTS THAT ANY CHANGES MADE TO UPGRADES AFTER SIGNING THIS PURCHASERS EXTRA FORM ARE SUBJECT TO A MINIMUM ADMINISTRATION FEE OF \$1,000 PLUS A 10% HOLDBACK FEE.  
Note:

This Document is Extremely Time Sensitive - Printed 16 Feb 18 at 14:15

Unit

100

### BEDROOM 3

## Notes

Printed Dec 06, 2017 10:37 am



OUR SCHEME

INTERIOR

Telephone Res. / Bus

Project

Closing Date

Unit

Purchasers

Decor Consultant

Model Type

Telephone Res. / Bus

Project

Closing Date

Unit

LUIGI CIARDULLO & SANTINA M. CIARDULLO

Melissa Di Martino

CALVERTON

(416) 499-0218 /

Hampton Place

28/09/2018

315

Page 2 of 3

CABINETRY, VANITIES AND COUNTERTOPS

|                   | Countertop                                                                                |                                     | Counter Edge                         |                | Handle / Knob |
|-------------------|-------------------------------------------------------------------------------------------|-------------------------------------|--------------------------------------|----------------|---------------|
|                   | Style                                                                                     |                                     |                                      |                |               |
| MAIN BATHROOM     | <input checked="" type="checkbox"/> CATEGORY 2 - MAPLE - CHESTNUT QT 2503 (STD)           | <input checked="" type="checkbox"/> | ASPEN TERRA WHITE (STD)              | A " EDGE (STD) | 16338-195     |
| MASTER ENSUITE    | <input checked="" type="checkbox"/> CATEGORY 1 - FIBERBOARD - WHITE QT 1203 (STD)         | <input checked="" type="checkbox"/> | BIANCO ANTICO GRANITE (STD)          | A " EDGE (STD) | 16338-195     |
| POWDER ROOM       | N/A                                                                                       |                                     | N/A                                  | N/A            | N/A           |
| KITCHEN / DINETTE | <input checked="" type="checkbox"/> CATEGORY 3 - FIBERBOARD - STORMY MONDAY QT 4401 (UPG) | <input checked="" type="checkbox"/> | 4141 Misty Carrara CaesarStone (Upg) | M " EDGE (UPG) | 3487-128      |
| LAUNDRY ROOM      | N/A                                                                                       |                                     | N/A                                  | N/A            | N/A           |
|                   |                                                                                           |                                     |                                      |                |               |
|                   |                                                                                           |                                     |                                      |                |               |

APPLIANCE PACKAGE

Upgrade  
Package #2

Std 31in Opening

PLUMBING FIXTURES

|                |                                              |
|----------------|----------------------------------------------|
| KITCHEN        |                                              |
| Sink Model     | <input checked="" type="checkbox"/> STANDARD |
| Sink Faucet    | <input checked="" type="checkbox"/> STANDARD |
| TOILETS        |                                              |
| Master Ensuite | <input checked="" type="checkbox"/> STANDARD |
| Main Bathroom  | <input checked="" type="checkbox"/> STANDARD |
| Powder Room    | N/A                                          |
| VANITY FAUCETS |                                              |
| Master Ensuite | <input checked="" type="checkbox"/> STANDARD |
| Main Bathroom  | <input checked="" type="checkbox"/> STANDARD |
| Powder Room    | N/A                                          |

VANITY SINKS

|                |                                              |
|----------------|----------------------------------------------|
| Master Ensuite | <input checked="" type="checkbox"/> STANDARD |
| Main Bathroom  | <input checked="" type="checkbox"/> STANDARD |
| Powder Room    | N/A                                          |

SHOWER STALL / TUBS

|                             |                                              |
|-----------------------------|----------------------------------------------|
| Master Ensuite Shower Stall | <input checked="" type="checkbox"/> STANDARD |
| Master Ensuite Tub          | N/A                                          |
| Main Bathroom Tub           | <input checked="" type="checkbox"/> STANDARD |

Trim

|                    |                                                                |
|--------------------|----------------------------------------------------------------|
| Baseboard & Casing | <input checked="" type="checkbox"/> STANDARD                   |
| Interior Doors     | <input checked="" type="checkbox"/> STANDARD - CARRARA, SMOOTH |

Levers

|             |                                              |
|-------------|----------------------------------------------|
| Door Height | <input checked="" type="checkbox"/> STANDARD |
|-------------|----------------------------------------------|

Cornice Moulding / Medallion

|                |                                                         |
|----------------|---------------------------------------------------------|
| Foyer          | <input checked="" type="checkbox"/> STANDARD - #CTR-611 |
| Living Room    | <input checked="" type="checkbox"/> STANDARD - #CTR-611 |
| Dining Room    | <input checked="" type="checkbox"/> STANDARD - #CTR-611 |
| Den            | NONE                                                    |
| Master Bedroom | NONE                                                    |
| Bedroom 2      | NONE                                                    |
| Bedroom 3      | N/A                                                     |

Fireplace

|                   |     |
|-------------------|-----|
| Fireplace         | N/A |
| Location Flooring | N/A |
| Style             | N/A |
| Finish            | N/A |
| Marble            | N/A |
| Hearth            | N/A |

MISC. INSTALLATIONS

Ceramic Accessories  
(installed by Vendor)  
☒ Yes ☐ No

Bathroom Mirrors  
(installed by Vendor)  
☒ Yes ☐ No

Wire Shelving - Closet  
(installed by Vendor)  
☒ Yes ☐ No

Paint Throughout

Walls

STANDARD - BIRCH WHITE

Trim

STANDARD - WHITE

Page 2 of 3

Decor Consultant:

Melissa Di Martino

Purchaser:

LUIGI CIARDULLO

Purchaser:


SANTINA M. CIARDULLO

Vendor:

Hampton Place

ot: 315 Project: Hampton Place Model: CALVERTON

Printed Dec 06, 2017 10:37 am

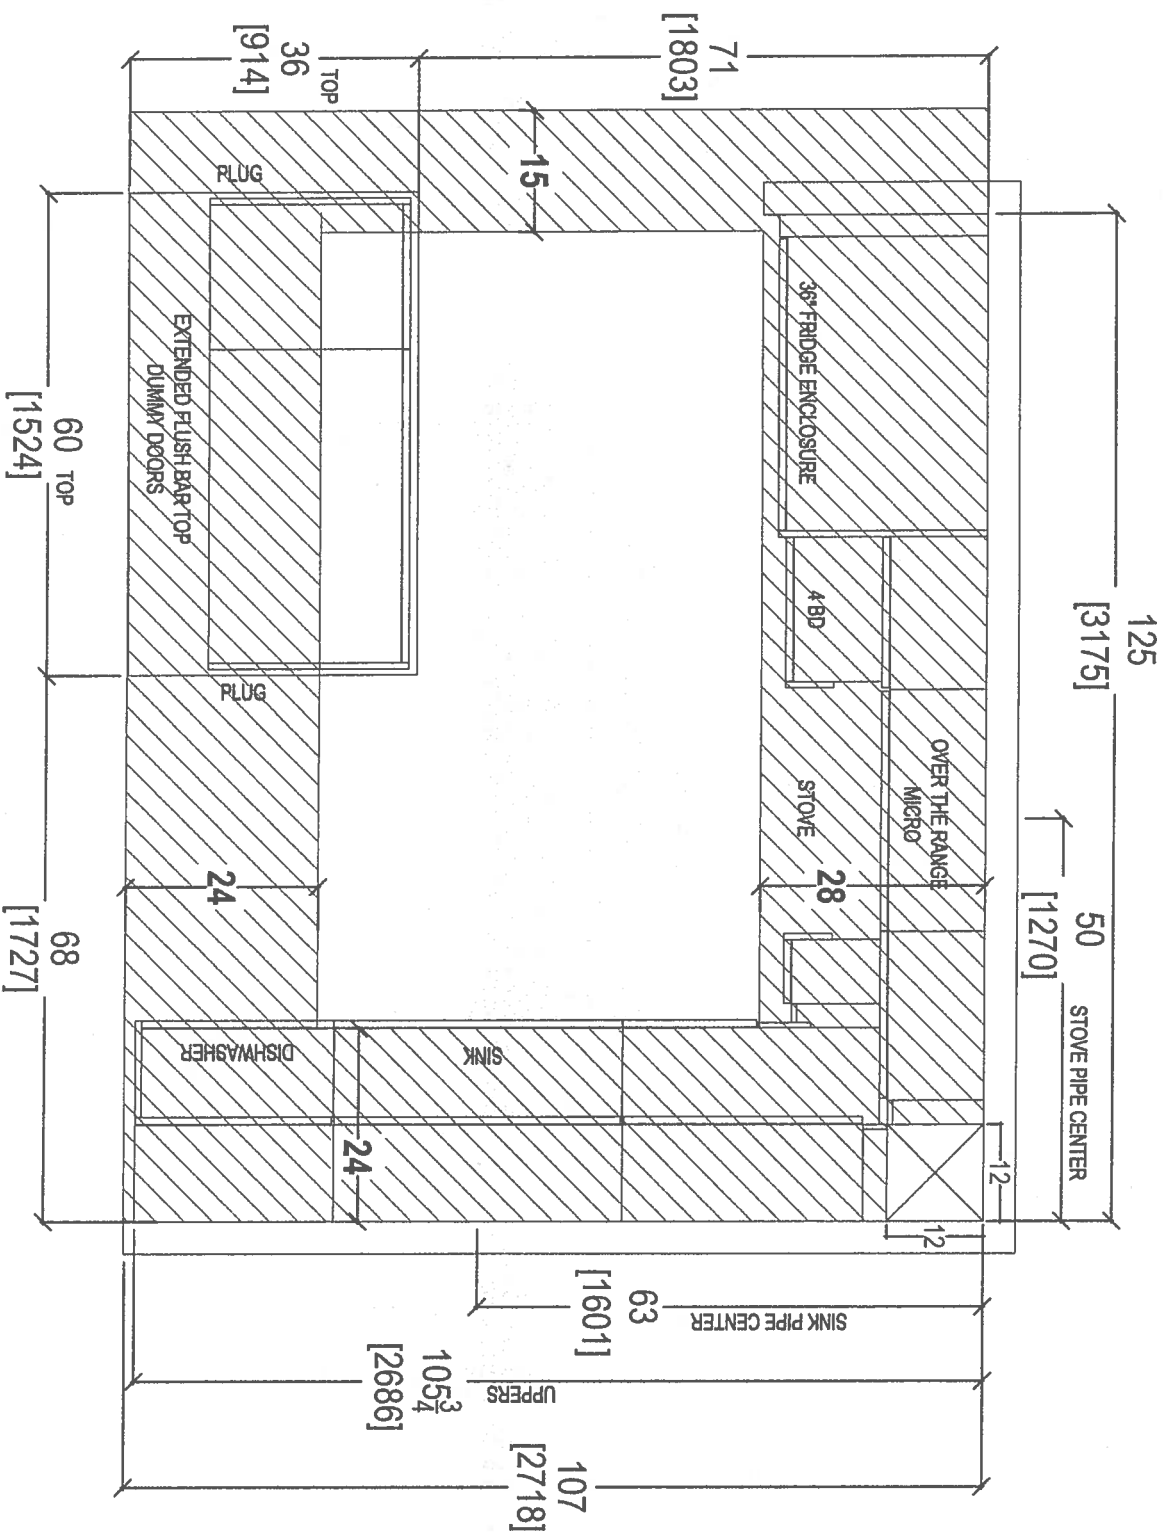

|                          |                        |                               |                      |
|--------------------------|------------------------|-------------------------------|----------------------|
| CLIENT: ROYAL PINE HOMES | JOB NAME: UNIT 315 HMP | ROOM: KITCHEN - BULKHEAD PLAN | DRAWN BY: SK         |
| SITE: HAMPTON PLACE      | DOOR STYLE: —          | DOOR HANDLE: —                | SCALE: 1/2" = 1'-0"  |
| PHONE: —                 | FINISH: —              | DRW HANDLE: —                 | DATE: APRIL 18, 2018 |
| EMAIL: —                 | SPECIES: —             | TOP: —                        | PAGE: —              |


COMMENTS:

PLEASE NOTE ALL DIMENSIONS  
ARE NOT FINAL AND ARE  
SUBJECT TO CHANGE UPON  
FINAL SITE MEASURE



80 SANTE DRIVE, VAUGHAN, L4K 3C4,  
T: 416.746.1811 F: 416.746.1812

69

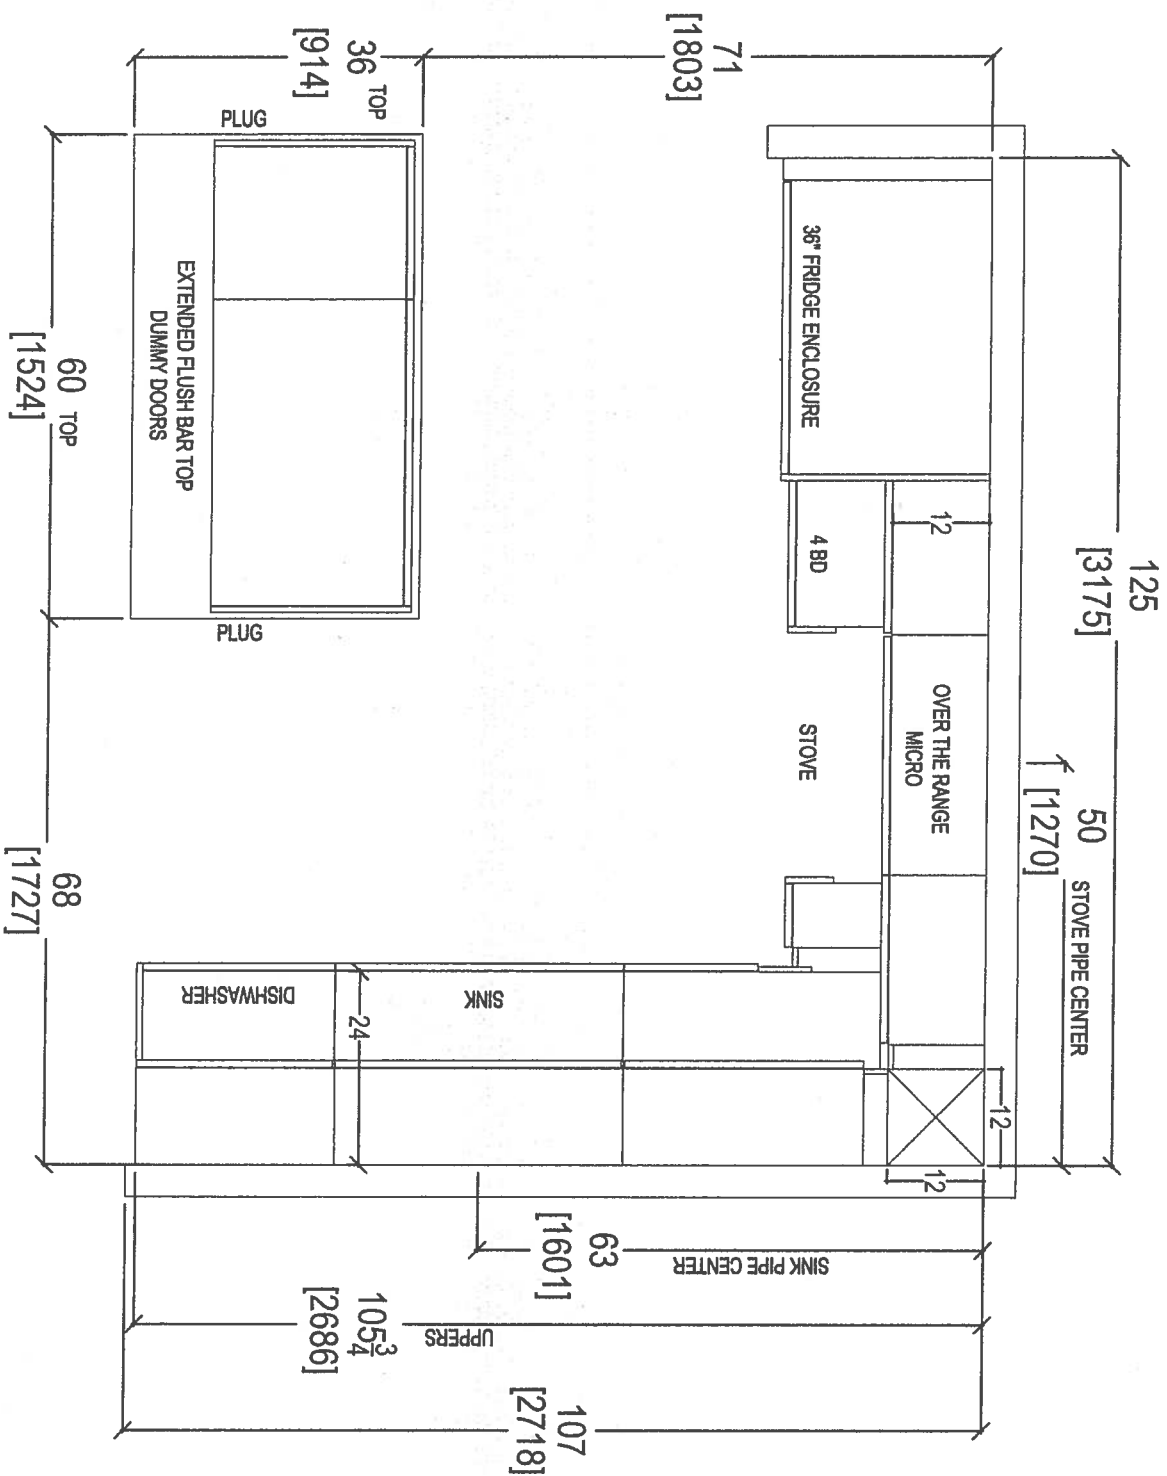

|                          |                        |                          |                       |
|--------------------------|------------------------|--------------------------|-----------------------|
| CLIENT: ROYAL PINE HOMES | JOB NAME: UNIT 315 HMP | ROOM: KITCHEN FLOOR PLAN | DRAWN BY: SK          |
| SITE: HAMPTON PLACE      | DOOR STYLE: —          | DOOR HANDLE: —           | SCALE: 1/2" = 1' - 0" |
| PHONE: —                 | FINISH: —              | DRW HANDLE: —            | DATE: APRIL 18, 2018  |
| EMAIL: —                 | SPECIES: —             | TOP: —                   | PAGE: —               |

COMMENTS:

PLEASE NOTE ALL DIMENSIONS  
ARE NOT FINAL AND ARE  
SUBJECT TO CHANGE UPON  
FINAL SITE MEASURE




80 SANTE DRIVE, VAUGHAN, L4K 3C4,  
T: 416.746.1811 F: 416.746.1812

64



*your kitchen, your taste*  
80 SANTE DRIVE, VAUGHAN, ONTARIO L4V 1L1

**PLEASE NOTE ALL DIMENSIONS  
ARE NOT FINAL AND ARE  
SUBJECT TO CHANGE UPON  
FINAL SITE MEASURE**

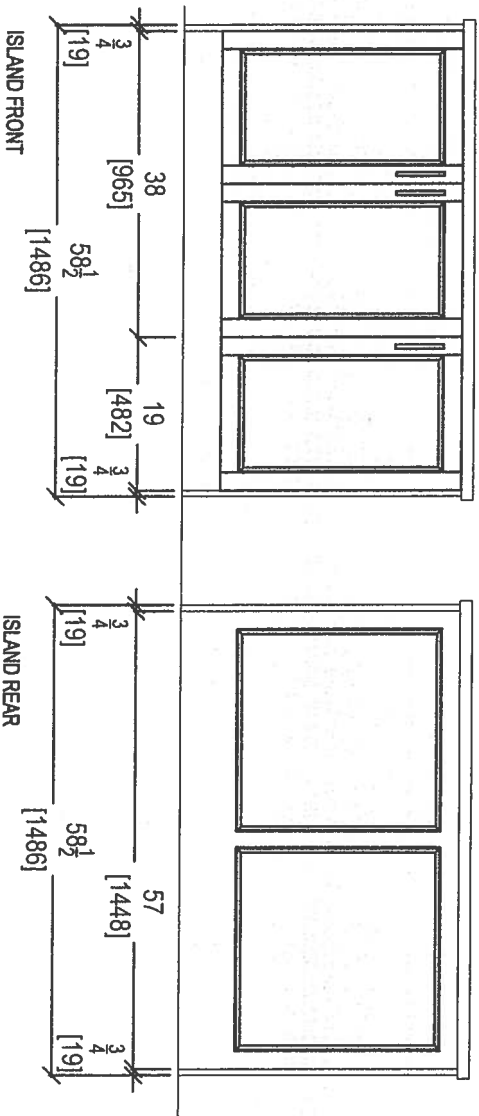





|                          |                        |                |                      |
|--------------------------|------------------------|----------------|----------------------|
| CLIENT: ROYAL PINE HOMES | JOB NAME: UNIT 315 HMP | ROOM: KITCHEN  | DRAWN BY: SK         |
| SITE: HAMPTON PLACE      | DOOR STYLE: —          | DOOR HANDLE: — | SCALE: 1/2" = 1'-0"  |
| PHONE: —                 | FINISH: —              | DRW HANDLE: —  | DATE: APRIL 20, 2018 |
| EMAIL: —                 | SPECIES: —             | TOP: —         | PAGE: —              |



80 SANTE DRIVE, VAUGHAN, ONTARIO L4K 3C4,  
T: 416.746.1811 F: 416.746.1801

COMMENTS:  
PLEASE NOTE ALL DIMENSIONS  
ARE NOT FINAL AND ARE  
SUBJECT TO CHANGE UPON  
FINAL SITE MEASURE

64

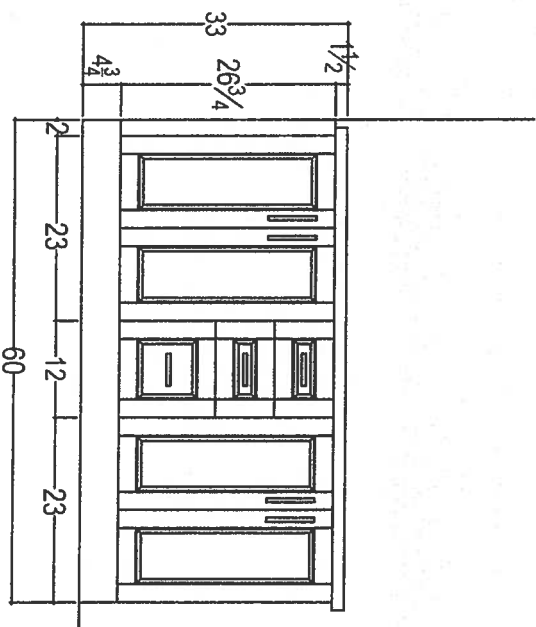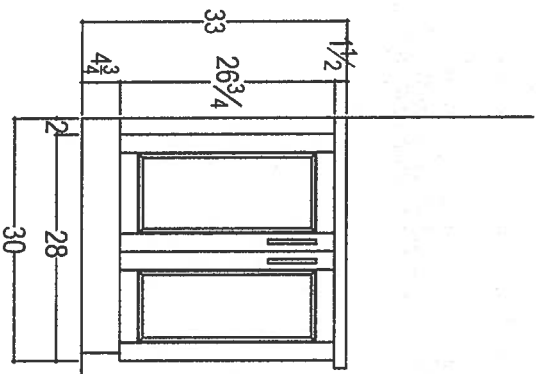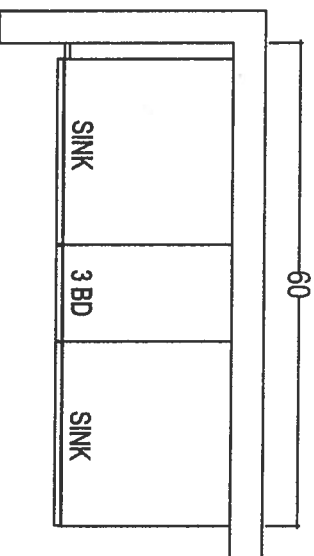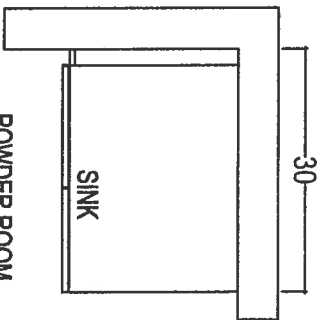

|                          |                        |                |                      |
|--------------------------|------------------------|----------------|----------------------|
| CLIENT: ROYAL PINE HOMES | JOB NAME: UNIT 315 HMP | ROOM: VANITIES | DRAWN BY: SK         |
| SITE: HAMPTON PLACE      | DOOR STYLE: —          | DOOR HANDLE: — | SCALE: 1/2" = 1'-0"  |
| PHONE: —                 | FINISH: —              | DRW HANDLE: —  | DATE: APRIL 20, 2018 |
| EMAIL: —                 | SPECIES: —             | TOP: —         | PAGE: —              |




80 SANTE DRIVE, VAUGHAN, ONT L4K 3C4,  
T: 416.746.1811 F: 416.746.1801

COMMENTS:  
PLEASE NOTE ALL DIMENSIONS  
ARE NOT FINAL AND ARE  
SUBJECT TO CHANGE UPON  
FINAL SITE MEASURE

KRFC302ESS

22 cu.ft. 36-Inch Width Counter Depth French Door Refrigerator  
with Interior Dispense

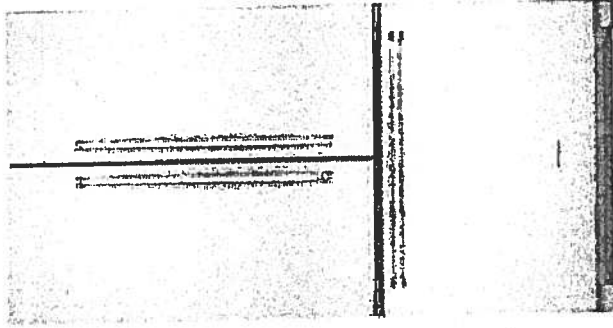

MADE IN  
AMERICA

INSIDE ADVANTAGE™



<http://www.insideadvantage.com>

**Product Dimensions:**

Height: 72  
Width: 35 3/4  
Depth: 30 1/4

**Electrical Requirements:**

15 Amps.

**Available In:**

☒ Stainless Steel  
☒ Black  
☐ White

**KRFC302ESS**

**Key Features:**

- ExtendFresh™ Temperature Management System
- Interior Water Dispenser™
- Professionally-Inspired Design
- Produce Preserver
- Humidity-Controlled Crispers
- FreshChill™ Temperature-Controlled Full-Width Pantry
- Pull-Out Tri-Level Freezer Drawer
- SatinGlide® System
- LED Lighting
- Star-K Certified
- Automatic Ice Maker
- Max Cool

Suite 315  
Hampton

Upgrade  
Package 2

Le

Se

Because Whirlpool Corporation policy includes a continuous commitment to improve our products, we reserve the right to change materials and specifications without notice. We also reserve the right to discontinue or transition products without notice.

Reg. Registered trademark/™ Trademark of Whirlpool U S A © 2013 Whirlpool Corporation. All Rights Reserved. All other trademarks are owned by their respective companies.

Created On: Wednesday, April 22, 2015 15:51:04

Suite 315  
Hampton

Upgrade  
Package 2

Le


Se

KSEB900ESS

**KitchenAid®**

30-Inch 5-Element Electric Convection Slide-In  
Range with Baking Drawer

<http://www.kitchenaid.com>

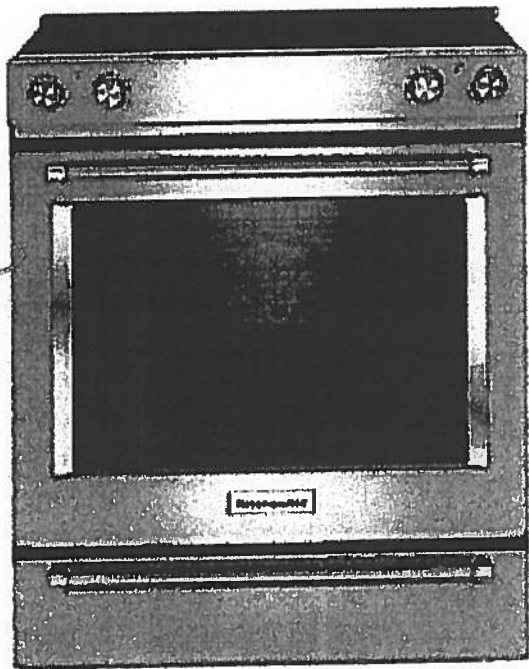

**Key Features:**

- Baking Drawer
- Even-Heat™ True Convection
- Wireless Probe
- Steam Rack
- 7.1 Cu Ft. Total Capacity
- 5 Cooking Elements Including a Warm Zone
- EasyConvect™ Conversion
- FIT Guarantee
- Aqualift®
- Glass Touch Controls
- Side Trim Accessory Kit

**Product Dimensions:**

Height: 36

Width: 29 7/8

**Electrical Requirements:**

40 Amps.

**Additional Information:**

[Use And Care Guide](#)

[Dimension Guide](#)

[Installation Guide](#)

[Warranty Certificate](#)

**Available in:**

- Black
- Stainless Steel
- White

INVESTED  
IN  
AMERICA

ADA  
Compliant

©Registered trademark/TM Trademark of Whirlpool, U.S.A. © 2013 Whirlpool Corporation. All Rights Reserved. All other trademarks are owned by their respective companies. Because Whirlpool Corporation policy includes a continuous commitment to improve our products, we reserve the right to change materials and specifications without notice. We also reserve the right to discontinue or transition products without notice. Manufacturer's Suggested Retail Price (MSRP) and Minimum Advertised Price (MAP) provided for reference purposes only. Dealer alone determines advertised and retail prices. Created On: Tuesday, December 22, 2015 14:04:50

# Suite 315 Hampton Upgrade Package 2

Le

Se

KMHP519ESS

1000-Watt Convection Microwave with High-Speed  
Cooking - 30"

**KitchenAid®**

<http://www.kitchenaid.com>

#### Key Features:

- High-Speed Cooking
- Convection Cooking
- Professionally-Inspired Design Including Handle, Badge, Graphics, Chrome Chamfer.
- Cookshield Finish
- Crispwave™ Technology and Crisper Pan
- 1200 Watts Power
- 1.9 Cu. Ft. Capacity
- Halogen Cavity Lights and Task Light
- Steam Cleaning Function
- Keep Warm Function
- Sound-Based Popcorn Function

#### Product Dimensions:

Height: 17 1/8

Width: 30

Depth: 17

#### Electrical Requirements:

15.


#### Additional Information:

[Use And Care](#)

[Dimension Guide](#)

[Installation Guide](#)

[Warranty](#)

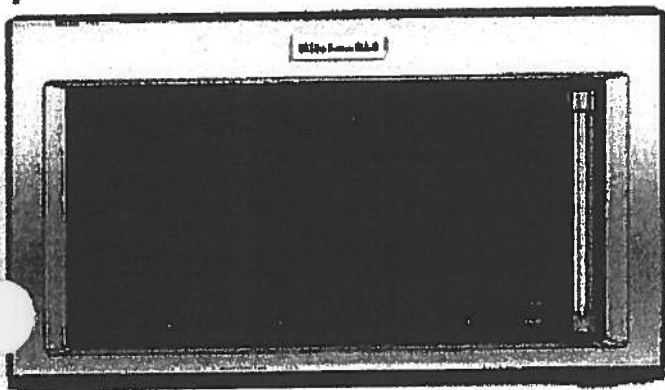

Available In:

 Stainless Steel

®Registered trademark/TM Trademark of Whirlpool, U.S.A. ©2016 Whirlpool Corporation All Rights Reserved All other trademarks are owned by their respective companies.

Because Whirlpool Corporation policy includes a continuous commitment to improve our products, we reserve the right to change materials and specifications without notice. We also reserve the right to discontinue or transition products without notice.

Manufacturer's Suggested Retail Price (MSRP) and Minimum Advertised Price (MAP) provided for reference purposes only. Dealer alone determines advertised and retail prices.

Suite 315  
Hampton

Upgrade  
Package 2




KDTM354ESS

**KitchenAid®**

4 dBA Dishwasher with Clean Water Wash System

<http://www.kitchenaid.com>

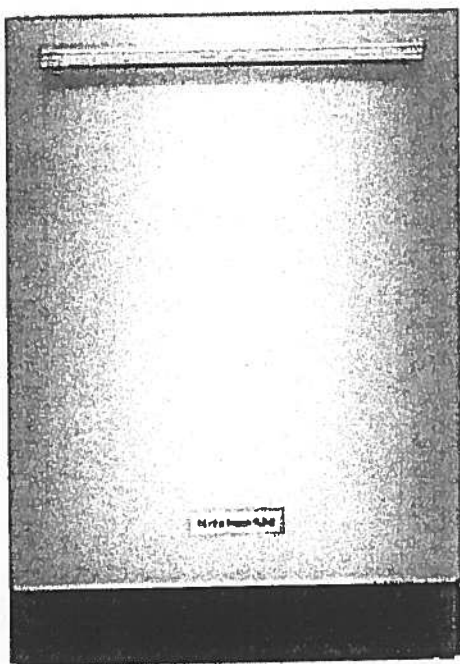

**Key Features:**

- Clean Water Wash System
- ProScrub® Option
- Professionally-Inspired Design
- Advanced ProDry™ System
- ProWash™ Cycle
- SatinGlide® Max Rails (Upper Rack)
- Sliding Tines in the Lower Rack
- 2 Rows Fold-Down Tines in Upper Rack
- Fold-Down Tines in the Lower Rack
- 2 Fold-Down Cup Shelves with Integrated Stemware Holders
- Utility Basket (Upper Rack)
- Express Wash

**Product Dimensions:**

Height: 34 1/2

Width: 23 7/8

Depth: 24 3/4

**Electrical Requirements:**

15 Amps.

**Additional Information:**

[Use And Care Guide](#)

[Dimension Guide](#)

[Installation Guide](#)

[Energy Guide](#)

[Warranty Certificate](#)

Available in:

 Stainless Steel

INVESTED  
IN  
AMERICA

®Registered trademark/TM Trademark of Whirlpool, U.S.A. © 2013 Whirlpool Corporation All Rights Reserved.  
All other trademarks are owned by their respective companies.  
Because Whirlpool Corporation policy includes a continuous commitment to improve our products, we reserve the right to change materials and specifications without notice. We also reserve the right to discontinue or transition products without notice.  
Manufacturer's Suggested Retail Price (MSRP) and Minimum Advertised Price (MAP) provided for reference purposes only. Dealer alone determines advertised and retail prices.  
Created On: Friday, March 04, 2016 16:36:55

Suite 315  
Hampton

Upgrade  
Package 2

LC


SC

WED85HEFC

Whirlpool®

<http://www.whirlpool.com>

7.4 cu. ft. Electric Dryer with Quick Dry Cycle

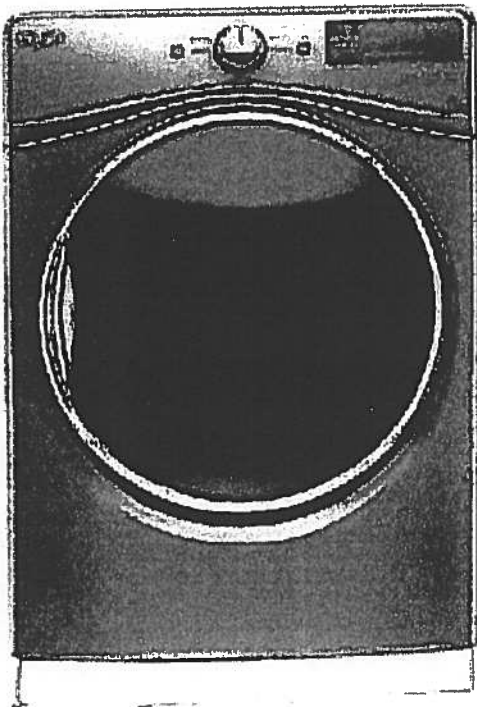

Key Features:

- Advanced Moisture Sensing System
- Tap Touch Controls with Memory
- EcoBoost™ Option
- Steam Refresh Cycle
- Wrinkle Shield™ Option
- Quad Baffles
- 7.4 Cu. Ft. Capacity
- Undercounter Installation
- ENERGY STAR® Qualified
- Sanitize Cycle
- Quick Dry Cycle

Product Dimensions:

Height: 39

Width: 27

Depth: 31

Additional Information:

[Use And Care Guide](#)

[Dimension Guide](#)

[Installation Guide](#)

[Warranty Certificate](#)

INVESTED  
IN  
AMERICA



©Registered trademark/TM Trademark of Whirlpool, U.S.A. ©2016 Whirlpool Corporation. All Rights Reserved  
All other trademarks are owned by their respective companies  
Because Whirlpool Corporation policy includes a continuous commitment to improve our products, we reserve  
the right to change materials and specifications without notice. We also reserve the right to discontinue or  
transition products without notice  
Manufacturer's Suggested Retail Price (MSRP) and Minimum Advertised Price (MAP) provided for reference  
purposes only. Dealer alone determines advertised and retail prices  
Created On: Thursday, March 23, 2017 17:33:37

# Suite 315 Hampton Upgrade Package 2


LE S.E.

WFW85HEFC

Whirlpool®

<http://www.whirlpool.com>

4.5 cu. ft. Front Load Washer with TumbleFresh™  
option

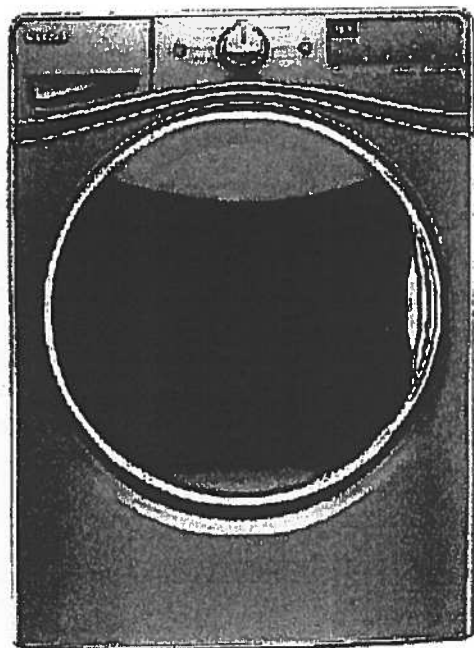

## Key Features:

- TumbleFresh™ Option
- ColorLast™ Cycle
- Presoak Option
- EcoBoost™ Option
- Precision Dispense
- Steam Clean Option
- Adaptive Wash Technology
- Smooth Wave Stainless Steel Wash Basket
- 4.5 cu. ft. Capacity
- Undercounter Installation
- Add-A-Garment
- ENERGY STAR® Certified

## Product Dimensions:

Height: 39 3/4

Width: 27

Depth: 33 5/16

## Additional Information:

[Use And Care Guide](#)

[Dimension Guide](#)

[Installation Guide](#)

[Energy Guide](#)

[Warranty Certificate](#)

Available in:

- ☒ Chrome Shadow  
☐ White

INVESTED  
IN  
AMERICA




©Registered trademark/TM Trademark of Whirlpool, U.S.A. © 2016 Whirlpool Corporation. All Rights Reserved.  
All other trademarks are owned by their respective companies.  
Because Whirlpool Corporation policy includes a continuous commitment to improve our products, we reserve the right to change materials and specifications without notice. We also reserve the right to discontinue or transition products without notice.  
Manufacturer's Suggested Retail Price (MSRP) and Minimum Advertised Price (MAP) provided for reference purposes only. Dealer alone determines advertised and retail prices.  
Created On: Wednesday, December 14, 2016 18:12:43


° Standard °



Suite 315  
Hampton

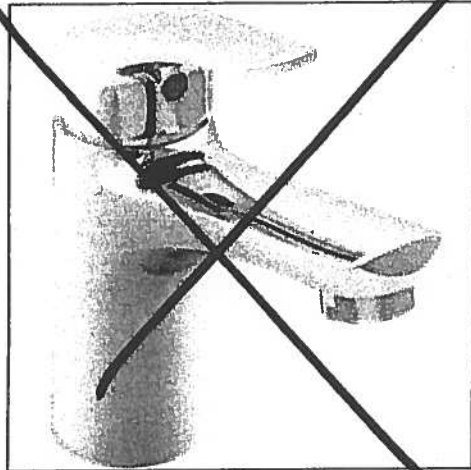



Delta Wynne Chrome Single Lever  
Lavatory Faucet With Pop Up  
#534LF

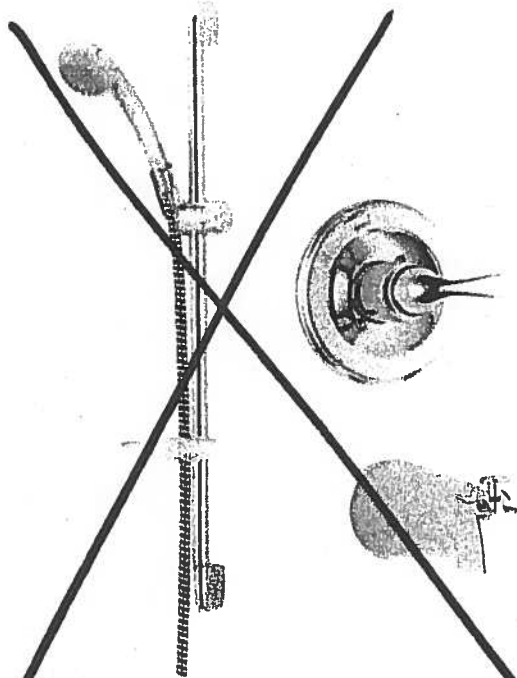

Delta Shower Trim with Tub Spout and  
Hansgrohe Slide Bar with Handheld  
#R10000/T13020-CDN/2001-TP/27454002/  
27744000

Master Ensuite  
Shower

RAIN HEAD  
FROM CEILING.

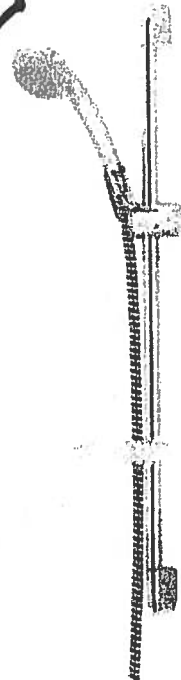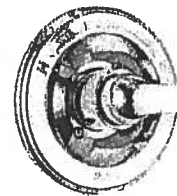

Delta Shower Trim and  
Hansgrohe Slide Bar with Handheld and  
Ceiling Mount Showerhead  
#R10000/T13020-CDN/27454002/  
27744000/RP52382/RP46870/RP6025/  
R11000/T11800


Countertop Edges  
Suite 315  
Hampton

S.E. LL  
Dec. 6, 2017


CONNOLLY Marble & Granite Ltd.

EDGE  
DETAILS


004

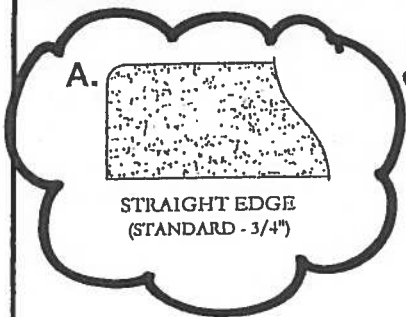

Standard:  
Main Bath  
Master Ensuite

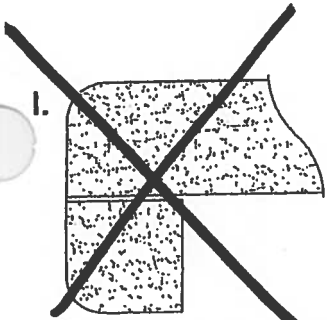

DOUBLE TOP "D" EDGE  
(STANDARD - 1 1/2")

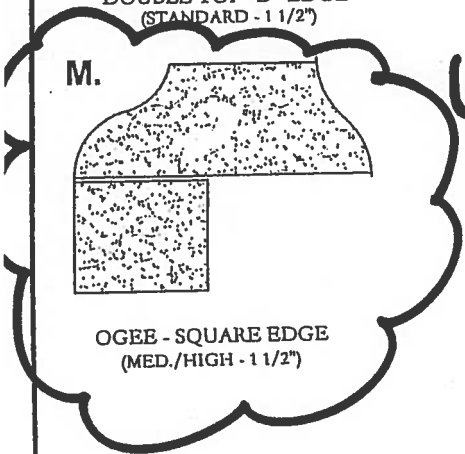

Upgrade:  
Kitchen

EDGING UP-GRADE OPTIONS