



Noyac Bay



1,121 SQ FT *plus 81 sq. ft. of balcony area*

Suite 609


ORIGINAL LAYOUT

INVENTORY SUITE


OLD LAYOUT

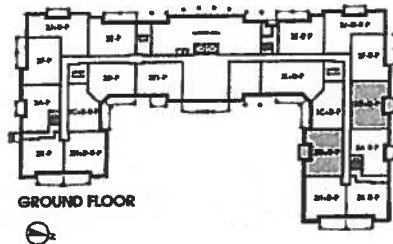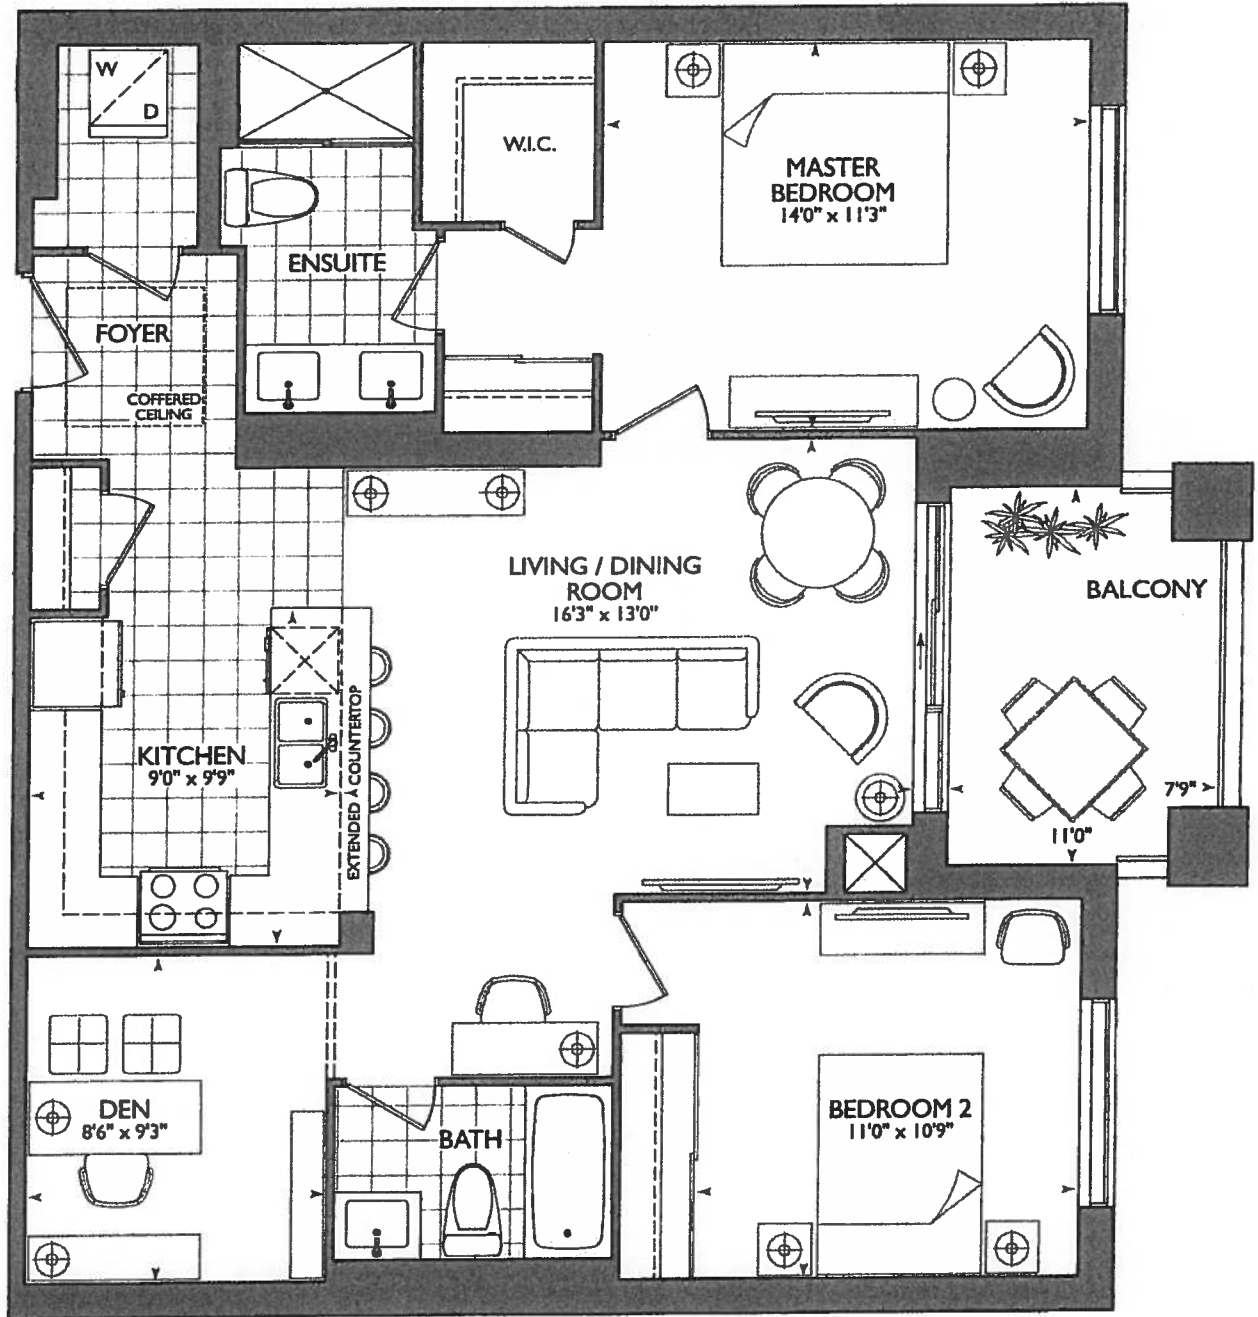

GROUND FLOOR

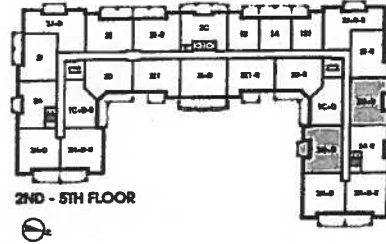


2ND - 5TH FLOOR

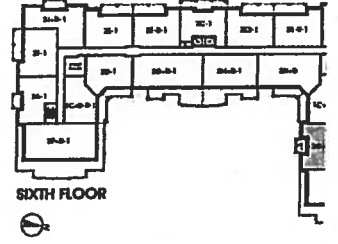

SIXTH FLOOR



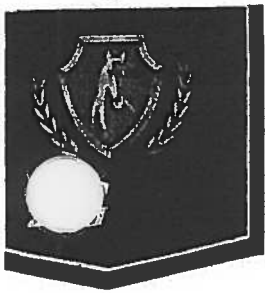


Noyac Bay

1,121 SQ FT *plus 76 sq. ft. of balcony area*

SUITE 609
ORIGINAL LAYOUT
INVENTORY SUITE


NEW

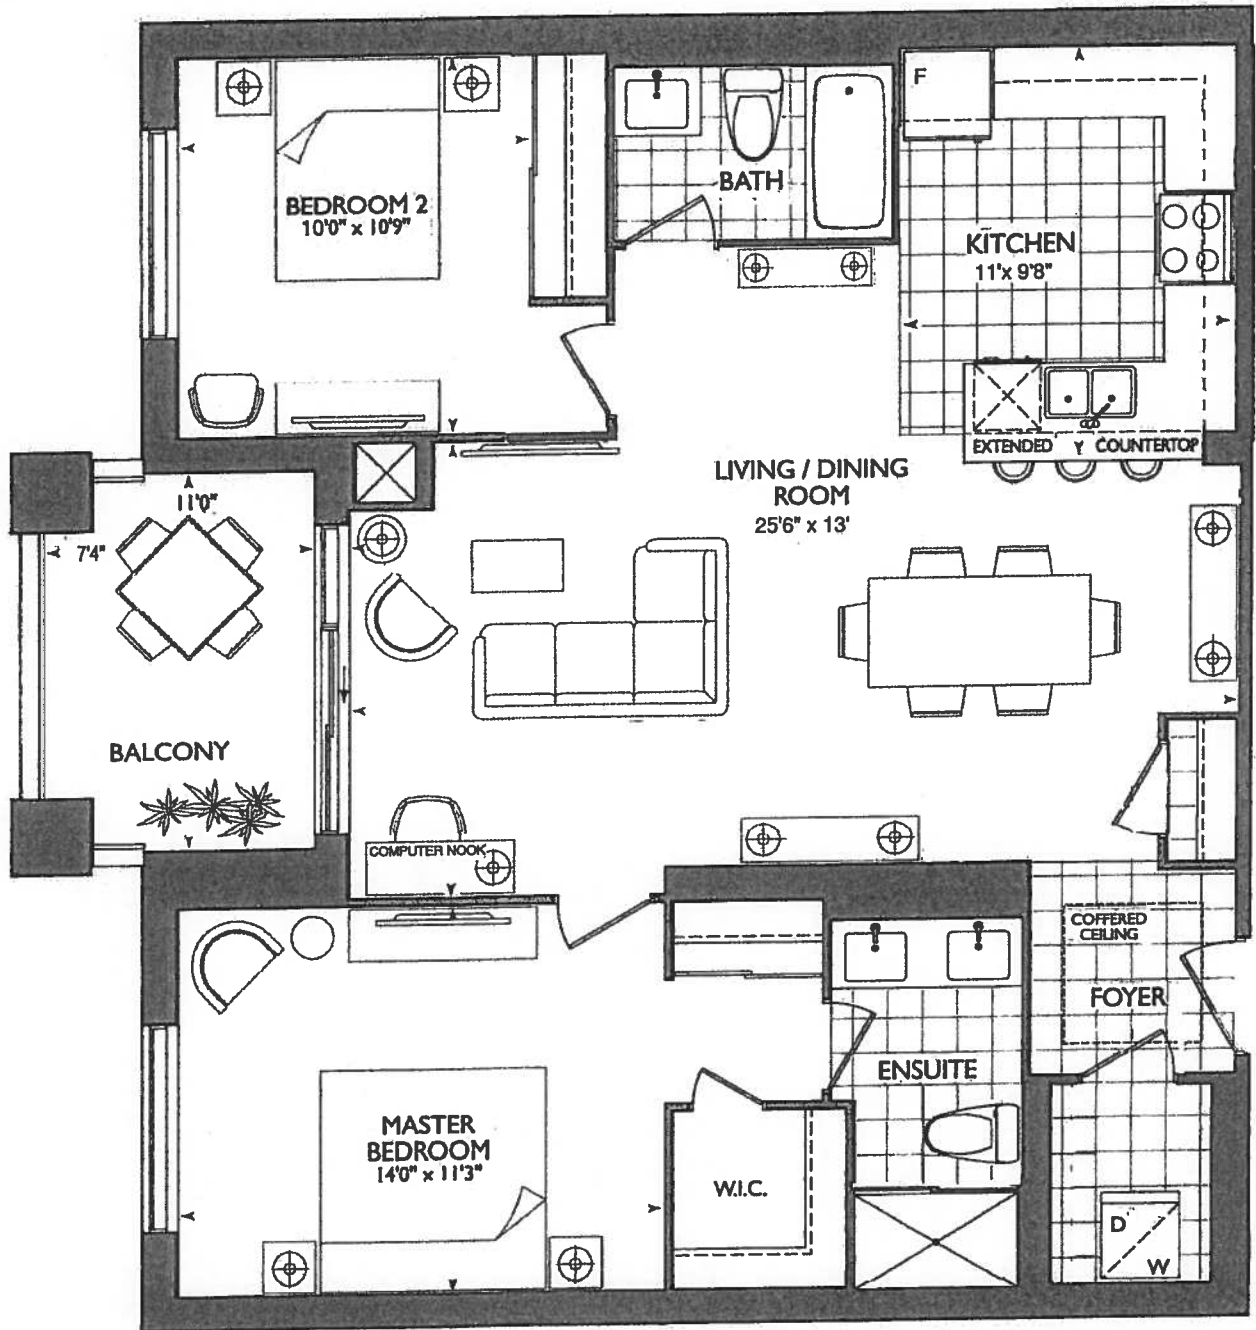

2ND FLOOR



3ND - 5TH FLOOR

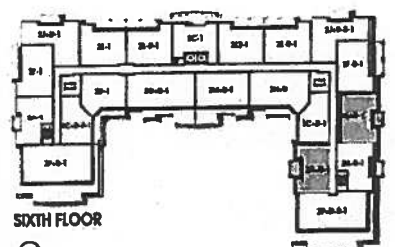

6TH FLOOR

Plans and specifications are subject to change without notice. Actual usable floor space may vary from the stated floor area. All renderings are artist's concept E. & O. E.



*** KITCHEN ***

**CHOICE OF STD. KITCHEN LAYOUT WITH
STD. APPLIANCE PACKAGE**

OR

CAN UPGRADE AT DECOR CENTER

-(x²) CAPPED PENDANT

-(x1) PLUG PENINSULA

-(x) PUCK LIGHTS

***SEE ATTACHED UPG.**

#1-KITCHEN LAYOUT WITH 1ST UPG.

APPLIANCE PACKAGE


*** SUITE 609 * (INVENTORY SUITE)**

NEW PLAN

-REMOVED DEN

-REVISED KITCHEN


***REVISED LAUNDRY DOOR SWING & ENSUITE WALL AS PER THIS BROCHURE**

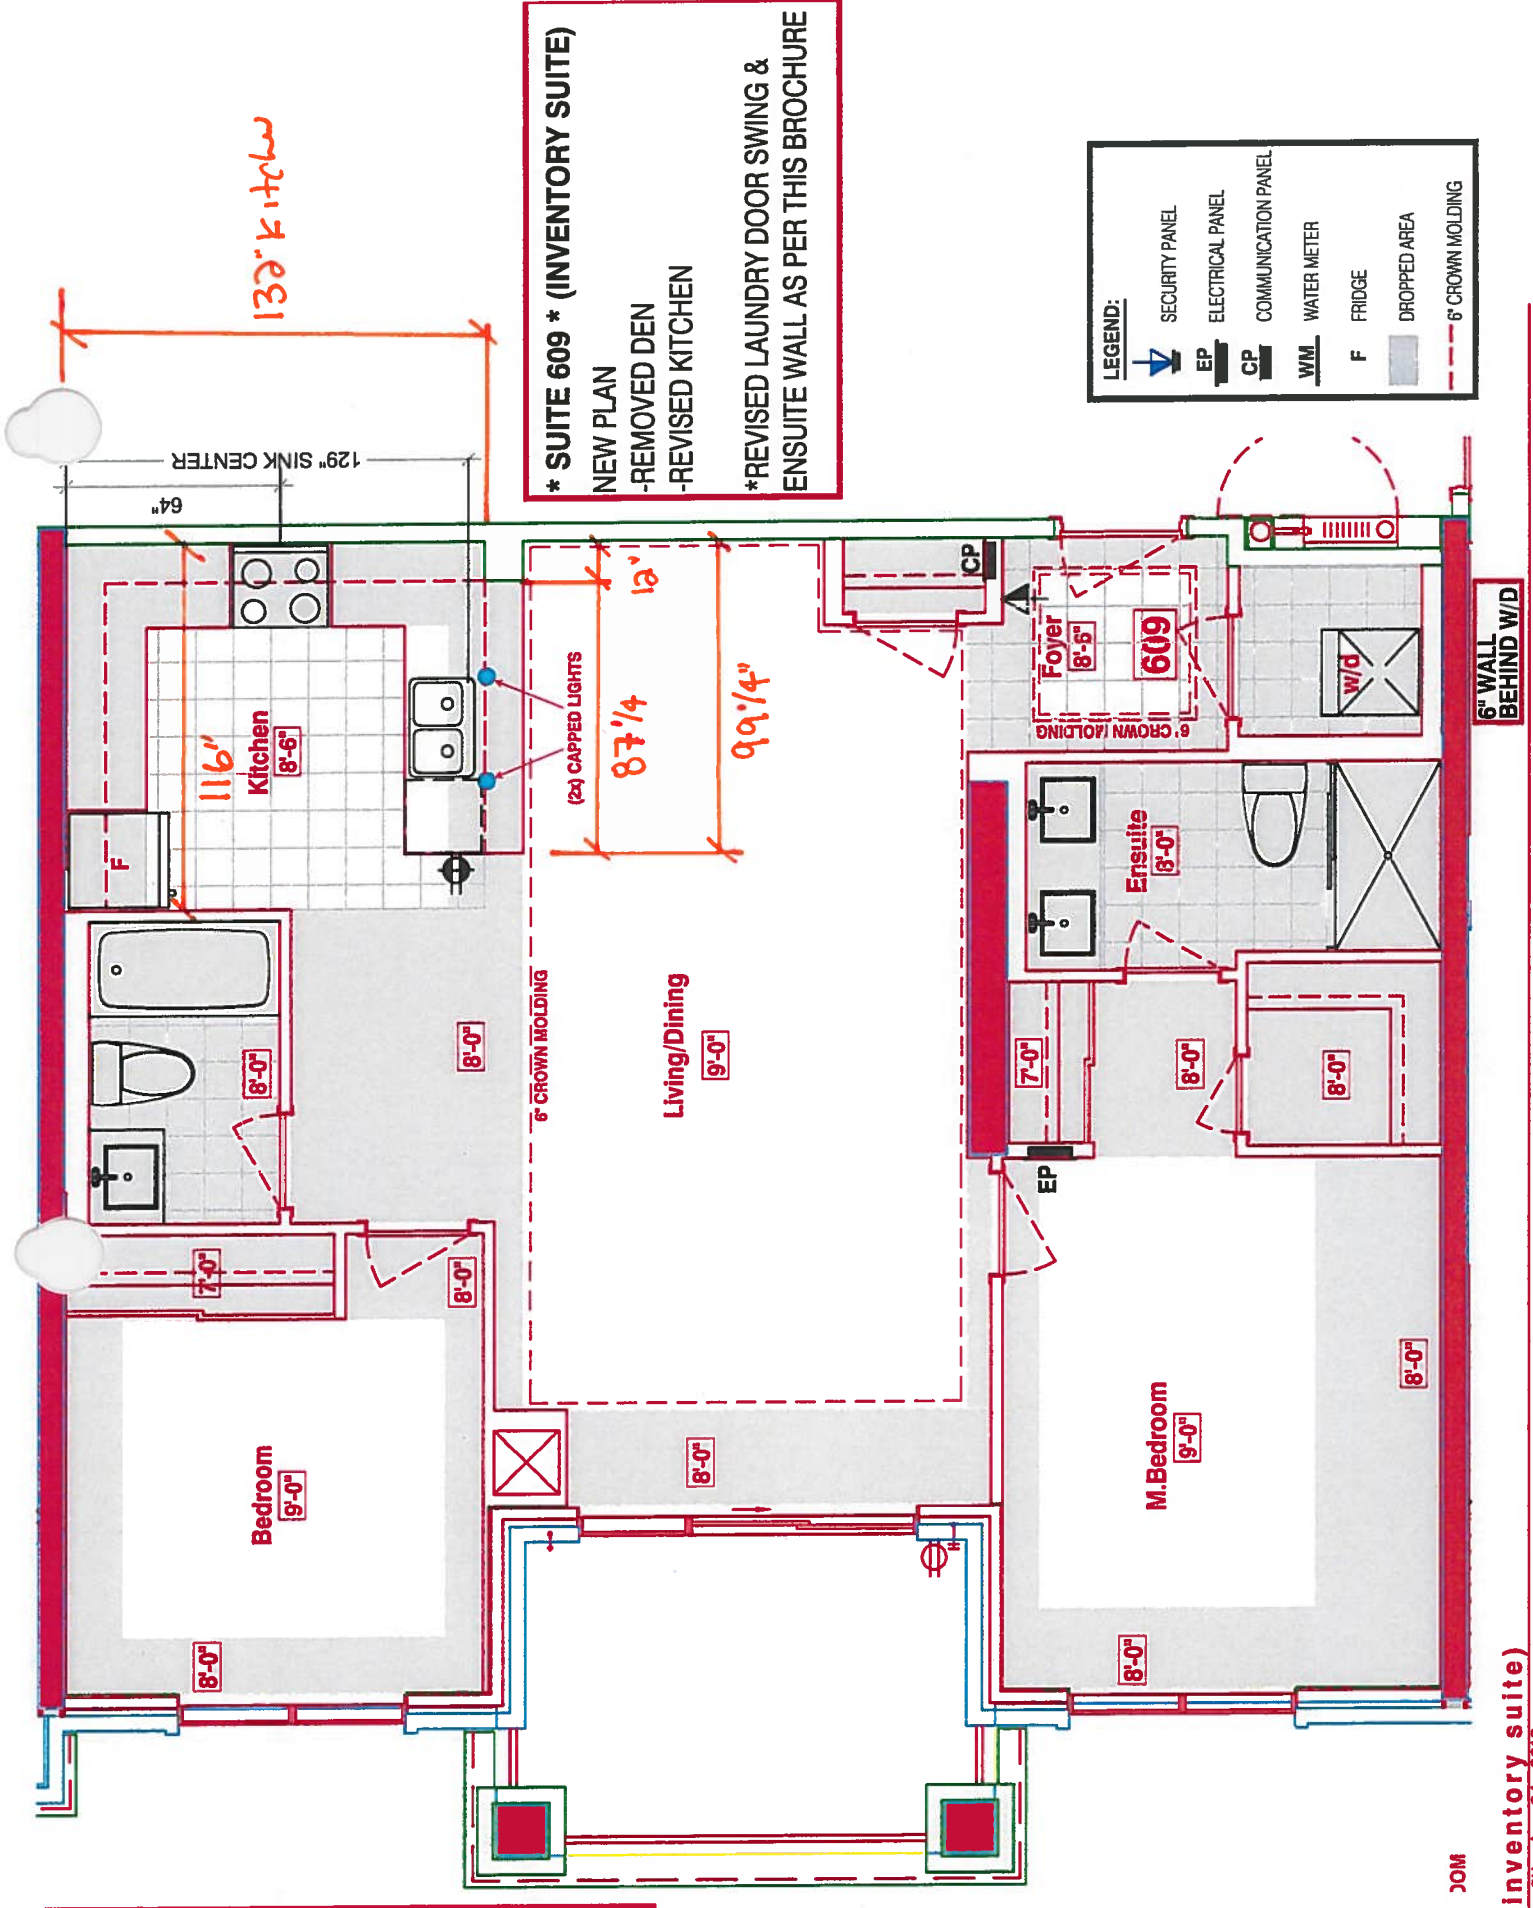**SUITES 609 - NOYAC BAY (inventory suite)**


■ Royal Pine Homes ■ 25 Baker Hill Blvd -- Stouffville, ON ■ Apr 04, 2018

609-Inventory Suite


- STD KITCHEN LAYOUT
- STD APPLIANCES PKG
- (1x) = Plug, Peninsula
- (5x) = Plug Lights
- (2x) = Pendant Lights

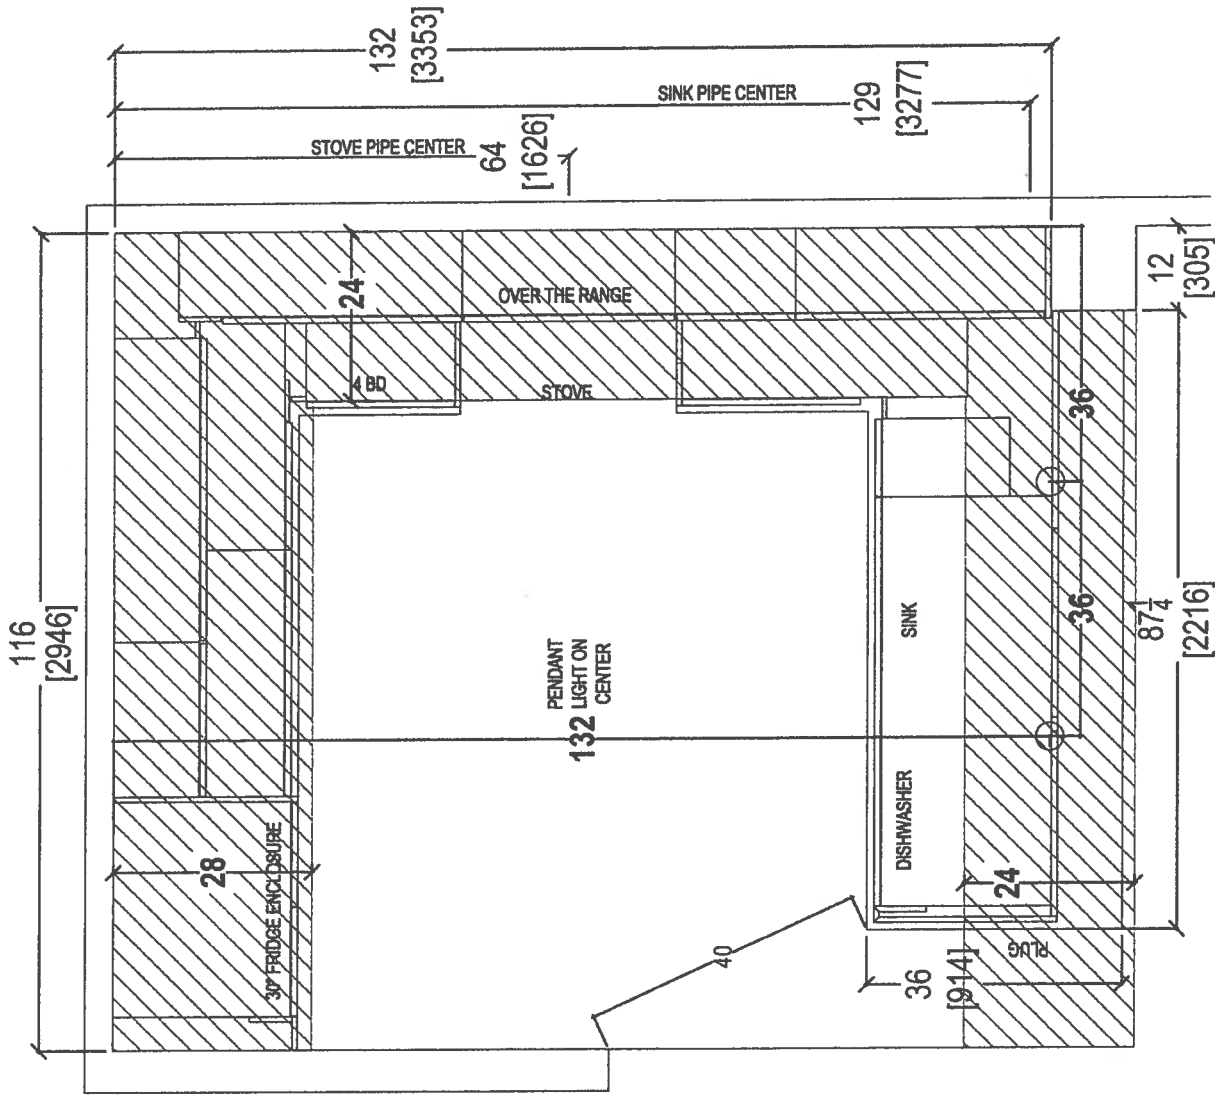

 your kitchen, your taste. 80 SANTE DRIVE, VAUGHAN, ON L4K 3C4. T: 416.746.1811 F: 905.761.5901	CLIENT: ROYAL PINE HOMES	JOB NAME: UNIT 809 HMP (STANDARD)	ROOM:	KITCHEN FLOOR PLAN	DRAWN BY: SK	COMMENTS: PLEASE NOTE ALL DIMENSIONS ARE NOT FINAL AND ARE SUBJECT TO CHANGE UPON FINAL SITE MEASURE
	SITE: HAMPTON PLACE	DOOR STYLE: ---	DOOR HANDLE: ---	SCALE: 1/2" = 1' - 0"		
	PHONE: ---	FINISH: ---	DRW HANDLE: ---	DATE: MAY 10, 2018		
	EMAIL: ---	SPECIES: ---	TOP: ---	PAGE:		

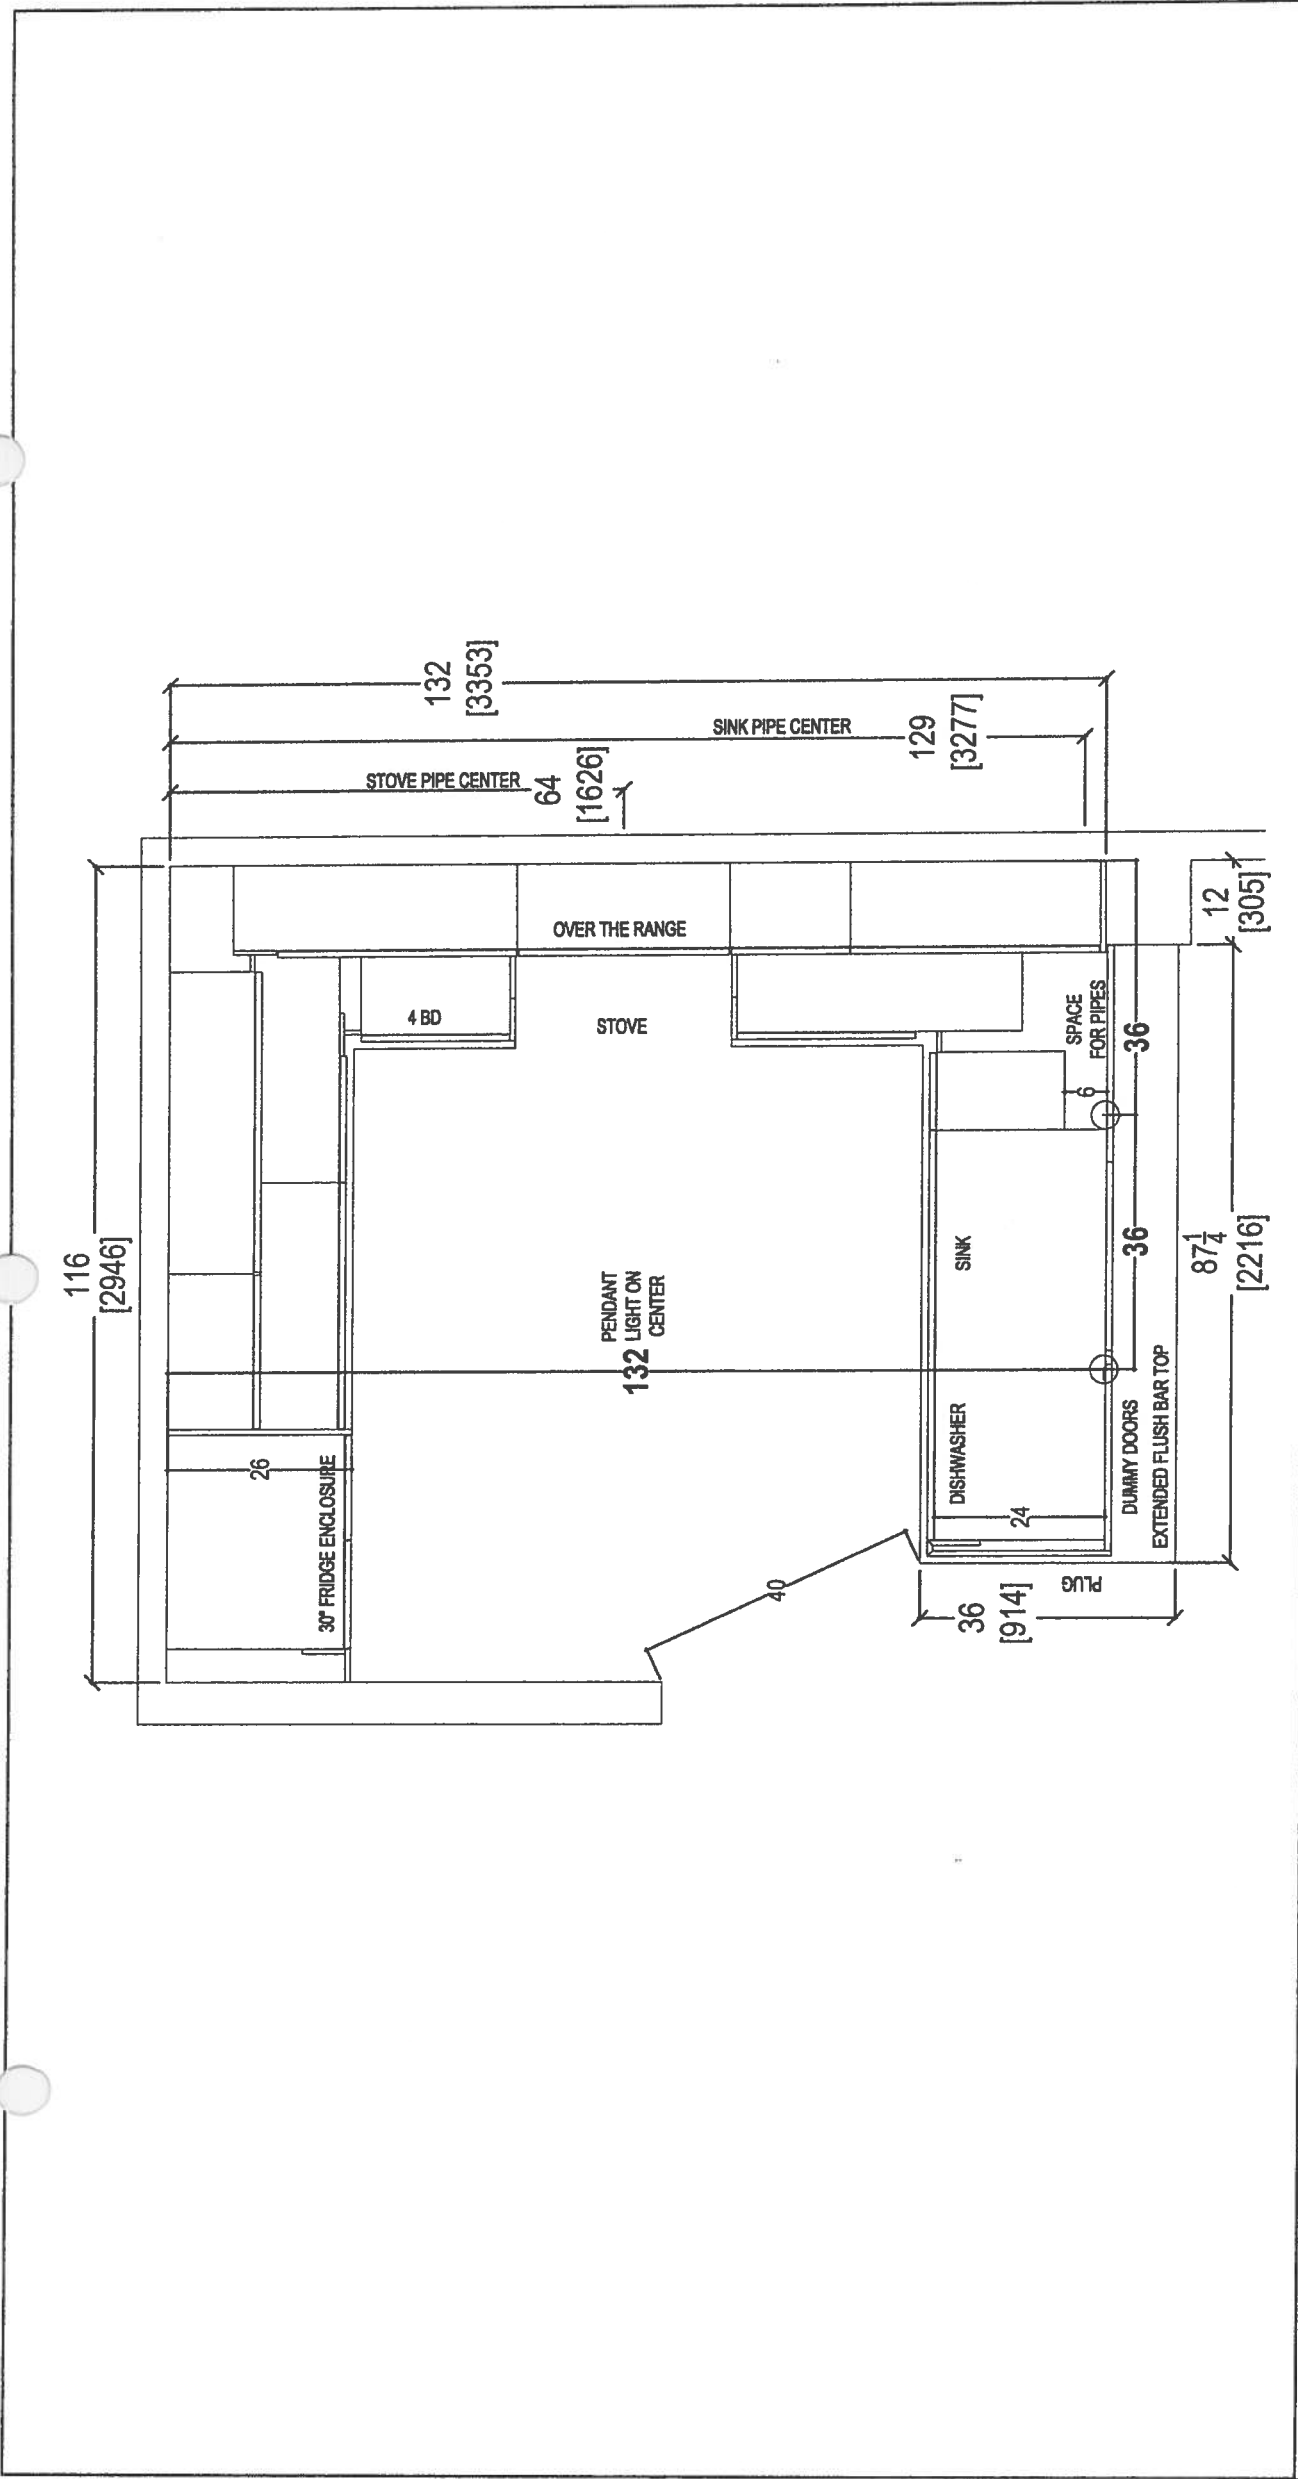



 your kitchen, your taste. 80 SANTE DRIVE, VAUGHAN, ON L4K 3C4, T: 416.746.1811 F: 905.761.5901	CLIENT: ROYAL PINE HOMES	JOB NAME: UNIT 608 HMP (STANDARD)	ROOM:	KITCHEN FLOOR PLAN	DRAWN BY: SK	COMMENTS: PLEASE NOTE ALL DIMENSIONS ARE NOT FINAL AND ARE SUBJECT TO CHANGE UPON FINAL SITE MEASURE
	SITE: HAMPTON PLACE	DOOR STYLE: —	DOOR HANDLE: —		SCALE: 1/2" = 1' - 0"	
	PHONE: —	FINISH: —	DRW HANDLE: —		DATE: MAY 10, 2018	
	EMAIL: —	SPECIES: —	TOP: —		PAGE:	

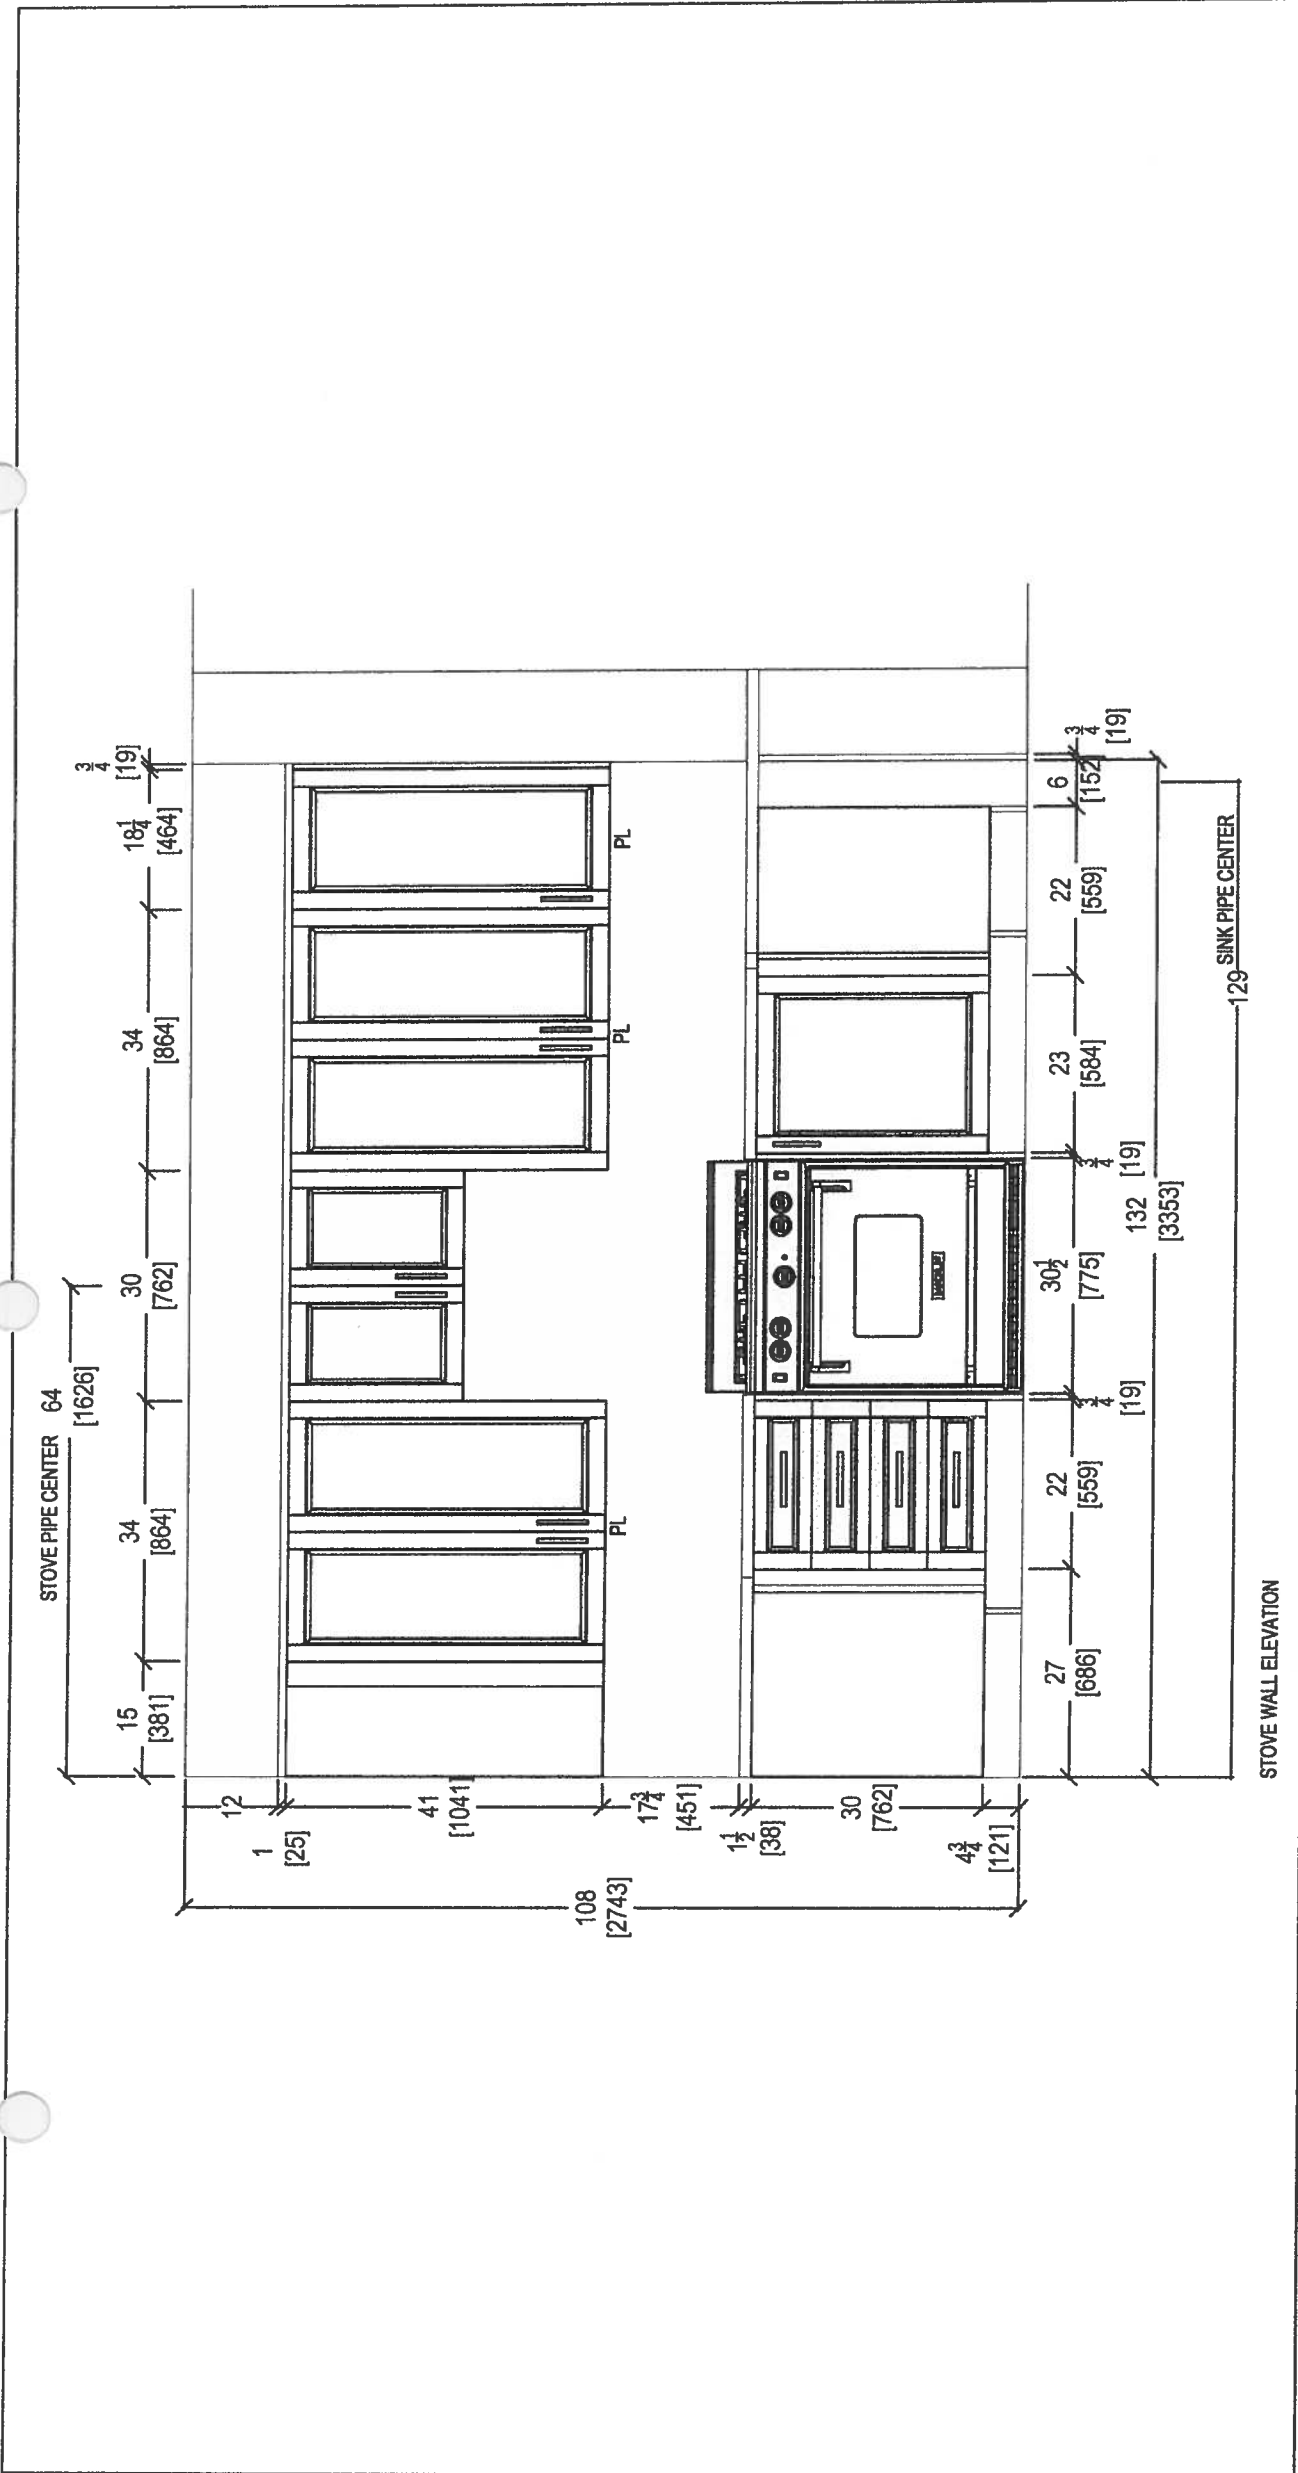





 <i>your kitchen, your taste</i> 80 SANTE DRIVE, VAUGHAN, ON L4K 3C4, T. 416.746.1811 F.905.781.5901	CLIENT: ROYAL PINE HOMES	JOB NAME: UNIT 609 HMP (STANDARD)	ROOM: KITCHEN	DRAWN BY: SK	COMMENTS: PLEASE NOTE ALL DIMENSIONS ARE NOT FINAL AND ARE SUBJECT TO CHANGE UPON FINAL SITE MEASURE
	SITE: HAMPTON PLACE	DOOR STYLE: —	DOOR HANDLE: —	SCALE: 1/2" = 1' - 0"	
	PHONE: —	FINISH: —	DRW HANDLE: —	DATE: MAY 10, 2018	
	EMAIL: —	SPECIES: —	TOP: —	PAGE:	



 your kitchen, your taste 80 SANTE DRIVE, VAUGHAN, ON L4K 3C4, T: 416.748.1811 F: 905.761.5901	CLIENT: ROYAL PINE HOMES		JOB NAME: UNIT 808 HMP (STANDARD)	ROOM: KITCHEN	DRAWN BY: SK	PLEASE NOTE ALL DIMENSIONS ARE NOT FINAL AND ARE SUBJECT TO CHANGE UPON FINAL SITE MEASURE
	SITE: HAMPTON PLACE		DOOR STYLE: —	DOOR HANDLE: —	SCALE: 1/2" = 1' - 0"	
	PHONE: —		FINISH: —	DRW HANDLE: —	DATE: MAY 10, 2018	
	EMAIL: —		SPECIES: —	TOP: —	PAGE: —	

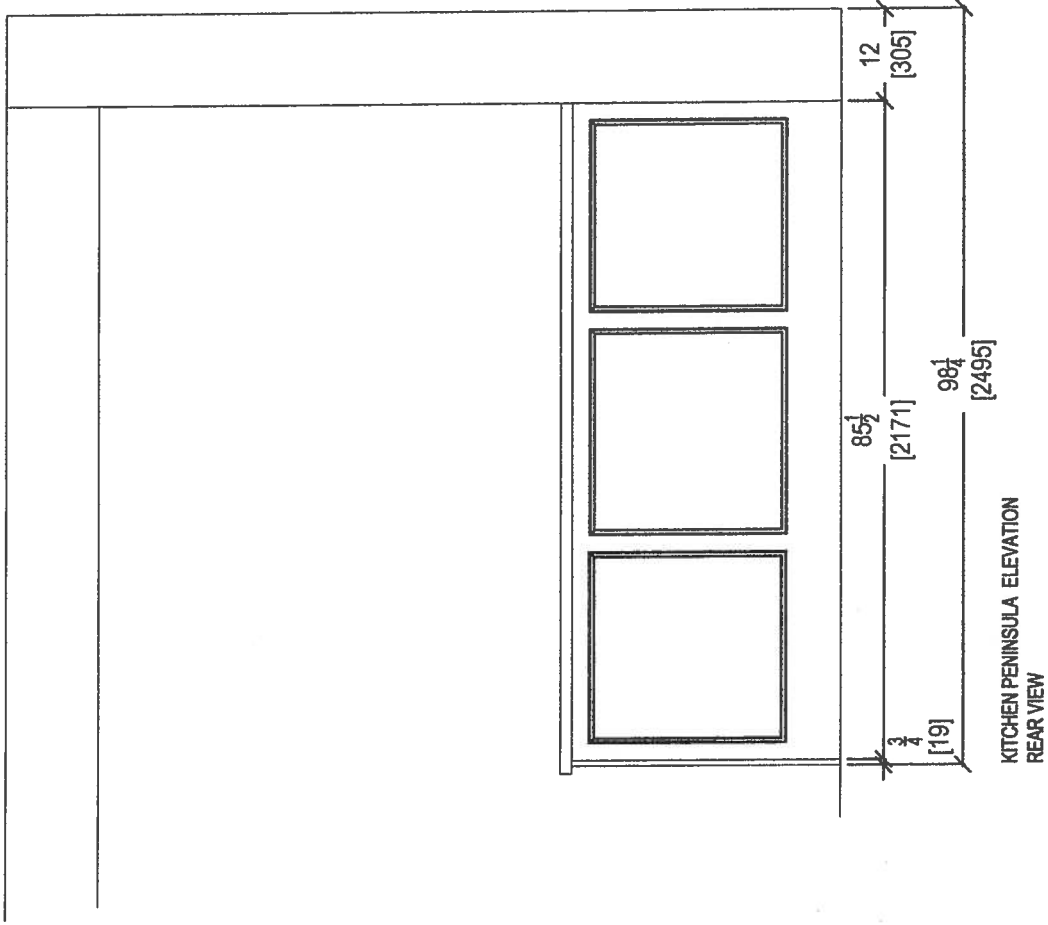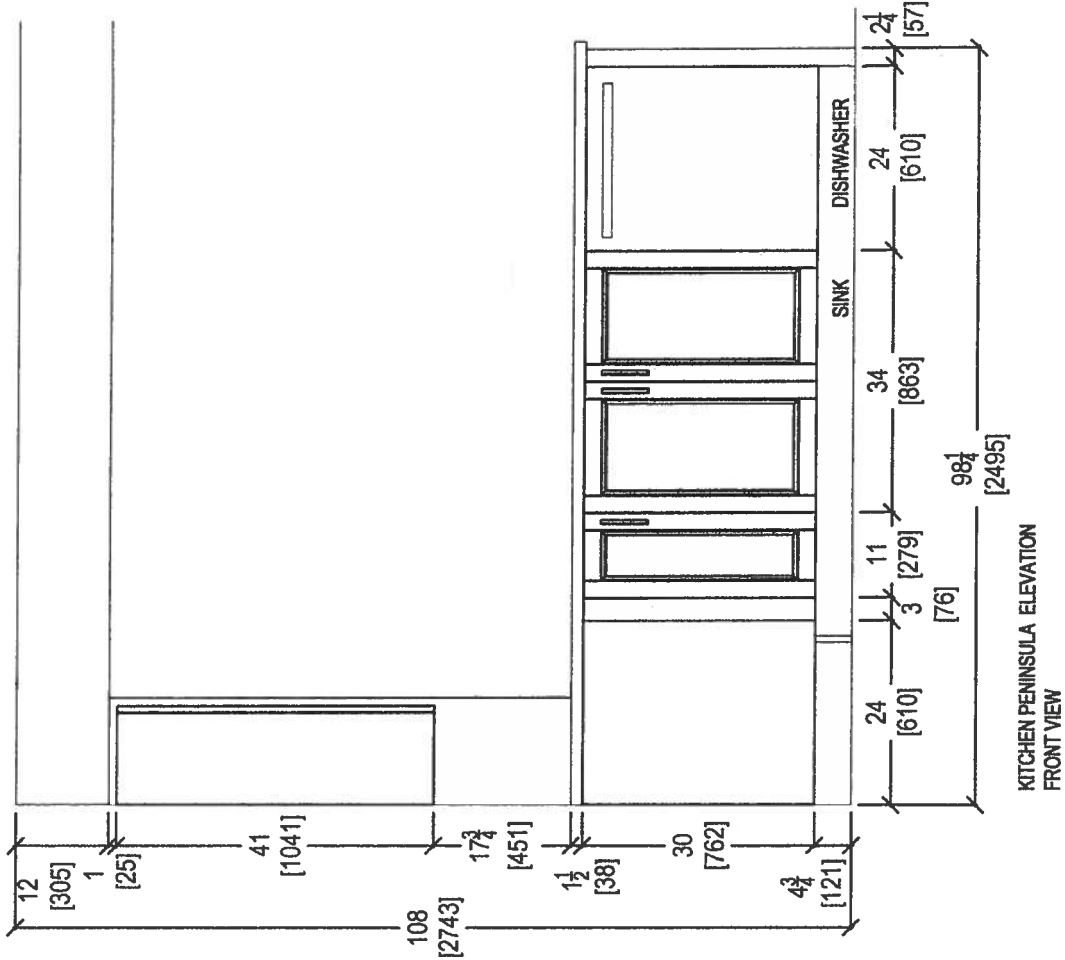


 your kitchen, your taste. 80 SANTE DRIVE, VAUGHAN, ON L4K 3C4, T: 416.746.1811 F: 905.781.5901	CLIENT: ROYAL PINE HOMES	JOB NAME: UNIT 809 HMP (STANDARD)	ROOM: KITCHEN	DRAWN BY: SK	COMMENTS: PLEASE NOTE ALL DIMENSIONS ARE NOT FINAL AND ARE SUBJECT TO CHANGE UPON FINAL SITE MEASURE
	SITE: HAMPTON PLACE	DOOR STYLE: —	DOOR HANDLE: —	SCALE: 1/2" = 1' - 0"	
	PHONE: —	FINISH: —	DRW HANDLE: —	DATE: MAY 10, 2018	
	EMAIL: —	SPECIES: —	TOP: —	PAGE:	

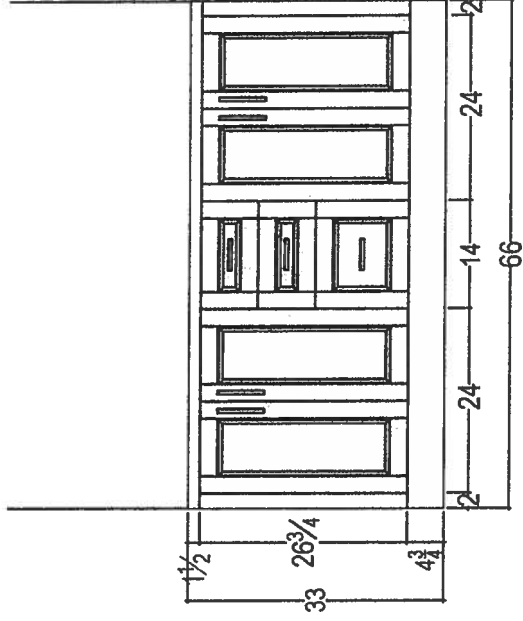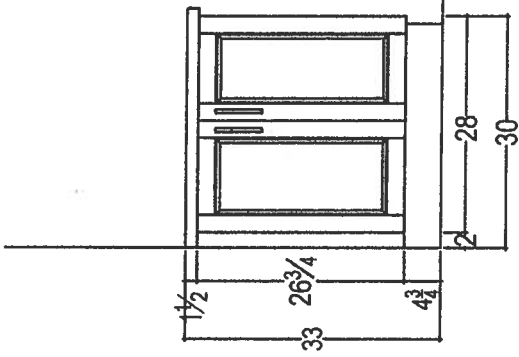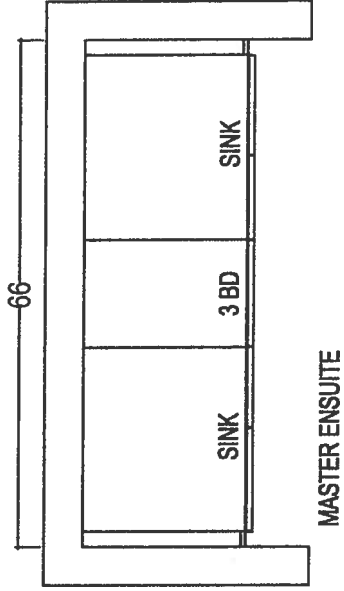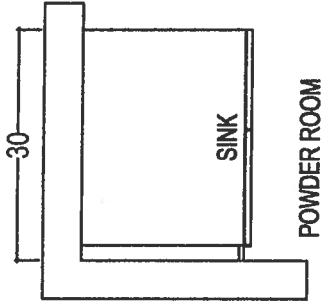

80 SANTE DRIVE, VAUGHAN, ON L4K 3C4,
T: 416.746.1811 F: 905.761.5901

CLIENT: ROYAL PINE HOMES	JOB NAME: UNIT 608 HMP (STANDARD)	ROOM:	VANITIES	DRAWN BY: SK	COMMENTS: PLEASE NOTE ALL DIMENSIONS ARE NOT FINAL AND ARE SUBJECT TO CHANGE UPON FINAL SITE MEASURE	
SITE: HAMPTON PLACE	DOOR STYLE: —	DOOR HANDLE: —				SCALE: 1/2" = 1' - 0"
PHONE: —	FINISH: —	DRW HANDLE: —				DATE: MAY 10, 2018
EMAIL: —	SPECIES: —	TOP: —				PAGE:

Opt. 1st UPG
Kitchen Layout
w/ opt 1st UPG
Appliance PKG

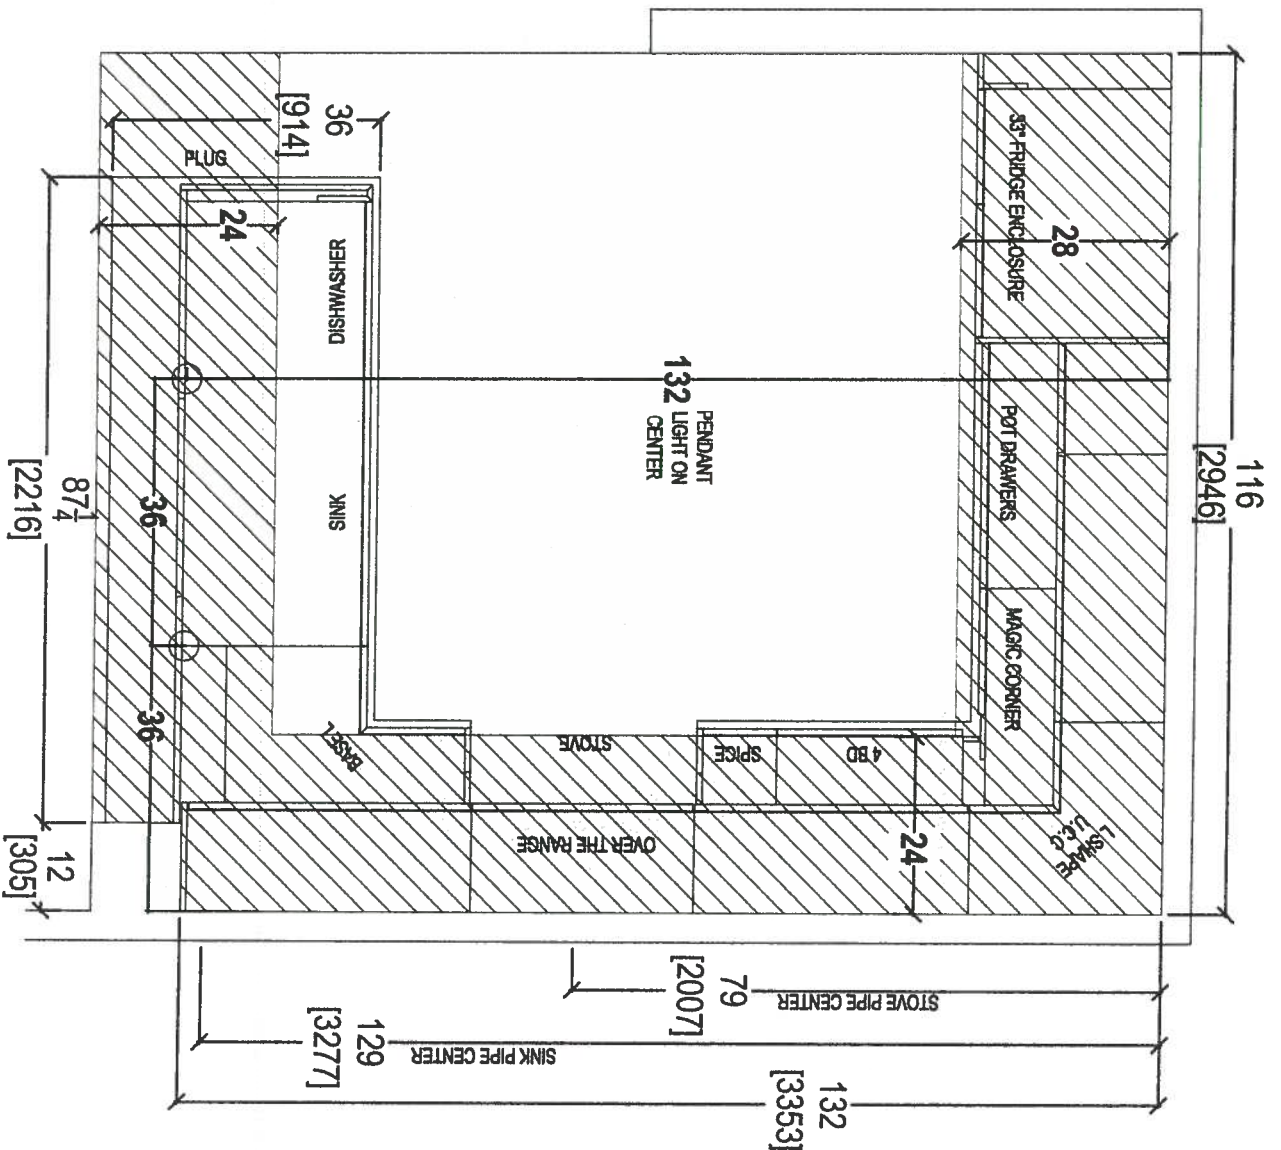

QTH

your kitchen, your taste
80 SANTE DRIVE, VAUGHAN, ON L4K 3C4,
T: 416.748.1811 F: 905.761.5901

CLIENT: ROYAL PINE HOMES

JOB NAME: UNIT 608 HMP

ROOM: KITCHEN FLOOR PLAN

DRAWN BY: SK

SITE: HAMPTON PLACE

DOOR STYLE: —

DOOR HANDLE: —

SCALE: 1/2" = 1' - 0"

PHONE: —

FINISH: —

DRW HANDLE: —

DATE: MAY 1, 2018

EMAIL: —

SPECIES: —


TOP: —

PAGE:

COMMENTS:


PLEASE NOTE ALL DIMENSIONS
ARE NOT FINAL AND ARE
SUBJECT TO CHANGE UPON
FINAL SITE MEASURE

61

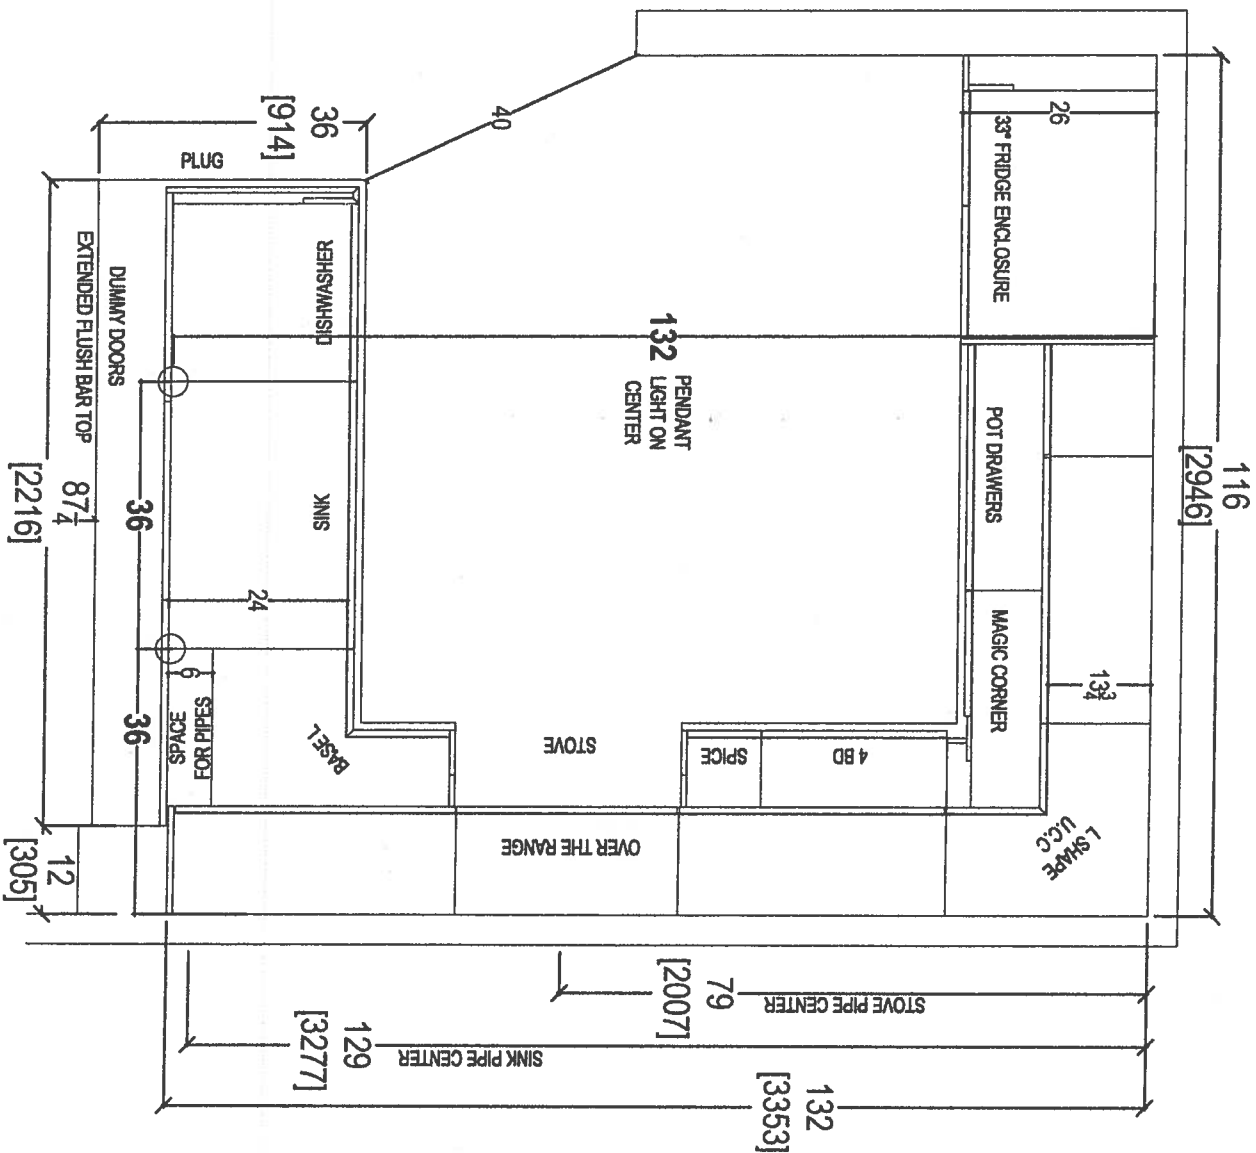

your kitchen, your taste
80 SANTE DRIVE, VAUGHAN, ON L4K 3C4,
T: 416.748.1811 F: 905.761.5901

CLIENT: ROYAL PINE HOMES	JOB NAME: UNIT 609 HMP	ROOM: KITCHEN FLOOR PLAN	DRAWN BY: SK	COMMENTS: PLEASE NOTE ALL DIMENSIONS ARE NOT FINAL AND ARE SUBJECT TO CHANGE UPON FINAL SITE MEASURE
SITE: HAMPTON PLACE	DOOR STYLE: —	DOOR HANDLE: —	SCALE: 1/2" = 1' - 0"	
PHONE: —	FINISH: —	DRW HANDLE: —	DATE: MAY 1, 2018	
EMAIL: —	SPECIES: —	TOP: —	PAGE:	

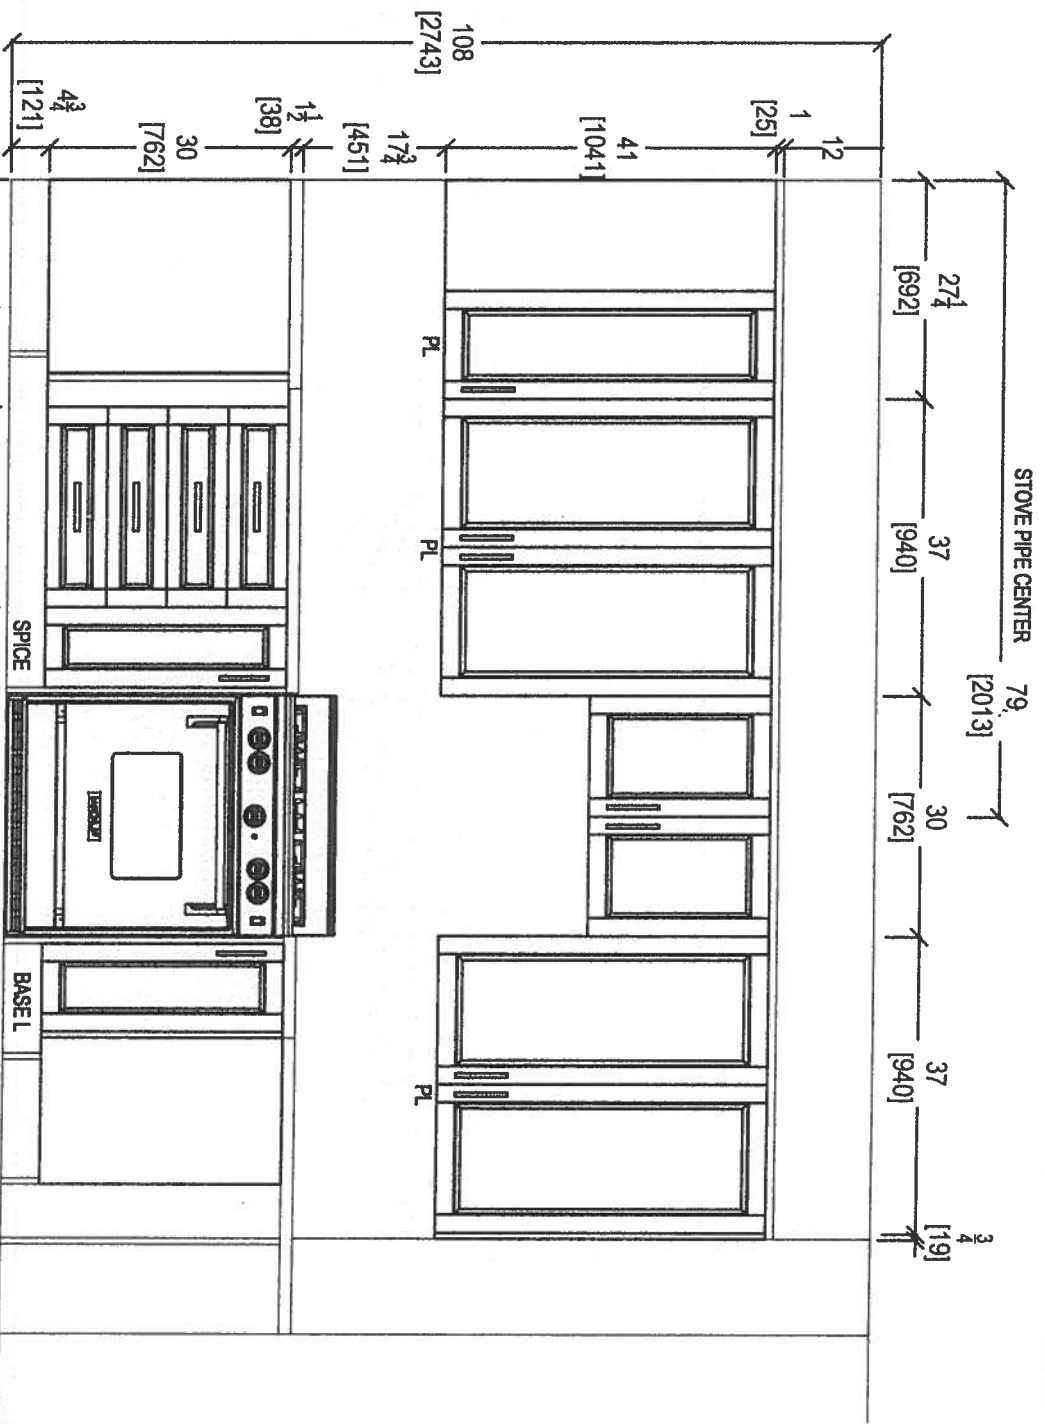


STOVE WALL ELEVATION

CLIENT: ROYAL PINE HOMES	JOB NAME: UNIT 609 HMP	ROOM: KITCHEN	DRAWN BY: SK
SITE: HAMPTON PLACE	DOOR STYLE: —	DOOR HANDLE: —	SCALE: 1/2" = 1'-0"
PHONE: —	FINISH: —	DRW HANDLE: —	DATE: MAY 1, 2018
EMAIL: —	SPECIES: —	TOP: —	PAGE: —



your kitchen, your taste
80 SANTE DRIVE, VAUGHAN, ON L4K 3C4,
T: 416.748.1811 F: 905.761.5901

COMMENTS:
PLEASE NOTE ALL DIMENSIONS
ARE NOT FINAL AND ARE
SUBJECT TO CHANGE UPON
FINAL SITE MEASURE

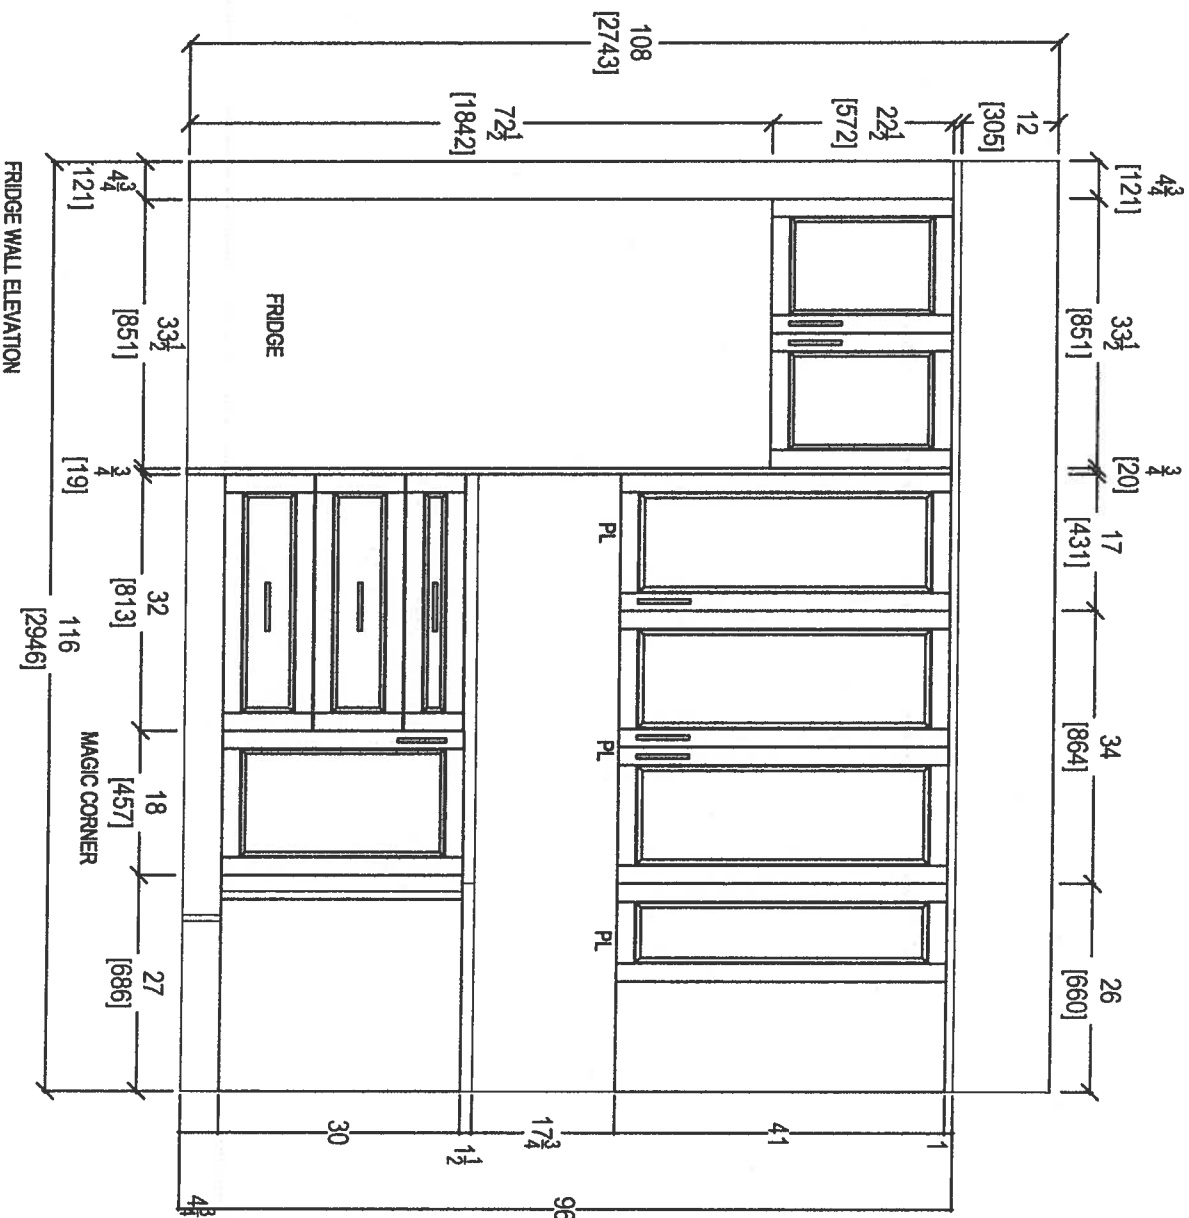

CLIENT: ROYAL PINE HOMES	JOB NAME: UNIT 609 HMP	ROOM: KITCHEN	DRAWN BY: SK
--------------------------	------------------------	---------------	--------------

SITE: HAMPTON PLACE	DOOR STYLE: —	DOOR HANDLE: —	SCALE: 1/2" = 1' - 0"
---------------------	---------------	----------------	-----------------------

PHONE: —	FINISH: —	DRW HANDLE: —	DATE: MAY 1, 2018
----------	-----------	---------------	-------------------


EMAIL: —	SPECIES: —	TOP: —	PAGE: —
----------	------------	--------	---------

COMMENTS:
PLEASE NOTE ALL DIMENSIONS
ARE NOT FINAL, AND ARE
SUBJECT TO CHANGE UPON
FINAL SITE MEASURE




80 SANTE DRIVE, VAUGHAN, ON L4K 3C4,
T: 416.746.1811 F: 905.761.4901

9A

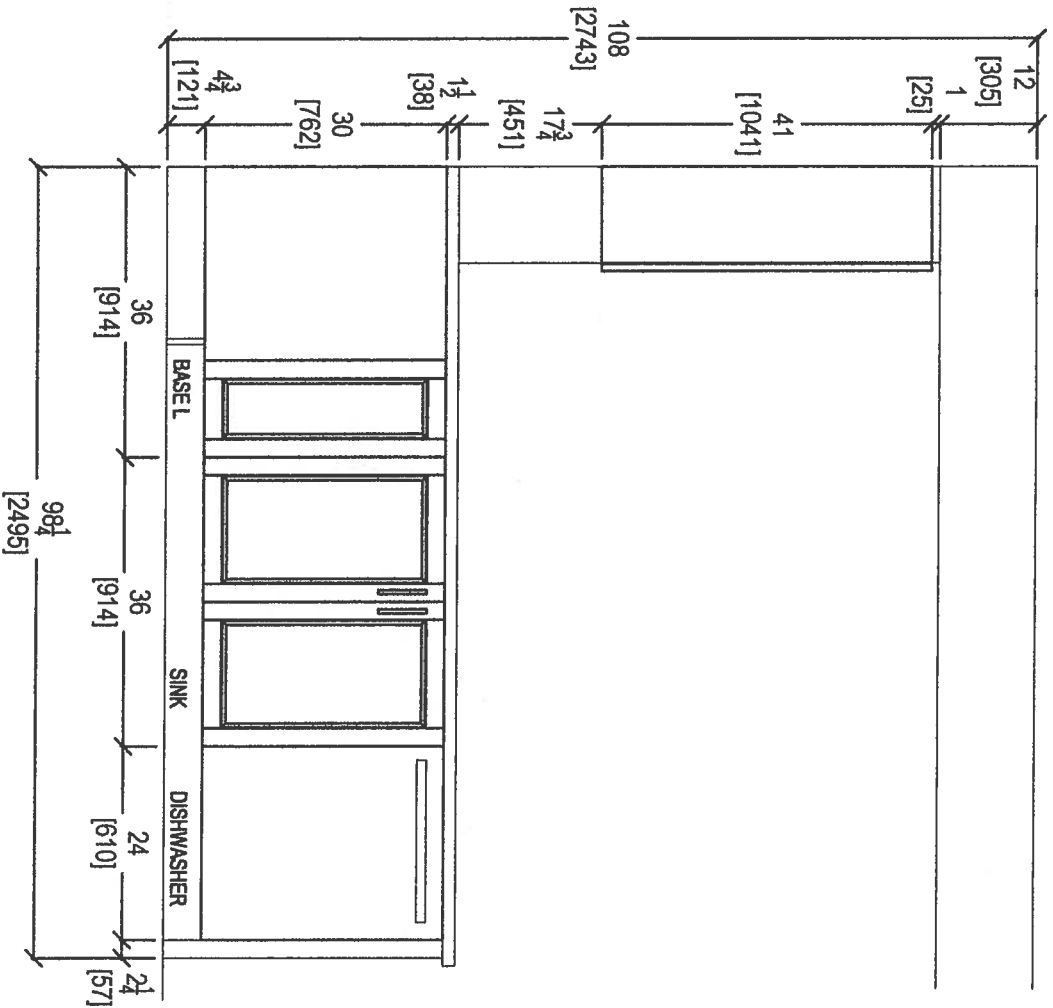

KITCHEN PENINSULA ELEVATION
FRONT VIEW

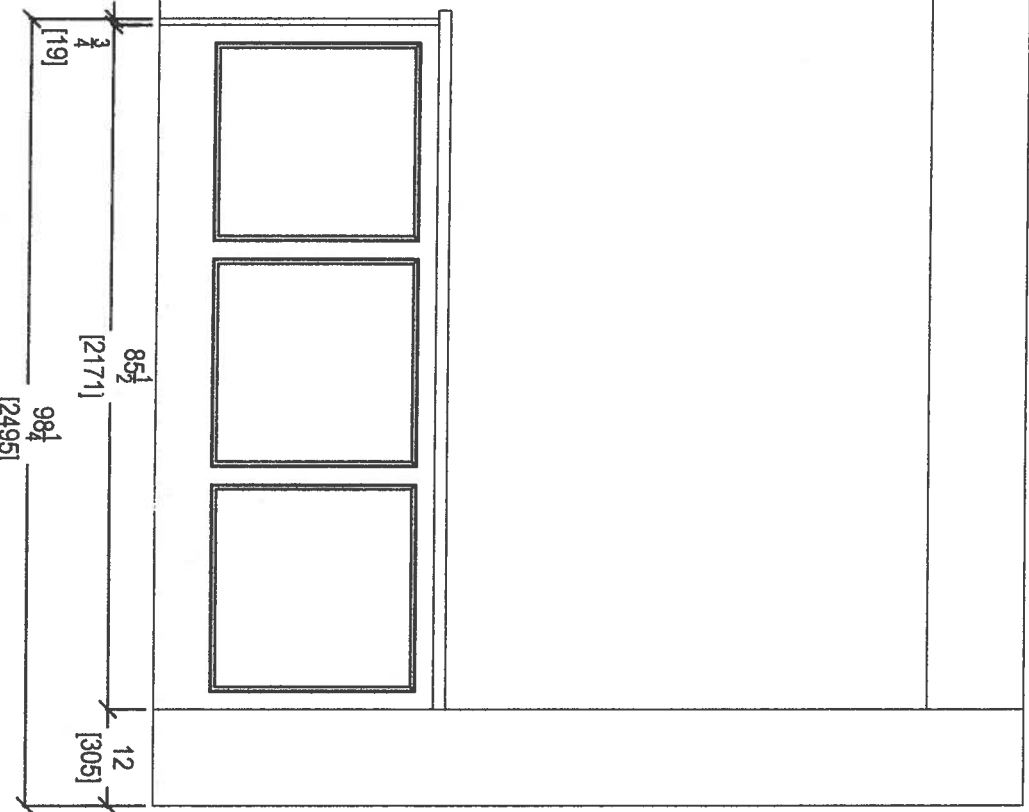

KITCHEN PENINSULA ELEVATION
REAR VIEW

CLIENT: ROYAL PINE HOMES	JOB NAME: UNIT 609 HMP	ROOM: KITCHEN	DRAWN BY: SK
SITE: HAMPTON PLACE	DOOR STYLE: —	DOOR HANDLE: —	SCALE: 1/2" = 1' - 0"
PHONE: —	FINISH: —	DRW HANDLE: —	DATE: MAY 1, 2018
EMAIL: —	SPECIES: —	TOP: —	PAGE:


COMMENTS:

PLEASE NOTE ALL DIMENSIONS
ARE NOT FINAL AND ARE
SUBJECT TO CHANGE UPON
FINAL SITE MEASURE




80 SANTE DRIVE, VAUGHAN, ON L4K 3C4,
T: 416.748.1811 F: 905.761.5001



61

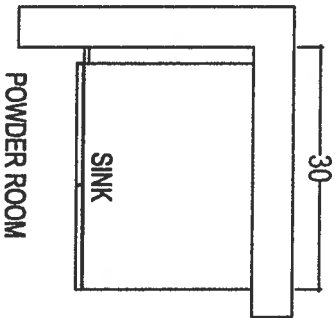

POWDER ROOM

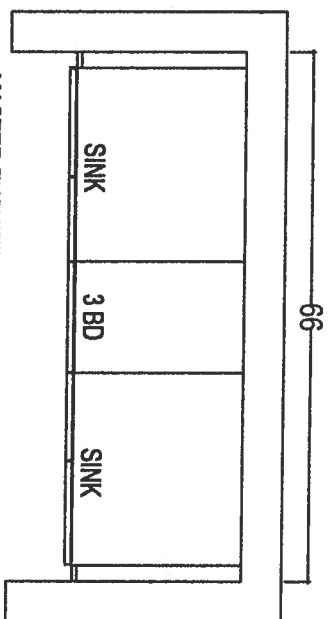

MASTER ENSUITE

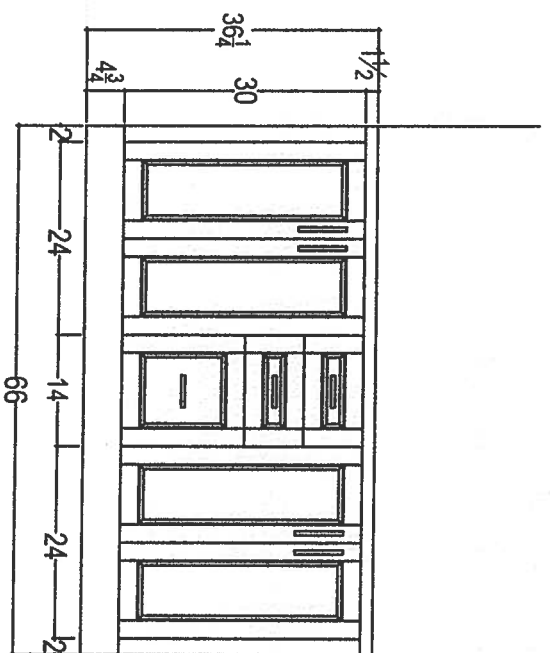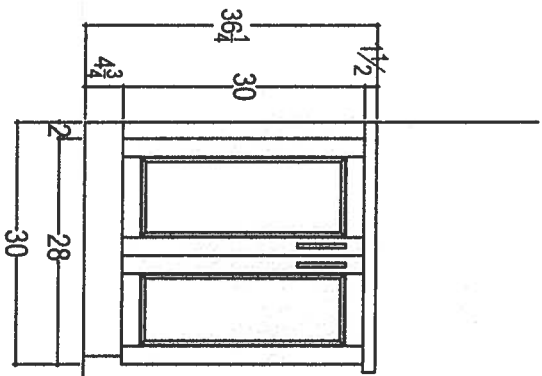

your kitchen, your taste.
80 SANTE DRIVE, VAUGHAN, ON L4K 3C4,
T: 416.748.1811 F: 905.761.8901

CLIENT: ROYAL PINE HOMES	JOB NAME: UNIT 609 HMP	ROOM: VANITIES	DRAWN BY: SK
SITE: HAMPTON PLACE	DOOR STYLE: —	DOOR HANDLE: —	SCALE: 1/2" = 1' - 0"
PHONE: —	FINISH: —	DRW HANDLE: —	DATE: MAY 1, 2018
EMAIL: —	SPECIES: —	TOP: —	PAGE:

COMMENTS:
PLEASE NOTE ALL DIMENSIONS
ARE NOT FINAL AND ARE
SUBJECT TO CHANGE UPON
FINAL SITE MEASURE