








Sag Harbor

SUITE 610

ORIGINAL LAYOUT

INVENTORY SUITE

878 SQ FT plus 119 sq. ft. of balcony area

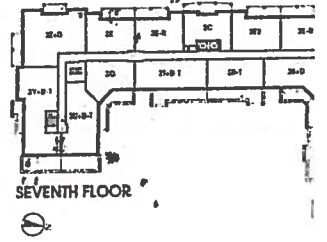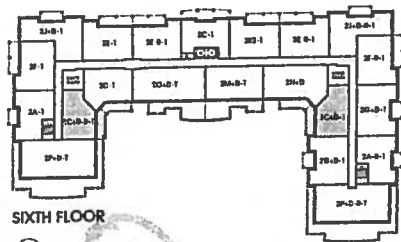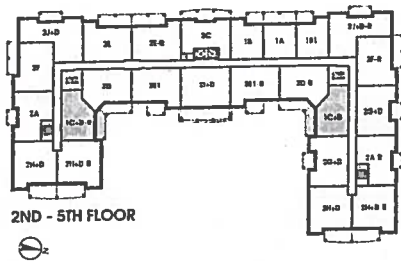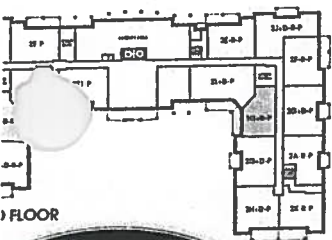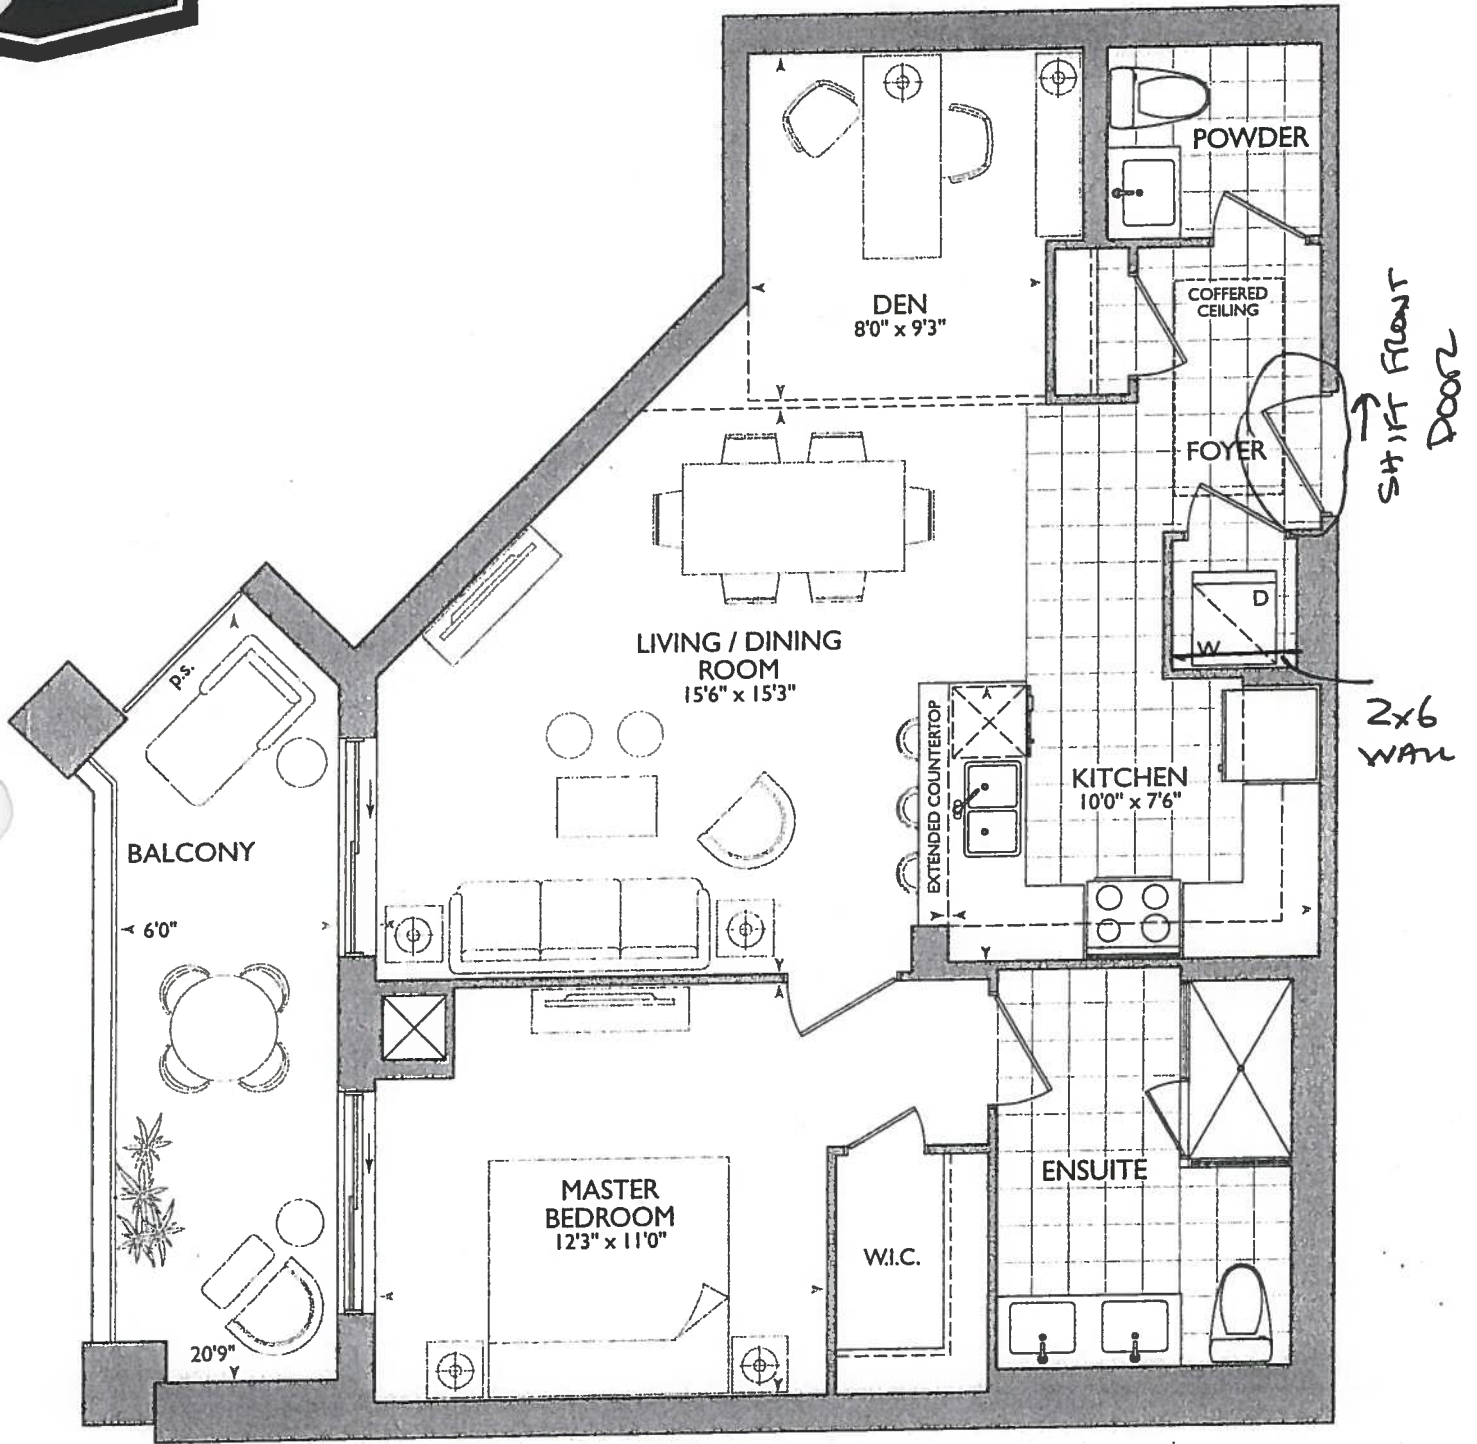

13

Suite 610 - INVENT SUITE

KITCHEN


- STD KITCHEN LAYOUT
- STD APPLIANCE PKG
- (x3) = PUCK LIGHTS
- (x1) = PLUG PENINSULA
- (x2) = CAPPED PENDANT LIGHTS
- 66" - STOVE PIPE CENTER
- 117" SINK PRE CENTER

OR

OPTIONAL 1ST UPG KIT. LAYOUT
W 1ST UPGRADE APPLIANCE
PKG
see upg. KIT LAYOUT

* BARRIER
FREE
SUITE *


* SHIFT FRONT DOOR
TOWARDS MAIN WASHTROOM
DUE 2x6 WALL
ADDED BEHIND
WASH/DRYER

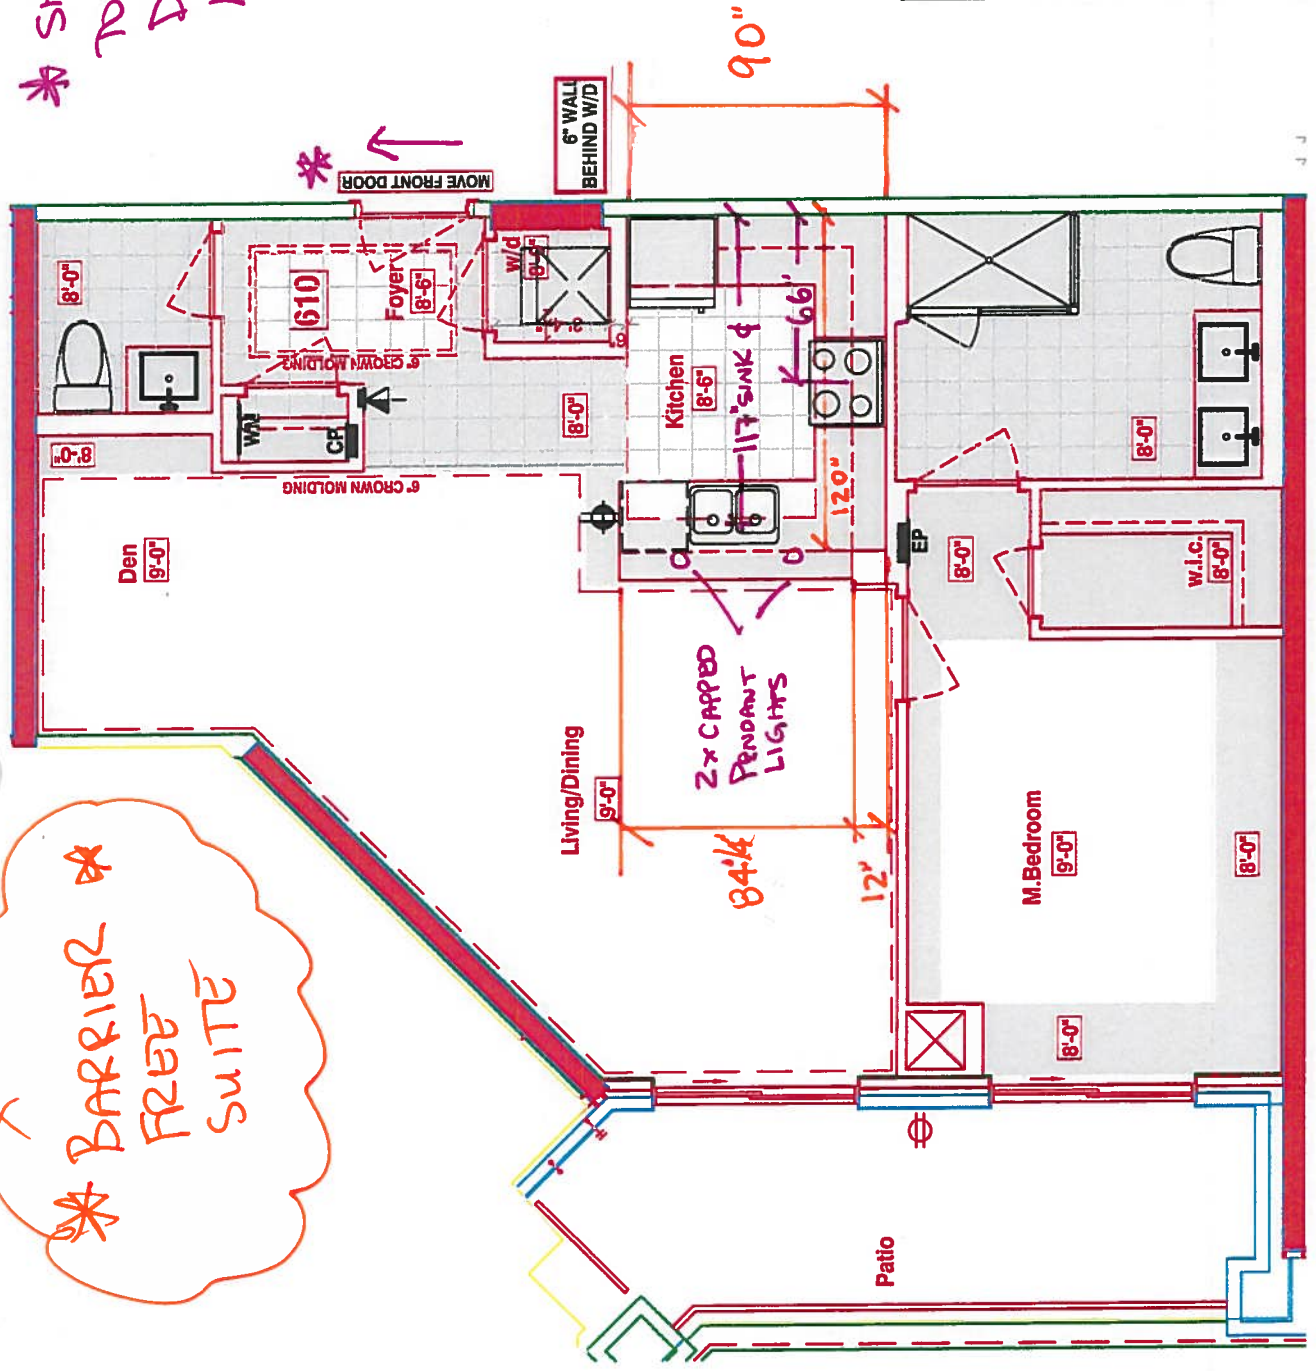

Suite 610


Inventory Suite

- STD KITCHEN LAYOUT
- STD APPLANCE PKG
- (x3) = PUCK LIGHTS
- (x1) = Plug Peninsula
- (x2) = Capped Pendant Lights


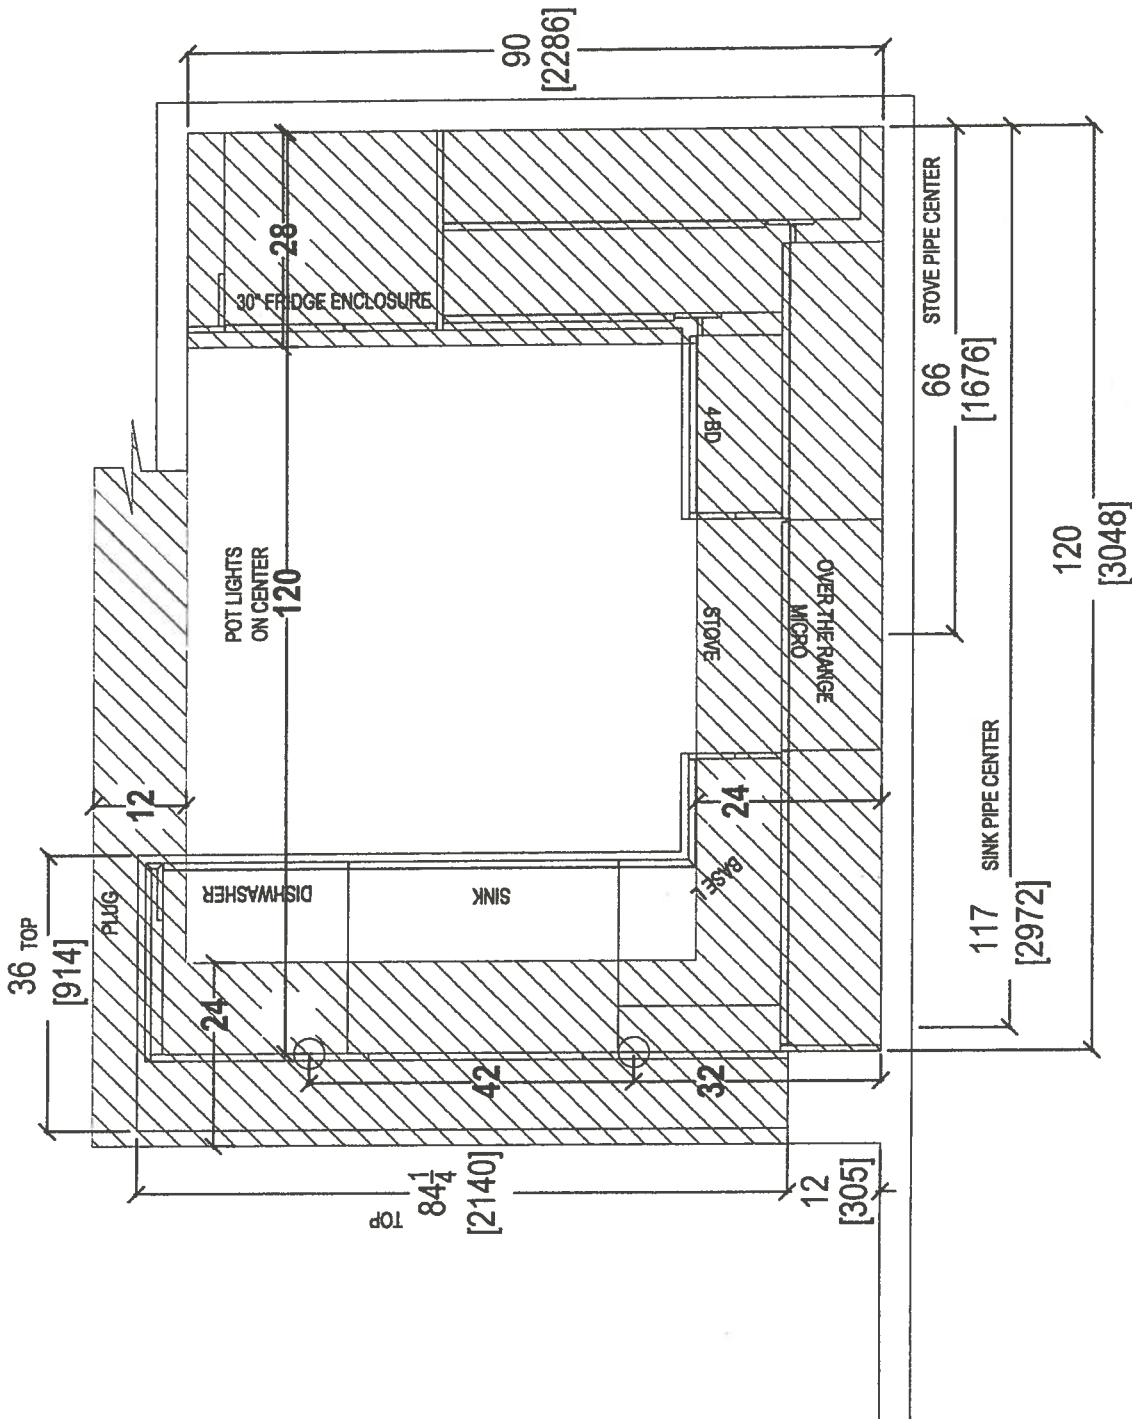


your kitchen, your taste.
80 SANTE DRIVE, VAUGHAN, ON L4K 3C4,
T: 416.746.1811 F: 905.781.5901





CLIENT: ROYAL PINE HOMES SITE: HAMPTON PLACE PHONE: — EMAIL: —	JOB NAME: 610 HMP (STANDARD)	ROOM: KITCHEN FLOOR PLAN	DRAWN BY: SK	COMMENTS: PLEASE NOTE ALL DIMENSIONS ARE NOT FINAL AND ARE SUBJECT TO CHANGE UPON FINAL SITE MEASURE	
	DOOR STYLE: —	DOOR HANDLE: —	SCALE: 1/2" = 1' - 0"		
	FINISH: —	DRW HANDLE: —	DATE: MAY 10, 2018		
	SPECIES: —	TOP: —	PAGE:		

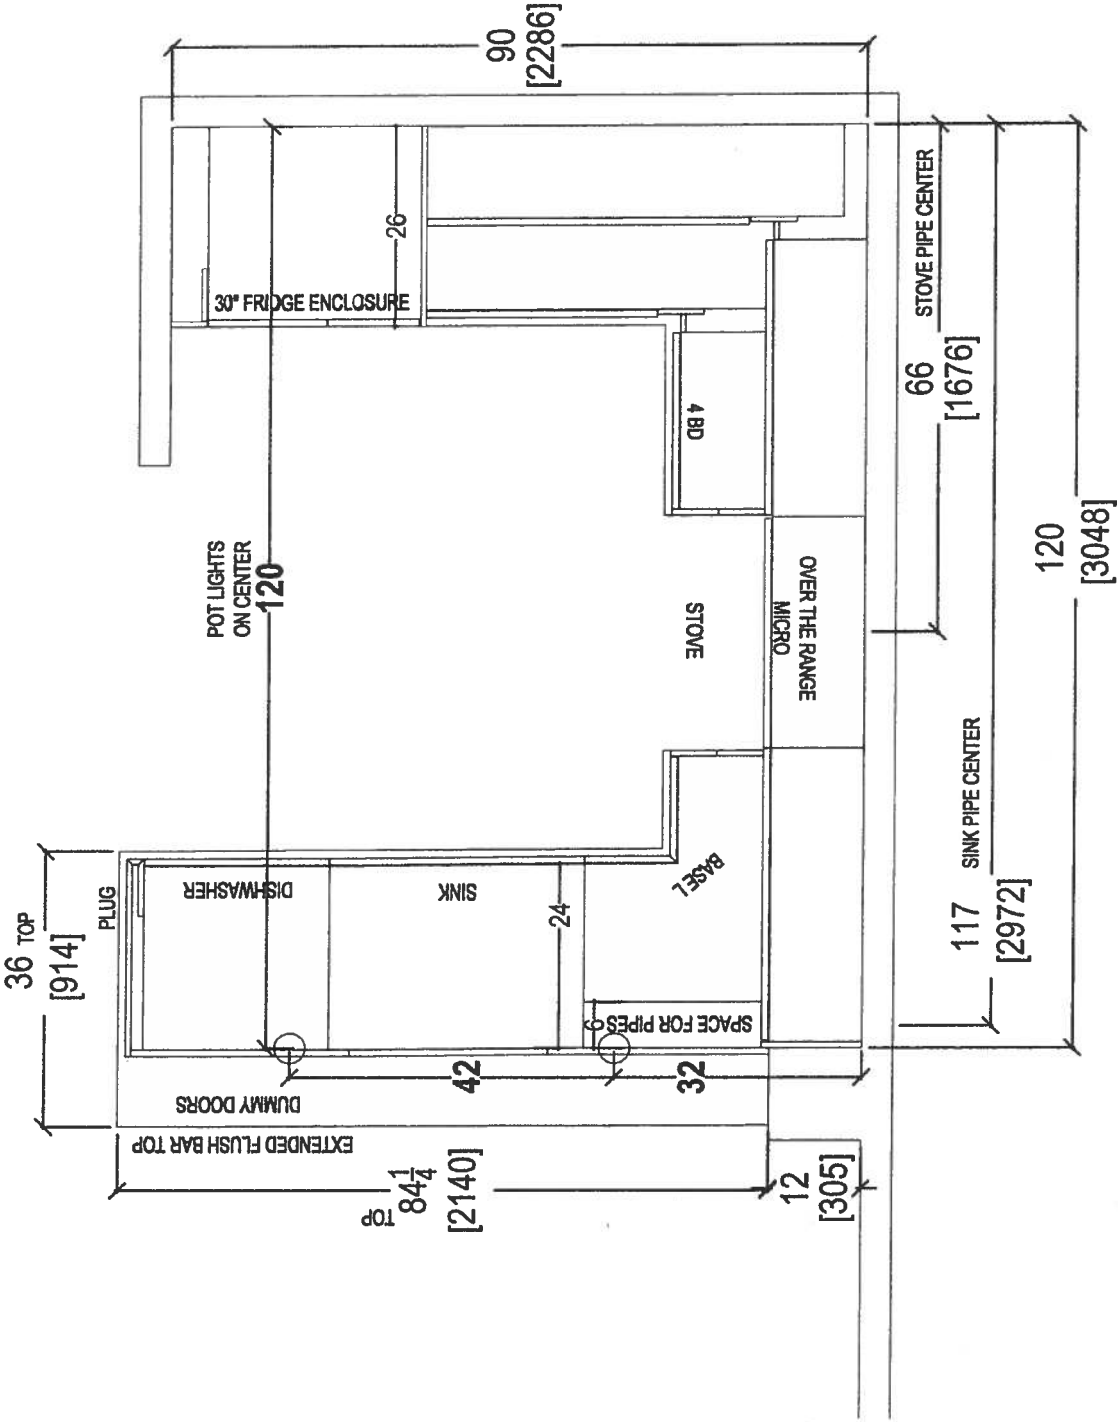

 your kitchen. your taste. 80 SANTE DRIVE, VAUGHAN, ON L4K 3C4. T: 416.748.1811 F: 905.761.5801	CLIENT: ROYAL PINE HOMES	JOB NAME: 610 HMP (STANDARD)	ROOM: KITCHEN FLOOR PLAN	DRAWN BY: SK	COMMENTS: PLEASE NOTE ALL DIMENSIONS ARE NOT FINAL AND ARE SUBJECT TO CHANGE UPON FINAL SITE MEASURE
	SITE: HAMPTON PLACE	DOOR STYLE: —	DOOR HANDLE: —	SCALE: 1/2" = 1'-0"	
	PHONE: —	FINISH: —	DRW HANDLE: —	DATE: MAY 10, 2018	
	EMAIL: —	SPECIES: —	TOP: —	PAGE:	

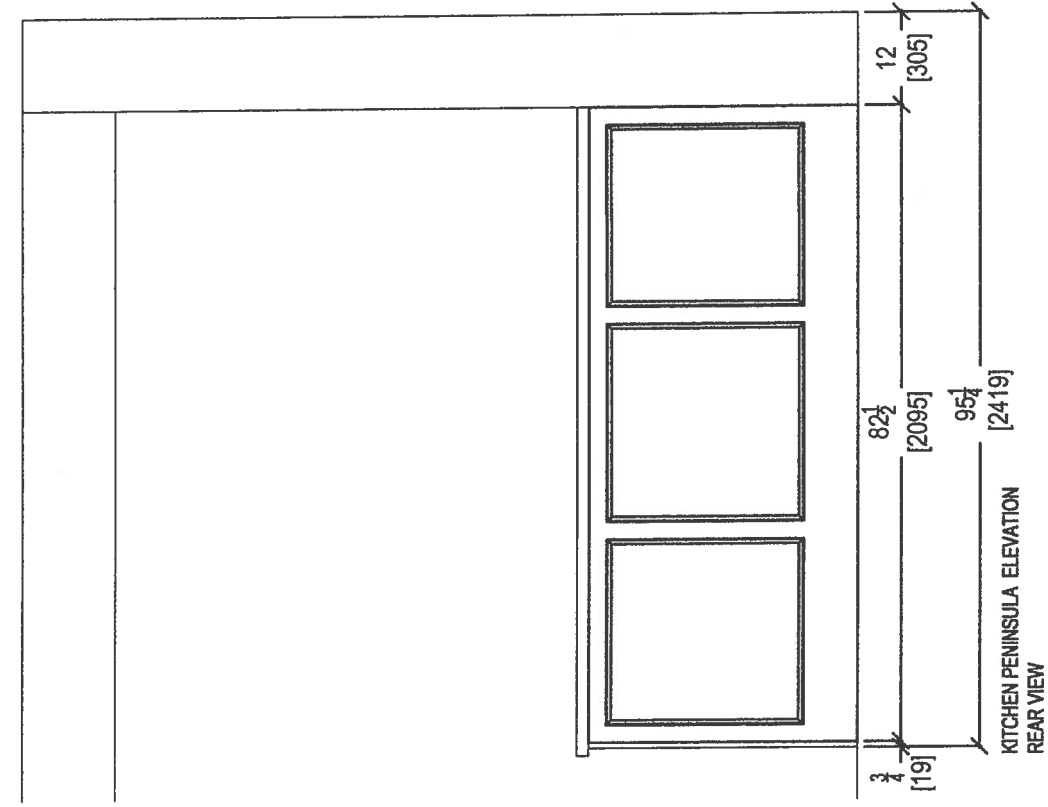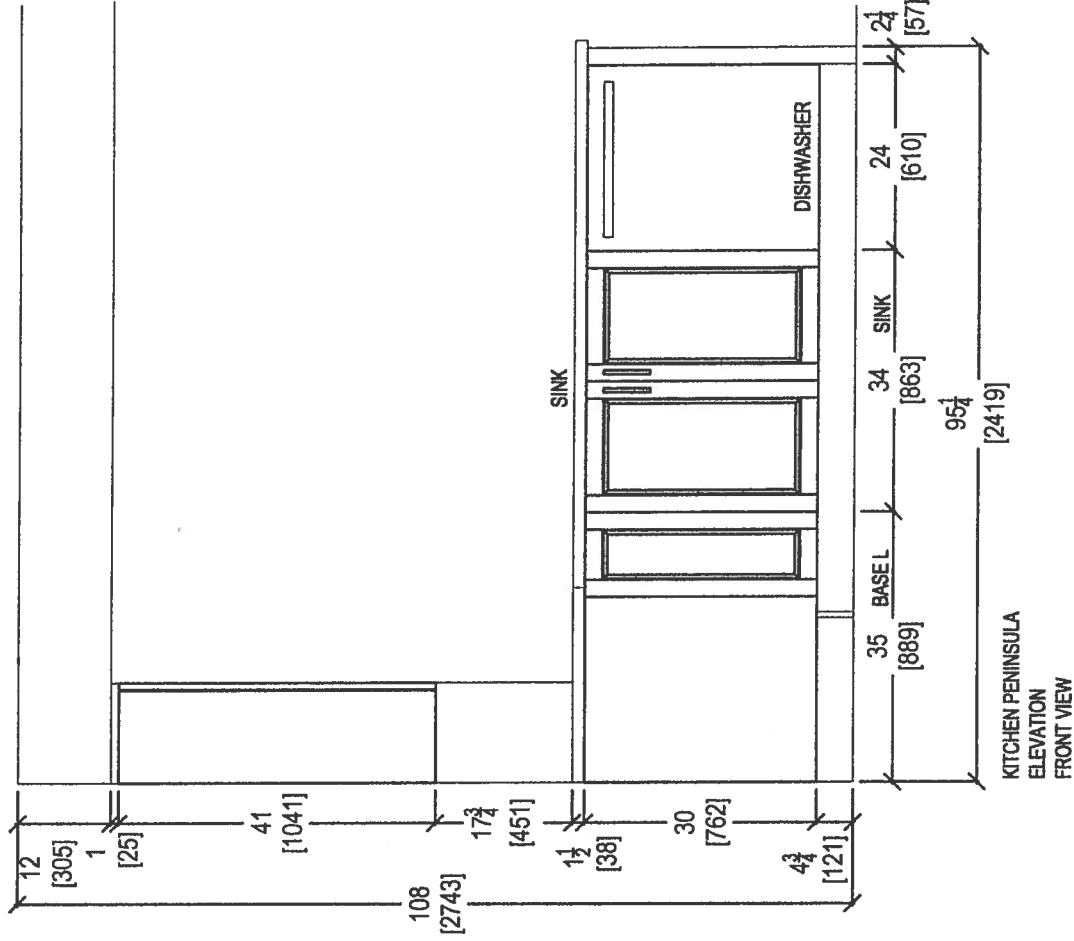

 your kitchen, your taste 80 SANTE DRIVE, VAUGHAN, ON L4K 3C4, T: 416.746.1811 F: 905.761.5901		CLIENT: ROYAL PINE HOMES	JOB NAME: 610 HMP (STANDARD)	ROOM: KITCHEN	DRAWN BY: SK	COMMENTS: PLEASE NOTE ALL DIMENSIONS ARE NOT FINAL AND ARE SUBJECT TO CHANGE UPON FINAL SITE MEASURE
		SITE: HAMPTON PLACE	DOOR STYLE: —	DOOR HANDLE: —	SCALE: 1/2" = 1' - 0"	
		PHONE: —	FINISH: —	DRW HANDLE: —	DATE: MAY 10, 2018	
		EMAIL: —	SPECIES: —	TOP: —	PAGE:	

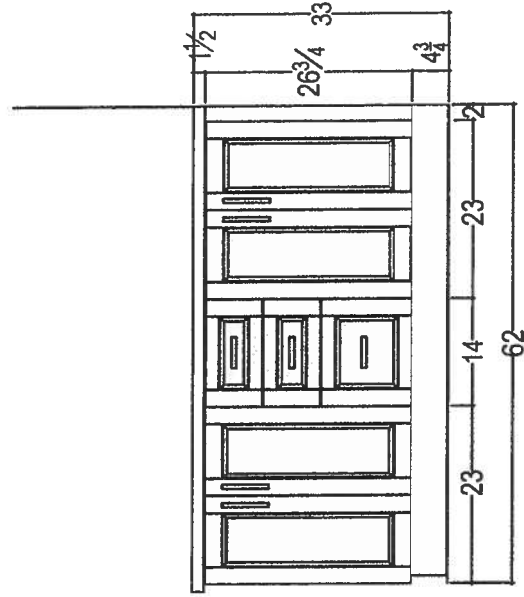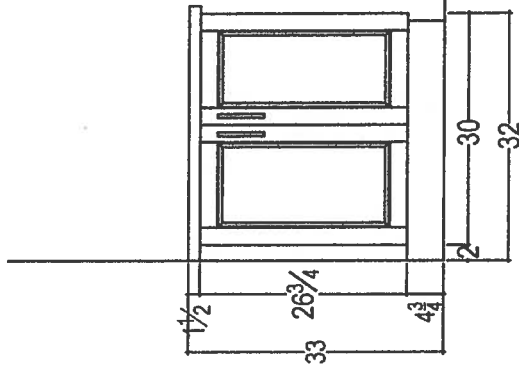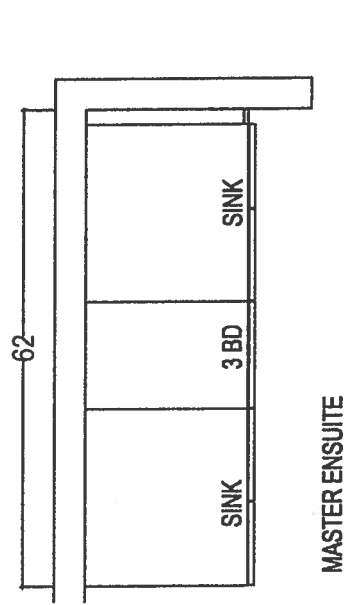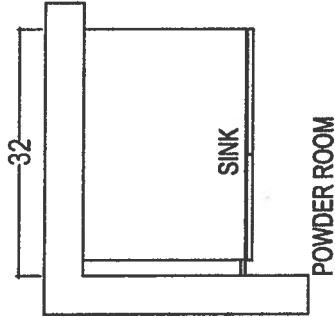


your kitchen, your taste.
80 SANTE DRIVE, VAUGHAN, ON L4K 3C4,
T: 416.748.1811 F: 905.761.5901

CLIENT: ROYAL PINE HOMES SITE: HAMPTON PLACE PHONE: --- EMAIL: ---	JOB NAME: 610 HMP (STANDARD)	ROOM:	DRAWN BY: SK	COMMENTS: PLEASE NOTE ALL DIMENSIONS ARE NOT FINAL AND ARE SUBJECT TO CHANGE UPON FINAL SITE MEASURE
	DOOR STYLE: ---	DOOR HANDLE: ---	SCALE: 1/2" = 1' - 0"	
	FINISH: ---	DRW HANDLE: ---	DATE: MAY 10, 2018	
	SPECIES: ---	TOP: ---	PAGE:	


UPGRADE
* KITCHEN *
* LAYOUT *
* OPTIONAL *

UPGRADE
* KITCHEN *
* LAYOUT *
* OPTIONAL *

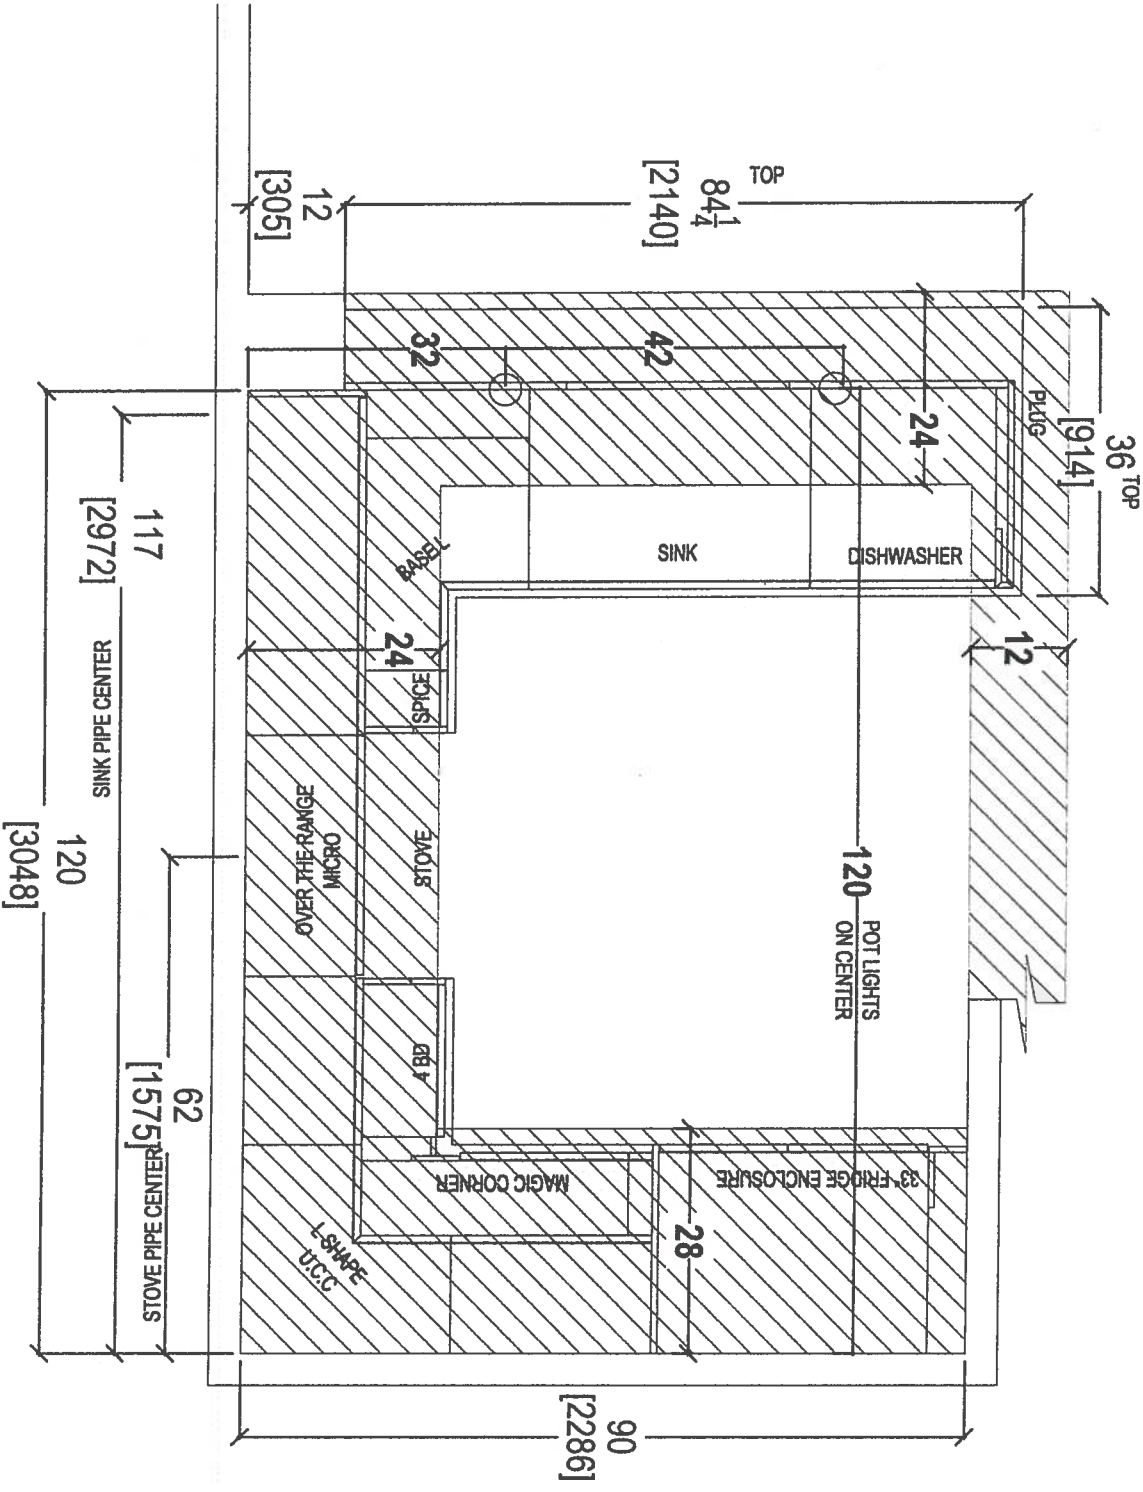

80 SANTE DRIVE, VAUGHAN, ON L4K 3C4,
T: 416.746.1811 F: 905.761.5901

CLIENT: ROYAL PINE HOMES	JOB NAME: 610 HMP	ROOM: KITCHEN FLOOR PLAN	DRAWN BY: SK	COMMENTS:
SITE: HAMPTON PLACE	DOOR STYLE: —	DOOR HANDLE: —	SCALE: 1/2" = 1'-0"	PLEASE NOTE ALL DIMENSIONS ARE NOT FINAL AND ARE SUBJECT TO CHANGE UPON FINAL SITE MEASURE
PHONE: —	FINISH: —	DRW HANDLE: —	DATE: MAY 1, 2018	
EMAIL: —	SPECIES: —	TOP: —	PAGE:	


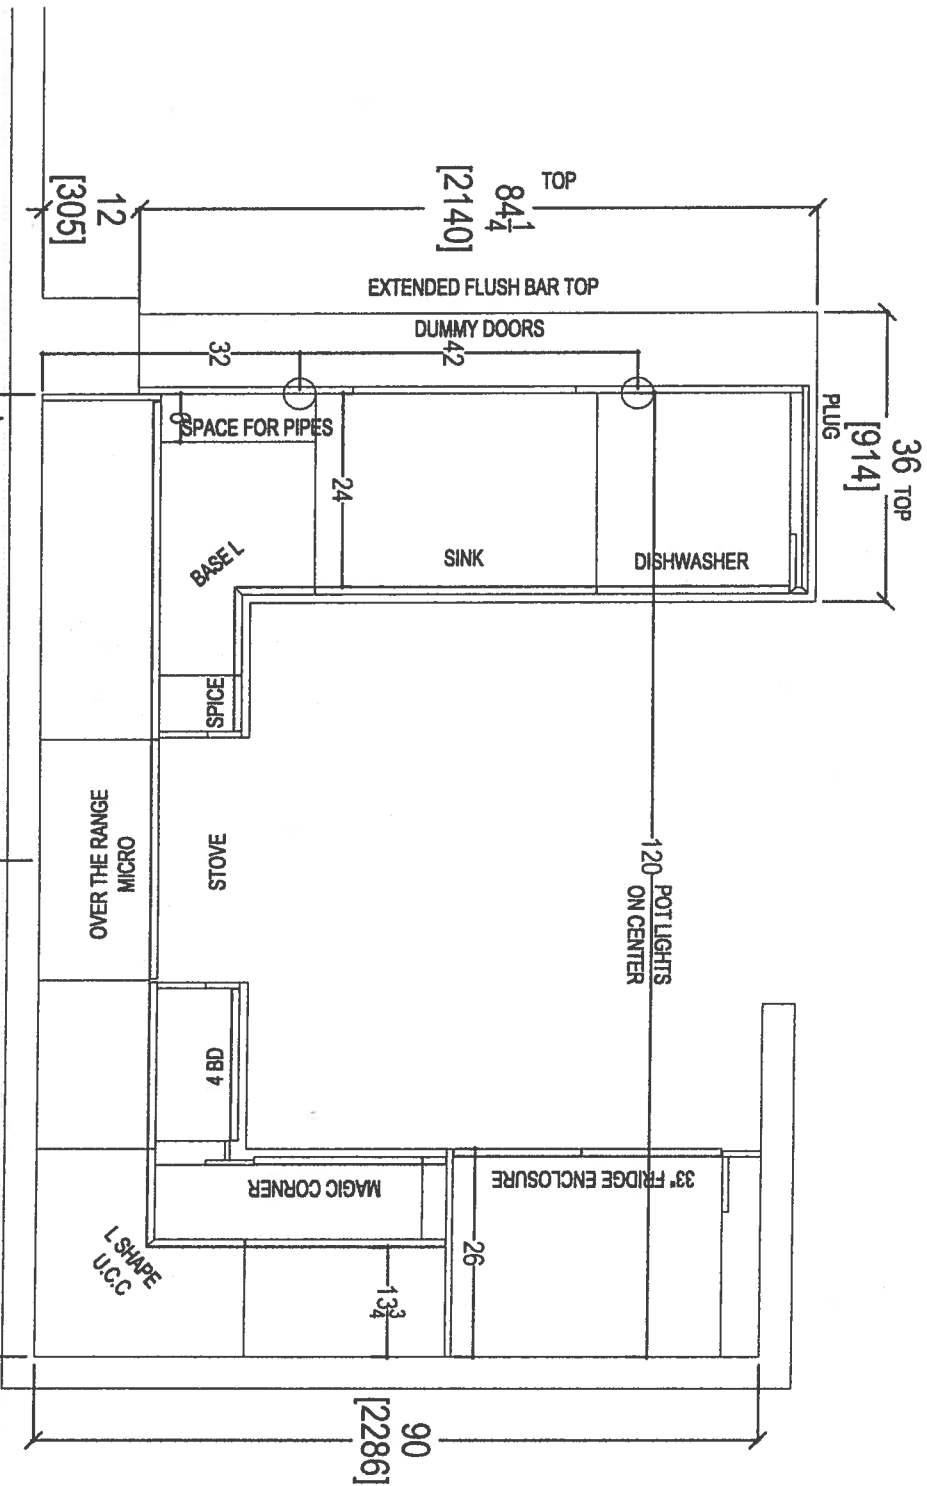


CLIENT: ROYAL PINE HOMES	JOB NAME: 610 HMP	ROOM: KITCHEN FLOOR PLAN	DRAWN BY: SK
SITE: HAMPTON PLACE	DOOR STYLE: —	DOOR HANDLE: —	SCALE: 1/2" = 1' - 0"
PHONE: —	FINISH: —	DRW HANDLE: —	DATE: MAY 1, 2018
EMAIL: —	SPECIES: —	TOP: —	PAGE:

COMMENTS:
PLEASE NOTE ALL DIMENSIONS
ARE NOT FINAL AND ARE
SUBJECT TO CHANGE UPON
FINAL SITE MEASURE




80 SANTE DRIVE, VAUGHAN, ON L4K 3C4,
T: 416.746.1811 F: 905.781.5801

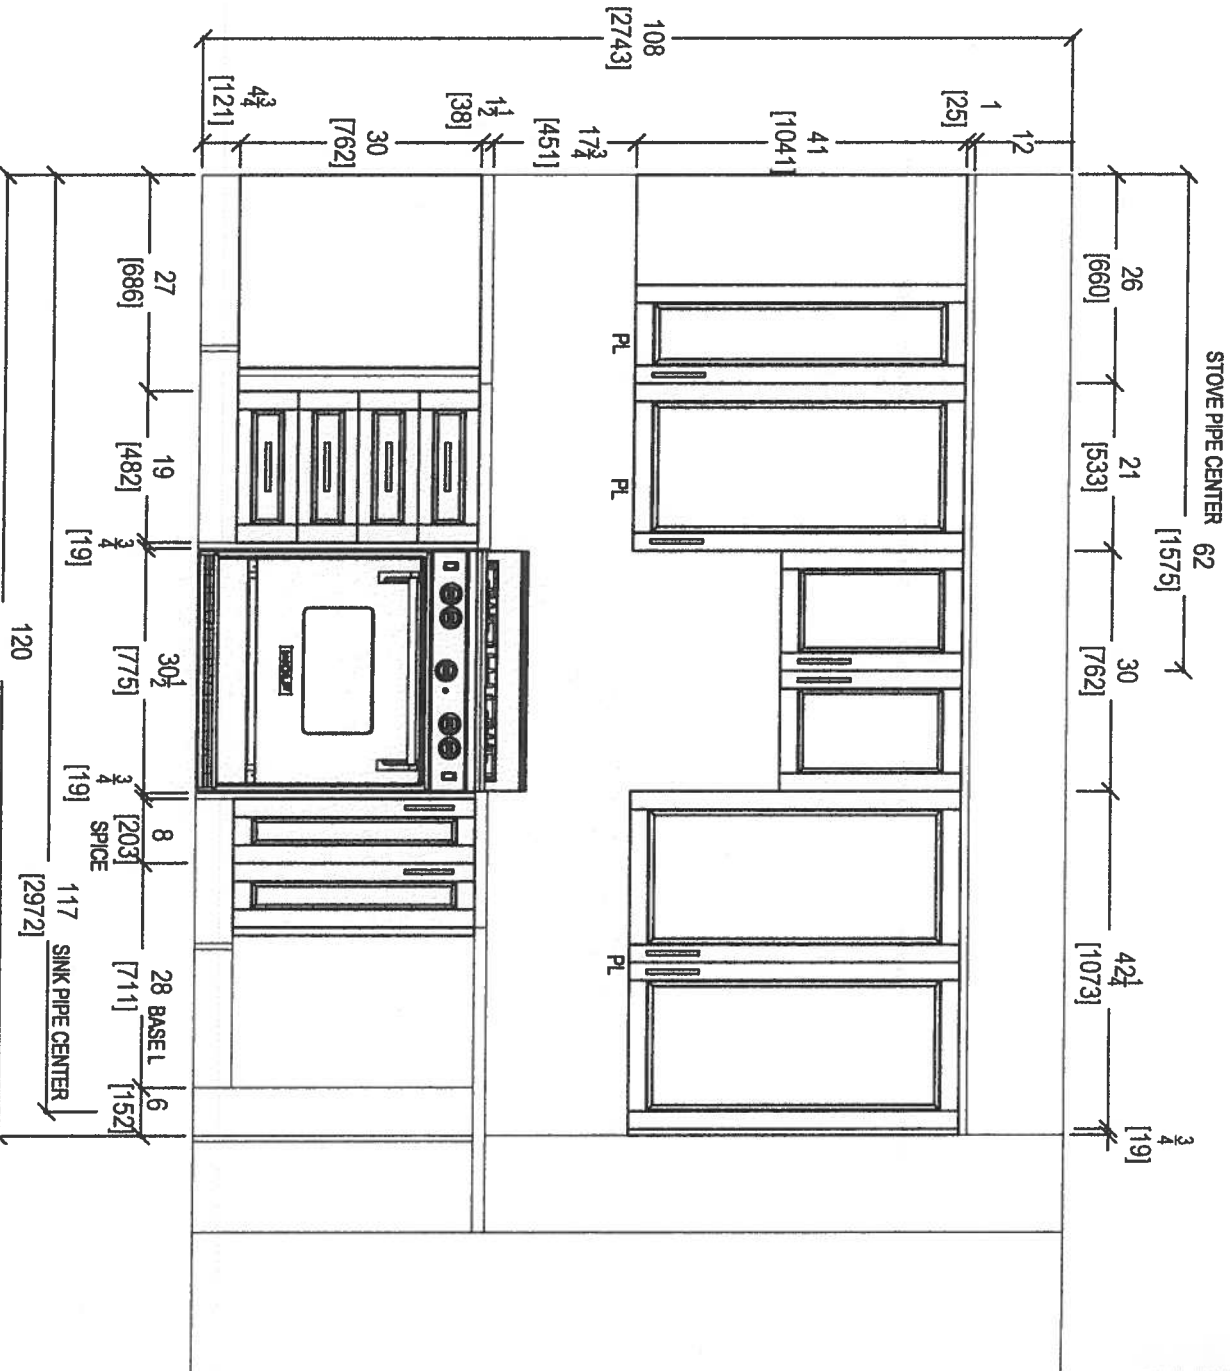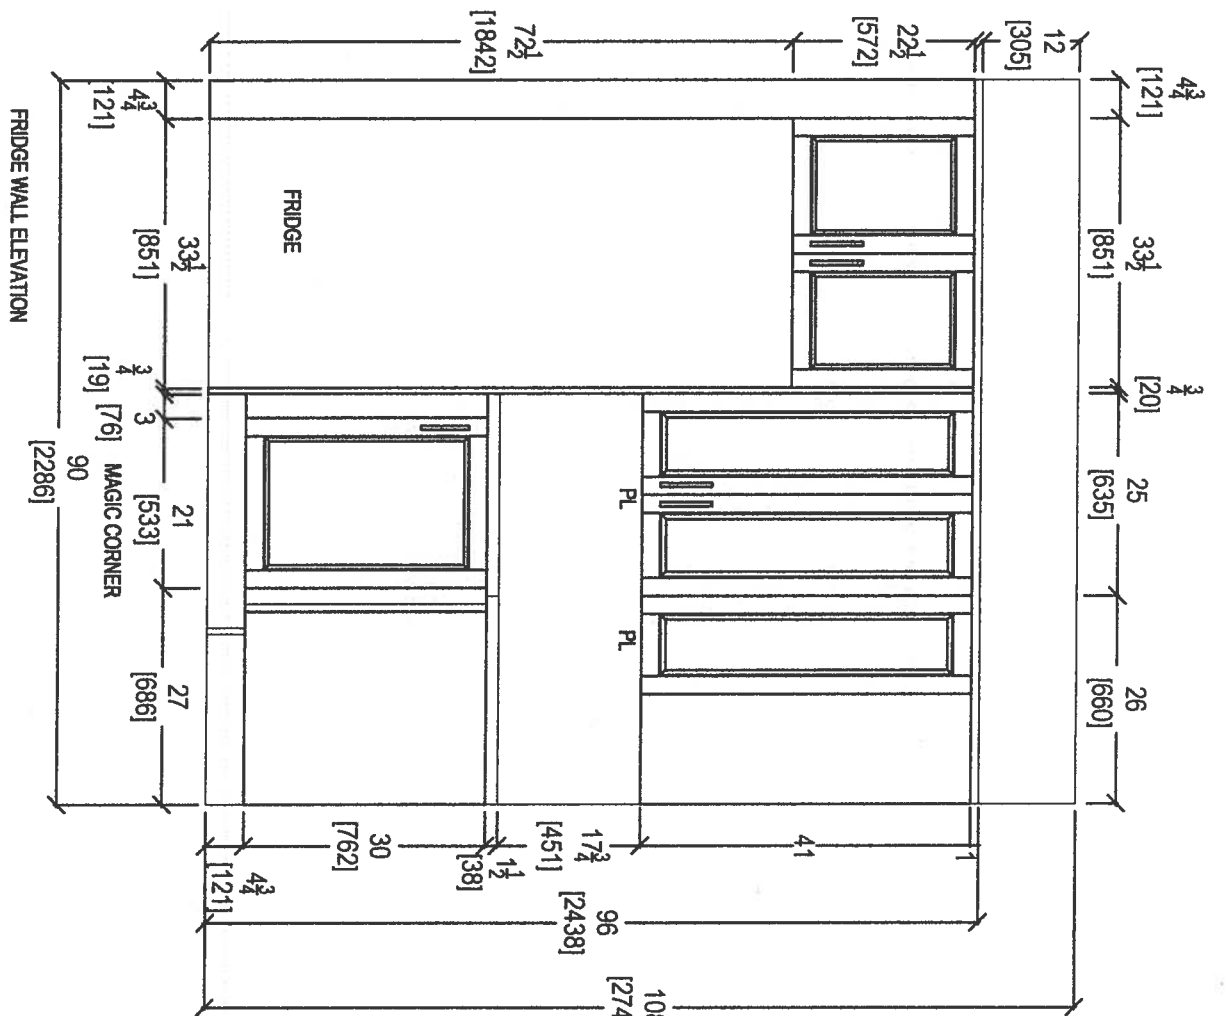

80 SANTE DRIVE, VAUGHAN, ON L4K 3C4,
T: 416.746.1811 F: 905.761.5901


CLIENT: ROYAL PINE HOMES		JOB NAME: 610 HMP	ROOM: KITCHEN	DRAWN BY: SK	COMMENTS: PLEASE NOTE ALL DIMENSIONS ARE NOT FINAL AND ARE SUBJECT TO CHANGE UPON FINAL SITE MEASURE
SITE: HAMPTON PLACE	DOOR STYLE: —		DOOR HANDLE: —	SCALE: 1/2" = 1' - 0"	
PHONE: —	FINISH: —		DRW HANDLE: —	DATE: MAY 1, 2018	
EMAIL: —	SPECIES: —		TOP: —	PAGE:	

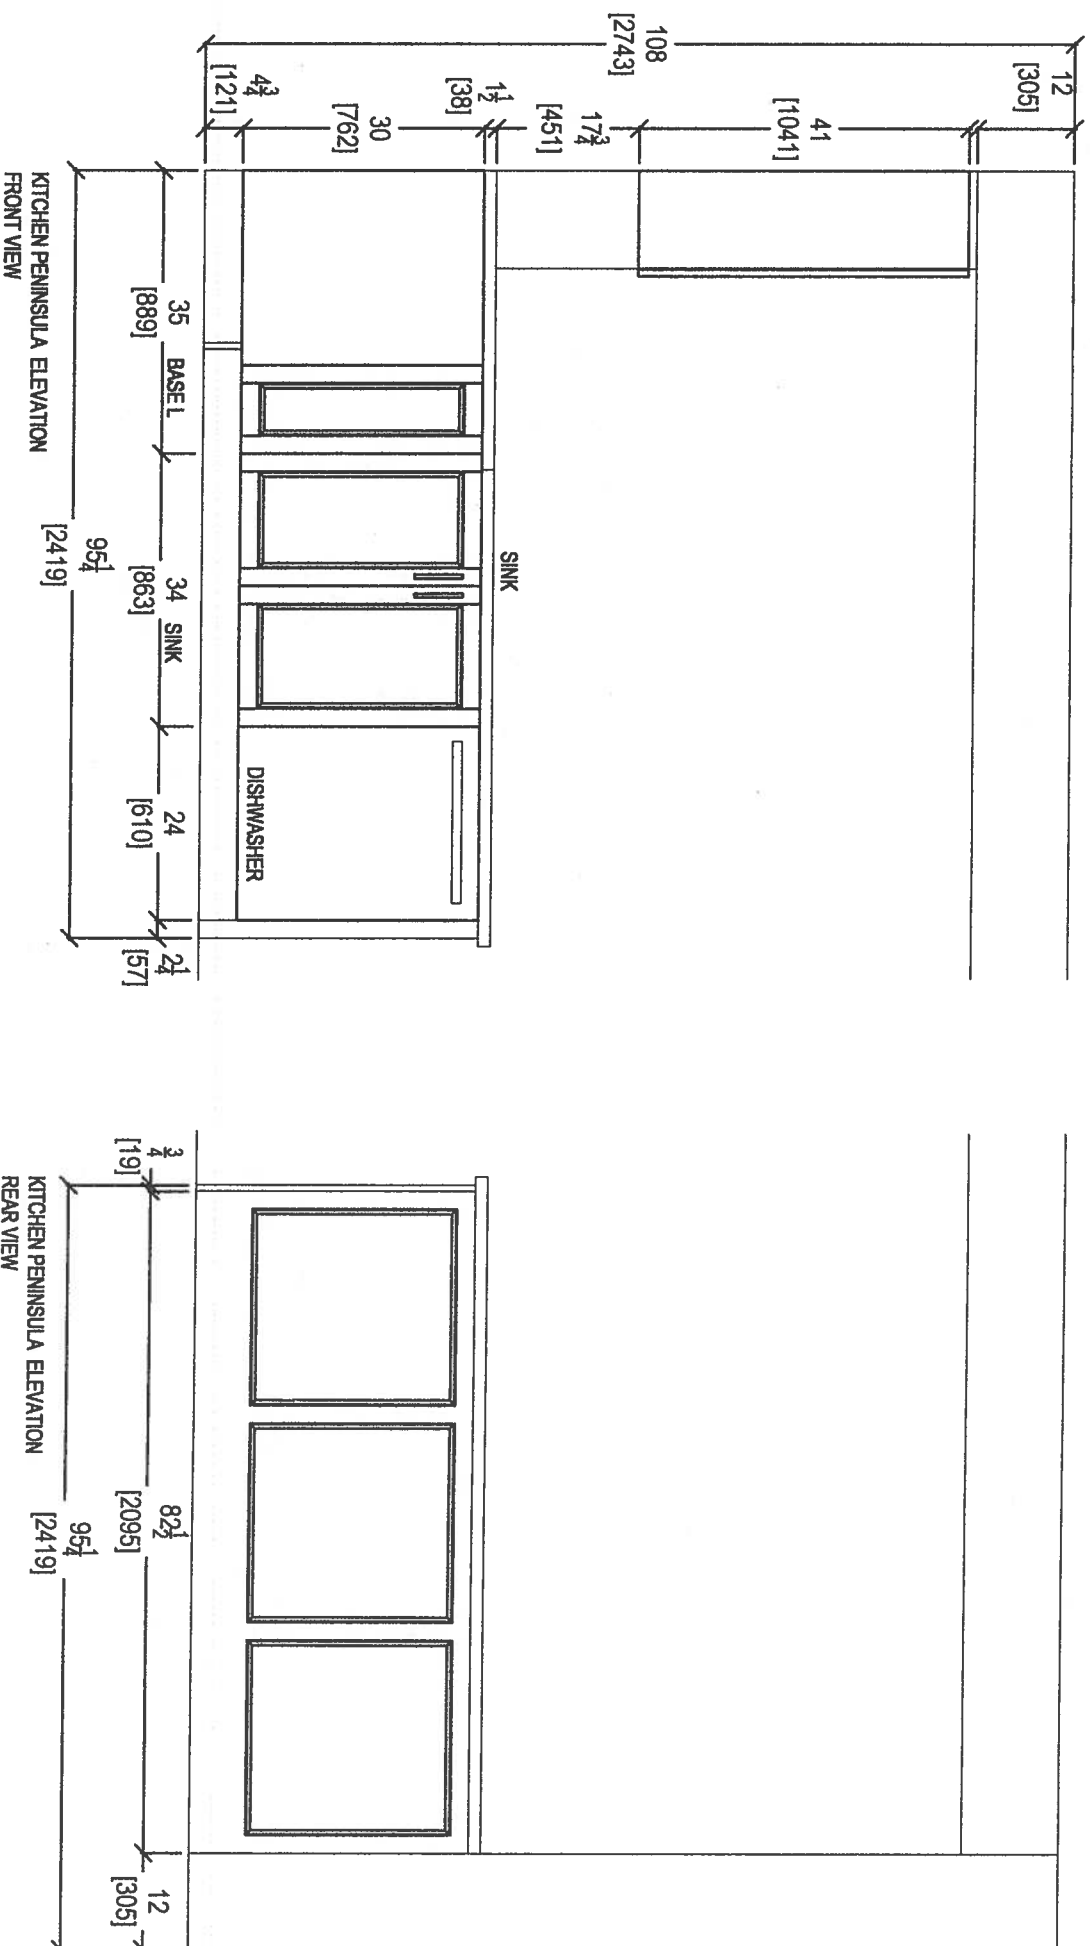


80 SANTE DRIVE, VAUGHAN, ON L4K 3C4,
T: 416.746.1811 F: 905.761.5601

CLIENT: ROYAL PINE HOMES	JOB NAME: 610 HMP	ROOM: KITCHEN	DRAWN BY: SK	COMMENTS:
SITE: HAMPTON PLACE	DOOR STYLE: —	DOOR HANDLE: —	SCALE: 1/2" = 1' - 0"	
PHONE: —	FINISH: —	DRW HANDLE: —	DATE: MAY 1 2018	
EMAIL: —	SPECIES: —	TOP: —	PAGE:	



61

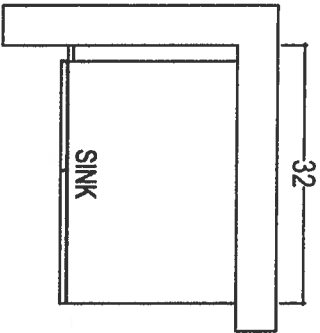

POWDER ROOM

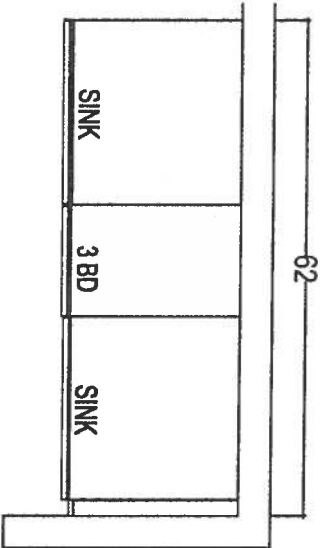

MASTER ENSUITE

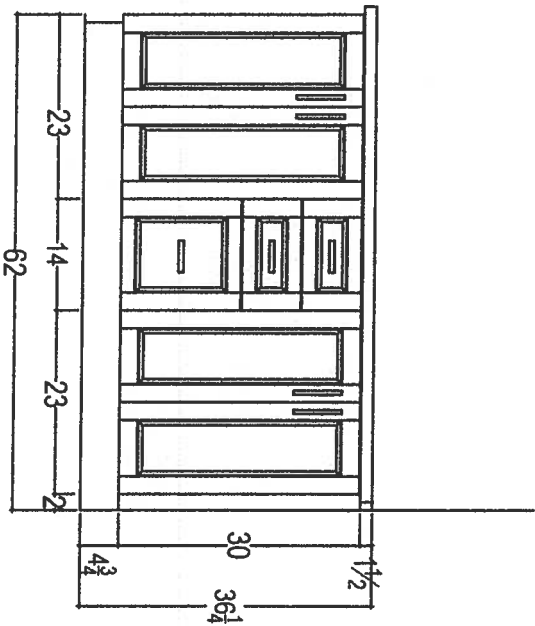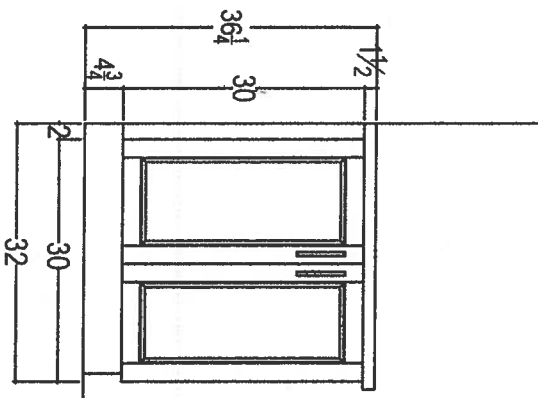

 your kitchen, your taste 80 SANTE DRIVE, VAUGHAN, ON L4K 3C4, T: 416.746.1811 F: 905.761.5801		CLIENT: ROYAL PINE HOMES		JOB NAME: 610 HMP		ROOM: VANITIES		DRAWN BY: SK		COMMENTS: PLEASE NOTE ALL DIMENSIONS ARE NOT FINAL AND ARE SUBJECT TO CHANGE UPON FINAL SITE MEASURE	
SITE: HAMPTON PLACE		DOOR STYLE: —		DOOR HANDLE: —		SCALE: 1/2" = 1'-0"					
PHONE: —		FINISH: —		DRW HANDLE: —		DATE: MAY 1, 2018					
EMAIL: —		SPECIES: —		TOP: —		PAGE:					

61