
SITE INSTRUCTION # 10**Project Name: Hampton Manor (25 Baker Hill Boulevard) - Stouffville****Project Number: 20140490****Vince Staffieri****May 11, 2018****Royal Pine Homes****3550 Langstaff Road, Suite 200****Woodbridge, Ontario L4L 9G3****via email: vince@royalpinehomes.com**

Distribution: Owner []; Contractor []; Consultant A []; M []; E []; L []; Other

-
1. Site instructions are issued only for the purpose of recording any clarification or interpretation of the contract documents or giving direction on problems resulting from field conditions.
 2. These instructions are subject to the provisions of the contract documents and unless stated herein and specifically co-authorized by the Client, will not affect the contract.
 3. Should the Contractor require a change in the contract price or project schedule, he shall submit an itemized proposal to the Architect within 14 calendar days of the date hereof.
 4. If the proposal is accepted by the Client, this site instruction will be superseded by a Change Order.
-

A. REFERENCE:

- .1 Drawings S1-05 and S1-06.

B. INSTRUCTION:

- .1 Revise Studrail reinforcement for slabs at Levels 6 and 7, as indicated.

C. REASON:

- .1 To suit floor openings required for precast concrete cladding and M&E services.

Yours very truly,
STEPHENSON ENGINEERING LIMITED

per

Mauricio Nieto, MAsc., P.Eng.
Senior Engineer, Project Manager
mnieto@stephenson-eng.com

per


Saundra Cullen, P.Eng.
Principal
scullen@stephenson-eng.com

Distribution cc:

Jeffrey Ellis	jellis@dineen.com
Gino Colangelo	gcolangelo@gc-architects.com
Shari Grant	SGrant@gc-architects.com
Colin Hutson	chutson@stephenson-eng.com

THE CONTRACTOR SHALL CHECK ALL DIMENSIONS WITH THE LATEST ISSUE OF ARCHITECTURAL, MECHANICAL AND ELECTRICAL DRAWINGS. REPORT ANY DISCREPANCIES TO THE ARCHITECT BEFORE PROCEEDING WITH WORK.

1	MAR 18 2016	ISSUED FOR TENDER
2	DEC 28 2016	ISSUED FOR BUILDING PERMIT
3	MAY 09 2017	ISSUED FOR FOUNDATION PERMIT
10	JUL 19 2017	IPC - ABOVE GRADE LEVELS
18	MAY 11 2018	ISSUED FOR SITE INSTRUCTION #10

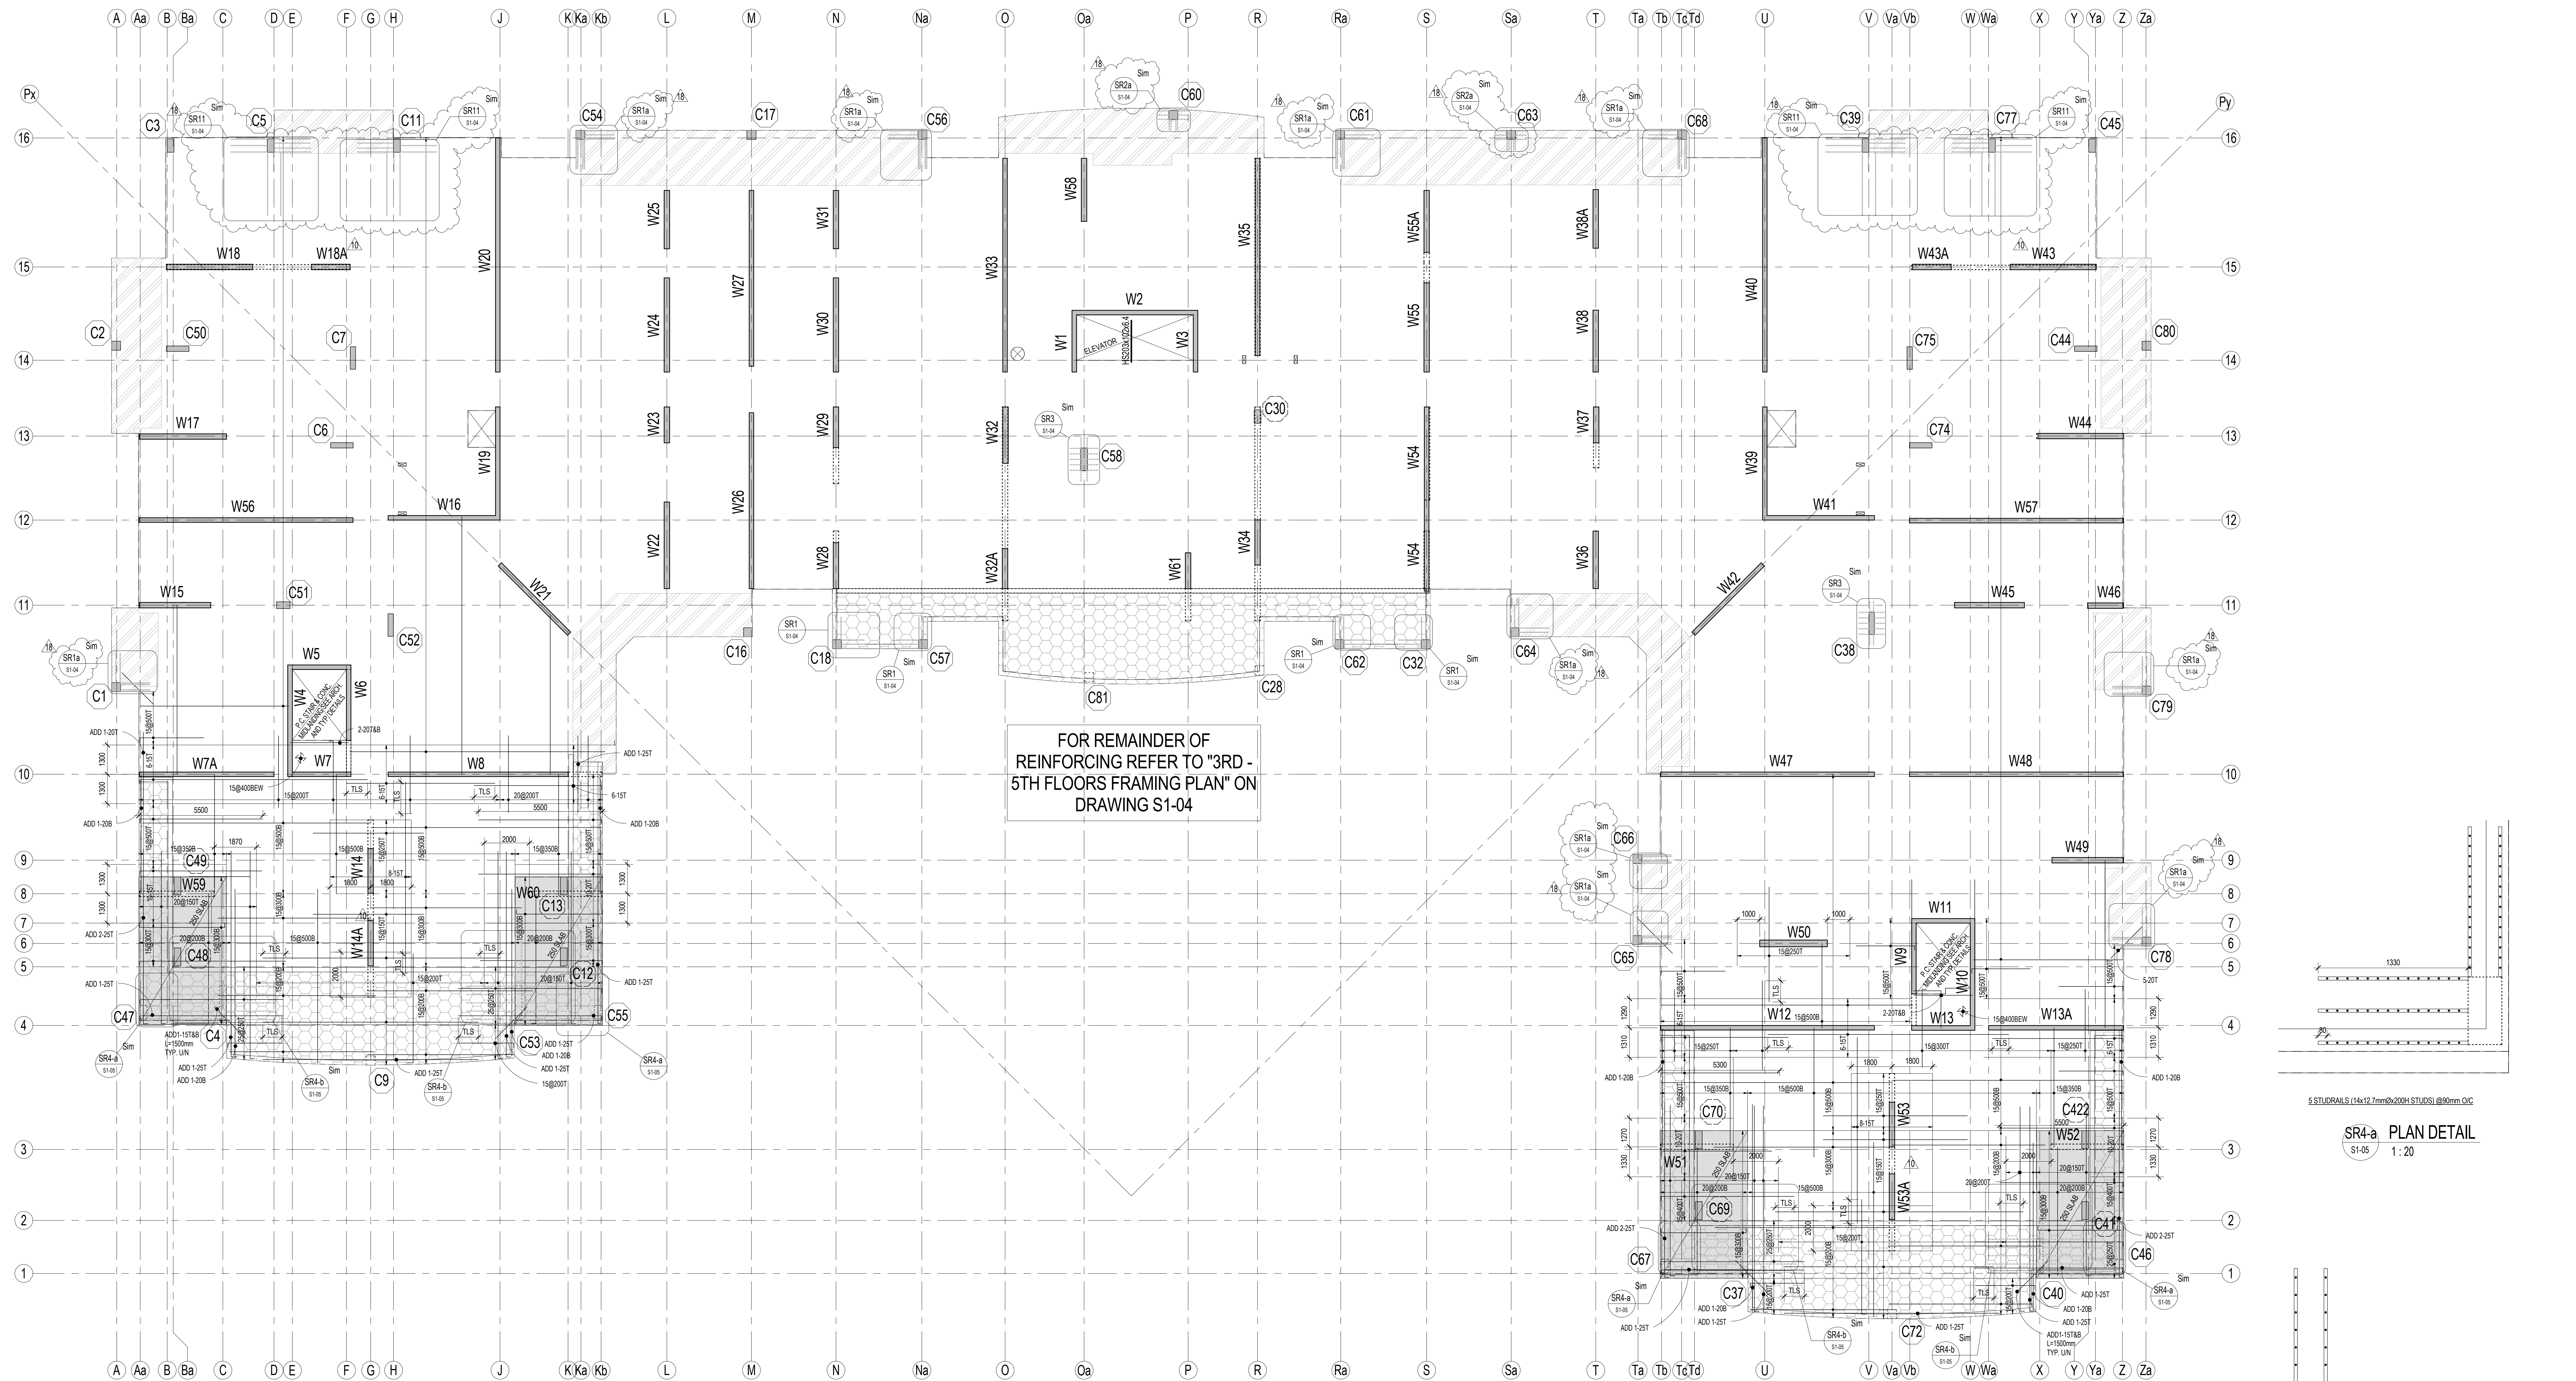


6TH FLOOR FRAMING PLAN
1:100

- TOP OF STRUCTURAL SLAB TO BE 0.0 mm BELOW FINISHED FLOOR DATUM ELEVATION EXCEPT AS CROSSED AND NOTED. SEE ARCHITECTURAL DRAWINGS FOR DATUM ELEVATION.
- THE STRUCTURAL SLAB HAS BEEN DESIGNED FOR THE FOLLOWING LIVE LOADS (LL) AND SUPERIMPOSED DEAD LOADS (SDL) IN ADDITION TO THE SELF WEIGHT.


	LL	SDL	S
FLAT	1.8 kPa	1.0 kPa	-
TERRACE	4.8 kPa	1.0 kPa	2.0 kPa **
STAIRS	4.8 kPa	0.5 kPa	-
BALCONIES	4.8 kPa	1.5 kPa	2.0 kPa **
LODGERS	4.8 kPa	1.5 kPa	-

* INCLUDES ALLOWANCE FOR SLOPES AND ROOF MATERIALS.
** AN ALLOWANCE FOR ACCUMULATED SNOW LOAD HAS BEEN CALCULATED IN ACCORDANCE WITH THE O.B.C. IS IN ADDITION TO THIS LOAD AND IS NOTED ON PLAN.

- CONCRETE COVER FOR TOP AND BOTTOM BARS IN SLABS TO BE 25 mm.
- APPROVAL MUST BE OBTAINED FROM ENGINEER FOR ALL OPENINGS OTHER THAN THOSE SHOWN ON PLAN.
- THE PROJECT SUPERINTENDENT MUST CONTACT THIS OFFICE 24 HOURS PRIOR TO PLACING STRUCTURAL CONCRETE FOR A REVIEW OF PREPARATIONS.
- SEE TYPICAL DETAIL DRAWING FOR DETAILS IN NON-LOAD BEARING BLOCK WALLS.
- SEE ALSO TYPICAL NOTES AND DETAILS.
- REFER TO BEAM COLUMN SCHEDULES AND WALL ELEVATIONS.
- AREAS NOTED THUS ON PLAN, DENOTE BALCONY LOADING. SEE LOADING TABLE.
- AREAS NOTED THUS ON PLAN, DENOTE TERRACE LOADING. SEE LOADING TABLE.

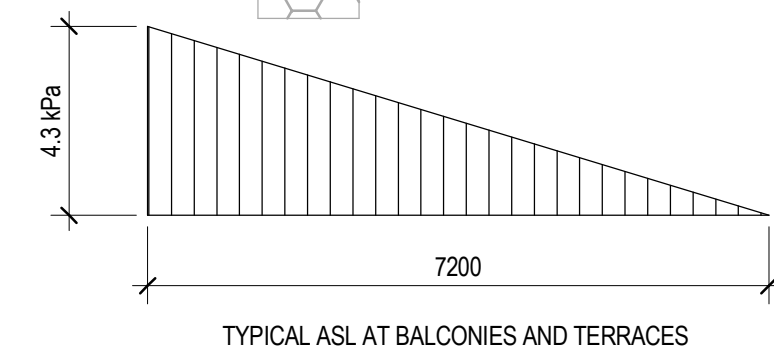

SR4-a PLAN DETAIL
S1-05 1:20

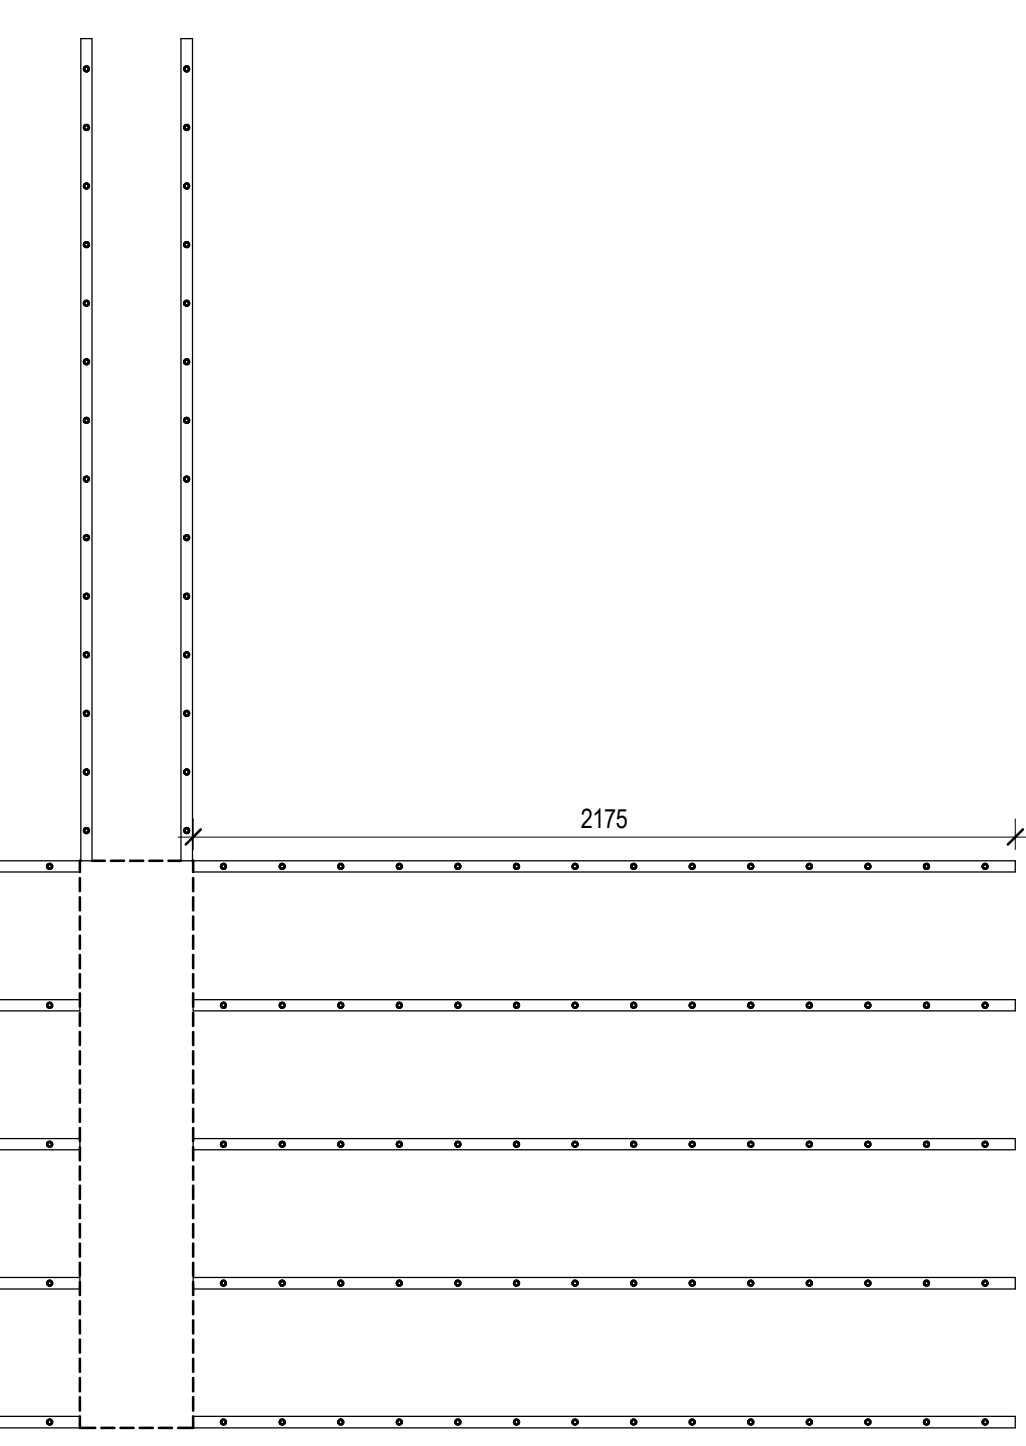

SR4-b PLAN DETAIL
S1-05 1:20



stephenson
ENGINEERING

2550 Victoria Park Ave., Suite 402
Toronto, ON M2J 6A7 Tel: 416 415 9799
www.stephenson-eng.com | info@stephenson-eng.com



PROPOSED RESIDENTIAL DEVELOPMENT
25 BAKER HILL BLVD.
ROYAL PINES HOMES
STOUFFVILLE ONTARIO

Drawn By: RS
Checked By: NH/PZ/AS
Plot Date: DECEMBER 2016
Job #: 20140490


6TH FLOOR FRAMING PLAN
As indicated
S1-05

THE CONTRACTOR SHALL CHECK ALL DIMENSIONS WITH THE LATEST ISSUE OF ARCHITECTURAL, MECHANICAL AND ELECTRICAL DRAWINGS. REPORT ANY DISCREPANCIES TO THE ARCHITECT BEFORE PROCEEDING WITH WORK.


1	MAR 18/2016	ISSUED FOR TENDER
2	DEC 28/2016	ISSUED FOR BUILDING PERMIT
3	MAY 09/2017	ISSUED FOR FOUNDATION PERMIT
10	JUL 19/2017	IPC - ABOVE GRADE LEVELS
11	JUL 24/2017	ISSUED FOR SITE INSTRUCTION #2
13	SEP 12/2017	ISSUED FOR SITE INSTRUCTION #5
18	MAY 11/2018	ISSUED FOR SITE INSTRUCTION #10

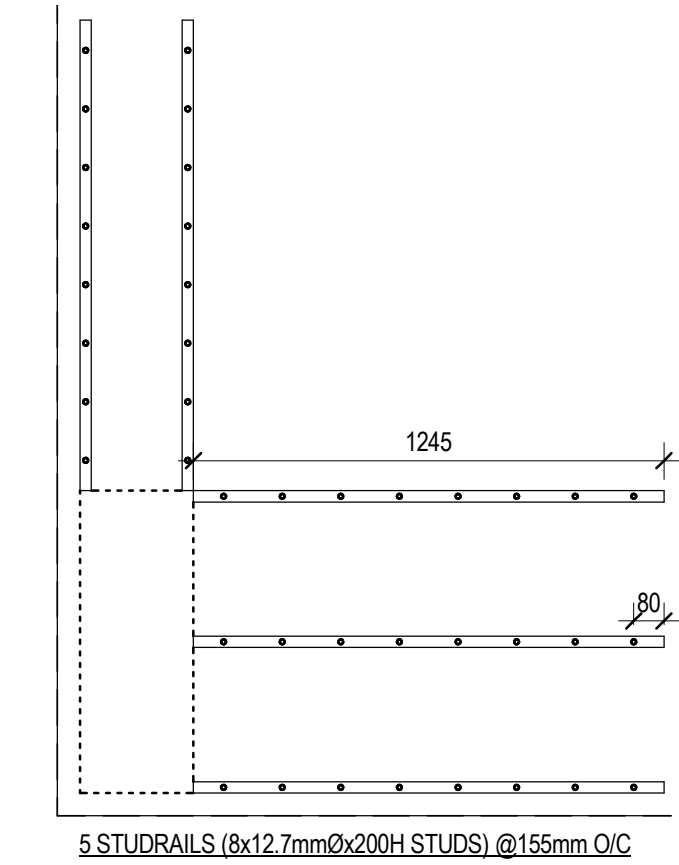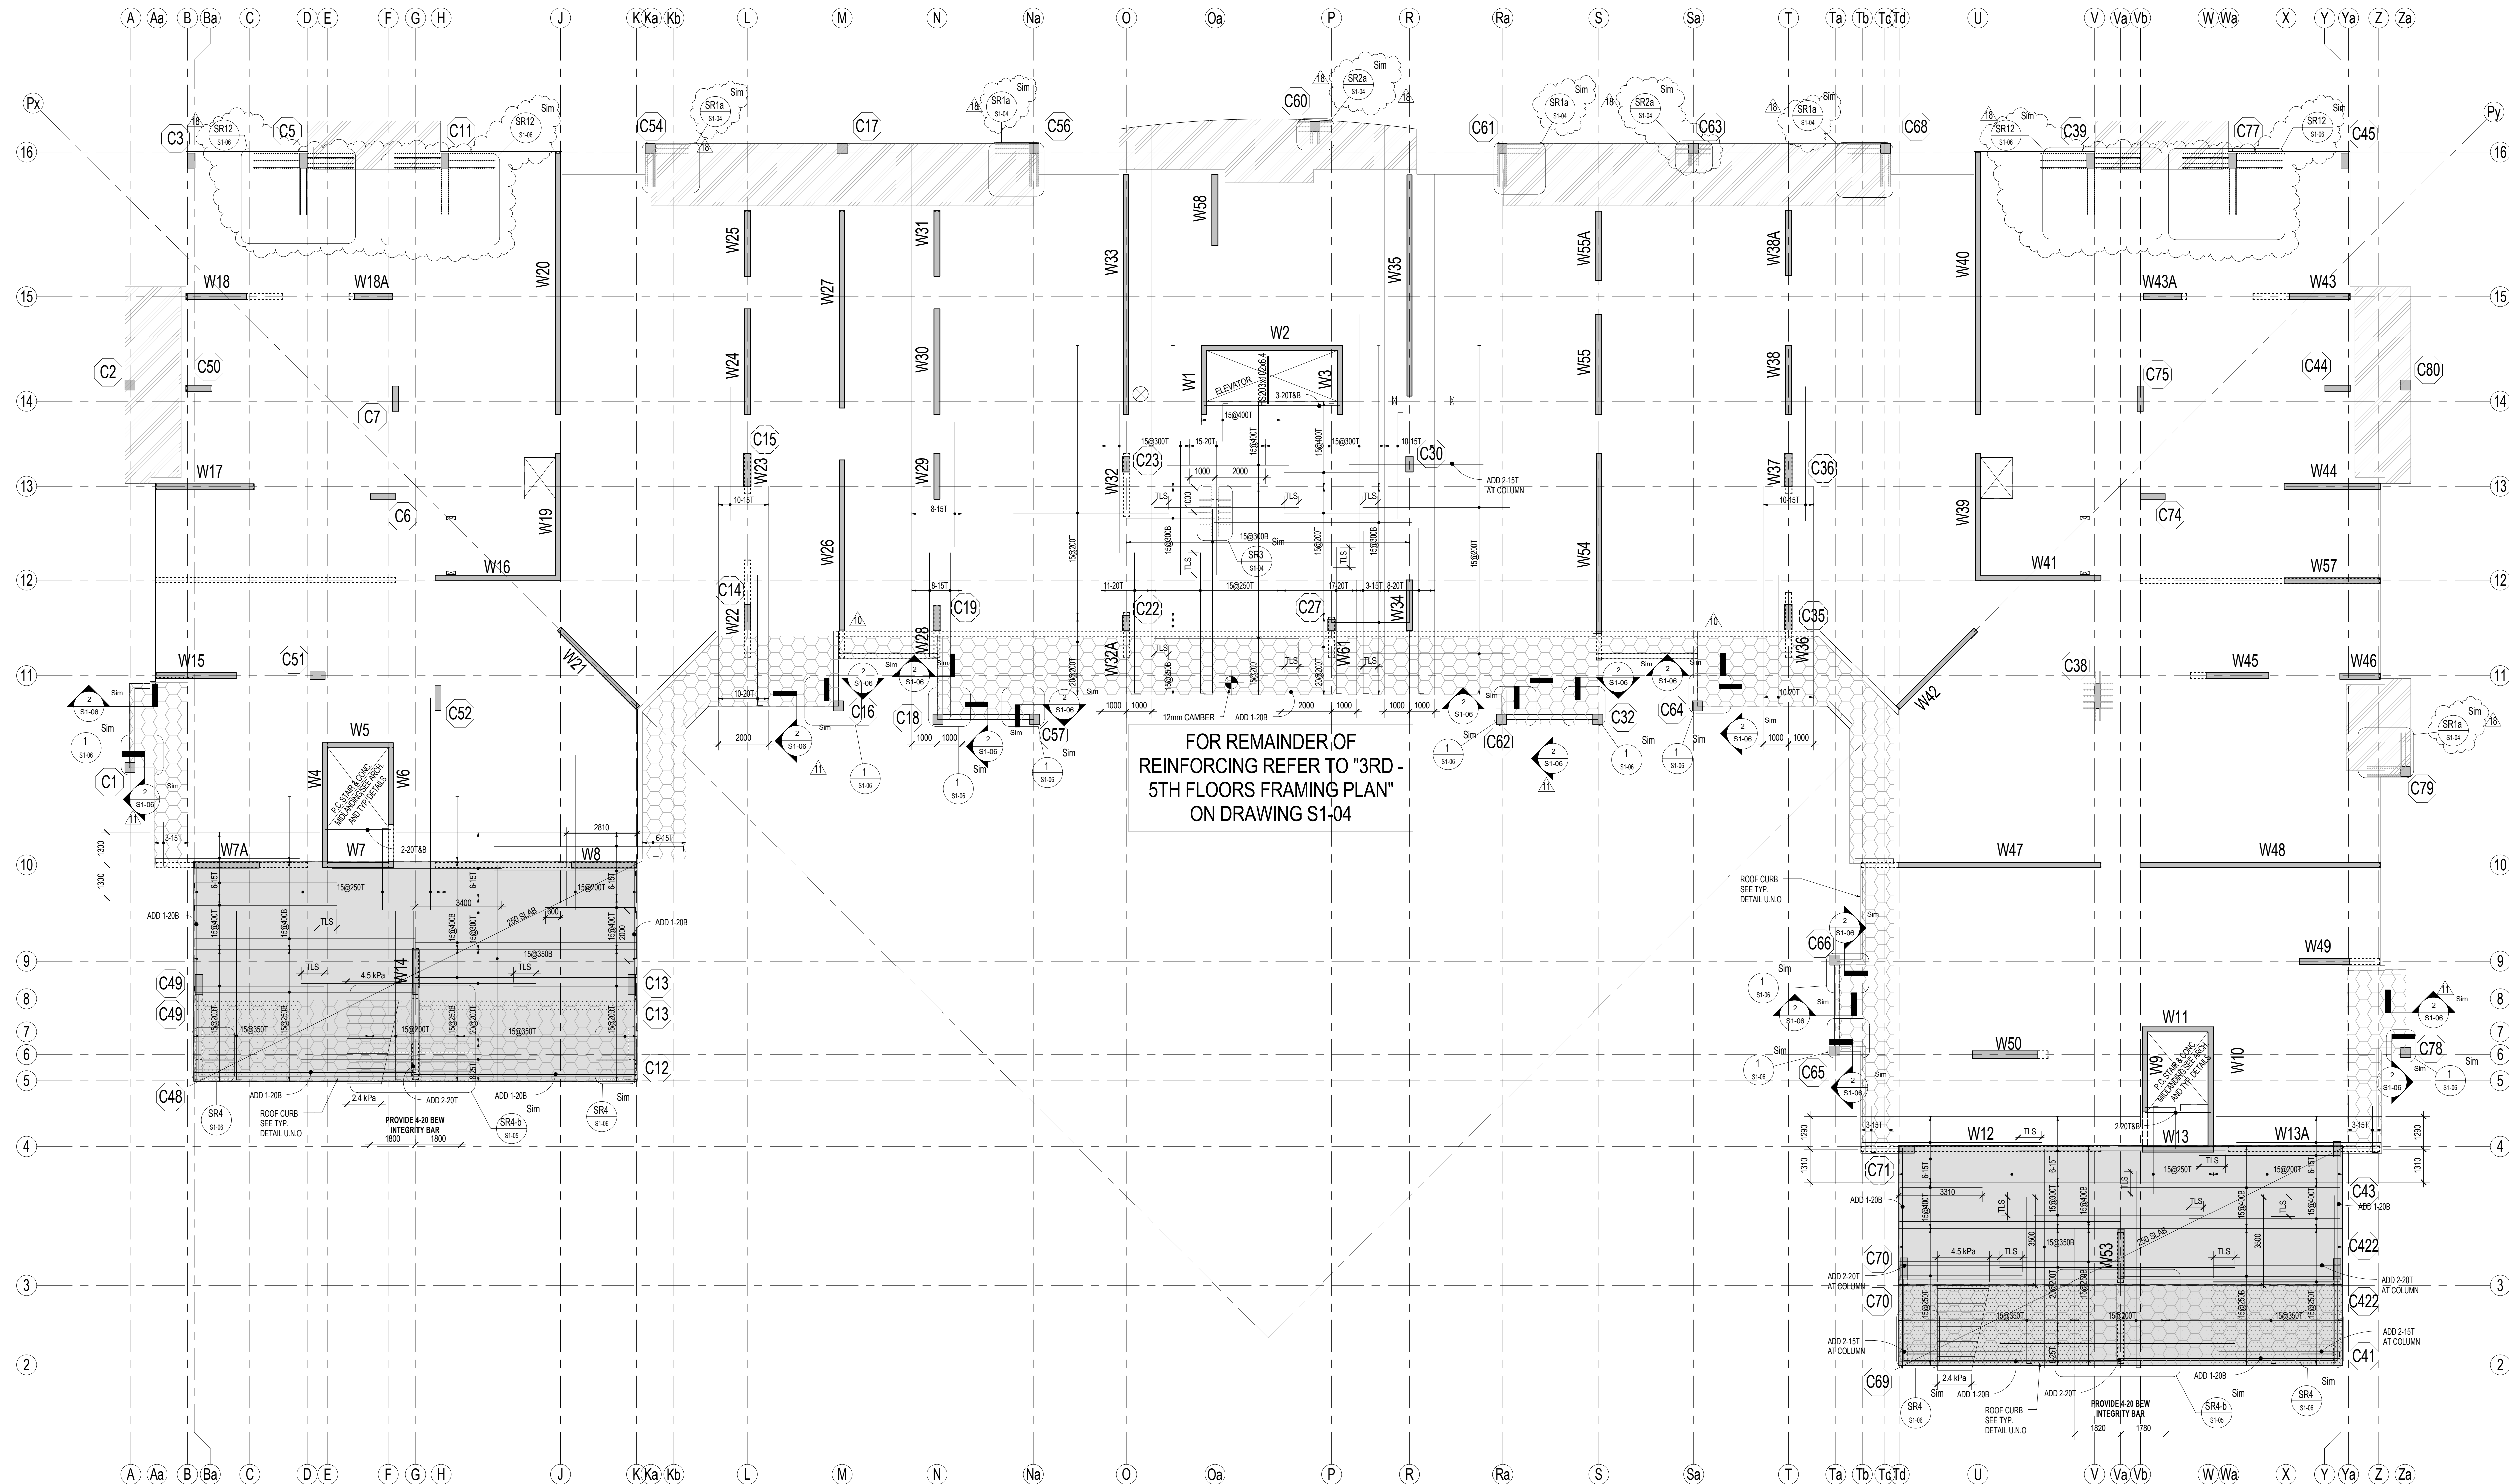

SR4 PLAN DETAIL
1:20

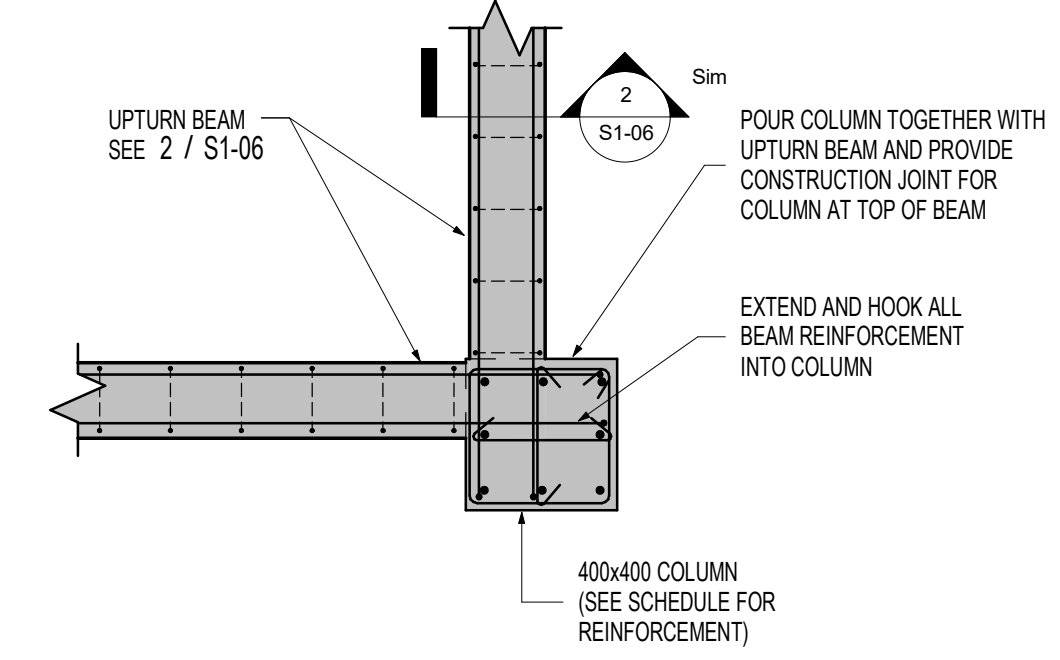

1 PLAN DETAIL
1:20

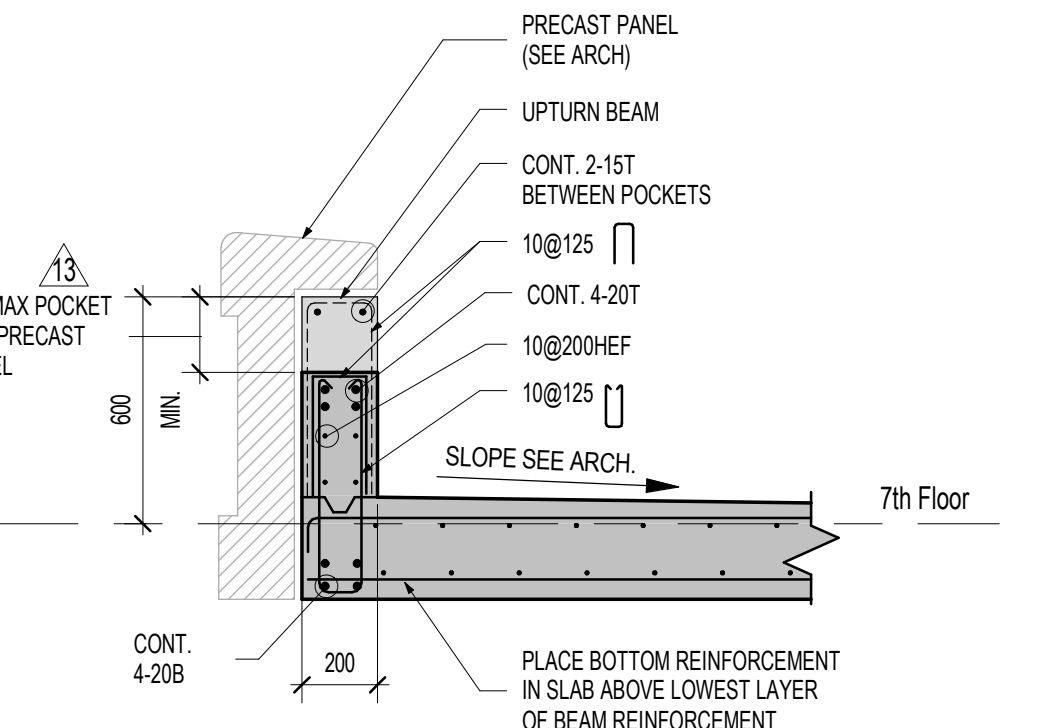

2 SECTION
1:20

NOTE: COORDINATE LOCATION OF PRECAST POCKETS WITH PRECAST SUPPLIER



7TH FLOOR FRAMING PLAN
1:100

TLL = TOP UPPER LAYER	
TLL = TOP LOWER LAYER	
BL = BOTTOM UPPER LAYER	
BL = BOTTOM LOWER LAYER	


REINFORCEMENT PLACEMENT DIAGRAM	
SLAB:	200 MIN. LIN
INTERFERENCE BARS:	3.000W
CONCRETE STRENGTH:	30 MPa
TEMP. STEEL:	150/200
SLAB:	250 MIN. LIN
INTERFERENCE BARS:	3.000W
CONCRETE STRENGTH:	30 MPa
TEMP. STEEL:	150/200

- TOP OF STRUCTURAL SLAB TO BE 0.0 mm BELOW FINISHED FLOOR DATUM ELEVATION EXCEPT AS CROSSED AND NOTED. SEE ARCHITECTURAL DRAWINGS FOR DATUM ELEVATION.
- THE STRUCTURAL SLAB HAS BEEN DESIGNED FOR THE FOLLOWING LIVE LOADS (LL) AND SUPERIMPOSED DEAD LOADS (SDL) IN ADDITION TO THE SELF WEIGHT.

	LL	SDL	S
SUITES	1.9 kPa	1.0 kPa	
TERRACE	4.8 kPa	3.6 kPa**	2.0 kPa**
STAIRS	4.8 kPa	0.5 kPa	
BALCONIES	4.8 kPa	0.5 kPa	2.0 kPa**
LOBBIES	4.8 kPa	1.5 kPa	

* INCLUDES ALLOWANCE FOR SLOPES AND ROOFING MATERIALS
** AN ALLOWANCE FOR ACCUMULATED SNOW LOAD (ASL) CALCULATED IN ACCORDANCE WITH THE C.B.C. IS IN ADDITION TO THIS LOAD AND IS NOTED ON PLAN

- CONCRETE COVER FOR TOP AND BOTTOM BARS IN SLABS TO BE 25 mm.
- APPROVAL MUST BE OBTAINED FROM ENGINEER FOR ALL OPENINGS OTHER THAN THOSE SHOWN ON PLAN. THE PROJECT SUPERINTENDENT MUST CONTACT THIS OFFICE 24 HOURS PRIOR TO PLACING STRUCTURAL CONCRETE FOR A REVIEW OF PREPARATIONS.
- SEE TYPICAL DETAIL DRAWING FOR LINTELS IN NON-LOAD BEARING BLOCK WALLS.
- SEE ALSO TYPICAL NOTES AND DETAILS.
- REFER TO BEAM, COLUMN SCHEDULES, AND WALL ELEVATIONS.
- AREAS NOTED THUS ON PLAN, DENOTE TERRACE LOADING. SEE LOADING TABLE.
- AREAS NOTED THUS ON PLAN, DENOTE TERRACE LOADING. SEE LOADING TABLE.

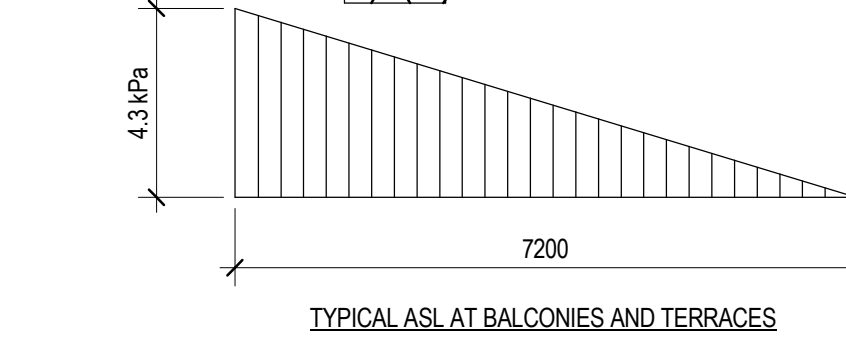

SR12 PLAN DETAIL
1:20