





South Fork

Suite 705

ORIGINAL

Suite Layout

1,518 SQ FT plus 81 sq. ft. of balcony area

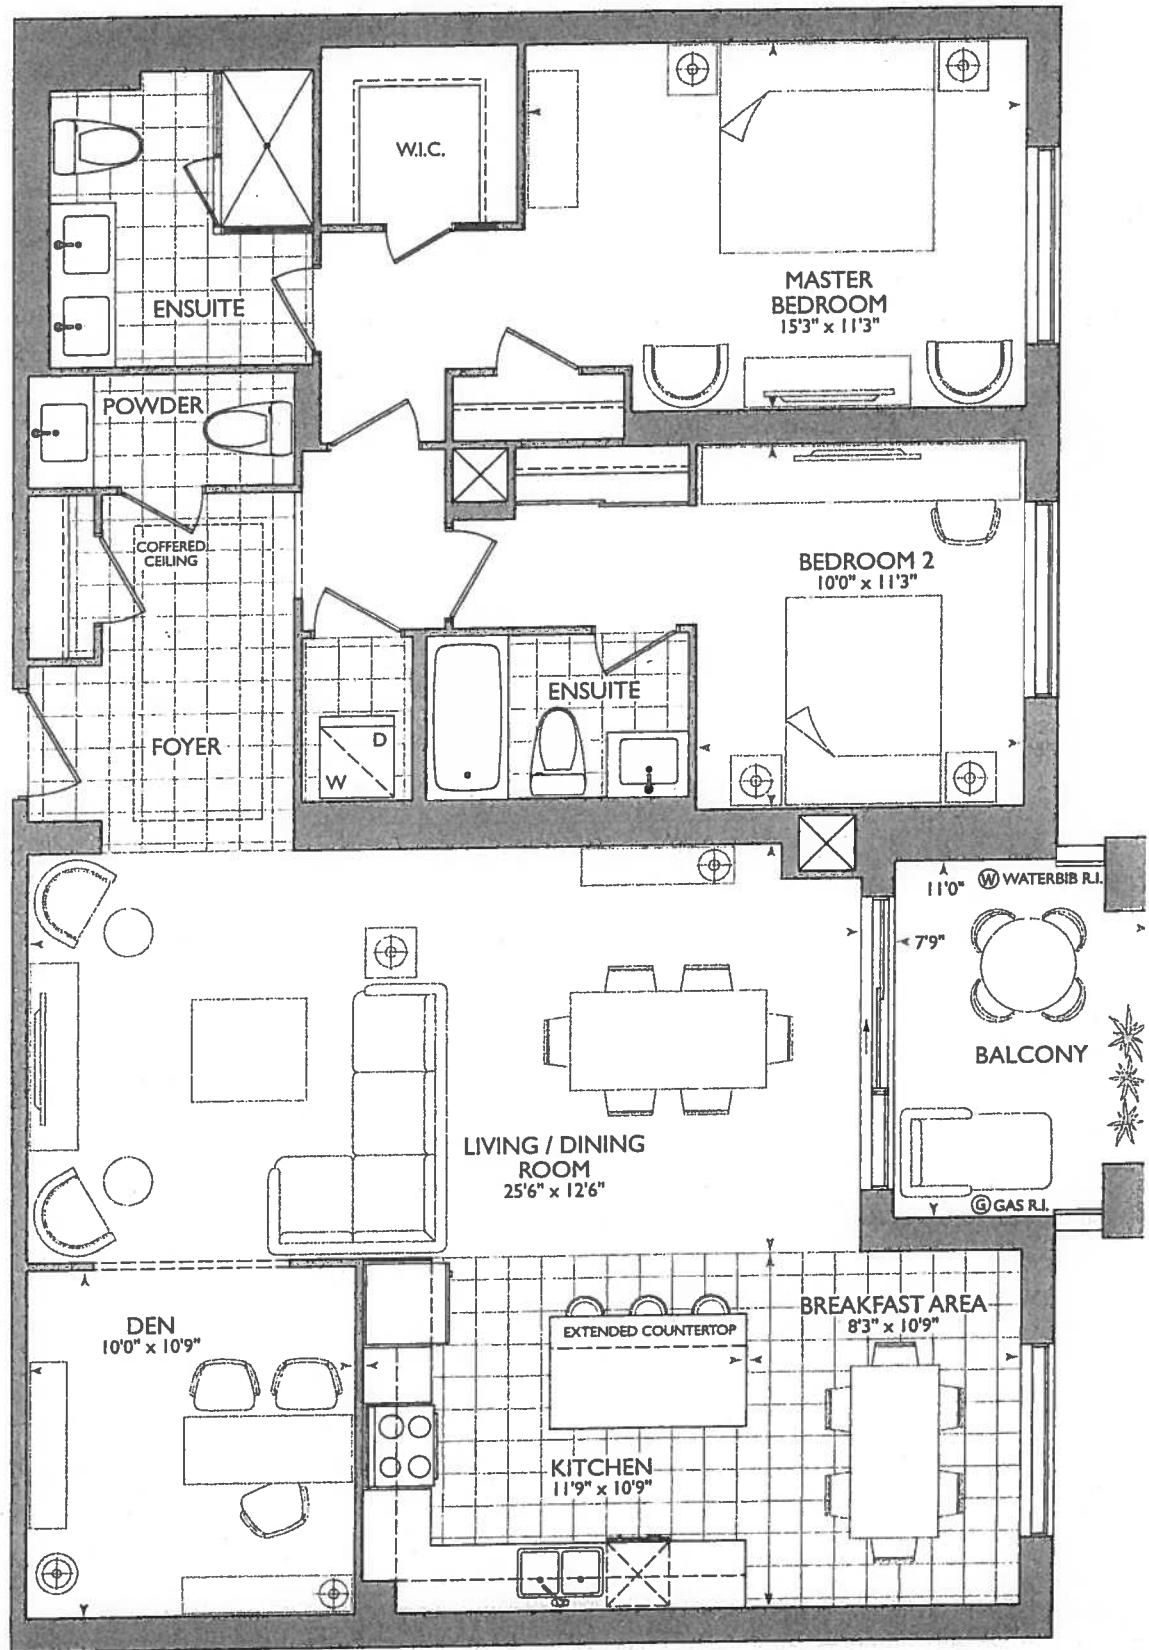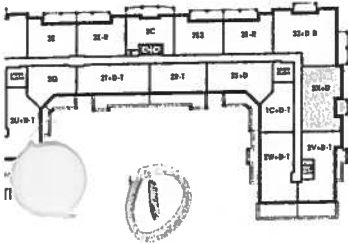


7.7

- UPG KITCHEN SEE OTC
- UPG 2 = APPLIANCE PKG.
- DELETE BACKSPLASH
- (x6) = PUCK LIGHTS
- (x2) = PLUGS ISLAND
- (x8) = POT LIGHTS (SEE OTC)
- (x2) = CAPPED CEILING LIGHTS
OVER ISLAND.
- 52" STOVE PIPE CENTER
- 77 1/2" SINK PIPE CENTER.
- RAISED VANITIES 36 1/4" + 3" SPLASH

SUITE 705 - SOUTH FORK

■ HAMPTON PLACE ■ 25 Baker Hill Blvd -- Stouffville, ON ■ Jan 31, 2018

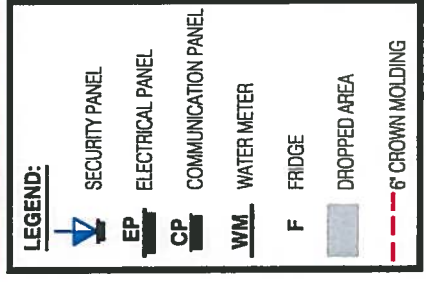



1500K
SITE COPY

CONSTRUCTION SUMMARY

Hampton Place

PURCHASERS: DEBORAH L. FLUTE and JOHN H. FLUTE

TEL: RES.: 905-471-1989 BUS.: 416-805-7452

LOT NUMBER	PHASE	HOUSE TYPE	CLOSING DATE
705	1	SOUTH FORK	14-Nov-18

Offer	VENDOR TO INSTALL TWO FRENCH DOORS ON DEN AS PER VENDORS STANDARD SAMPLES.
Workshee	Note: 30"

Offer	PURCHASER TO RECEIVE \$4,000.00(INCLUDES APPLICABLE TAXES) WORTH OF UPGRADES AT THE DECOR CENTER AT TIME OF COLOUR CHART.
Workshee	Note:

Offer	VENDOR AGREES TO SUPPLY AND INSTALL SMOOTH CEILINGS, AS PER PLAN, EXTENDED UPPER CABINETRY IN KITCHEN AS PER PLAN AND AS PER VENDORS SPECIFICATIONS, AND EXTENDED INTERIOR DOORS AS PER PLAN AND AS PER VENDORS SPECIFICATIONS.
Workshee	Note:

Offer	ADDITIONAL - LOCKER UNIT
Upgrade	Note:

Offer	DELETE STANDARD LIGHT FIXTURES IN THE KITCHEN AND INSTALL TWO (2) CAPPED CEILING LIGHTS OVER ISLAND ON SWITCH FROM ORIGINAL LIGHTING. SPLIT ISLAND IN 3 AND INSTALL FIRST CAPPED CEILING LIGHT 1/3 FROM END OF ISLAND AND SECOND CAPPED LIGHT 1/3 FROM OTHER END OF ISLAND
Upgrade	Note: AS PER ATTACHED SKETCH .

Offer	INSTALL 8 POTLIGHTS ON TWO SEPARATE SWITCHES AS PER ATTACHED SKETCH. INSTALL 4 POTLIGHTS IN WALKING AREA OF KITCHEN EQUALLY SPACED BETWEEN BULKHEADS AND ISLAND ON ONE SWITCH. INSTALL 4 POTLIGHTS IN BREAKFAST AREA EQUALLY SPACED BETWEEN BLUKHEADS AND ISLAND.
Upgrade	Note: (STANDARD SWITCH FOR BREAKFAST AREA TO BE USED FOR POTLIGHTS IN BREAKFAST AREA) SEE ATTACHED SKETCH

Offer	DELETE STANDARD CEILING LIGHT IN MASTER ENSUITE AND INSTALL 3 POTLIGHTS ONE IN FRONT OF EACH SINK AND ONE IN FRONT OF TOILET IN ONE LINE AS PER ATTACHED SKETCH EQUALLY SPACED BETWEEN CABINETRY AND SHOWER (IF POSSIBLE) ON ORIGINAL LIGHTING SWITCH.
Upgrade	Note:

Offer	INSTALL CONDUIT AND BLOCKING FOR WALL MOUNTED TV (60 INCHES ABOVE FF) IN LIVING ROOM.
Upgrade	Note:



SITE COPY

CONSTRUCTION SUMMARY

Hampton Place

PURCHASERS: DEBORAH L. FLUTE and JOHN H. FLUTE

TEL: RES.: 905-471-1989 BUS.: 416-805-7452

LOT NUMBER	PHASE	HOUSE TYPE	CLOSING DATE	
705	1	SOUTH FORK	14-Nov-18	

Date Added: 12-Apr-18

Invoice Number: 7124

1 - CLARIFICATION; REFER TO APAS; BEDROOM - Standard electrical outlet to be installed at standard height beside conduit pipe Additional electrical outlet to be installed beside conduit pipe & standard cable rough-in Approx. 60" AFF (See Attached Sketch) Note: As per Vince at Head-Office
1 - CLARIFICATION - REFER TO APAS; DEN - Install Double French Doors - Extended Height Clear Bevelled Glass with Wood Mullions (See Sketch) Note:
1 - BEDROOM #2 - Install DOUBLE DOOR Closet in lieu of standard mirrored sliders at bedroom #2 closet (See Sketch) Note:
1 - LAUNDRY ROOM - 1ST UPGRADE - CERAMIC TILES - 13x13 RUSTIC GREY - To be installed throughout laundry room floor (See Sketch) Note:
65 - MASTER ENSUITE - 1ST UPGRADE - PORCELAIN TILES - 20x20 CALACATTA GRIS - To be installed throughout master ensuite floor (To be Installed Straight) (See Sketch) Note: Includes Larger Size
1 - FOYER & KITCHEN - Install Standard LAMINATE FLOORING in lieu of builder Standard Porcelain Tiles throughout Foyer and Kitchen, where applicable (See Sketch) Note:
KITCHEN & BATHROOMS - SEE QUALITY TOPS & KITCHENS FOR ALL KITCHEN & BATHROOMS UPGRADES/LAYOUT. (See Attached QTK Paperwork) Note:
2 - KITCHEN - Install TWO (2) ADDITIONAL PUCK LIGHTS (Same Switch as Standard Puck Lights) at kitchen. To be installed below kitchen cabinetry, where applicable. (See Attached QTK Layout for Locations) Note: Purchaser Paying Difference for Additional Puck Lights - Standard Kitchen to Receive Four (4) Puck Lights - Upgrade Kitchen Requires Six (6) Puck Lights
1 - KITCHEN - Install ADDITIONAL Standard Granite Countertop - BIANCO ANTICO - To be installed throughout kitchen, where applicable (does not include granite backsplash) (See Sketch) Note: To Accommodate Additional Cabinetry on Sink Wall Priced as per Orlando at Connolly
1 - KITCHEN - COUNTERTOP EDGING - Install UPGRADE " I " EDGING - To be installed throughout kitchen countertop, where applicable (See Sketch) Note: Priced as per Orlando at Connolly
1 - DISCLAIMER - GRANITE COUNTERTOP; KITCHEN - Due to the many variables that can affect the pattern, colour and/or design and "pitting" of natural products, granite installed will not be identical to the samples displayed. Note: Every effort is made to provide granite countertops as close as possible but the vendor is not responsible for results which differ from the sample displayed. All countertop surfaces may have seams, and product pattern and shade can change in areas containing seams.
1 - DISCLAIMER - STONE COUNTERTOP; DEN - Stone slabs vary in size & all seams are visible & the fabricator reserves the right to position the seams as necessary.
1 - KITCHEN - Kitchen Sink - Install Standard Undermount Sink - BLANCO Horizon Plus U2 Undermount Sink (8") - Model # 401234 Note:
1 - KITCHEN - Kitchen Faucet - Install Standard Faucet - DELTA Chrome Pull-Out Kitchen Faucet (Single Hole) - Model # 469LF - Chrome Note:
1 - KITCHEN - Kitchen Backsplash - DELETE - Do Not Install / Supply / Credit Purchaser for Builders Standard Kitchen Backsplash (See Sketch) Note:



SITE COPY

CONSTRUCTION SUMMARY

Hampton Place

PURCHASERS: DEBORAH L. FLUTE and JOHN H. FLUTE

TEL: RES.: 905-471-1989 BUS.: 416-805-7452

LOT NUMBER	PHASE	HOUSE TYPE	CLOSING DATE	
705	1	SOUTH FORK	14-Nov-18	

Date Added: 12-Apr-18

Invoice Number: 7124

1 - APPLIANCE PACKAGE - Install Upgrade Appliance Package - UPGRADE PACKAGE #2 - To be installed throughout suite, where applicable (See Sketch)

1 - KITCHEN - Install WATER LINE To FRIDGE at Kitchen (See Sketch)
Note:

1 - POWDER ROOM / MASTER ENSUITE / ENSUITE #2 - Install RAISED HEIGHT VANITY throughout all bathrooms, where applicable To Include; Powder Room, Master Ensuite and Ensuite #2 (See Attached QTK Paperwork)
Note:

1 - CLARIFICATION;
ALL BATHROOMS - Install Standard 3" Splash throughout all bathroom vanity countertops, where applicable. To Include; Powder Room, Master Ensuite and Ensuite #2 (See Sketch)
Note:

1 - DISCLAIMER - STONE COUNTERTOP;
ALL BATHROOMS - Stone slabs vary in size & all seams are visible & the fabricator reserves the right to position the seams as necessary.
Note:

1 - CLARIFICATION;
ALL BATHROOMS - DELETE Do Not Install / Supply / Credit Purchaser for builders standard ceramic bathroom accessories (toilet paper, towel bar & soap dish) throughout all bathrooms where applicable.
Note: To Include; Powder Room, Master Ensuite and Ensuite #2 (See Sketch)

1 - CLARIFICATION;
ALL BATHROOMS - DELETE Do Not Install / Supply / Credit Purchaser for builders' standard Bathroom Mirrors, throughout all bathrooms, where applicable. To Include; Powder Room, Master Ensuite and Ensuite #2. (See Sketch)
Note:

1 - CLARIFICATION;
MASTER ENSUITE - Purchaser accepts & acknowledges the standard frameless glass enclosure at master ensuite shower stall will NOT touch the ceiling and will receive a Standard Chrome Header. (See Sketch)
Note:

1 - CLARIFICATION;
ALL BATHROOMS - Install Standard Plumbing Fixtures throughout all bathrooms, where applicable. To Include; Powder Room, Master Ensuite and Ensuite #2 (See Sketch)
Note: **See Below Items for Upgrade Toilets at; Powder Room, Master Ensuite and Ensuite #2**

1 - POWDER ROOM - TOILET - Install Upgrade Toilet - CONTRAC CALI One Piece Elongated Toilet - Model # 4710-BOVU - White (See Sketch)
Note:

1 - MASTER ENSUITE - TOILET - Install Upgrade Toilet - CONTRAC CALI One Piece Elongated Toilet - Model # 4710-BOVU - White (See Sketch)
Note:

1 - ENSUITE #2 - TOILET - Install Upgrade Toilet - CONTRAC CALI One Piece Elongated Toilet - Model # 4710-BOVU - White (See Sketch)
Note:

1 - BONUS PACKAGE - PURCHASER HAS APPLIED \$4,000.00 (Includes Taxes) WORTH OF UPGRADE PROMOTIONAL PACKAGE TOWARDS THE PURCHASE OF UPGRADES COMPLETED AT THE DECOR CENTRE.
Note:

1 - PURCHASER HAS ATTENDED A COLOR APPOINTMENT AT THE DECOR CENTRE AND HAS DECLINED ANY ADDITIONAL UPGRADES. Purchaser accepts and acknowledges that there will be no further changes/additions/deletions to be made upon signing on April 12,2018
Note:



* INTERIOR COLOR SCHEME *

Purchasers		Decor Consultant	Model Type	Telephone Res. / Bus	Project	Closing Date	Unit
DEBORAH L. FLUTE & JOHN H. FLUTE		Melissa Di Marino	SOUTH FORK	(905) 471-1989 / (416) 805-7452	Hampton Place	14/11/2018	705

Page 2 of 3

CABINETS, VANITIES AND COUNTERTOPS

	Style	Countertop		Counter Edge		Handle / Knob	APPLIANCE PACKAGE
		Style	Material	Edge	Material		
Ensuite #2							
MASTER ENSUITE			CATEGORY 2 - MAPLE - SMOKEHOUSE QT 2503 (STD)	✓	ASPEN TERRA WHITE (STD)	B603-SC	Upgrade Package #2
POWDER ROOM			CATEGORY 2 - MAPLE - CHESTNUT QT 2503 (STD)	✓	ASPEN TERRA WHITE (STD)	16338-195	
KITCHEN / DINETTE			CATEGORY 2 - MAPLE - CHESTNUT QT 2503 (STD)	✓	ASPEN TERRA WHITE (STD)	B603-SC	
LAUNDRY ROOM			Category 1 Fiberglass White QT 1203 (STD) (See Notes)	✓	1" EDGE (UPG)	3487-123	
			N/A		N/A	N/A	Std 31in Opening

PLUMBING FIXTURES

KITCHEN	Sink Model	☒ STANDARD	Trim	Baseboard & Casing	☒ STANDARD	Levers	☒ STANDARD	
	Sink Faucet	☒ STANDARD		Interior Doors	☒ STANDARD - CARRARA SMOOTH		Door Height	☒ STANDARD
TOILETS	Master Ensuite	☒ UPGRADE - Contrac Cali #4710-BOVU	Cornice Moulding / Medallion	Foyer	☒ STANDARD - #CTR-611	Fireplace	N/A	
	Ensuite #2	☒ UPGRADE - Contrac Cali #4710-BOVU		Living Room	☒ STANDARD - #CTR-611		N/A	
	Powder Room	☒ UPGRADE - Contrac Cali #4710-BOVU		Dining Room	☒ STANDARD - #CTR-611		N/A	
VANITY FAUCETS	Master Ensuite	☒ STANDARD	Den	Den	NONE	Style	N/A	
	Ensuite #2	☒ STANDARD		Master Bedroom	NONE	Finish	N/A	
	Powder Room	☒ STANDARD		Bedroom 2	NONE	Marble	N/A	
VANITY SINKS	Master Ensuite	☒ STANDARD	Bedroom 3	Bedroom 3	N/A	Hearth	N/A	
	Ensuite #2	☒ STANDARD						
	Powder Room	☒ STANDARD						
SHOWER STALL / TUBS	Master Ensuite Shower Stall	☒ STANDARD	Paint Throughout	Walls	STANDARD - OYSTER WHITE	Trim	STANDARD - WHITE	
	Master Ensuite Tub	N/A						
	Ensuite #2 Tub	☒ STANDARD						

MISC. INSTALLATIONS		☐ Yes ☒ No
Ceramic Accessories (installed by Vendor)	Bathroom Mirrors (installed by Vendor)	☐ Yes ☒ No
Wire Shelving - Closet (installed by Vendor)		☒ Yes ☐ No

MISC. INSTALLATIONS	
Ceramic Accessories (installed by Vendor)	☐ Yes ☒ No
Bathroom Mirrors (installed by Vendor)	☐ Yes ☒ No
Wire Shelving - Closet (installed by Vendor)	☒ Yes ☐ No


Page 2 of 3

Master Enquire Tub	✓	STANDARD
Enquire #2 Tub	✓	

Decor Consultant: Melissa Di Marino
Purchaser: Deborah L. Flute
Purchaser: JOHN H. FLUTE
Vendor: Hampton Place


Lot: 705 Project: Hampton Place Model: SOUTH FORK

Printed Apr 11, 2018 2:55 pm

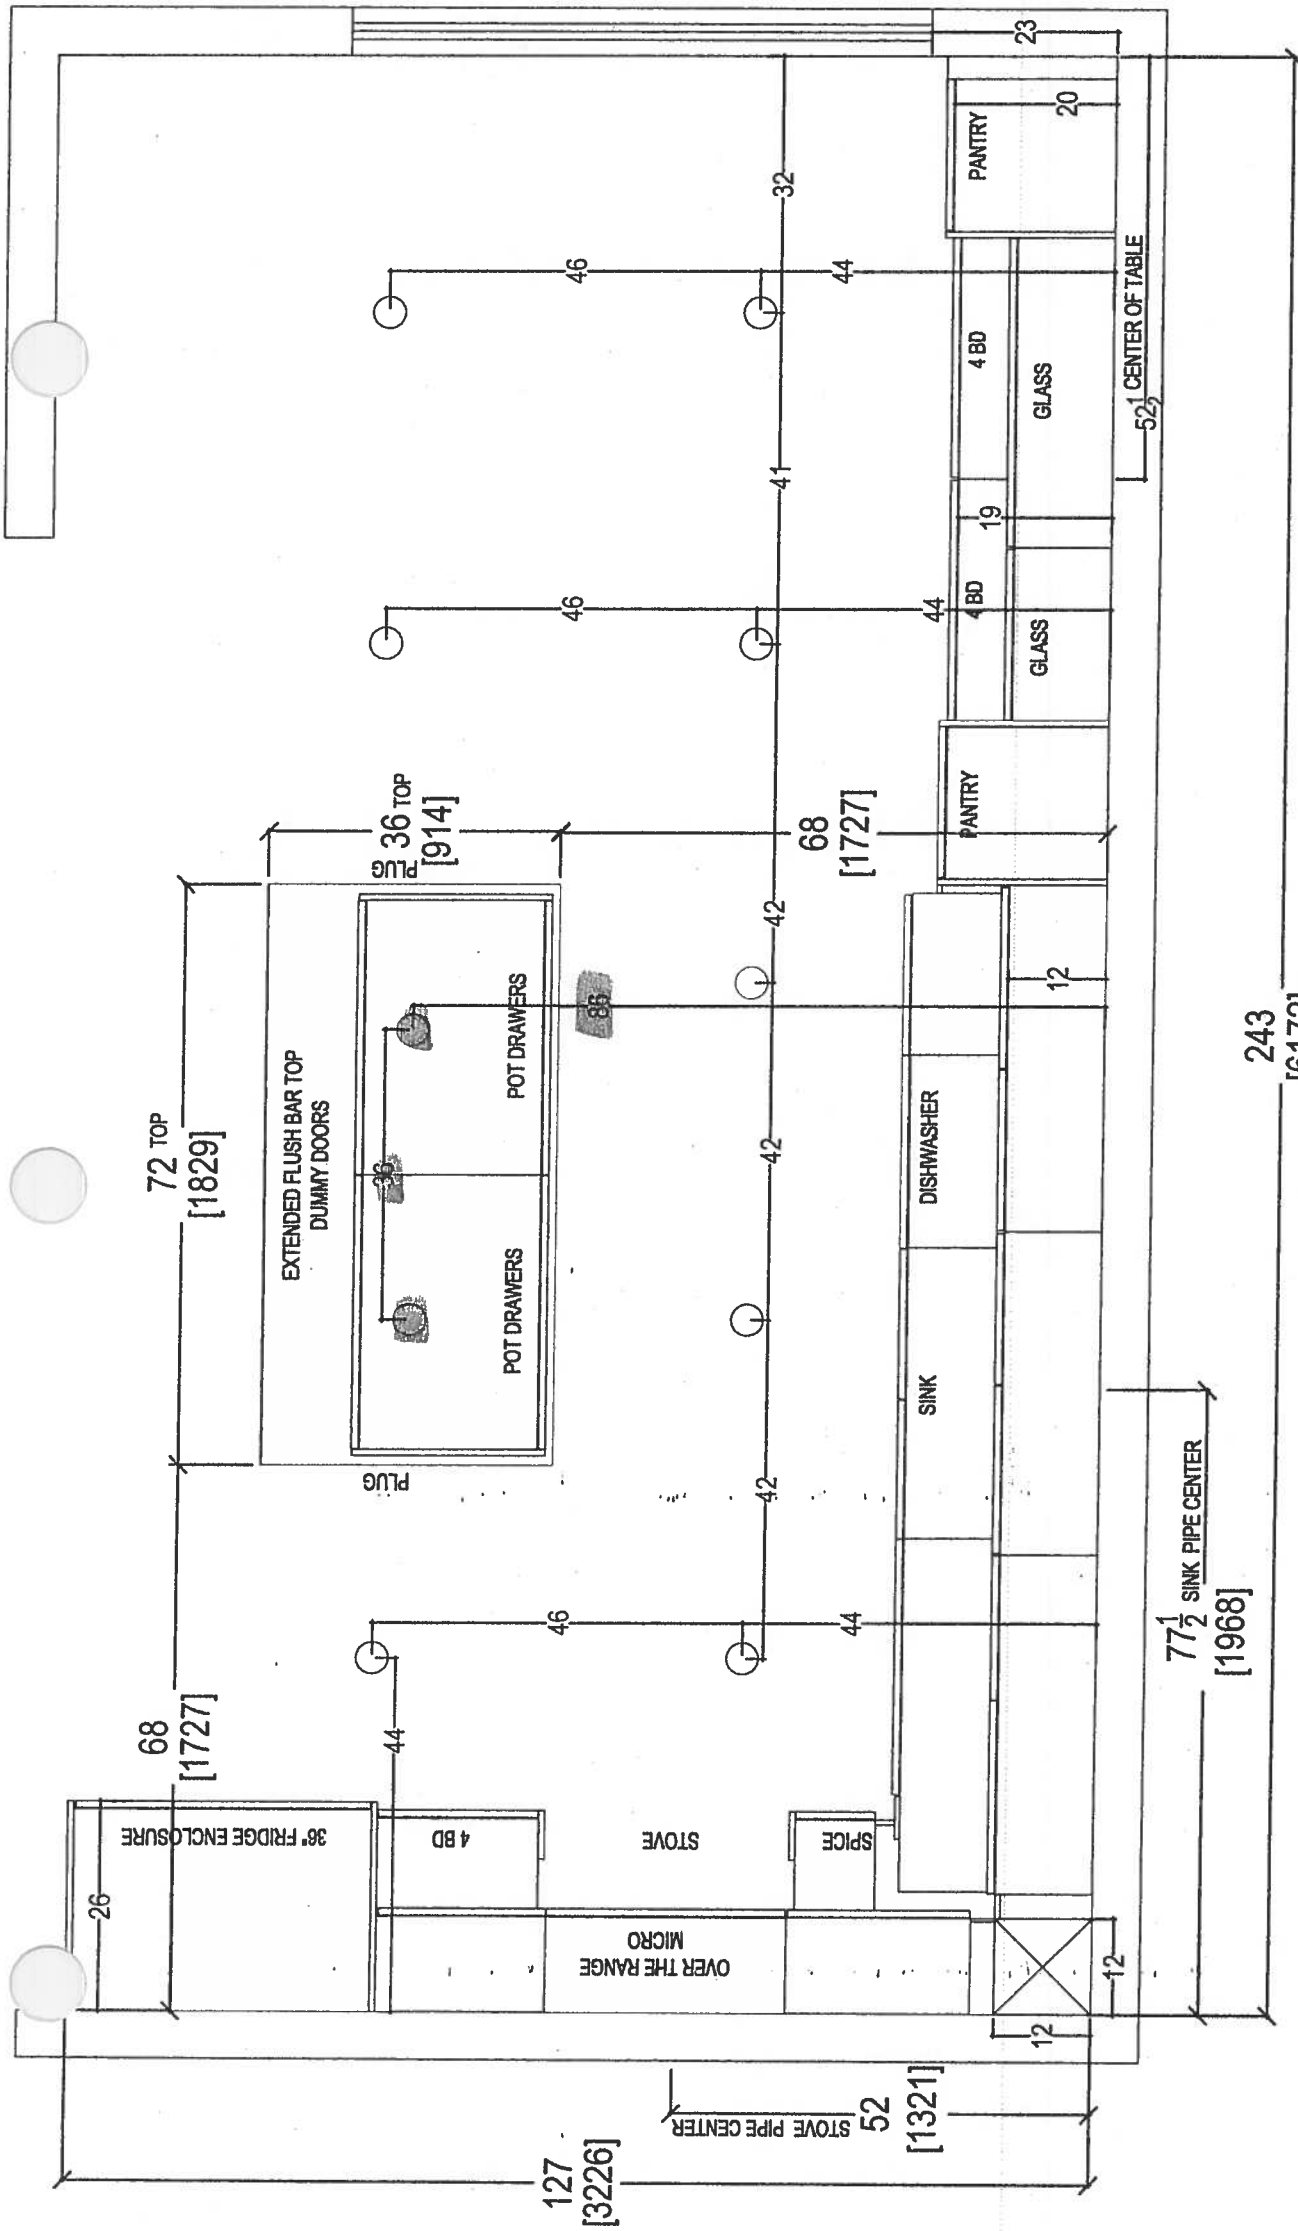


80 SANTE DRIVE, VAUGHAN, ON L4K 3C4,
T: 416.746.1811 F: 905.746.1811

CLIENT: ROYAL PINE HOMES		UNIT 705 HMP	ROOM:	KITCHEN FLOOR PLAN	DRAWN BY: SK	COMMENTS: PLEASE NOTE ALL DIMENSIONS ARE NOT FINAL AND ARE SUBJECT TO CHANGE UPON FINAL SITE MEASURE
SITE:	HAMPTON PLACE	DOOR STYLE: --	DOOR HANDLE: --	SCALE: 1/2" = 1' - 0"		
PHONE: --	FINISH: --	DRW HANDLE: --	DATE: APRIL 28, 2018	PAGE: --		
EMAIL: --	SPECIES: --	TOP: --				

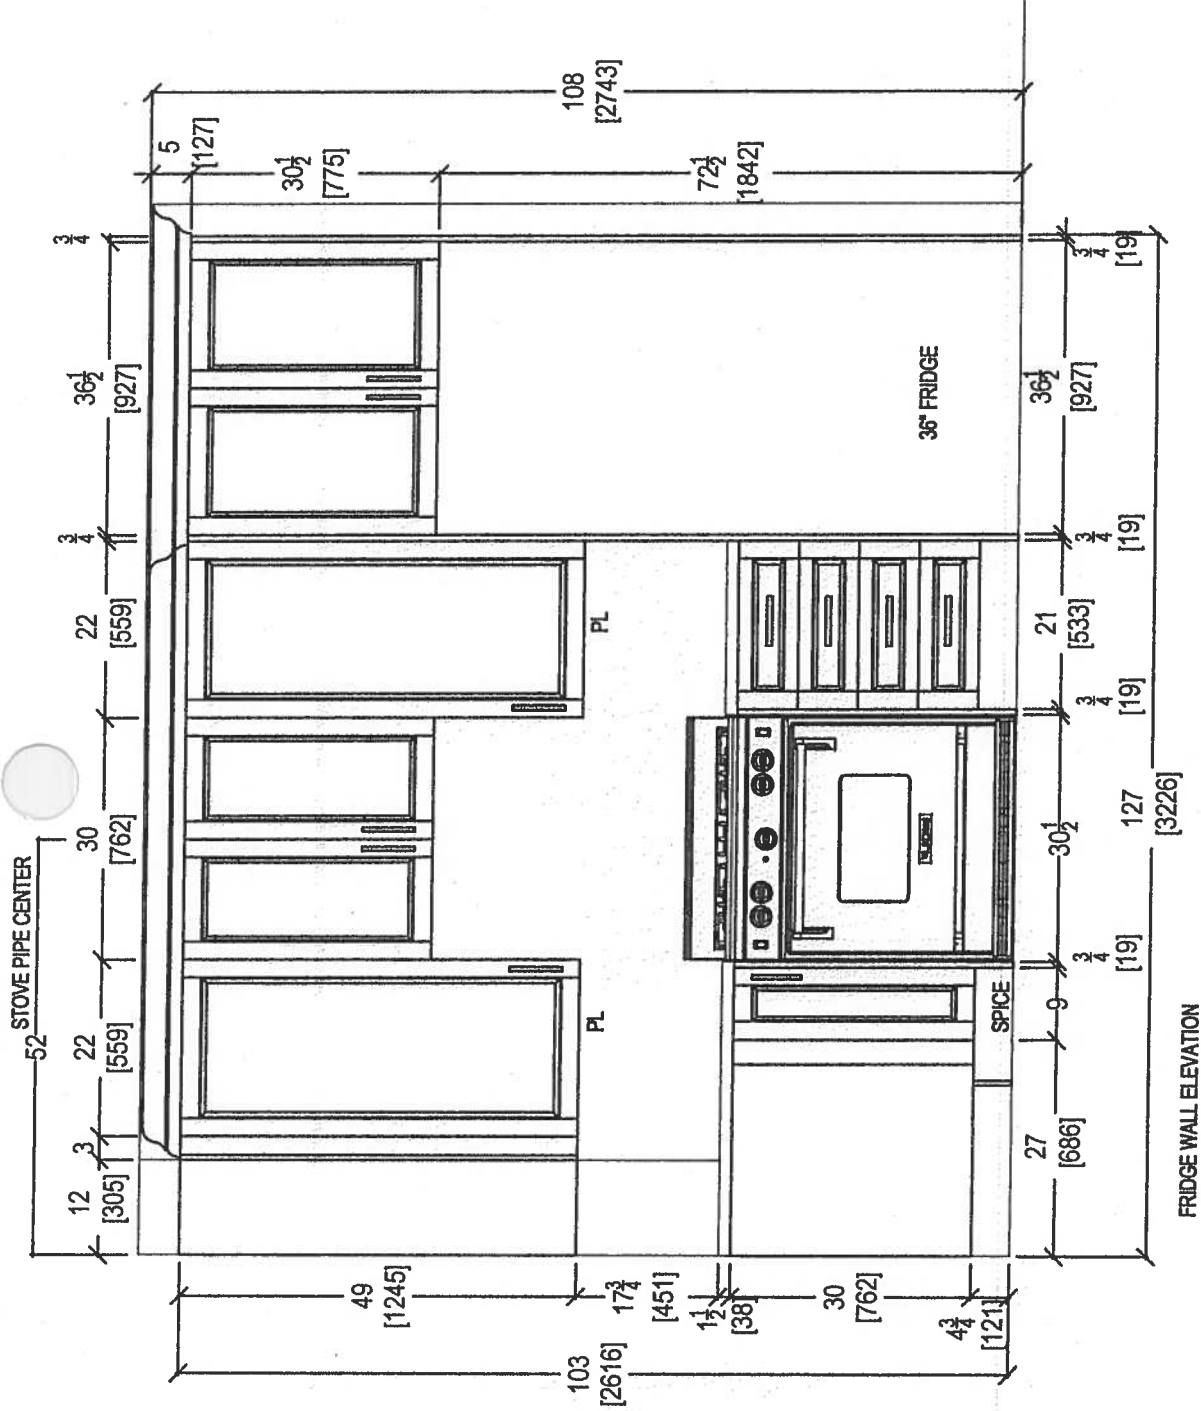


80 SANTE DRIVE, VAUGHAN, ON L4K 3C4,
T: 416.746.1811 F: 905.761.5901

CLIENT: ROYAL PINE HOMES		UNIT 705 HMP	ROOM: KITCHEN	DRAWN BY: SK	COMMENTS: PLEASE NOTE ALL DIMENSIONS ARE NOT FINAL AND ARE SUBJECT TO CHANGE UPON FINAL SITE MEASURE
SITE: HAMPTON PLACE	DOOR STYLE: —	DOOR HANDLE: —	SCALE: 1/2" = 1' - 0"		
PHONE: —	FINISH: —	DRW HANDLE: —	DATE: APRIL 28, 2018		
EMAIL: —	SPECIES: —	TOP: —	PAGE: —		

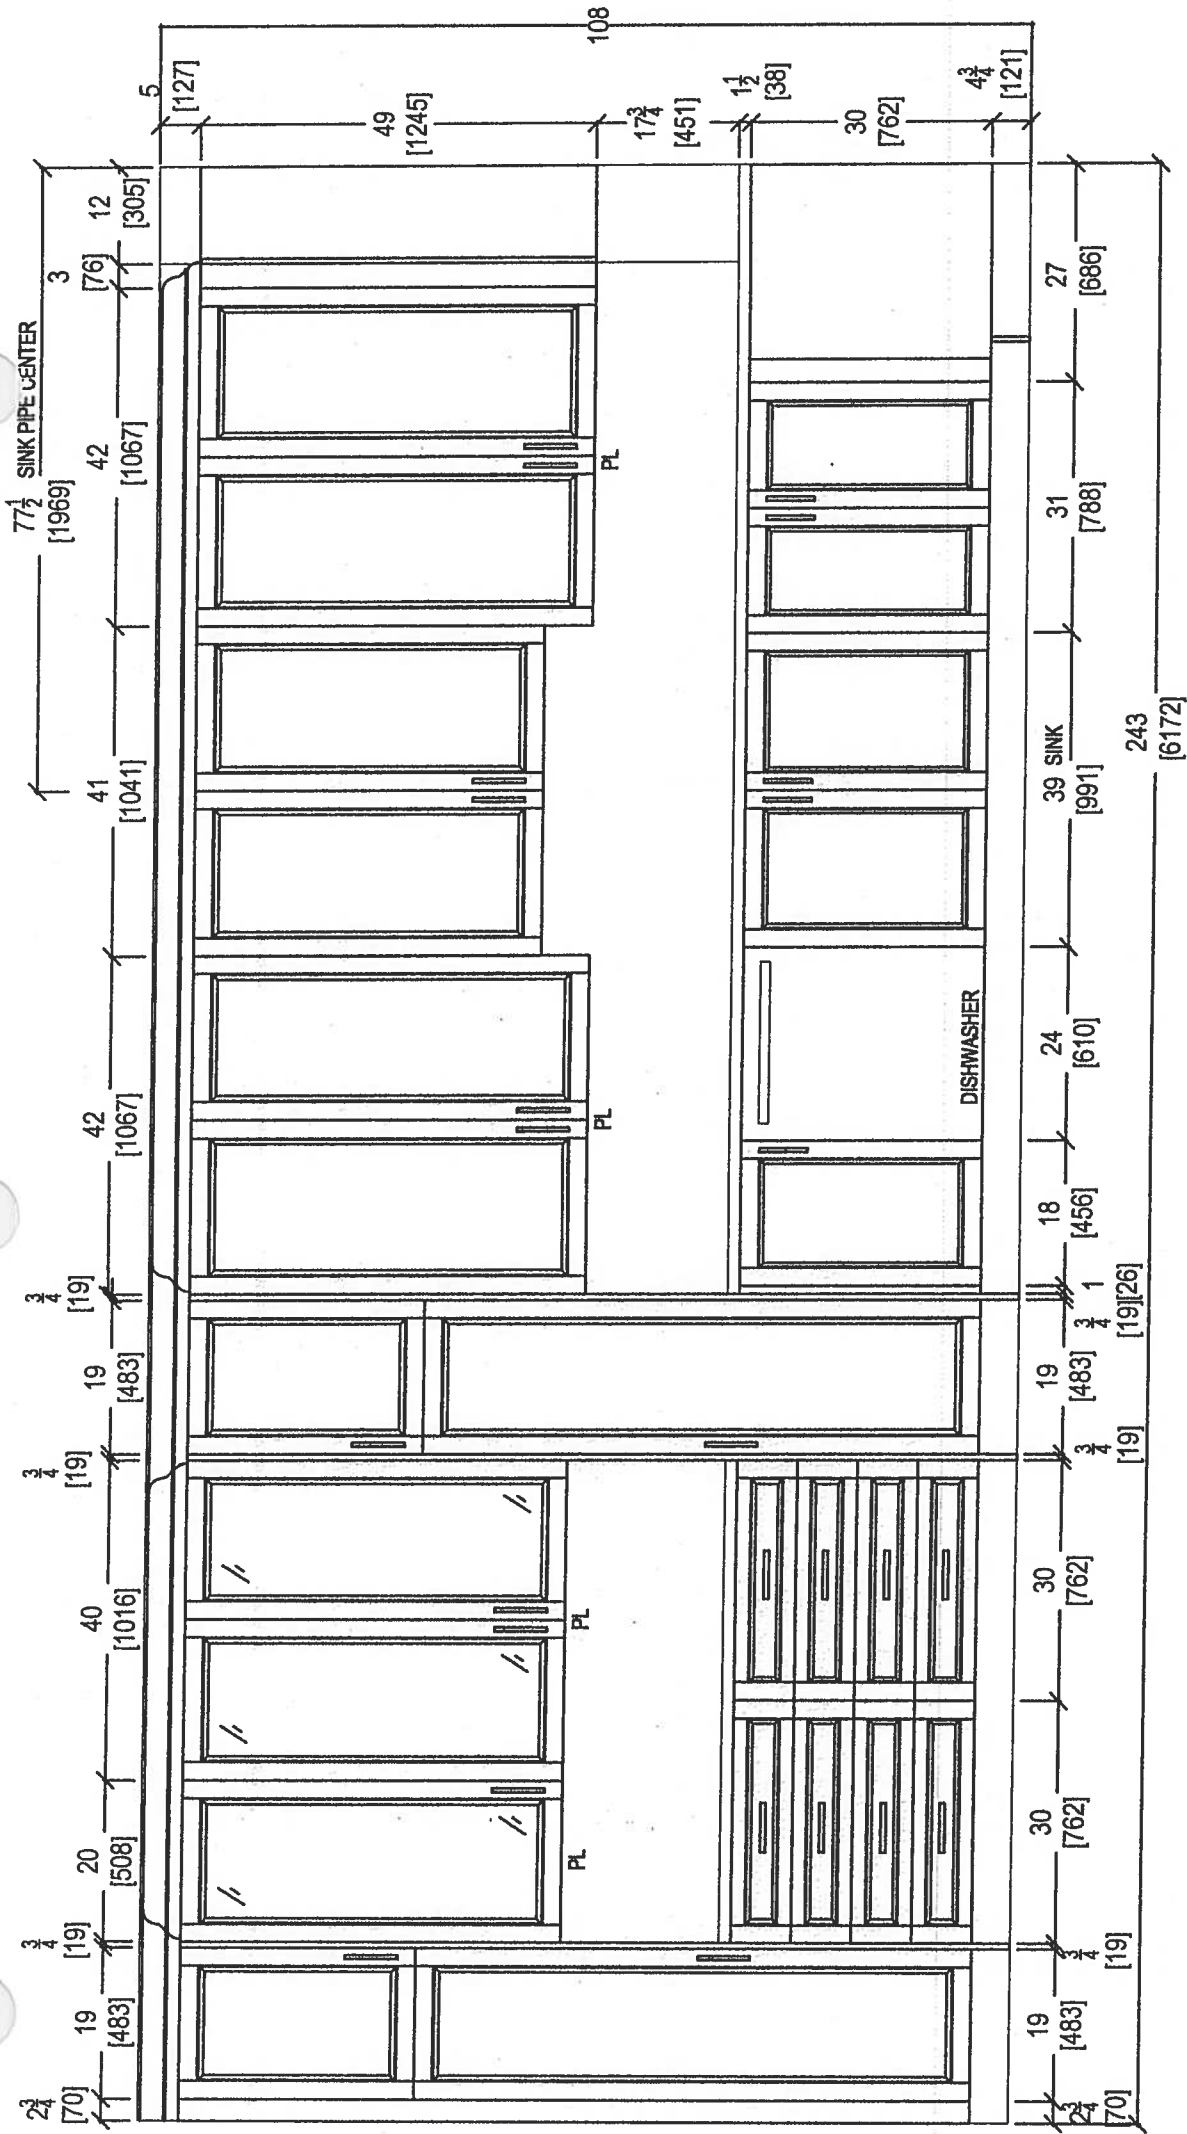


SINK WALL ELEVATION


 <i>your kitchen, your taste.</i> 80 SANTE DRIVE, VAUGHAN, ON L4K 3C4, T: 416.746.1811 F: 905.761.5901		CLIENT: ROYAL PINE HOMES		UNIT 705 HMP		ROOM: KITCHEN		DRAWN BY: SK		COMMENTS: PLEASE NOTE ALL DIMENSIONS ARE NOT FINAL AND ARE SUBJECT TO CHANGE UPON FINAL SITE MEASURE			
		SITE: HAMPTON PLACE		DOOR STYLE: —		DOOR HANDLE: —		SCALE: 1/2" = 1' - 0"					
		PHONE: —		FINISH: —		DRW HANDLE: —		DATE: APRIL 28, 2018					
		EMAIL: —		SPECIES: —		TOP: —		PAGE: —					

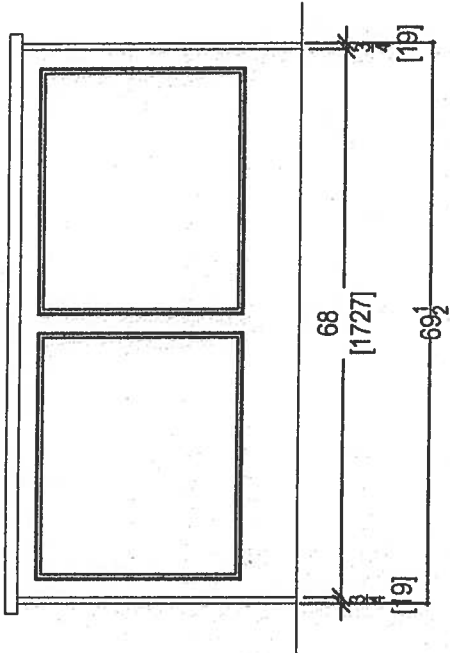

ISLAND REAR

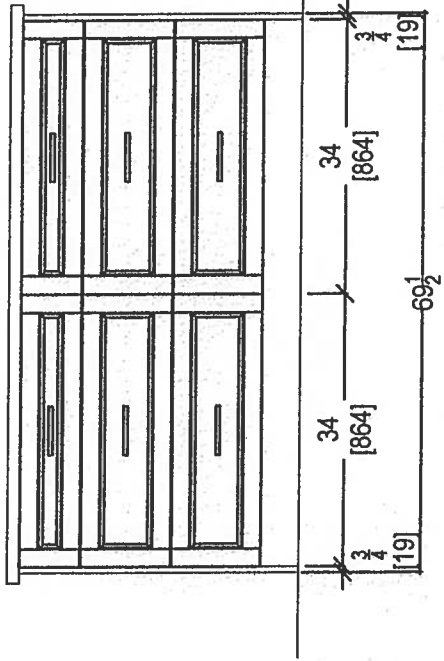


ISLAND FRONT

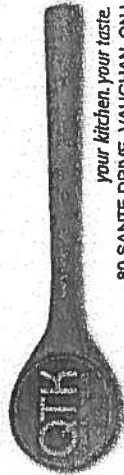


your kitchen, your taste.
80 SANTE DRIVE, VAUGHAN, ON L4K 3C4,
T: 416.746.1811 F: 905.761.5901


CLIENT: ROYAL PINE HOMES	UNIT 705 HMP		ROOM: KITCHEN	DRAWN BY: SK	COMMENTS: PLEASE NOTE ALL DIMENSIONS ARE NOT FINAL AND ARE SUBJECT TO CHANGE UPON FINAL SITE MEASURE
	SITE: HAMPTON PLACE	DOOR STYLE: —	DOOR HANDLE: —	SCALE: 1/2" = 1' - 0"	
	PHONE: —	FINISH: —	DRW HANDLE: —	DATE: APRIL 28, 2018	
	EMAIL: —	SPECIES: —	TOP: —	PAGE: —	

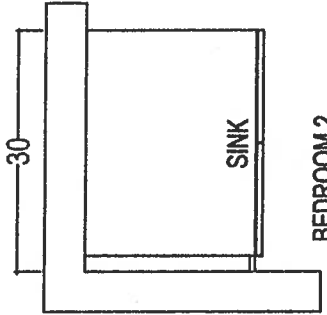




BEDROOM 2

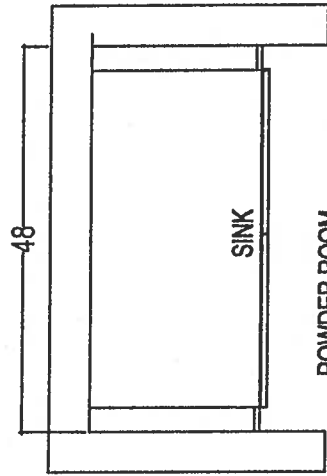

POWDER ROOM

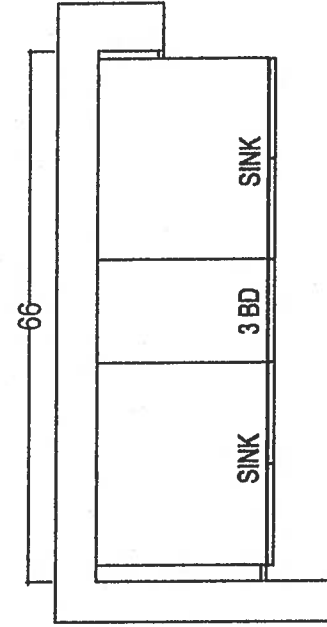

MASTER ENSUITE

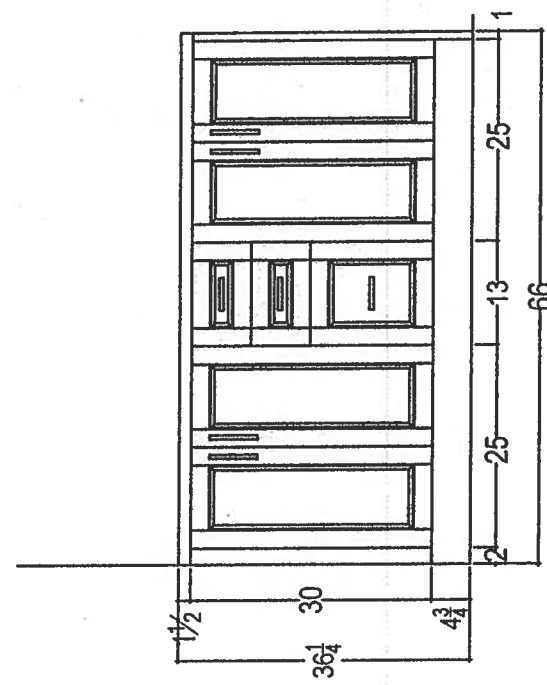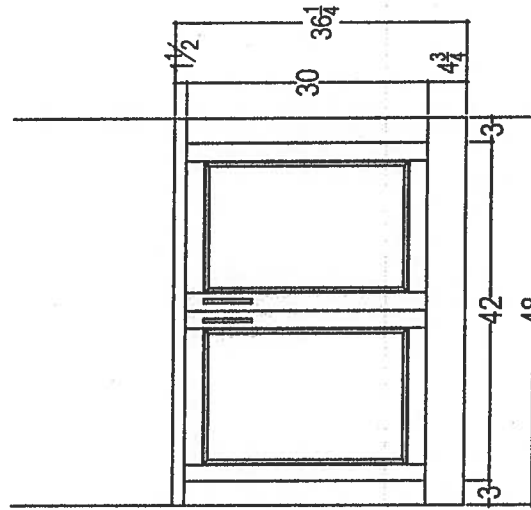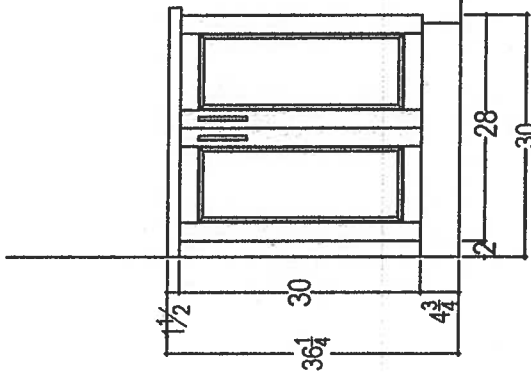


80 SANTE DRIVE, VAUGHAN, ON L4K 3C4,
T: 416.746.1811 F: 905.761.5901

CLIENT: ROYAL PINE HOMES	UNIT 705 HMP	ROOM:	VANITIES	DRAWN BY: SK	COMMENTS: PLEASE NOTE ALL DIMENSIONS ARE NOT FINAL AND ARE SUBJECT TO CHANGE UPON FINAL SITE MEASURE
SITE: HAMPTON PLACE	DOOR STYLE: —	DOOR HANDLE: —	SCALE: 1/2" = 1'-0"		
PHONE: —	FINISH: —	DRW HANDLE: —	DATE: MARCH 15, 2018		
EMAIL: —	SPECIES: —	TOP: —	PAGE: —		

KRFC302ESS

22 cu.ft. 36-Inch Width Counter Depth French Door Refrigerator
with Interior Dispense

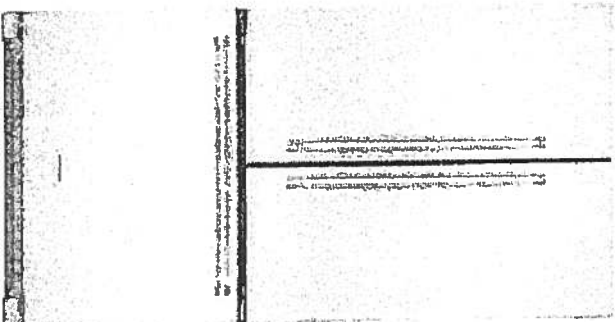

KRFC302ESS

Key Features:

- ExtendFresh™ Temperature Management System
- Interior Water Dispenser
- Professionally-Inspired Design
- Produce Preserver
- Humidity-Controlled Crispers
- FreshChill™ Temperature-Controlled Full-Width Pantry
- Pull-Out Tri-Level Freezer Drawer
- SatinGlide® System
- LED Lighting
- Star-K Certified
- Automatic Ice Maker
- Max Cool

KitchenAid®
<http://www.kitchenaid.com>

Product Dimensions:

Height: 72
Width: 35 3/4
Depth: 30 1/4

Electrical Requirements:

15 Amps.

Available In:

- ☒ Stainless Steel
- ☒ Black
- ☐ White

MAJORS
BY
AMERICA

Upgrade
Package 2

Suite 705
Hampton

07-04

Suite 705
Hampton

Upgrade
Package 2

27
✓

KSEB900ESS


30-Inch 5-Element Electric Convection Slide-In
Range with Baking Drawer

<http://www.kitchenaid.com>

Key Features:

- Baking Drawer
 - Even-Heat™ True Convection
 - Wireless Probe
 - Steam Rack
 - 7.1 Cu Ft. Total Capacity
 - 5 Cooking Elements Including a Warm Zone
 - EasyConvect™ Conversion
 - FIT Guarantee
 - Aqualift®
 - Glass Touch Controls
 - Side Trim Accessory Kit
- Product Dimensions:
- Height: 36
 - Width: 29 7/8
- Electrical Requirements:
- 40 Amps.
- Additional Information:

Use And Care Guide
Dimension Guide
Installation Guide
Warranty Certificate

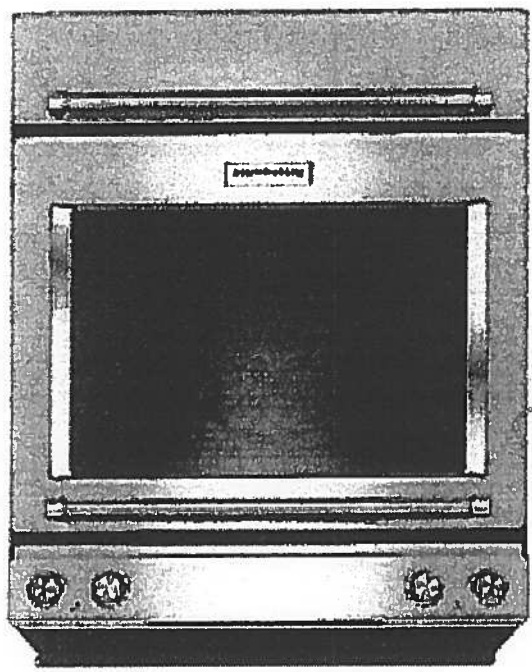

Available in:

- Black
- Stainless Steel
- White

INVESTED
IN
AMERICA



Registered trademark/TM Trademark of Whirlpool, U.S.A. © 2013 Whirlpool Corporation. All Rights Reserved.
All other trademarks are owned by their respective companies.
Because Whirlpool Corporation policy includes a continuous commitment to improve our products, we reserve the right to change materials and specifications without notice. We also reserve the right to discontinue or transition products without notice.
Manufacturer's Suggested Retail Price (MSRP) and Minimum Advertised Price (MAP) provided for reference purposes only. Dealer alone determines advertised and retail prices.
Created On: Tuesday, December 22, 2015 14:04:50

Suite 705
Hampton
Upgrade
Package 2

2020

KMHP519ESS

1200-Watt Convection Microwave with High-Speed Cooking - 30"

<http://www.kitchenaid.com>

- Key Features:**
- High-Speed Cooking
 - Convection Cooking
 - Professionally-Inspired Design Including Handle, Badge, Graphics, Chrome Chamfer.
 - Cookshield Finish
 - Crispwave™ Technology and Crisper Pan
 - 1200 Watts Power
 - 1.9 Cu. Ft. Capacity
 - Halogen Cavity Lights and Task Light
 - Steam Cleaning Function
 - Keep Warm Function
 - Sound-Based Popcorn Function

Product Dimensions:


Height: 17 1/8"
Width: 30"
Depth: 17"

Electrical Requirements:

15.

Additional Information:

Use And Care
Dimension Guide
Installation Guide
Manually

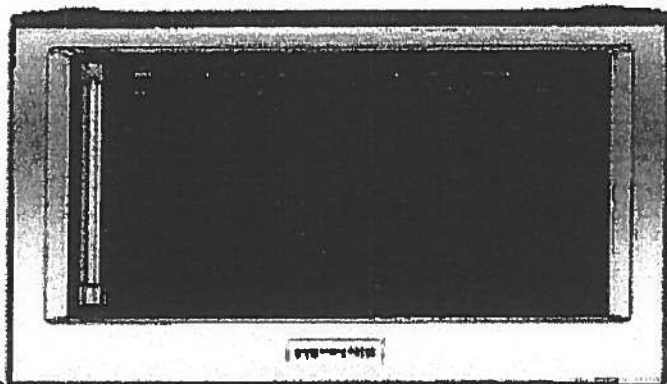

Available In:

Stainless Steel

Registered trademark/™ Trademark of Whirlpool, U.S.A. © 2016 Whirlpool Corporation All Rights Reserved. All other trademarks are owned by their respective companies. Because Whirlpool Corporation policy includes a continuous commitment to improve our products, we reserve the right to change materials and specifications without notice. We also reserve the right to discontinue or transition products without notice. Manufacturer's Suggested Retail Price (MSRP) and Minimum Advertised Price (MAP) provided for reference purposes only. Dealer alone determines advertised and retail prices.

Suite 705
Hampton

Upgrade
Package 2

20
21

KDTM354ESS

44 dBA Dishwasher with Clean Water Wash System

<http://www.kitchenaid.com>

KitchenAid



Electrical Requirements:
15 Amps.

Additional Information:

Use And Care Guide
Dimension Guide
Installation Guide
Energy Guide
Warranty Certificate

Available in:
Stainless Steel

INVESTED
IN
AMERICA

©Registered trademark/™ of Whirlpool, U.S.A. © 2013 Whirlpool Corporation. All Rights Reserved.
All other trademarks are owned by their respective companies.
Because Whirlpool Corporation policy includes a continuous commitment to improve our products, we reserve the right to change materials and specifications without notice. We also reserve the right to discontinue or transition products without notice.
Manufacturer's Suggested Retail Price (MSRP) and Minimum Advertised Price (MAP) provided for reference purposes only. Dealer alone determines advertised and retail prices.
Created On: Friday, March 04, 2016 16:36:55

Suite 705
Hampton

Upgrade
Package 2

WED85HEFC

7.4 cu. ft. Electric Dryer with Quick Dry Cycle

<http://www.whirlpool.com>

Whirlpool®



Key Features:


- Advanced Moisture Sensing System
- Tap Touch Controls with Memory
- EcoBoost™ Option
- Steam Refresh Cycle
- Wrinkle Shield™ Option
- Quad Baffles
- 7.4 Cu. Ft. Capacity
- Undercounter Installation
- ENERGY STAR® Qualified
- Sanitize Cycle
- Quick Dry Cycle

Product Dimensions:

Height: 39
Width: 27
Depth: 31

Additional Information:

Use And Care Guide
Dimension Guide
Installation Guide
Warranty Certificate

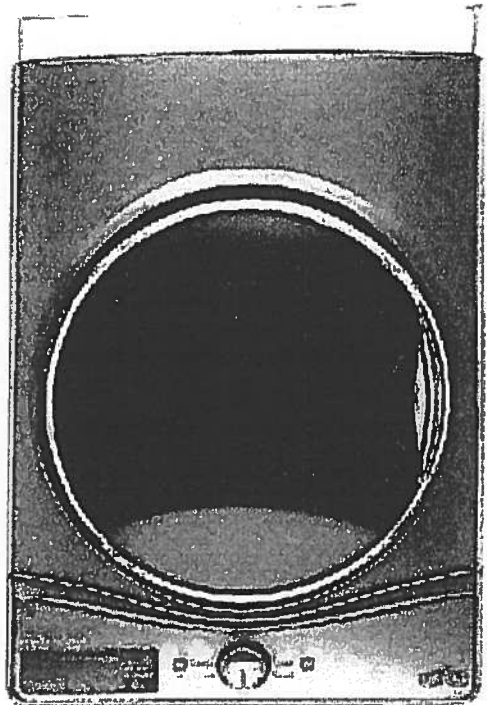

INVESTED
IN
AMERICA



Registered trademark of Whirlpool, U.S.A. © 2016 Whirlpool Corporation. All Rights Reserved.
All other trademarks are owned by their respective companies.
Because Whirlpool Corporation policy includes a continuous commitment to improve our products, we reserve the right to change materials and specifications without notice. We also reserve the right to discontinue or transition products without notice.
Manufacturer's Suggested Retail Price (MSRP) and Minimum Advertised Price (MAP) provided for reference purposes only. Dealer alone determines advertised and retail prices.
Created On: Thursday, March 23, 2017 17:33:37

Suite 705
Hampton


Upgrade
Package 2

WFW85HEFC

4.5 cu. ft. Front Load Washer with TumbleFresh™

option

<http://www.whirlpool.com>

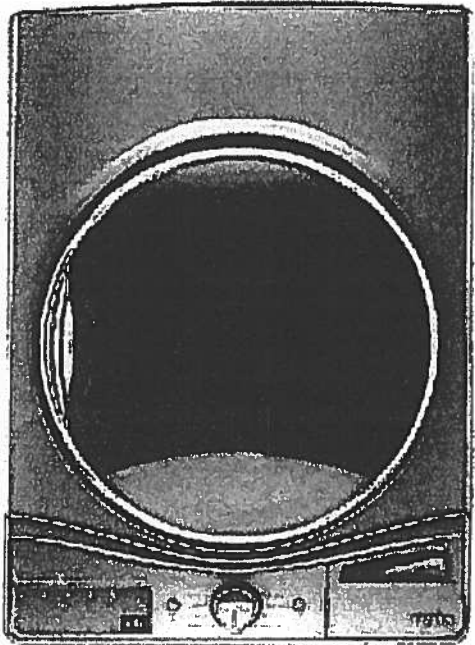

Key Features:

- TumbleFresh™ Option
- ColorLast™ Cycle
- Presoak Option
- EcoBoost™ Option
- Precision Dispense
- Steam Clean Option
- Adaptive Wash Technology
- Smooth Wave Stainless Steel Wash Basket
- 4.5 cu. ft. Capacity
- Undercounter Installation
- Add-A-Garment
- ENERGY STAR® Certified

Product Dimensions:

Height: 39 3/4
Width: 27
Depth: 33 5/16

Additional Information:

- Use And Care Guide
- Dimension Guide
- Installation Guide
- Energy Guide
- Warranty Certificate

Available in:

- ☐ Chrome Shadow
- ☐ White

INVESTED
IN
AMERICA



®Registered trademark/™ Trademark of Whirlpool U.S.A. © 2016 Whirlpool Corporation. All Rights Reserved.
All other trademarks are owned by their respective companies.
Because Whirlpool Corporation policy includes a continuous commitment to improve our products, we reserve the right to change materials and specifications without notice. We also reserve the right to discontinue or transition products without notice.
Manufacturer's Suggested Retail Price (MSRP) and Minimum Advertised Price (MAP) provided for reference purposes only. Dealer alone determines advertised and retail prices.
Created On: Wednesday, December 14, 2016 18:12:43

Suite 705
Hampton

Powder Room
Ensuite #2
Master Ensuite

CALL®

4.8Lpf / 1.28Gpf 1PC 16 7/8" HIGH ELONGATED

- ☐ 4710BOV Lined Tank
☒ 4710BOVU Unlined Tank

Product Specs:

- High efficiency toilet
- 4.8Lpf/1.28Gpf
- Elongated bowl with concealed skirted trapway
- Vitreous china
- 16" Plus Height bowl
- Soft white tank lever
- 12" (305mm) Rough-in
- 2" Fully glazed ball pass trapway
- 3" Flapper
- Siphon jet flush action
- Water surface (240mm x 170mm) 9 1/2" x 6"
- Decorative chrome and soft white side caps included
- Smooth close toilet seat included

Overall Dimensions:

392mm (W) x 725mm (D) x 760mm (H)
15 1/2" (W) x 28 1/2" (D) x 29 3/4" (H)

Compliance Certifications:



Meets or exceeds the following:

- IAPMO cUPC
- US EPA WaterSense
- ASME A 12.19.2 / CSA B45.1-2013
- ADA Guidelines & ANSI A117.1
- MaP Tested 1000g
- LEED Compliant

Shipping:

Cube 9.39

GW 92.50lbs

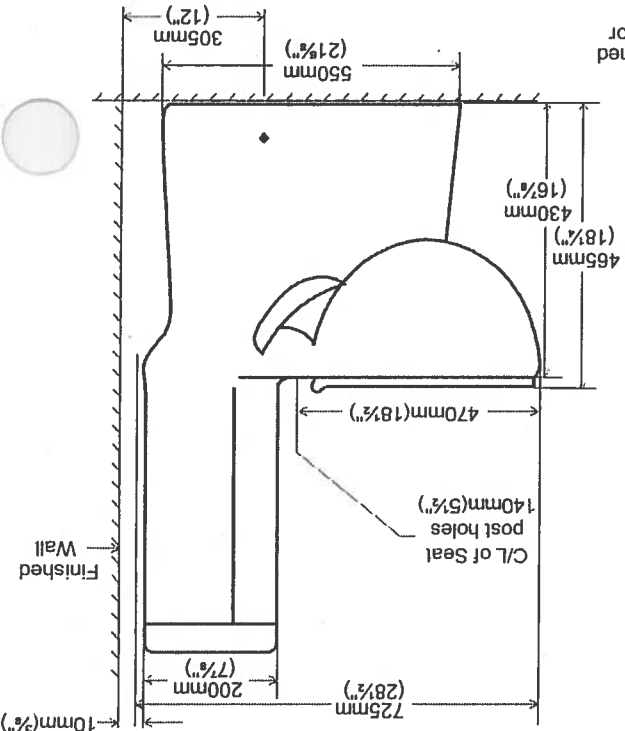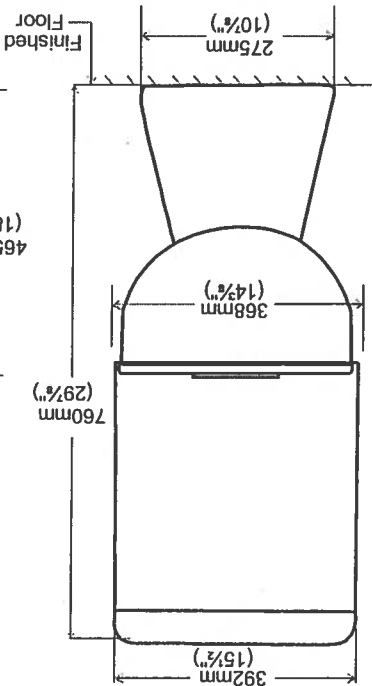

Notes:

This toilet is designed to rough-in at a minimum dimension of 305mm (12") from finished wall to C/L of outlet. Supply line not included with fixture and must be ordered separately.
Important: Dimensions of fixtures are nominal and may vary within the range of tolerances established by ASME standard A112.19.2. These measurements are subject to change or cancellation. No responsibility is assumed for use of superseded or voided pages.
Products are designed to comply ADA/ANSI A117.1 Standard. It shall be the responsibility of the installer to comply with the local disability codes and standards prior to installing the product.




Suite 705
Hampton

Living Room

CONDUIT

CABLE/BELL @ 60" PLUG

CONDUIT BLANK RATE PLUG

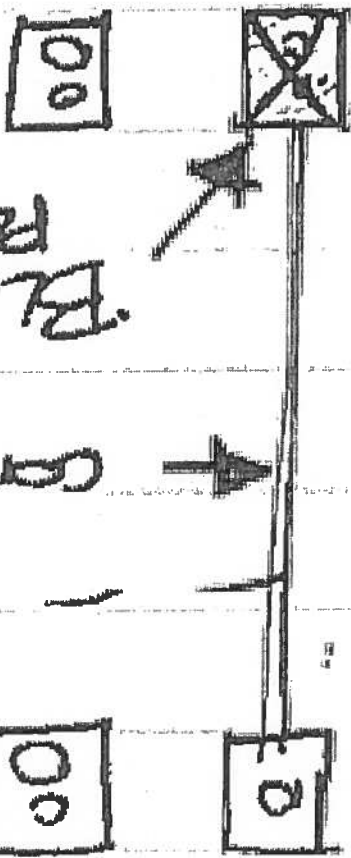

Countertop Edges Suite 705 Hampton


07
2

EDGE
DETAILS



004

CONNOLLY Marble & Granite Ltd.

Standard:
Powder Room
Ensuite #2
Master Ensuite

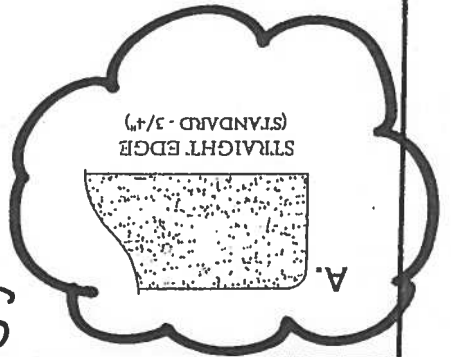

Upgrade:
Kitchen

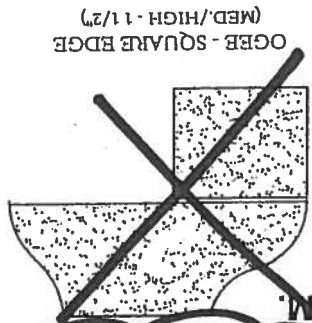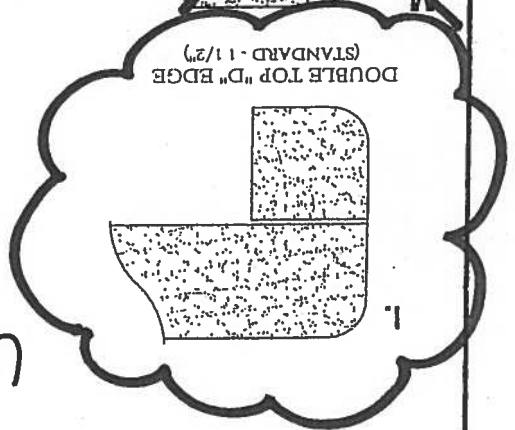

EDGING UP-GRADE OPTIONS