






Sag Harbor

Suite 708

ORIGINAL SUITE


LAYOUT (Inventory Suite)


878 SQ FT plus 119 sq. ft. of balcony area

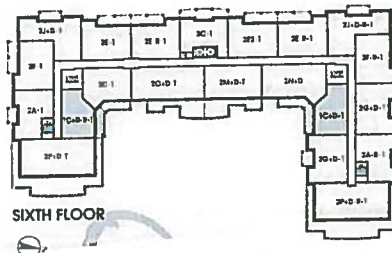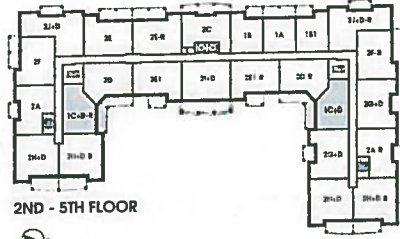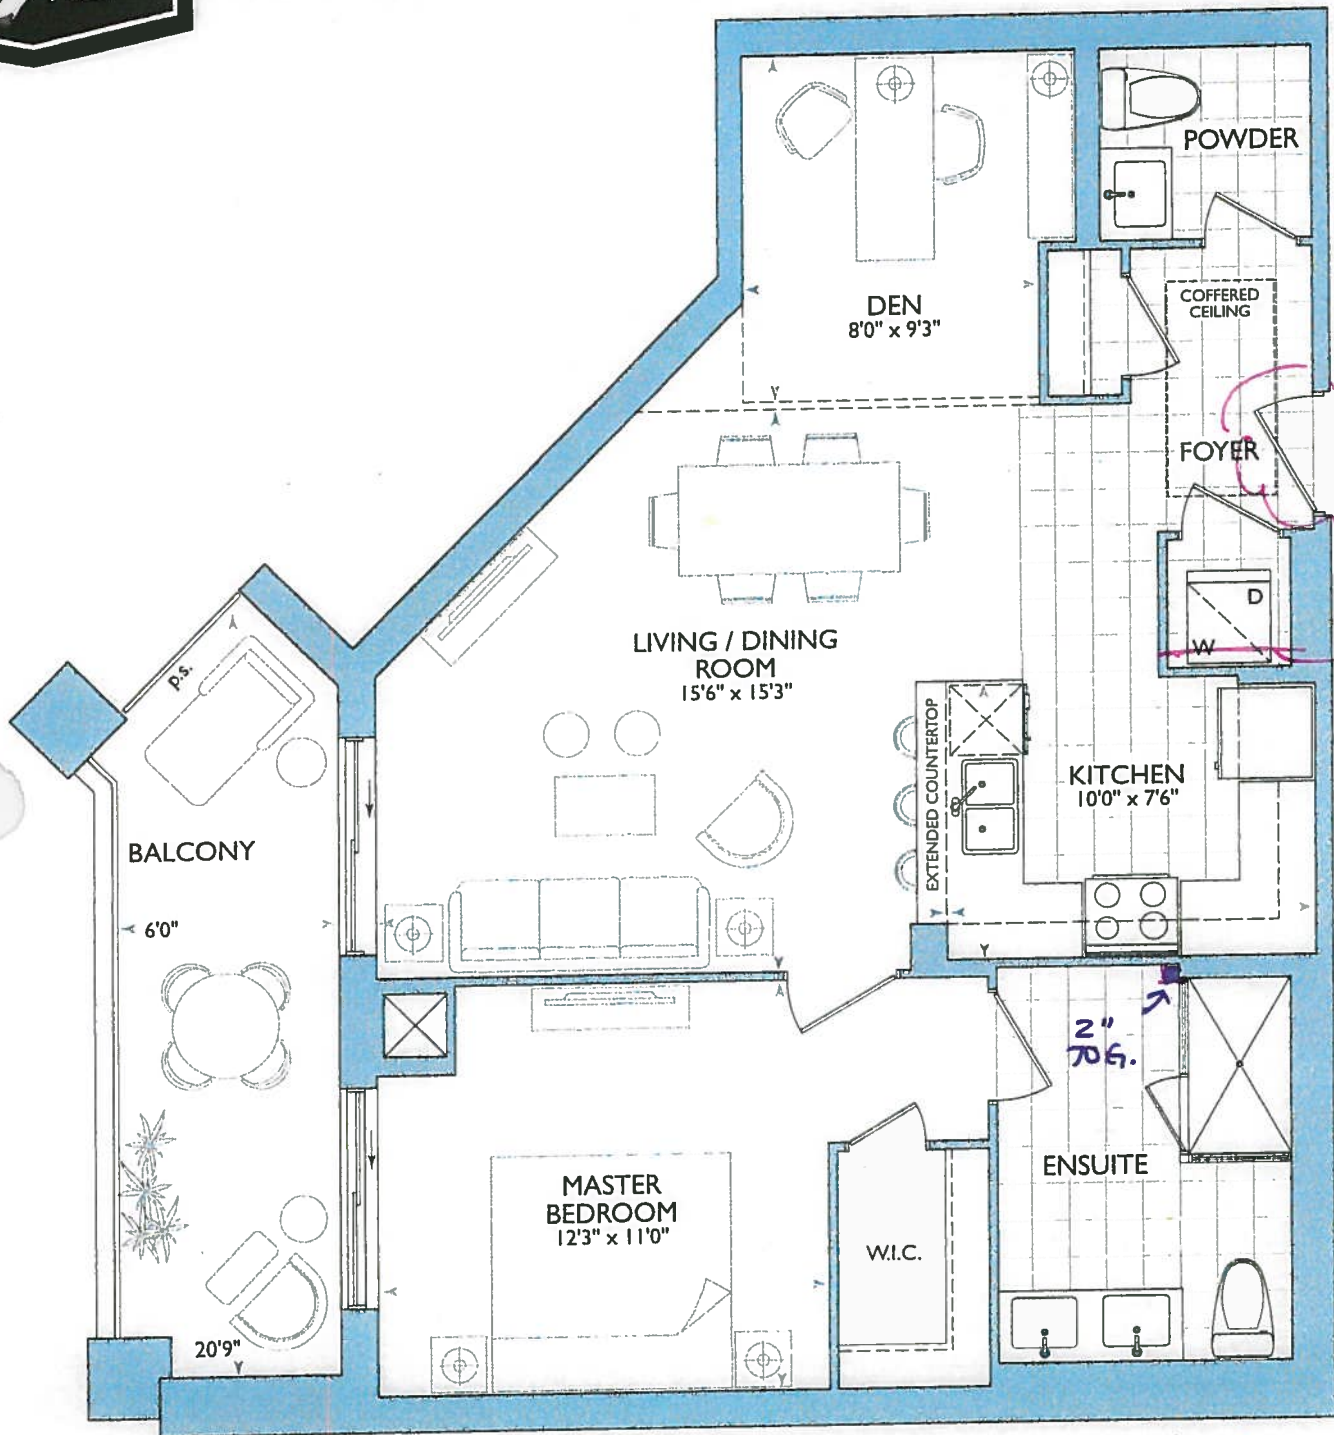

Suite 708 - Inventory Suite

- STO 7th Floor Kitchen
- STO APPLIANCE PKGS.
- (x3) PUCK LIGHTS
- (x1) PLUG PENINSULA
- 66" STOVE PIPE CENTER
- 117" SINK PIPE CENTER
- (x2) = CAPPED PENDANT LIGHTS OVER PENINSULA.

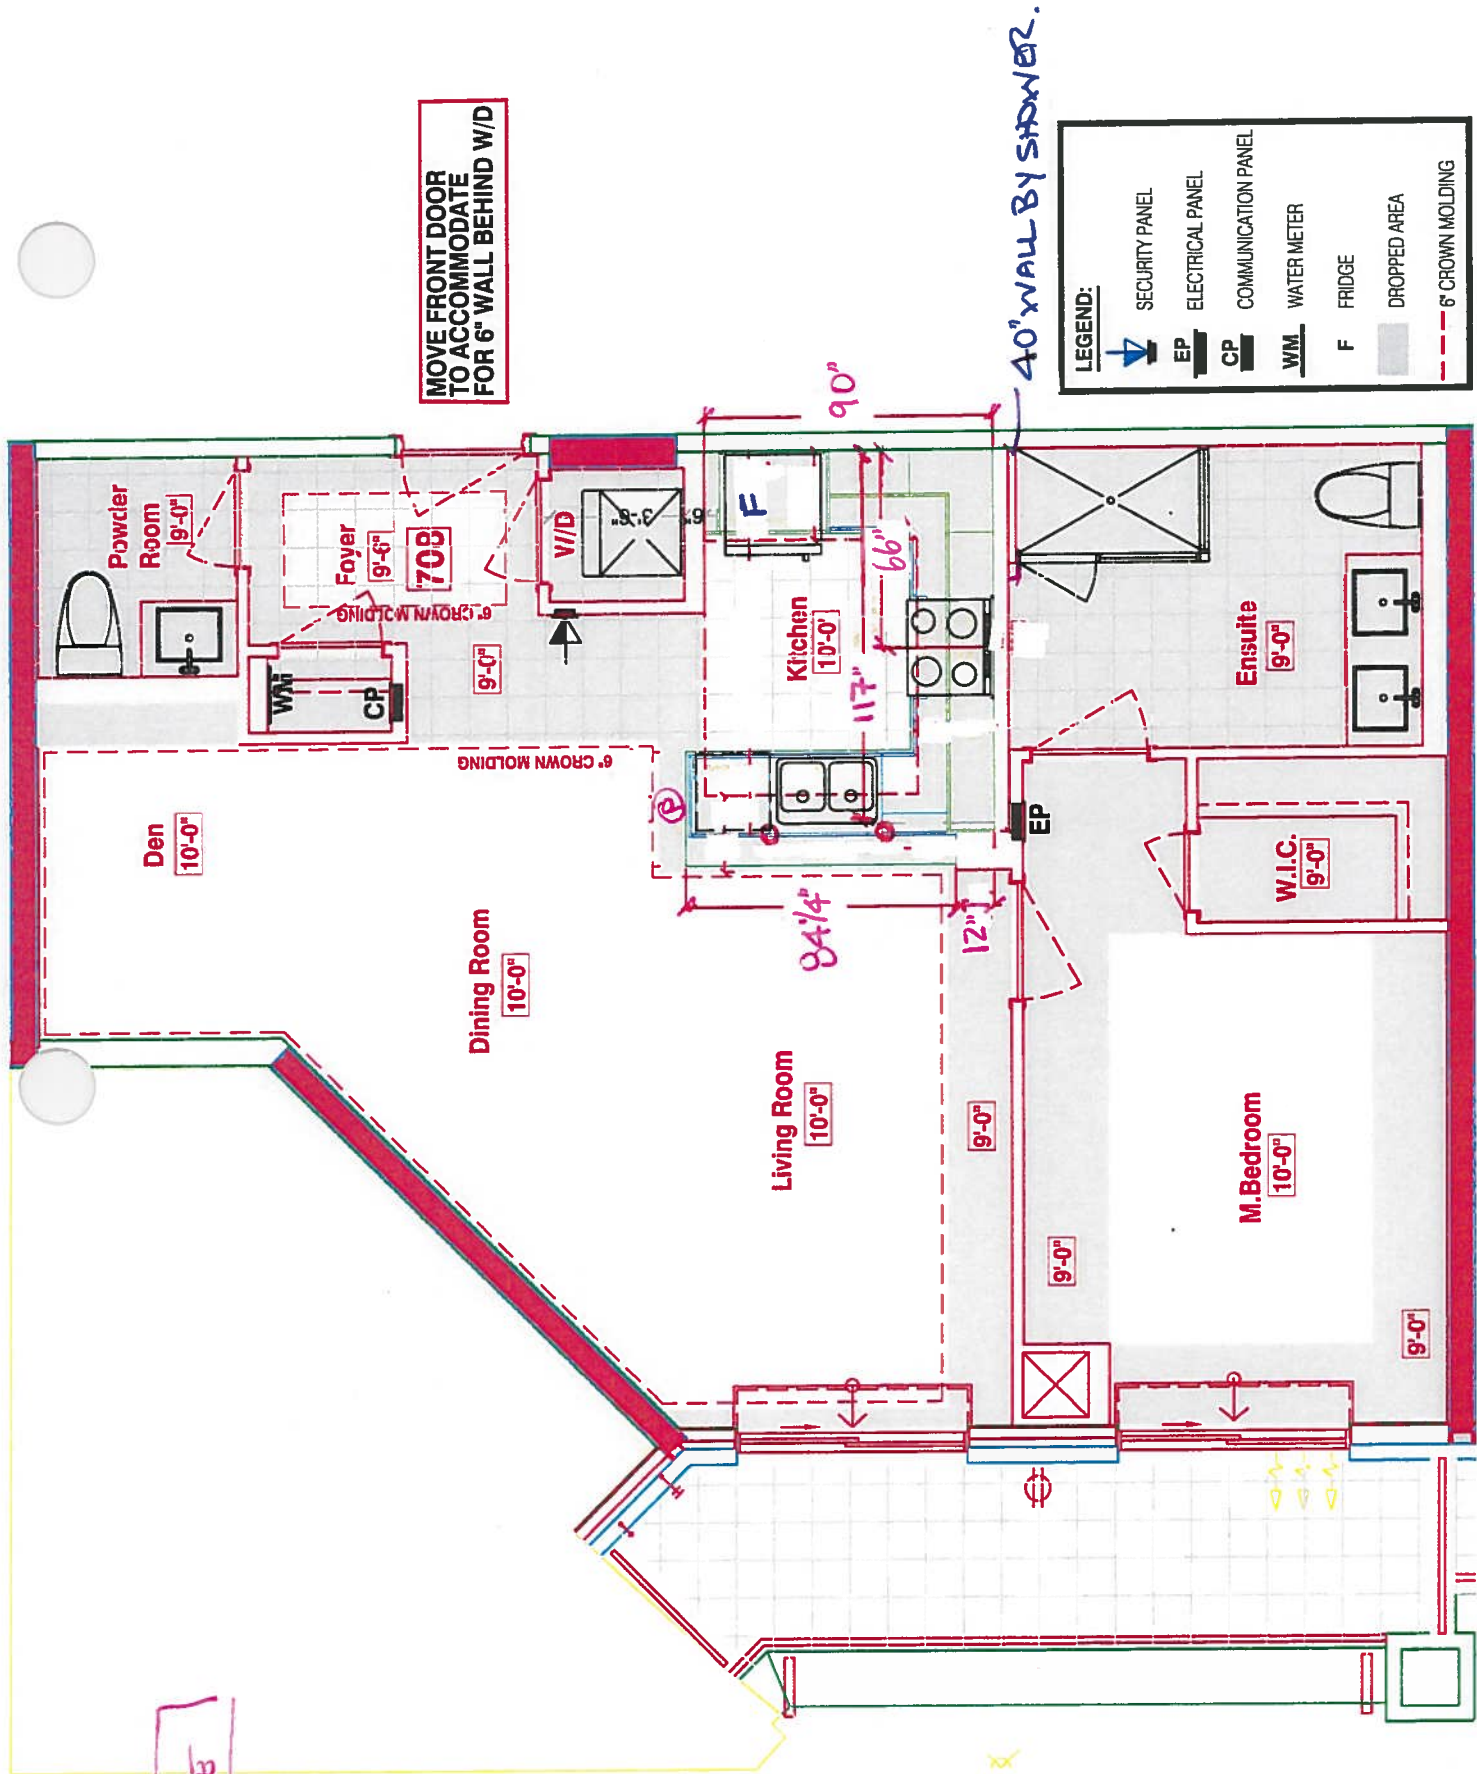

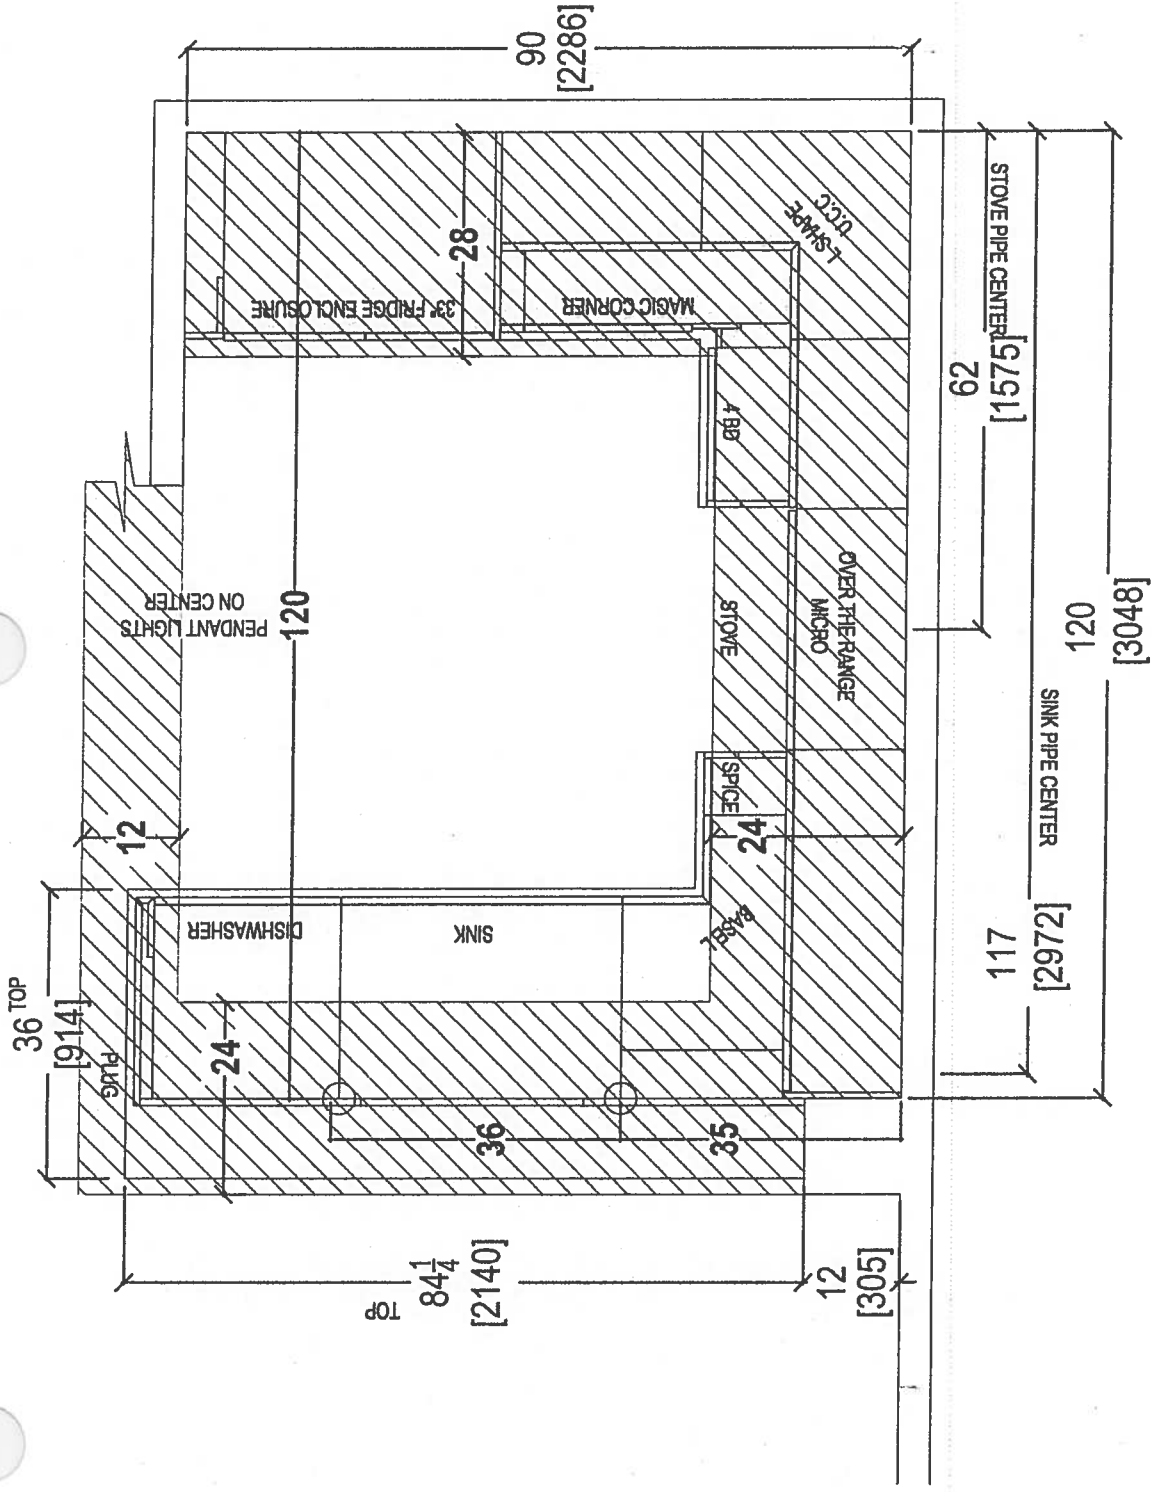


SUITE 708 - INVENTORY
SUITE

- OPTIONAL 1ST UPG KITCHEN
- OPT 1ST UPG APPLIANCE
- (x5) PUCK LIGHTS
- (x2) CARRIES PENDANT LIGHTS
- (x1) PLUG PENINSULA




80 SANTE DRIVE, VAUGHAN, ON L4K 3C4,
T: 416.746.1811 F: 905.761.5901

CLIENT: ROYAL PINE HOMES SITE: HAMPTON PLACE PHONE: — EMAIL: —	JOB NAME: UNIT 708 HMP UPGRADE	ROOM: KITCHEN	DRAWN BY: SK	COMMENTS: PLEASE NOTE ALL DIMENSIONS ARE NOT FINAL AND ARE SUBJECT TO CHANGE UPON FINAL SITE MEASURE
	DOOR STYLE: —	DOOR HANDLE: —	SCALE: 1/2" = 1' - 0"	
	FINISH: —	DRW HANDLE: —	DATE: APRIL 27, 2018	
	SPECIES: —	TOP: —	PAGE:	

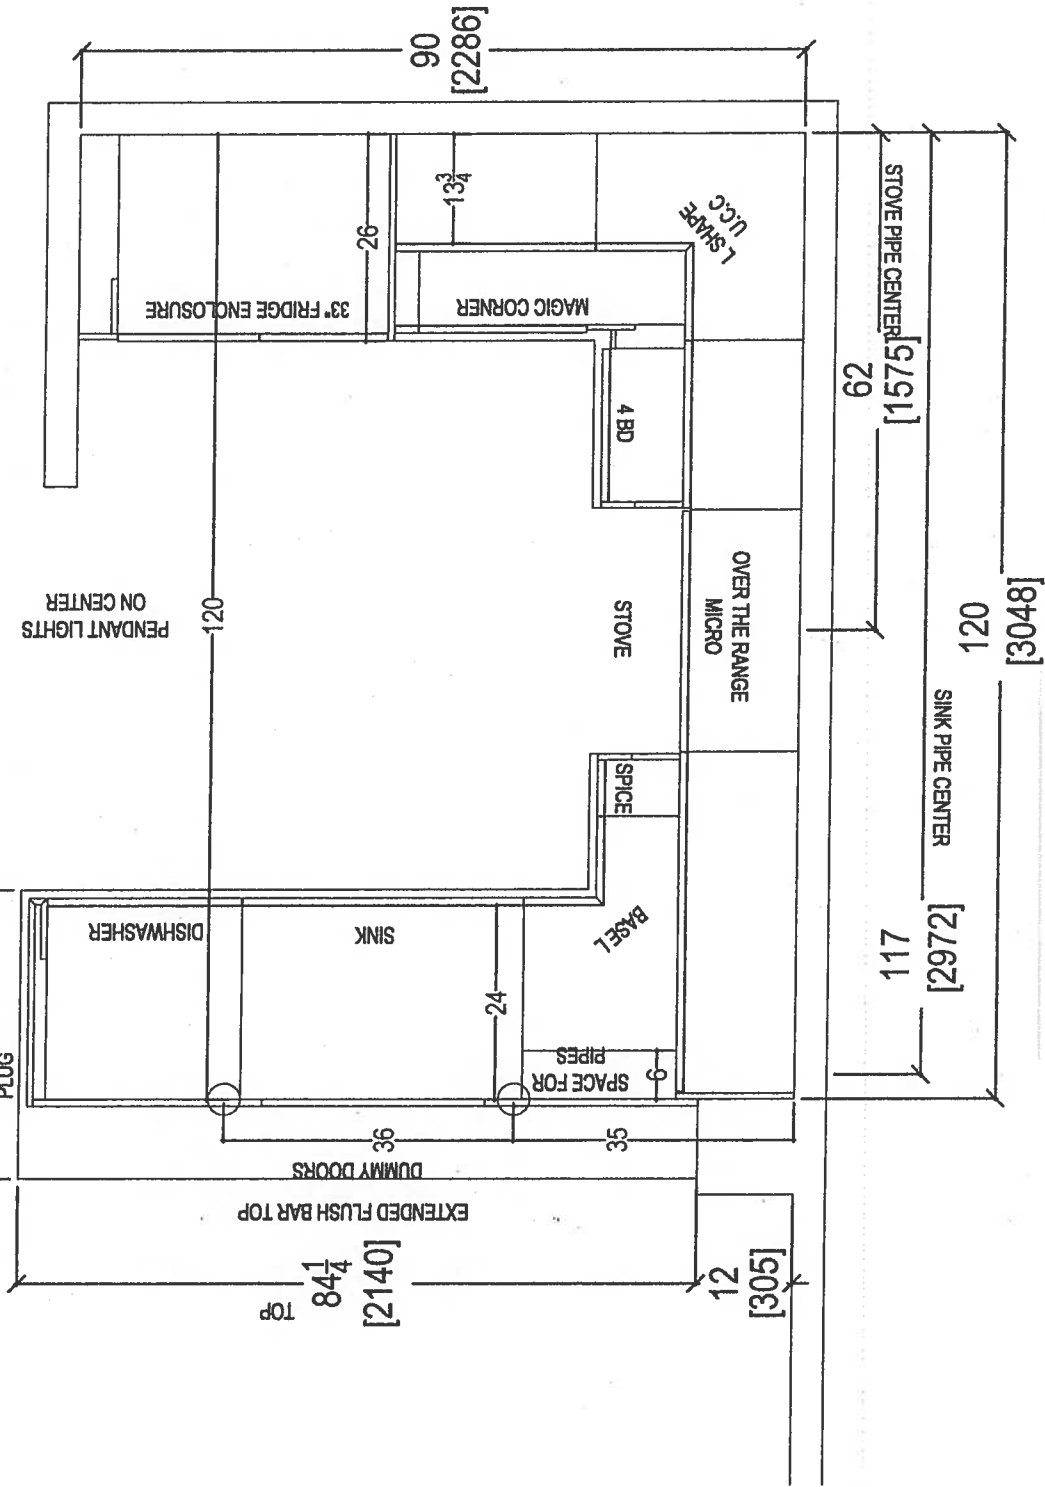


 <i>your kitchen, your taste.</i> 80 SANTE DRIVE, VAUGHAN, ON L4K 3C4, T: 416.746.1811 F: 905.761.5901	CLIENT: ROYAL PINE HOMES		JOB NAME: UNIT 708 HMP	ROOM: KITCHEN	DRAWN BY: SK	
	SITE: HAMPTON PLACE		DOOR STYLE: —	DOOR HANDLE: —	SCALE: 1/2" = 1' - 0"	
	PHONE: —		FINISH: —	DRW HANDLE: —	DATE: APRIL 27, 2018	
	EMAIL: —		SPECIES: —	TOP: —	PAGE:	
	COMMENTS: PLEASE NOTE ALL DIMENSIONS ARE NOT FINAL AND ARE SUBJECT TO CHANGE UPON FINAL SITE MEASURE					

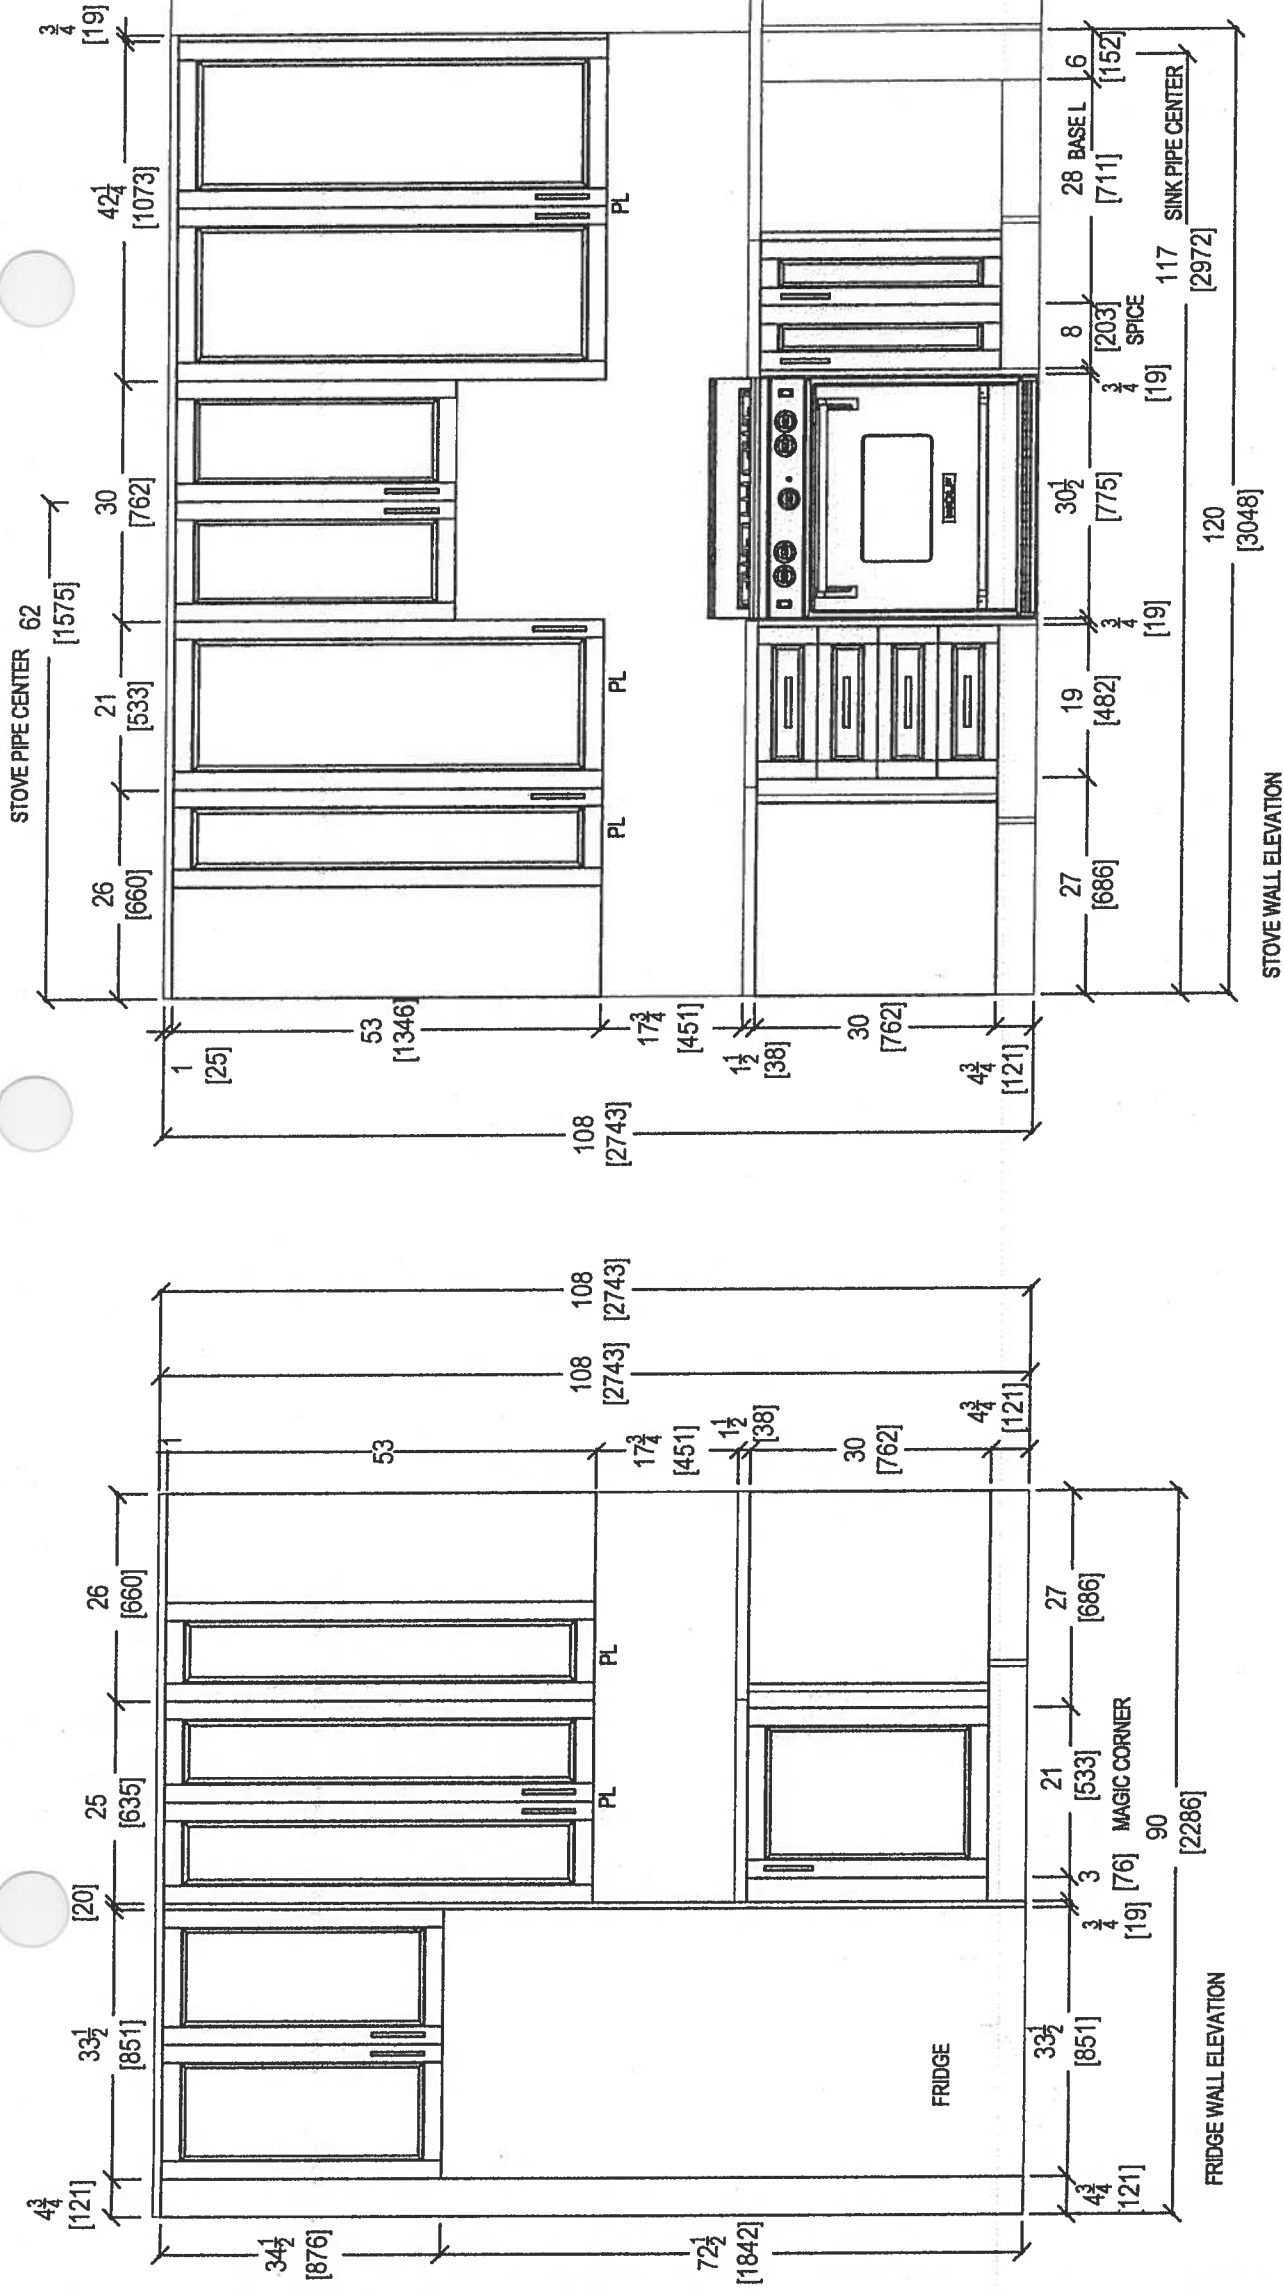


 your kitchen, your taste. 80 SANTE DRIVE, VAUGHAN, ON L4K 3C4, T: 416.748.1811 F: 905.761.5901	CLIENT: ROYAL PINE HOMES		JOB NAME: 708 HMP	ROOM: KITCHEN	DRAWN BY: SK	COMMENTS: PLEASE NOTE ALL DIMENSIONS ARE NOT FINAL AND ARE SUBJECT TO CHANGE UPON FINAL SITE MEASURE
	SITE: HAMPTON PLACE		DOOR STYLE: —	DOOR HANDLE: —	SCALE: 1/2" = 1' - 0"	
	PHONE: —		FINISH: —	DRW HANDLE: —	DATE: APRIL 27, 2018	
	EMAIL: —		SPECIES: —	TOP: —	PAGE:	

9

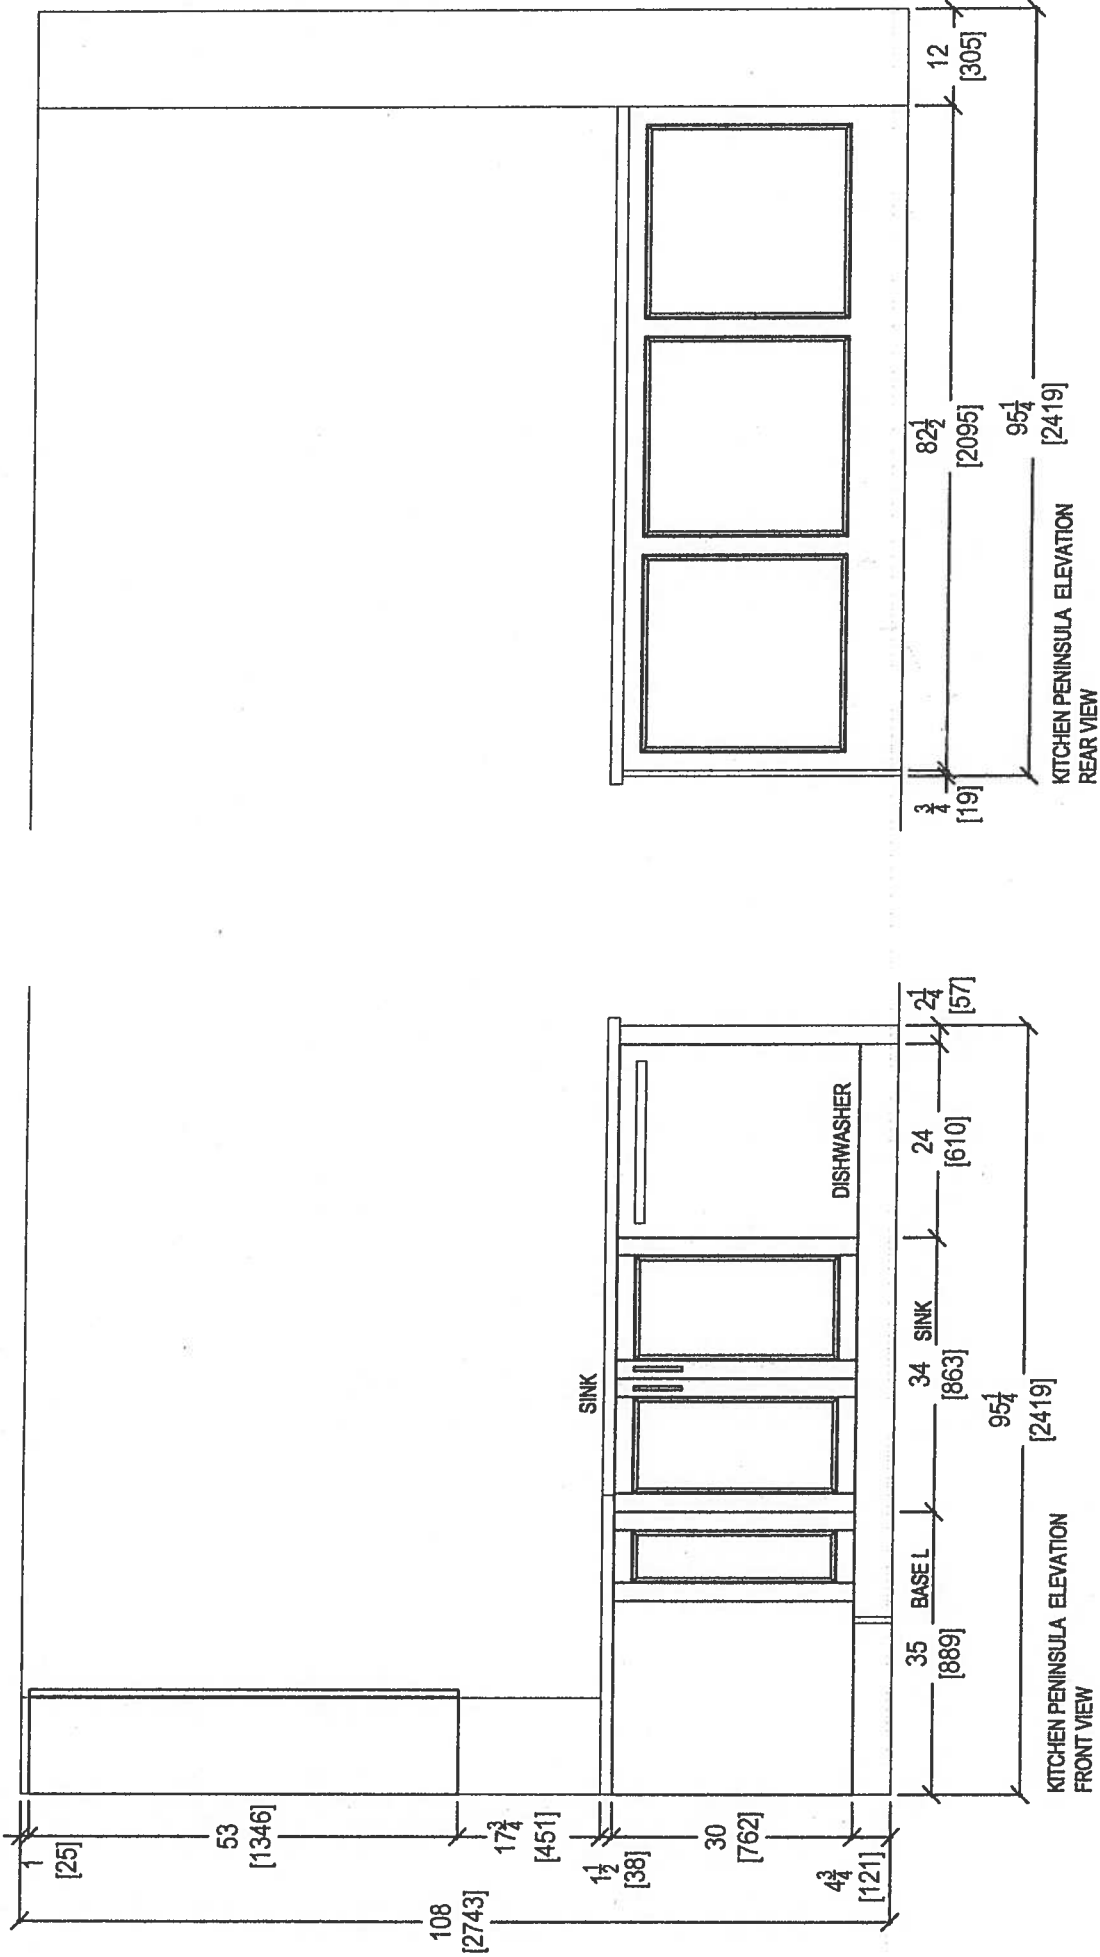


80 SANTE DRIVE, VAUGHAN, ON L4K 3C4,
T: 416.746.1811 F: 905.781.5801



CLIENT: ROYAL PINE HOMES		JOB NAME: 708 HMP	ROOM: KITCHEN	DRAWN BY: SK	COMMENTS:
SITE: HAMPTON PLACE	DOOR STYLE: —	DOOR HANDLE: —	SCALE: 1/2" = 1' - 0"		
PHONE: —	FINISH: —	DRW HANDLE: —	DATE: APRIL 27, 2018		
EMAIL: —	SPECIES: —	TOP: —	PAGE:		

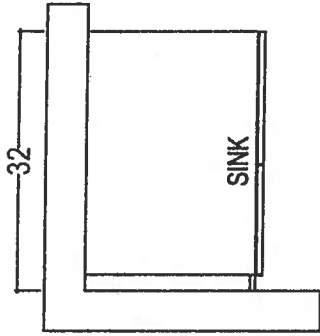

POWDER ROOM

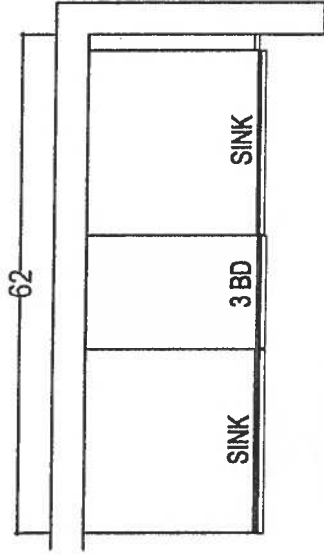

MASTER ENSUITE

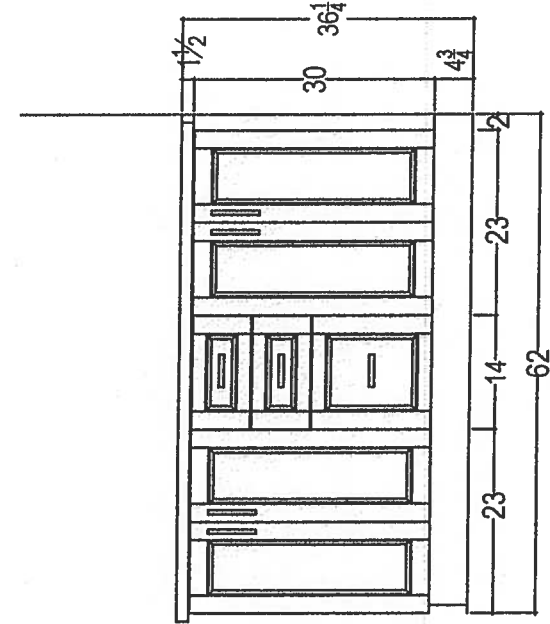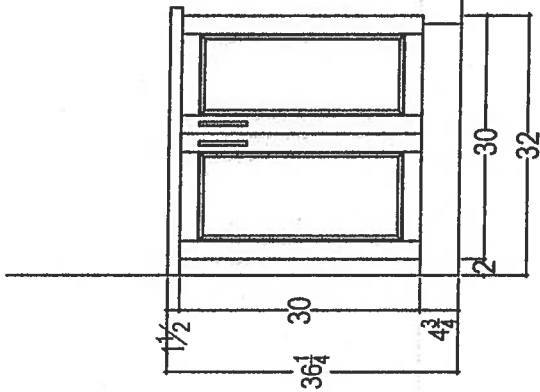


your kitchen, your taste.
80 SANTE DRIVE, VAUGHAN, ON L4K 3C4,
T: 416.746.1811 F: 905.761.5901

CLIENT: ROYAL PINE HOMES SITE: HAMPTON PLACE PHONE: — EMAIL: —	JOB NAME:	UNIT 708 HMP	ROOM:	VANITIES	DRAWN BY: SK	COMMENTS: PLEASE NOTE ALL DIMENSIONS ARE NOT FINAL AND ARE SUBJECT TO CHANGE UPON FINAL SITE MEASURE
	DOOR STYLE:	—	DOOR HANDLE:	—	SCALE: 1/2" = 1'-0"	
	FINISH:	—	DRW HANDLE:	—	DATE: APRIL 27, 2018	
	SPECIES:	—	TOP:	—	PAGE:	


9

Suite 708 - INX. Suite 708


- STD K TETHER LAYOUT
- STD APPLIANCE PKGS
- (x3) PUCK LIGHTS
- (x2) CAPPED PENOANT LIGHTS
- (x1) PLUG PENINSULA

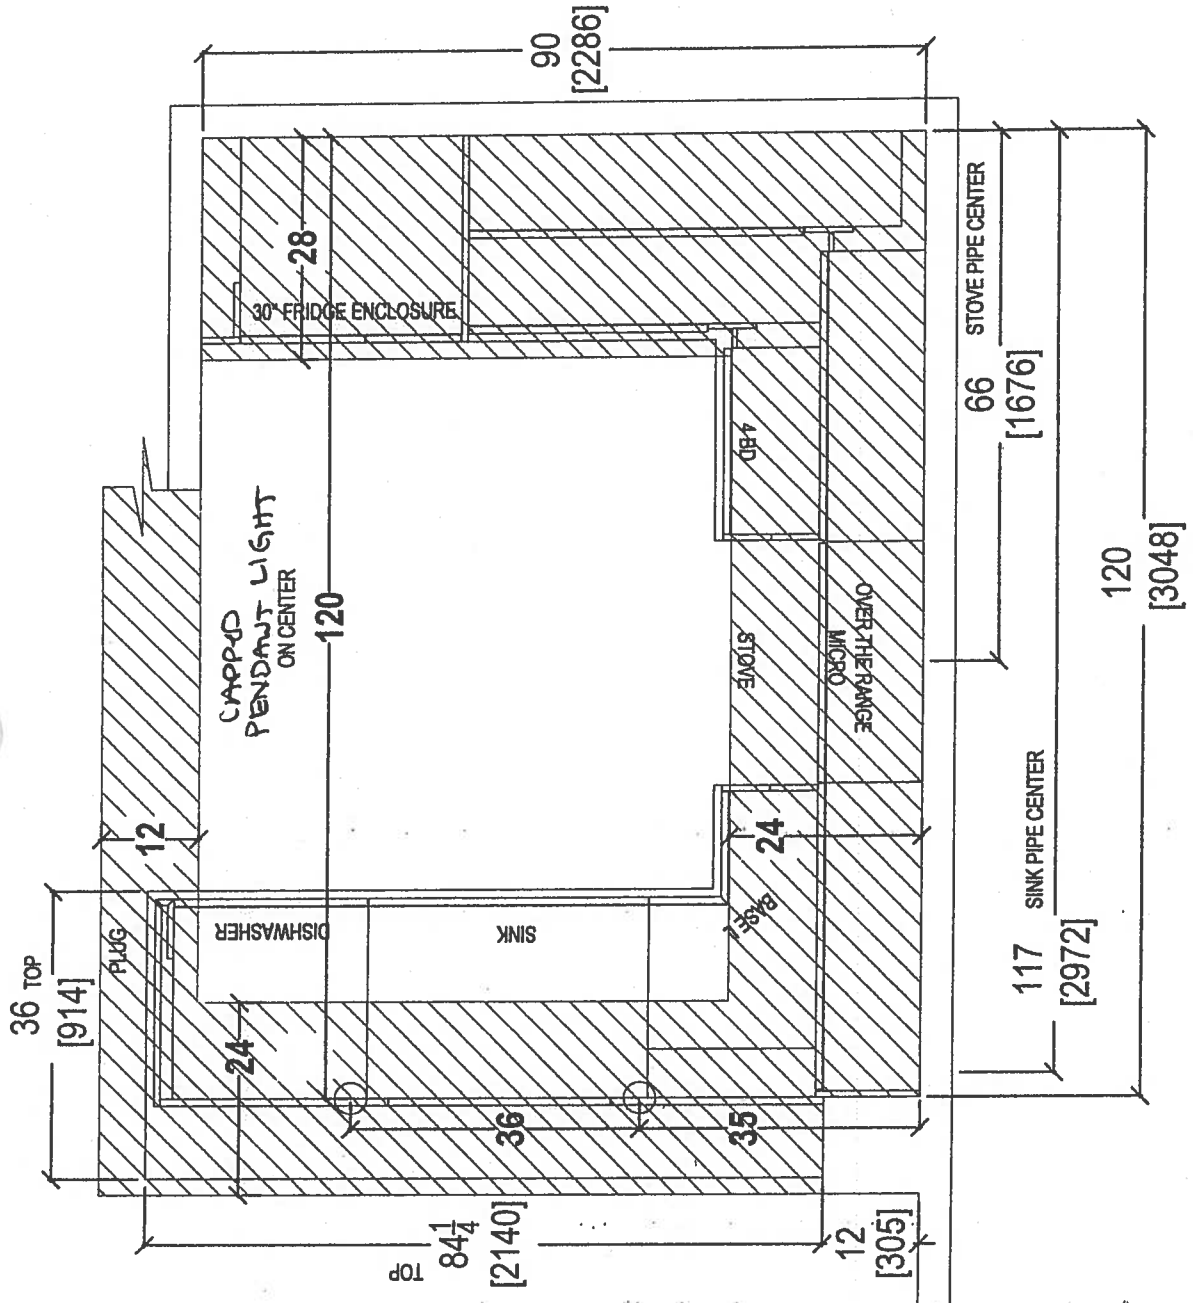

 <i>your kitchen, your taste.</i> 80 SANTE DRIVE, VAUGHAN, ON L4K 3C4, T: 416.746.1811 F: 905.781.5901	CLIENT: ROYAL PINE HOMES		JOB NAME: UNIT 708 HMP (STANDARD)	ROOM: KITCHEN	DRAWN BY: SK	COMMENTS: PLEASE NOTE ALL DIMENSIONS ARE NOT FINAL AND ARE SUBJECT TO CHANGE UPON FINAL SITE MEASURE
	SITE: HAMPTON PLACE	DOOR STYLE: —	DOOR HANDLE: —	SCALE: 1/2" = 1' - 0"		
	PHONE: ---	FINISH: —	DRW HANDLE: —	DATE: MAY 11, 2018		
	EMAIL: ---	SPECIES: ---	TOP: —	PAGE:		

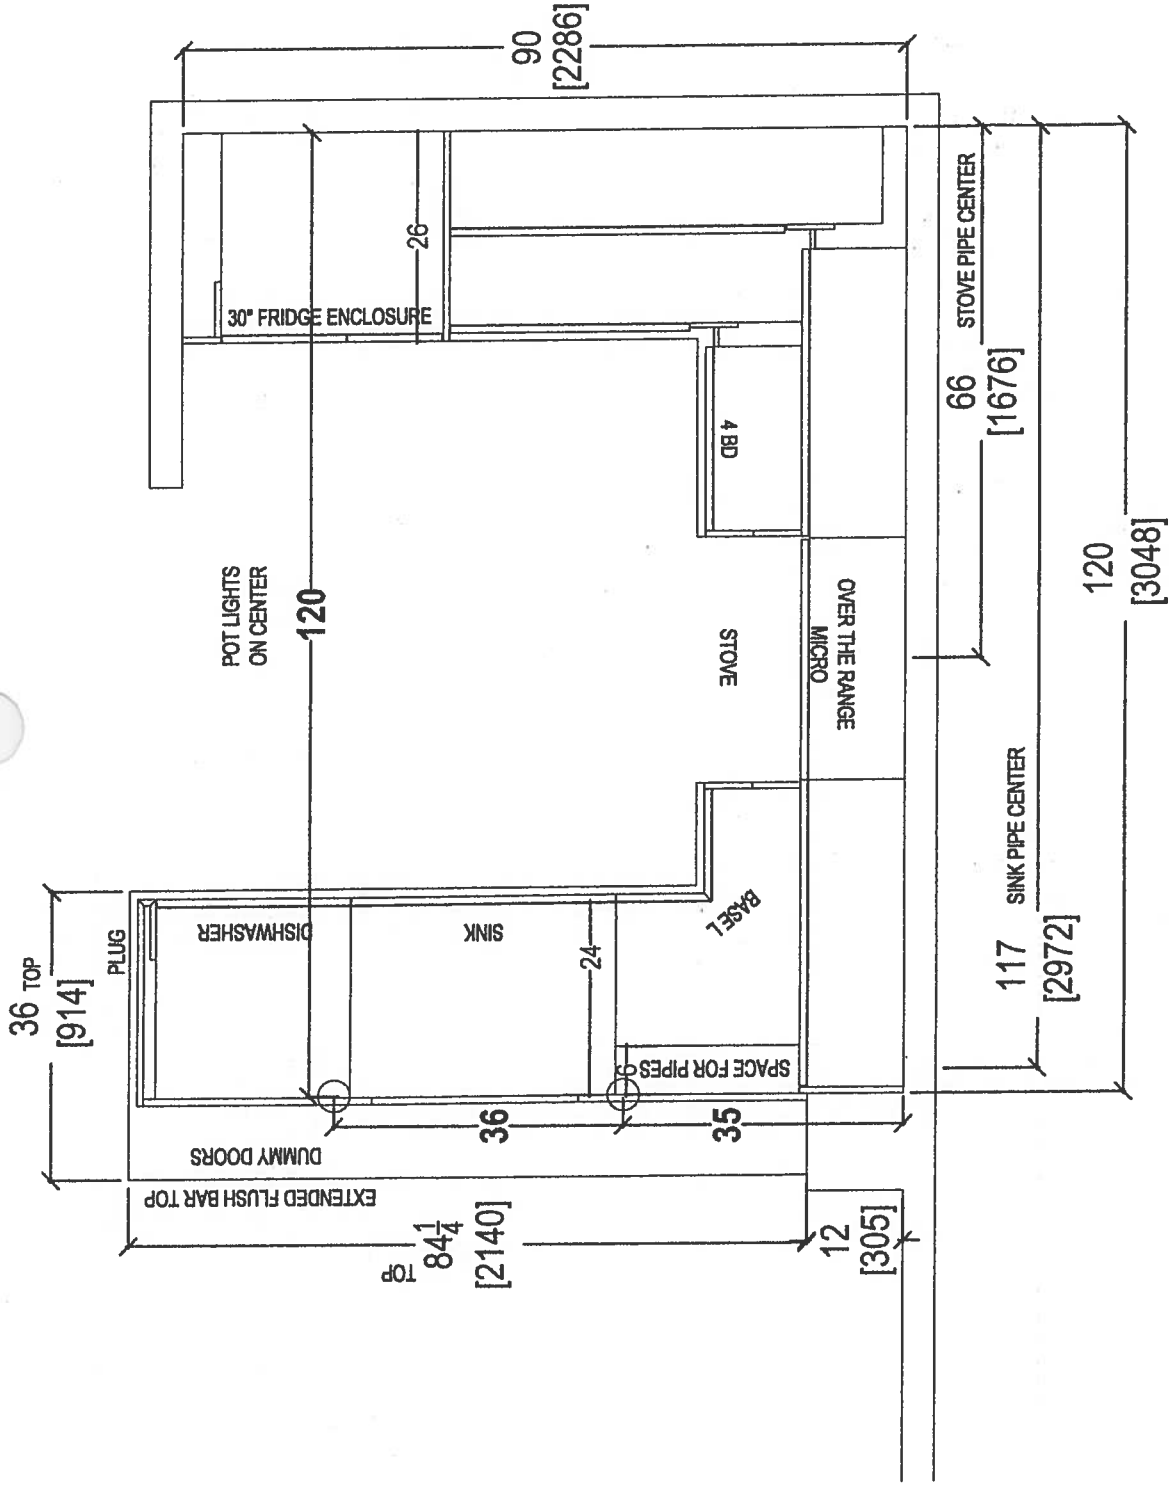


CLIENT: ROYAL PINE HOMES		JOB NAME: UNIT 708 HMP (STANDARD)		ROOM: KITCHEN	DRAWN BY: SK	COMMENTS: PLEASE NOTE ALL DIMENSIONS ARE NOT FINAL AND ARE SUBJECT TO CHANGE UPON FINAL SITE MEASURE
SITE: HAMPTON PLACE		DOOR STYLE: —		DOOR HANDLE: —	SCALE: 1/2" = 1' - 0"	
PHONE: —		FINISH: —		DRW HANDLE: —	DATE: MAY 11, 2018	
EMAIL: —		SPECIES: —		TOP: —	PAGE: —	

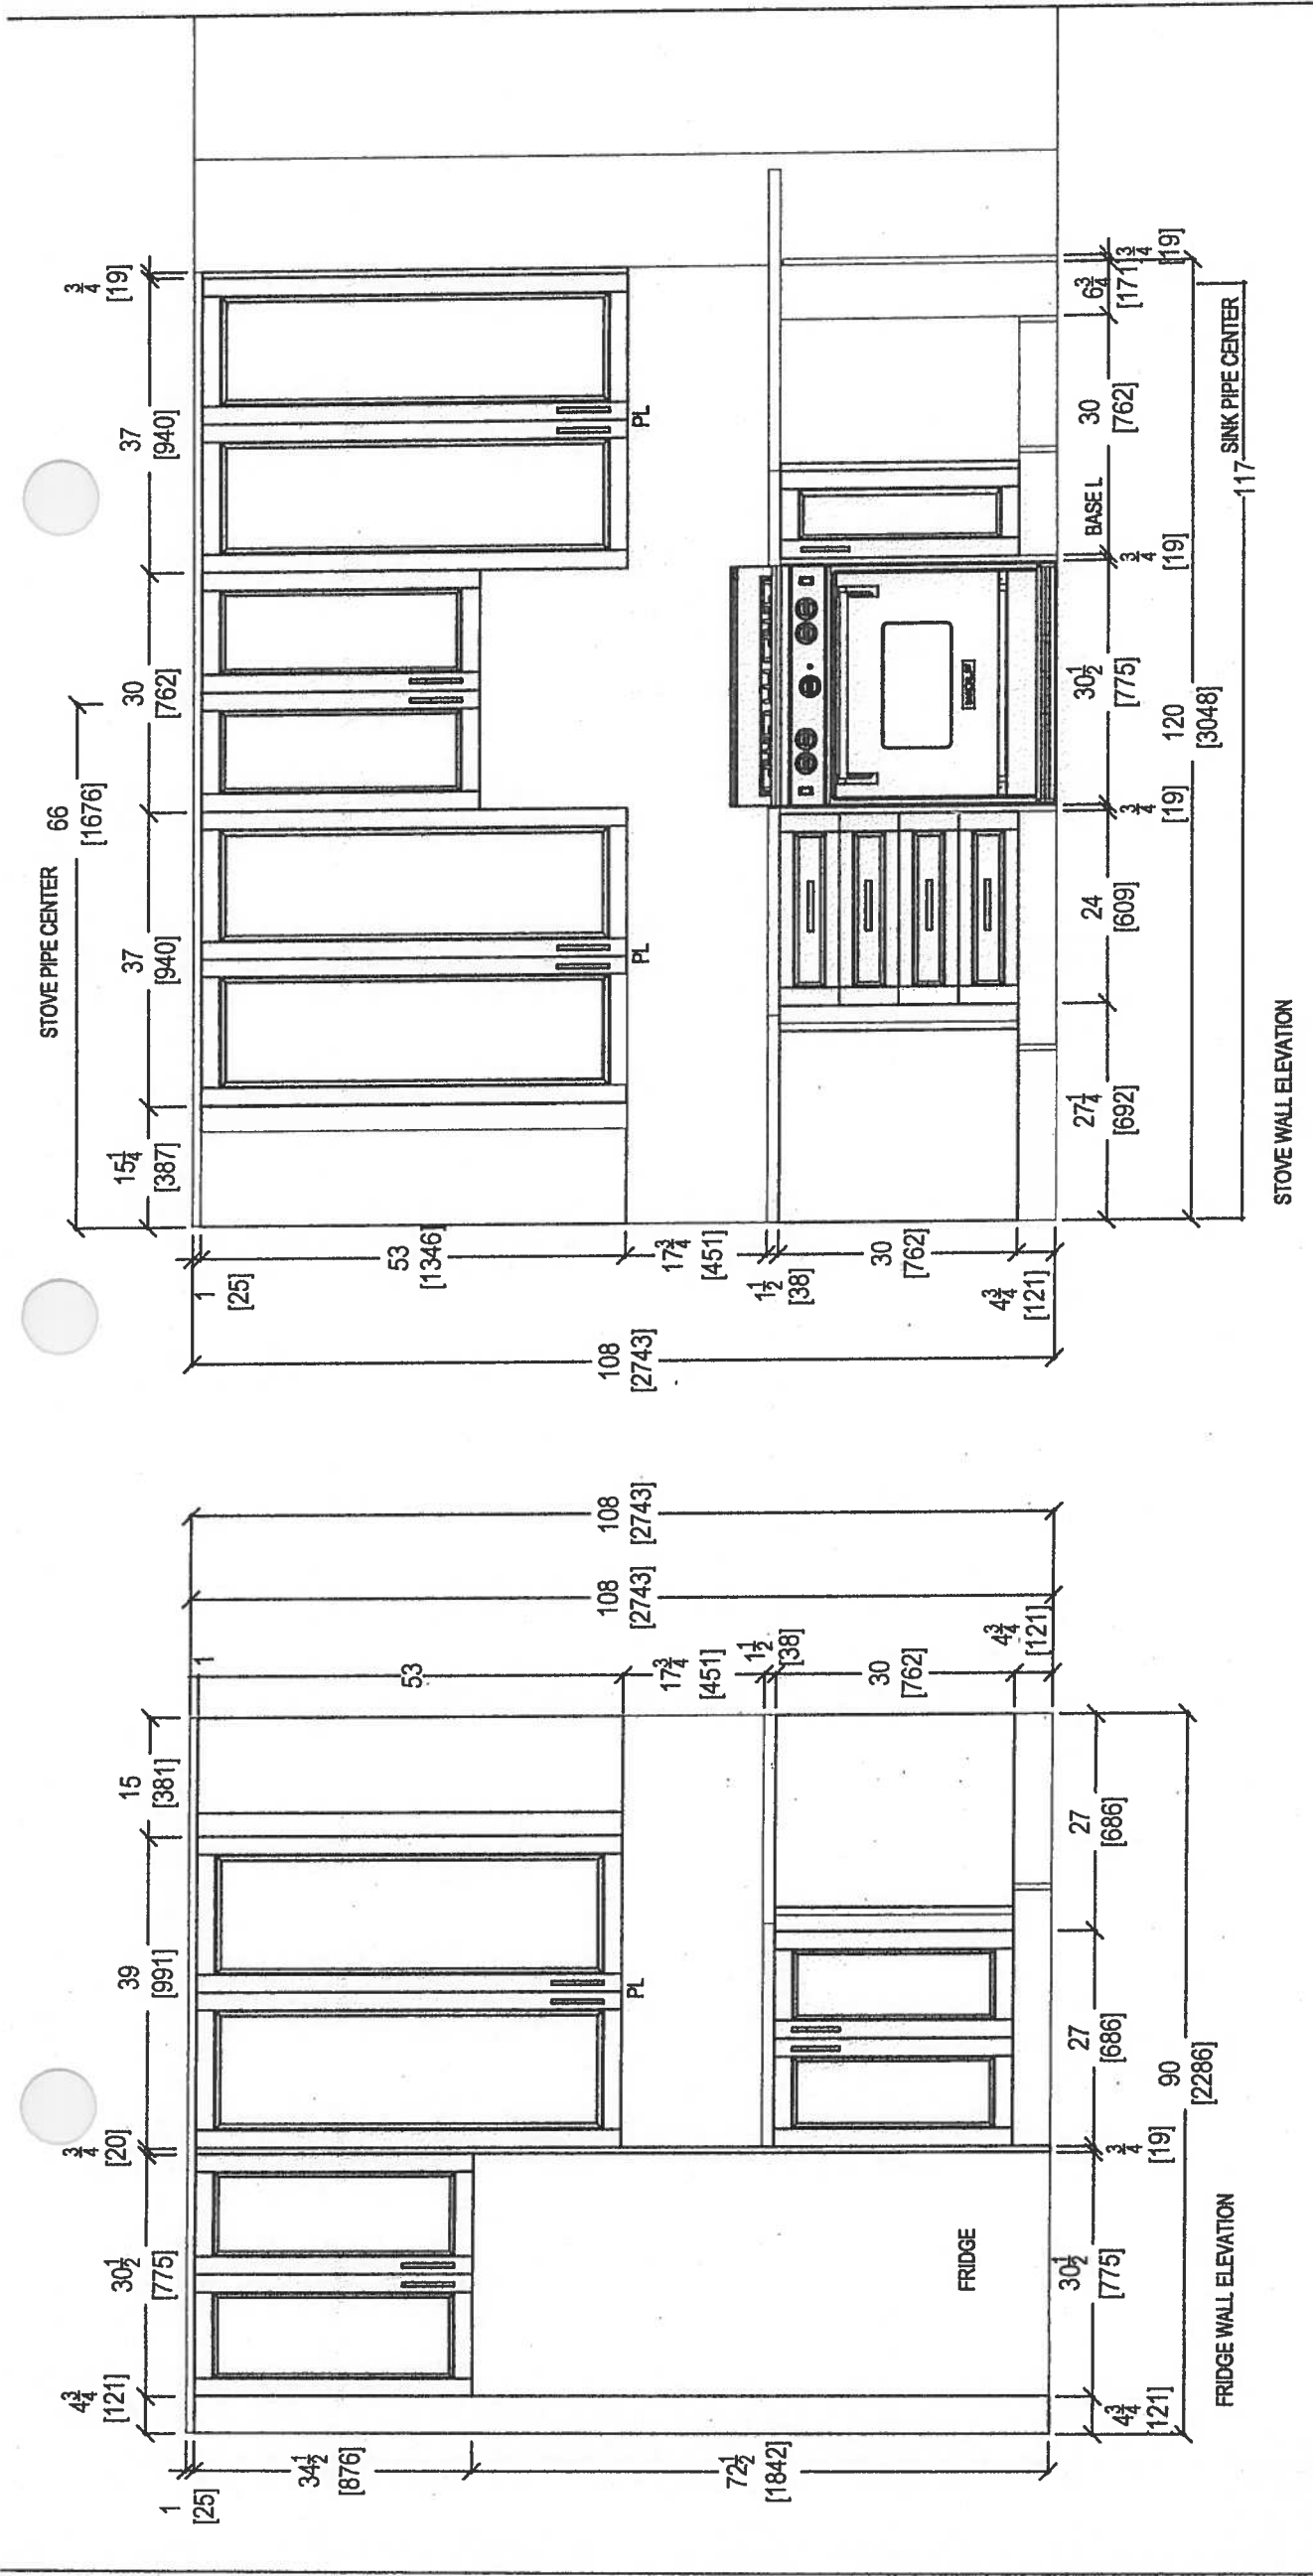


CLIENT: ROYAL PINE HOMES		JOB NAME: 708 HMP (STANDARD)	ROOM: KITCHEN	DRAWN BY: SK	COMMENTS: PLEASE NOTE ALL DIMENSIONS ARE NOT FINAL AND ARE SUBJECT TO CHANGE UPON FINAL SITE MEASURE
SITE: HAMPTON PLACE	DOOR STYLE: —	DOOR HANDLE: —	SCALE: 1/2" = 1' - 0"		
PHONE: —	FINISH: —	DRW HANDLE: —	DATE: MAY 11, 2018		
EMAIL: —	SPECIES: —	TOP: —	PAGE:		



80 SANTE DRIVE, VAUGHAN, ON L4K 3C4,
T: 416.748.1811 F: 905.761.5901

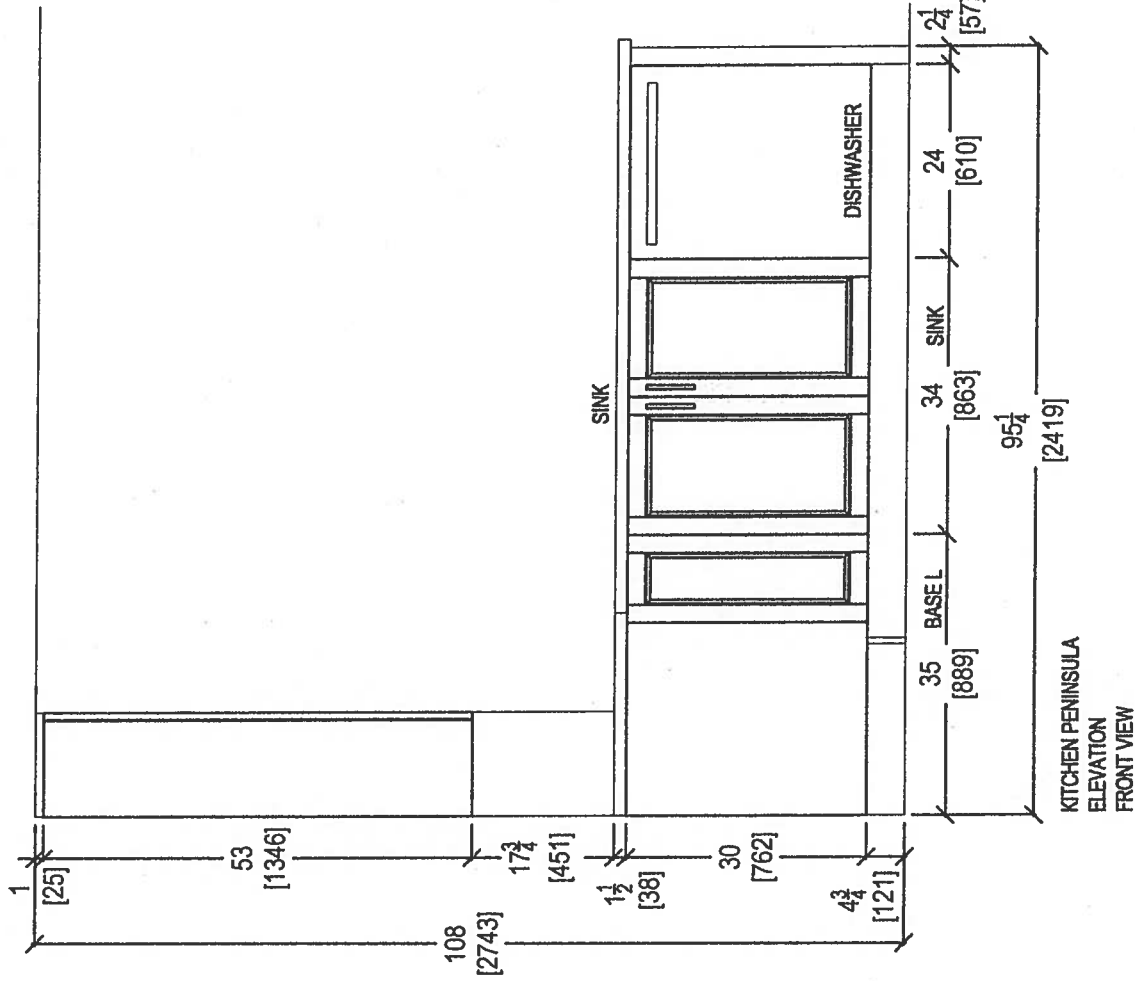





KITCHEN PENINSULA
ELEVATION
FRONT VIEW

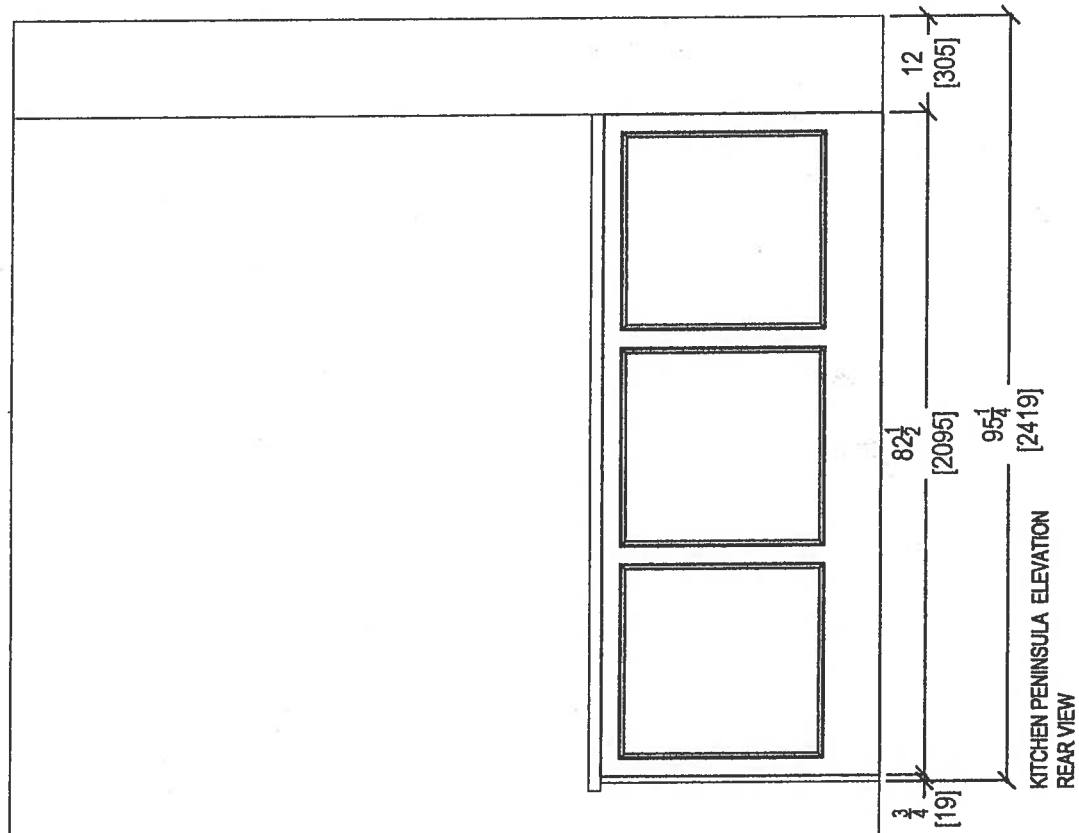

KITCHEN PENINSULA ELEVATION
REAR VIEW



CLIENT: ROYAL PINE HOMES SITE: HAMPTON PLACE PHONE: — EMAIL: —	JOB NAME: 708 HMP (STANDARD)		ROOM: KITCHEN	DRAWN BY: SK	COMMENTS: PLEASE NOTE ALL DIMENSIONS ARE NOT FINAL AND ARE SUBJECT TO CHANGE UPON FINAL SITE MEASURE
	DOOR STYLE: —		DOOR HANDLE: —	SCALE: 1/2" = 1' - 0"	
	FINISH: —		DRW HANDLE: —	DATE: MAY 11, 2018	
	SPECIES: —		TOP: —	PAGE:	

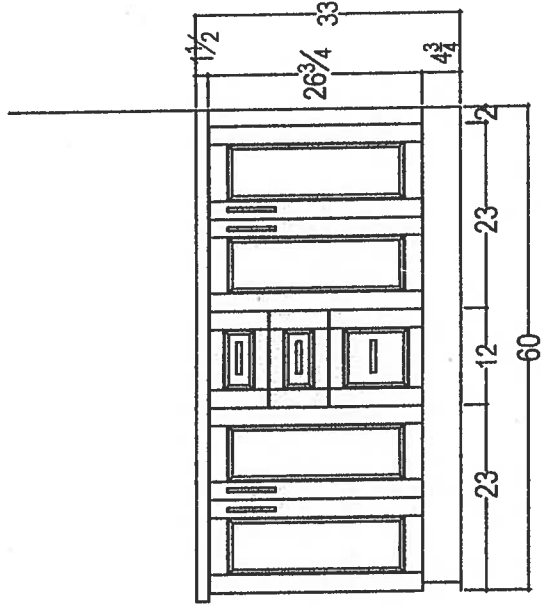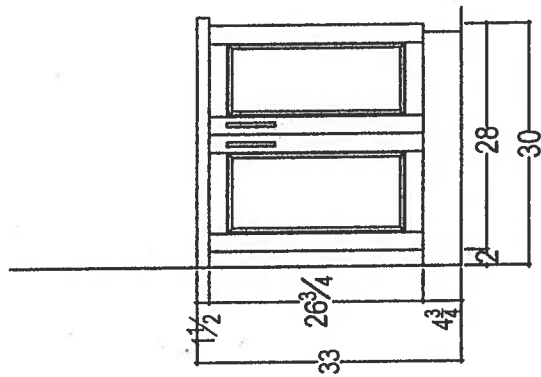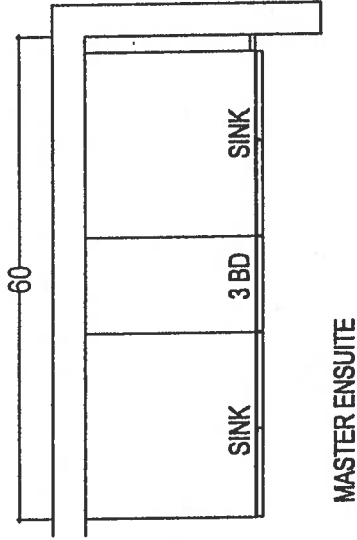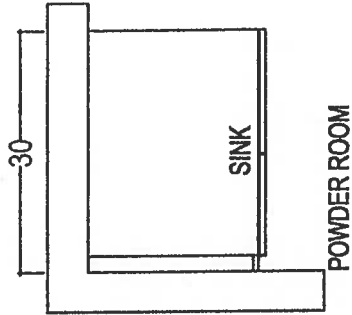

your kitchen. your taste.
80 SANTE DRIVE, VAUGHAN, ON L4K 3C4.
T: 416.746.1811 F: 905.761.5901

CLIENT: ROYAL PINE HOMES		JOB NAME: UNIT 708 HMP (STANDARD)	ROOM:	VANITIES	DRAWN BY: SK	COMMENTS: PLEASE NOTE ALL DIMENSIONS ARE NOT FINAL AND ARE SUBJECT TO CHANGE UPON FINAL SITE MEASURE
SITE: HAMPTON PLACE		DOOR STYLE: —	DOOR HANDLE: —		SCALE: 1/2" = 1' - 0"	
PHONE: —		FINISH: —	DRW HANDLE: —		DATE: MAY 10, 2018	
EMAIL: —		SPECIES: —	TOP: —		PAGE:	