

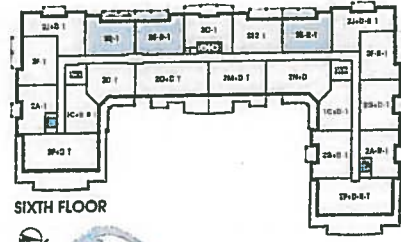


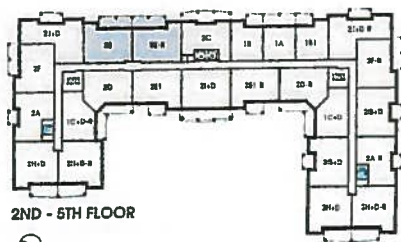

# Flanders

SUITE 717  
ORIGINAL LAYOUT

1,059 SQ FT *plus* 180 sq. ft. of balcony area

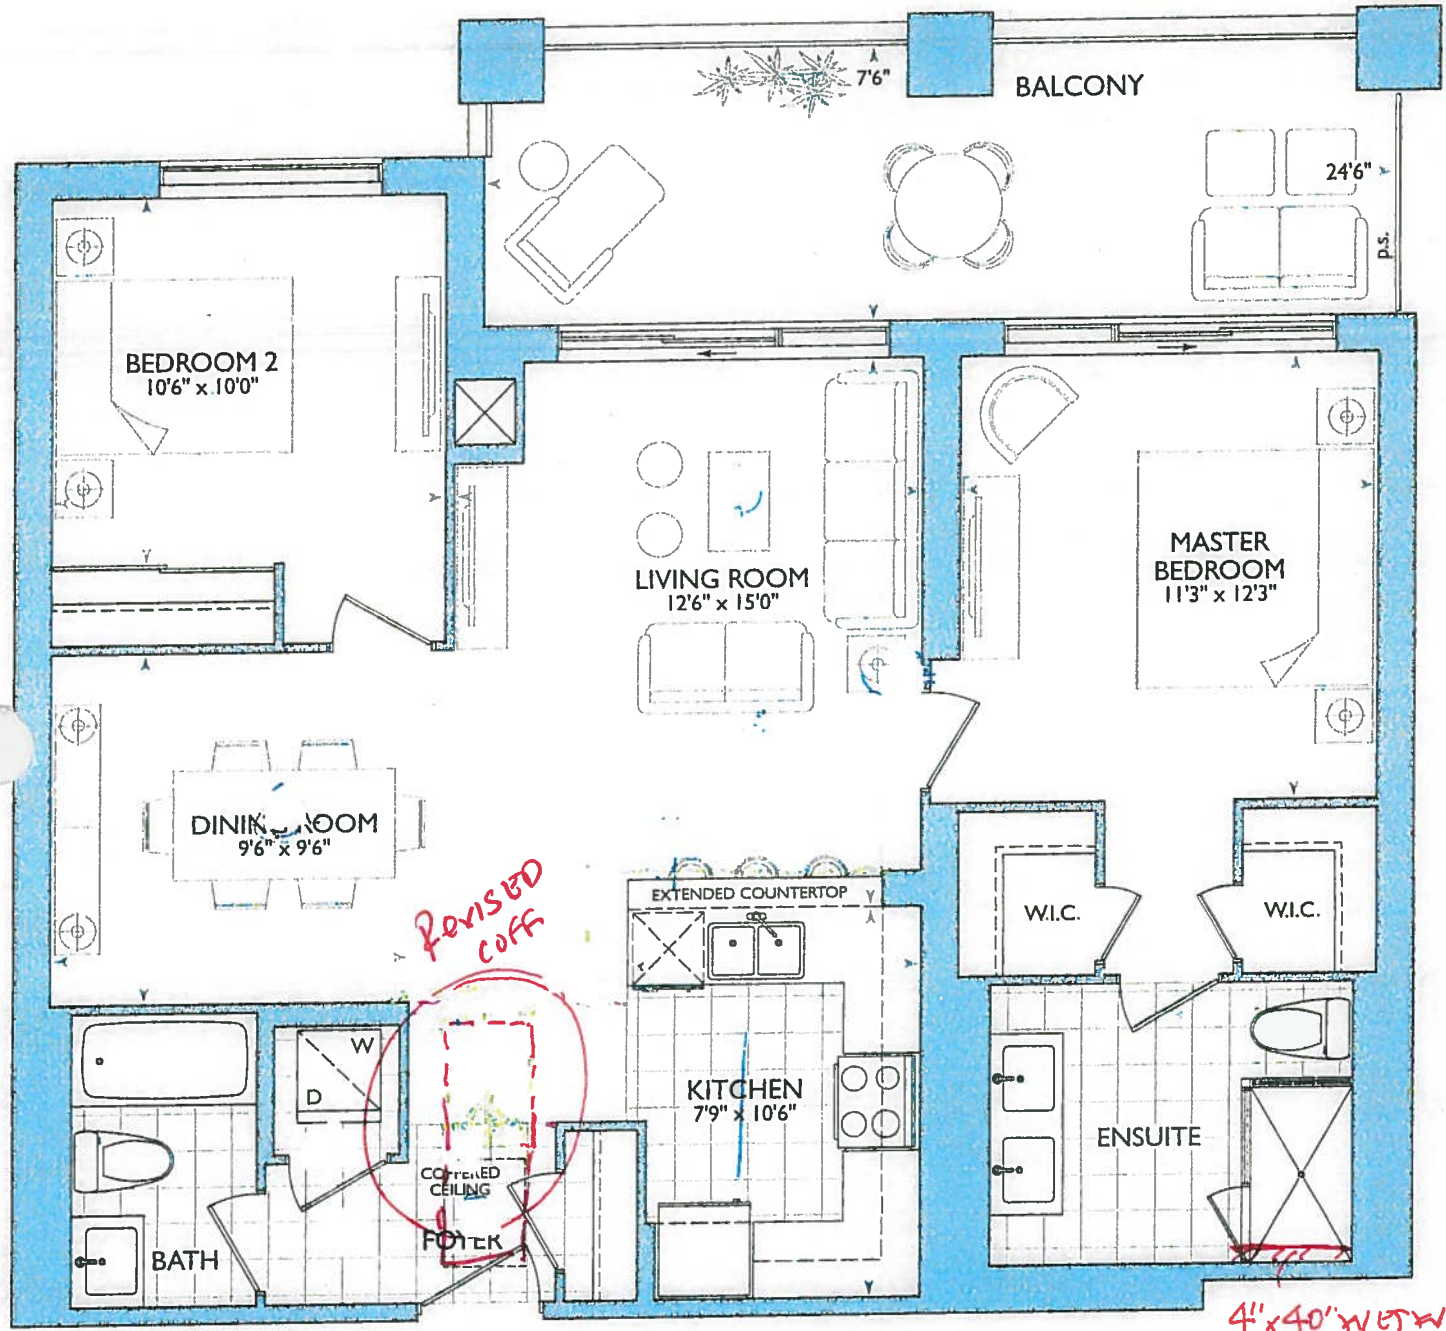

16

February 26, 2018

112 (LQ)

KITCHEN


- STD KIT. LAYOUT (extended uppers)
- UPGRADE APPLIANCE PKG.
- (x4) - PUCK LIGHTS
- (x1) - PLUS PENINSULA
- (x3) - POTS OVER PENINSULA (sep. switch)
- 63" stove PIPE CENTER
- 125" sink PIPE CENTER

\* ENSUITE ENLARGED  
4" Due to 4"x40" WET WALL FOR FAUCET  
MASTER BEDRM +  
W.I.C. measurements  
Revised


4"x40" WET WALL  
RECEIVED  
Feb 14, 2018

\* REUSED FOYER COFFERED CIE 6.  
AS PER THIS BROCHURE (Delete tile Foyer)

- Foyer + Kitchen: Install Standard Laminate throughout Foyer + Kitchen
- Install Vac Pod Unit at Foyer Closet and One (1) Additional Vac Rough In Inlet at Living Room
- DELETE ALL WASHROOM ACCESSORIES

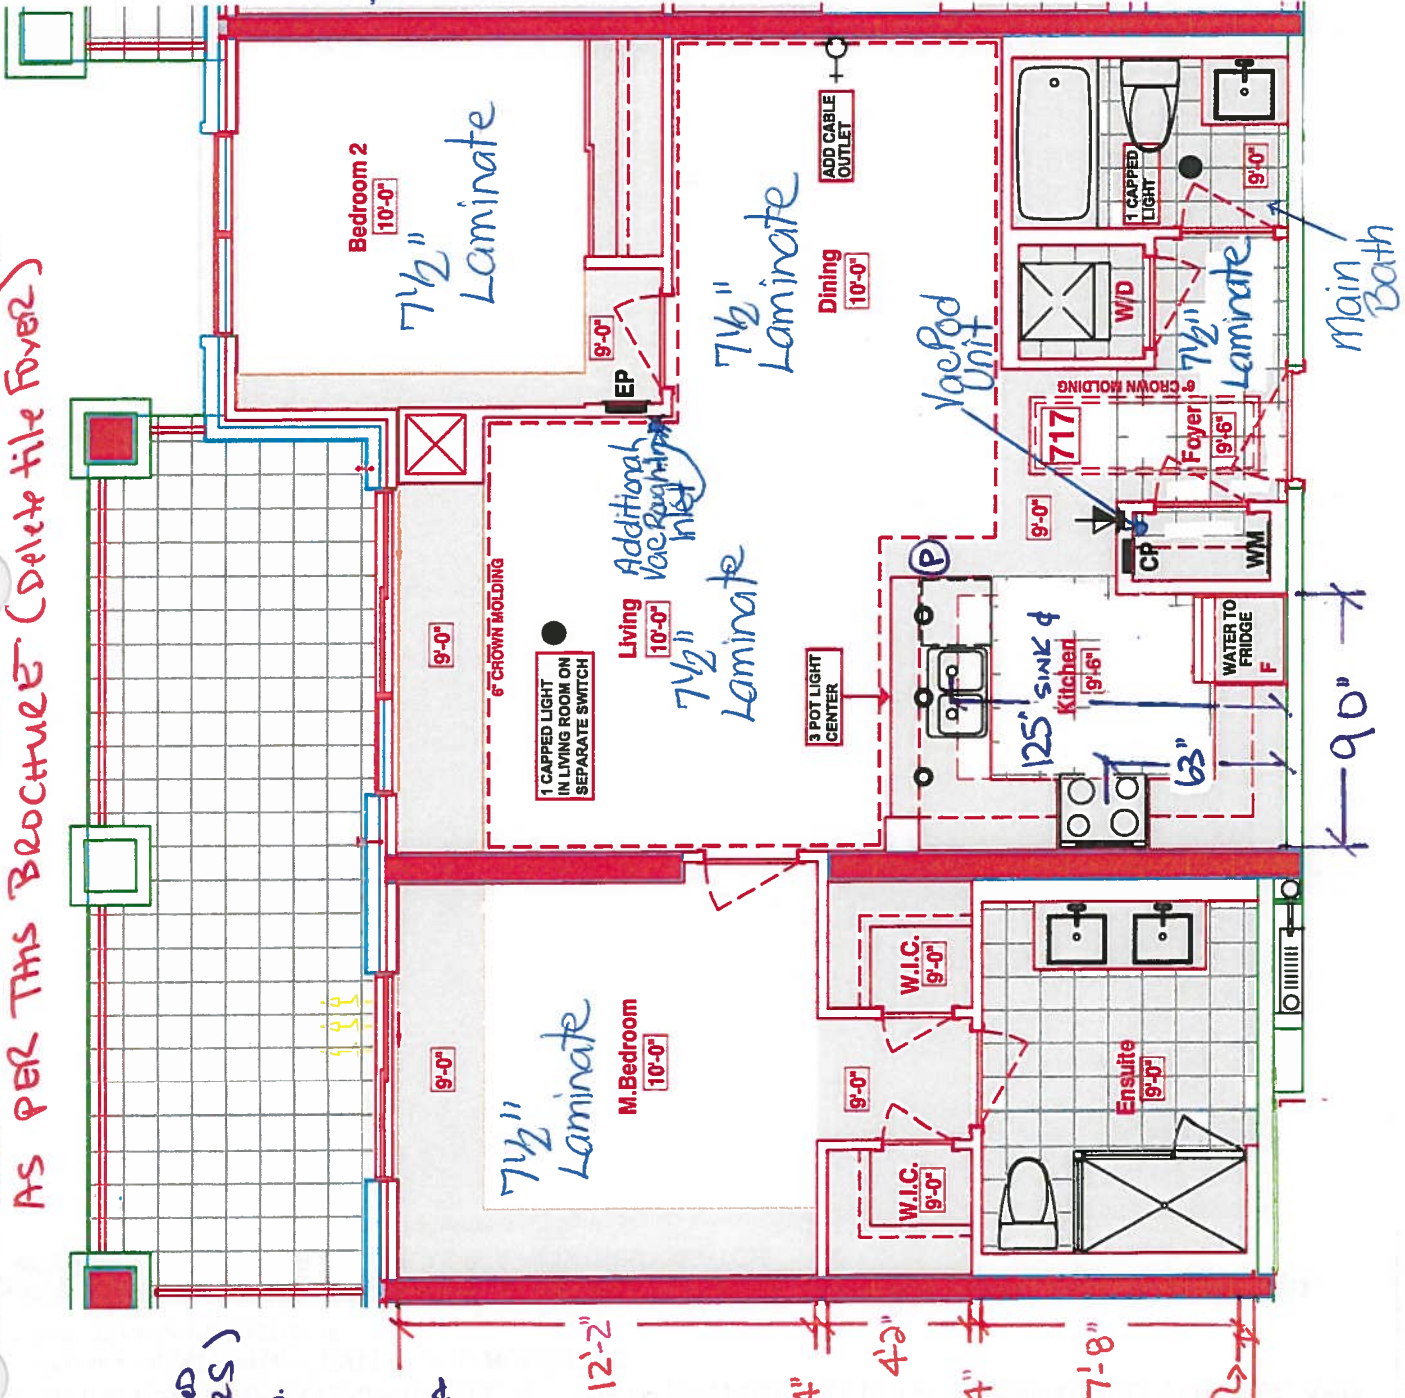

LOCATION OF KITCHEN LIGHTS REFER TO QTK. DWG.

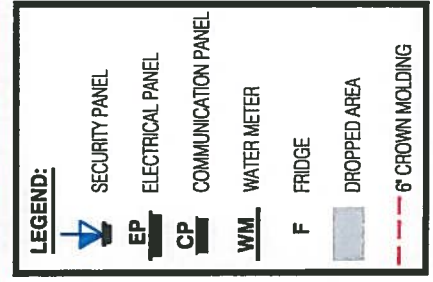



CONSTRUCTION SUMMARY

Hampton Place

PURCHASERS: ROCCO S. QUINTO and LIDIA QUINTO

TEL: RES.: 905-944-9414

| LOT NUMBER | PHASE | HOUSE TYPE   | CLOSING DATE |
|------------|-------|--------------|--------------|
| 717        | 1     | FLANDERS(2E) | 22-Nov-18    |

|          |                                                                                                                                                                                                                                 |
|----------|---------------------------------------------------------------------------------------------------------------------------------------------------------------------------------------------------------------------------------|
| Offer    | VENDOR AGREES TO SUPPLY AND INSTALL SMOOTH CEILINGS, AS PER PLAN, EXTENDED UPPER CABINETRY IN KITCHEN AS PER PLAN AND AS PER VENDORS SPECIFICATIONS, AND EXTENDED INTERIOR DOORS AS PER PLAN AND AS PER VENDORS SPECIFICATIONS. |
| Workshee | Note:                                                                                                                                                                                                                           |

|          |                                                  |
|----------|--------------------------------------------------|
| Offer    | PURCHASER TO SELECT LOCKER LOCATION ON 7TH FLOOR |
| Workshee | Note:                                            |

|         |                                                                                           |
|---------|-------------------------------------------------------------------------------------------|
| Offer   | INSTALL ADDITIONAL CEILING CAPPED OUTLET IN LIVING ROOM ON SEPARATE SWITCH AS PER SKETCH. |
| Upgrade | Note:                                                                                     |

|         |                                                                         |
|---------|-------------------------------------------------------------------------|
| Offer   | INSTALL ADDITIONAL CABLE OUTLET IN DINING ROOM SEE SKETCH FOR LOCATION. |
| Upgrade | Note:                                                                   |

|         |                                                      |
|---------|------------------------------------------------------|
| Offer   | DO NOT INSTALL CERAMIC ACCESSORIES IN ALL BATHROOMS. |
| Upgrade | Note:                                                |

|         |                                                                                                                                                                                                                                                                     |
|---------|---------------------------------------------------------------------------------------------------------------------------------------------------------------------------------------------------------------------------------------------------------------------|
| Offer   | INSTALL 3 POTLIGHTS OVER PENINSULA. ONE POTLIGHT IN THE MIDDLE BETWEEN EXTENDED WALL (BY EXTENDED COUNTERTOP) AND END OF COUNTERTOP BY FOYER. ONE POTLIGHT BETWEEN THE MIDDLE POTLIGHT AND THE EXTENDED WALL AND THE OTHER POTLIGHT BETWEEN THE MIDDLE POTLIGHT AND |
| Upgrade | END OF COUNTERTOP CENTERED IN BULKHEAD.                                                                                                                                                                                                                             |

|         |                       |
|---------|-----------------------|
| Offer   | WATER LINE FOR FRIDGE |
| Upgrade | Note:                 |

|         |                                                                                                                                    |
|---------|------------------------------------------------------------------------------------------------------------------------------------|
| Offer   | INSTALL ONE CAPPED CEILING OUTLET IN MAIN BATHROOM NOT ON SEPARATE SWITCH CENTERED BETWEEN WALL AND BATHTUB AS PER ATTACHED SKETCH |
| Upgrade | Note:                                                                                                                              |



SITE COPY

CONSTRUCTION SUMMARY

Hampton Place

PURCHASERS: ROCCO S. QUINTO and LIDIA QUINTO

TEL: RES.: 905-944-9414

| LOT NUMBER | PHASE | HOUSE TYPE   | CLOSING DATE |  |
|------------|-------|--------------|--------------|--|
| 717        | 1     | FLANDERS(2E) | 22-Nov-18    |  |

Date Added: 26-Feb-18      Invoice Number: 7127

1 - FOYER CLOSET - Install VAC-POD at Foyer Closet (Includes 30ft. air hose package)  
Include; ONE (1) ADDITIONAL VAC-ROUGH-IN INLET at living room. (See Sketch)  
Note:

1 - FOYER & KITCHEN - Install Standard Laminate Flooring throughout Foyer and Kitchen in lieu of builders standard porcelain tiles (See Sketch)  
Note:

1 - LAUNDRY ROOM - 2ND UPGRADE - PORCELAIN TILES - 13x13 HELLO SILVER - To be installed throughout laundry room floor (See Sketch)  
Note:

1 - KITCHEN & BATHROOMS - Purchaser has DECLINED All Upgrades offered during decor appointment at the decor centre for kitchen & bathroom cabinetry. Standard Kitchen Layout & Standard Bathroom Vanities to be installed as per standard plan. (See Sketch)  
Note:

1 - KITCHEN - Install Standard Granite Countertop - SERENATA - To be installed throughout kitchen, where applicable (does not include granite backsplash) (See Sketch)  
Note:

1 - DISCLAIMER - GRANITE COUNTERTOP;  
KITCHEN - Due to the many variables that can affect the pattern, colour and/or design and "pitting" of natural products, granite installed will not be identical to the samples displayed.  
Note: Every effort is made to provide granite countertops as close as possible but the vendor is not responsible for results which differ from the sample displayed. All countertop surfaces may have seams, and product pattern and shade can change in areas containing seams.

1 - DISCLAIMER - STONE COUNTERTOP;  
KITCHEN - Stone slabs vary in size & all seams are visible & the fabricator reserves the right to position the seams as necessary.  
Note:

1 - KITCHEN - Kitchen Sink - Install Standard Undermount Sink - BLANCO Horizon Plus U2 Undermount Sink (8") - Model # 401234  
Note:

1 - KITCHEN - Kitchen Faucet - Install Standard Faucet - DELTA Chrome Pull-Out Kitchen Faucet (Single Hole) - Model # 469LF - Chrome  
Note:

1 - KITCHEN - Kitchen Backsplash - Install Standard 3x6 SUBWAY WHITE Backsplash Tile in UPGRADE BRICK PATTERN - To be installed throughout kitchen, where applicable (Does not include behind the fridge or stove) (See Sketch)  
Note:

1 - APPLIANCE PACKAGE - Install Upgrade Appliance Package - UPGRADE PACKAGE #2 - To be installed throughout suite, where applicable (See Sketch)  
Note:

1 - CLARIFICATION;  
MAIN BATH & MASTER ENSUITE - Install Standard 3" Splash throughout Main Bath and Master Ensuite vanity countertop, where applicable (See Sketch)  
Note:

1 - DISCLAIMER - STONE COUNTERTOP;  
MAIN BATH & MASTER ENSUITE - Stone slabs vary in size & all seams are visible & the fabricator reserves the right to position the seams as necessary.  
Note:

1 - CLARIFICATION;  
MASTER ENSUITE - Purchaser accepts & acknowledges the standard frameless glass enclosure at master ensuite shower stall will NOT touch the ceiling and will receive a Standard Chrome Header. (See Sketch)  
Note:



SITE COPY

CONSTRUCTION SUMMARY

Hampton Place

PURCHASERS: ROCCO S. QUINTO and LIDIA QUINTO

TEL: RES.: 905-944-9414

| LOT NUMBER | PHASE | HOUSE TYPE   | CLOSING DATE |
|------------|-------|--------------|--------------|
| 717        | 1     | FLANDERS(2E) | 22-Nov-18    |

Date Added: 26-Feb-18 Invoice Number: 7127

1 - CLARIFICATION;  
N BATH & MASTER ENSUITE - Install Standard Plumbing Fixtures throughout Main Bath and Master Ensuite where applicable (See Sketch)  
:

1 - PURCHASER HAS ATTENDED A COLOR APPOINTMENT AT THE DECOR CENTRE AND HAS DECLINED ANY ADDITIONAL UPGRADES. Purchaser accepts and acknowledges that there will be no further changes/additions/deletions to be made upon signing on February 26,2018  
Note:

1 - PURCHASER AWARE AND ACCEPTS THAT ANY CHANGES MADE TO UPGRADES AFTER SIGNING THIS PURCHASERS EXTRA FORM ARE SUBJECT TO A MINIMUM ADMINISTRATION FEE OF \$1,000 PLUS A 10% HOLDBACK FEE.  
Note:

This Document is Extremely Time Sensitive - Printed 10 May 18 at 16:05



**\* INTERIOR COLOUR SCHEME \***

Decor Consultant

ROCCO S. QUINTO &amp; LIDIA QUINTO

Model Type

FLANDERS(2E)

Telephone Res. / Bus

(905) 944-9414 /

## Project

Hampton Place

Closing Date

22/11/2018

Unit

717

Page 1 of 3

## MASTER ENSUITE

## MAIN BATHROOM

**POWDER ROOM**

KITCHEN / DINETTE

## FOYER

## LAUNDRY

LIVING ROOM

## DINING ROOM

DEN

## MASTER BEDROOM

## BEDROOM 2

### BEDROOM 3

Page 1 of 3

Consultant:  Melissa Di Marino

**Consultant:** [

Melissa Di Marino

Purchaser:

**ROCCO S. QUINTO**

Purchaser: \_\_\_\_\_

LIDIA QUINTO

Vendor:

Hampton Place

**Lot: 717 Project: Hampton Place Model: FLANDERS(2E)**

Printed Feb 26, 2018 12:14 pm



\* INTERIOR CLOUR SCHEME \*

|                                                     |                                              |                                   |                                                 |                                 |                                   |                    |
|-----------------------------------------------------|----------------------------------------------|-----------------------------------|-------------------------------------------------|---------------------------------|-----------------------------------|--------------------|
| <b>Purchasers</b><br>ROCCO S. QUINTO & LIDIA QUINTO | <b>Decor Consultant</b><br>Melissa Di Marino | <b>Model Type</b><br>FLANDERS(2E) | <b>Telephone Res. / Bus</b><br>(905) 944-9414 / | <b>Project</b><br>Hampton Place | <b>Closing Date</b><br>22/11/2018 | <b>Unit</b><br>717 |
|-----------------------------------------------------|----------------------------------------------|-----------------------------------|-------------------------------------------------|---------------------------------|-----------------------------------|--------------------|

Page 2 of 3

CABINETRY, VANITIES AND COUNTERTOPS

|                   | Style                                                                             | Countertop                                                  | Counter Edge                                       | Handle / Knob |
|-------------------|-----------------------------------------------------------------------------------|-------------------------------------------------------------|----------------------------------------------------|---------------|
| MAIN BATHROOM     | <input checked="" type="checkbox"/> CATEGORY 1 - FIBERBOARD - WHITE QT 1203 (STD) | <input checked="" type="checkbox"/> ASPEN TERRA WHITE (STD) | <input checked="" type="checkbox"/> A " EDGE (STD) | 3487-128      |
| MASTER ENSUITE    | <input checked="" type="checkbox"/> CATEGORY 2 - MAPLE - CHESTNUT QT 2503 (STD)   | <input checked="" type="checkbox"/> ASPEN TERRA WHITE (STD) | <input checked="" type="checkbox"/> A " EDGE (STD) | 3487-128      |
| POWDER ROOM       | <input type="checkbox"/> N/A                                                      | <input type="checkbox"/> N/A                                | <input type="checkbox"/> N/A                       | N/A           |
| KITCHEN / DINETTE | <input checked="" type="checkbox"/> CATEGORY 1 - FIBERBOARD - WHITE QT 1203 (STD) | <input checked="" type="checkbox"/> SERANATA GRANITE (STD)  | <input checked="" type="checkbox"/> A " EDGE (STD) | 3487-128      |
| LAUNDRY ROOM      | <input type="checkbox"/> N/A                                                      | <input type="checkbox"/> N/A                                | <input type="checkbox"/> N/A                       | N/A           |
|                   | <input type="checkbox"/>                                                          | <input type="checkbox"/>                                    | <input type="checkbox"/>                           |               |
|                   | <input type="checkbox"/>                                                          | <input type="checkbox"/>                                    | <input type="checkbox"/>                           |               |

APPLIANCE PACKAGE  
upgrade  
Package #2  
Std 31in Opening

PLUMBING FIXTURES

|                |                                              |
|----------------|----------------------------------------------|
| KITCHEN        | <input checked="" type="checkbox"/> STANDARD |
| Sink Model     | <input checked="" type="checkbox"/> STANDARD |
| Sink Faucet    | <input checked="" type="checkbox"/>          |
| TOILETS        | <input checked="" type="checkbox"/> STANDARD |
| Master Ensuite | <input checked="" type="checkbox"/> STANDARD |
| Main Bathroom  | <input checked="" type="checkbox"/> STANDARD |
| Powder Room    | <input type="checkbox"/> N/A                 |
| VANITY FAUCETS | <input checked="" type="checkbox"/> STANDARD |
| Master Ensuite | <input checked="" type="checkbox"/> STANDARD |
| Main Bathroom  | <input checked="" type="checkbox"/> STANDARD |
| Powder Room    | <input type="checkbox"/> N/A                 |

VANITY SINKS

|                |                                              |
|----------------|----------------------------------------------|
| Master Ensuite | <input checked="" type="checkbox"/> STANDARD |
| Main Bathroom  | <input checked="" type="checkbox"/> STANDARD |
| Powder Room    | <input type="checkbox"/> N/A                 |

SHOWER STALL / TUBS

|                             |                                              |
|-----------------------------|----------------------------------------------|
| Master Ensuite Shower Stall | <input checked="" type="checkbox"/> STANDARD |
| Master Ensuite Tub          | <input type="checkbox"/> N/A                 |
| Main Bathroom Tub           | <input checked="" type="checkbox"/> STANDARD |

|                |                            |          |
|----------------|----------------------------|----------|
| Trim           | Baseboard & Casing         | STANDARD |
| Interior Doors | STANDARD - CARRARA, SMOOTH |          |

|             |          |
|-------------|----------|
| Levers      | STANDARD |
| Door Height | STANDARD |

Cornice Moulding / Medallion

|                |                                                         |
|----------------|---------------------------------------------------------|
| Foyer          | <input checked="" type="checkbox"/> STANDARD - #CTR-611 |
| Living Room    | <input checked="" type="checkbox"/> STANDARD - #CTR-611 |
| Dining Room    | <input checked="" type="checkbox"/> STANDARD - #CTR-611 |
| Den            | <input type="checkbox"/> N/A                            |
| Master Bedroom | <input type="checkbox"/> NONE                           |
| Bedroom 2      | <input type="checkbox"/> N/A                            |
| Bedroom 3      | <input type="checkbox"/> N/A                            |

Fireplace

|                   |     |
|-------------------|-----|
| Fireplace         | N/A |
| Location Flooring | N/A |
| Style             | N/A |
| Finish            | N/A |
| Marble            | N/A |
| Hearth            | N/A |

Paint Throughout


|       |                        |
|-------|------------------------|
| Walls | STANDARD - BIRCH WHITE |
| Trim  | STANDARD - WHITE       |

MISC. INSTALLATIONS

|                                                 |                                                               |
|-------------------------------------------------|---------------------------------------------------------------|
| Ceramic Accessories<br>(installed by Vendor)    | <input checked="" type="radio"/> Yes <input type="radio"/> No |
| Bathroom Mirrors<br>(installed by Vendor)       | <input checked="" type="radio"/> Yes <input type="radio"/> No |
| Wire Shelving - Closet<br>(installed by Vendor) | <input checked="" type="radio"/> Yes <input type="radio"/> No |

Page 2 of 3

Decor Consultant: Melissa Di Marino  
Purchaser: Rocco Quinto  
LIDIA QUINTO

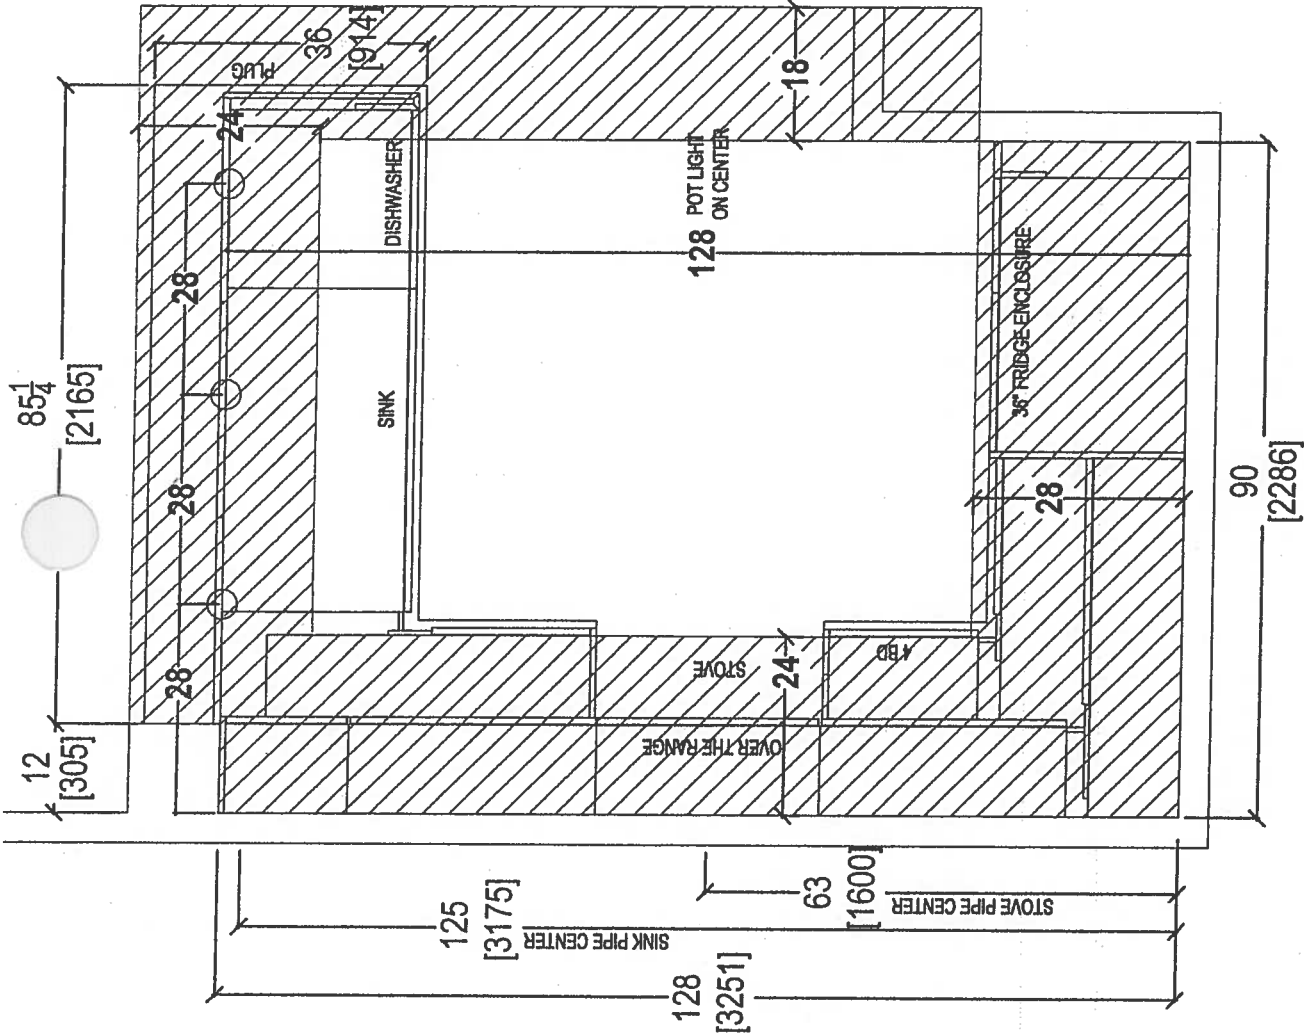

- SKD KITCHEN LAYOUT
- UPG #2- APPLIANCE PKG.
- (x4) - PUCK LIGHTS
- (x1) = PLUG PENINSULA
- (x3) = POTS OVER PENINSULA



80 SANTE DRIVE, VAUGHAN, ON L4K 3C4,  
T: 416.748.1811 F: 905.761.5901

CLIENT: ROYAL PINE HOMES  
SITE: HAMPTON PLACE  
PHONE: —  
EMAIL: —

JOB NAME: UNIT 717 HMP  
DOOR STYLE: —  
FINISH: —  
SPECIES: —


ROOM: KITCHEN FLOOR PLAN  
DOOR HANDLE: —  
DRW HANDLE: —  
TOP: —

DRAWN BY: SK  
SCALE: 1/2" = 1' - 0"  
DATE: APRIL 28, 2018  
PAGE:

COMMENTS:

PLEASE NOTE ALL DIMENSIONS  
ARE NOT FINAL AND ARE  
SUBJECT TO CHANGE UPON  
FINAL SITE MEASURE


9

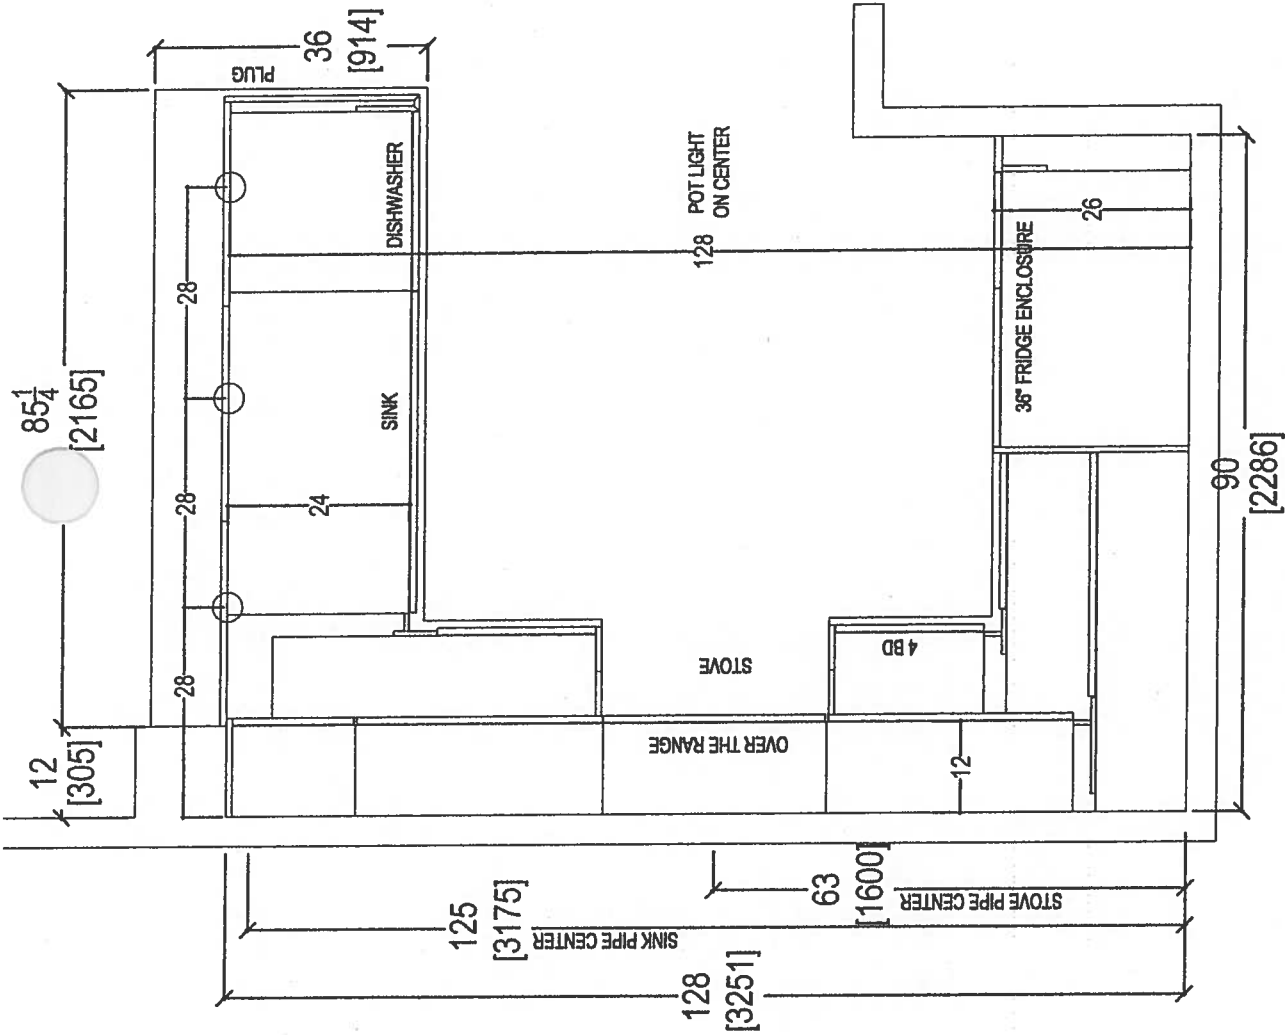

80 SANTE DRIVE, VAUGHAN, ON L4K 3C4,  
T: 416.746.1611 F: 905.761.5601

|                          |               |                        |                          |              |                                                                                                                      |
|--------------------------|---------------|------------------------|--------------------------|--------------|----------------------------------------------------------------------------------------------------------------------|
| CLIENT: ROYAL PINE HOMES |               | JOB NAME: UNIT 717 HMP | ROOM: KITCHEN FLOOR PLAN | DRAWN BY: SK | COMMENTS:<br><br>PLEASE NOTE ALL DIMENSIONS<br>ARE NOT FINAL AND ARE<br>SUBJECT TO CHANGE UPON<br>FINAL SITE MEASURE |
| SITE: HAMPTON PLACE      | DOOR STYLE: — | DOOR HANDLE: —         | SCALE: 1/2" = 1'-0"      |              |                                                                                                                      |
| PHONE: —                 | FINISH: —     | DRW HANDLE: —          | DATE: APRIL 28, 2018     |              |                                                                                                                      |
| EMAIL: —                 | SPECIES: —    | TOP: —                 | PAGE:                    |              |                                                                                                                      |


6

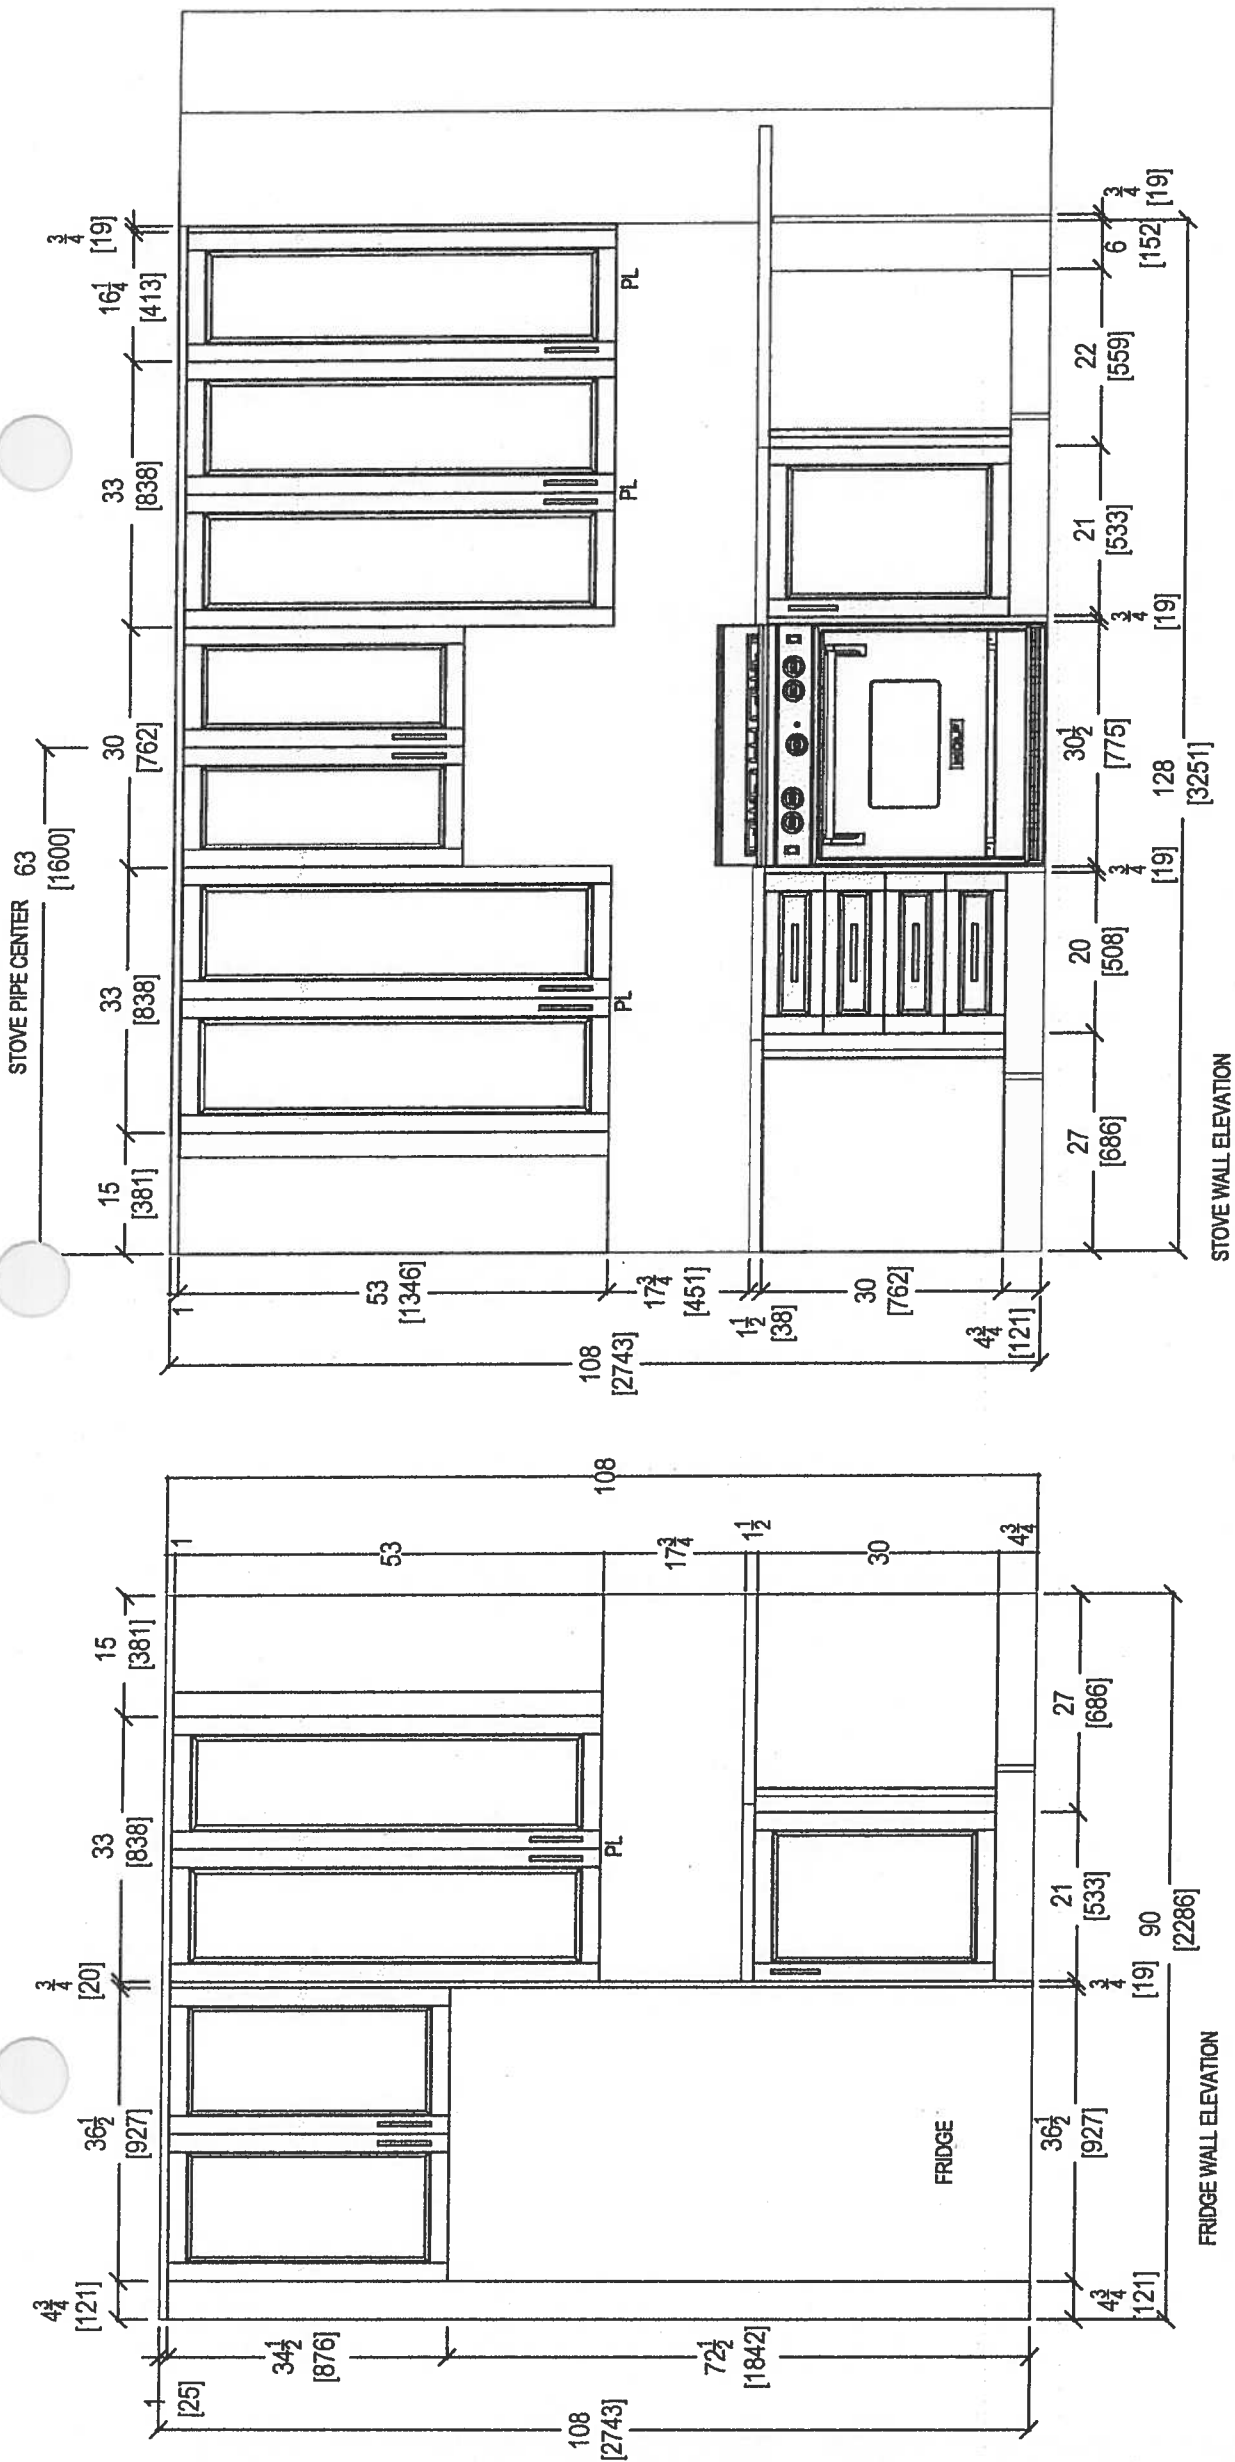

your kitchen, your taste.  
80 SANTE DRIVE, VAUGHAN, ON L4K 3C4,  
T: 416.748.1811 F: 905.761.5901

|                                                                         |                        |                |                       |                                                                                                                      |
|-------------------------------------------------------------------------|------------------------|----------------|-----------------------|----------------------------------------------------------------------------------------------------------------------|
| CLIENT: ROYAL PINE HOMES<br>SITE: HAMPTON PLACE<br>PHONE: —<br>EMAIL: — | JOB NAME: UNIT 717 HMP | ROOM: KITCHEN  | DRAWN BY: SK          | COMMENTS:<br><br>PLEASE NOTE ALL DIMENSIONS<br>ARE NOT FINAL AND ARE<br>SUBJECT TO CHANGE UPON<br>FINAL SITE MEASURE |
|                                                                         | DOOR STYLE: —          | DOOR HANDLE: — | SCALE: 1/2" = 1' - 0" |                                                                                                                      |
|                                                                         | FINISH: —              | DRW HANDLE: —  | DATE: APRIL 28, 2018  |                                                                                                                      |
|                                                                         | SPECIES: —             | TOP: —         | PAGE:                 |                                                                                                                      |

6



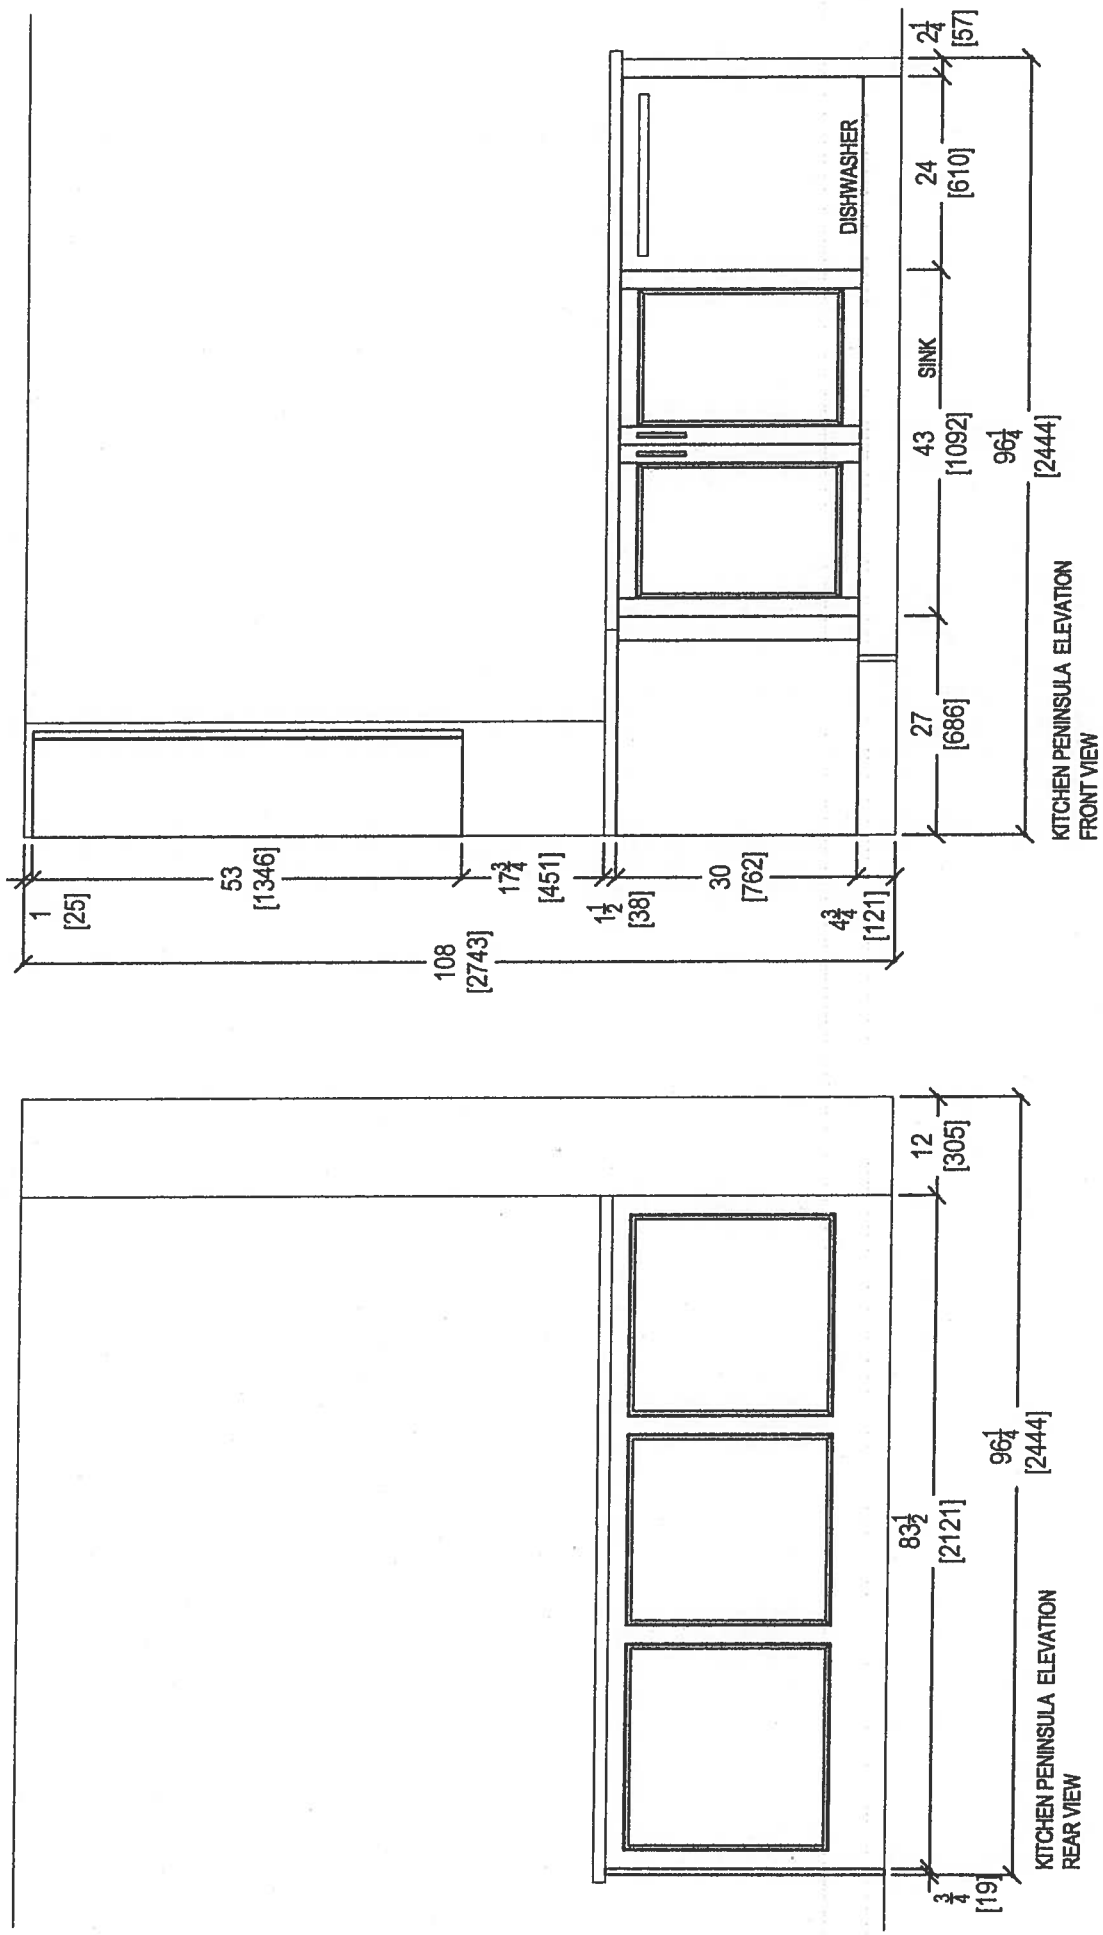


|                          |               |                        |                       |              |                                                                                                                      |
|--------------------------|---------------|------------------------|-----------------------|--------------|----------------------------------------------------------------------------------------------------------------------|
| CLIENT: ROYAL PINE HOMES |               | JOB NAME: UNIT 717 HMP | ROOM: KITCHEN         | DRAWN BY: SK | COMMENTS:<br><br>PLEASE NOTE ALL DIMENSIONS<br>ARE NOT FINAL AND ARE<br>SUBJECT TO CHANGE UPON<br>FINAL SITE MEASURE |
| SITE: HAMPTON PLACE      | DOOR STYLE: — | DOOR HANDLE: —         | SCALE: 1/2" = 1' - 0" |              |                                                                                                                      |
| PHONE: —                 | FINISH: —     | DRW HANDLE: —          | DATE: APRIL 28, 2018  |              |                                                                                                                      |
| EMAIL: —                 | SPECIES: —    | TOP: —                 | PAGE:                 |              |                                                                                                                      |



80 SANTE DRIVE, VAUGHAN, ON L4K 3C4,  
T: 416.746.1811 F: 905.781.5901

9

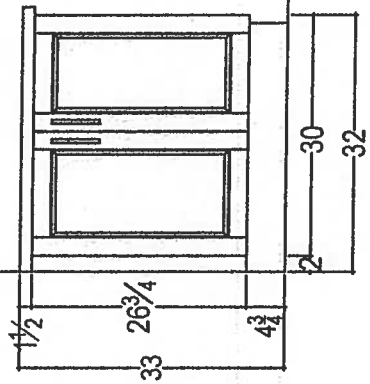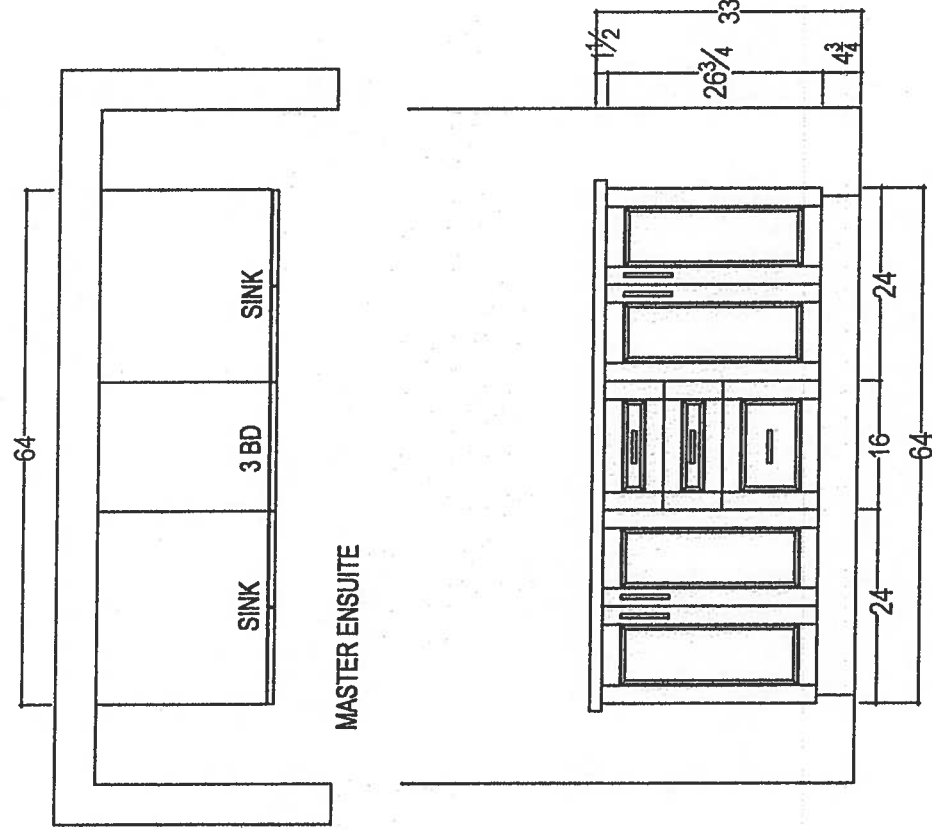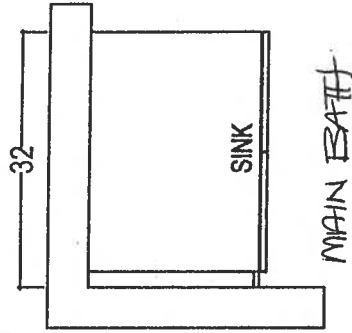

your kitchen, your taste.  
80 SANTE DRIVE, VAUGHAN, ON L4K 3C4,  
T: 416.746.1811 F: 905.761.5901

|                          |            |                        |                |          |                       |                                                                                                                      |
|--------------------------|------------|------------------------|----------------|----------|-----------------------|----------------------------------------------------------------------------------------------------------------------|
| CLIENT: ROYAL PINE HOMES |            | JOB NAME: UNIT 717 HMP | ROOM:          | VANITIES | DRAWN BY: SK          | COMMENTS:<br><br>PLEASE NOTE ALL DIMENSIONS<br>ARE NOT FINAL AND ARE<br>SUBJECT TO CHANGE UPON<br>FINAL SITE MEASURE |
| SITE: HAMPTON PLACE      | LOT #:     |                        | DOOR HANDLE: — |          | SCALE: 1/2" = 1' - 0" |                                                                                                                      |
| PHONE: —                 | FINISH: —  |                        | DRW HANDLE: —  |          | DATE: APRIL 28, 2018  |                                                                                                                      |
| EMAIL: —                 | SPECIES: — |                        | TOP: —         |          | PAGE:                 |                                                                                                                      |
|                          |            |                        |                |          |                       |                                                                                                                      |

Suite 717  
Hampton

Upgrade  
Package 2

L-8 R-8

INSIDEADVANTAGE™



<http://www.insideadvantage.com>

**Product Dimensions:**

Height: 72  
Width: 35 3/4  
Depth: 30 1/4

**Electrical Requirements:**

15 Amps.

**Available In:**

- ☐ Stainless Steel
- ☒ Black
- ☐ White


KRFC302ESS

22 cu.ft. 36-Inch Width Counter Depth French Door Refrigerator  
with Interior Dispense

**KRFC302ESS**

**Key Features:**

- ExtendFresh™ Temperature Management System
- Interior Water Dispenser
- Professionally-Inspired Design
- Produce Preserver
- Humidity-Controlled Crispers
- FreshChill™ Temperature-Controlled Full-Width Pantry
- Pull-Out Tri-Level Freezer Drawer
- SatinGlide® System
- LED Lighting
- Star-K Certified
- Automatic Ice Maker
- Max Cool

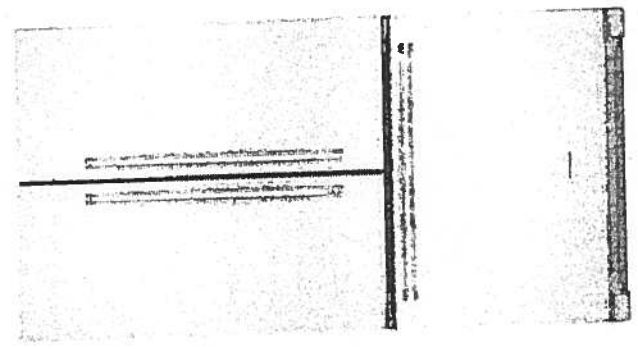

MADE IN  
AMERICA

Because Whirlpool Corporation policy includes a continuous commitment to improve our products, we reserve the right to change materials and specifications without notice. We also reserve the right to discontinue or transition products without notice.  
Reg. Registered trademark/TM Trademark of Whirlpool U.S.A. © 2013 Whirlpool Corporation. All Rights Reserved. All other trademarks are owned by their respective companies.  
Created On: Wednesday, April 22, 2015 15:51:04

# Suite 717 Hampton Upgrade Package 2



KMHP519ESS

1200-Watt Convection Microwave with High-Speed  
Cooking - 30"

**KitchenAid**

<http://www.kitchenaid.com>

#### Key Features:

- High-Speed Cooking
- Convection Cooking
- Professionally-Inspired Design Including Handle, Badge, Graphics, Chrome Chamfer.
- Cookshield Finish
- Crispwave™ Technology and Crisper Pan
- 1200 Watts Power
- 1.9 Cu. Ft. Capacity
- Halogen Cavity Lights and Task Light
- Steam Cleaning Function
- Keep Warm Function
- Sound-Based Popcorn Function

#### Product Dimensions:

Height: 17 1/8

Width: 30

Depth: 17

#### Electrical Requirements:

15.


#### Additional Information:

[Use And Care](#)

[Dimension Guide](#)

[Installation Guide](#)

[Warranty](#)

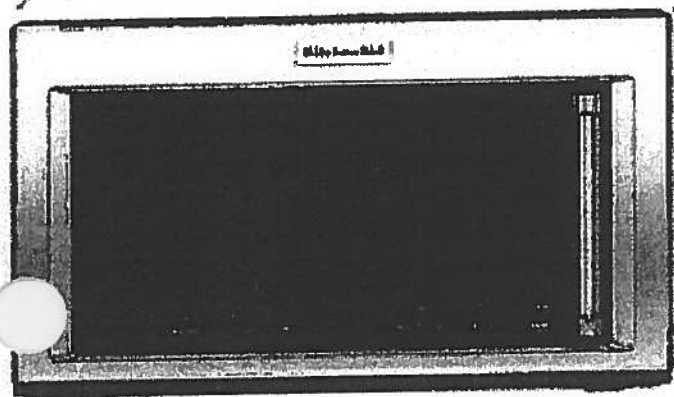

Available In:



Stainless Steel

®Registered trademark/TM Trademark of Whirlpool, U.S.A. © 2016 Whirlpool Corporation. All Rights Reserved. All other trademarks are owned by their respective companies.

Because Whirlpool Corporation policy includes a continuous commitment to improve our products, we reserve the right to change materials and specifications without notice. We also reserve the right to discontinue or transition products without notice.

Manufacturer's Suggested Retail Price (MSRP) and Minimum Advertised Price (MAP) provided for reference purposes only. Dealer alone determines advertised and retail prices.

Suite 717  
Hampton

Upgrade  
Package 2




KSEB900ESS

**KitchenAid**

36-Inch 5-Element Electric Convection Slide-In  
Range with Baking Drawer

<http://www.kitchenaid.com>

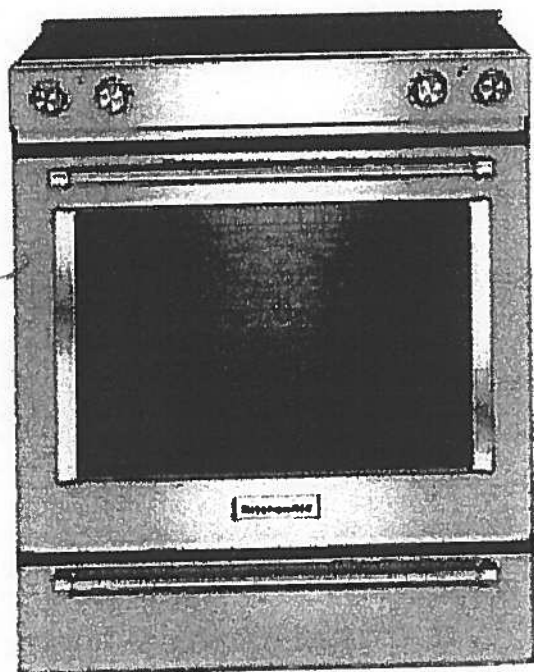

**Key Features:**

- Baking Drawer
- Even-Heat™ True Convection
- Wireless Probe
- Steam Rack
- 7.1 Cu Ft. Total Capacity
- 5 Cooking Elements Including a Warm Zone
- EasyConvect™ Conversion
- FIT Guarantee
- Aqualift®
- Glass Touch Controls
- Side Trim Accessory Kit

**Product Dimensions:**

Height: 36

Width: 29 7/8

**Electrical Requirements:**

40 Amps.

**Additional Information:**

[Use And Care Guide](#)

[Dimension Guide](#)

[Installation Guide](#)

[Warranty Certificate](#)

Available in:

- Black
- Stainless Steel
- White

INVESTED  
IN  
AMERICA

ADA  
Compliant

©Registered trademark/TM Trademark of Whirlpool, U.S.A. © 2013 Whirlpool Corporation. All Rights Reserved  
All other trademarks are owned by their respective companies.  
Because Whirlpool Corporation policy includes a continuous commitment to improve our products, we reserve  
the right to change materials and specifications without notice. We also reserve the right to discontinue or  
transition products without notice.  
Manufacturer's Suggested Retail Price (MSRP) and Minimum Advertised Price (MAP) provided for reference  
purposes only. Dealer alone determines advertised and retail prices  
Created On: Tuesday, December 22, 2015 14:04:50

Suite 717  
Hampton

Upgrade  
Package 2




KDTM354ESS

**KitchenAid®**

dBA Dishwasher with Clean Water Wash System

<http://www.kitchenaid.com>

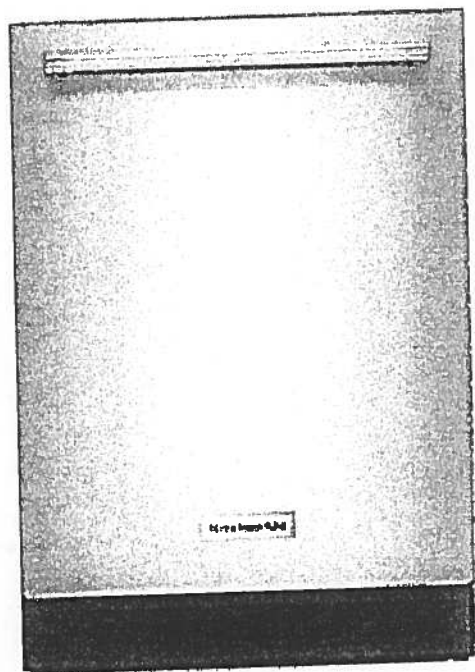

#### Key Features:

- Clean Water Wash System
- ProScrub® Option
- Professionally-Inspired Design
- Advanced ProDry™ System
- ProWash™ Cycle
- SatinGlide® Max Rails (Upper Rack)
- Sliding Tines in the Lower Rack
- 2 Rows Fold-Down Tines in Upper Rack
- Fold-Down Tines in the Lower Rack
- 2 Fold-Down Cup Shelves with Integrated Stemware Holders
- Utility Basket (Upper Rack)
- Express Wash

#### Product Dimensions:

Height: 34 1/2

Width: 23 7/8

Depth: 24 3/4

#### Electrical Requirements:

15 Amps.

#### Additional Information:

[Use And Care Guide](#)

[Dimension Guide](#)

[Installation Guide](#)

[Energy Guide](#)

[Warranty Certificate](#)

Available in:

● Stainless Steel

INVESTED  
IN  
AMERICA

®Registered trademark/TM Trademark of Whirlpool, U.S.A. © 2013 Whirlpool Corporation. All Rights Reserved.  
All other trademarks are owned by their respective companies.  
Because Whirlpool Corporation policy includes a continuous commitment to improve our products, we reserve the right to change materials and specifications without notice. We also reserve the right to discontinue or transition products without notice.  
Manufacturer's Suggested Retail Price (MSRP) and Minimum Advertised Price (MAP) provided for reference purposes only. Dealer alone determines advertised and retail prices.  
Created On: Friday, March 04, 2016 16:36:55

Suite 717  
Hampton

# Upgrade Package 2


LA RA

WFW85HEFC

Whirlpool®

<http://www.whirlpool.com>

4.5 cu. ft. Front Load Washer with TumbleFresh™  
option

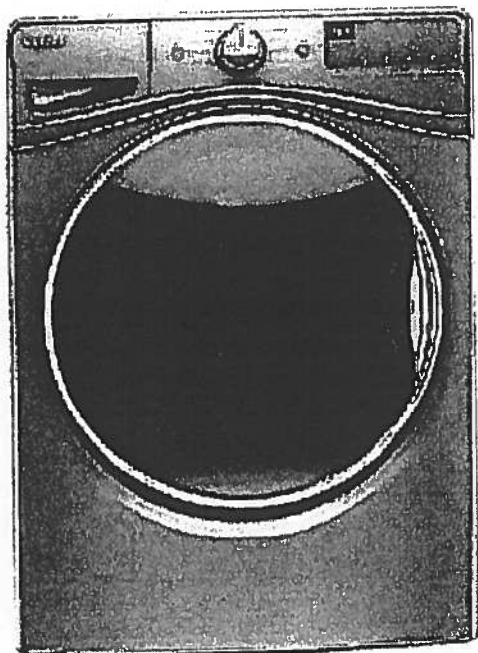

## Key Features:

- TumbleFresh™ Option
- ColorLast™ Cycle
- Presoak Option
- EcoBoost™ Option
- Precision Dispense
- Steam Clean Option
- Adaptive Wash Technology
- Smooth Wave Stainless Steel Wash Basket
- 4.5 cu. ft. Capacity
- Undercounter Installation
- Add-A-Garment
- ENERGY STAR® Certified

## Product Dimensions:

Height: 39 3/4

Width: 27

Depth: 33 5/16

## Additional Information:

[Use And Care Guide](#)

[Dimension Guide](#)

[Installation Guide](#)

[Energy Guide](#)

[Warranty Certificate](#)

## Available in:

- ☒ Chrome Shadow  
☐ White

INVESTED  
IN  
AMERICA



©Registered trademark/TM Trademark of Whirlpool, U.S.A. © 2016 Whirlpool Corporation. All Rights Reserved.  
All other trademarks are owned by their respective companies.  
Because Whirlpool Corporation policy includes a continuous commitment to improve our products, we reserve the right to change materials and specifications without notice. We also reserve the right to discontinue or transition products without notice.  
Manufacturer's Suggested Retail Price (MSRP) and Minimum Advertised Price (MAP) provided for reference purposes only. Dealer alone determines advertised and retail prices.  
Created On: Wednesday, December 14, 2016 18:12:43

Suite 717  
Hampton

Upgrade  
Package 2




WED85HEFC

Whirlpool®

<http://www.whirlpool.com>

cu. ft. Electric Dryer with Quick Dry Cycle

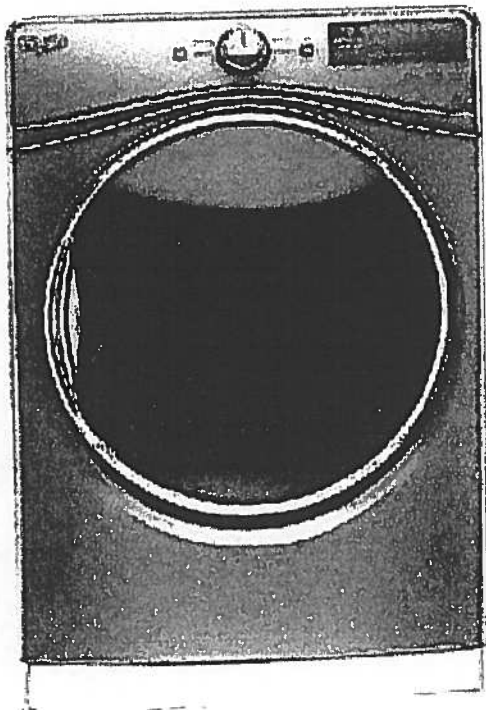

Key Features:

- Advanced Moisture Sensing System
- Tap Touch Controls with Memory
- EcoBoost™ Option
- Steam Refresh Cycle
- Wrinkle Shield™ Option
- Quad Baffles
- 7.4 Cu. Ft. Capacity
- Undercounter Installation
- ENERGY STAR® Qualified
- Sanitize Cycle
- Quick Dry Cycle

Product Dimensions:

Height: 39

Width: 27

Depth: 31

Additional Information:

[Use And Care Guide](#)

[Dimension Guide](#)

[Installation Guide](#)

[Warranty Certificate](#)

INVESTED  
IN  
AMERICA



©Registered trademark/TM Trademark of Whirlpool, U.S.A. © 2016 Whirlpool Corporation. All Rights Reserved  
All other trademarks are owned by their respective companies  
Because Whirlpool Corporation policy includes a continuous commitment to improve our products, we reserve the right to change materials and specifications without notice. We also reserve the right to discontinue or transition products without notice  
Manufacturer's Suggested Retail Price (MSRP) and Minimum Advertised Price (MAP) provided for reference purposes only. Dealer alone determines advertised and retail prices  
Created On: Thursday, March 23, 2017 17:33:37

# Countertop Edges

## Suite 717

## Hampton



1/2

**CONNOLLY** Marble & Granite Ltd.

EDGE  
DETAILS


004

A.




STRAIGHT EDGE  
(STANDARD - 3/4")

Standard:  
Kitchen  
Main Bath  
Master Ensuite

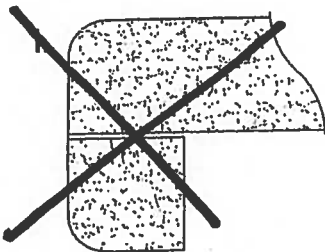

DOUBLE TOP "D" EDGE  
(STANDARD - 1 1/2")

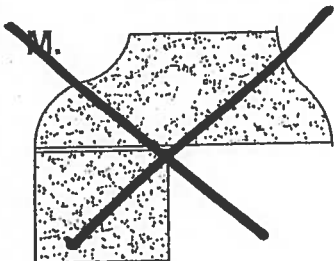

OGEE - SQUARE EDGE  
(MED./HIGH - 1 1/2")

EDGING UP-GRADE OPTIONS