





Flanders


ORIGINAL CITY

SUITE 314.


1,059 SQ FT *plus* 180 sq. ft. of balcony area

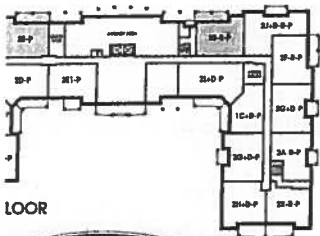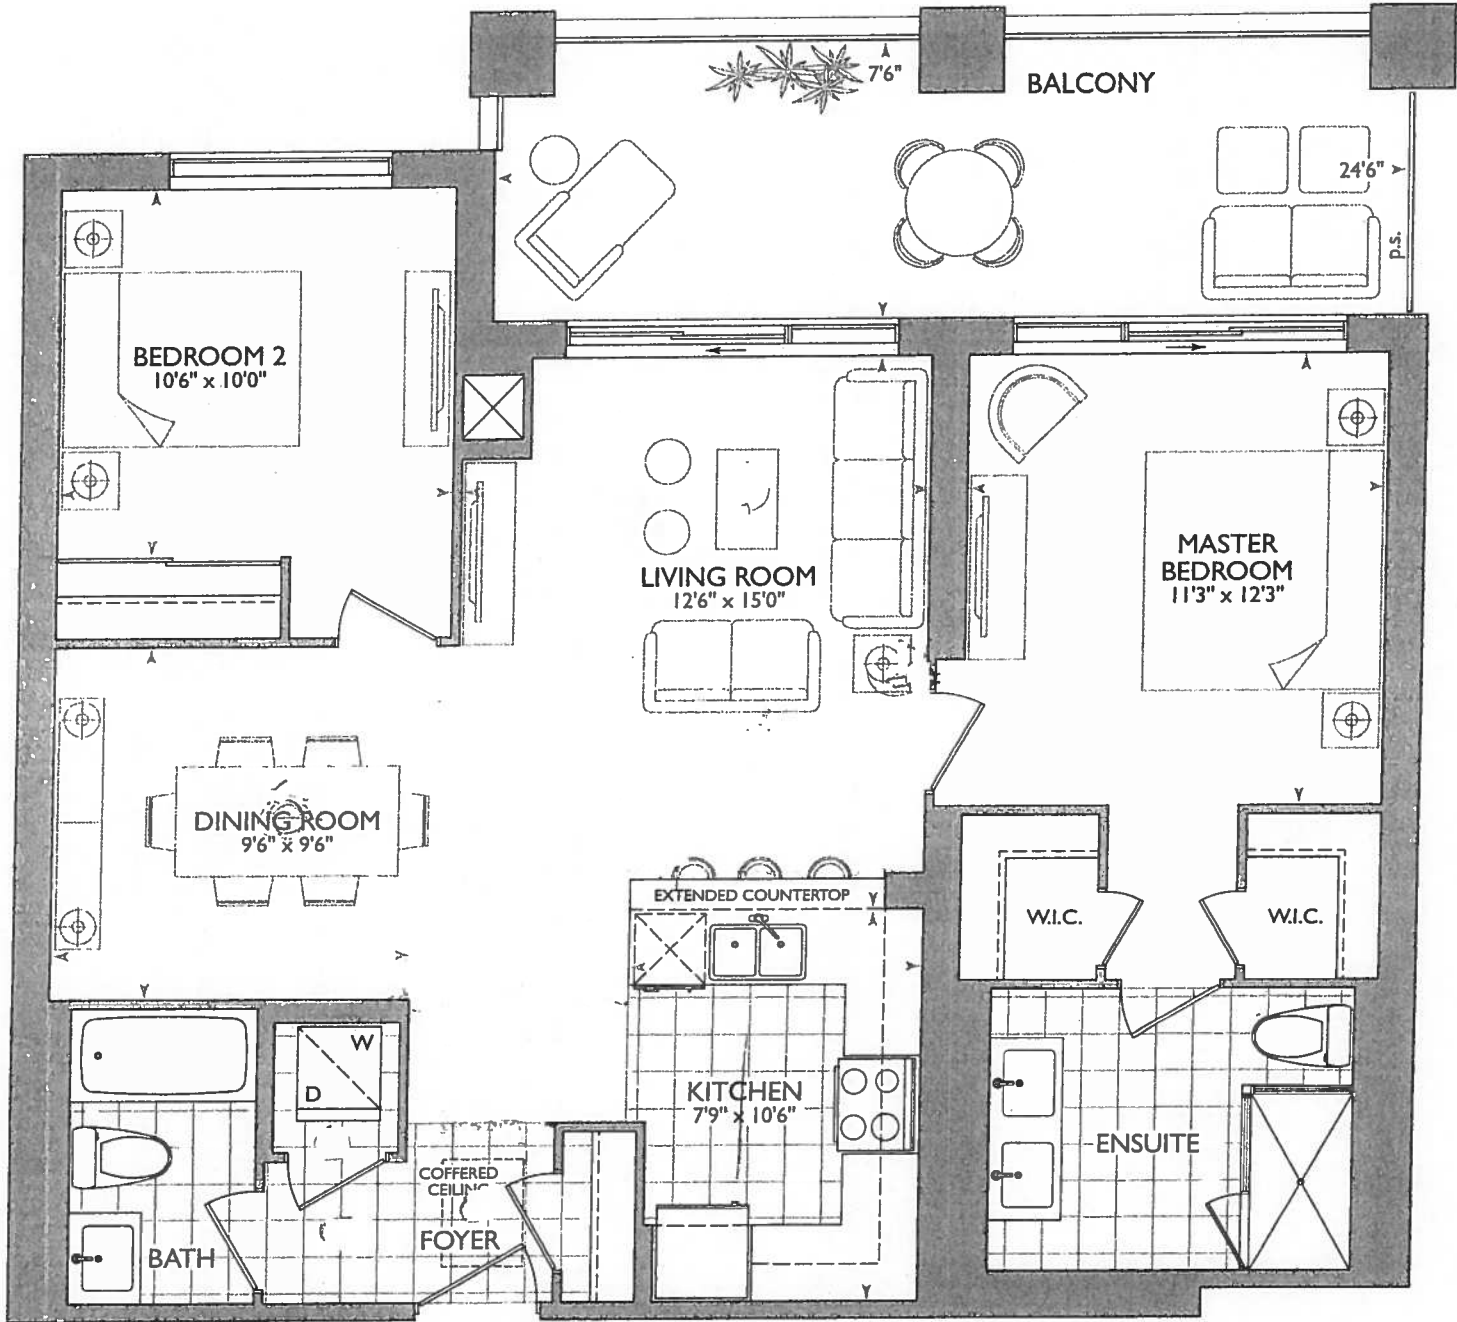

1st FLOOR

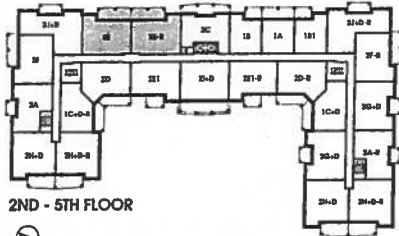

2ND - 5TH FLOOR

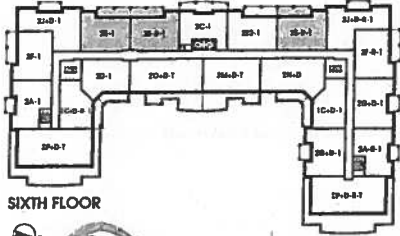

SIXTH FLOOR



SEVENTH FLOOR



16

December 7, 2017


GP Air

KITCHEN

- URG 1-APPLANCE PACKAGE.
- (X) = PUCK LIGHTS
- (P) = PUCK. PENINSULA.
- (IX) = POT LIGHT OVER SINK PENINSULA.

- 61" STOVE PIPE CENTER
- 121" SINK PIPE CENTER
- MAIN ENSUITE RAISED VANITIES 36 1/4" (+)
- 3" SPLASH

* REUSED COFFERED CEILING FOYER AS PER THIS BROCHURE, TILES TO REMAIN THE SAME AS PER ORIGINAL SUITE LAYOUT

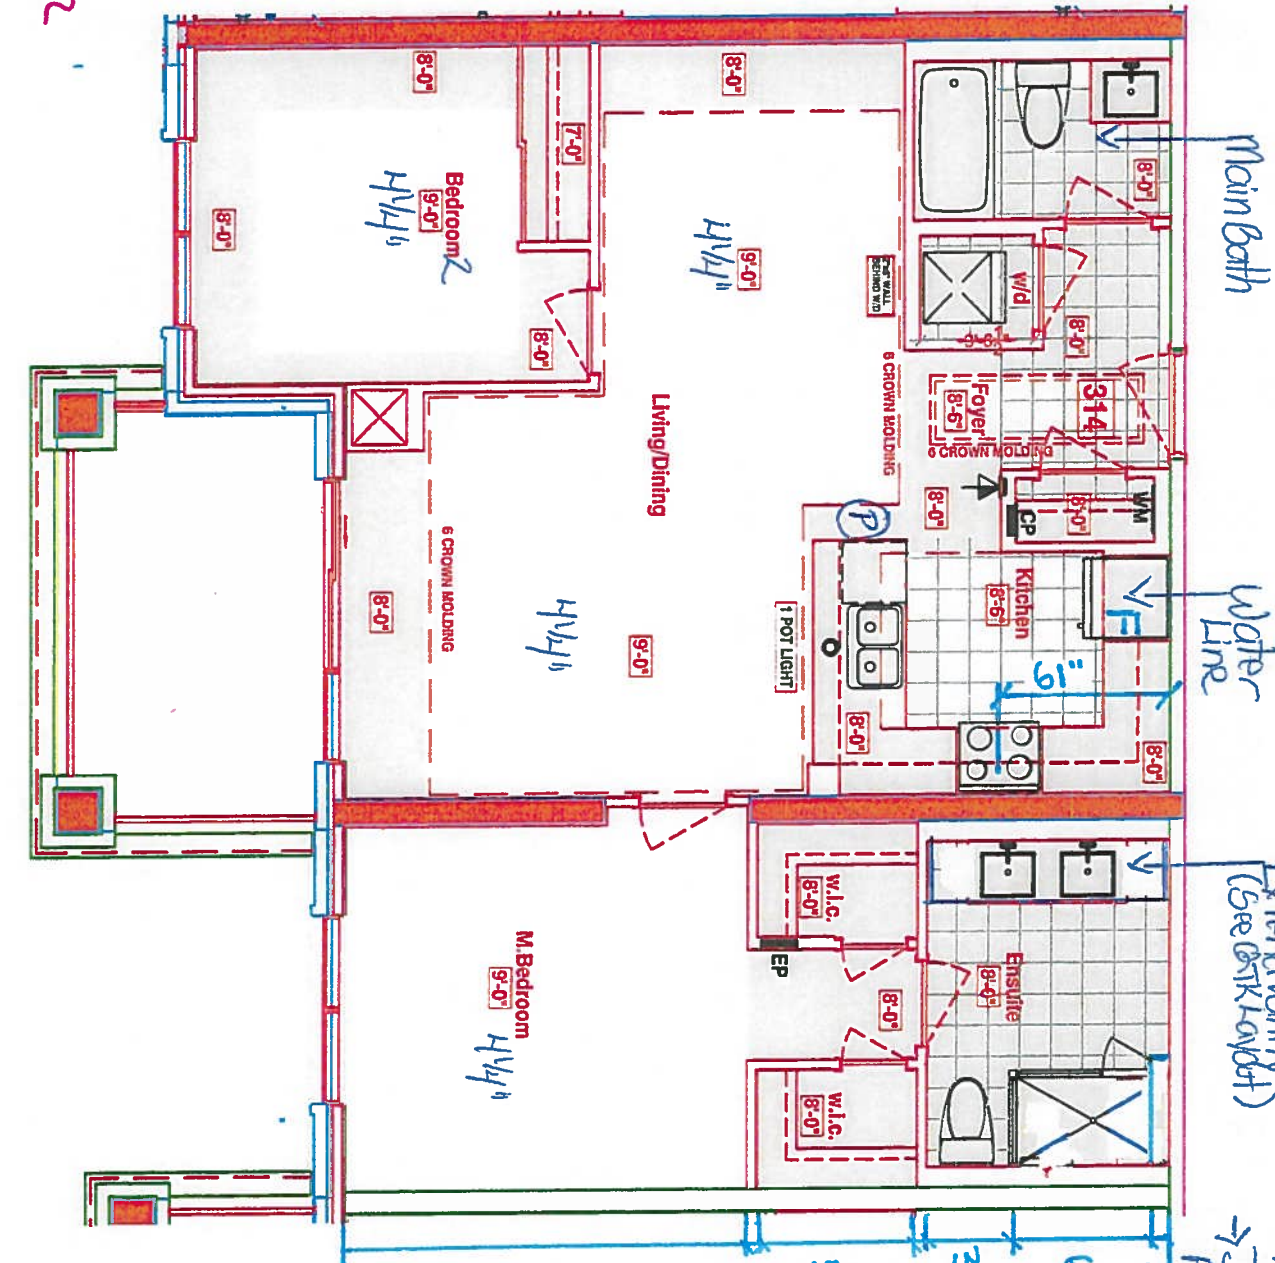

Main Bath

Water Line

Extend Vanity (See sketch p. 4)

NO!

→ Kitchen - Water Line to Fridge
→ Delete Bathroom Ceramic Accessories - Main Bath & Master Ensuite

* ENSUITE RAIN SHOWER FROM WALL

ADD 4"x40" WET WALL FOR SHOWER FAUCET
* REVISED ENSUITE + W.I.C. + MASTER BEDROOM MEASUREMENTS

LEGEND:	
	SECURITY PANEL
	ELECTRICAL PANEL
	COMMUNICATION PANEL
	WATER METER
	FRIDGE
	DROPPED AREA
	6\"/>



VINCE'S
SITE COPY

CONSTRUCTION SUMMARY

Hampton Place

CHASERS: MERVIN D. WILLIAMS and PATRICE A. WILLIAMS

TEL: RES.: 905-836-5448 BUS.: 416-451-3006

LOT NUMBER	PHASE	HOUSE TYPE	CLOSING DATE
314	1	FLANDERS(2E1)FRONT	01-Oct-18

Offer	ADDITIONAL - SINGLE PARKING UNIT
Workshee	Note:
er	PURCHASER TO RECEIVE \$5,000(INCLUDES APPLICABLE TAXES) WORTH OF UPGRADES AT THE DECOR CENTER AT TIME OF COLOUR CHART.
Workshee	Note:
Offer	ADDITIONAL - LOCKER UNIT
Workshee	Note:
Offer	POT LIGHT ABOVE SINK , IF POSSIBLE
Upgrade	Note:
Offer	RAINHEAD FROM WALL IN MASTER ENSUITE SHOWER , FROM VENDORS STANDARD SAMPLES
Upgrade	Note:

FLANDERS: 314

-REVISED FOYER COFFERED CEILING AS PER COLOURED PLAN,
TILES TO REMAIN AS PER ORIGINAL SUITE LAYOUT
-ENSUITE 4" ADDED 4"x40" WET WALL FOR SHOWER FAUCET, NEW
DIMENTIONS ARE ON THE NEW COLOURED BROCHURE FOR W.I.C.
& MASTER BEDROOM



SITE COPY

CONSTRUCTION SUMMARY

Hampton Place

PURCHASERS: MERVIN D. WILLIAMS and PATRICE A. WILLIAMS TEL: RES.: 905-836-5448 BUS.: 416-451-3006

LOT NUMBER	PHASE	HOUSE TYPE	CLOSING DATE	
314	1	FLANDERS(2E1)FRONT	01-Oct-18	

Date Added: 07-Dec-17 Invoice Number: 7050

712 - HARDWOOD FLOORING - Install prefinished 4 1/4" x 1/2" Mirage Red Oak Lock Floating Floor in lieu of builders standard laminate flooring. To be installed throughout; Living/Dining Room, Master Bedroom, and Bedroom #2 (See Sketch) Note:
1 - KITCHEN & BATHROOMS - SEE QUALITY TOPS & KITCHENS FOR ALL KITCHEN & BATHROOMS UPGRADES / LAYOUTS. (See Attached QTK Paperwork) Note:
2 - KITCHEN - Install TWO (2) ADDITIONAL PUCK LIGHTS (Same Switch as Standard Puck Lights) at kitchen. To be installed below kitchen cabinetry, where applicable. (See Attached QTK Layout for Locations) Note: Purchaser Paying Difference for Additional Puck Lights - Standard Kitchen to Receive Four (4) Puck Lights - Upgrade Kitchen Requires Six (6) Puck Lights
1 - KITCHEN - Install 1ST UPGRADE CAESARSTONE COUNTERTOP - 4141 MISRY CARRARA - To be installed throughout kitchen, where applicable. (does not include stone backsplash) (See Sketch) Note:
1 - DISCLAIMER - STONE COUNTERTOP; KITCHEN - Stone slabs vary in size & all seams are visible & the fabricator reserves the right to position the seams as necessary. Note:
1 - KITCHEN - Kitchen Backsplash - Install 1ST UPGRADE BACKSPLASH - 12x12 CLOUD RANDOM STRIP GLASS MOSAICS - To be installed throughout kitchen, where applicable (does not include behind the fridge or stove) (See Sketch) Note:
1 - KITCHEN - Kitchen Sink - Install Upgrade Undermount Sink - BLANCO Quatrus U Super Single Undermount Sink - Model # 401248 (See Attached) Note:
1 - KITCHEN - Kitchen Faucet - Install Standard Faucet - DELTA Chrome Pull-Out Kitchen Faucet (Single Hole) - Model # 469LF - Chrome Note:
1 - APPLIANCE PACKAGE - Install Upgrade Appliance Package - UPGRADE PACKAGE #1 - To be installed throughout suite, where applicable. (See Sketch) Note:
1 - KITCHEN - Install WATER LINE ROUGH-IN ONLY To Fridge at Kitchen (See Sketch) Note:
1 - CLARIFICATION; MAIN BATH & MASTER ENSUITE - Install RAISED VANITY HEIGHTS at Main Bath and Master Ensuite Vanities, where applicable. (See Attached QTK Paperwork) Note:
1 - MASTER ENSUITE - Install ADDITIONAL Standard Granite Countertop - BIANCO ANTICO - Throughout master ensuite vanity, where applicable. (Includes 3" Splash) (See Sketch) Note: Priced as per Orlando at Connolly
1 - DISCLAIMER - GRANITE COUNTERTOP; MASTER ENSUITE - Due to the many variables that can affect the pattern, colour and/or design and "pitting" of natural products, granite installed will not be identical to the samples displayed. Note: Every effort is made to provide granite countertops as close as possible but the vendor is not responsible for results which differ from the sample displayed. All countertop surfaces may have seams, and product pattern and shade can change in areas containing seams.
1 - CLARIFICATION; MAIN BATH & MASTER ENSUITE - Install Standard 3" Splash throughout Main Bath and Master Ensuite Vanity Countertops, where applicable. (See Sketch) Note:



SITE COPY

CONSTRUCTION SUMMARY

Hampton Place

PURCHASERS: MERVIN D. WILLIAMS and PATRICE A. WILLIAMS

TEL: RES.: 905-836-5448 BUS.: 416-451-3006

LOT NUMBER	PHASE	HOUSE TYPE	CLOSING DATE	
314	1	FLANDERS(2E1)FRONT	01-Oct-18	

Date Added: 07-Dec-17

Invoice Number: 7050

1 - DISCLAIMER - STONE COUNTERTOP;
MAIN BATH & MASTER ENSUITE - Stone slabs vary in size & all seams are visible & the fabricator reserves the right to position the seams as necessary.
Note:

1 - CLARIFICATION;
MAIN BATH & MASTER ENSUITE - Install Standard Plumbing Fixtures throughout Main Bath and Master Ensuite, where applicable. (See Sketch)
Note:

1 - CLARIFICATION - REFER TO APAS;
MASTER ENSUITE - Install Rain Shower Head from Wall at Master Ensuite Shower Stall - DELTA - Shower Trim and Hansgrohe Slide Bar with Handheld and Ceiling Mount Showerhead
Note: Model # R10000 / T13020-CDN/27454002 / 277440 / RP52382 / RP46870 / RP6025 / R11000 / T11800 - Chrome (See Sketch)

1 - CLARIFICATION;
MASTER ENSUITE - Purchaser accepts & acknowledges the standard frameless glass enclosure at master ensuite shower stall will NOT touch the ceiling and will receive a Standard Chrome Header. (See Sketch)
Note:

1 - CLARIFICATION;
MAIN BATH & MASTER ENSUITE - DELETE Do Not Install / Supply / Credit Purchaser for builders standard ceramic bathroom accessories (toilet paper, towel bar & soap dish) throughout all bathrooms where applicable.
Note: To Include; Main Bath & Master Ensuite (See Sketch)

1 - BONUS PACKAGE - PURCHASER HAS APPLIED \$3,983.00 (Includes Taxes) WORTH OF UPGRADE PROMOTIONAL PACKAGE TOWARDS THE PURCHASE OF UPGRADE COMPLETED AT THE DECOR CENTRE.
Note:

1 - PURCHASER HAS ATTENDED A COLOR APPOINTMENT AT THE DECOR CENTRE AND HAS DECLINED ANY ADDITIONAL UPGRADES. Purchaser accepts and acknowledges that there will be no further changes/additions/deletions to be made upon signing on December 7,2017
Note:

1 - PURCHASER AWARE AND ACCEPTS THAT ANY CHANGES MADE TO UPGRADES AFTER SIGNING THIS PURCHASERS EXTRA FORM ARE SUBJECT TO A MINIMUM ADMINISTRATION FEE OF \$1,000 PLUS A 10% HOLDBACK FEE.
Note:

This Document is Extremely Time Sensitive - Printed 16 Feb 18 at 14:12



* INTERIOR * OUR SCHEME *

Purchasers		Decor Consultant	Model Type	Telephone Res. / Bus	Project	Closing Date	Unit
MERVIN D. WILLIAMS & PATRICE A. WILLIAMS		Melissa Di Marino	FLANDERS(2E1)FRONT	(905) 836-5448 / (416) 451-3006	Hampton Place	01/10/2018	314

Page 1 of 3

Flooring		Wall Tile		
Description		Main	Accent/Insert	Pattern
✓ 13x13 RUSTIC CHARCOAL (STD)	✓	8x10 CARRARA MATT (STD)	NONE	NONE
✓ 13x13 RUSTIC GREY (STD)	✓	8x10 GOLF GRIGIO (STD)	NONE	NONE
N/A		N/A	N/A	N/A
✓ 20x20 PULPIS GRIS (STRAIGHT) (STD)	✓	12x12 Cloud Random Strip Glass Mosaic (Upg)	NONE	NONE
✓ 20x20 PULPIS GRIS (STRAIGHT) (STD)	✓	N/A	N/A	N/A
✓ 8x8 BEHRAM PINK (STD)	✓	N/A	N/A	N/A
✓ 4 1/4" Mirage RedOak Charcoal (SemiGloss) (UPG)	✓			
✓ 4 1/4" Mirage RedOak Charcoal (SemiGloss) (UPG)	✓			
N/A				
✓ 4 1/4" Mirage RedOak Charcoal (SemiGloss) (UPG)	✓			
✓ 4 1/4" Mirage RedOak Charcoal (SemiGloss) (UPG)	✓			
N/A				

Notes

Page 1 of 3

Consultant  Melissa Di Marino

Purchaser  MERVIN D. WILLIAMS

Purchaser  PATRICE A. WILLIAMS

Vendor  Hampton Place



* INTERIOR OUR SCHEME *

Purchasers		Decor Consultant	Model Type	Telephone Res. / Bus	Project	Closing Date	Unit
MERVIN D. WILLIAMS & PATRICEA A. WILLIAMS		Melissa Di Marino	FLANDERS(2E1)FRONT	(905) 836-5448 / (416) 451-3006	Hampton Place	01/10/2018	314

Page 2 of 3

CABINETRY, VANITIES AND COUNTERTOPS

	Style	Countertop	Counter Edge	Handle / Knob
MAIN BATHROOM	CATEGORY 1 - LP LAMINATE - TWILIGHT QT 1022 (STD)	☒ ASPEN TERRA WHITE (STD)	☒ A" EDGE (STD)	B603-SC
MASTER ENSUITE	CATEGORY 1 - FIBERBOARD - WHITE QT 1203 (STD)	☒ BIANCO ANTICO GRANITE (STD)	☒ A" EDGE (STD)	B603-SC
POWDER ROOM	N/A	N/A	N/A	N/A
KITCHEN / DINETTE	CATEGORY 1 - FIBERBOARD - WHITE QT 1203 (STD)	☒ 4141 MistyCarrara CaesarStone (UPG)	☒ A" EDGE (STD)	3487-128
LAUNDRY ROOM	N/A	N/A	N/A	N/A

APPLIANCE PACKAGE

Upgrade Package #1

Std 31in Opening

PLUMBING FIXTURES

KITCHEN	
Sink Model	☒ UPG-BlancoQuattusSuperSingle #40124
Sink Faucet	☒ STANDARD
TOILETS	
Master Ensuite	☒ STANDARD
Main Bathroom	☒ STANDARD
Powder Room	N/A
VANITY FAUCETS	
Master Ensuite	☒ STANDARD
Main Bathroom	☒ STANDARD
Powder Room	N/A
VANITY SINKS	
Master Ensuite	☒ STANDARD
Main Bathroom	☒ STANDARD
Powder Room	N/A
SHOWER STALL / TUBS	
Master Ensuite Shower Stall	☒ STANDARD
Master Ensuite Tub	N/A
Main Bathroom Tub	☒ STANDARD

Trim

Baseboard & Casing	☒ STANDARD
Interior Doors	☒ STANDARD - CARRARA, SMOOTH
Cornice Moulding / Medallion	
Foyer	☒ STANDARD - # CTR-611
Living Room	☒ STANDARD - # CTR-611
Dining Room	☒ STANDARD - # CTR-611
Den	N/A
Master Bedroom	NONE
Bedroom 2	NONE
Bedroom 3	N/A

Levers

Door Height	☒ STANDARD
-------------	--

Fireplace

Fireplace	N/A
Location Flooring	N/A
Style	N/A
Finish	N/A
Marble	N/A
Hearth	N/A

Paint Throughout

Walls	☒ STANDARD - OYSTER WHITE
Trim	☒ STANDARD - WHITE

MISC. INSTALLATIONS

Ceramic Accessories (Installed by Vendor)
☒ Yes ☐ No

Bathroom Mirrors (Installed by Vendor)
☒ Yes ☐ No

Wire Shelving - Closet (Installed by Vendor)
☒ Yes ☐ No


Page 2 of 3

Decor Consultant: Melissa Di Marino


Purchaser: MERVIN D. WILLIAMS

Purchaser: PATRICEA A. WILLIAMS

Vendor:

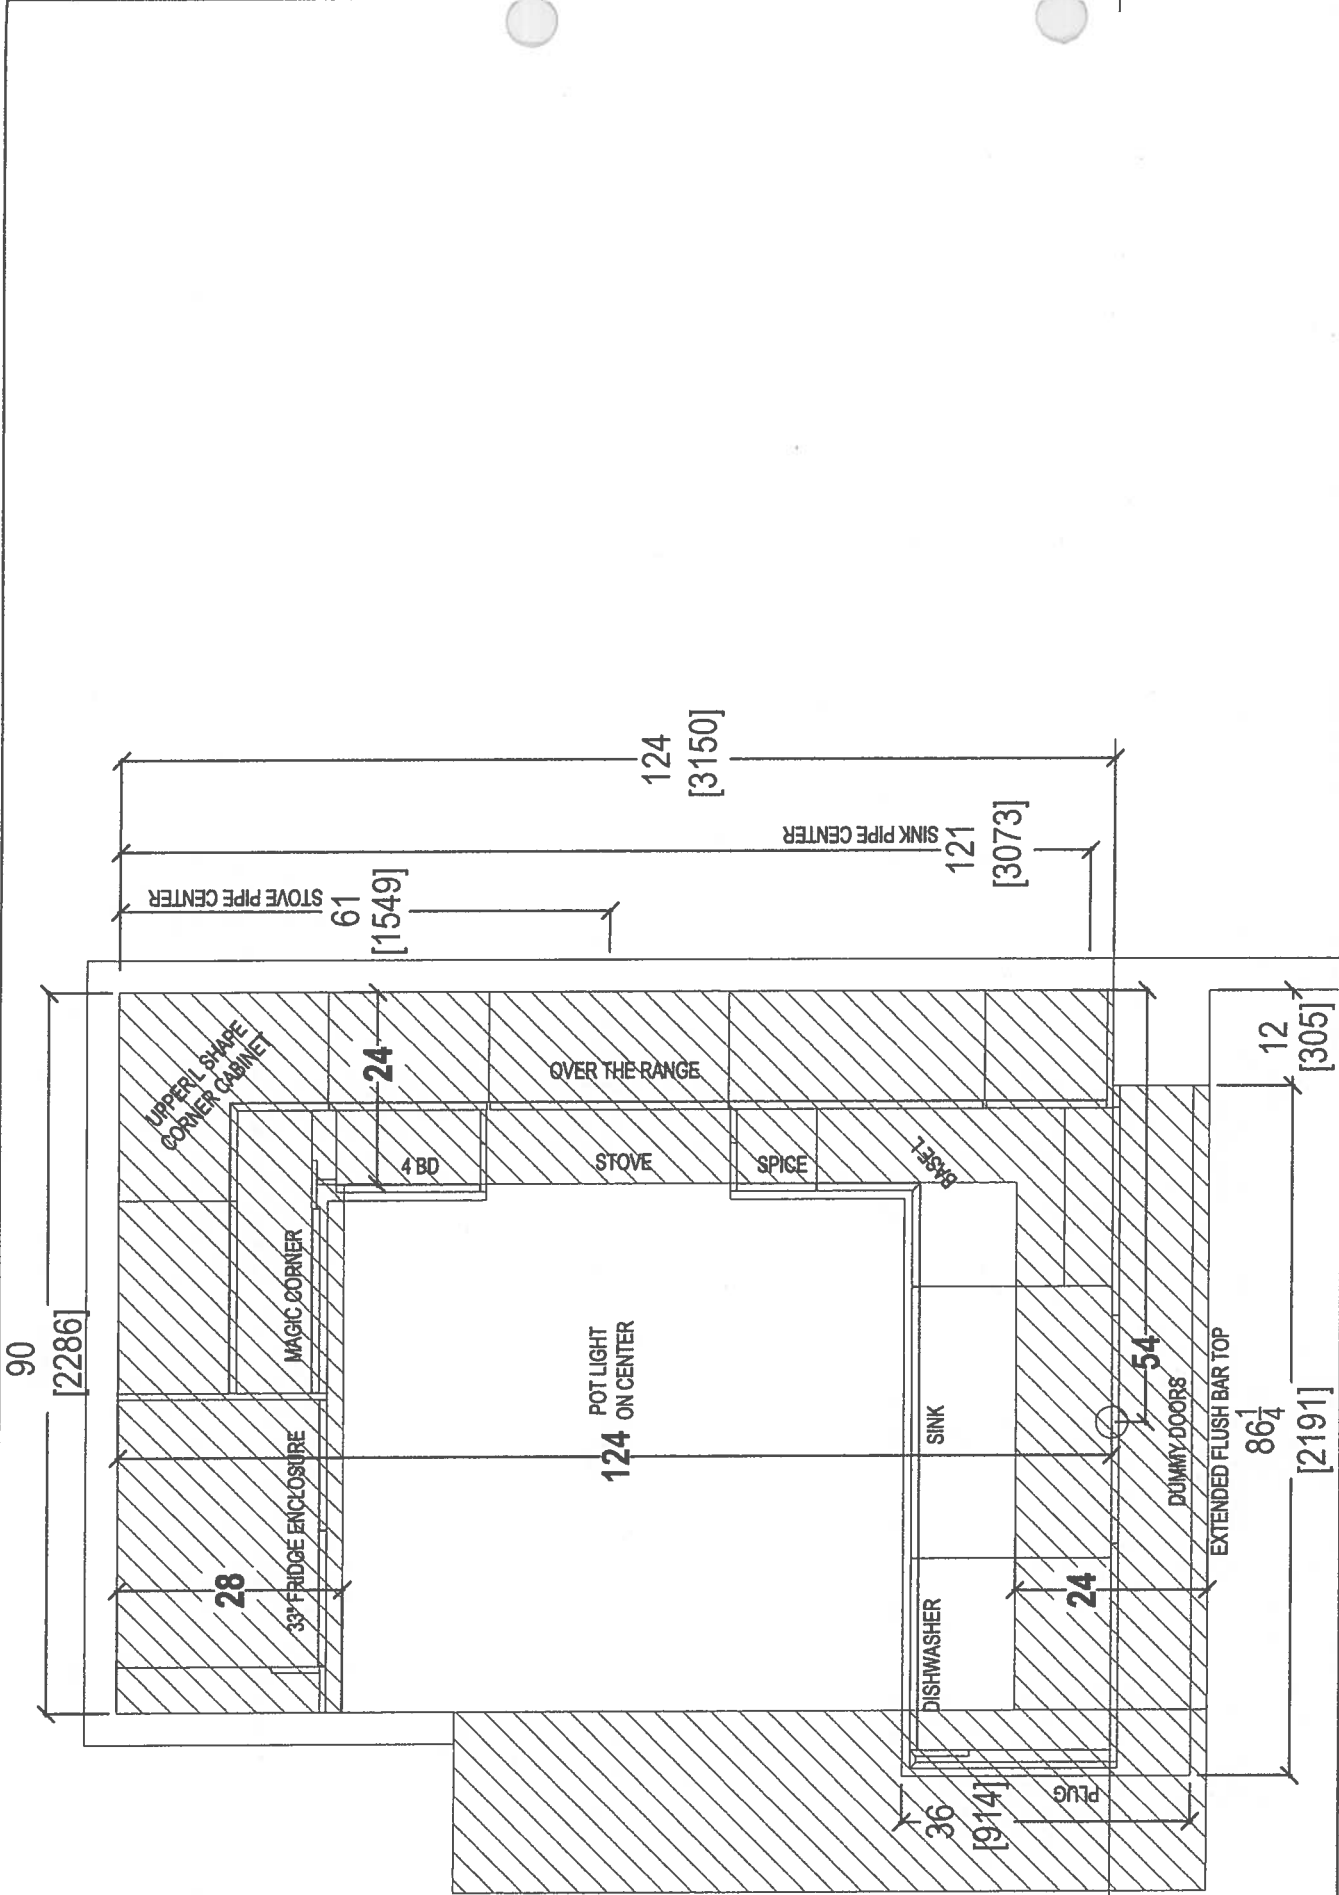



 your kitchen, your taste. 80 SANTE DRIVE VAUGHAN, ON L4K 3C4, T: 416.746.1811 F: 905.761.5901	CLIENT: ROYAL PINE HOMES		JOB NAME: UNIT 314 HMP		ROOM:	KITCHEN BULKHEAD PLAN	DRAWN BY: SK		COMMENTS: PLEASE NOTE ALL DIMENSIONS ARE NOT FINAL AND ARE SUBJECT TO CHANGE UPON FINAL SITE MEASURE	
	SITE:	HAMPTON PLACE	LOT #:		DOOR HANDLE:	---	SCALE:	1/2" = 1' - 0"		
	PHONE:	---	FINISH:	---	DRW HANDLE:	---	DATE:	APRIL 26, 2018		
	EMAIL:	---	SPECIES:	---	TOP:	---	PAGE:	---		

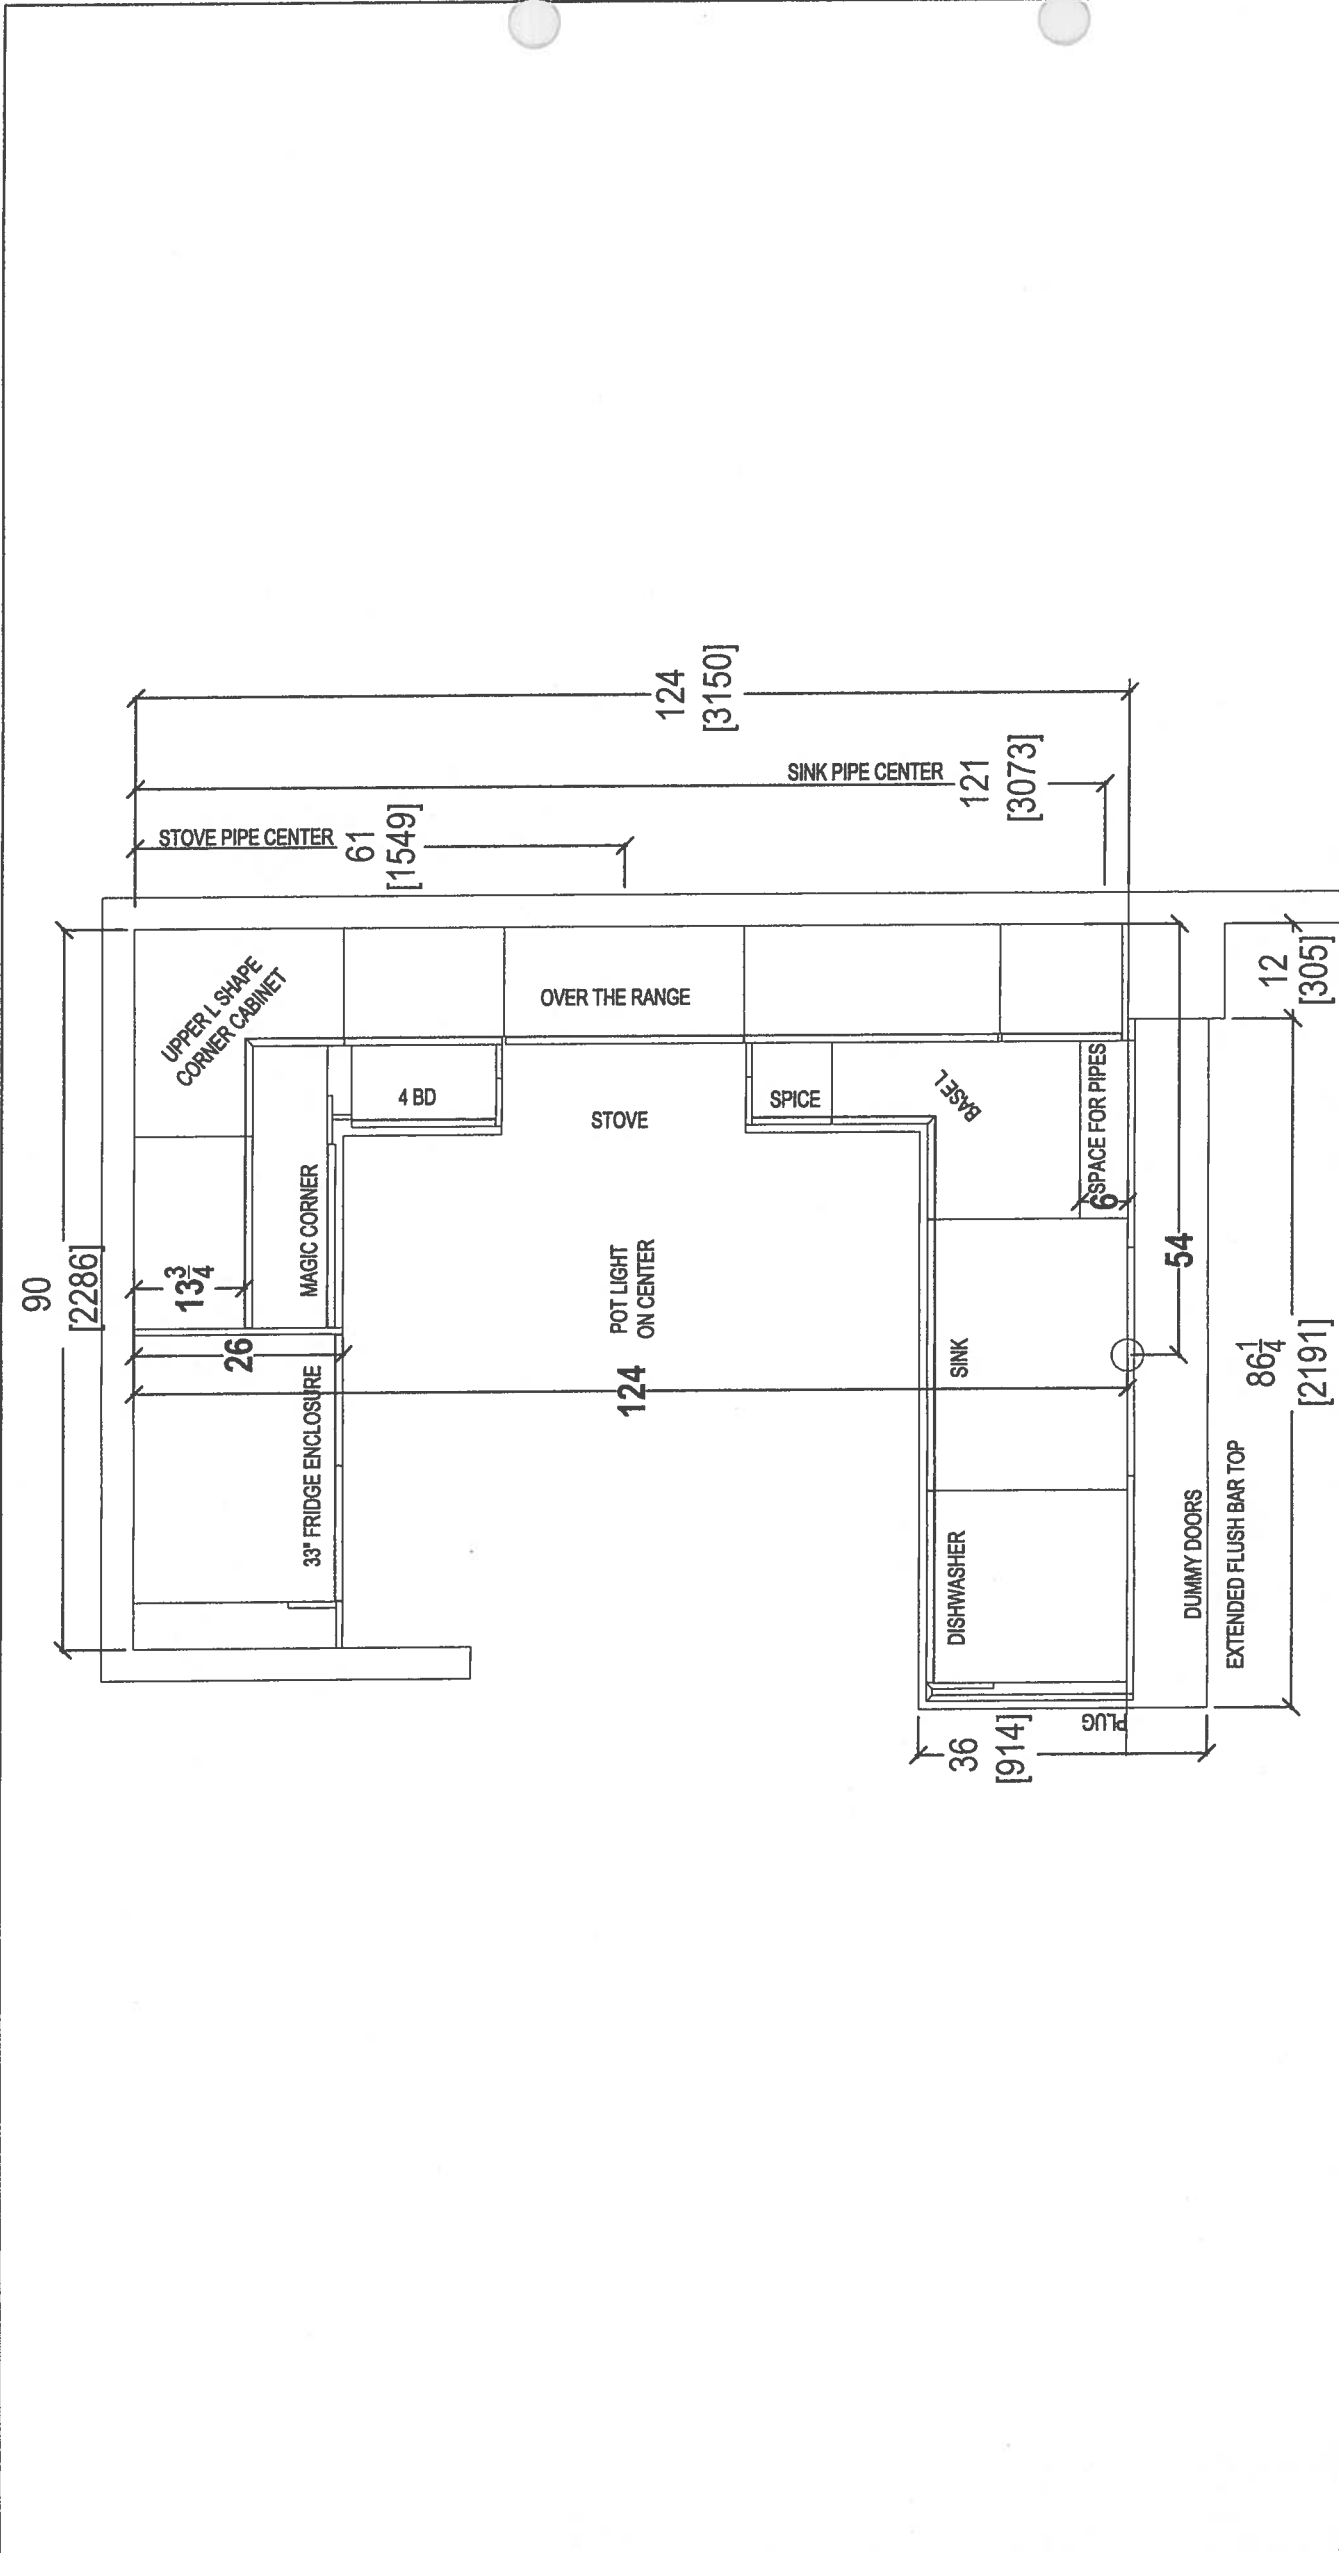

CLIENT: ROYAL PINE HOMES		JOB NAME: UNIT 314 HMP	ROOM: KITCHEN FLOOR PLAN	DRAWN BY: SK	COMMENTS: PLEASE NOTE ALL DIMENSIONS ARE NOT FINAL AND ARE SUBJECT TO CHANGE UPON FINAL SITE MEASURE
SITE: HAMPTON PLACE	LOT #:		DOOR HANDLE: —	SCALE: 1/2" = 1' - 0"	
PHONE: —	FINISH: —		DRW HANDLE: —	DATE: JAN 10, 2018	
EMAIL: —	SPECIES: —		TOP: —	PAGE: —	

your kitchen, your taste.

80 SANTE DRIVE, VAUGHAN, ON L4K 3C4,
T: 416.746.1811 F: 905.761.5901




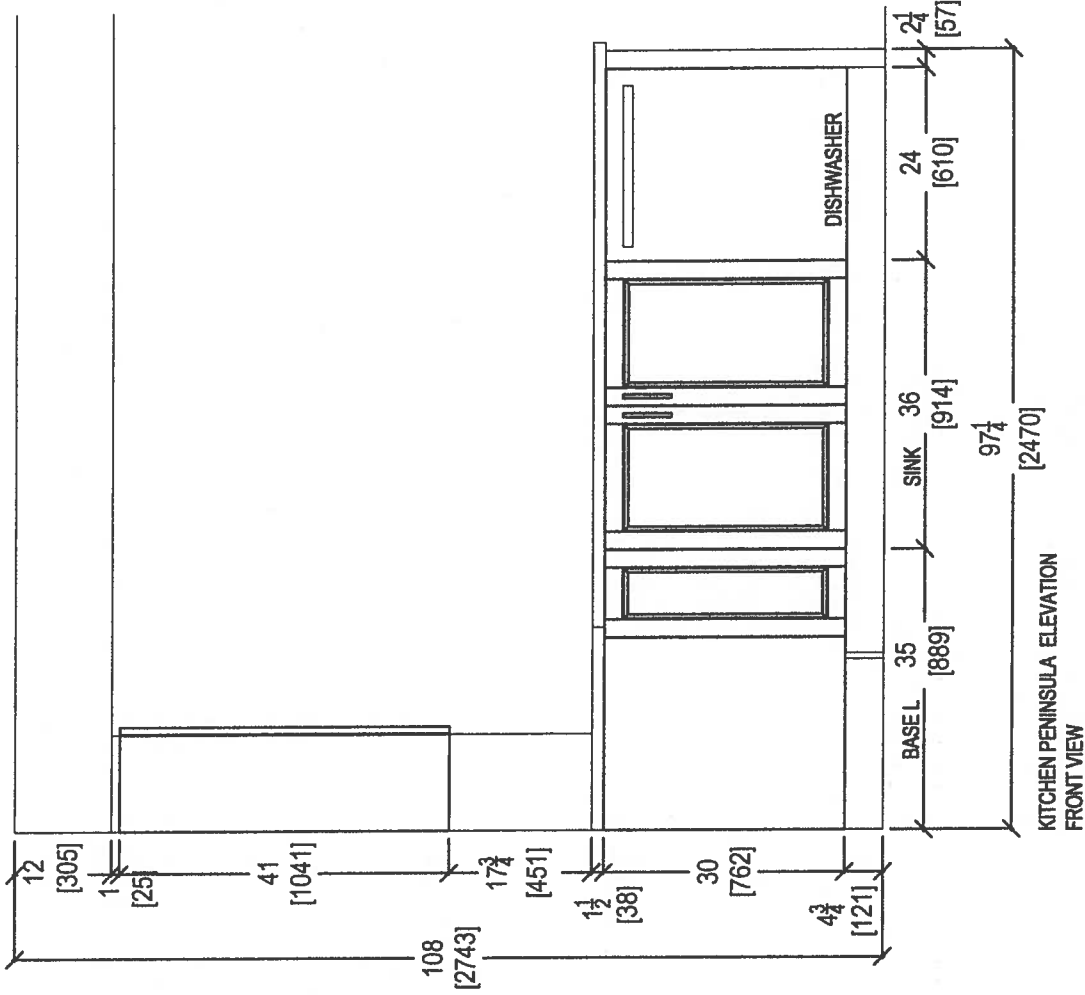
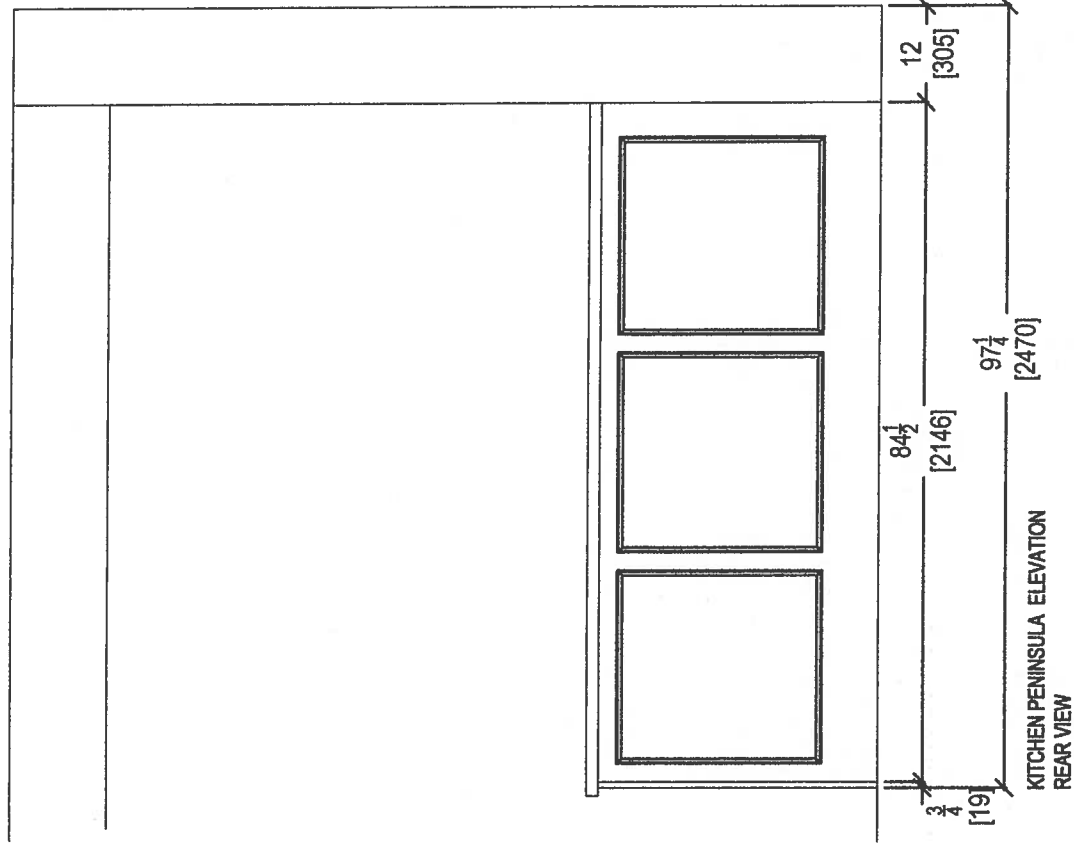


 <i>your kitchen, your taste</i> 80 SANTE DRIVE, VAUGHAN, ON L4K 3C4, T: 416.746.1811 F: 905.761.5901	CLIENT: ROYAL PINE HOMES		JOB NAME: UNIT 314 HMP		ROOM:	DRAWN BY: SK		COMMENTS: PLEASE NOTE ALL DIMENSIONS ARE NOT FINAL AND ARE SUBJECT TO CHANGE UPON FINAL SITE MEASURE		
	SITE: HAMPTON PLACE		LOT #:		DOOR HANDLE: —		SCALE: 1/2" = 1' - 0"			
	PHONE: —		FINISH: —		DRW HANDLE: —		DATE: JAN 10, 2018			
	EMAIL: —		SPECIES: —		TOP: —		PAGE: —			

67

Revised: January 14, 2019 - As per Fonzie

Suite # 314

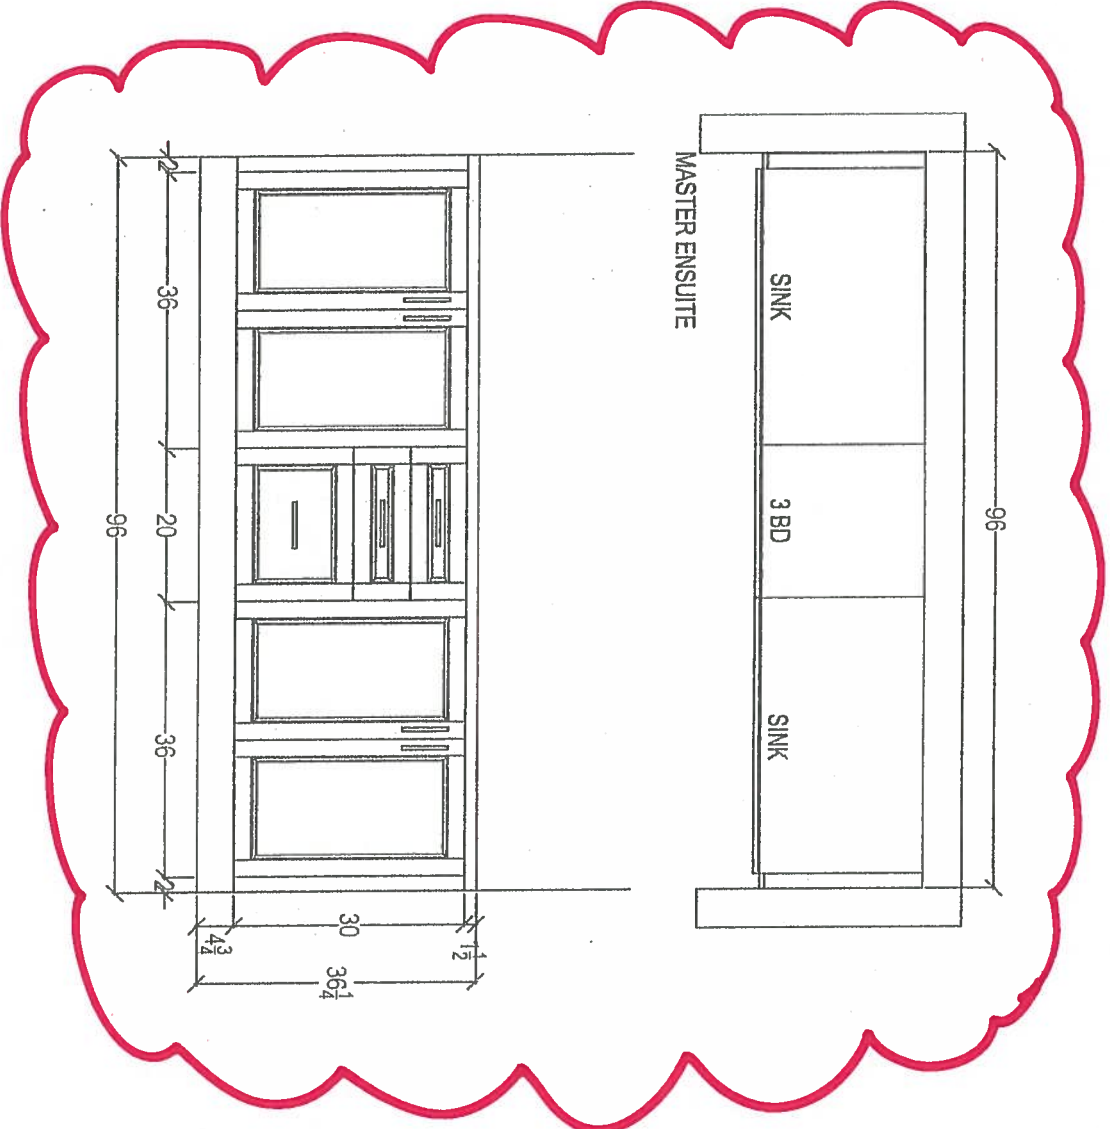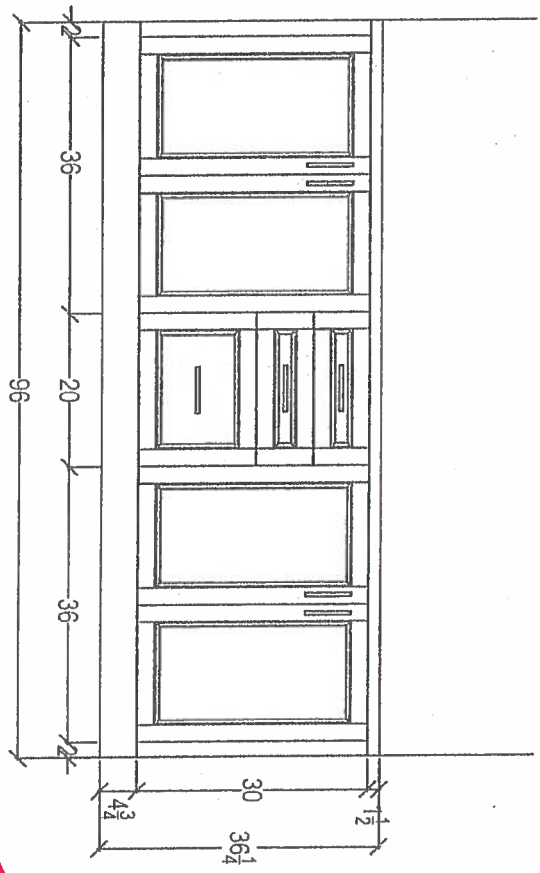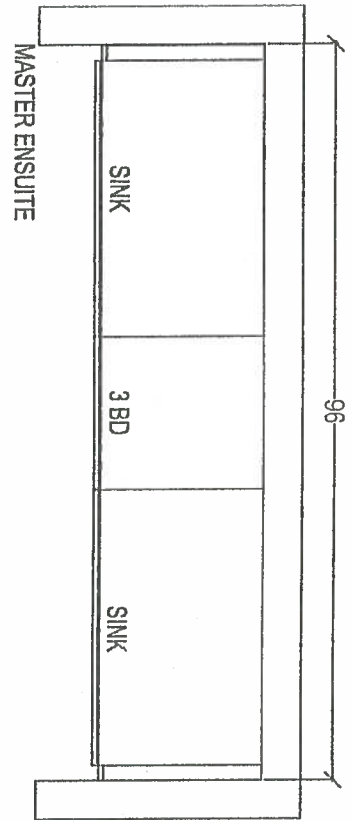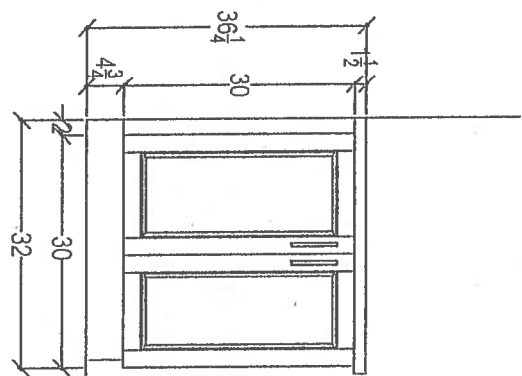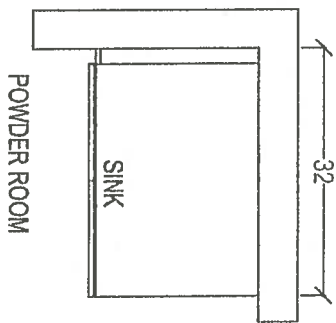

your kitchen, your taste.
80 SANTE DRIVE, VAUGHAN, ON L4K 3C4,
T: 416.746.1811 F: 905.761.5801

CLIENT: ROYAL PINE HOMES	JOB NAME: UNIT 314 HMP	ROOM: VANITIES	DRAWN BY: SK
SITE: HAMPTON PLACE	LOT #:	DOOR HANDLE: —	SCALE: 1/2" = 1' - 0"
PHONE: —	FINISH: —	DRW HANDLE: —	DATE: JAN 11, 2019
EMAIL: —	SPECIES: —	TOP: —	PAGE: —

COMMENTS:
PLEASE NOTE ALL DIMENSIONS
ARE NOT FINAL AND ARE
SUBJECT TO CHANGE UPON
FINAL SITE MEASURE

Suite 314
Hampton

Upgrade
Package I

WRB322DMBM

Whirlpool®

<http://www.whirlpool.com>

33-inches wide Bottom-Freezer Refrigerator with
SpillGuard™ Glass Shelves - 22 cu. ft

Key Features:

- SpillGuard™ Glass Shelves
- Adaptive Defrost / *Factory Installed Icemaker*
- FreshFlow™ Produce Preserver
- LED Interior Lighting
- ENERGY STAR® Qualified

Product Dimensions:

Height: 70

Width: 32 5/8

Depth: 33 3/8

Electrical Requirements:

15


Additional Information:

[Use And Care Guide](#)

[Dimension Guide](#)

[Energy Guide](#)

[Warranty Certificate](#)

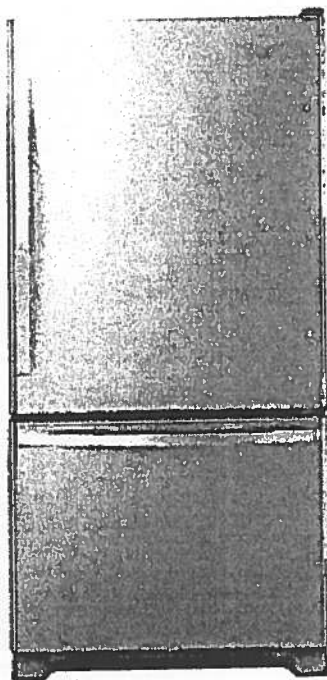

INVESTED
IN
AMERICA



©Registered trademark/TM Trademark of Whirlpool, U.S.A. © 2016 Whirlpool Corporation. All Rights Reserved.
All other trademarks are owned by their respective companies.
Because Whirlpool Corporation policy includes a continuous commitment to improve our products, we reserve
the right to change materials and specifications without notice. We also reserve the right to discontinue or
transition products without notice.
Manufacturer's Suggested Retail Price (MSRP) and Minimum Advertised Price (MAP) provided for reference
purposes only. Dealer alone determines advertised and retail prices.
Created On: Tuesday, March 14, 2017 11:30:08

Suite 314 Hampton

Upgrade Package I



WEE745H0FS

Whirlpool®

6.4 Cu. Ft. Slide-In Electric Range with True
Convection

<http://www.whirlpool.com>



Key Features:

- Frozen Bake™ Technology
- True Convection Cooking
- FlexHeat™ Triple Radiant Element
- Convection Conversion
- AquaLift® Self-Cleaning Technology
- Temperature Sensor
- Rapid Preheat
- 6.4 Cu. Ft. Capacity
- Easy-Wipe Ceramic Glass Cooktop
- Large Oven Window
- Max Capacity Rack
- Hidden Bake Element

Product Dimensions:

Height: 36

Width: 29 7/8

Additional Information:

[Use And Care Guide](#)

[Dimension Guide](#)

[Installation Guide](#)

[Warranty Certificate](#)

INVESTED
IN
AMERICA



®Registered trademark/TM Trademark of Whirlpool, U.S.A. © 2016 Whirlpool Corporation. All Rights Reserved.
All other trademarks are owned by their respective companies.
Because Whirlpool Corporation policy includes a continuous commitment to improve our products, we reserve
the right to change materials and specifications without notice. We also reserve the right to discontinue or
transition products without notice.
Manufacturer's Suggested Retail Price (MSRP) and Minimum Advertised Price (MAP) provided for reference
purposes only. Dealer alone determines advertised and retail prices.
Created On: Friday, January 27, 2017 10:46:47

Suite 314
Hampton

Upgrade
Package 1



YWMH76719CS

1.9 cu. ft. Microwave Hood Combination with
TimeSavor™ Plus True Convection



<http://www.whirlpool.com>

Key Features:

- TimeSavor™ Plus True Convection Cooking System
- Steam Cooking
- Sensor Cooking
- AccuPop™ Cycle
- CleanRelease® Non-Stick Interior
- SteamClean Option
- Integrated Hidden Vent and Console
- Auto Adapt Fan
- Recessed, Stoppable Glass Turntable
- Universal Microwave Steamer
- 1.9 cu. ft. Capacity
- 1,100 Watts Cooking Power

Product Dimensions:

Height: 17 1/8

Width: 29 15/16

Depth: 18 1/2

Electrical Requirements:

15 or 20. 120 V.

Additional Information:


Use And Care Guide

Installation Guide

Warranty Certificate

Available in:


 Stainless Steel

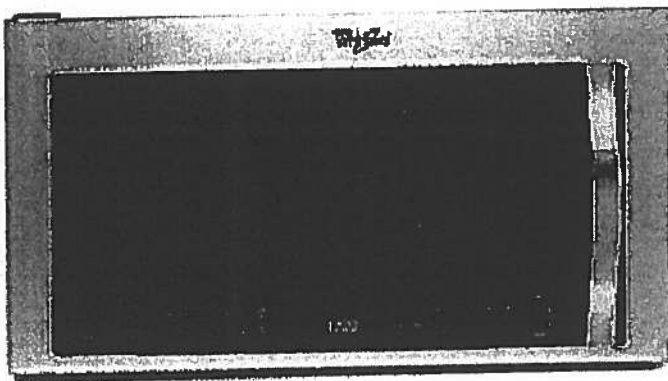

®Registered trademark/TM Trademark of Whirlpool, U.S.A. © 2013 Whirlpool Corporation. All Rights Reserved
All other trademarks are owned by their respective companies.
Because Whirlpool Corporation policy includes a continuous commitment to improve our products, we reserve the right to change materials and specifications without notice. We also reserve the right to discontinue or transition products without notice.
Manufacturer's Suggested Retail Price (MSRP) and Minimum Advertised Price (MAP) provided for reference purposes only. Dealer alone determines advertised and retail prices.
Created On: Monday, March 14, 2016 13:16:48

Suite 314
Hampton

Upgrade
Package 1

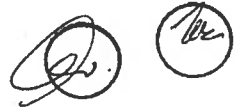

WDTA50SAHZ

Contemporary Design. Stainless Steel Tub
Dishwasher with TotalCoverage Spray Arm

Whirlpool®

<http://www.whirlpool.com>

Key Features:

- Sensor Cycle
- TotalCoverage Spray Arm
- 1-Hour Wash Cycle
- Tap Touch Controls

Product Dimensions:

Height: 34 1/2

Width: 23 7/8

Depth: 24 1/2

Additional Information:


[Use And Care](#)

[Dimension Guide](#)

[Installation Guide](#)

[Energy Guide](#)

[Warranty](#)

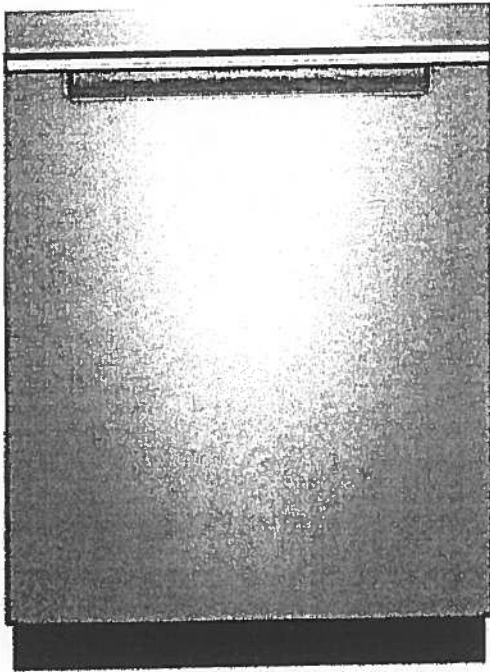

Available in:

● Black

Fingerprint Resistant Sunset Bronze

Fingerprint Resistant Black Stainless

○ White

Fingerprint Resistant Stainless Steel

INVESTED
IN
AMERICA



®Registered trademark/TM Trademark of Whirlpool, U.S.A. © 2016 Whirlpool Corporation. All Rights Reserved. All other trademarks are owned by their respective companies.

Because Whirlpool Corporation policy includes a continuous commitment to improve our products, we reserve the right to change materials and specifications without notice. We also reserve the right to discontinue or transition products without notice.

Manufacturer's Suggested Retail Price (MSRP) and Minimum Advertised Price (MAP) provided for reference purposes only. Dealer alone determines advertised and retail prices.

Suite 314
Hampton

Upgrade
Package 1




WFW75HEFW



4.5 cu. ft. Front Load Washer with Precision
Dispense

<http://www.whirlpool.com>

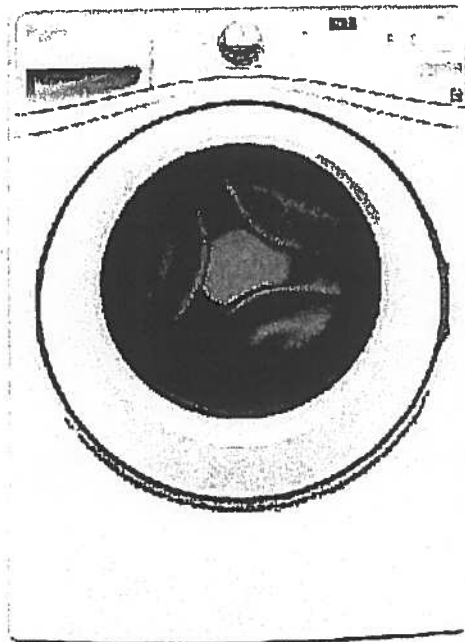

Key Features:

- Precision Dispense
- Adaptive Wash Technology
- Smooth Wave Stainless Steel Wash Basket
- 4.5 cu. ft. Capacity
- ENERGY STAR® Qualified

Product Dimensions:

Height: 39 3/4

Width: 27

Depth: 33 5/16

Electrical Requirements:

15 or 20. 120 V.

Additional Information:

[Use And Care Guide](#)

[Dimension Guide](#)

[Installation Guide](#)

[Energy Guide](#)


[Warranty Certificate](#)

INVESTED
IN
AMERICA



©Registered trademark/TM Trademark of Whirlpool, U.S.A. ©2013 Whirlpool Corporation All Rights Reserved.
All other trademarks are owned by their respective companies.
Because Whirlpool Corporation policy includes a continuous commitment to improve our products, we reserve the right to change materials and specifications without notice. We also reserve the right to discontinue or transition products without notice.
Manufacturer's Suggested Retail Price (MSRP) and Minimum Advertised Price (MAP) provided for reference purposes only. Dealer alone determines advertised and retail prices.
Created On: Wednesday, March 23, 2016 11:51:03

Suite 314 Upgrade Hampton Package 1

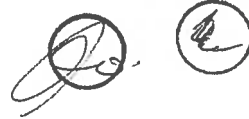

YWED75HEFW

Whirlpool®

8.5 cu. ft. Duet® High Efficiency Front Load Electric
Dryer with ENERGY STAR®

<http://www.whirlpool.com>

MSRP: \$0.00

Key Features:


- Advanced Moisture Sensing System
- Quad Baffles
- Tap Touch Controls with Memory
- EcoBoost™ Option
- Wrinkle Shield™ Plus Option
- Undercounter Installation
- 7.4 Cu. Ft. Capacity
- ENERGY STAR® Qualified

Product Dimensions:

Height: 39
Width: 27
Depth: 31

Additional Information:

[Use And Care](#)
[Installation Guide](#)
[Warranty](#)

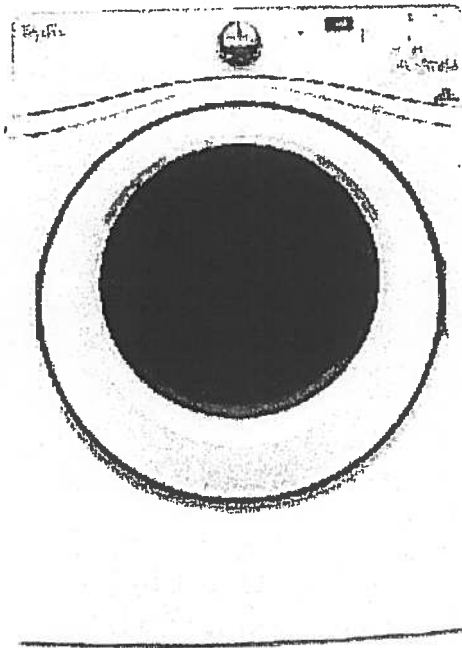

Available in:

☐ White

INVESTED
IN
AMERICA




©Registered trademark/TM Trademark of Whirlpool, U.S.A. © 2016 Whirlpool Corporation. All Rights Reserved. All other trademarks are owned by their respective companies.


Because Whirlpool Corporation policy includes a continuous commitment to improve our products, we reserve the right to change materials and specifications without notice. We also reserve the right to discontinue or transition products without notice.

Manufacturer's Suggested Retail Price (MSRP) and Minimum Advertised Price (MAP) provided for reference purposes only. Dealer alone determines advertised and retail prices.

Standard

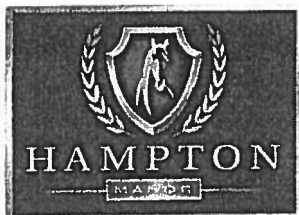


Suite 314
Hampton

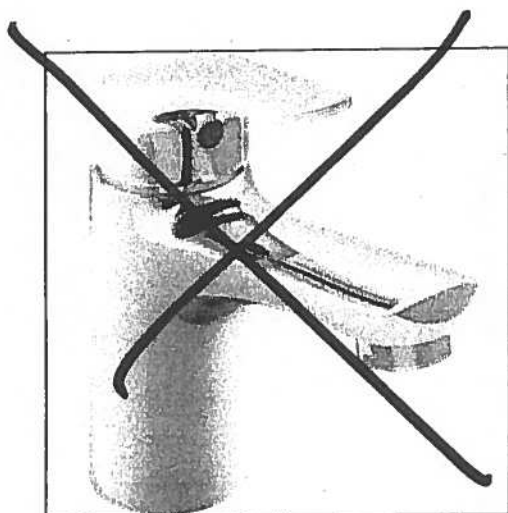


Delta Wynne Chrome Single Lever
Lavatory Faucet With Pop Up
#534LF

Master Ensuite
Shower Stall

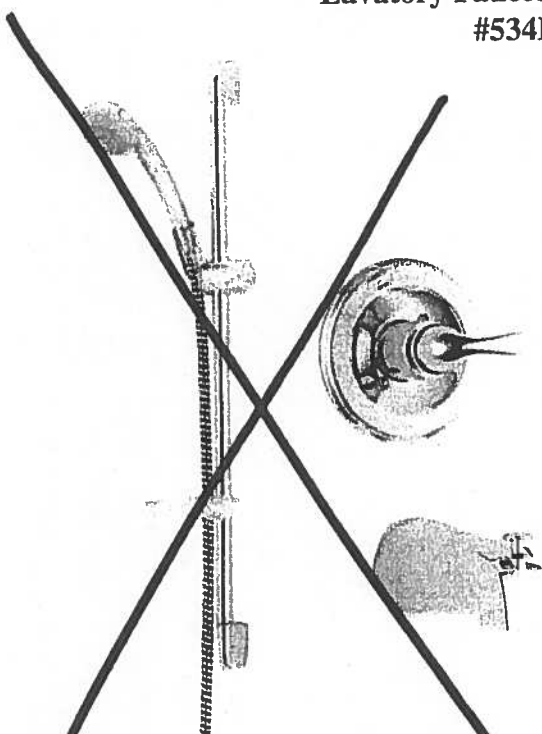

Delta Shower Trim with Tub Spout and
Hansgrohe Slide Bar with Handheld
#R10000/T13020-CDN/2001-TP/27454002/
27744000

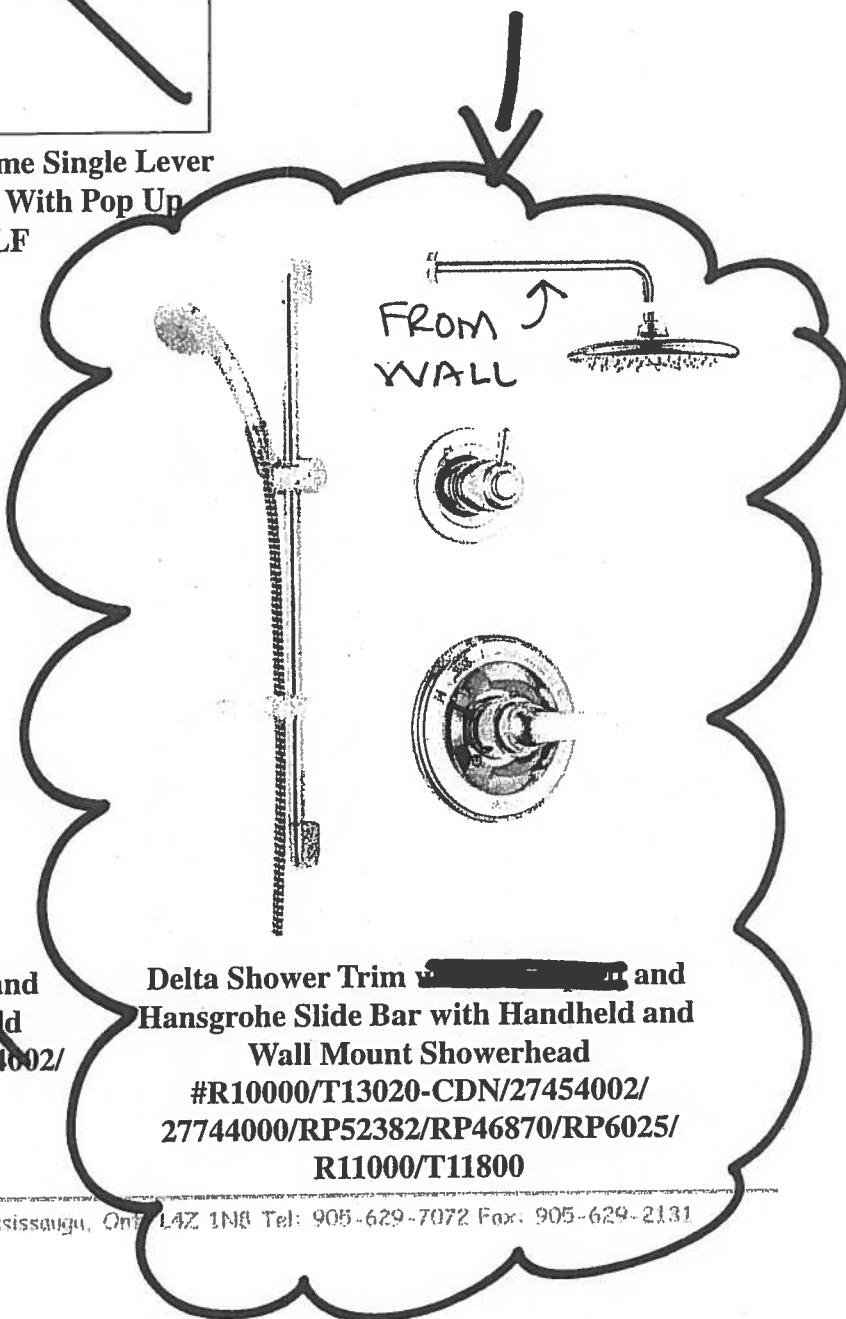

Delta Shower Trim and
Hansgrohe Slide Bar with Handheld and
Wall Mount Showerhead
#R10000/T13020-CDN/27454002/
27744000/RP52382/RP46870/RP6025/
R11000/T11800


Upgrade Kitchen Sinks




BLANCO

Suite 314
Hampton

Kitchen
Sink

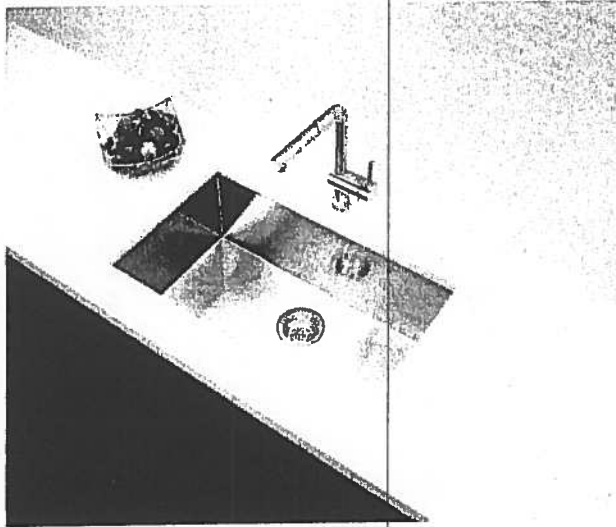

Blanco Quatrus U Super Single
Undermount Sink
#401248

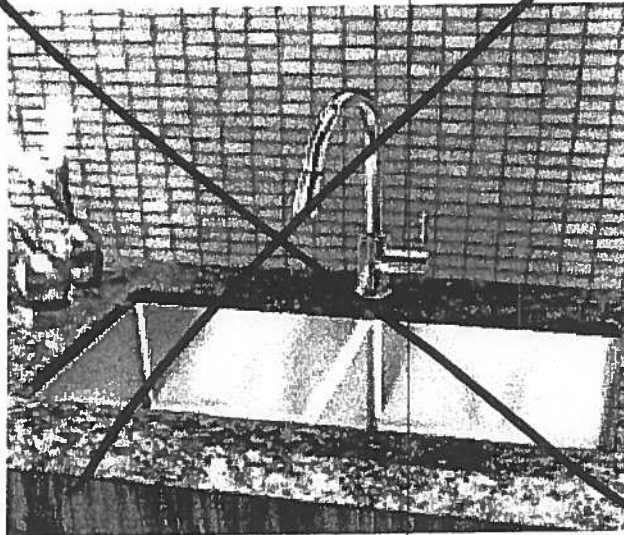

Blanco Quatrus R15 Two Bowl
Undermount Sink
#401519

Suite 314
Hampton


Kitchen
Sink

Product Specification Sheet
BLANCO QUATRUS U 1 SUPER SINGLE

Satin brushed finish



PRODUCT DIMENSIONS

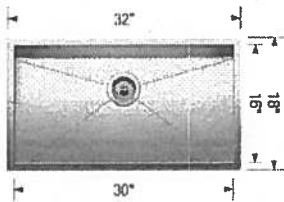

BLANCO QUATRUS U 1 SUPER SINGLE	Colour Finish	Model No.	FEATURES / SPECIFICATIONS
	Satin brushed finish	401248	• German designed and engineered • Premium 304 series, 18 gauge stainless steel • 18/10 chrome-nickel content for exceptional lustre, durability and strength • Compact sized model • Rear-positioned drain hole for maximum usable bowl and cabinet storage space • Zero-radius corners, X-pattern drain grooves • 3 1/2" (90 mm) stainless steel strainer included • Undermount clips, template included • Limited Lifetime Warranty
DESIGN AND PLANNING TIPS			
Cabinet Size: 36" (915 mm) Bowl depth: 9" (230 mm) Depending on cabinet construction, a different cabinet size may be required. Consult the cabinet manufacturer.			

WARRANTY

Limited Lifetime warranty

Code/Standards Compliance

BLANCO sinks and faucets are third-party tested and certified to CSA, cUPC, ANSI/ASME and NSF standards and listed by applicable certification bodies. For more information on individual product listings, contact our office or listing organization.

Countertop Edges

Suite 314

Hampton



Dec 7, 2017

CONNOLLY Marble & Granite Ltd.

EDGE
DETAILS

004


A.



STRAIGHT EDGE
(STANDARD - 3/4")


Standard:
Kitchen
Main Bath
Master Ensuite

~~I.~~

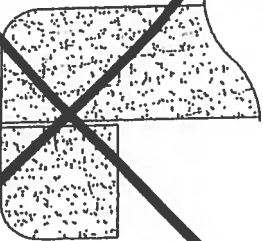

~~DOUBLE TOP "D" EDGE
(STANDARD - 1 1/2")~~

~~M.~~

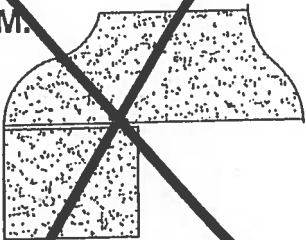

~~OGEE - SQUARE EDGE
(MED./HIGH - 1 1/2")~~

EDGING UP-GRADE OPTIONS