






Suite 217-
ORIGINAL (SALES)
(INVENTORY SUITE)

SAG HARBOUR: 217
- MOVE FRONT DOOR (FOR 6" WALL BEHIND WASHER/ DRYER)



Sag Harbor

878 SQ FT *plus 119 sq. ft. of balcony area*

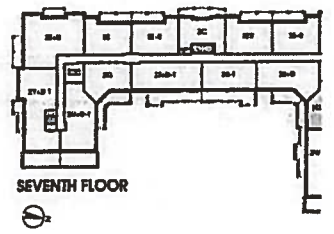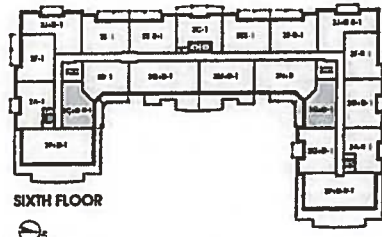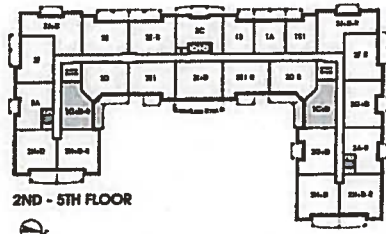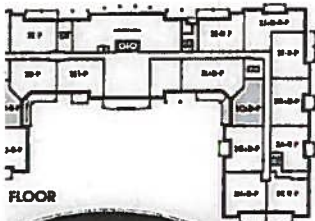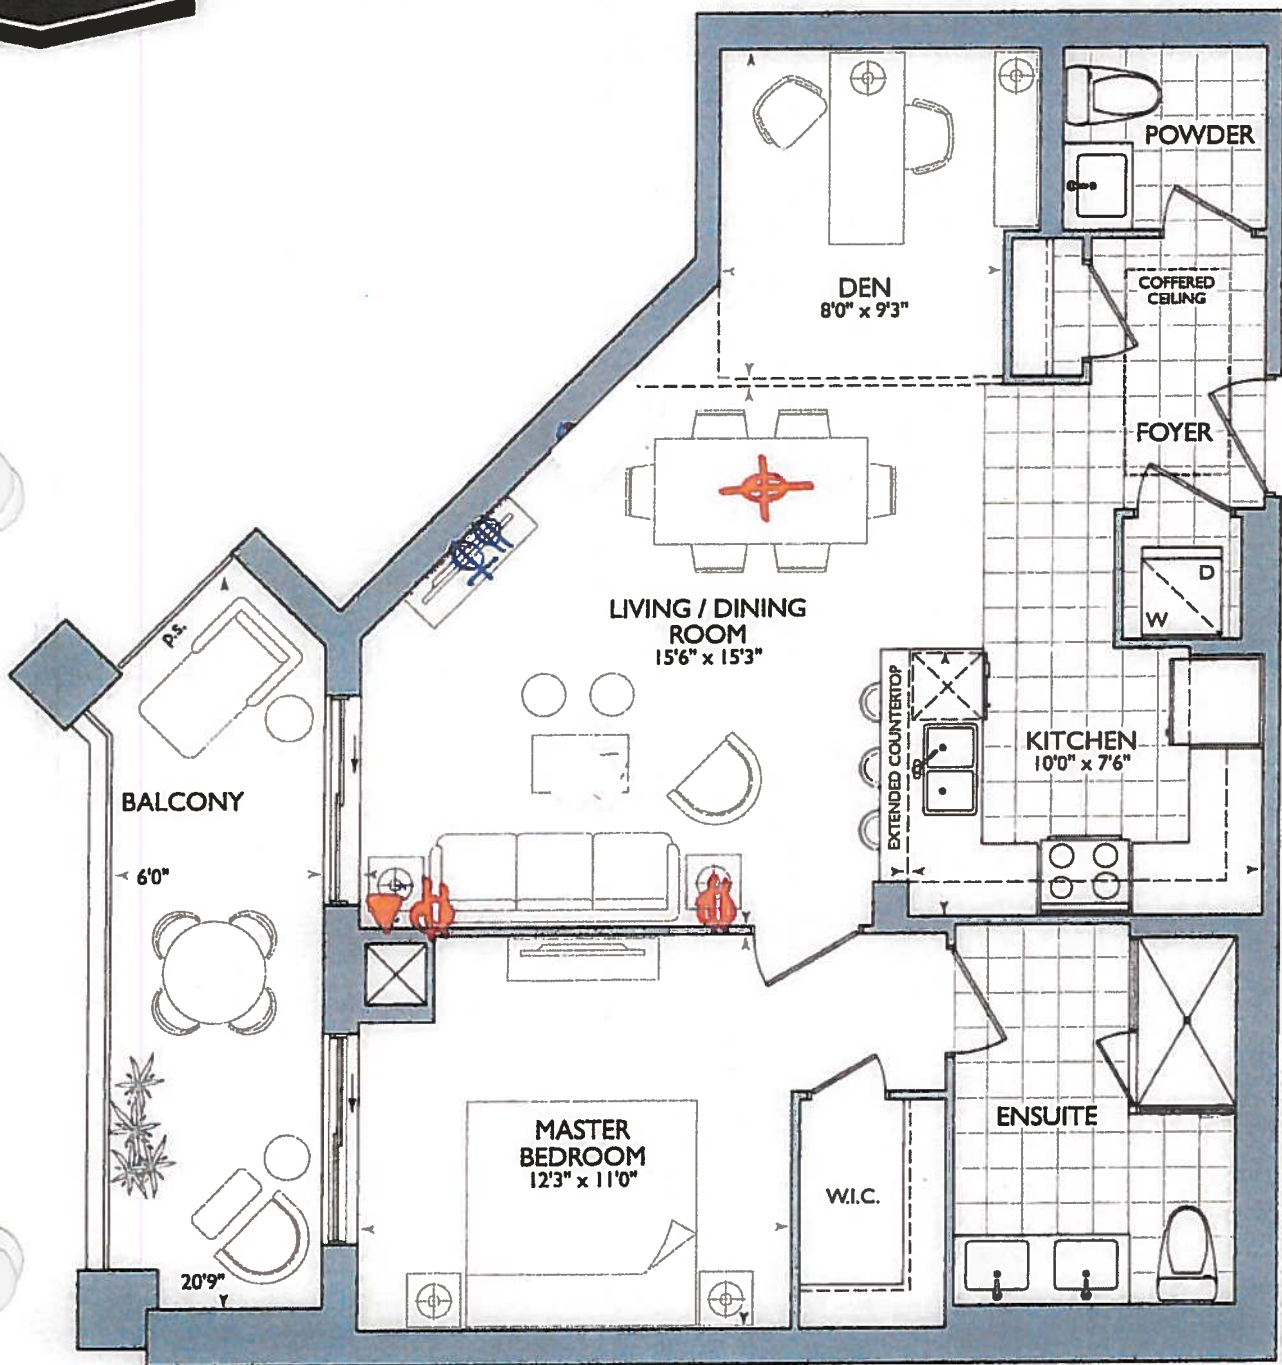

* Front Door move *
 Due to Laundry Room
 @ Kitchen size.


Kitchen

- (P) = Plug Peninsula
- (2x) = Pendant Lights over Peninsula
- SMO Kitchen Layout
- 1st Upgrade Appliance Pkg w/ 36" upg Fridge
- (x3) Puck Lights
- 66" stove pipe central (smo)
- 117" sink pipe central (smo)

INVENTORY SUITE

SUITE 217 - SAG HAR


HALETON PLACE 25 Baker Hill Bldg
 JFville, ON Jan 23, 2018
 DRAWING AS PER AGREEMENT OF PURCHASE AND SALE (before decor appointment)

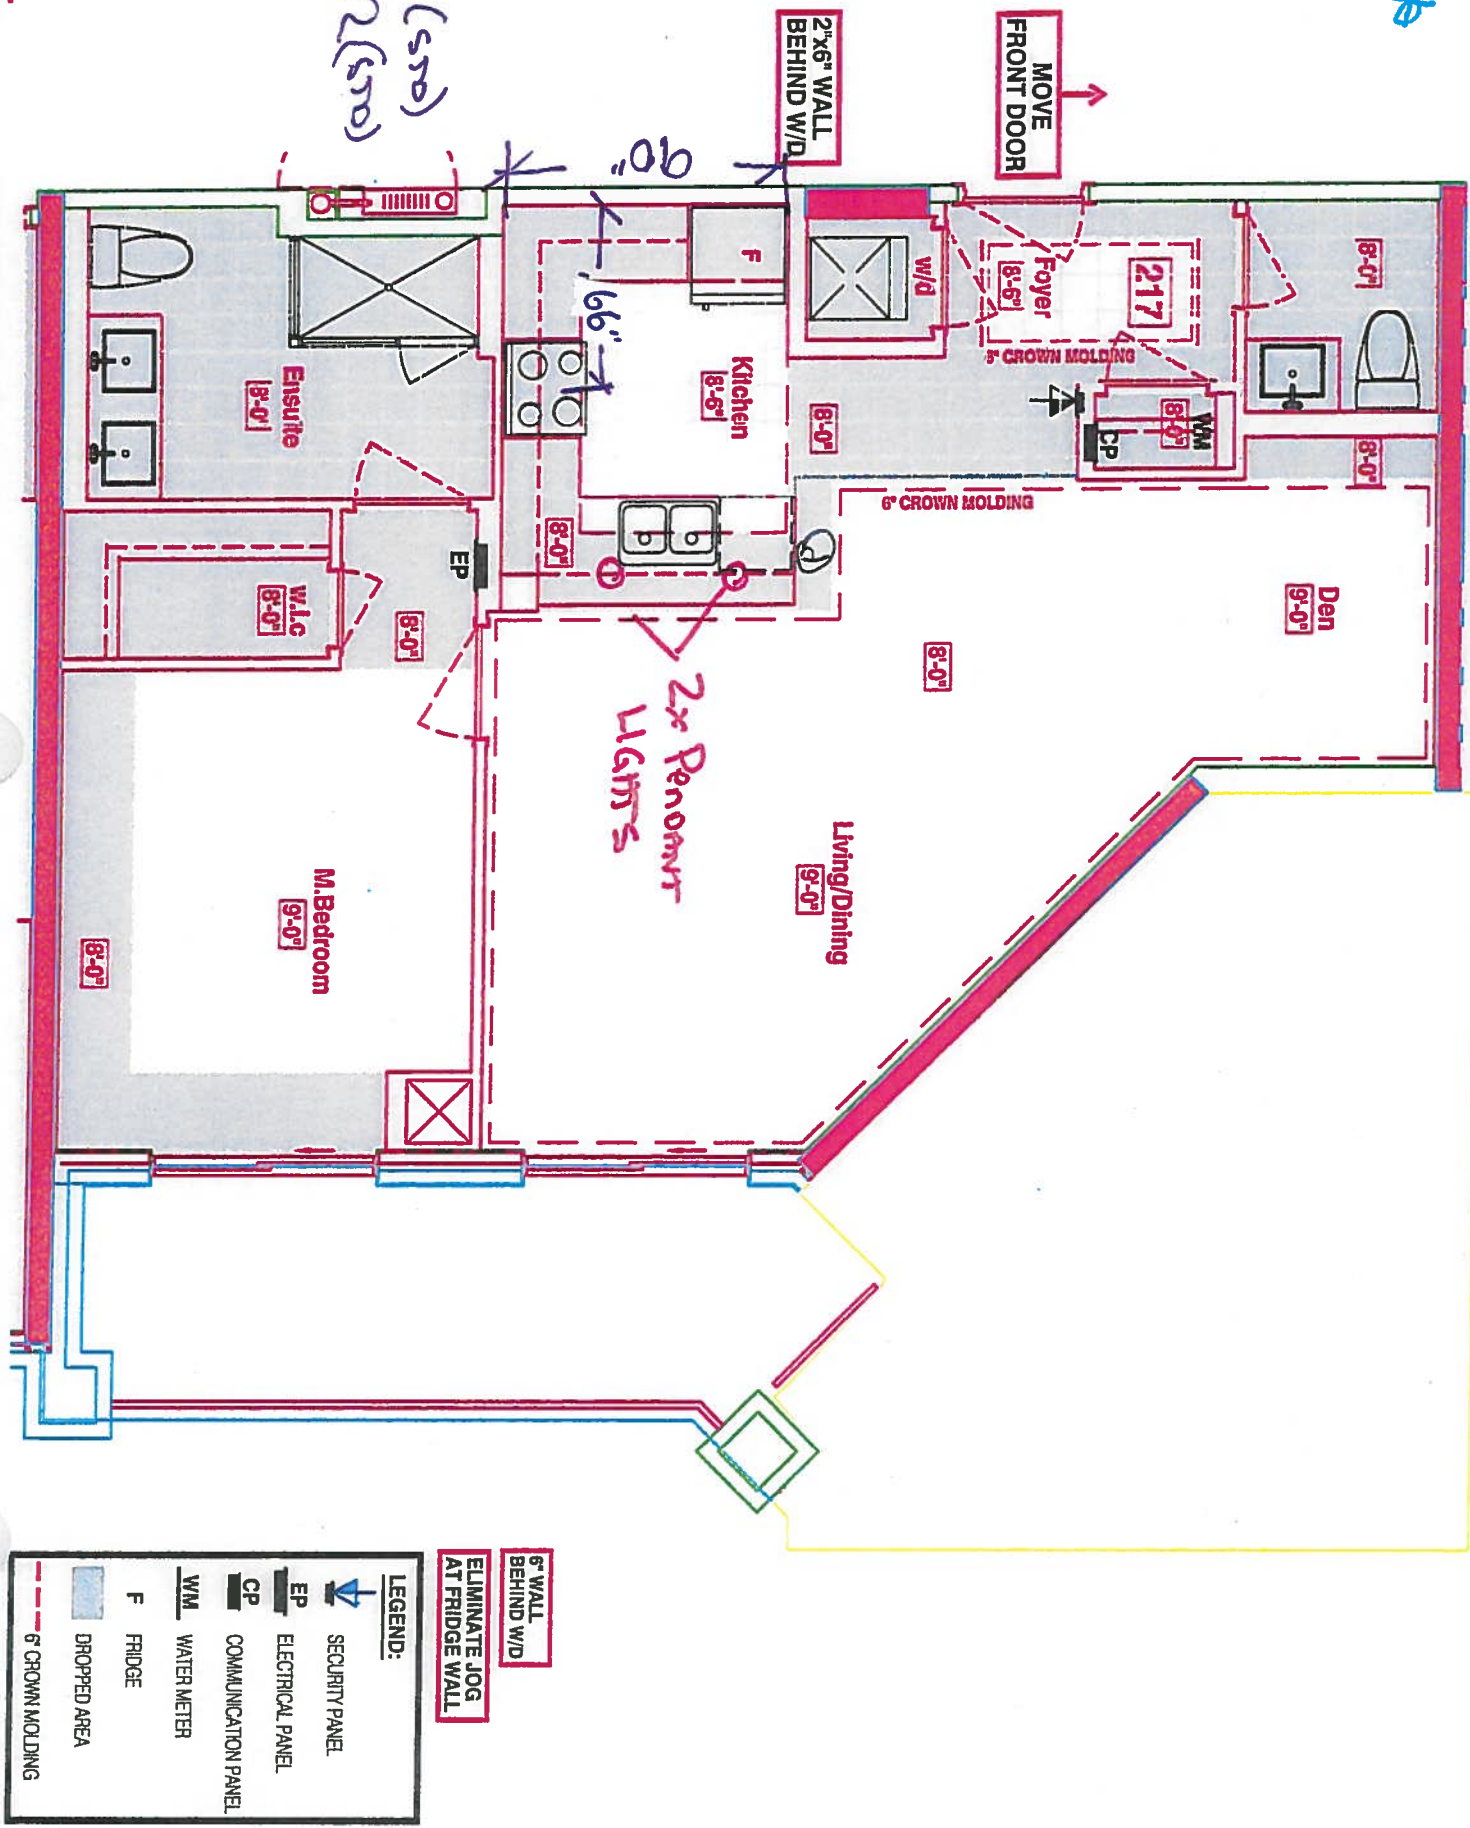



your kitchen. your taste.
80 SANTE DRIVE, VAUGHAN, ON L4K 3C4.
T: 416.746.1811 F: 905.761.5901

CLIENT: ROYAL PINE HOMES	JOB NAME: UNIT 217 HMP	ROOM: KITCHEN	DRAWN BY: SK	COMMENTS:
SITE: HAMPTON PLACE	DOOR STYLE: —	DOOR HANDLE: —	SCALE: 1/2" = 1' - 0"	
PHONE: —	FINISH: —	DRW HANDLE: —	DATE: JAN 22, 2019	
EMAIL: —	SPECIES: —	TOP: —	PAGE: —	

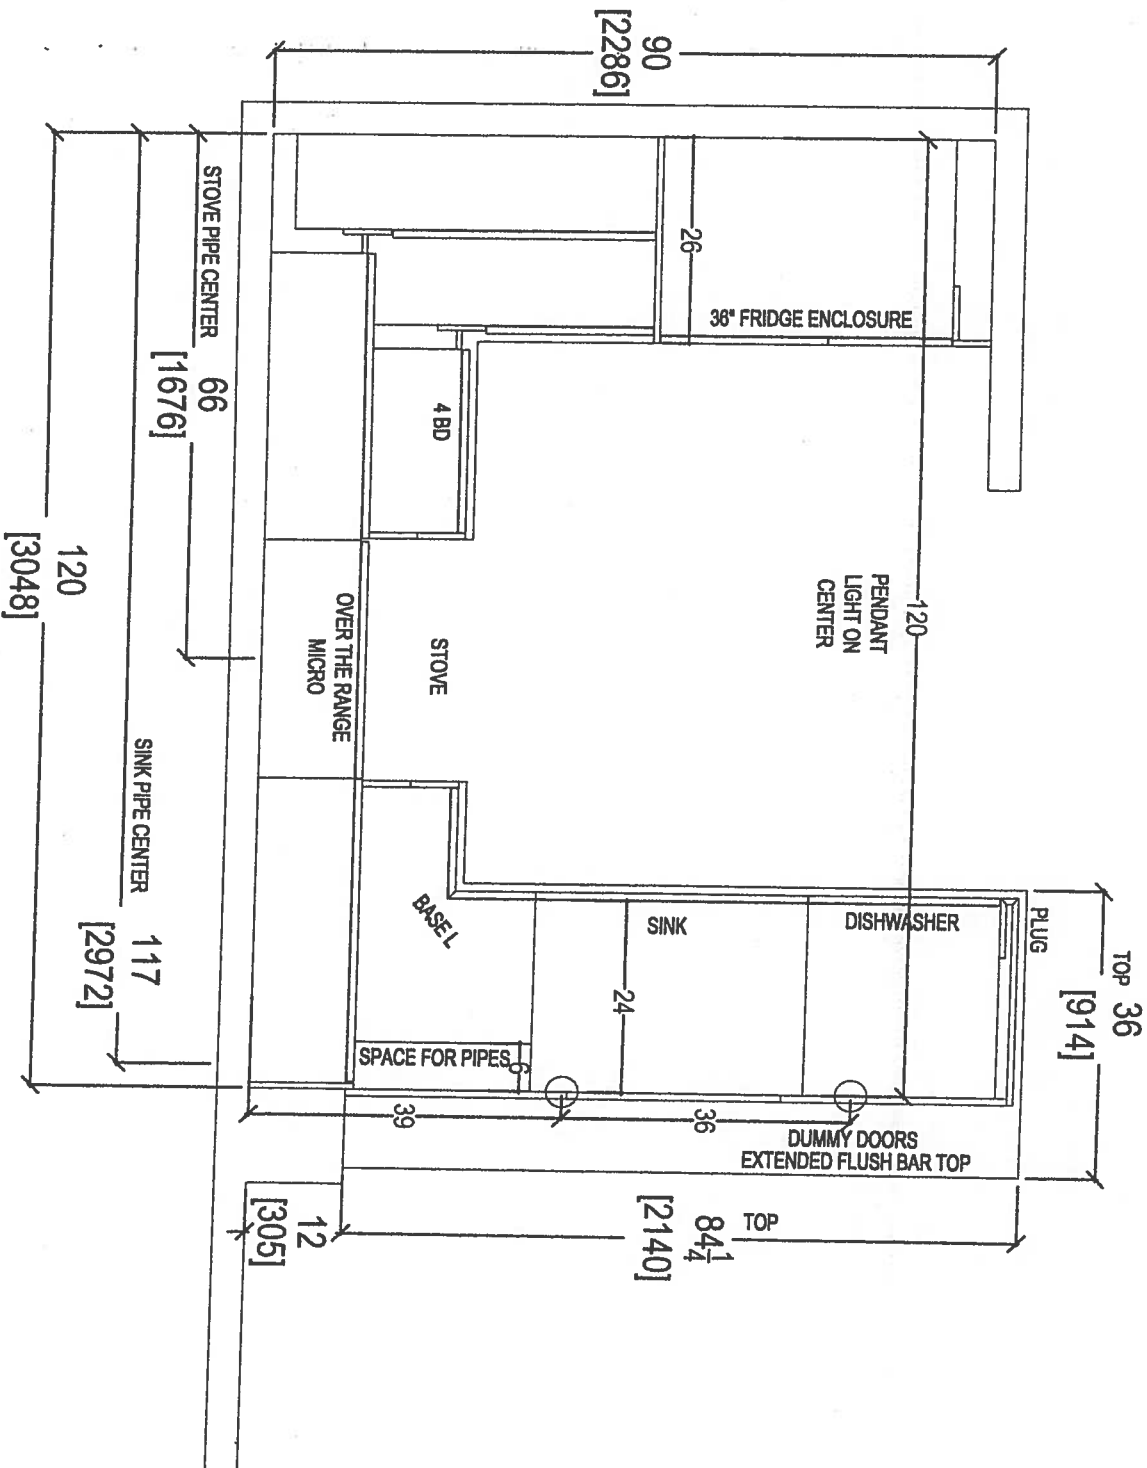

80 SANTE DRIVE, VAUGHAN, ON L4K 3C4,
T: 416.746.1811 F: 905.761.5901

CLIENT: ROYAL PINE HOMES

JOB NAME: UNIT 217 HMP

ROOM: KITCHEN

DRAWN BY: SK

COMMENTS:

SITE: HAMPTON PLACE

DOOR STYLE: —

DOOR HANDLE: —

SCALE: 1/2" = 1'-0"

PHONE: —

FINISH: —

DRW HANDLE: —

DATE: JAN 22, 2019

EMAIL: —

SPECIES: —

TOP: —

PAGE: —



your kitchen. your taste.

CLIENT: ROYAL PINE HOMES

JOB NAME: INIT 317 UNB

ROOM: KITCHEN

DRAWN BY: SK

COMMENTS:

SITE: HAMPTON PLACE

DOOR STYLE:

Age	Gender	Height (cm)	Weight (kg)	Body Mass Index (kg/m ²)	Waist Circumference (cm)	Waist-Hip Ratio	Trunk Flexion Angle (°)	Trunk Flexion Moment (Nm)	Trunk Flexion Force (N)	Trunk Flexion Torque (Nm)	Trunk Flexion Power (W)
20	Male	175	75	24.2	85	0.85	30	150	150	150	150
25	Male	180	80	24.7	90	0.85	35	175	175	175	175
30	Male	185	85	24.2	95	0.85	40	200	200	200	200
35	Male	190	90	24.7	100	0.85	45	225	225	225	225
40	Male	195	95	24.2	105	0.85	50	250	250	250	250
45	Male	200	100	24.7	110	0.85	55	275	275	275	275
50	Male	205	105	24.2	115	0.85	60	300	300	300	300
55	Male	210	110	24.7	120	0.85	65	325	325	325	325
60	Male	215	115	24.2	125	0.85	70	350	350	350	350
65	Male	220	120	24.7	130	0.85	75	375	375	375	375
70	Male	225	125	24.2	135	0.85	80	400	400	400	400
75	Male	230	130	24.7	140	0.85	85	425	425	425	425
80	Male	235	135	24.2	145	0.85	90	450	450	450	450
85	Male	240	140	24.7	150	0.85	95	475	475	475	475
90	Male	245	145	24.2	155	0.85	100	500	500	500	500
95	Male	250	150	24.7	160	0.85	105	525	525	525	525
100	Male	255	155	24.2	165	0.85	110	550	550	550	550
105	Male	260	160	24.7	170	0.85	115	575	575	575	575
110	Male	265	165	24.2	175	0.85	120	600	600	600	600
115	Male	270	170	24.7	180	0.85	125	625	625	625	625
120	Male	275	175	24.2	185	0.85	130	650	650	650	650
125	Male	280	180	24.7	190	0.85	135	675	675	675	675
130	Male	285	185	24.2	195	0.85	140	700	700	700	700
135	Male	290	190	24.7	200	0.85	145	725	725	725	725
140	Male	295	195	24.2	205	0.85	150	750	750	750	750
145	Male	300	200	24.7	210	0.85	155	775	775	775	775
150	Male	305	205	24.2	215	0.85	160	800	800	800	800
155	Male	310	210	24.7	220	0.85	165	825	825	825	825
160	Male	315	215	24.2	225	0.85	170	850	850	850	850
165	Male	320	220	24.7	230	0.85	175	875	875	875	875
170	Male	325	225	24.2	235	0.85	180	900	900	900	900
175	Male	330	230	24.7	240	0.85	185	925	925	925	925
180	Male	335	235	24.2	245	0.85	190	950	950	950	950
185	Male	340	240	24.7	250	0.85	195	975	975	975	975
190	Male	345	245	24.2	255	0.					

BOOK STYLE:

PHONE: _____

FINISH.

EMAIL: _____

SPECIFICATIONS.

— 3000 —

SPECIES:

1000

SPECIES:

TOP:

1

PAGE

1




DISHWASHER


**KITCHEN PENINSULA ELEVATION
FRONT VIEW**

**KITCHEN PENINSULA ELEVATION
REAR VIEW**



[2419]

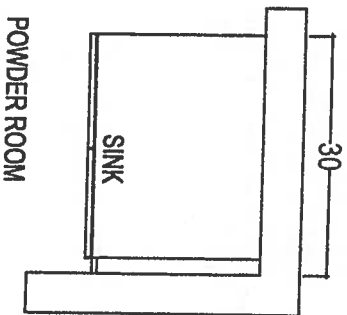

POWDER ROOM

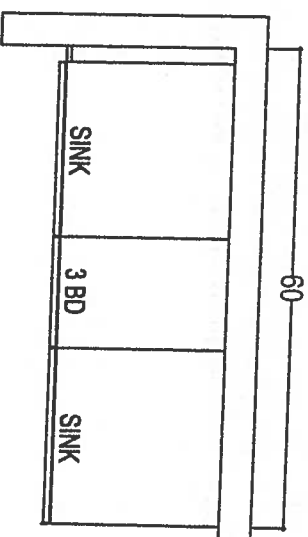

MASTER ENSUITE

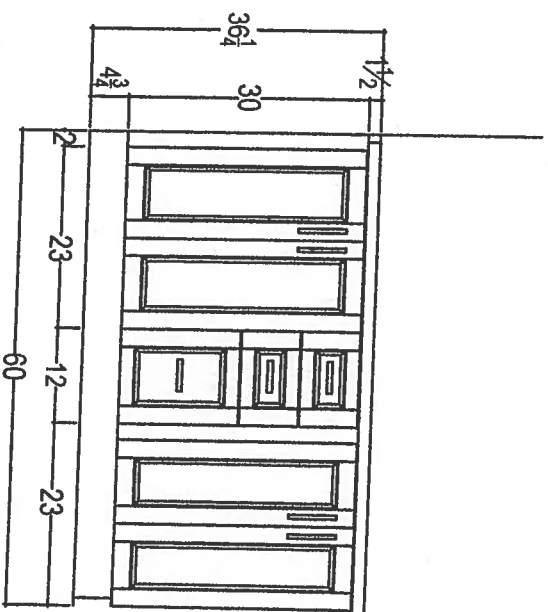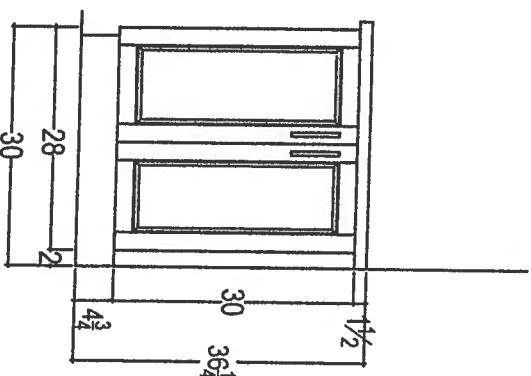

Your kitchen, your taste.
80 SANTE DRIVE, VAUGHAN, ON L4K 3C4,
T: 416.746.1811 F: 905.761.5901

CLIENT: ROYAL PINE HOMES	JOB NAME: UNIT 217 HMP	ROOM: VANITIES	DRAWN BY: SK	COMMENTS:
SITE: HAMPTON PLACE	DOOR STYLE: —	DOOR HANDLE: —	SCALE: 1/2" = 1' - 0"	PLEASE NOTE ALL DIMENSIONS ARE NOT FINAL AND ARE SUBJECT TO CHANGE UPON FINAL SITE MEASURE
PHONE: —	FINISH: —	DRV HANDLE: —	DATE: JAN 22, 2019	
EMAIL: —	SPECIES: —	TOP: —	PAGE: —	